



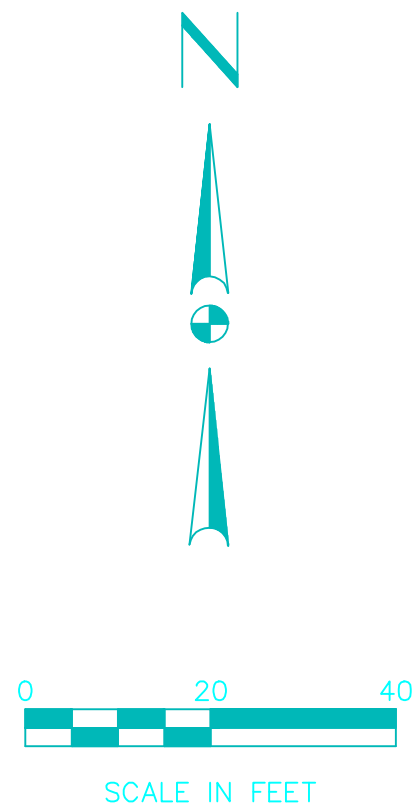

HIGHWAY PERMIT
TEMPORAY CONSTRUCTION ENTRANCE
1010 RIDGE ROAD
CITY OF ROCKWALL
ROCKWALL COUNTY, TEXAS
LOCATION MAP
NTS

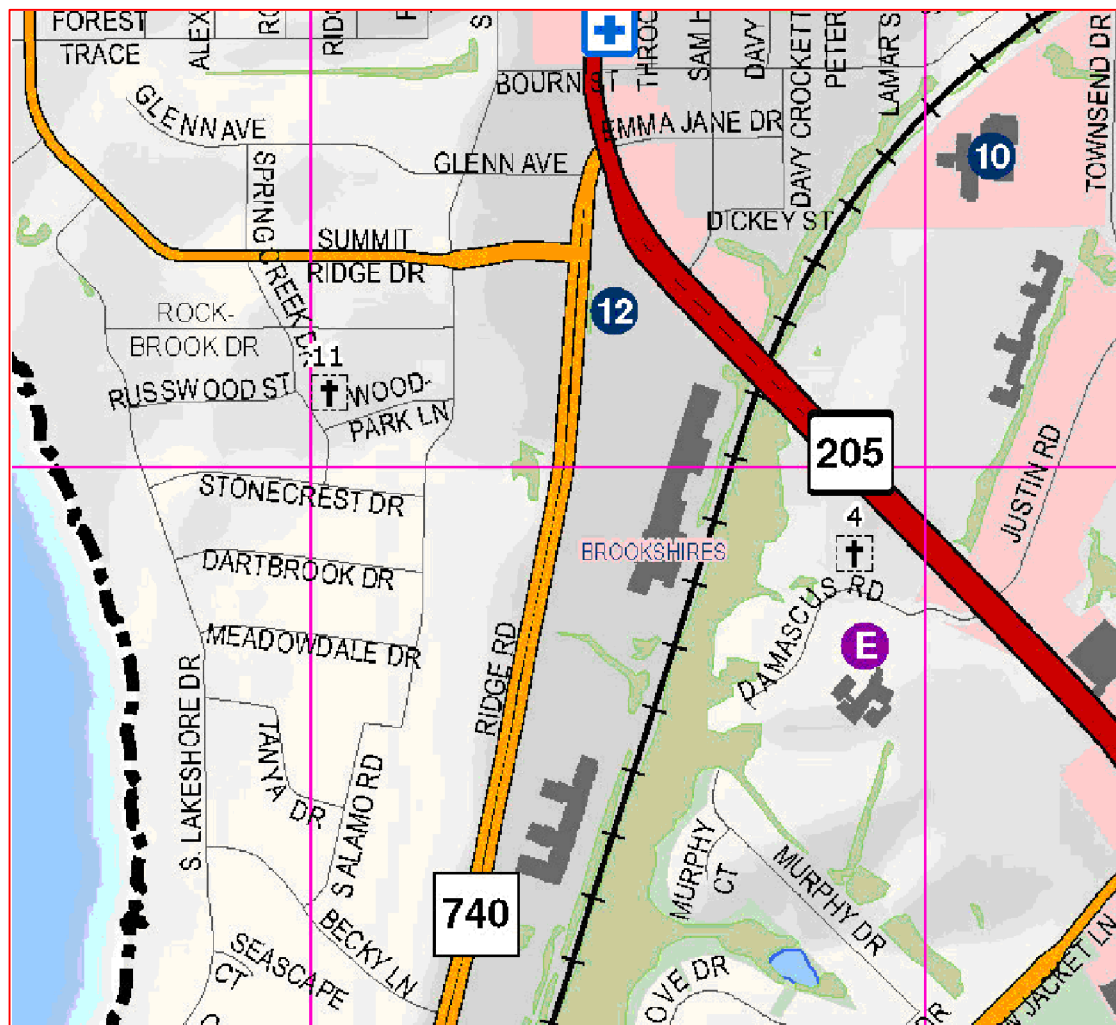


DOUPHRATE & ASSOCIATES, INC.
ENGINEERING • PROJECT MANAGEMENT • SURVEYING
2235 RIDGE RD., # 200
ROCKWALL, TEXAS 75087
PHONE: (972)771-9004 FAX: (972)771-9005

REVISED TO CONFORM TO CONSTRUCTION RECORDS.

W. L. Douphrate II


DATE: 12/17/15

HIGHWAY PERMIT
TURNOUT REMOVAL
AND CURB & WALK REPLACEMENT
1010 RIDGE ROAD
CITY OF ROCKWALL
ROCKWALL COUNTY, TEXAS
LOCATION MAP
NTS

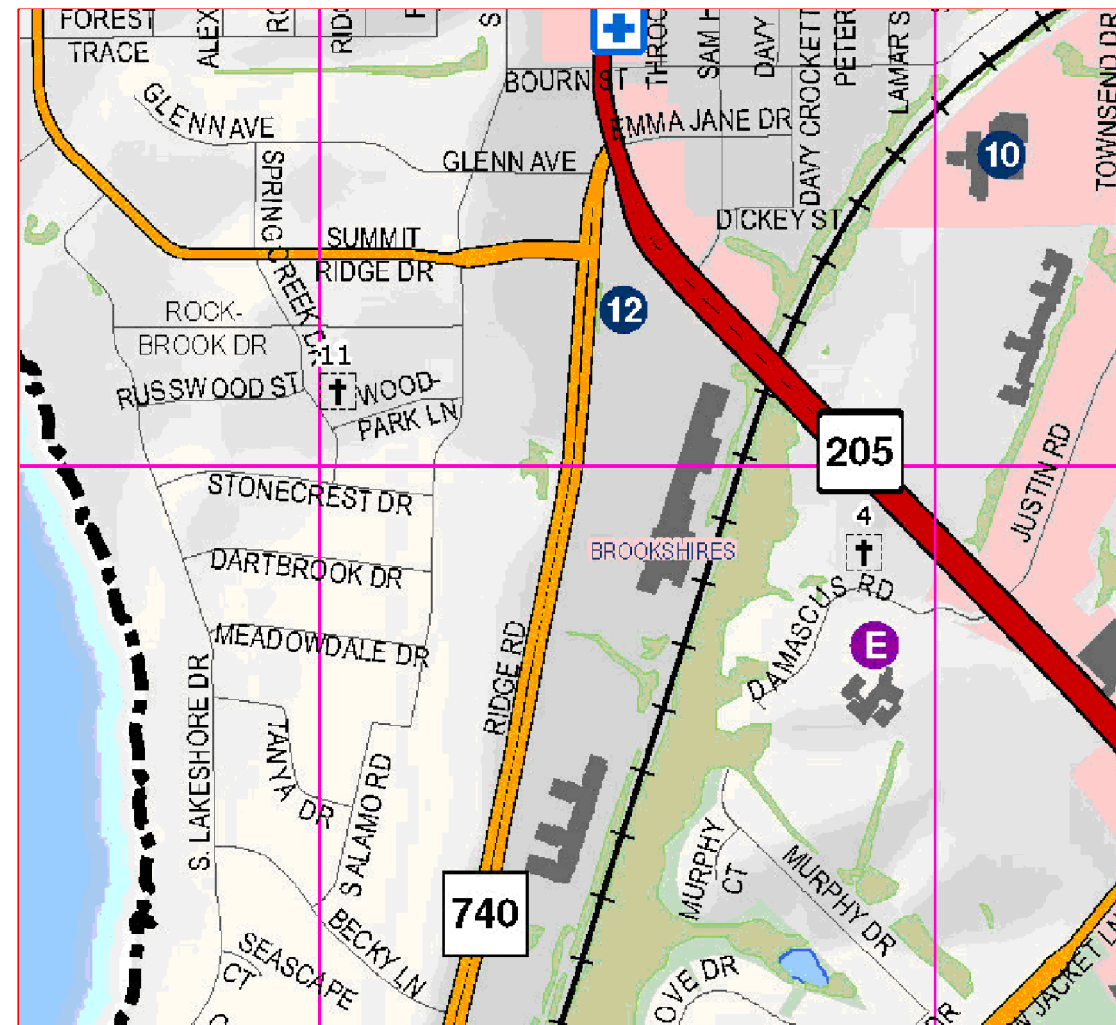

DOUPHRATE & ASSOCIATES, INC.
ENGINEERING • PROJECT MANAGEMENT • SURVEYING
2235 RIDGE RD., # 200
ROCKWALL, TEXAS 75087
PHONE: (972)771-9004 FAX: (972)771-9005

DOUPHRATE & ASSOCIATES, INC.



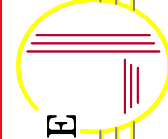


ENGINEERING • PROJECT MANAGEMENT • SURVEYING
2235 RIDGE RD., # 200 ROCKWALL, TEXAS 75087
PHONE: (972)771-9004 FAX: (972)771-9005

EROSION CONTROL PLAN
PREGNANCY RESOURCE CENTER
1010 RIDGE ROAD
CITY OF ROCKWALL
ROCKWALL COUNTY, TEXAS

REVISION	W.L.D.
CHECKED	
DRAWN	G.C.W.
SCALE	1"=20' N II
DATE	JUNE 16, 2015
PROJECT	15011
	8 OF 8

THE SEAL APPEARING ON THIS DOCUMENT WAS AUTHORIZED BY W.L. DOUPHRATE II, TEXAS P.E. NO. 60102, F-886, ON DATE: JUNE 16, 2015

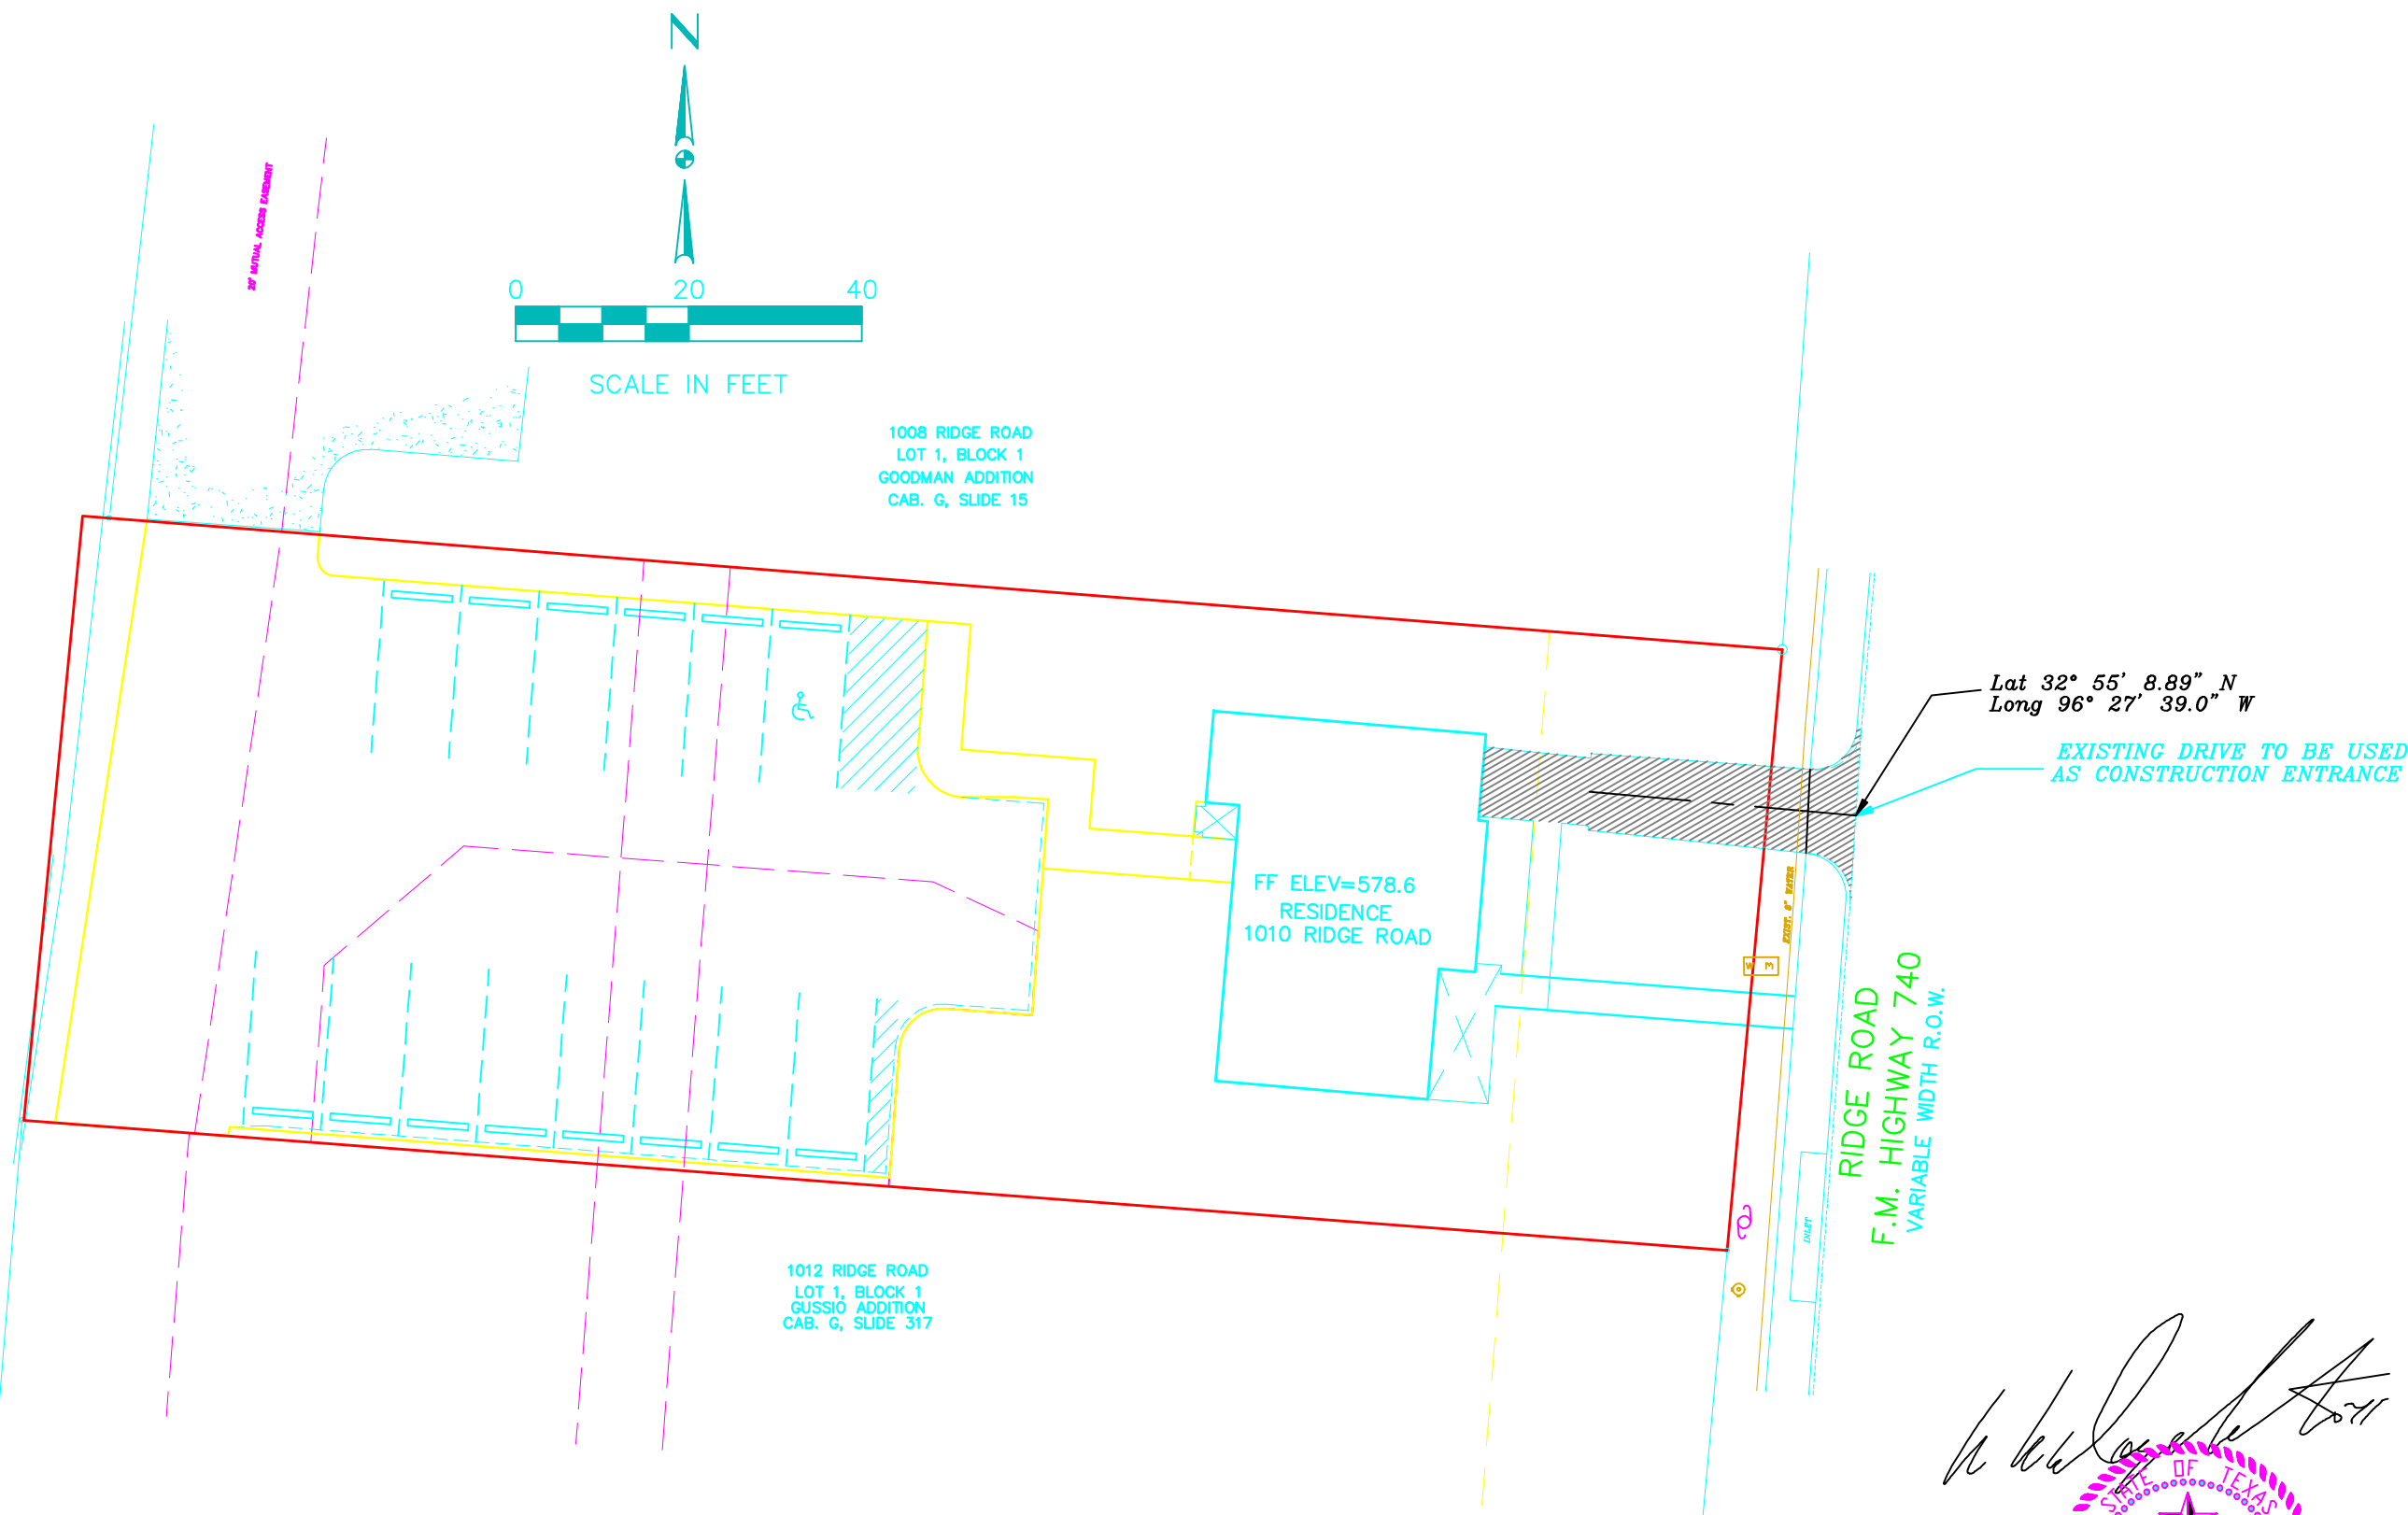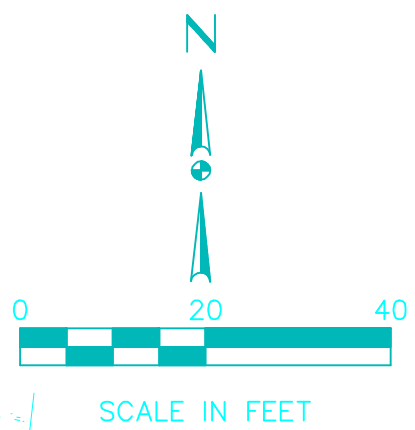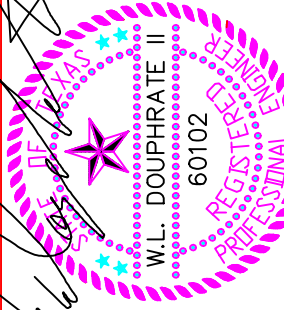



THE SEAL APPEARING ON THIS DOCUMENT WAS AUTHORIZED BY W.L. DOUPHRATE II, TEXAS P.E. NO. 60102, F-886, ON JULY 16, 2015.



HIGHWAY PERMIT
TEMPORARY CONSTRUCTION ENTRANCE
1010 RIDGE ROAD
CITY OF ROCKWALL
ROCKWALL COUNTY, TEXAS

DOUPHRATE & ASSOCIATES, INC.
ENGINEERING • PROJECT MANAGEMENT • SURVEYING
2235 RIDGE RD # 200
ROCKWALL, TEXAS 75087
PHONE: (972)771-9004 FAX: (972)771-9005

DATE: 7-16-15
DRAWN: G.C.W.
CHECKED: W.L.D.
SCALE: 1" = 20'
JOB NO. 15011

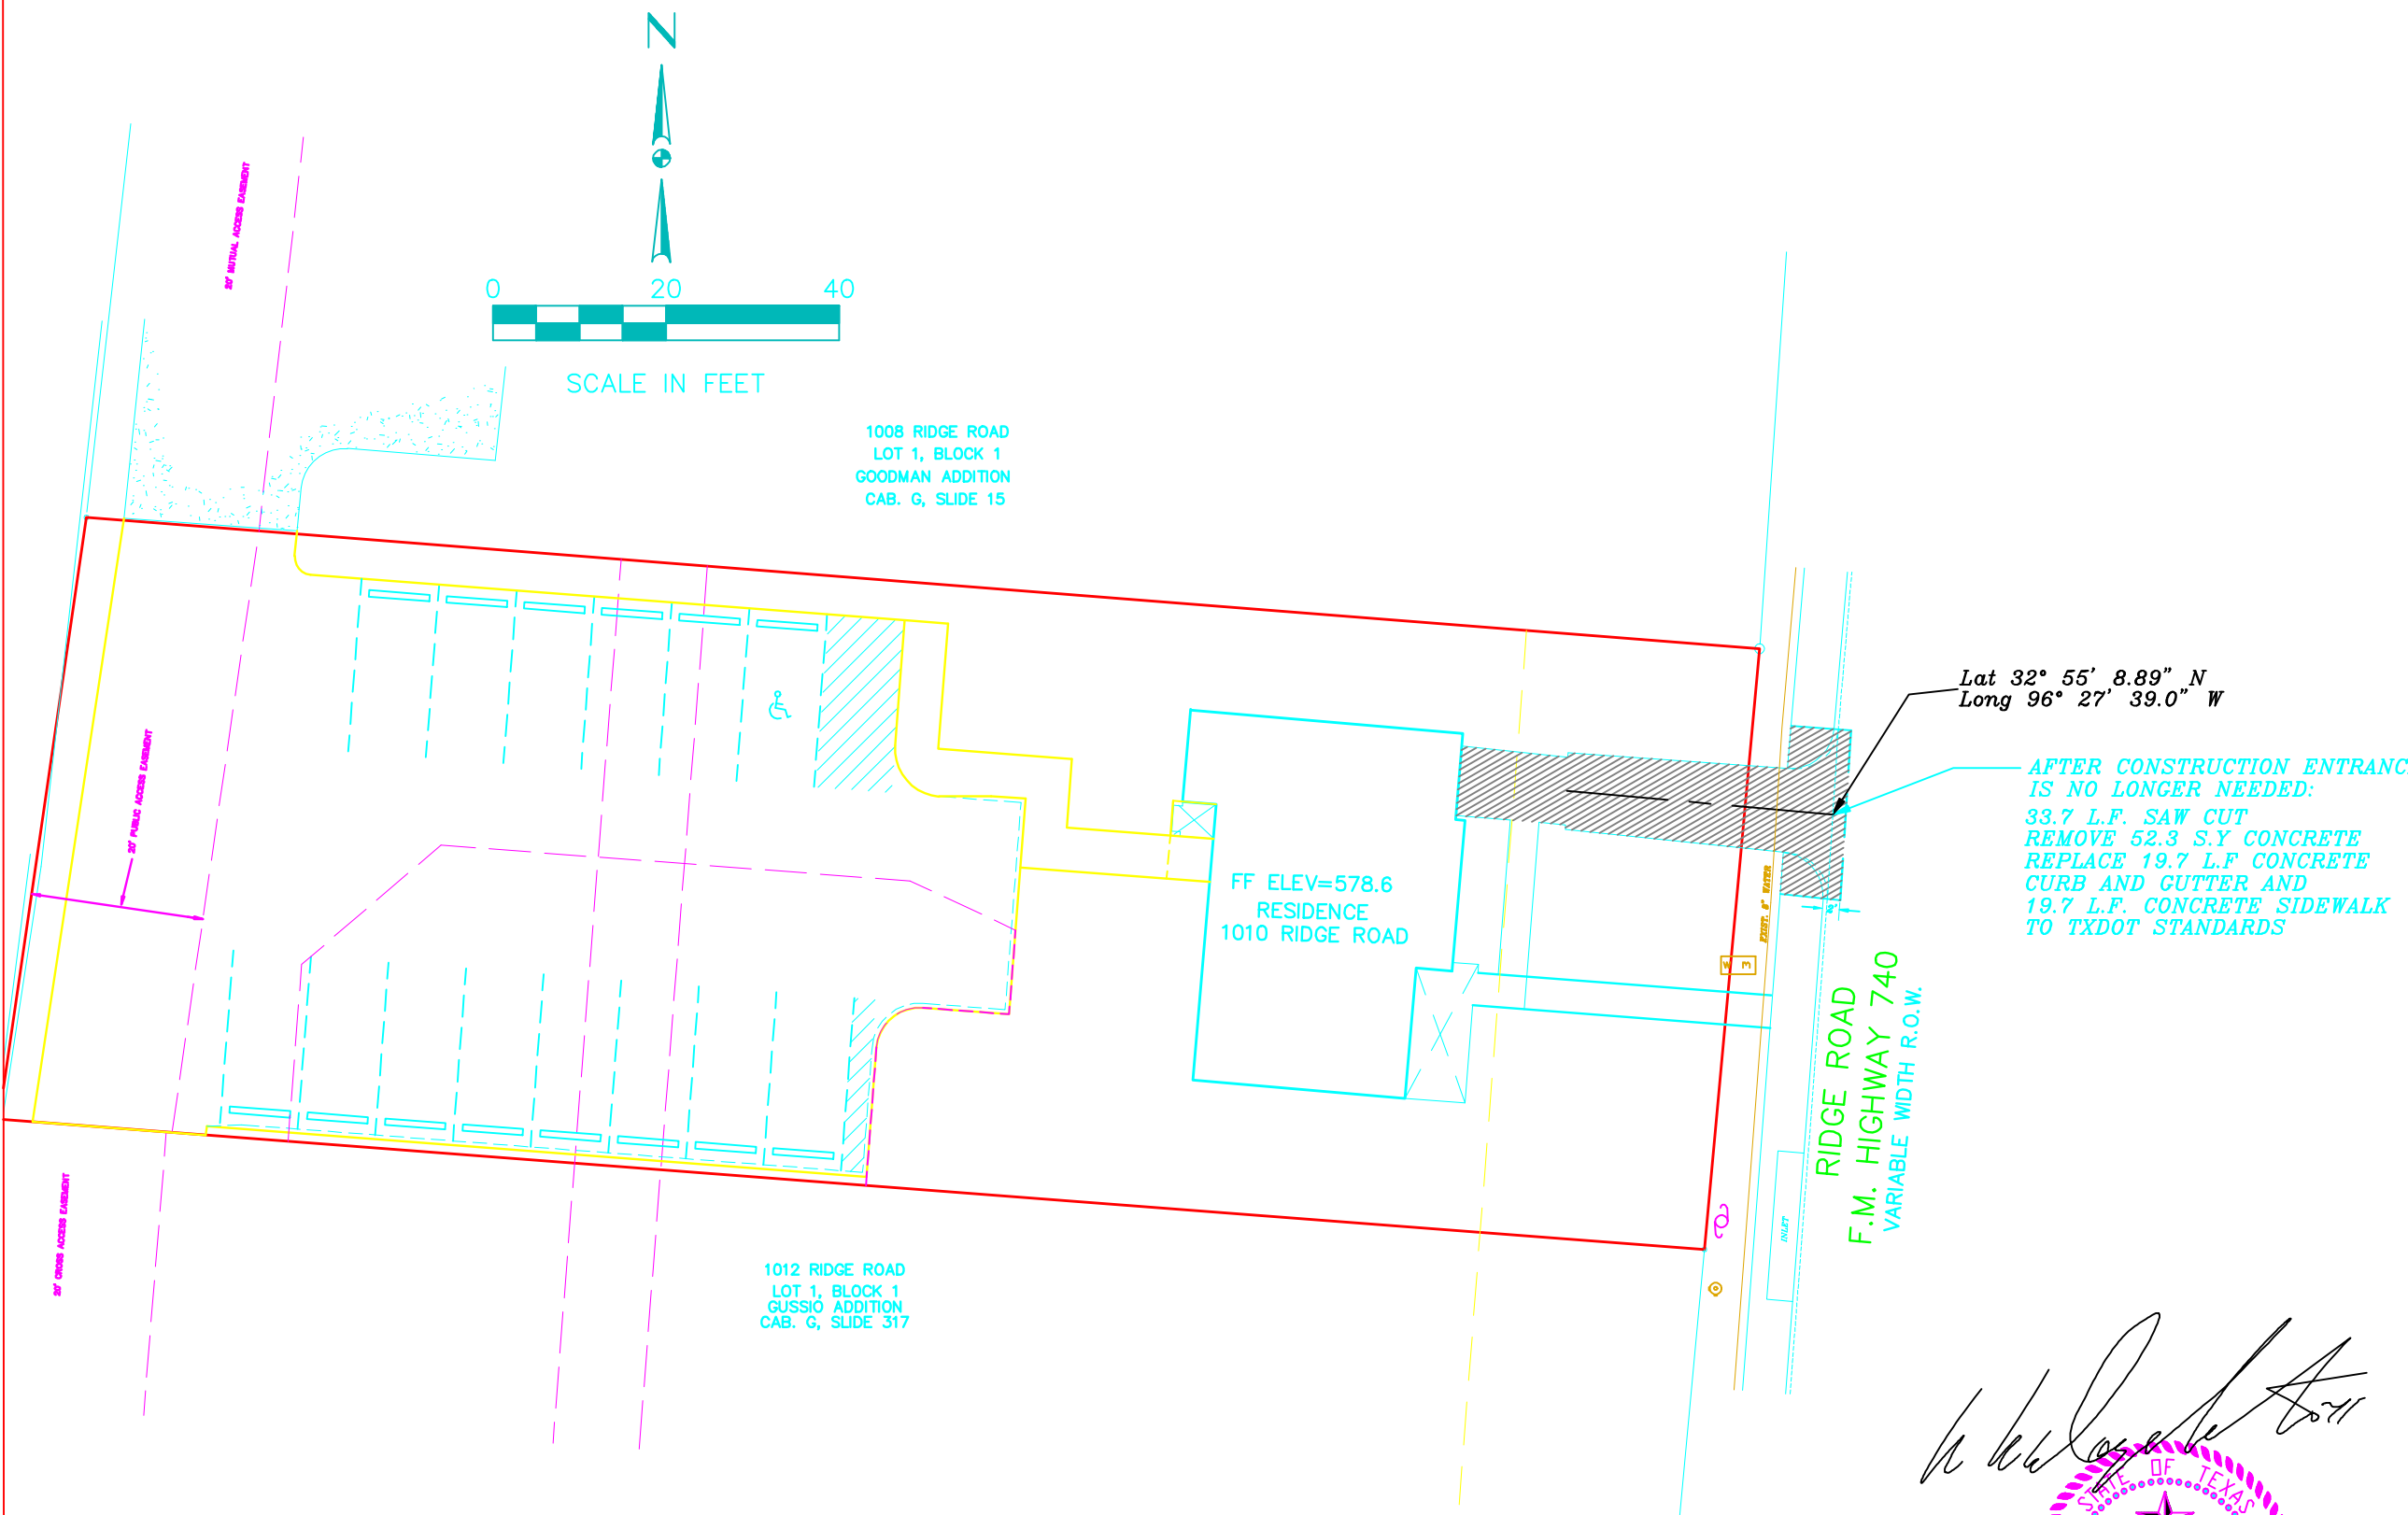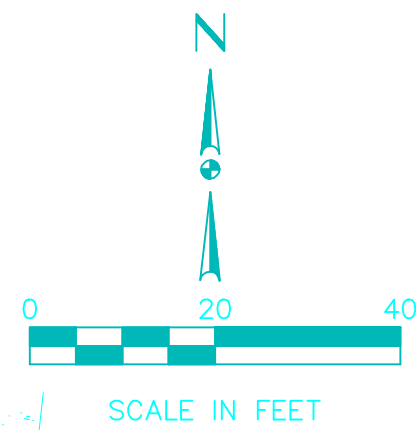

THE SEAL APPEARING ON THIS DOCUMENT WAS AUTHORIZED BY W.L. DOUPHRATE II, TEXAS P.E. NO. 60102, F-886, ON JULY 16, 2015.



HIGHWAY PERMIT
TURNOUT REMOVAL & REPLACEMENT
1010 RIDGE ROAD
CITY OF ROCKWALL
ROCKWALL COUNTY, TEXAS

DOUPHRATE & ASSOCIATES, INC.
ENGINEERING • PROJECT MANAGEMENT • SURVEYING
2235 RIDGE RD # 200
ROCKWALL, TEXAS 75087
PHONE: (972)771-9004 FAX: (972)771-9005

DATE: 7-16-15
DRAWN: G.C.W.
CHECKED: W.L.D.
SCALE: 1" = 20'
JOB NO. 15011