
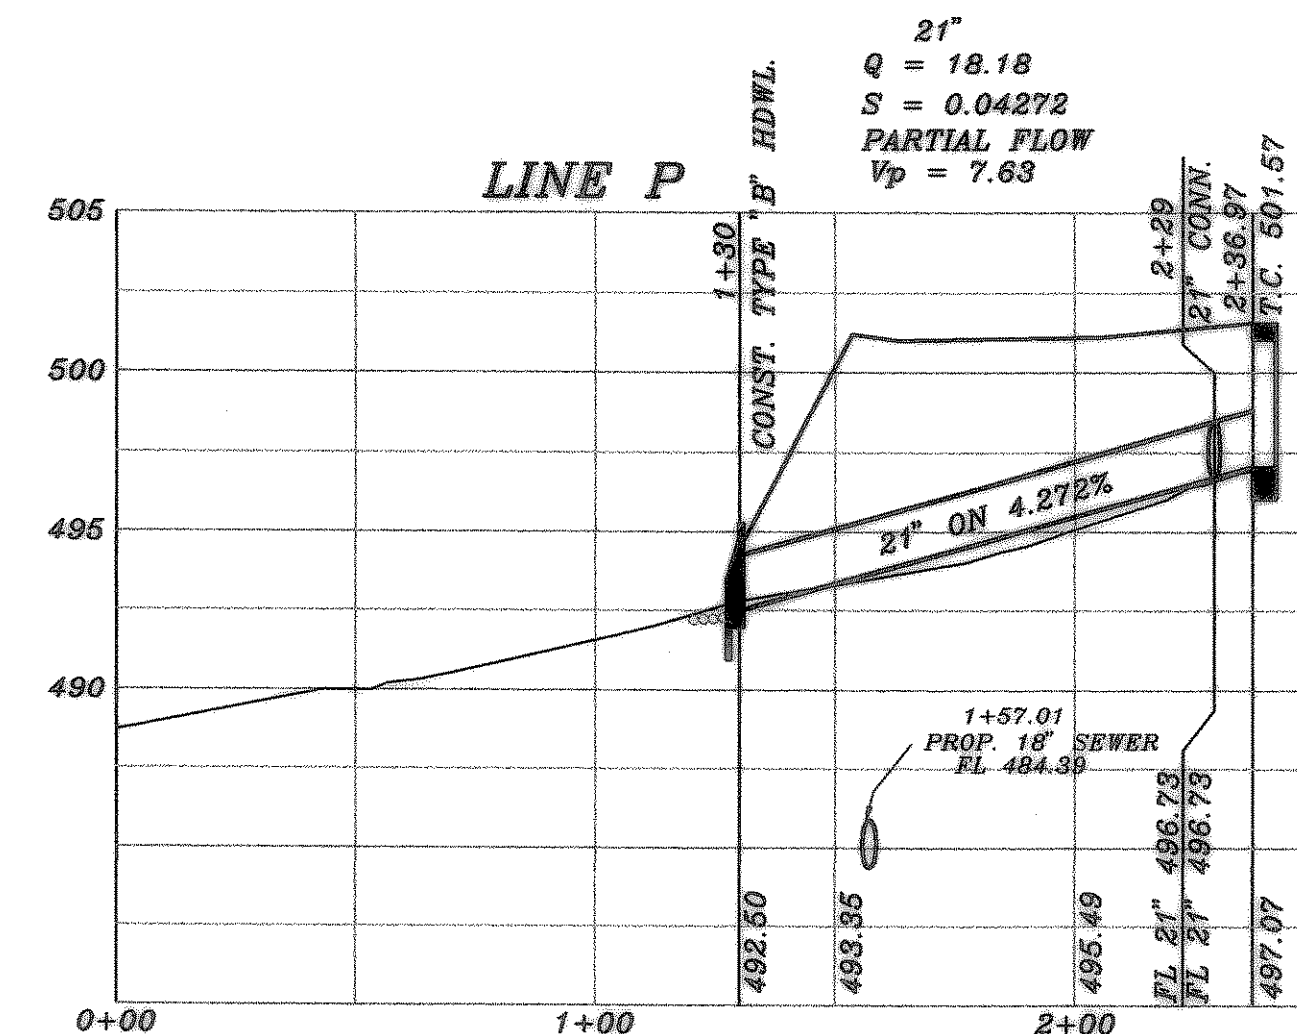


PHASE 2A

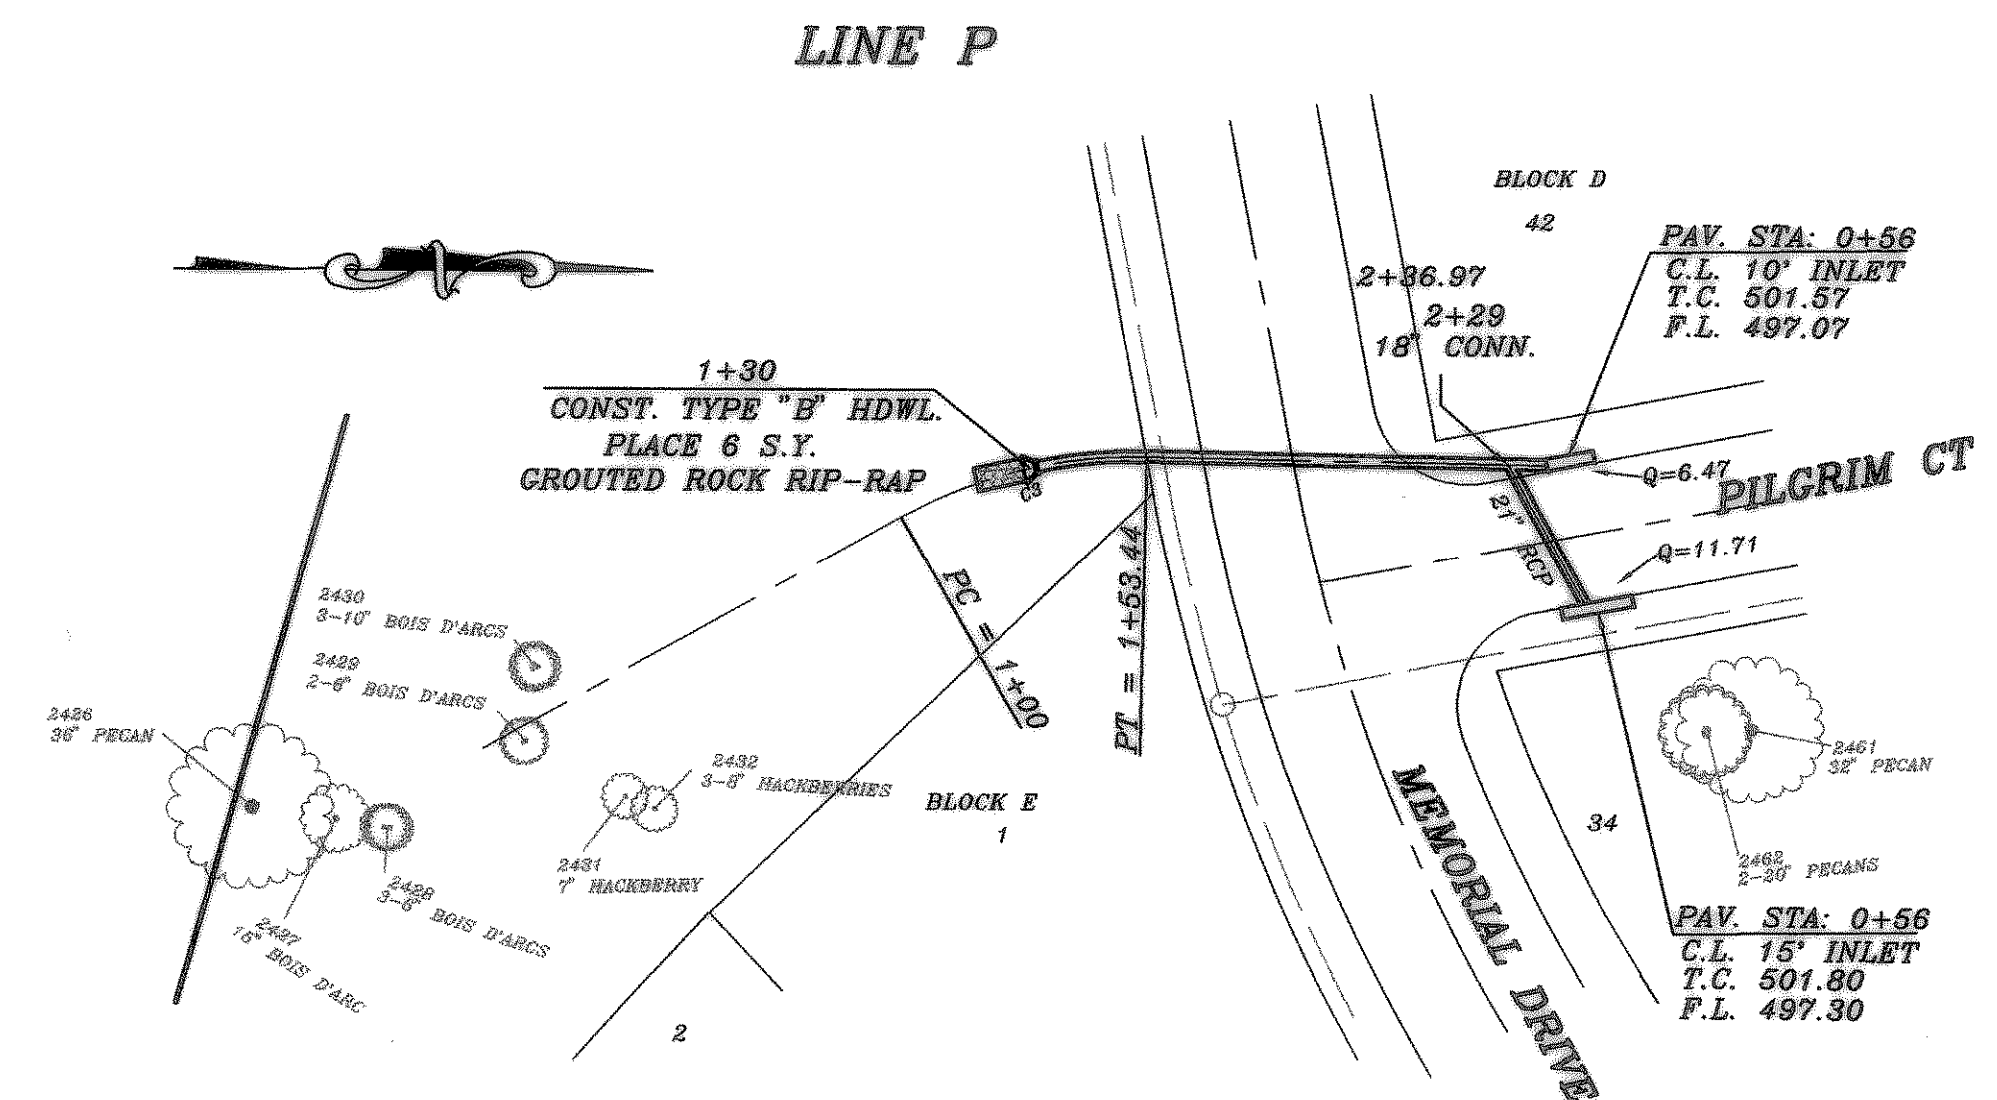

BENCH MARK
60D NAIL IN 18" PECAN TREE (TREE NO. 2114)
PAV. STA. 10+97 63.5' RT., AUDOBON LANE
ELEV.: 501.54

[Signature]

**PROPOSED DRAINAGE
LINE C AND P**

QUAIL RUN VALLEY NO. 2
CITY OF ROCKWALL

SHEET NO.
17
24
JOB NO.
0020