
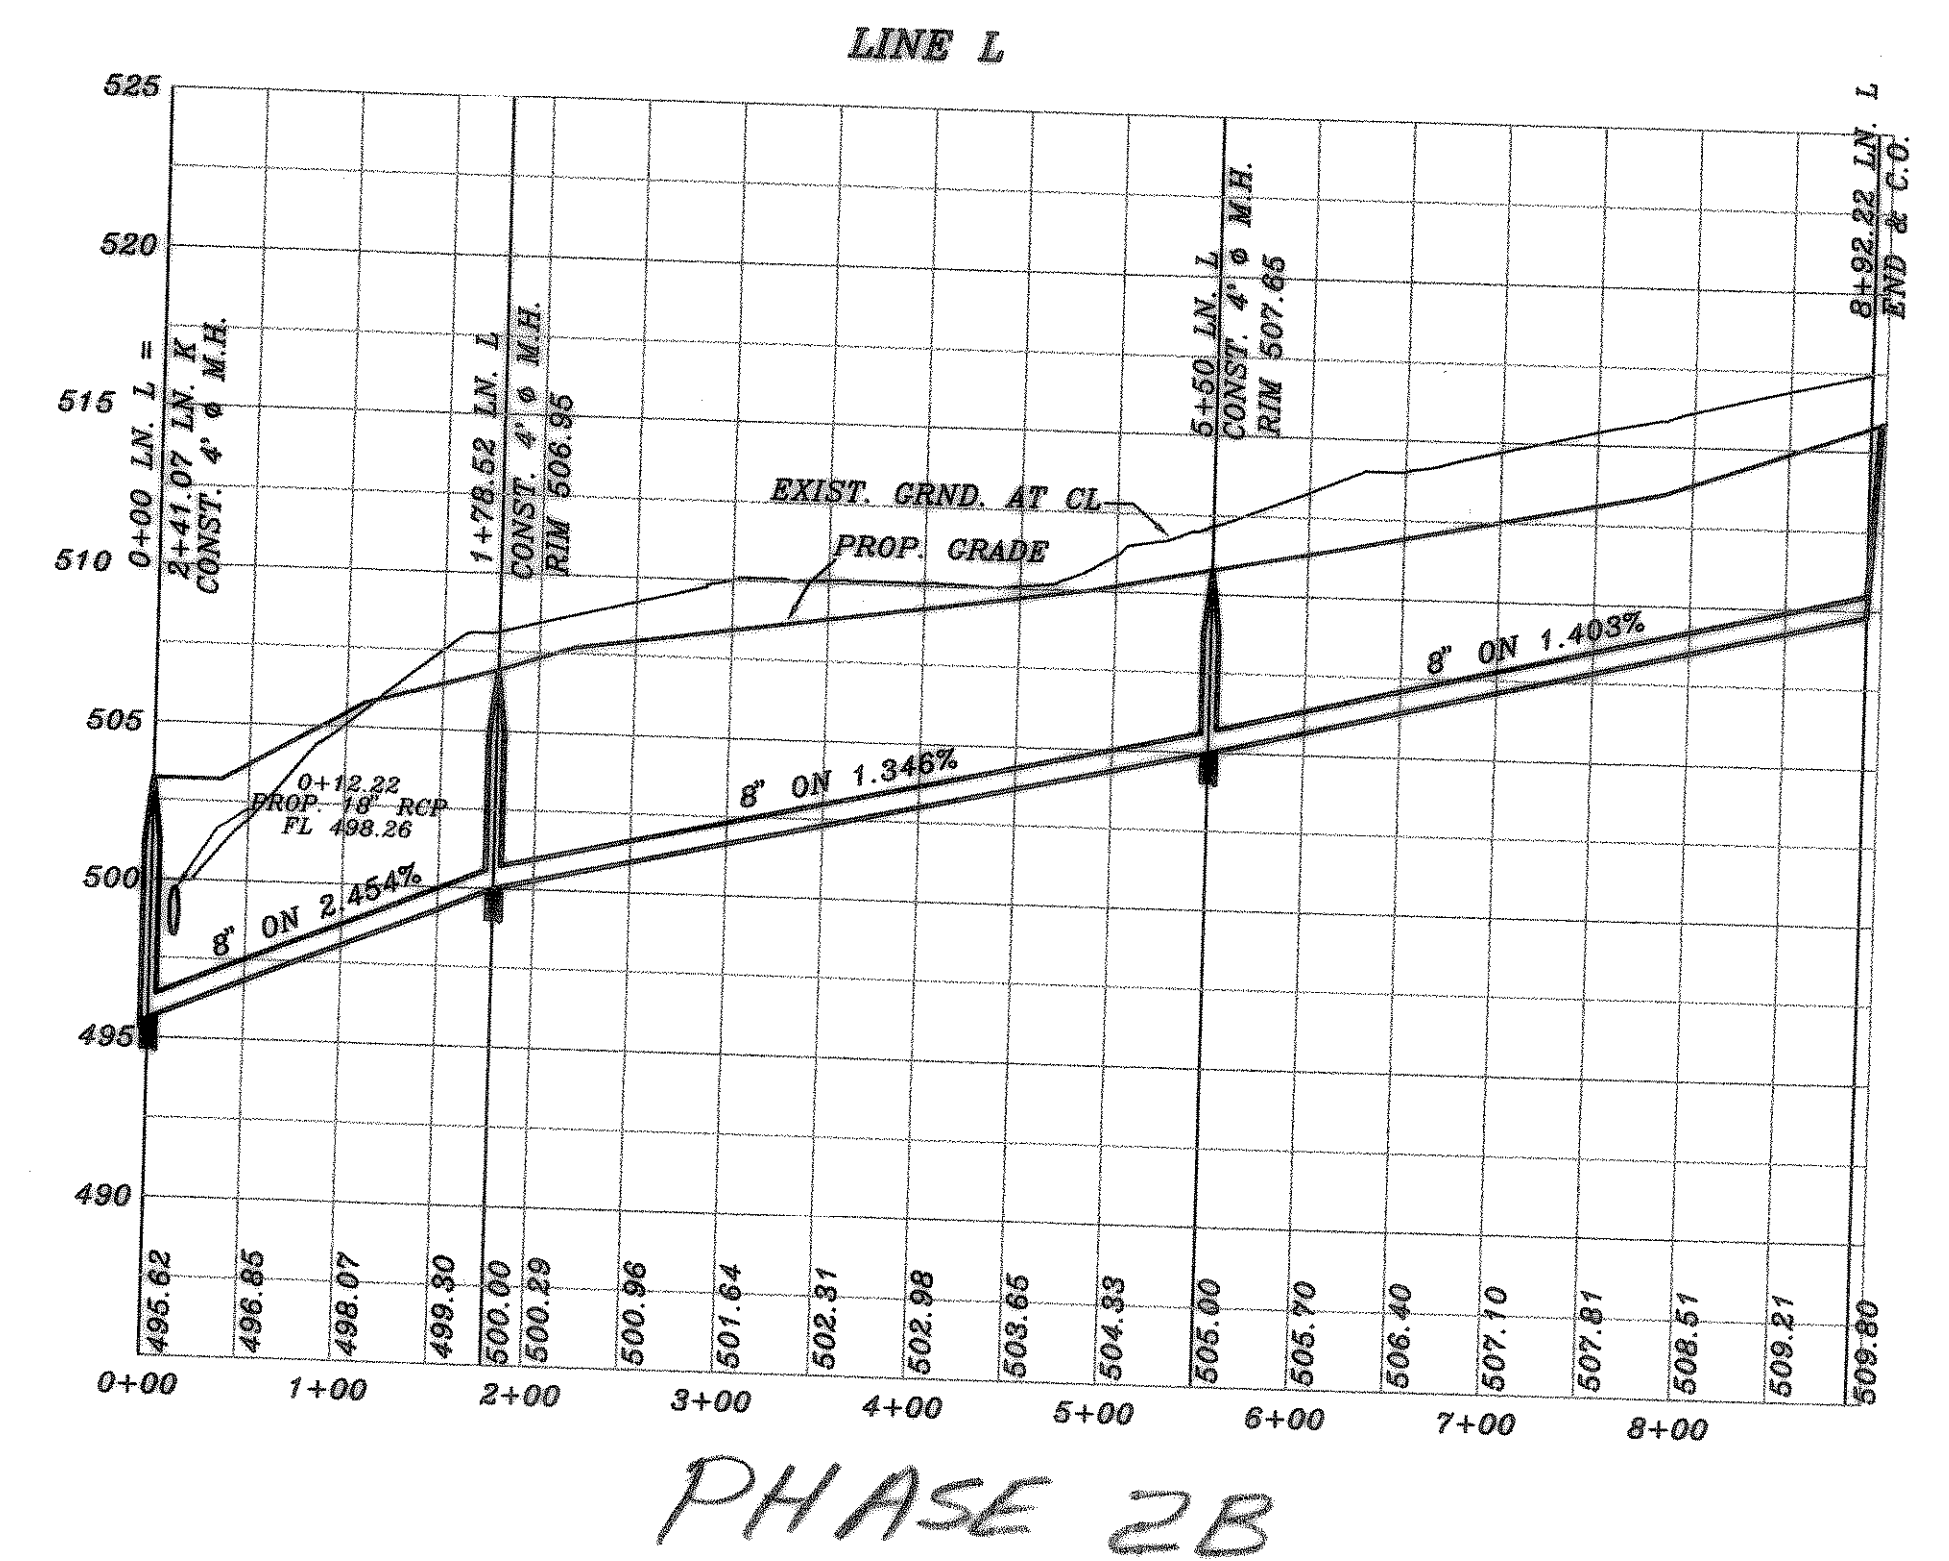
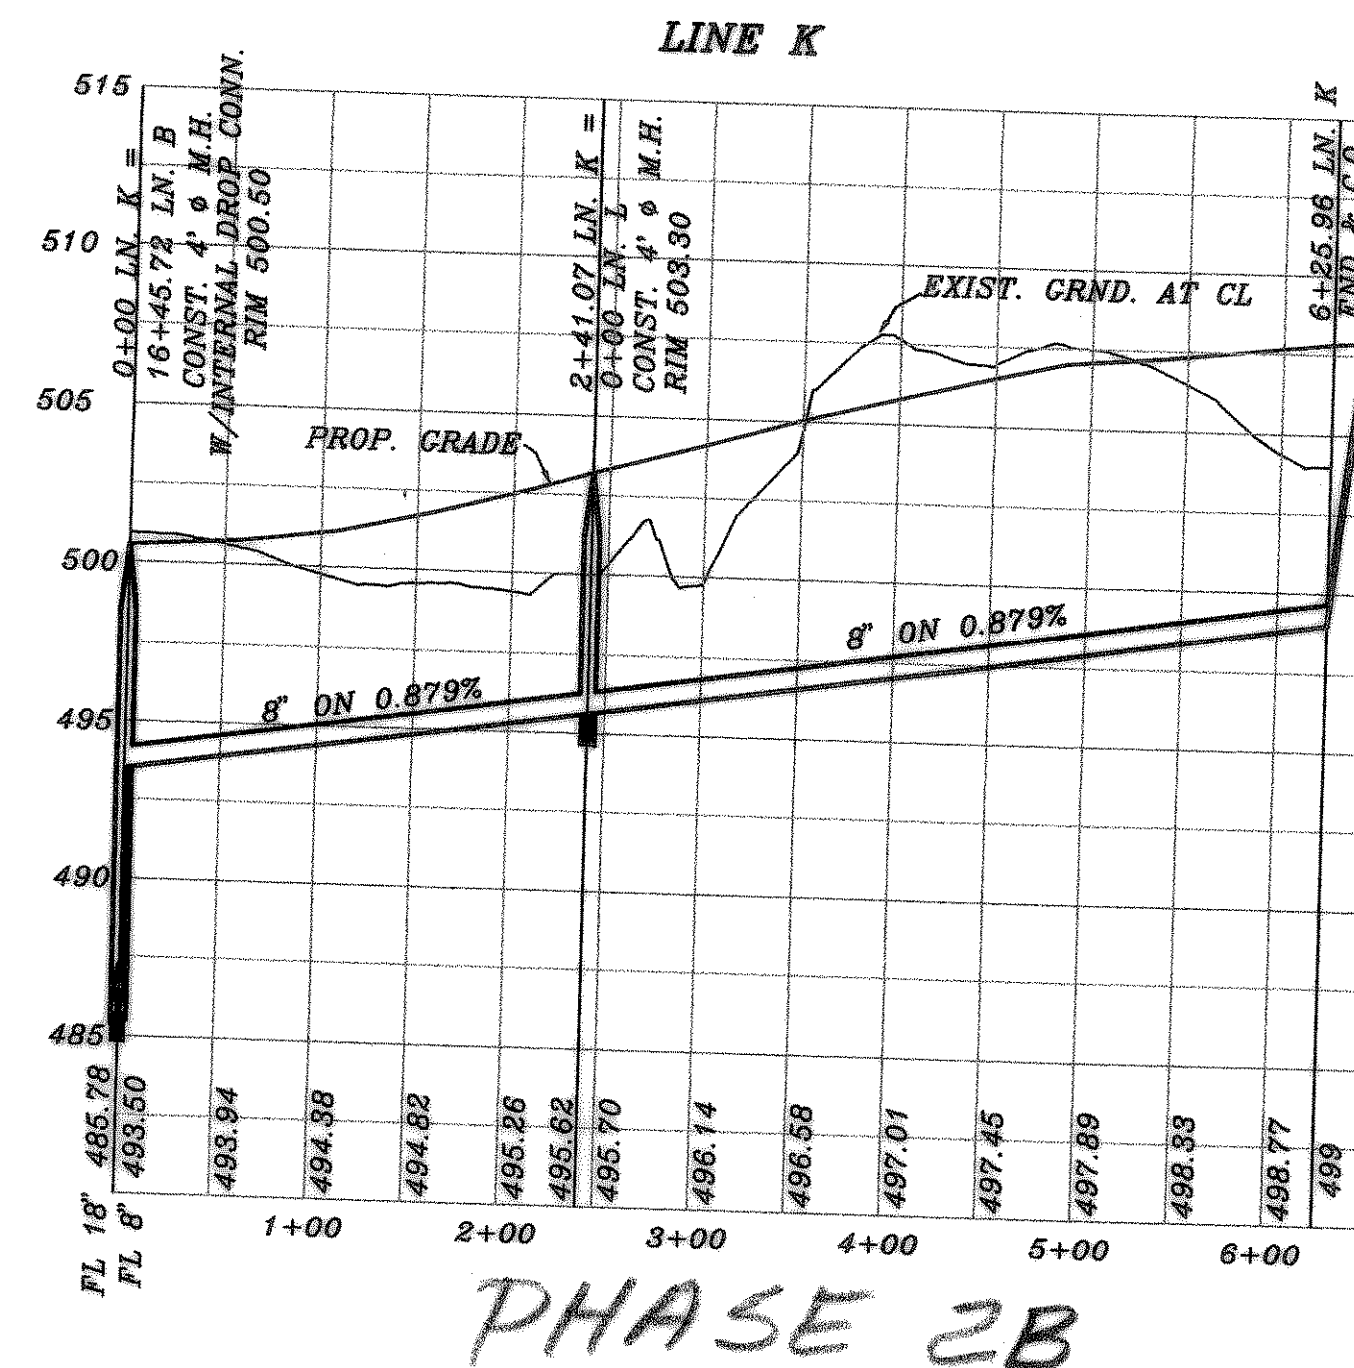
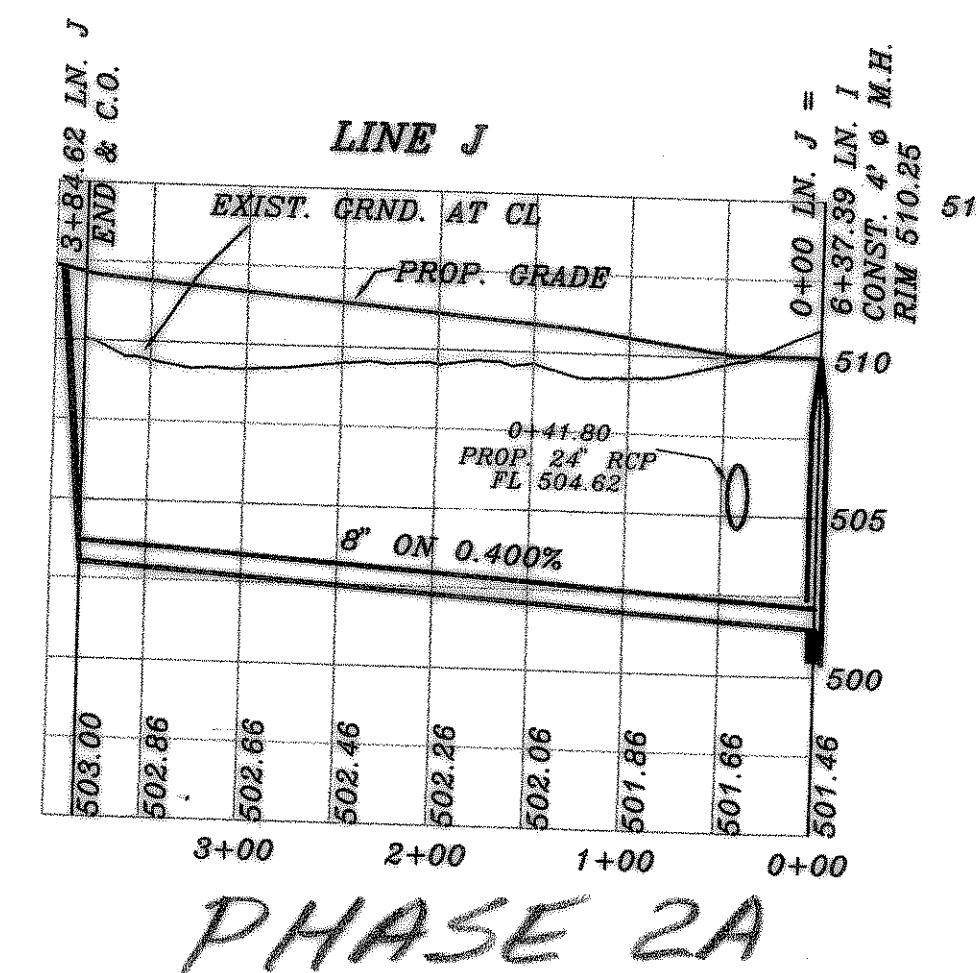
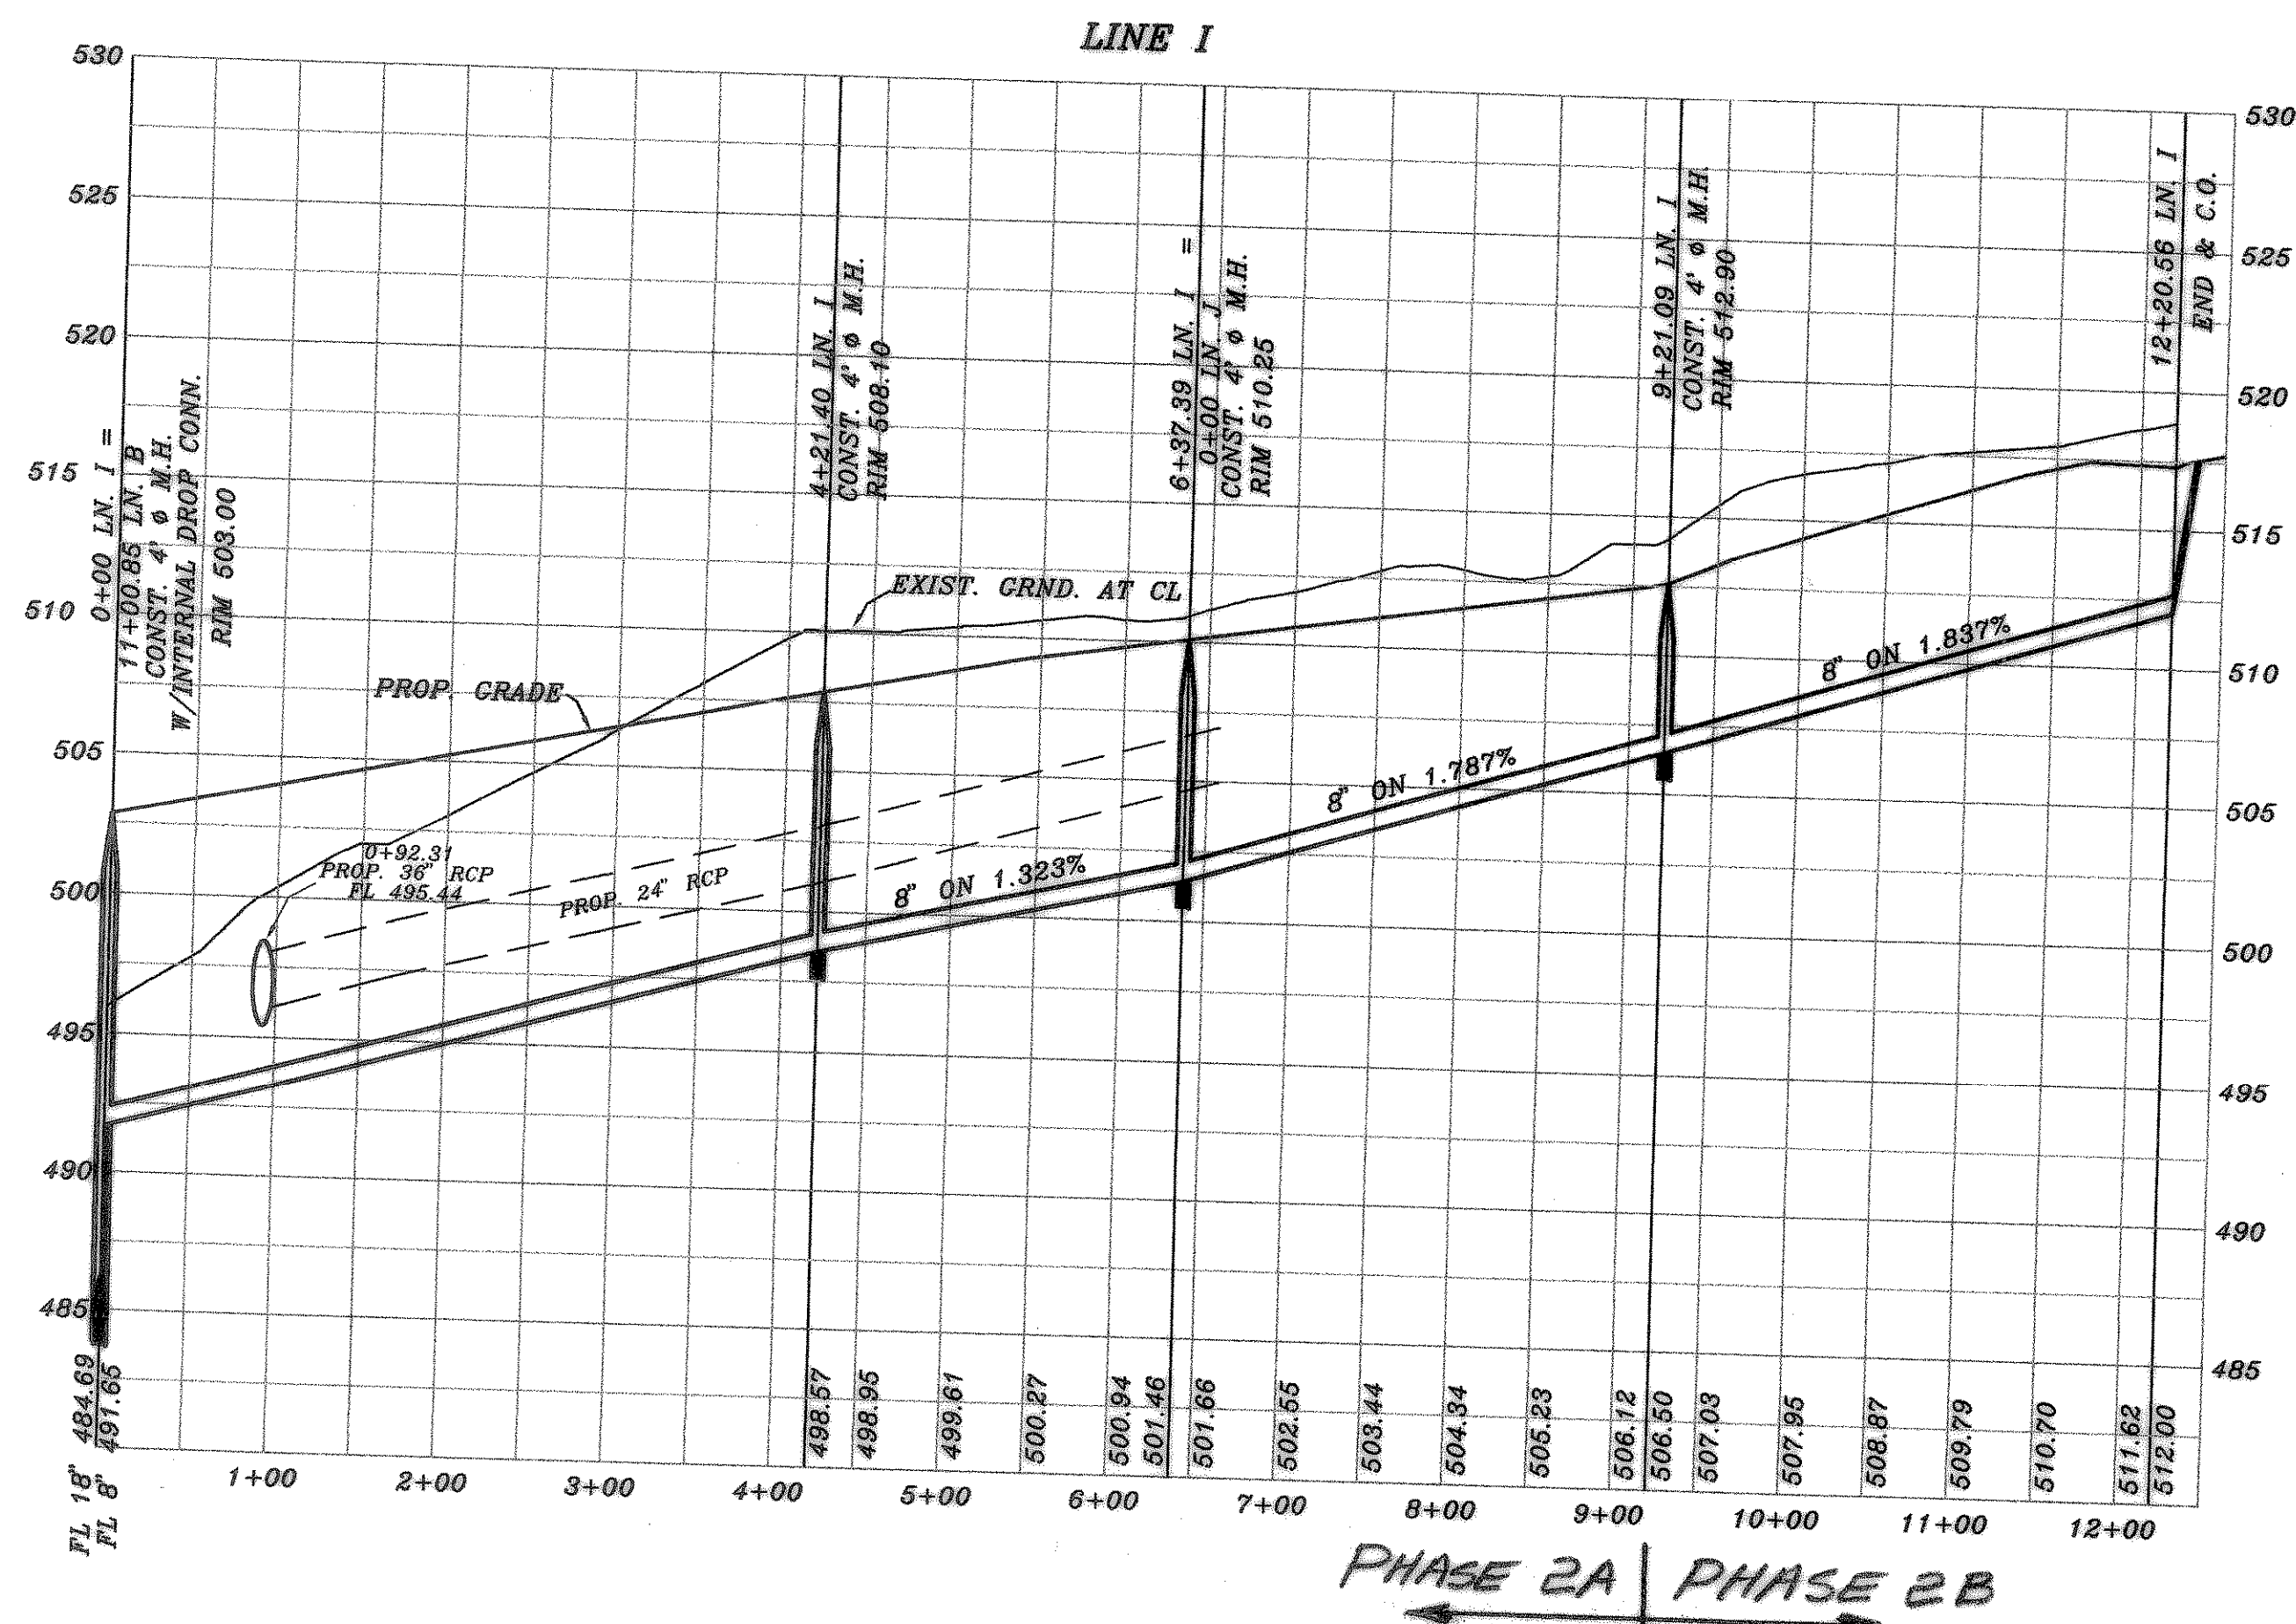
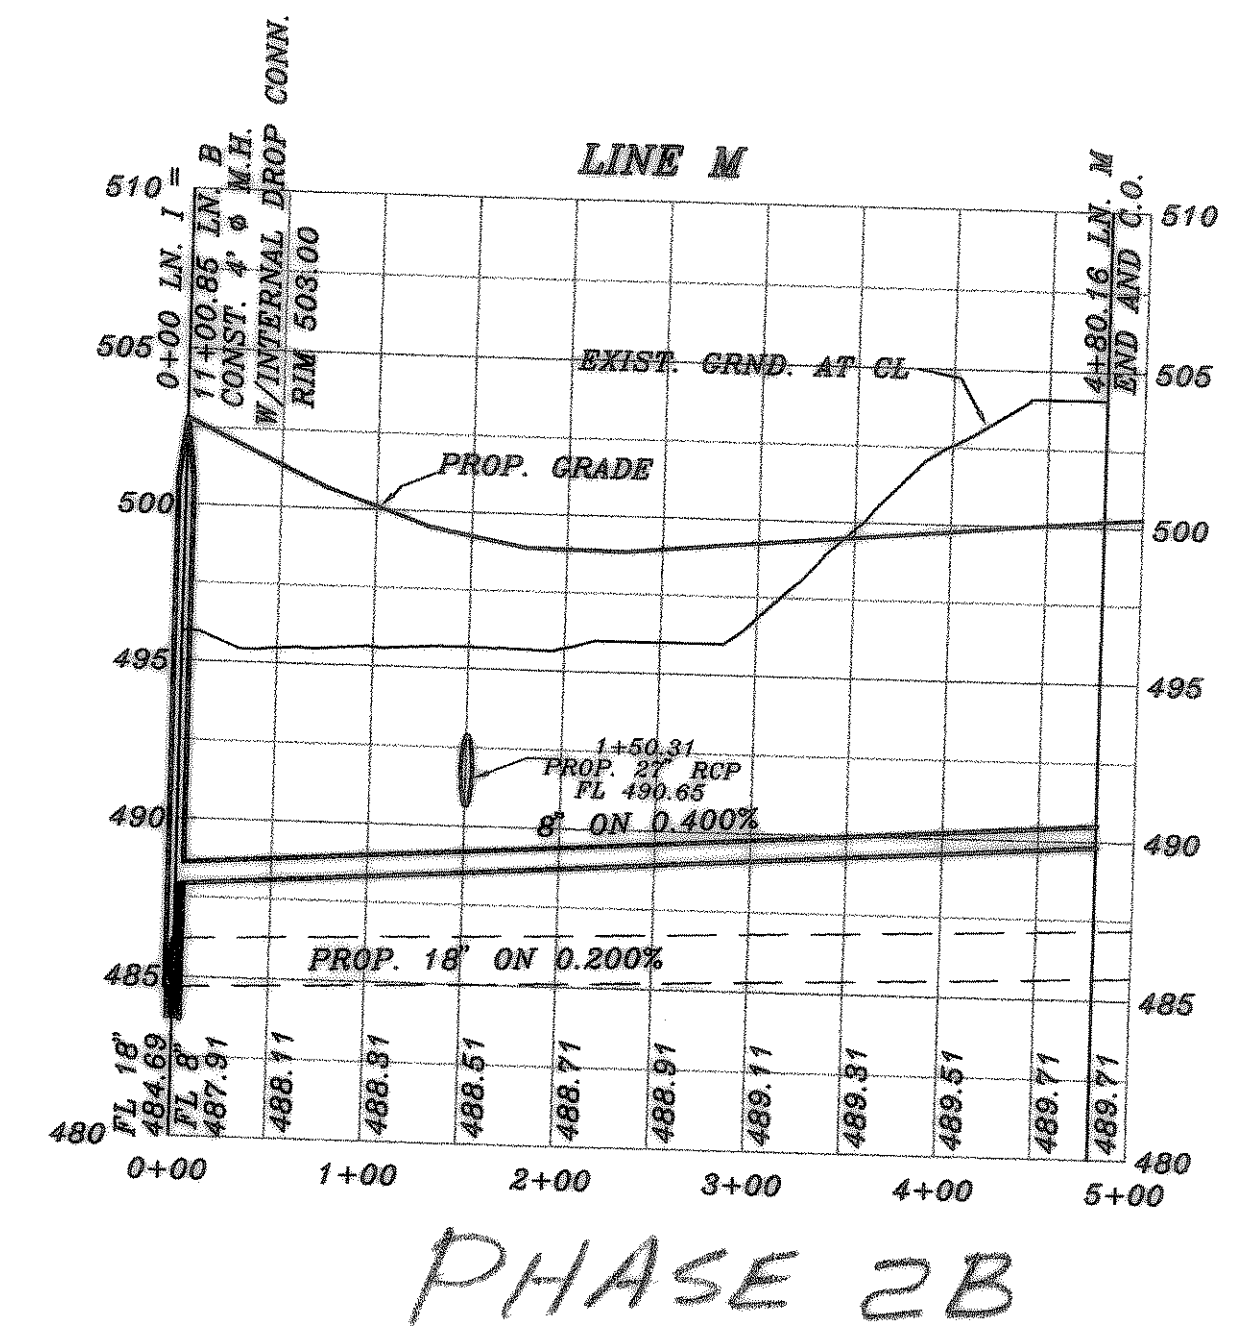
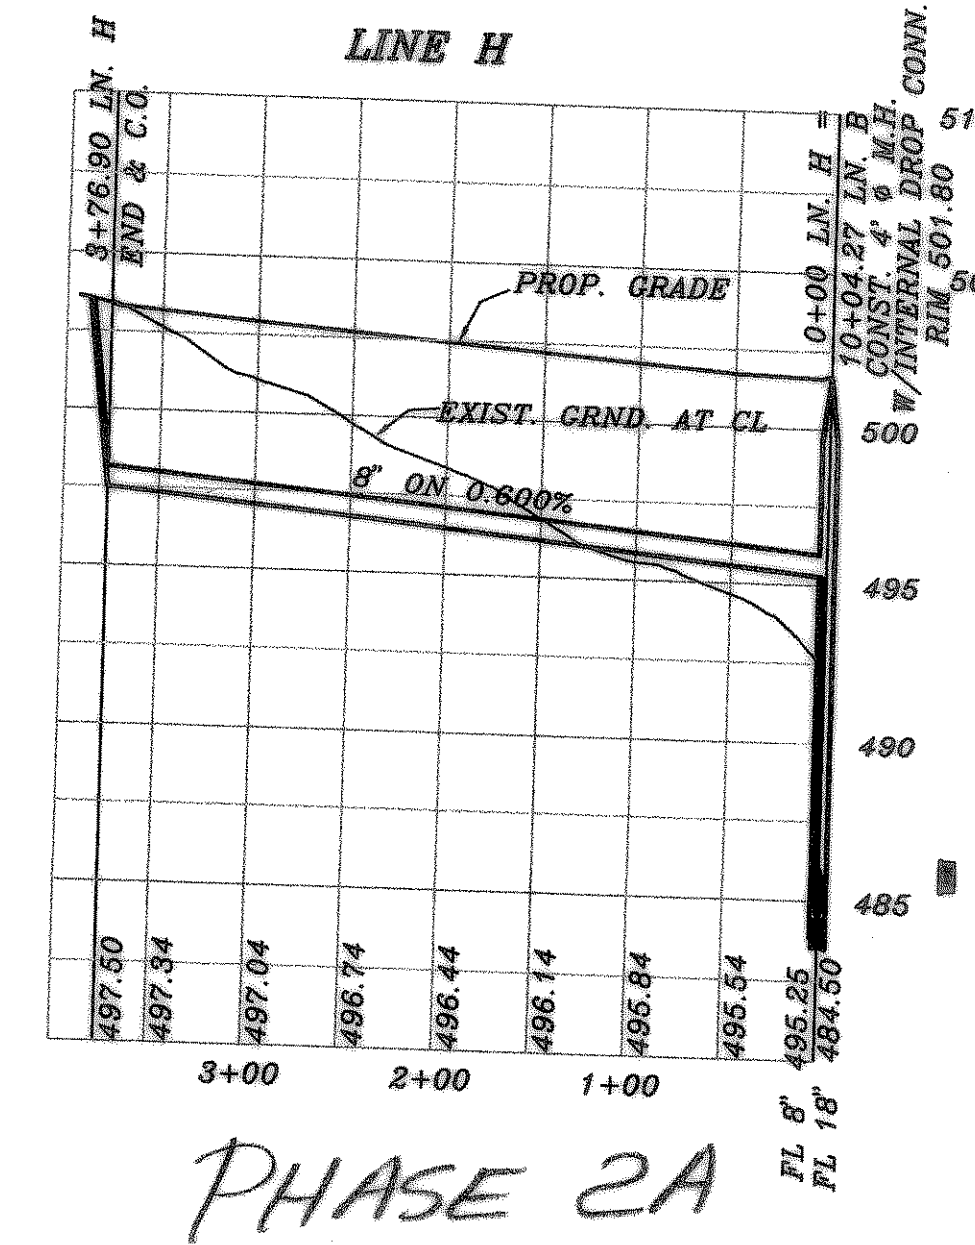


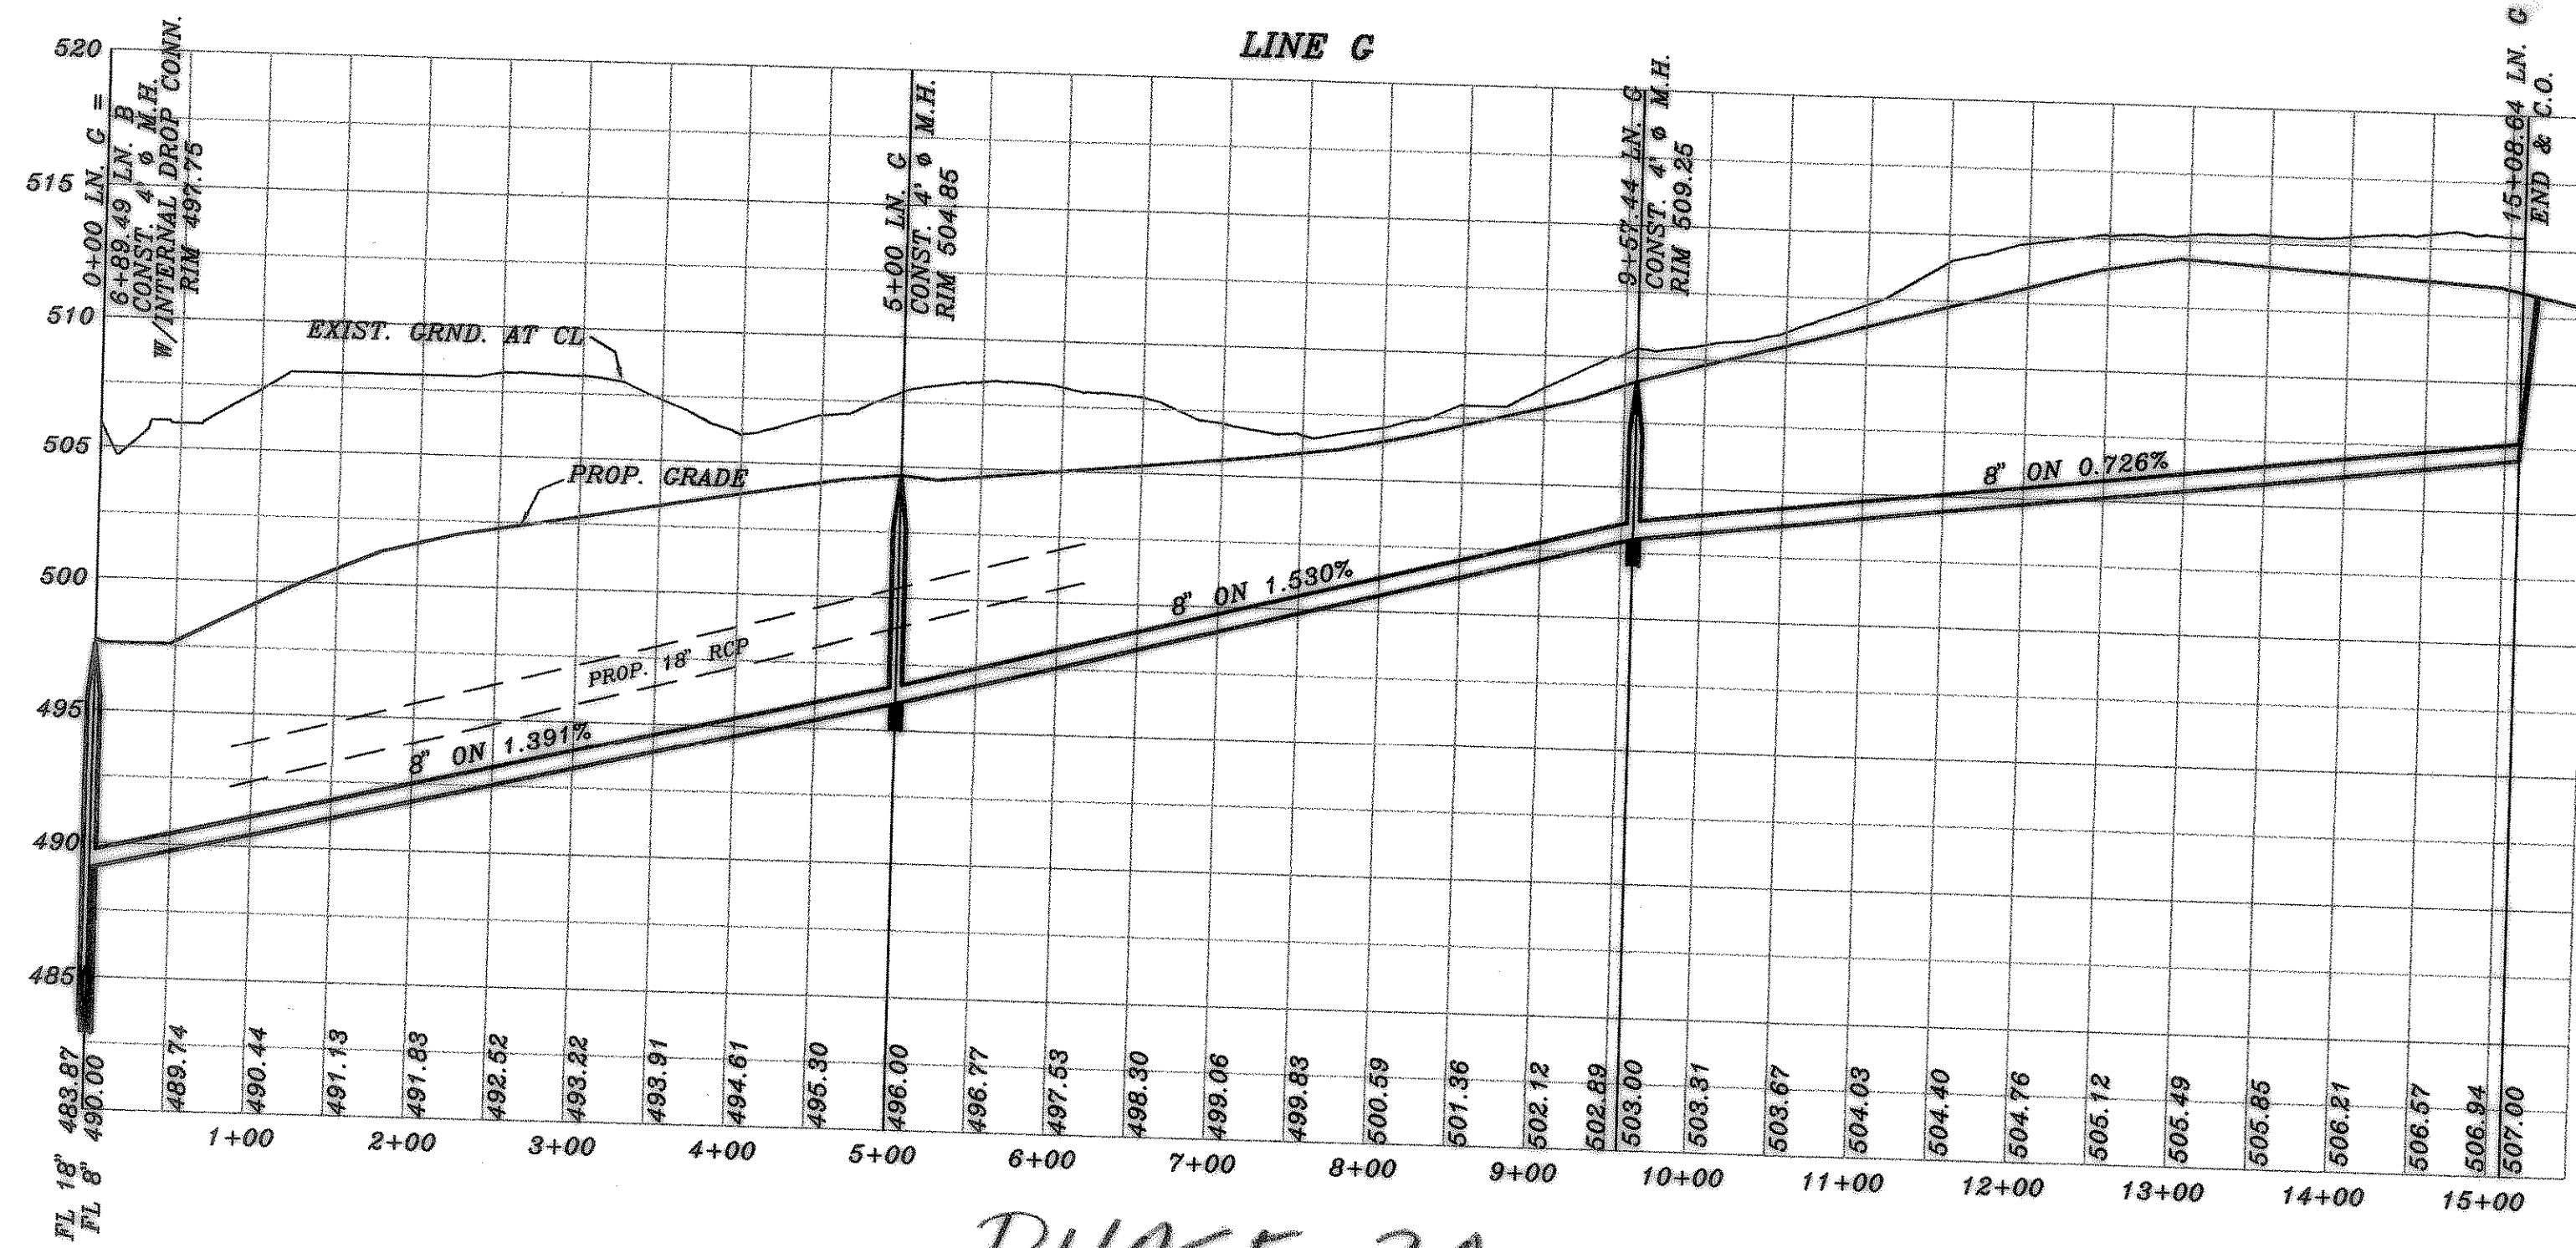

BENCH MARK
SQUARE CUT IN CONCRETE AT BASE OF
CONCRETE WALL AT S.E. CORNER OF
SOUTH APPROACH TO BRIDGE OVER
SQUABLE CREEK ON HWY. 205
ELEV.: 472.41


BENCH MARK
60D NAIL IN 36" PECAN TREE (TREE NO. 2302)
PAV. STA. 8+30, 71' RT., MEMORIAL DRIVE
ELEV.: 466.79

BENCH MARK
60D NAIL IN 34" PECAN TREE (TREE NO. 2314)
PAV. STA. 1+83, 138' RT., AUDOBON LANE
ELEV.: 480.88

BENCH MARK
60D NAIL IN 18" PECAN TREE (TREE NO. 2114)
PAV. STA. 10+97 63.5' RT., AUDOBON LANE
ELEV.: 501.54

Winkelmann & Associates, Inc. hereby states that this
plan, to the best of our knowledge is "As Built."
Modifications from the originally approved construction
documents have been made as per information provided by
the contractor. Winkelmann & Associates, Inc. does not
certify as to the correctness or quality of construction as no
field inspection was performed.

FE Madhavan
WINKELMANN & ASSOCIATES, INC.
DATE 9-27-02
PH 2A
DATE 9-14-04
PH 2B

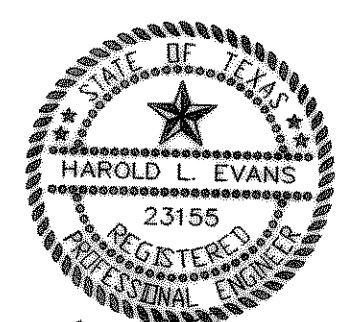

HAROLD L. EVANS CONSULTING ENGINEER P.O. BOX 28955 2331 GUS THOMASSON ROAD, SUITE 102 DALLAS, TEXAS 75228, (214) 328-8133		PROPOSED UTILITIES QUAIL RUN VALLEY NO. 2 CITY OF ROCKWALL		SHEET NO. 21 24 JOB NO. 0020
REV. PER 4th REVIEW REV. PER 3rd REVIEW REV. PER 2nd REVIEW	7/13/01 6/13/01 5/10/01	DATE SCALE DESIGN DRAWN	1" = 100' 1" = 6" H.L.E.	
REVISION DESCRIPTION 0020 PHASE 2 0020 R022				