
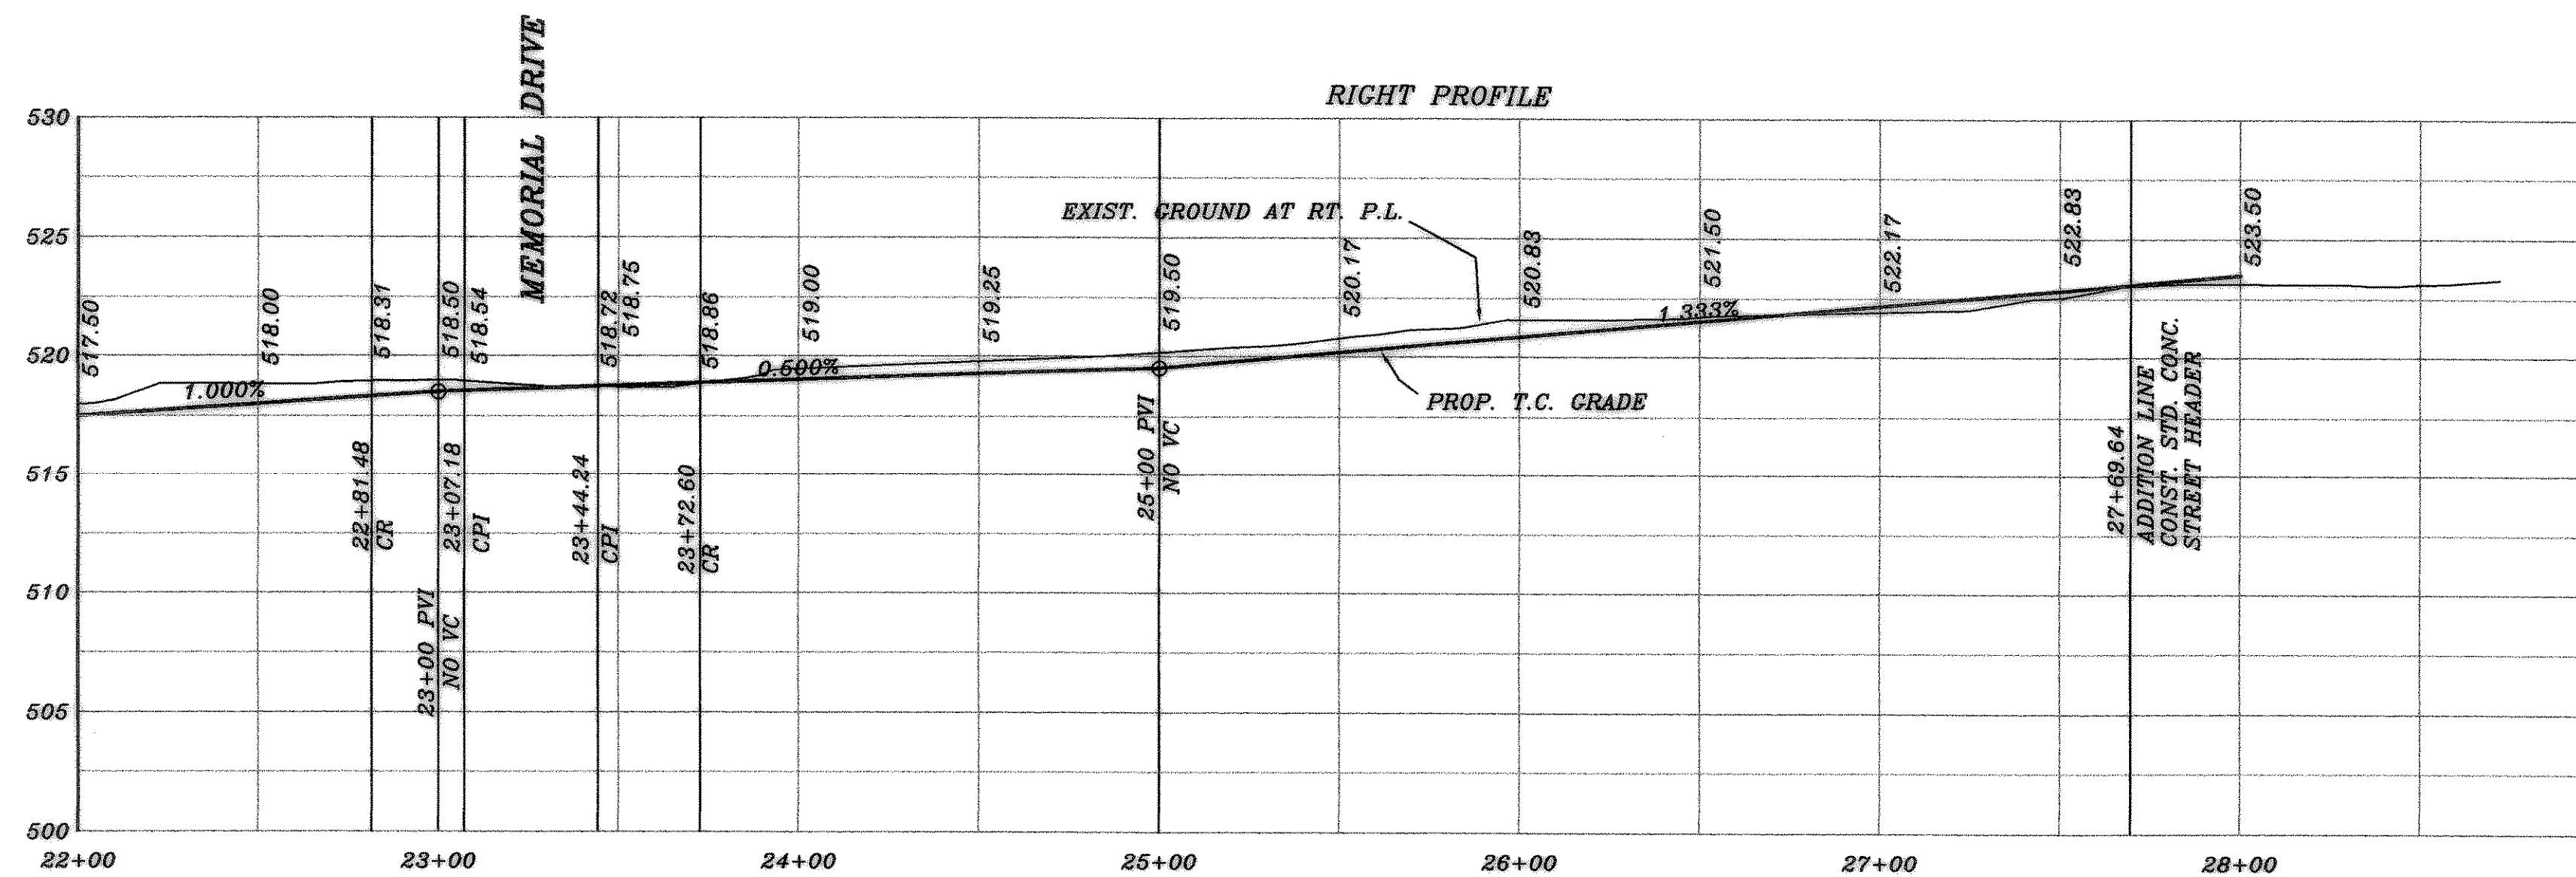
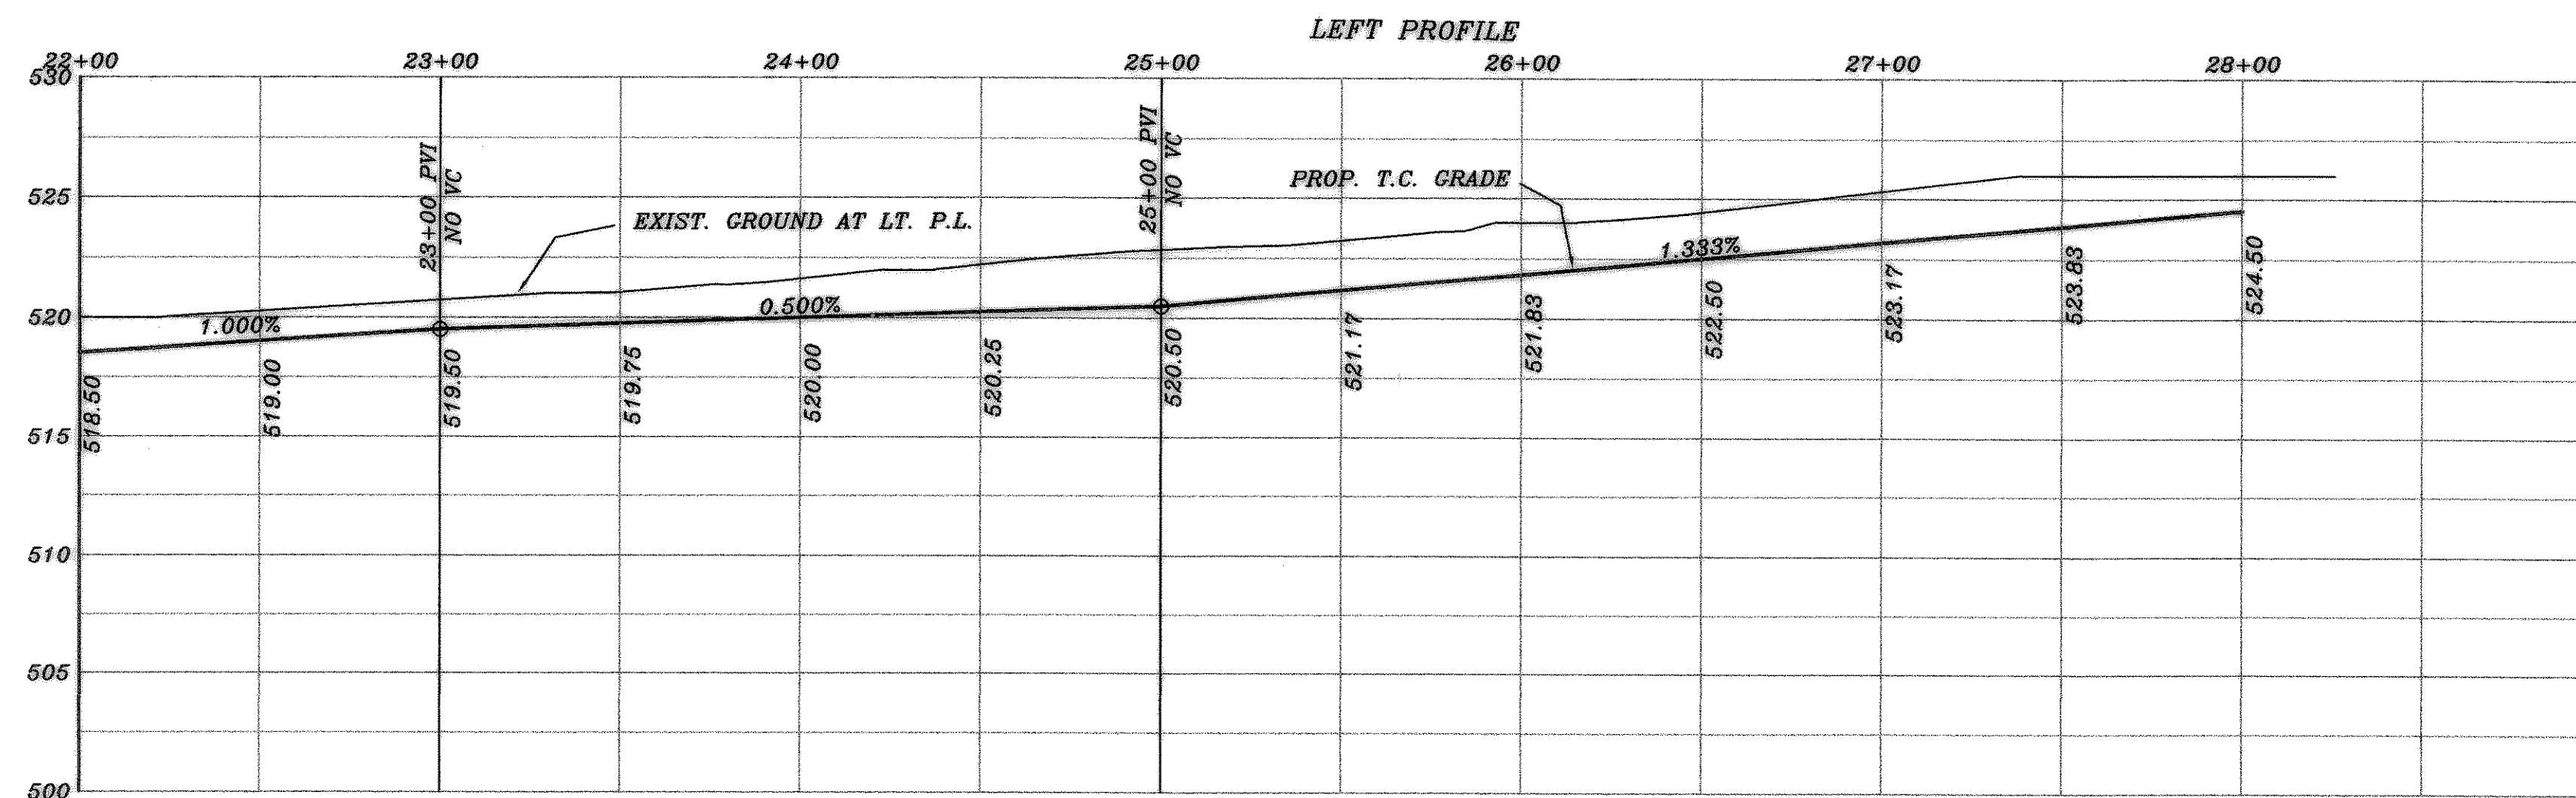


PHASE 2A

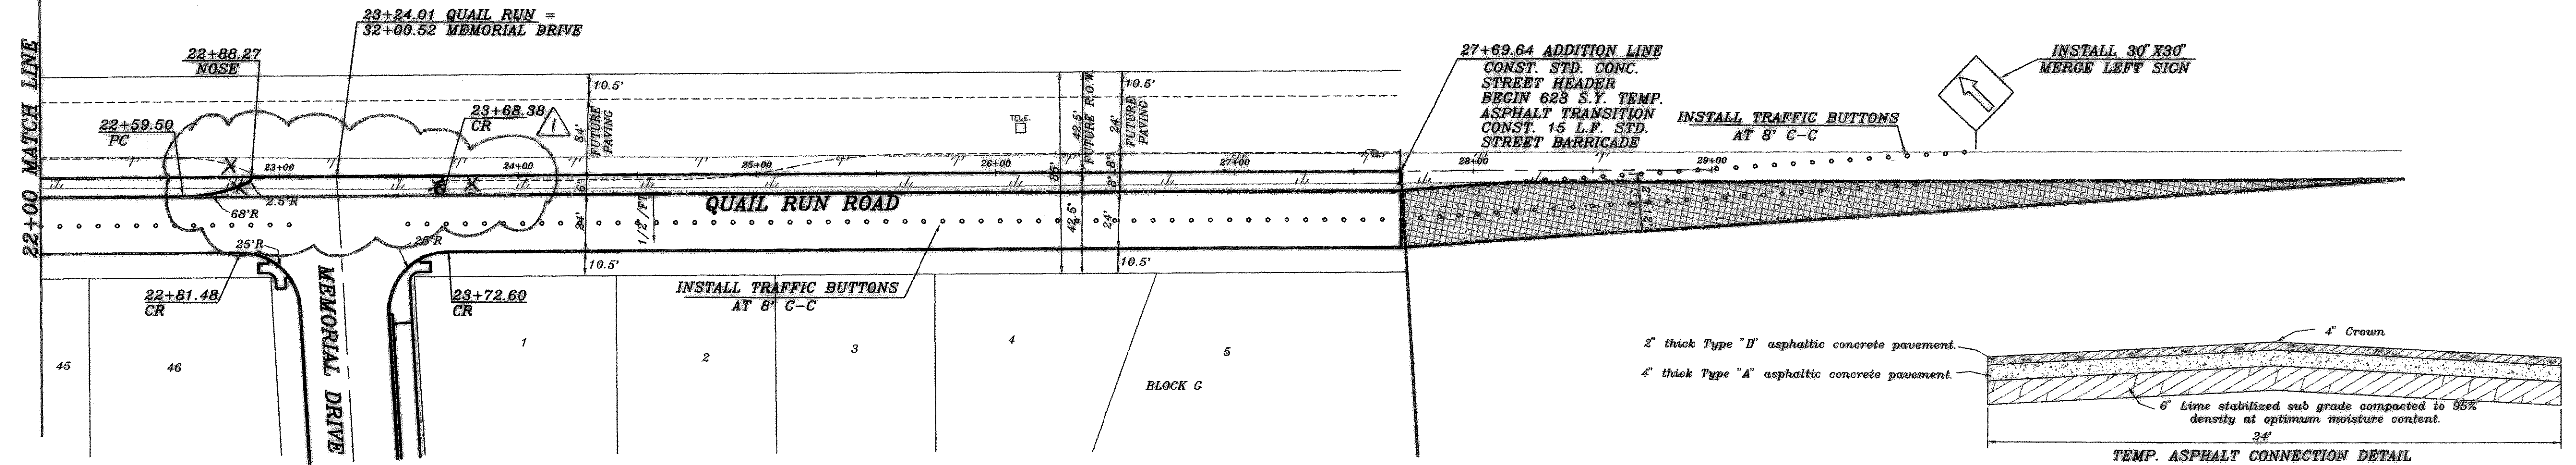

Winkelmann & Associates, Inc. hereby states that this plan, to the best of our knowledge is "As Built." Modifications from the originally approved construction documents have been made as per information provided by the contractor, Winkelmann & Associates, Inc. does not carry as to the correctness or quality of construction as no field inspection was performed.


Winkelmann & Associates, Inc. 9-27-02 Ph2A
9-14-04 Ph2B

BENCH MARK
SQUARE CUT IN CONCRETE AT BASE OF
CONCRETE WALL AT S.W. CORNER OF
SOUTH APPROACH TO BRIDGE OVER
SQUABBLE CREEK ON HWY. 205
ELEV.: 472.41

BENCH MARK
60D NAIL IN 36" PECAN TREE (TREE NO. 2314)
P.V. STA. 1+83.138 RT., AUDUBON LANE
ELEV.: 480.88

BENCH MARK
60D NAIL IN 36" PECAN TREE (TREE NO. 2302)
P.V. STA. 8+30.71 RT., MEMORIAL DRIVE
ELEV.: 466.79

BENCH MARK
60D NAIL IN 18" PECAN TREE (TREE NO. 2114)
P.V. STA. 10+97.63.5 RT., AUDUBON LANE
ELEV.: 501.54

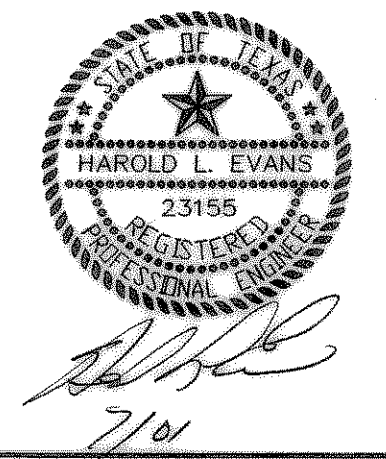

REVISION DESCRIPTION 0020 PHASE 2A	DATE SCALE DESIGN DRAWN	PROPOSED PAVING QUAIL RUN ROAD QUAIL RUN VALLEY NO. 2 CITY OF ROCKWALL	SHEET NO. 13 24 JOB NO. 0020
--	---	--	---