



CURVE	RADIUS	LENGTH	TANGENT	CHORD	BEARING	DELTA
C1	350.00'	56.20'	28.16'	56.14'	S01°08'43" W	091°11'59"
C2	350.00'	56.20'	28.16'	56.14'	N01°08'43" E	091°11'59"

CITY OF ROCKWALL
SURVEY MONUMENT
N 7034644.5993
E 2595678.1121
ELEV. 510.81

PHASE 2A

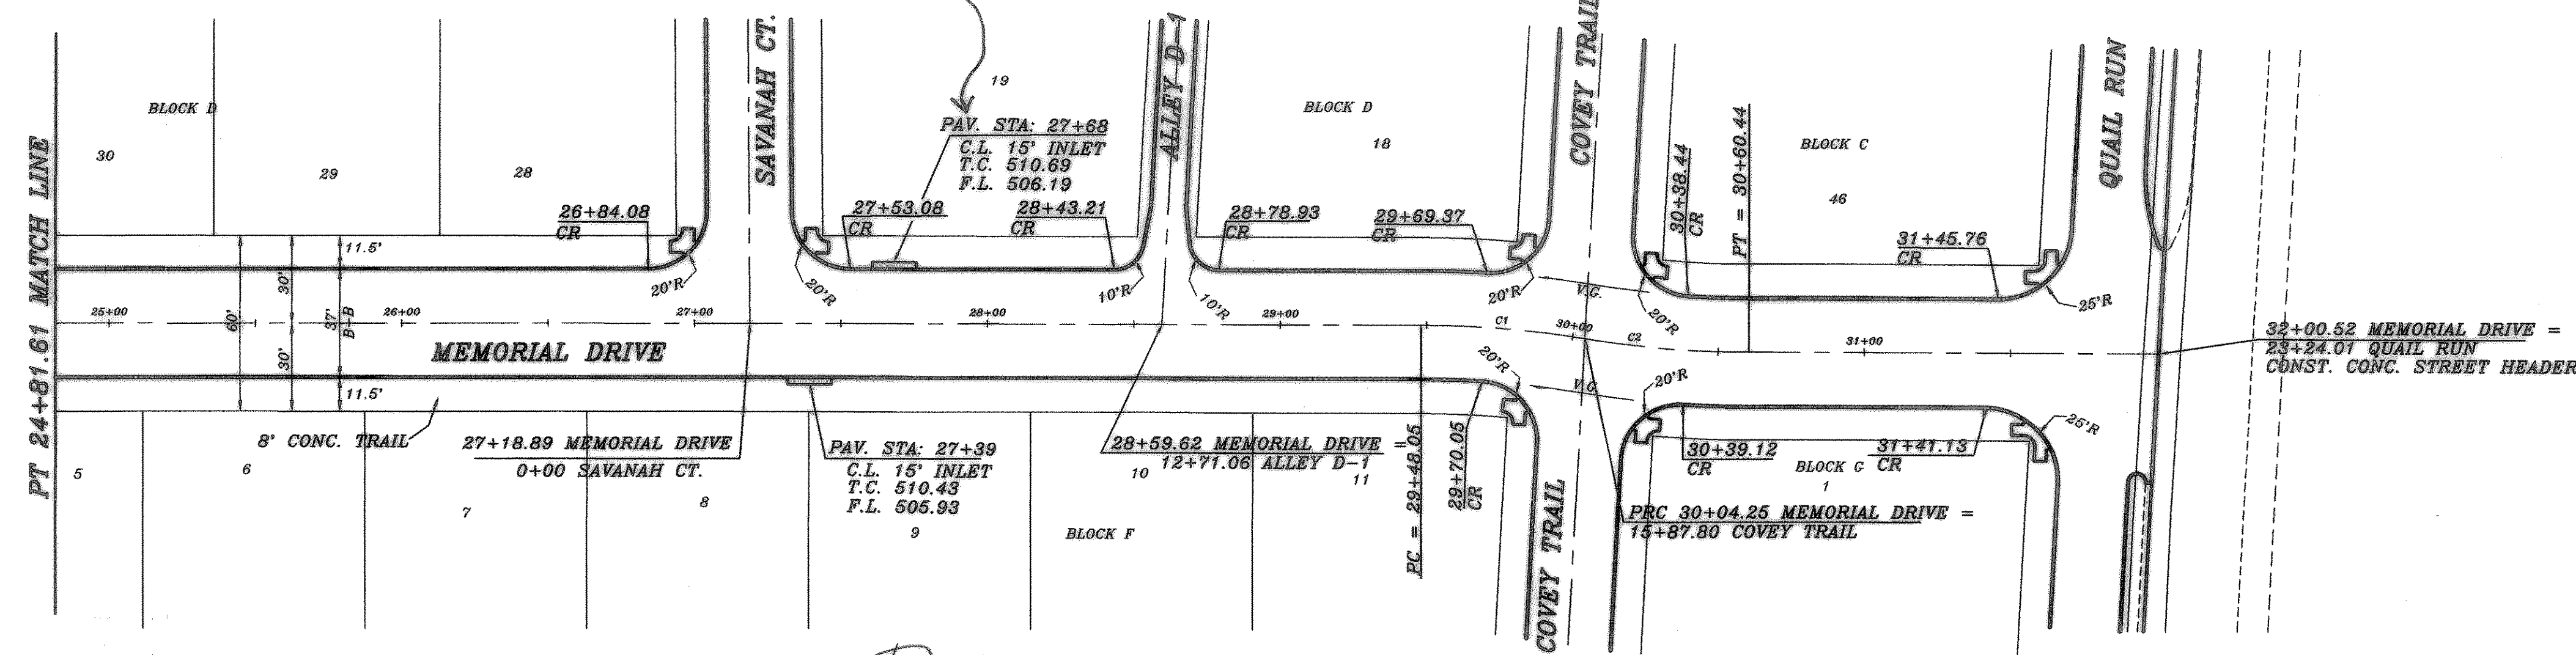

PHASE 2B

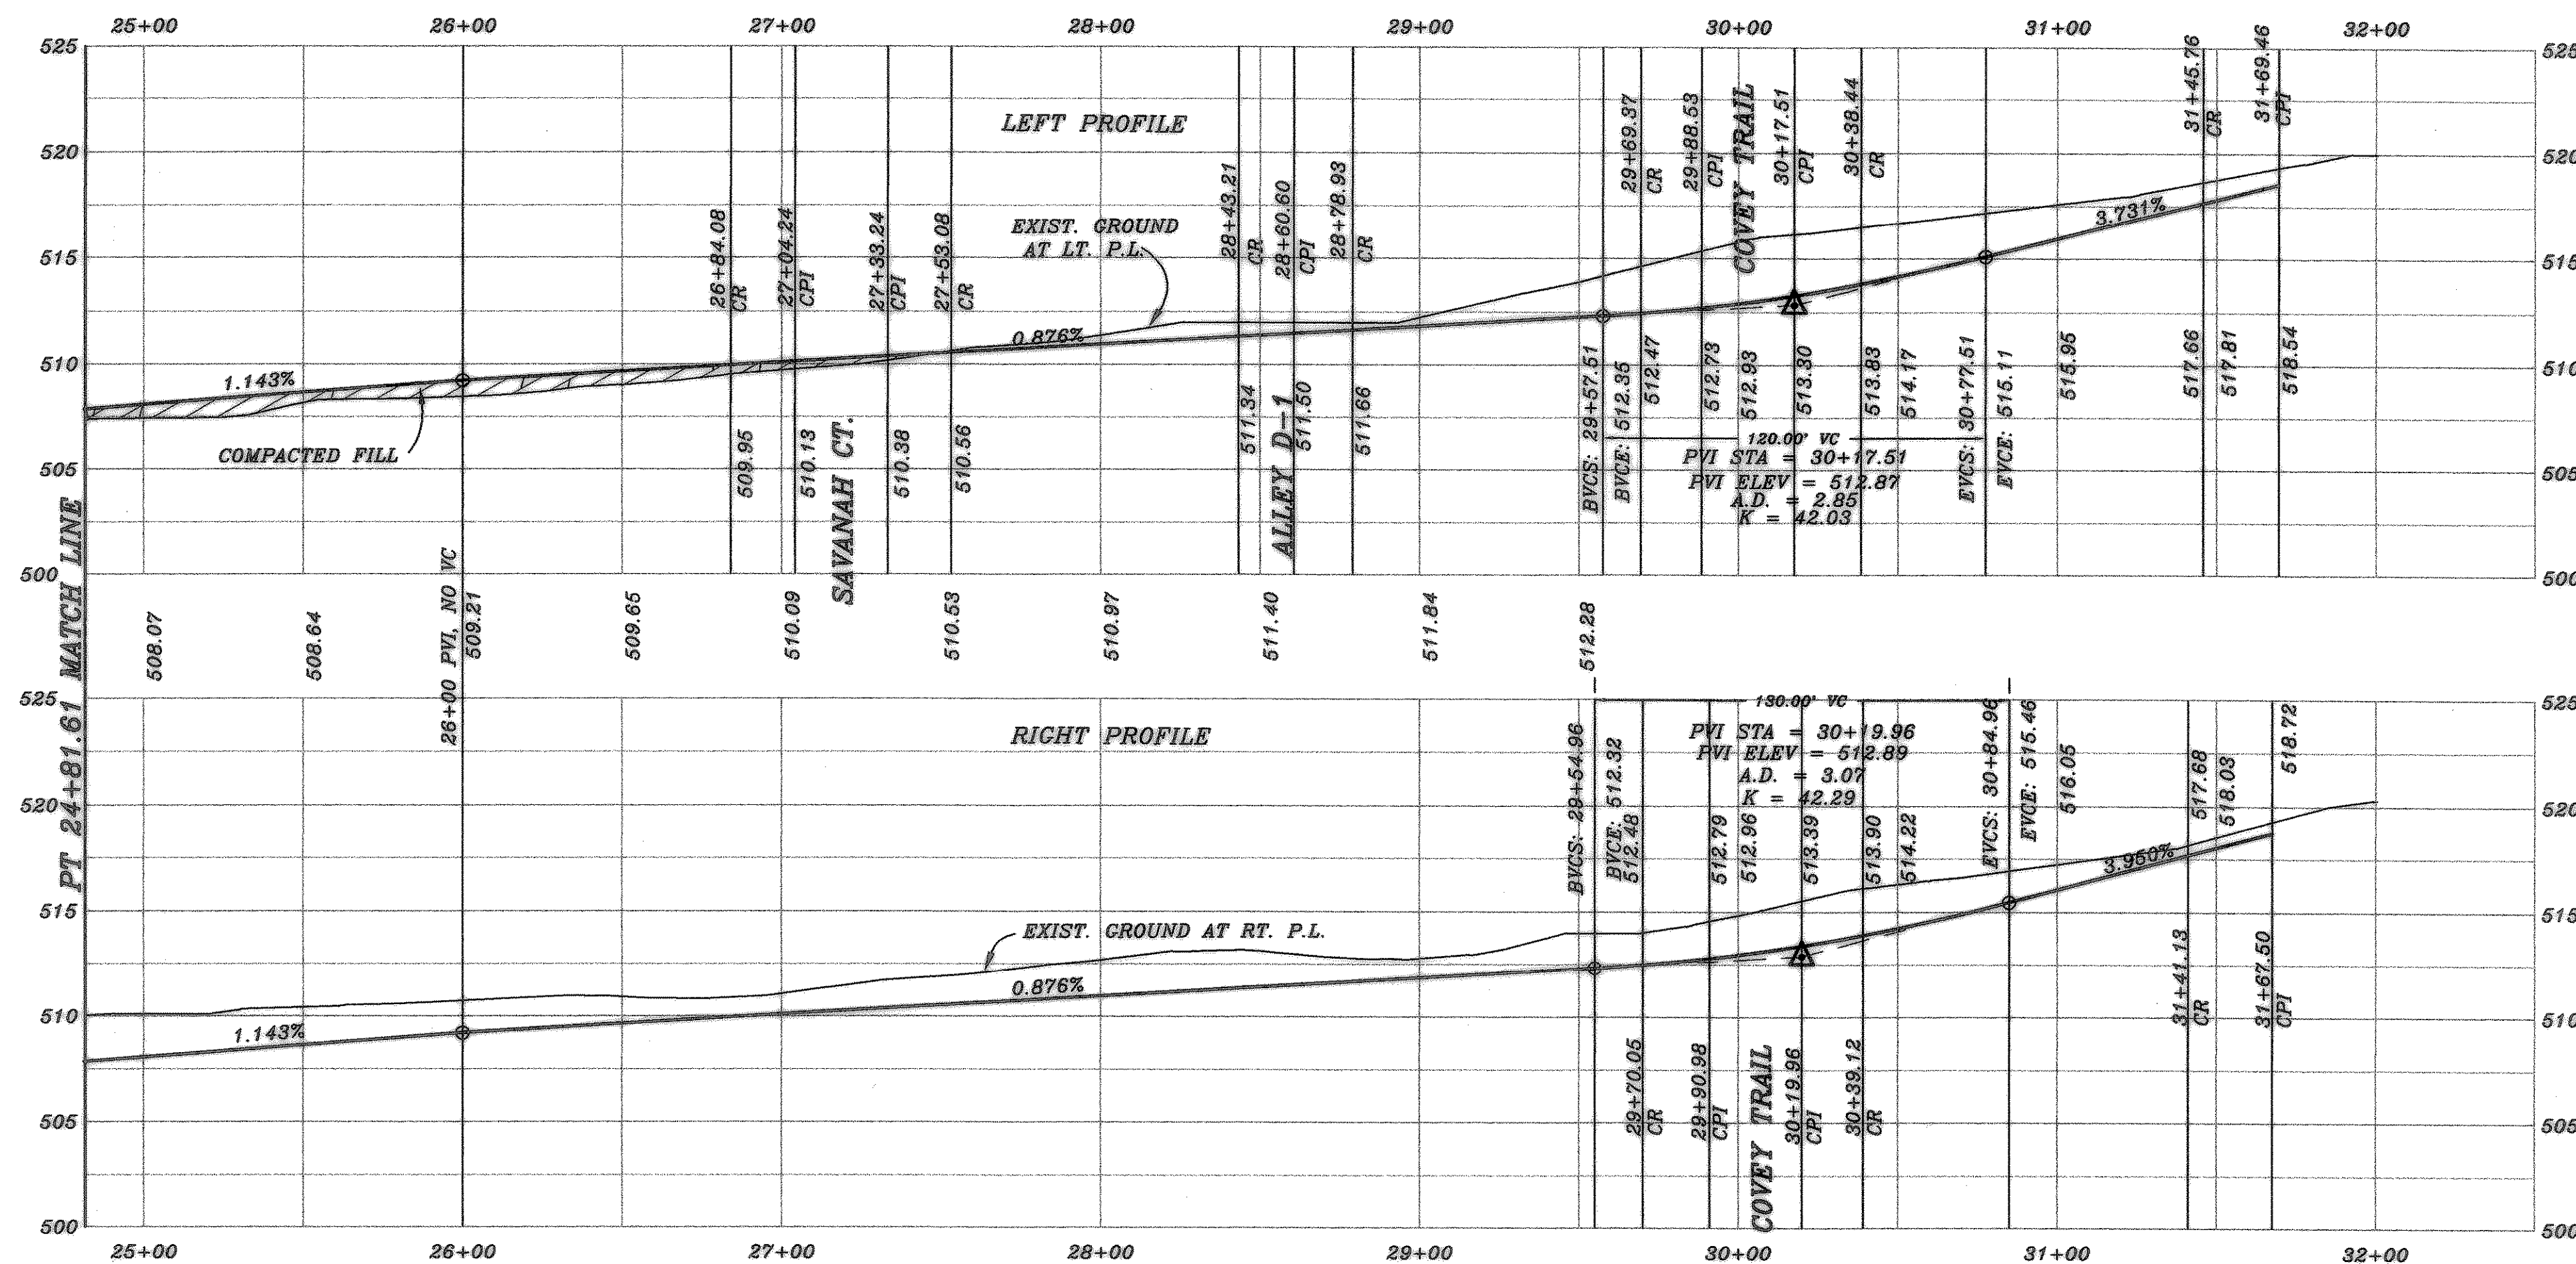

BENCH MARK
SQUARE CUT IN CONCRETE AT BASE OF
CONCRETE WALL AT S.W. CORNER OF
SOUTH APPROACH TO BRIDGE OVER
SQUABBLE CREEK ON HWY. 205
ELEV.: 472.41

BENCH MARK
60D NAIL IN 36" PECAN TREE (TREE NO. 2302)
PAY. STA. 8+30, 71' RT., MEMORIAL DRIVE
ELEV.: 466.79

BENCH MARK
60D NAIL IN 34" PECAN TREE (TREE NO. 2314)
PAY. STA. 1+03, 138' RT., AUDOBON LANE
ELEV.: 480.88

BENCH MARK
60D NAIL IN 18" PECAN TREE (TREE NO. 2114)
PAY. STA. 10+97, 63.5' RT., AUDOBON LANE
ELEV.: 501.54

ASBUILT
Winkelmann & Associates, Inc. hereby states that this
plan, to the best of our knowledge is "As Built."
Modifications from the originally approved construction
documents have been made as per information provided by
the contractor. Winkelmann & Associates, Inc. does not
certify as to the correctness or quality of construction as no
field inspection was performed.
9-27-02
DATE Ph 2A
9-14-04 Ph 2B



REV.	11/26/01
REV. PER 3rd CITY REVIEW	6/13/01
REV. PER 2nd CITY REVIEW	5/10/01
REV. PER CITY REVIEW	2/25/01
REVISION DESCRIPTION	DATE
0020 PHASE 2A 0020P23	2/1/01

HAROLD L. EVANS

CONSULTING ENGINEER

P.O. BOX 28355

2331 CUS THOMASSON ROAD, SUITE 102

DALLAS, TEXAS 75228, (214) 328-8133

SCALE DESIGN DRAWN

1" = 40'
1" = 6'

H.L.E.

PROPOSED PAVING

MEMORIAL DRIVE

QUAIL RUN VALLEY NO. 2

CITY OF ROCKWALL

SHEET NO.

4

24

JOB NO.

0020