


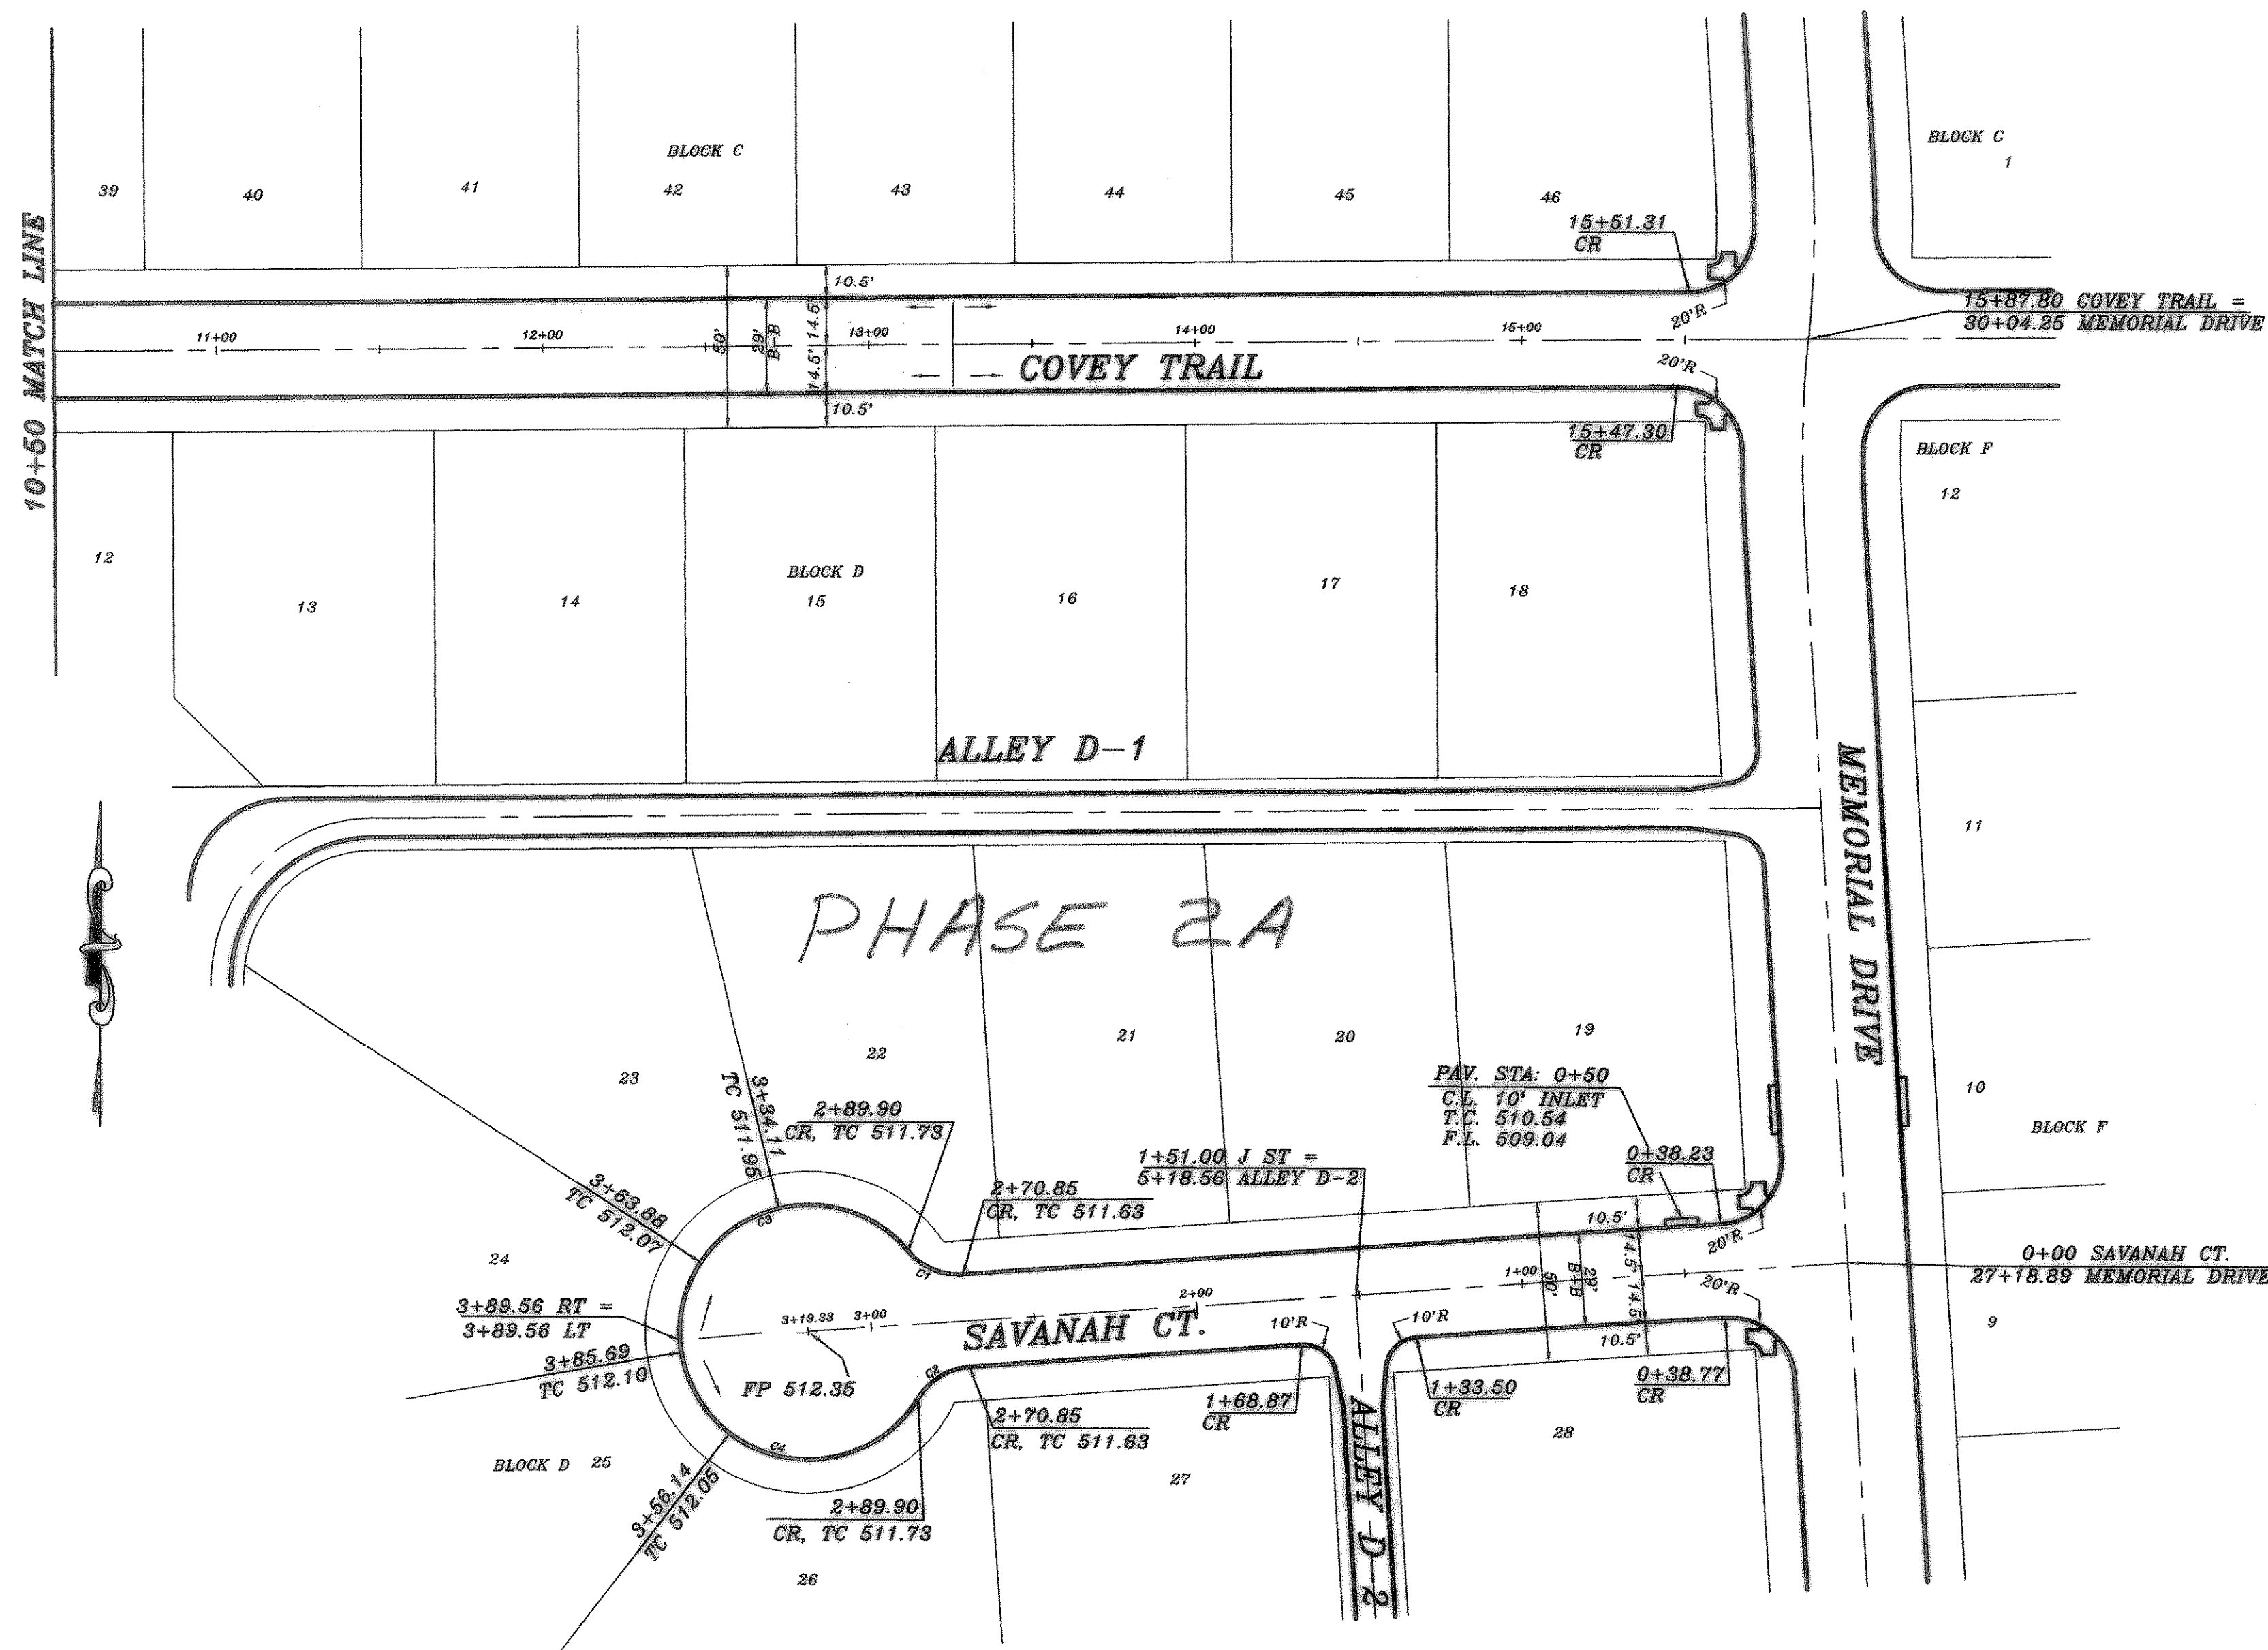



CURVE	RADIUS	LENGTH	TANGENT	CHORD	BEARING	DELTA
C1	20.00'	19.05'	10.31'	18.33'	S66°37'32"E	54°33'41"
C2	20.00'	19.05'	10.31'	18.33'	S58°48'48"W	54°33'41"
C3	39.50'	99.66'	123.63'	75.25'	S66°22'26"W	144°33'41"
C4	39.50'	99.66'	123.63'	75.25'	S76°11'12"E	144°33'41"

BENCH MARK
SQUARE CUT IN CONCRETE AT BASE OF
CONCRETE WALL AT S.W. CORNER OF
SOUTH APPROACH TO BRIDGE OVER
SQUABBLE CREEK ON HWY. 205
ELEV.: 472.41

BENCH MARK
60D NAIL IN 36" PECAN TREE (TREE NO. 2302)
PAV. STA. 8+30, 71' RT. MEMORIAL DRIVE
ELEV.: 466.79

BENCH MARK
60D NAIL IN 34' PECAN TREE (TREE NO. 2314)
PAV. STA. 1+33, 138' RT. AUDOBON LANE
ELEV.: 480.88

BENCH MARK
60D NAIL IN 18' PECAN TREE (TREE NO. 2114)
PAV. STA. 10+87, 63.5' RT. AUDOBON LANE
ELEV.: 501.54

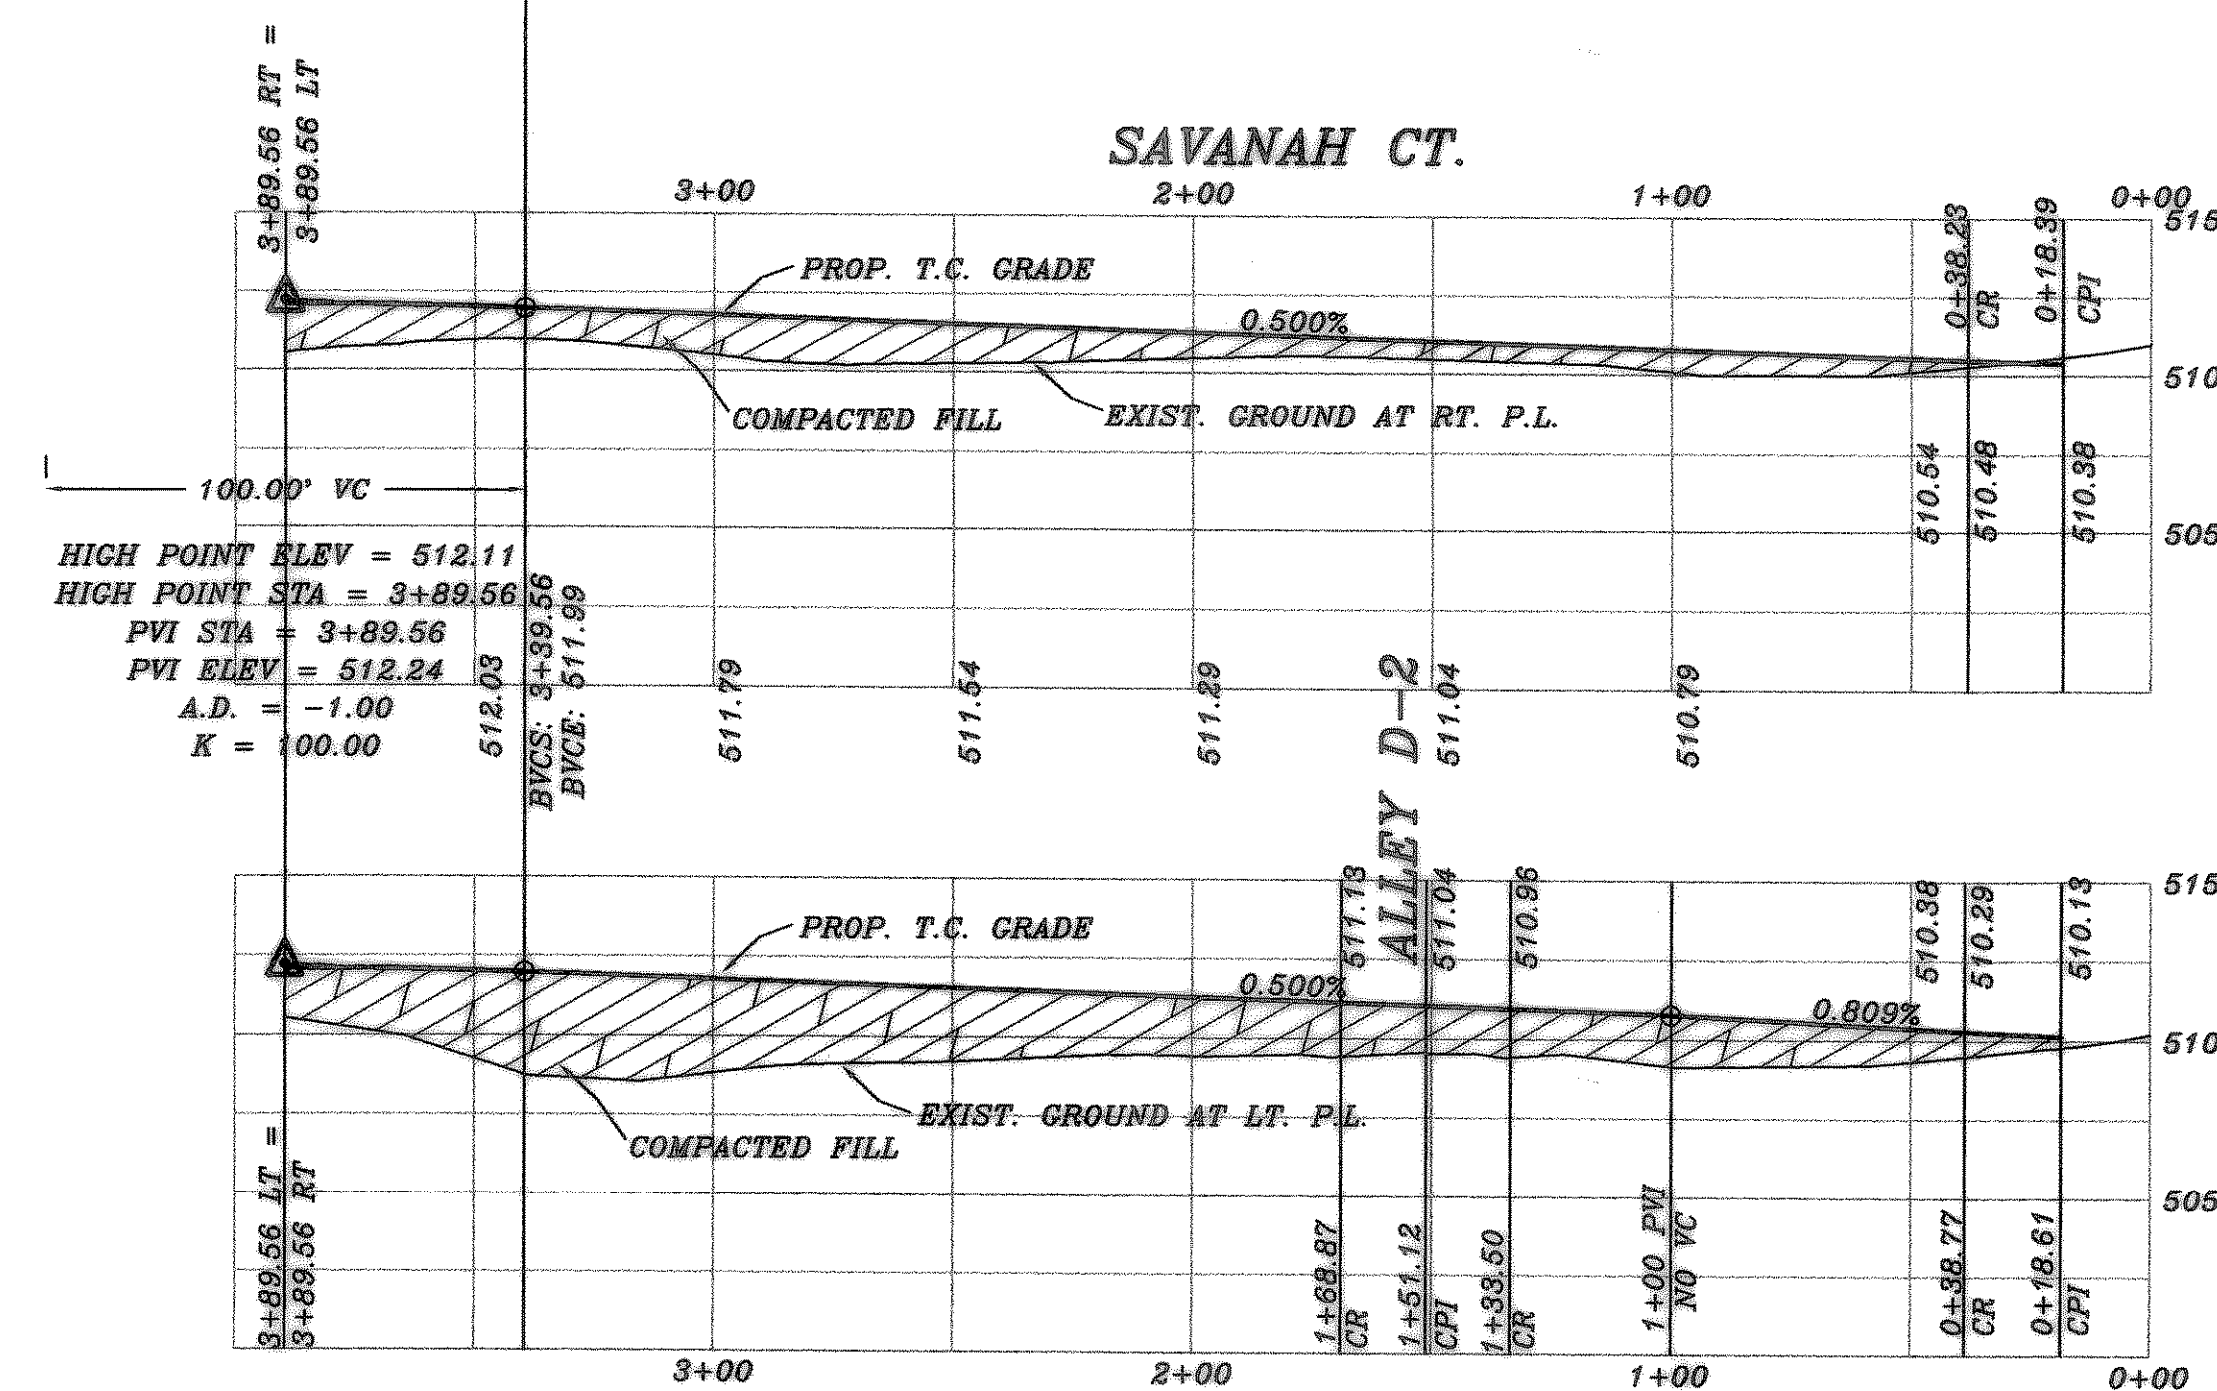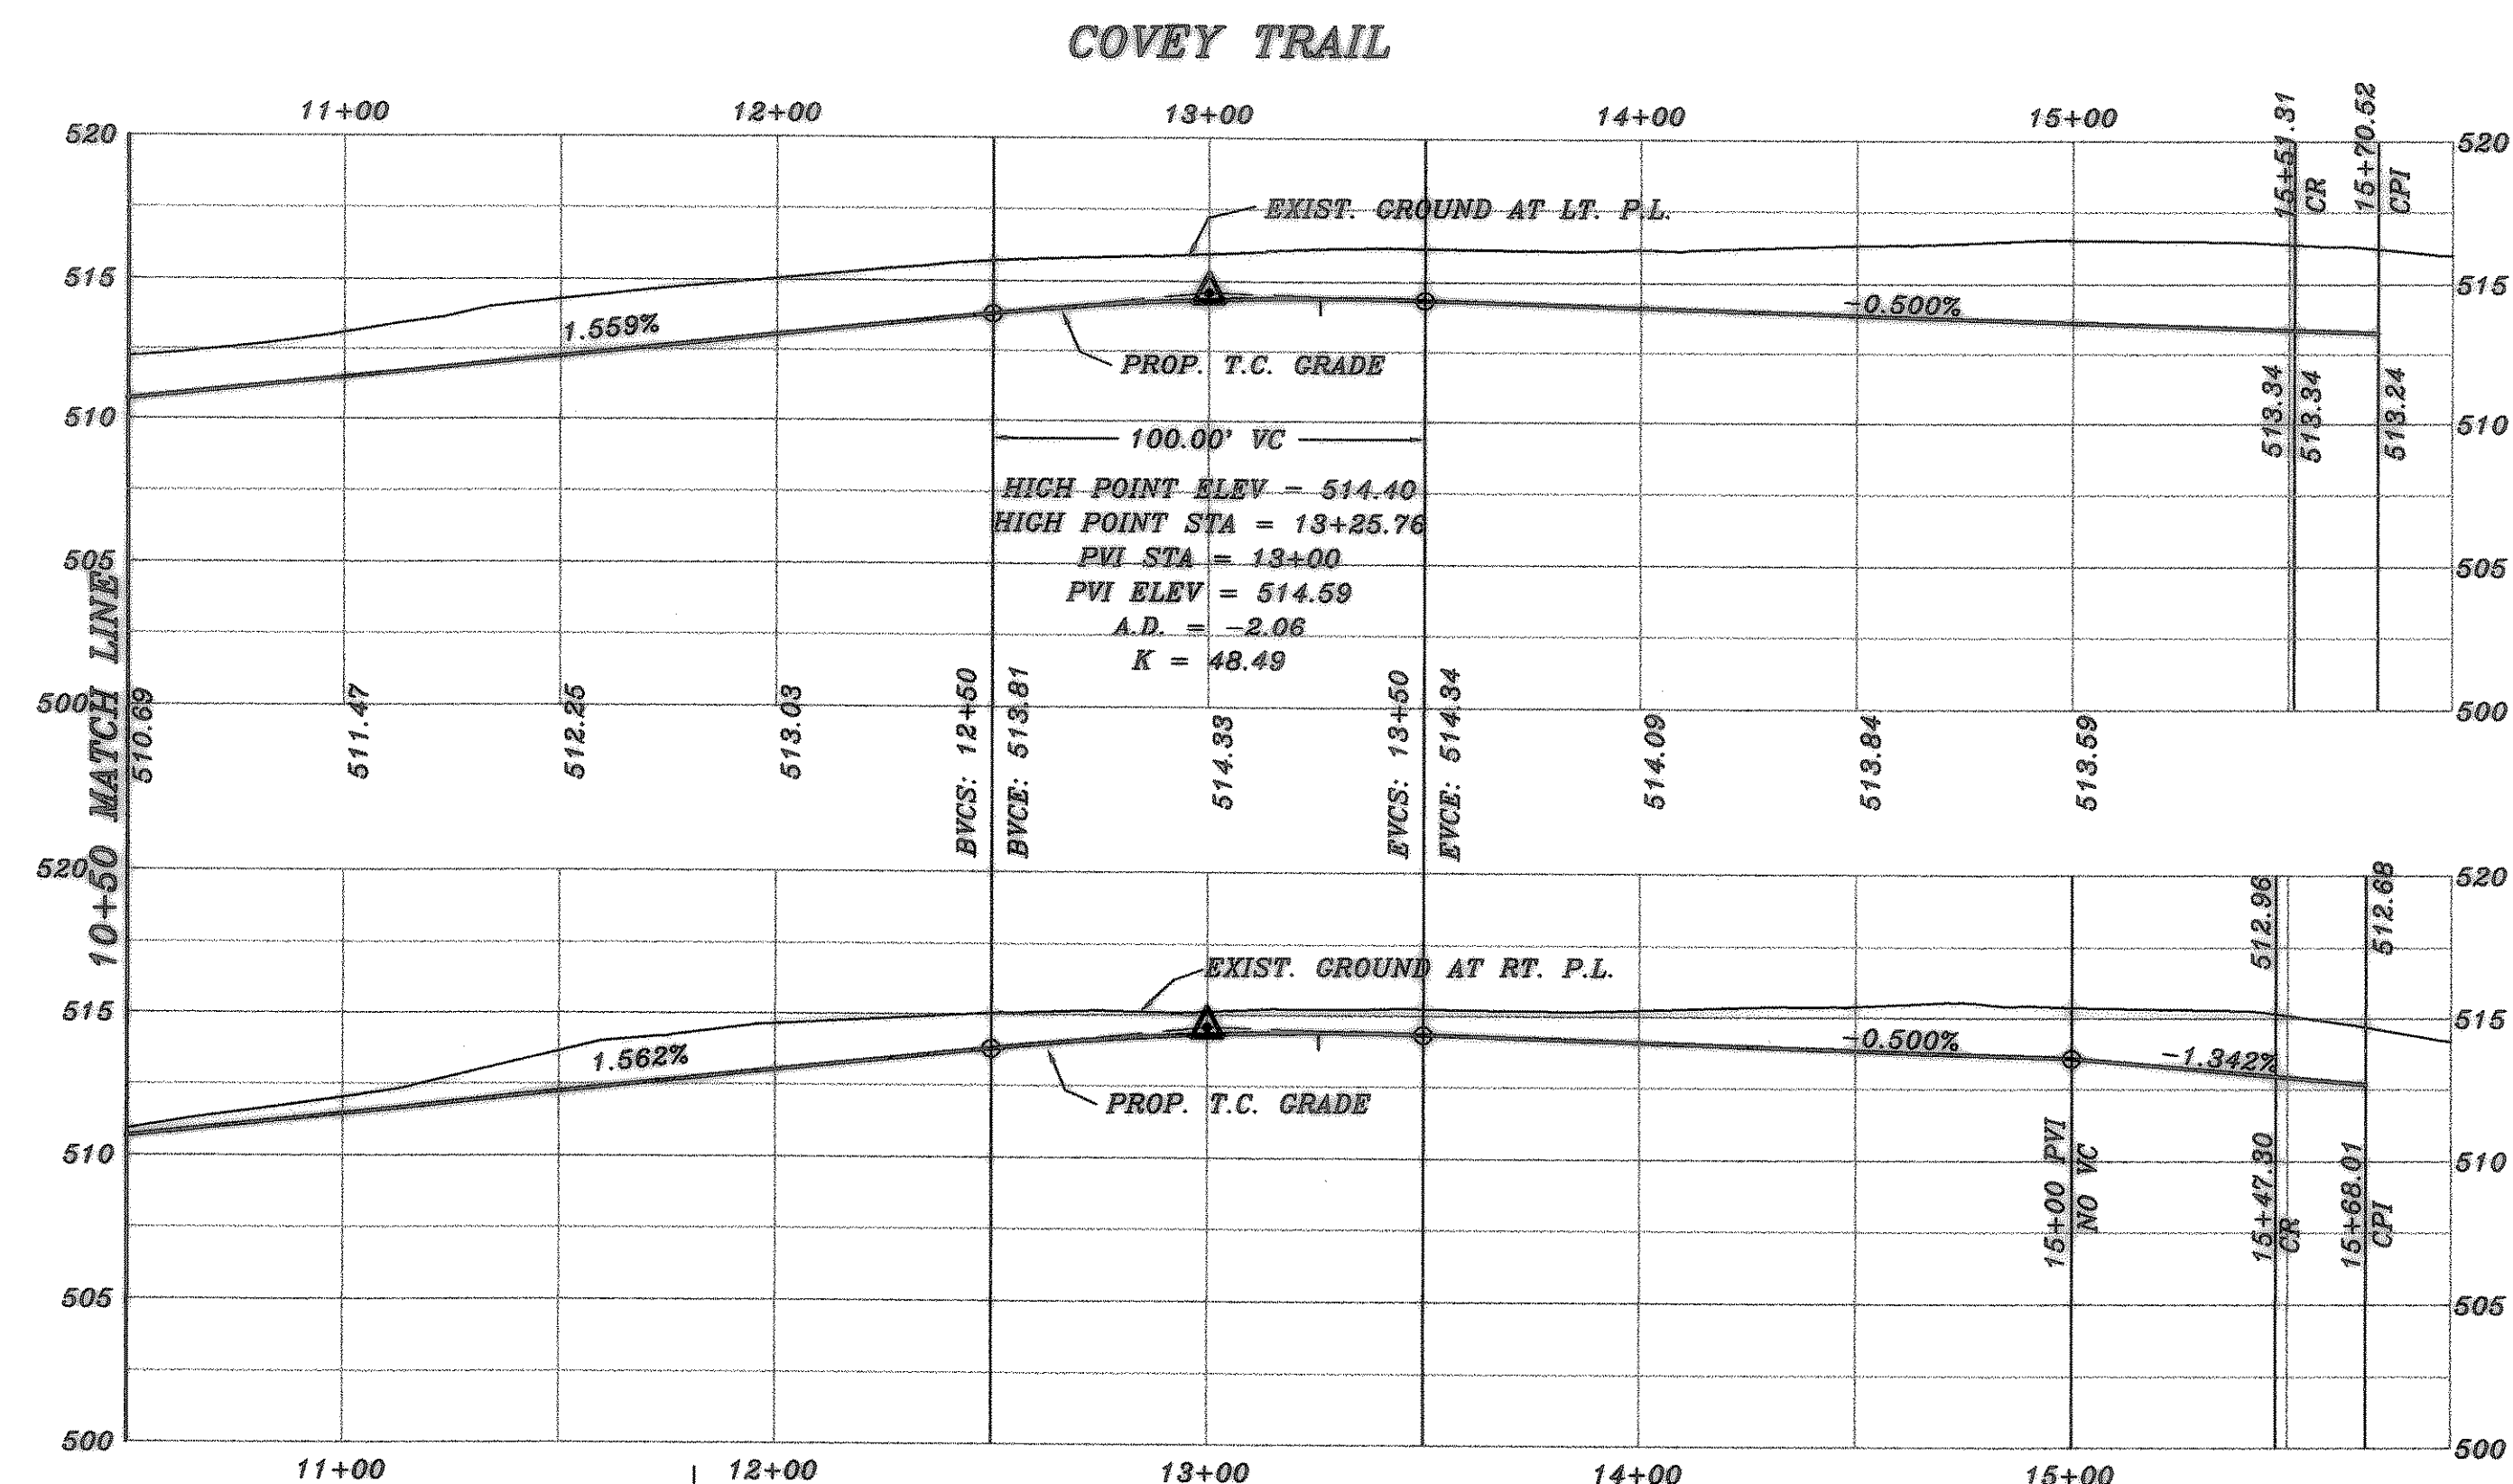


ASBUILT

Winkelmann & Associates, Inc. hereby states that this
plan to the best of our knowledge is "As Built."
Modifications from the originally approved construction
documents have been made as per information provided by
the contractor. Winkelmann & Associates, Inc. does not
warrant as to the correctness or quality of construction as no
field inspection was performed.

Winkelmann & Associates, Inc.
23155

DATE: 9-27-08
Fh 2A
9-18-04 Mh 28

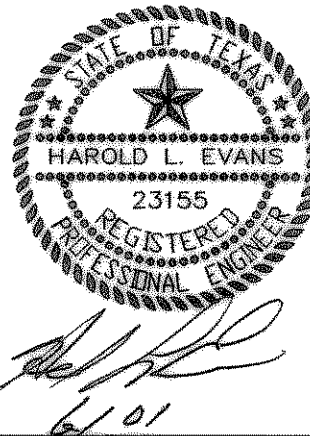

REVISION DESCRIPTION 0020A PHASE 2, 0020P25		DATE 5/10/01 5/10/01		SCALE 1" = 40' 1" = 6'		DESIGN H.L.E.		DRAWN	
HAROLD L. EVANS CONSULTING ENGINEER P.O. BOX 28355 2331 GUS THOMASSON ROAD, SUITE 102 DALLAS, TEXAS 75228, (214) 329-8133				PROPOSED PAVING COVEY TRAIL AND SAVANAH CT. QUAIL RUN VALLEY NO. 2 CITY OF ROCKWALL				SHEET NO. 6 24 JOB NO. 0020	