


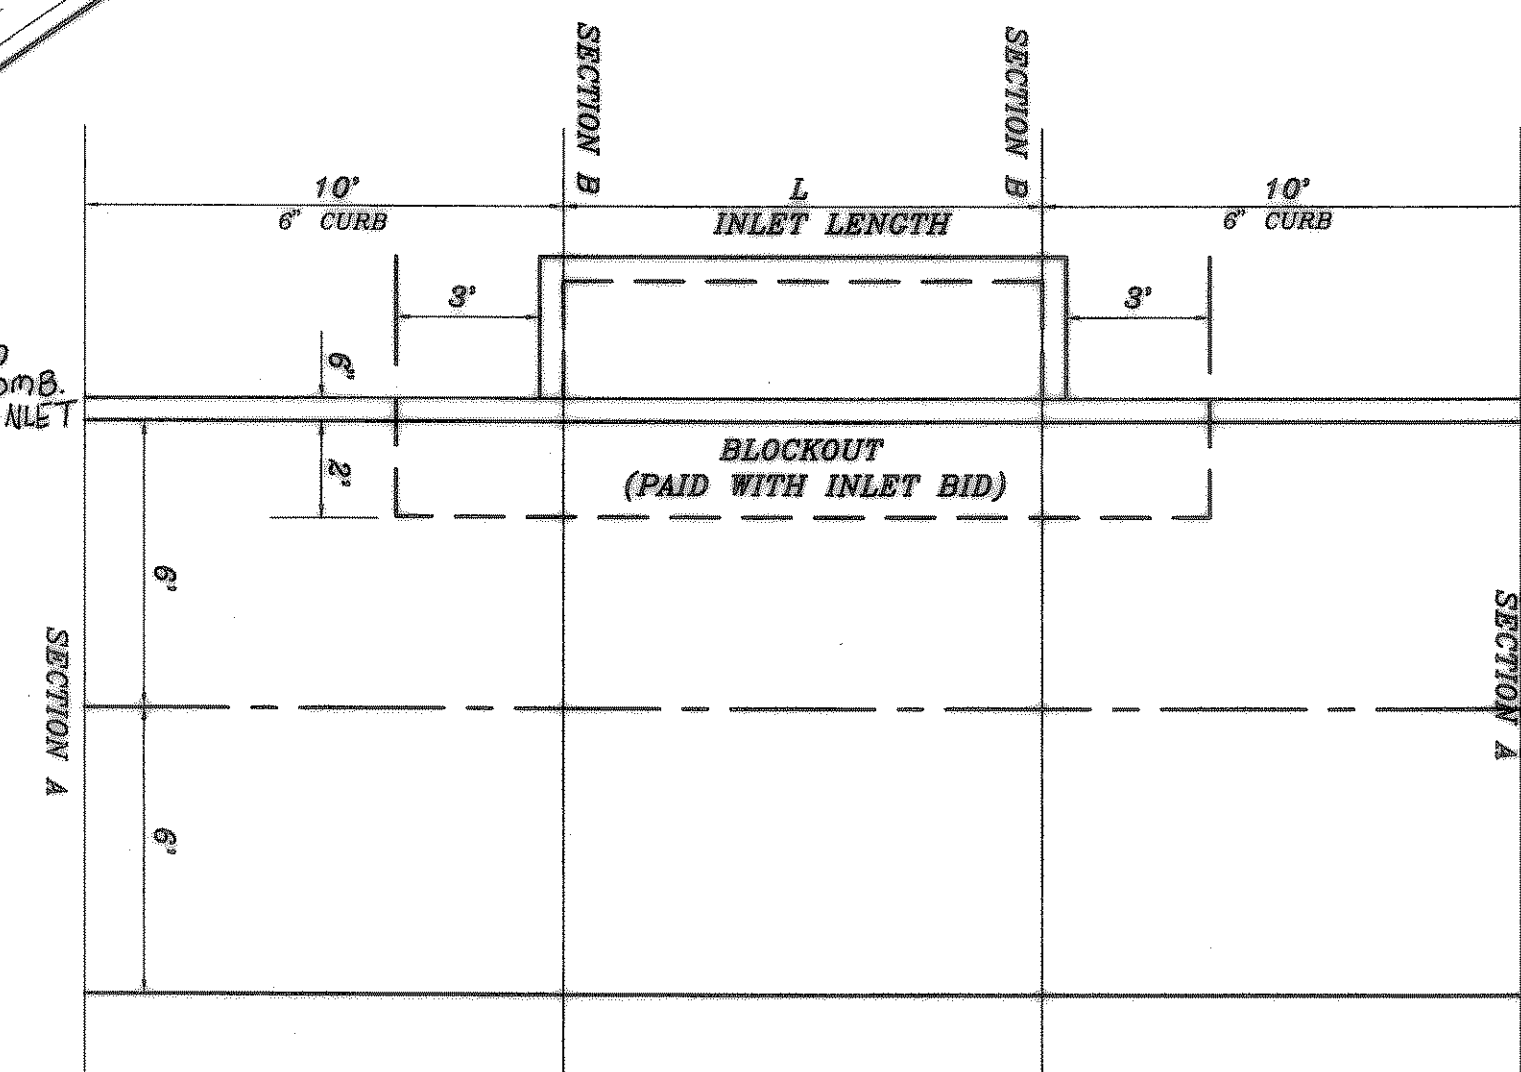


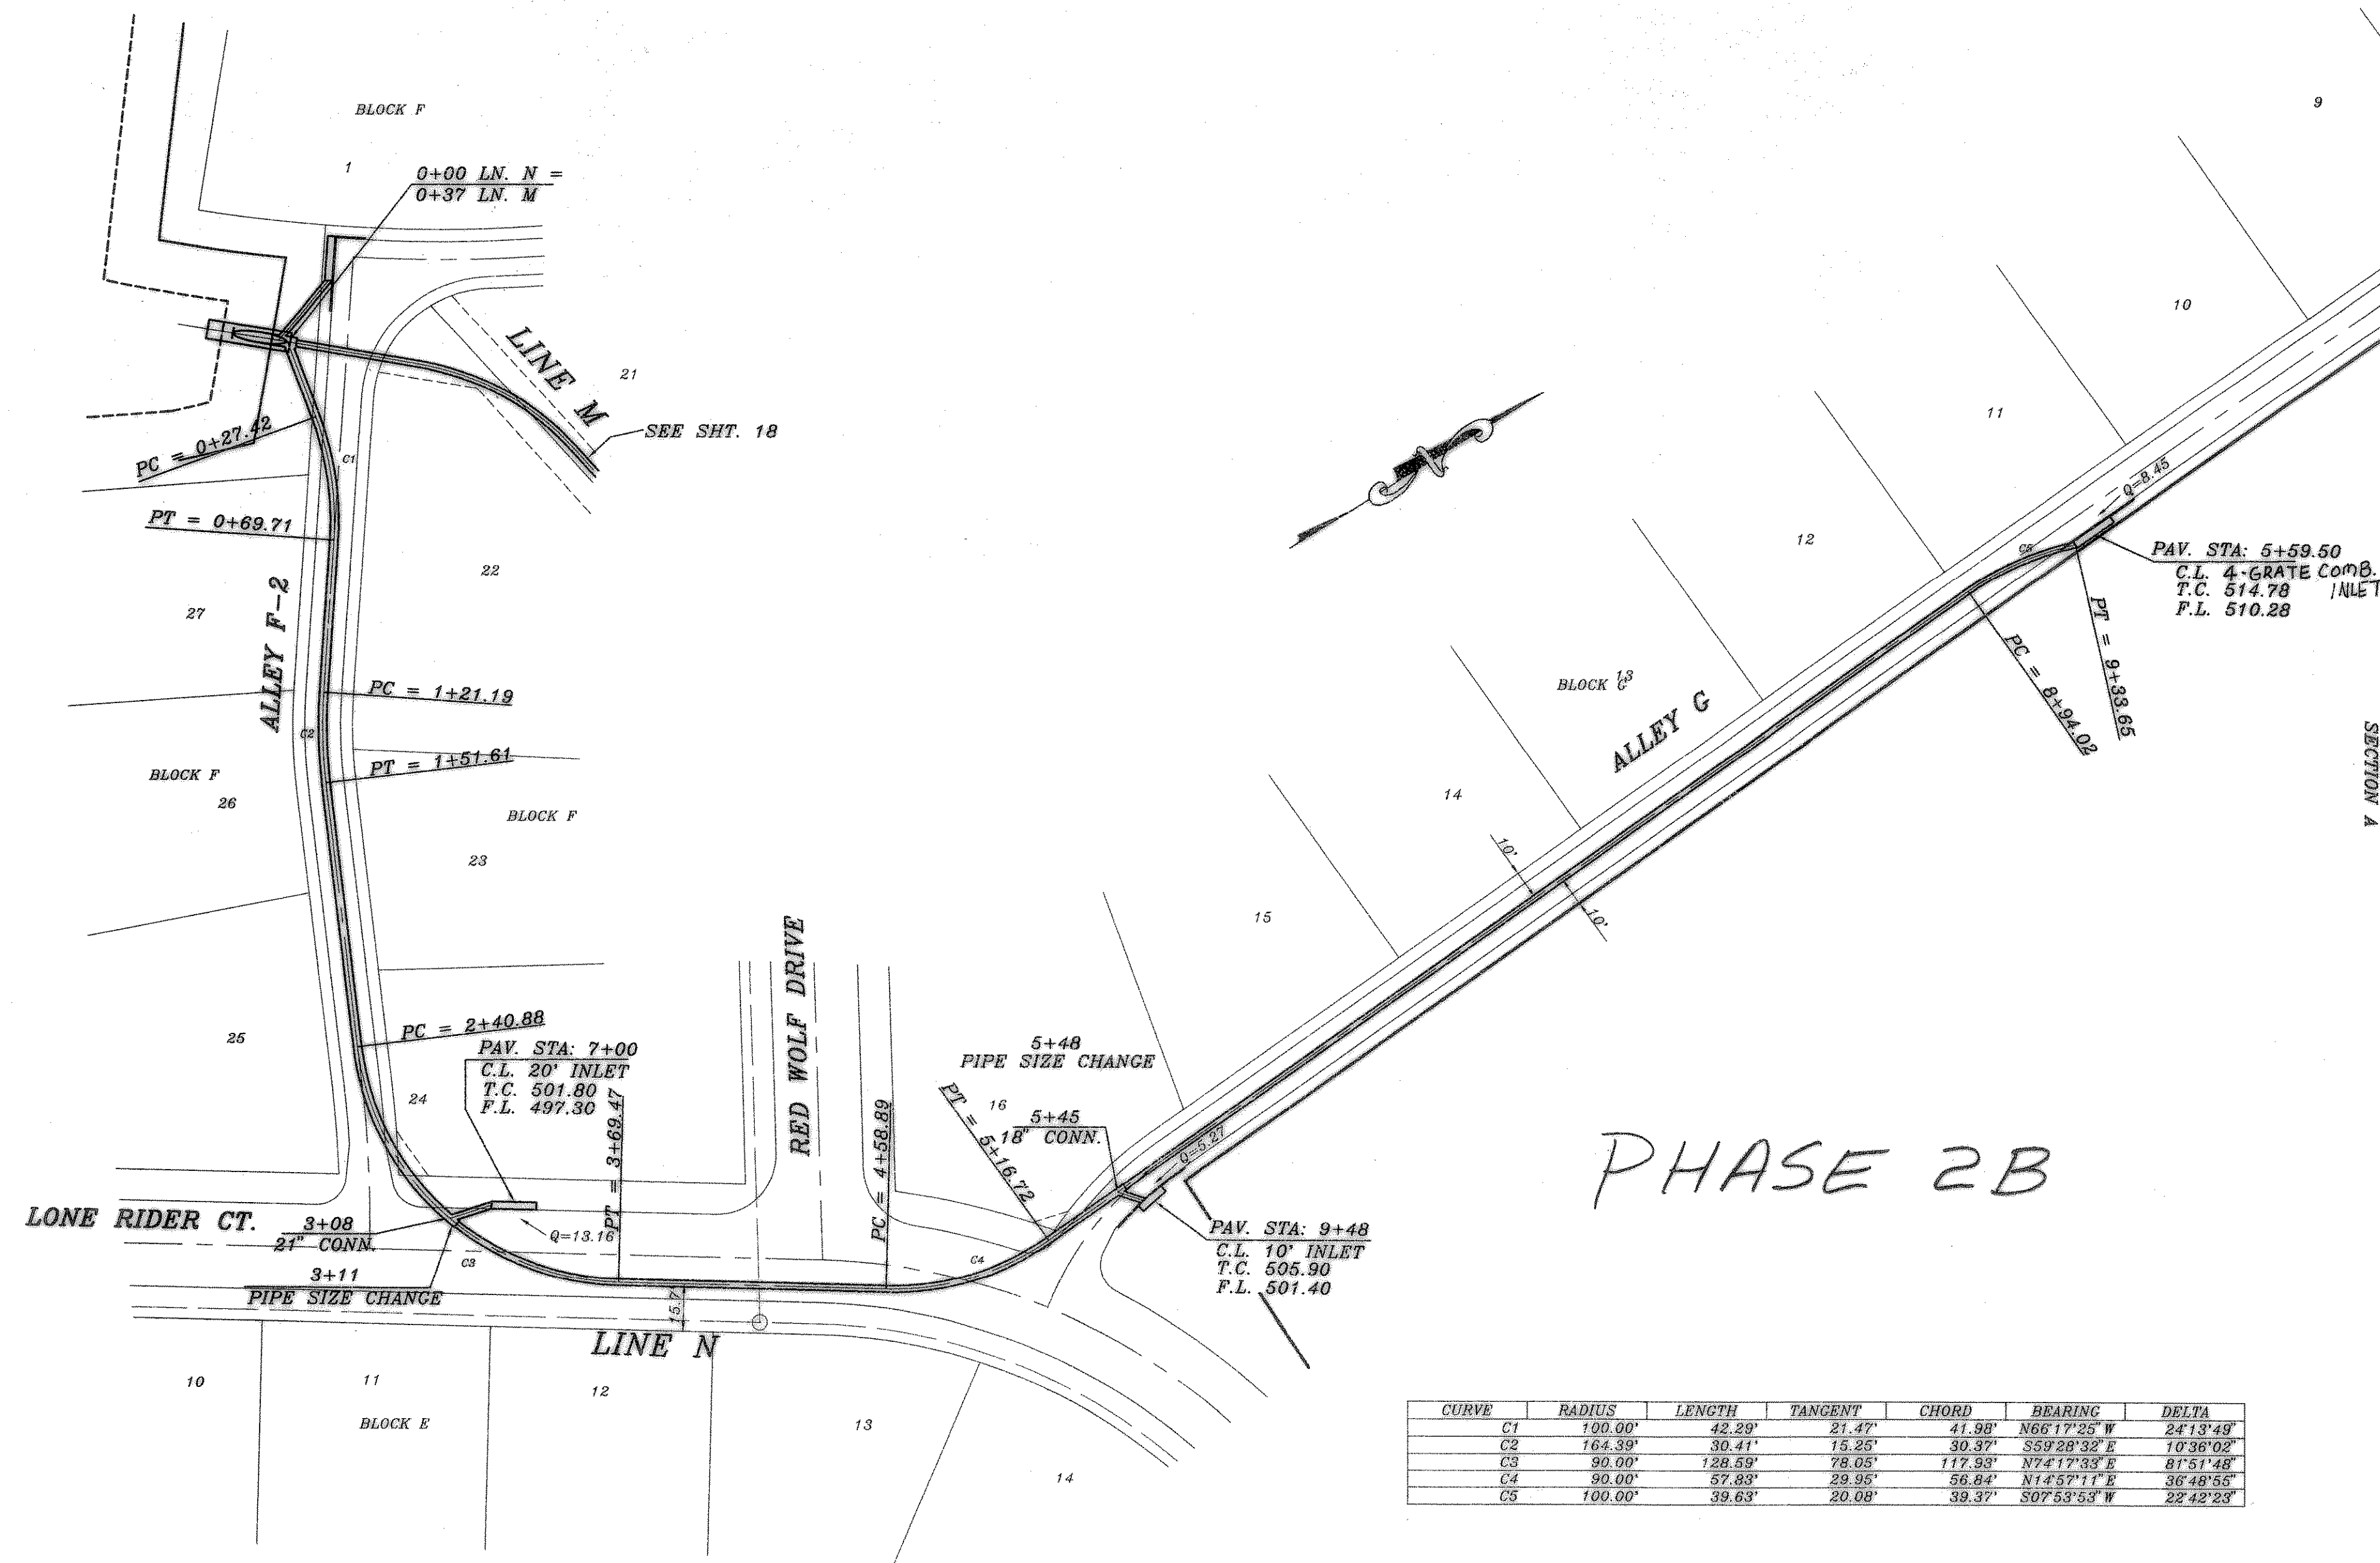

ALLEY INLET SECTION
SCALE: 1" = 4'

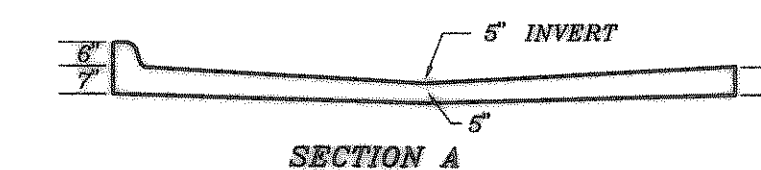


SECTION A

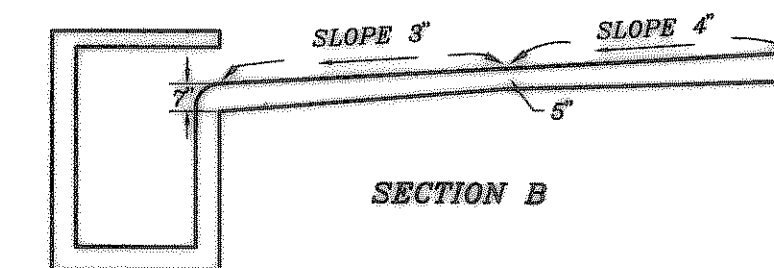

SECTION B

CURVE	RADIUS	LENGTH	TANGENT	CHORD	BEARING	DELTA
C1	100.00'	42.29'	21.47'	41.98'	N66°17'25" W	24°13'49"
C2	164.39'	30.41'	15.25'	30.37'	S69°28'32" E	10°36'02"
C3	90.00'	128.59'	78.05'	117.99'	N72°17'33" E	87°51'48"
C4	90.00'	57.83'	29.95'	56.84'	N14°57'11" E	36°48'55"
C5	100.00'	39.63'	20.08'	39.37'	S07°53'53" W	22°42'25"

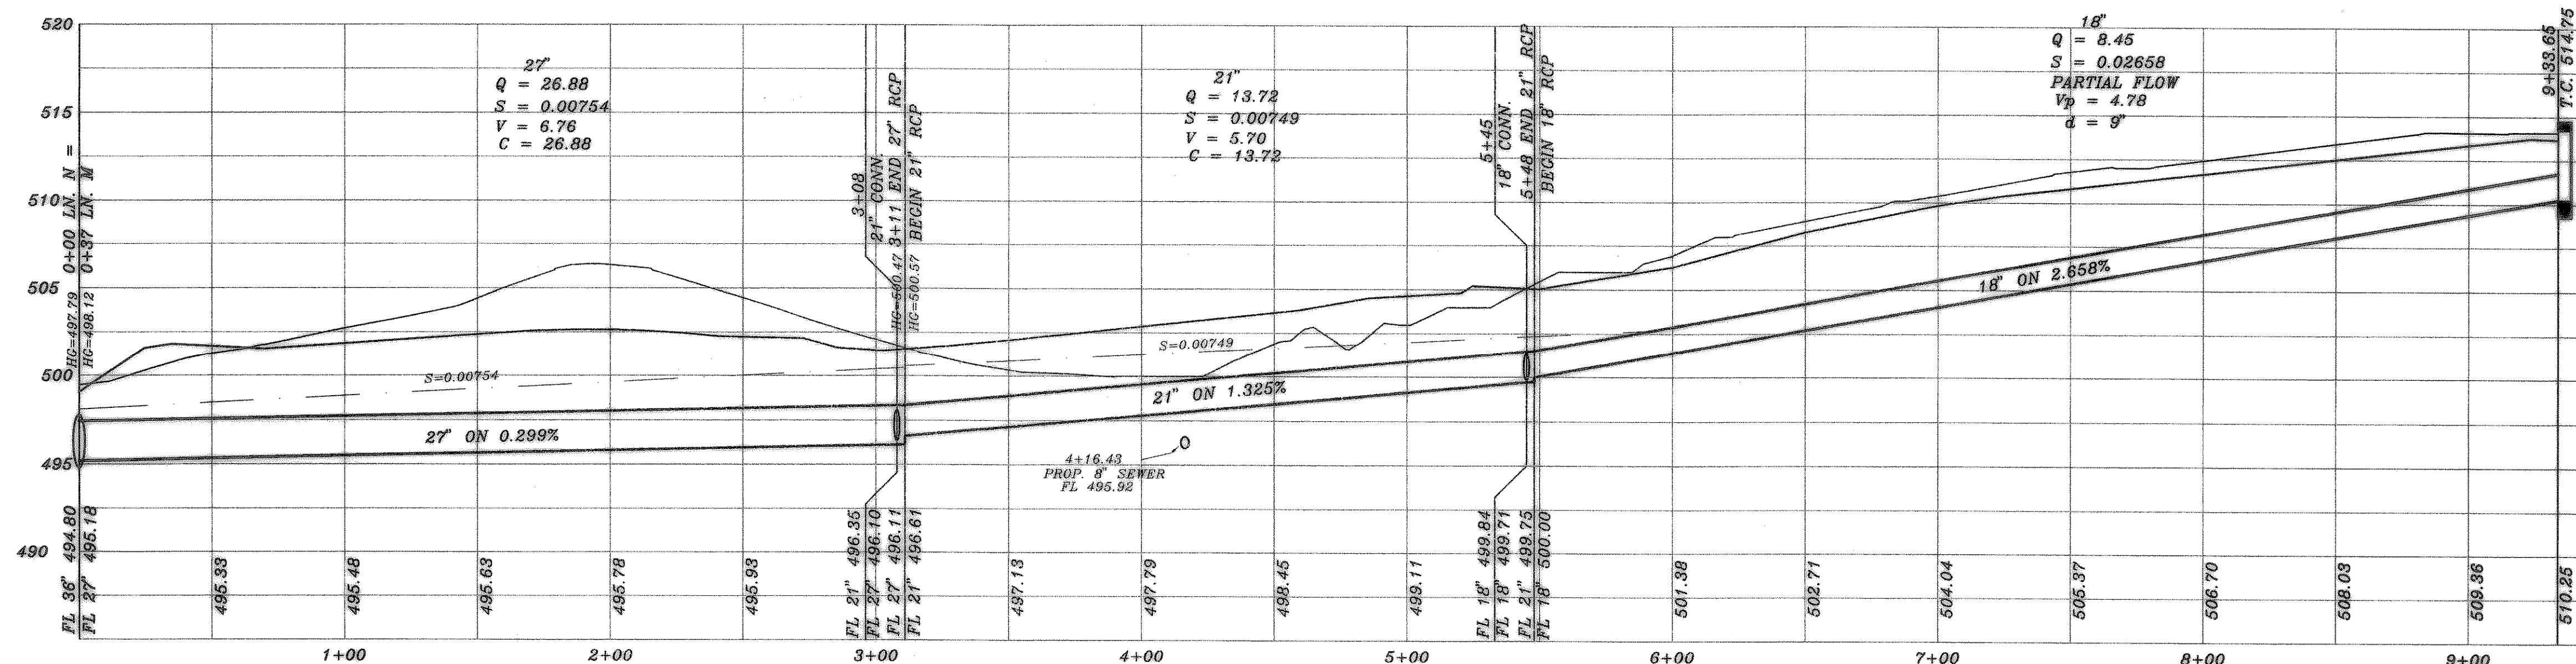


BENCH MARK
SQUARE CUT IN CONCRETE AT BASE OF
CONCRETE WALL AT S.W. CORNER OF
SOUTH APPROACH TO BRIDGE OVER
SQUABBLE CREEK ON HWY. 205
ELEV.: 472.41

BENCH MARK
60D NAIL IN 34" PECAN TREE (TREE NO. 2314)
PAV. STA. 1+48, 130' RT., AUDOBON LANE
ELEV.: 430.88

BENCH MARK
60D NAIL IN 18" PECAN TREE (TREE NO. 2114)
PAV. STA. 10+97 63.5' RT., AUDOBON LANE
ELEV.: 501.54

ASBUILT
Winkelmann & Associates, Inc. hereby states that this
plan, to the best of our knowledge is "As Built."
Modifications from the originally approved construction
documents have been made as per information provided by
the contractor. Winkelmann & Associates, Inc. does not
certify as to the correctness or quality of construction as no
field inspection was performed.
9-14-04
DATE: 9-14-04
PH 28

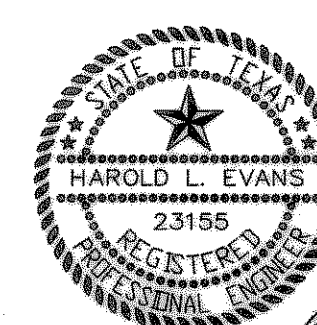

REVISION DESCRIPTION 0020 PHASE 2, 00205723		DATE 2/1/01	SCALE 1" = 40' 1" = 6'	DESIGN H.L.E.	DRAWN
REV. PER 4th REVIEW 7/13/01		REV. PER 3rd REVIEW 6/13/01		REV. PER 2nd REVIEW 5/10/01	
HAROLD L. EVANS CONSULTING ENGINEER P.O. BOX 28355 2331 GUS THOMASSON ROAD, SUITE 102 DALLAS, TEXAS 75228, (214) 328-8133					
PROPOSED DRAINAGE LINE N QUAIL RUN VALLEY NO. 2 CITY OF ROCKWALL					
SHEET NO. 19 24 JOB NO. 0020					