
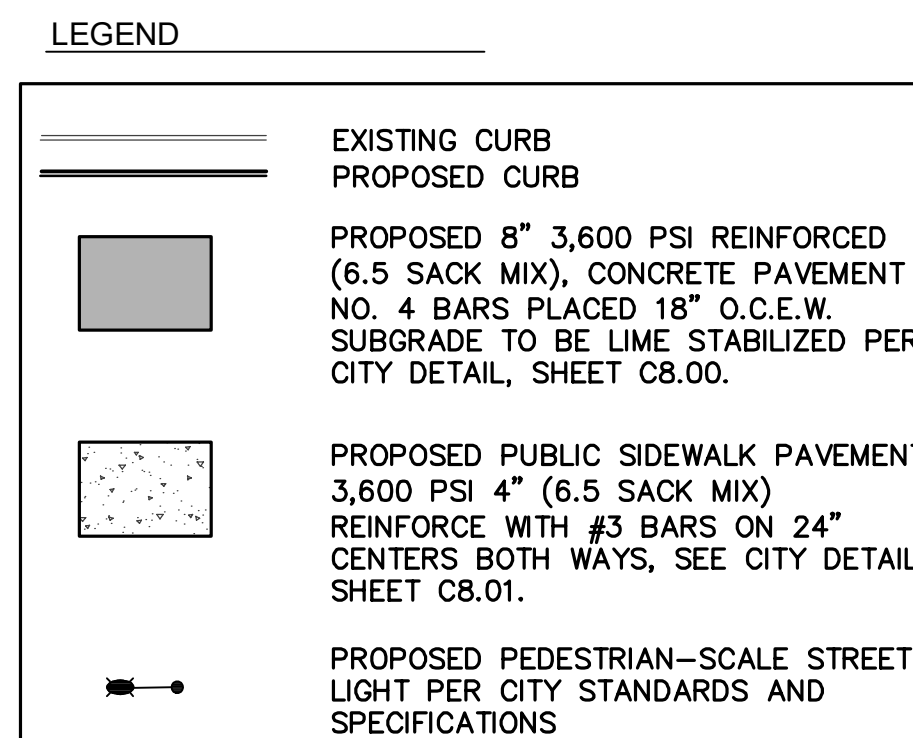


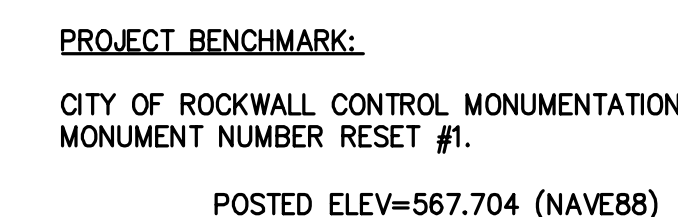

The diagram illustrates a typical cross-section of Glen Hill Way. The total width is 50 feet, designated as the Right of Way (ROW). This width is divided into several sections: a 9.5-foot sidewalk on the left, a 31-foot central roadway (B-B), and a 9.5-foot sidewalk on the right. The 31-foot roadway is further divided into two 15-foot lanes, separated by a 6-inch stabilized subgrade. The subgrade is labeled as being 27 lbs/sy. The diagram also shows a 12-inch curb on the left and a 6-inch curb on the right, both labeled as 'SIDEWALK'. The centerline of the roadway is marked with a 'C' and a 'B-B' line.

GLEN HILL WAY—TYPICAL SECTION
NOT TO SCALE

TO THE BEST OF OUR KNOWLEDGE CARRILLO
ENGINEERING, HEREBY STATES THAT THIS PLAN IS
AS-BUILT. THE INFORMATION PROVIDED IS BASED ON
SURVEYING AT THE SITE AND INFORMATION PROVIDED
BY THE CONTRACTOR

Sheet
C2.02