

SITE ENGINEERING PLANS

RIDGE ROAD TOWN CENTRE – PHASE I


ROCKWALL, TEXAS

OWNER:
RIDGE ROAD TOWN CENTRE PARTNERS, L.P.


DEVELOPER:



5400 W. PLANO PARKWAY, SUITE 200
PLANO, TEXAS 75093
972-381-9600

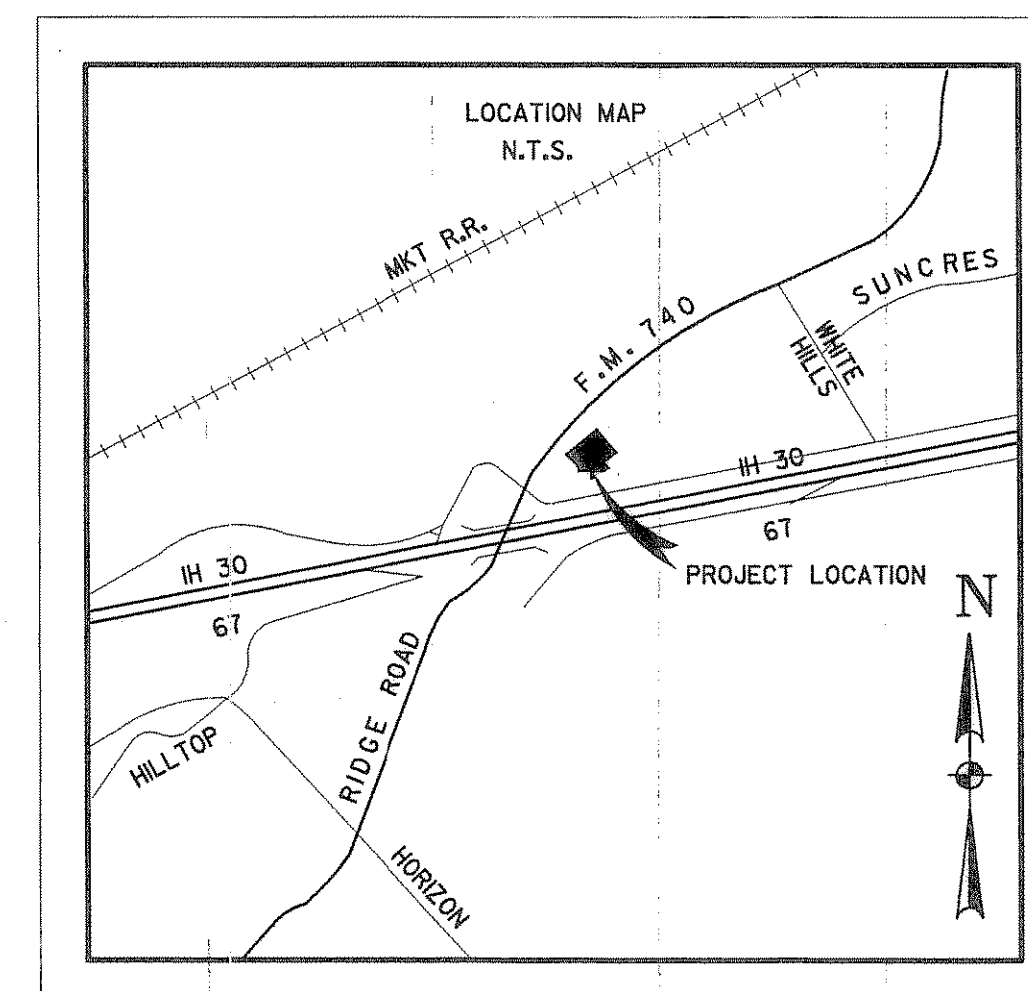

ENGINEER:

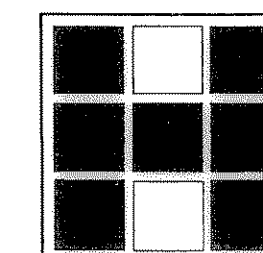


Halff Associates

8616 NORTHWEST PLAZA – DALLAS, TX 75225
ENGINEERS • SCIENTISTS • PLANNERS • SURVEYORS
Phone: (214) 346-6200 Fax: (214) 361-5573
Contact: Mark McGraw or Jamie Beard

AVO 20633
JANUARY 2003

SHEET INDEX	
SHEET NUMBER	TITLE
	COVER SHEET/INDEX
CFP01	FINAL PLAT
CCP01	OVERALL CONCEPT PLAN
CPP01	PAVING AND GRADING PLAN
CDA01	DRAINAGE AREA MAP
CSD01	STORM SEWER PLAN
CSD02	UTILITY PROFILES
CWW01	WATER AND SEWER PLAN
CEC01	EROSION CONTROL PLAN
CEC02	EROSION CONTROL NOTES & DETAILS

RECORD DRAWING	
THESE RECORD DRAWINGS HAVE BEEN PREPARED BASED ON INFORMATION PROVIDED BY THE CONTRACTOR. THE ENGINEER SHALL NOT BE HELD RESPONSIBLE FOR ANY ERRORS OR OMISSIONS WHICH MAY BE INCORPORATED HEREIN AS A RESULT.	
 ENGINEER	<u>3/8/04</u> DATE

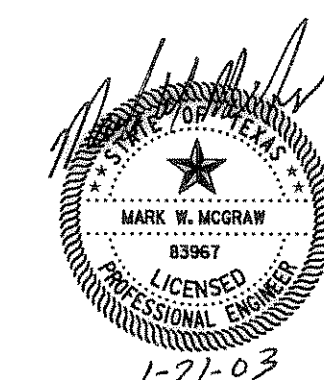

THE SEAL APPEARING ON THIS DOCUMENT WAS AUTHORIZED BY MARK W. MCGRAW, P.E. #83967 ON 1-21-2003. ALTERATION OF A SEALED DOCUMENT WITHOUT PROPER NOTIFICATION TO THE RESPONSIBLE ENGINEER IS AN OFFENSE UNDER THE TEXAS ENGINEERING PRACTICE ACT. THE RECORD COPY OF THIS DRAWING IS ON FILE AT THE OFFICE OF HALFF ASSOCIATES, INC. 8616 NORTHWEST PLAZA DRIVE, DALLAS, TEXAS 75225

7 03-08-04 RECORD DRAWINGS

RIDGE ROAD TOWN CENTRE – PHASE I