
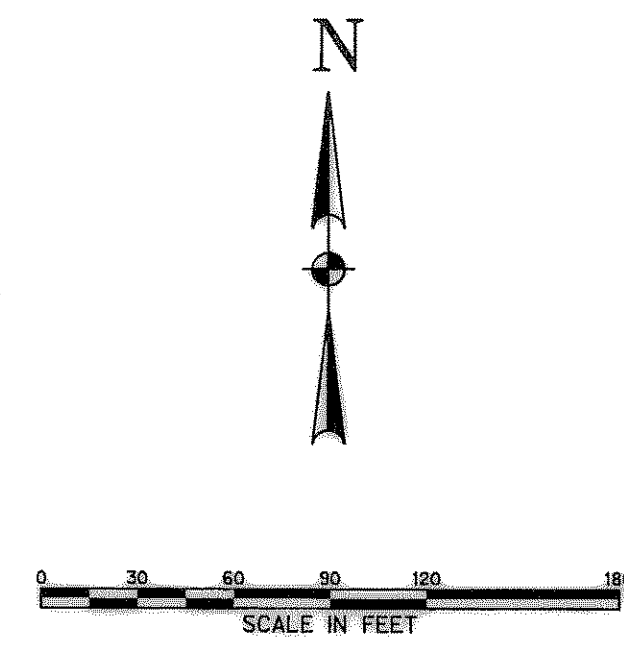
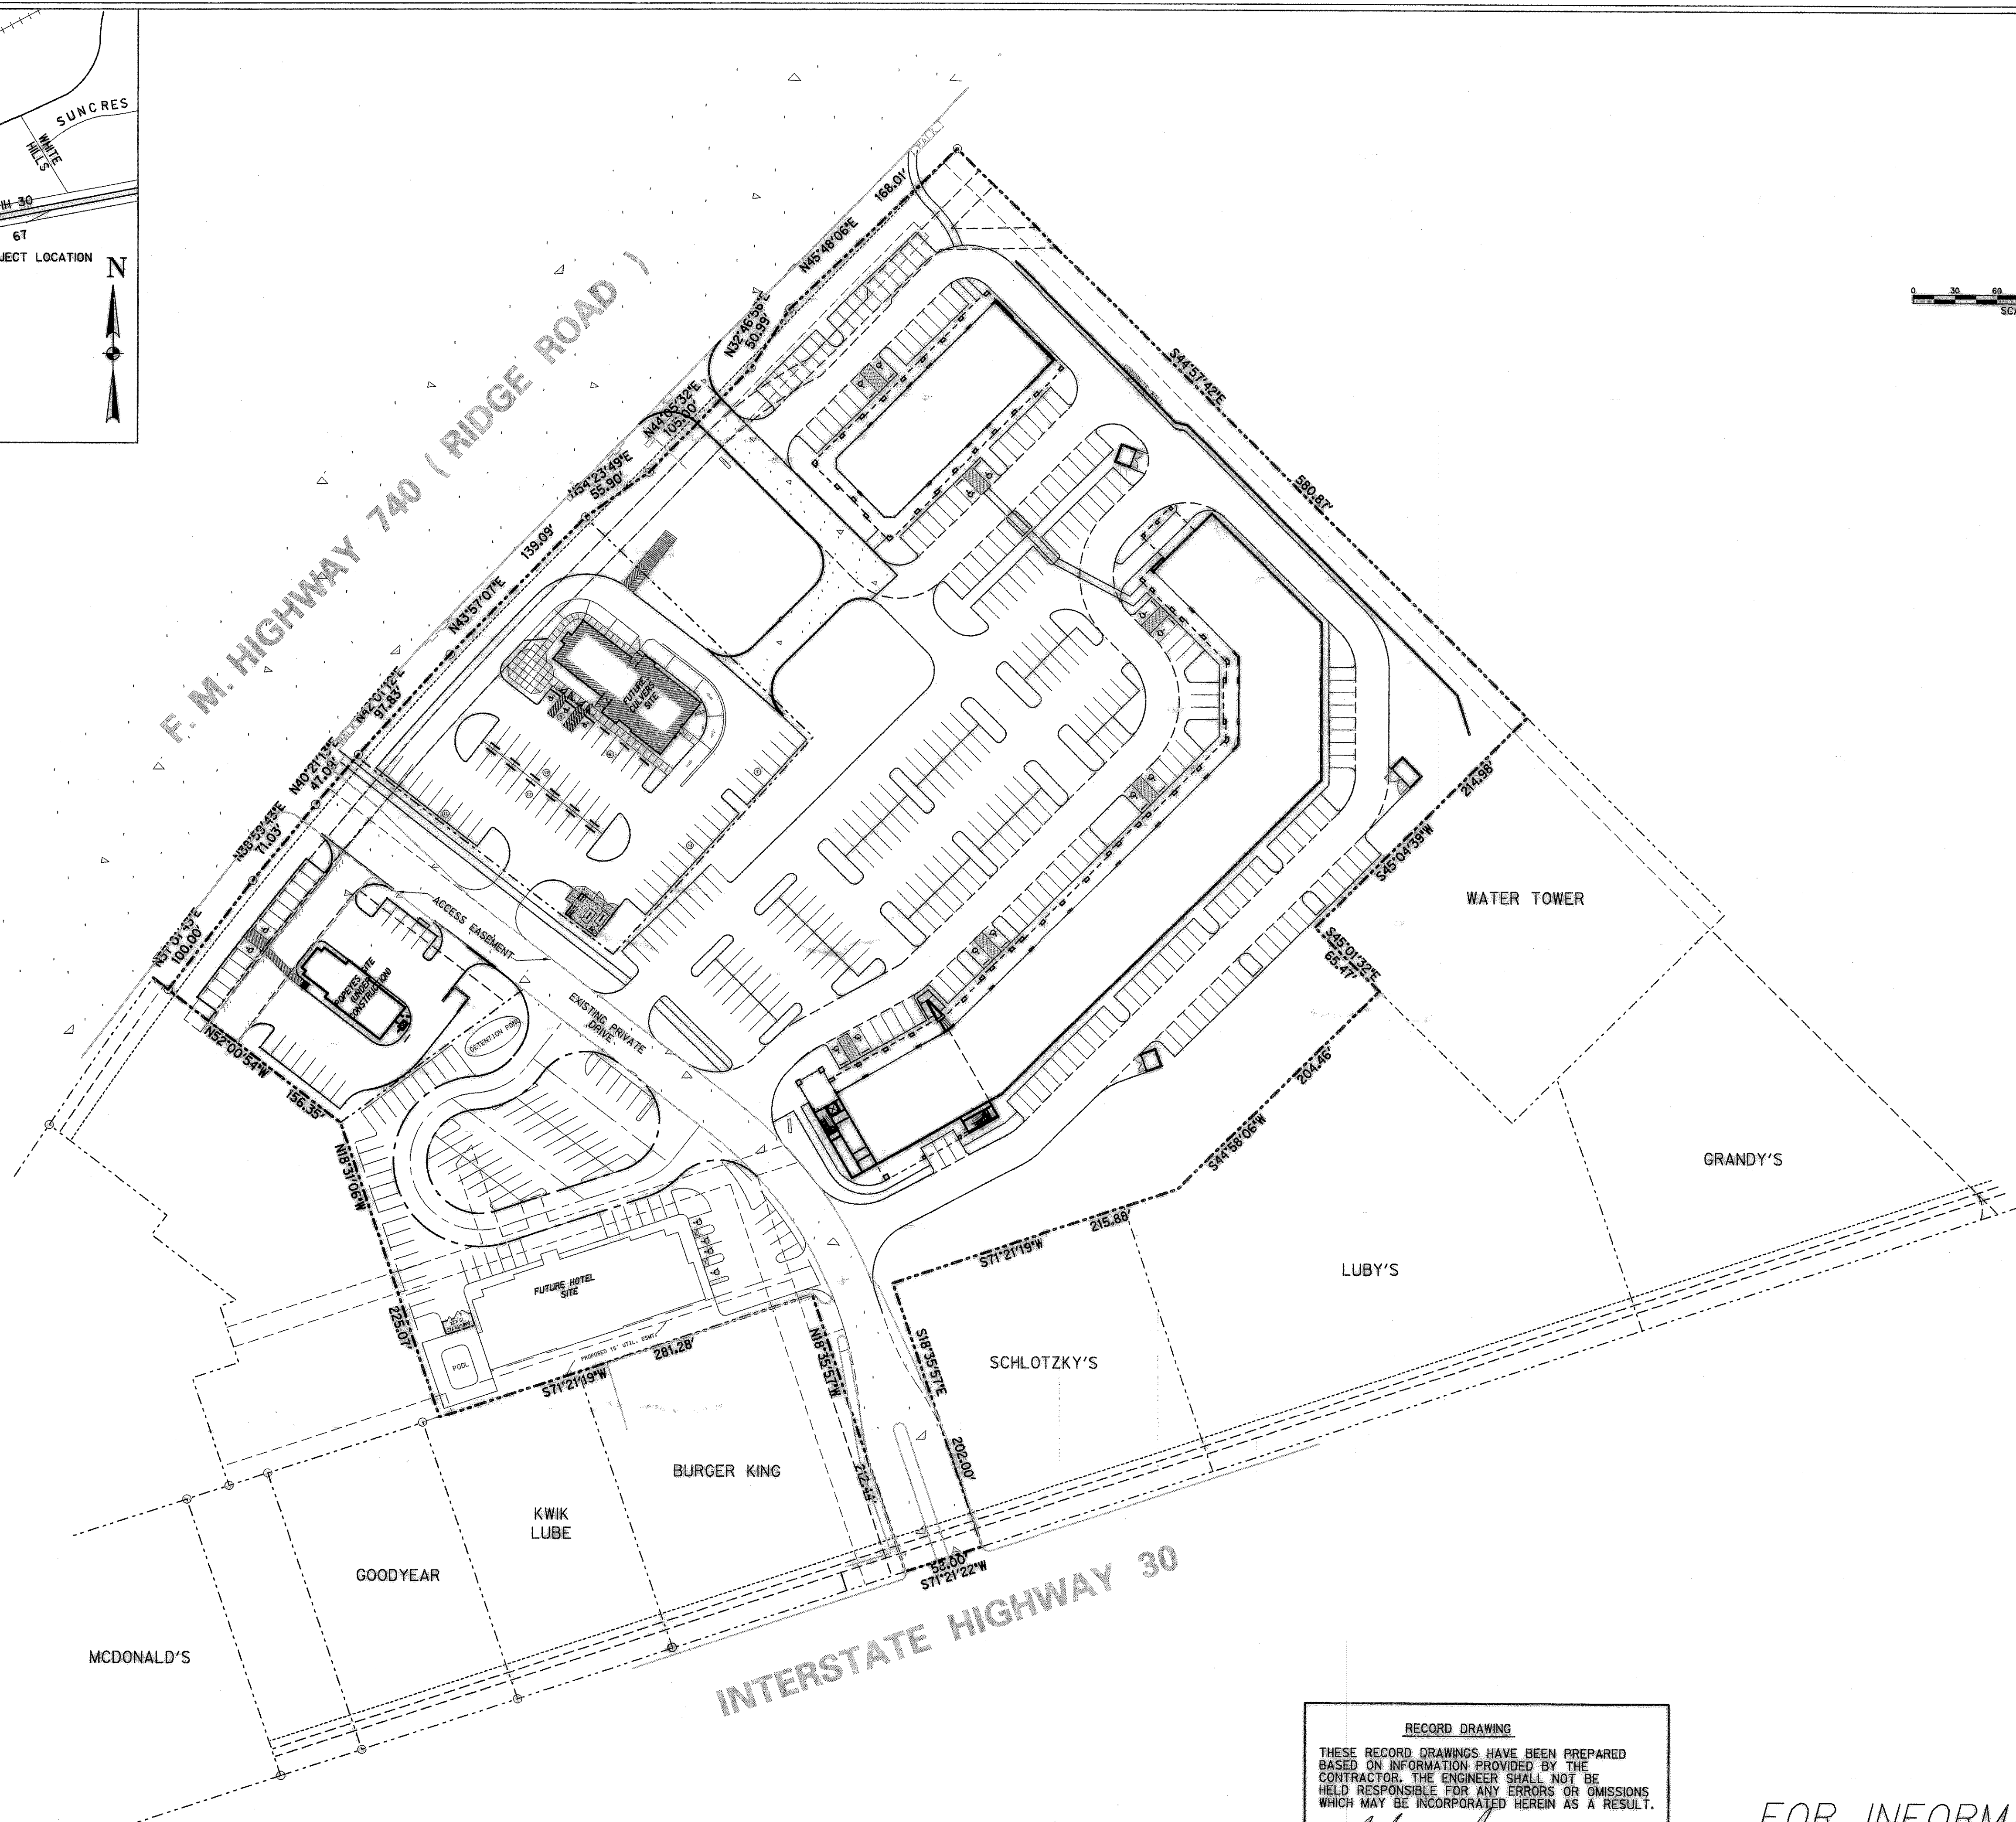


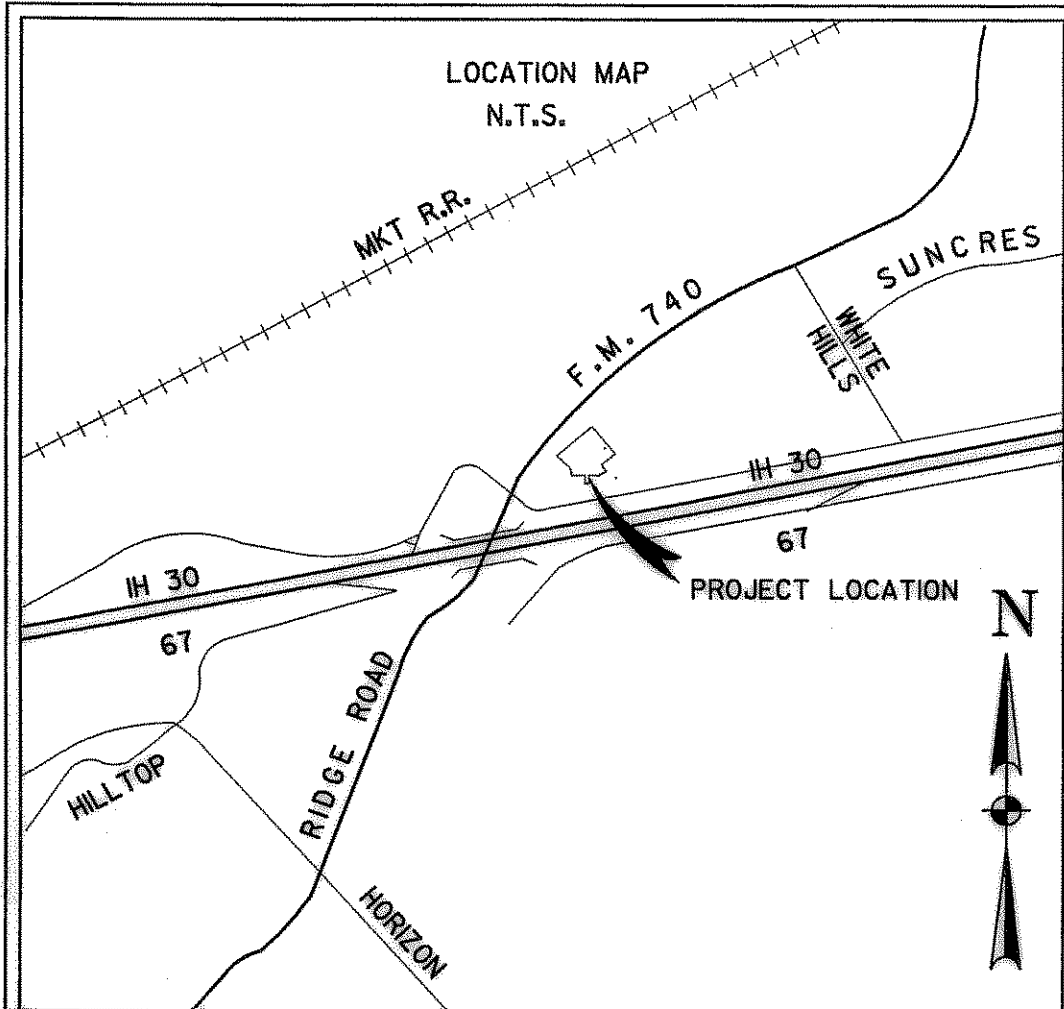

RECORD DRAWING

THESE RECORD DRAWINGS HAVE BEEN PREPARED
BASED ON INFORMATION PROVIDED BY THE
CONTRACTOR. THE ENGINEER SHALL NOT BE
HELD RESPONSIBLE FOR ANY ERRORS OR OMISSIONS
WHICH MAY BE INCORPORATED HEREIN AS A RESULT.

Mark W. McNew
ENGINEER


3/12/04
DATE

FOR INFORMATION ONLY

RIDGE ROAD
TOWN
CENTRE
ROCKWALL, TEXAS

Vigor
PROPERTIES INC.

Ridge Road Town Centre
Partners, L.P.
by its General Partners:
**RIDGE ROAD
PARTNERS L.L.C.**

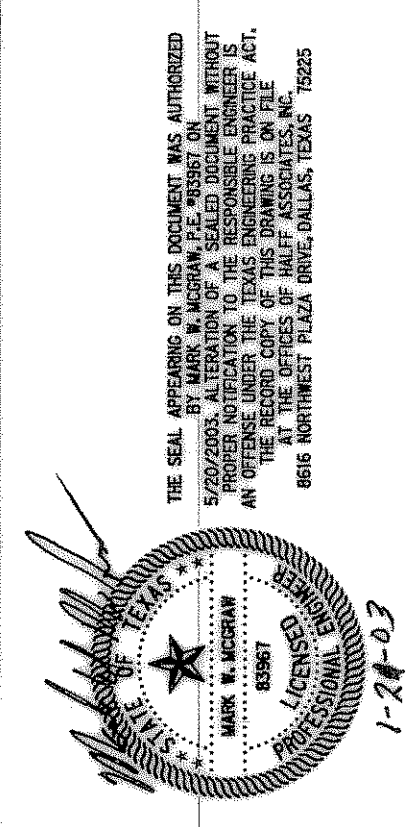

Halff Associates, Inc.
ENGINEERS • ARCHITECTS • SCIENTISTS • PLANNERS • SURVEYORS

866 NORTHWEST PLAZA DRIVE
DALLAS, TEXAS 75225
TEL (214) 746-6000
FAX (214) 759-4605

Project No:		AVO # 20633	
Issued:			
Revisions:			
No.	Date	Description	
1	8-05-02	FIRST SUBMITTAL	
2	9-25-02	SECOND SUBMITTAL	
3	10-30-02	THIRD SUBMITTAL	
4	12-10-02	FOURTH SUBMITTAL	
5	1-7-03	FIFTH SUBMITTAL	
6	1-21-03	SIXTH SUBMITTAL	

Drawn by:
Checked by:
Sheet Title
CONCEPT PLAN

CCP01