


EXISTING UNDERGROUND TELEPHONE LINE
ALONG S.E. ROW LINE OF FM 740. CONTRACTOR
TO USE EXTREME CARE AND CAUTION
WHILE WORKING IN THIS AREA. CONTRACTOR
SHALL CONTACT THE CITY OF ROCKWALL
48 HOURS PRIOR TO CONSTRUCTION

1. ALL UTILITIES ARE SHOWN SCHEMATICALLY AND ARE FOR THE CONTRACTORS GUIDANCE ONLY. THE UTILITIES HAVE BEEN SHOWN BASED ON INFORMATION PROVIDED BY THE CITY OF ROCKWALL. THE CONTRACTOR SHALL VERIFY THE LOCATION OF UTILITIES 48 HRS. PRIOR TO CONSTRUCTION.
2. ALL MATERIALS AND CONSTRUCTION SHALL CONFORM TO CITY OF ROCKWALL STANDARDS, SPECIFICATIONS AND DETAILS. ITEMS NOT INCLUDED OR ADDRESSED BY CITY OF ROCKWALL STANDARDS SHALL BE IN ACCORDANCE WITH N.C.T.C.O.G. STANDARD SPECIFICATIONS FOR PUBLIC WORKS CONSTRUCTION, LATEST REVISION.
3. ALL FILL SHALL BE COMPACTED TO 95% OF MAXIMUM DRY DENSITY TO WITHIN 6" OF SUBGRADE IN AREAS UNDER PAVING OR UNLESS OTHERWISE SPECIFIED, FILL TO BE COMPACTED W/ SHEEPS FOOT ROLLER.
4. ALL WORK WITHIN TxDOT R.O.W. SHALL BE PERFORMED IN ACCORDANCE WITH TxDOT SPECIFICATIONS & STANDARD DETAILS.



DOWELING DETAIL- DRIVEWAY CONNECTION TO FM740
N.T.S.

Mark
ENGINEER

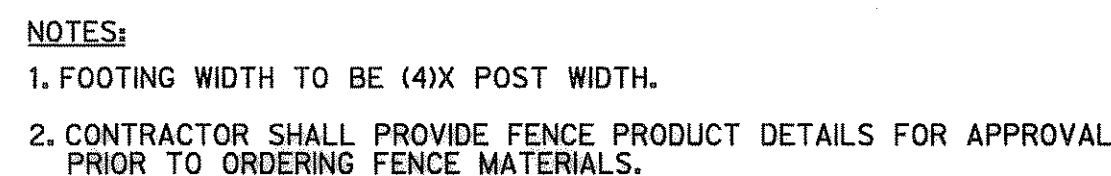


WROUGHT IRON FENCE DETAIL

N.T.S.



EXISTING PROPERTY LINE
EXISTING EASEMENT LINE
EXISTING WATER LINE
EXISTING SANITARY SEWER
EXISTING SAN SEWER MANHOLE
EXISTING STORM LINE
EXISTING DRAINAGE INLET
EXISTING POWER POLE
EXISTING GRADE LINE
WATER VALVE
FIRE HYDRANT
EXISTING UNDERGROUND TELEPHONE
EXISTING TELEPHONE MANHOLE
PROPOSED GRADE
PROPOSED WATER LINE
PROPOSED SANITARY SEWER
PROPOSED STORM LINE

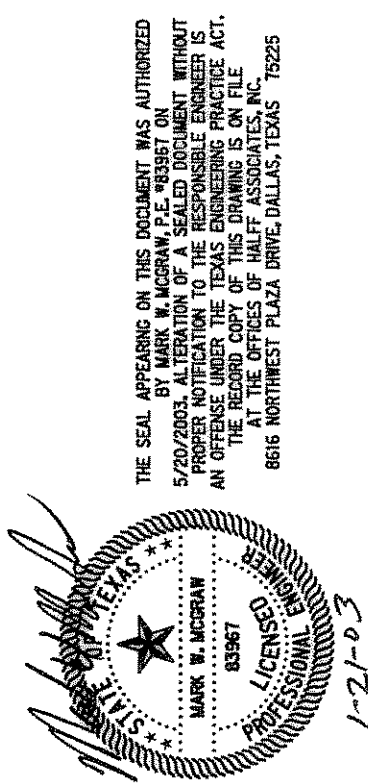

8616 NORTHWEST PLAZA DRIVE
DALLAS, TEXAS 75225
TEL (214) 346-6200
FAX (214) 739-0095

05001

Sheet Number

7 03-08-04 RECORD DRAWINGS