


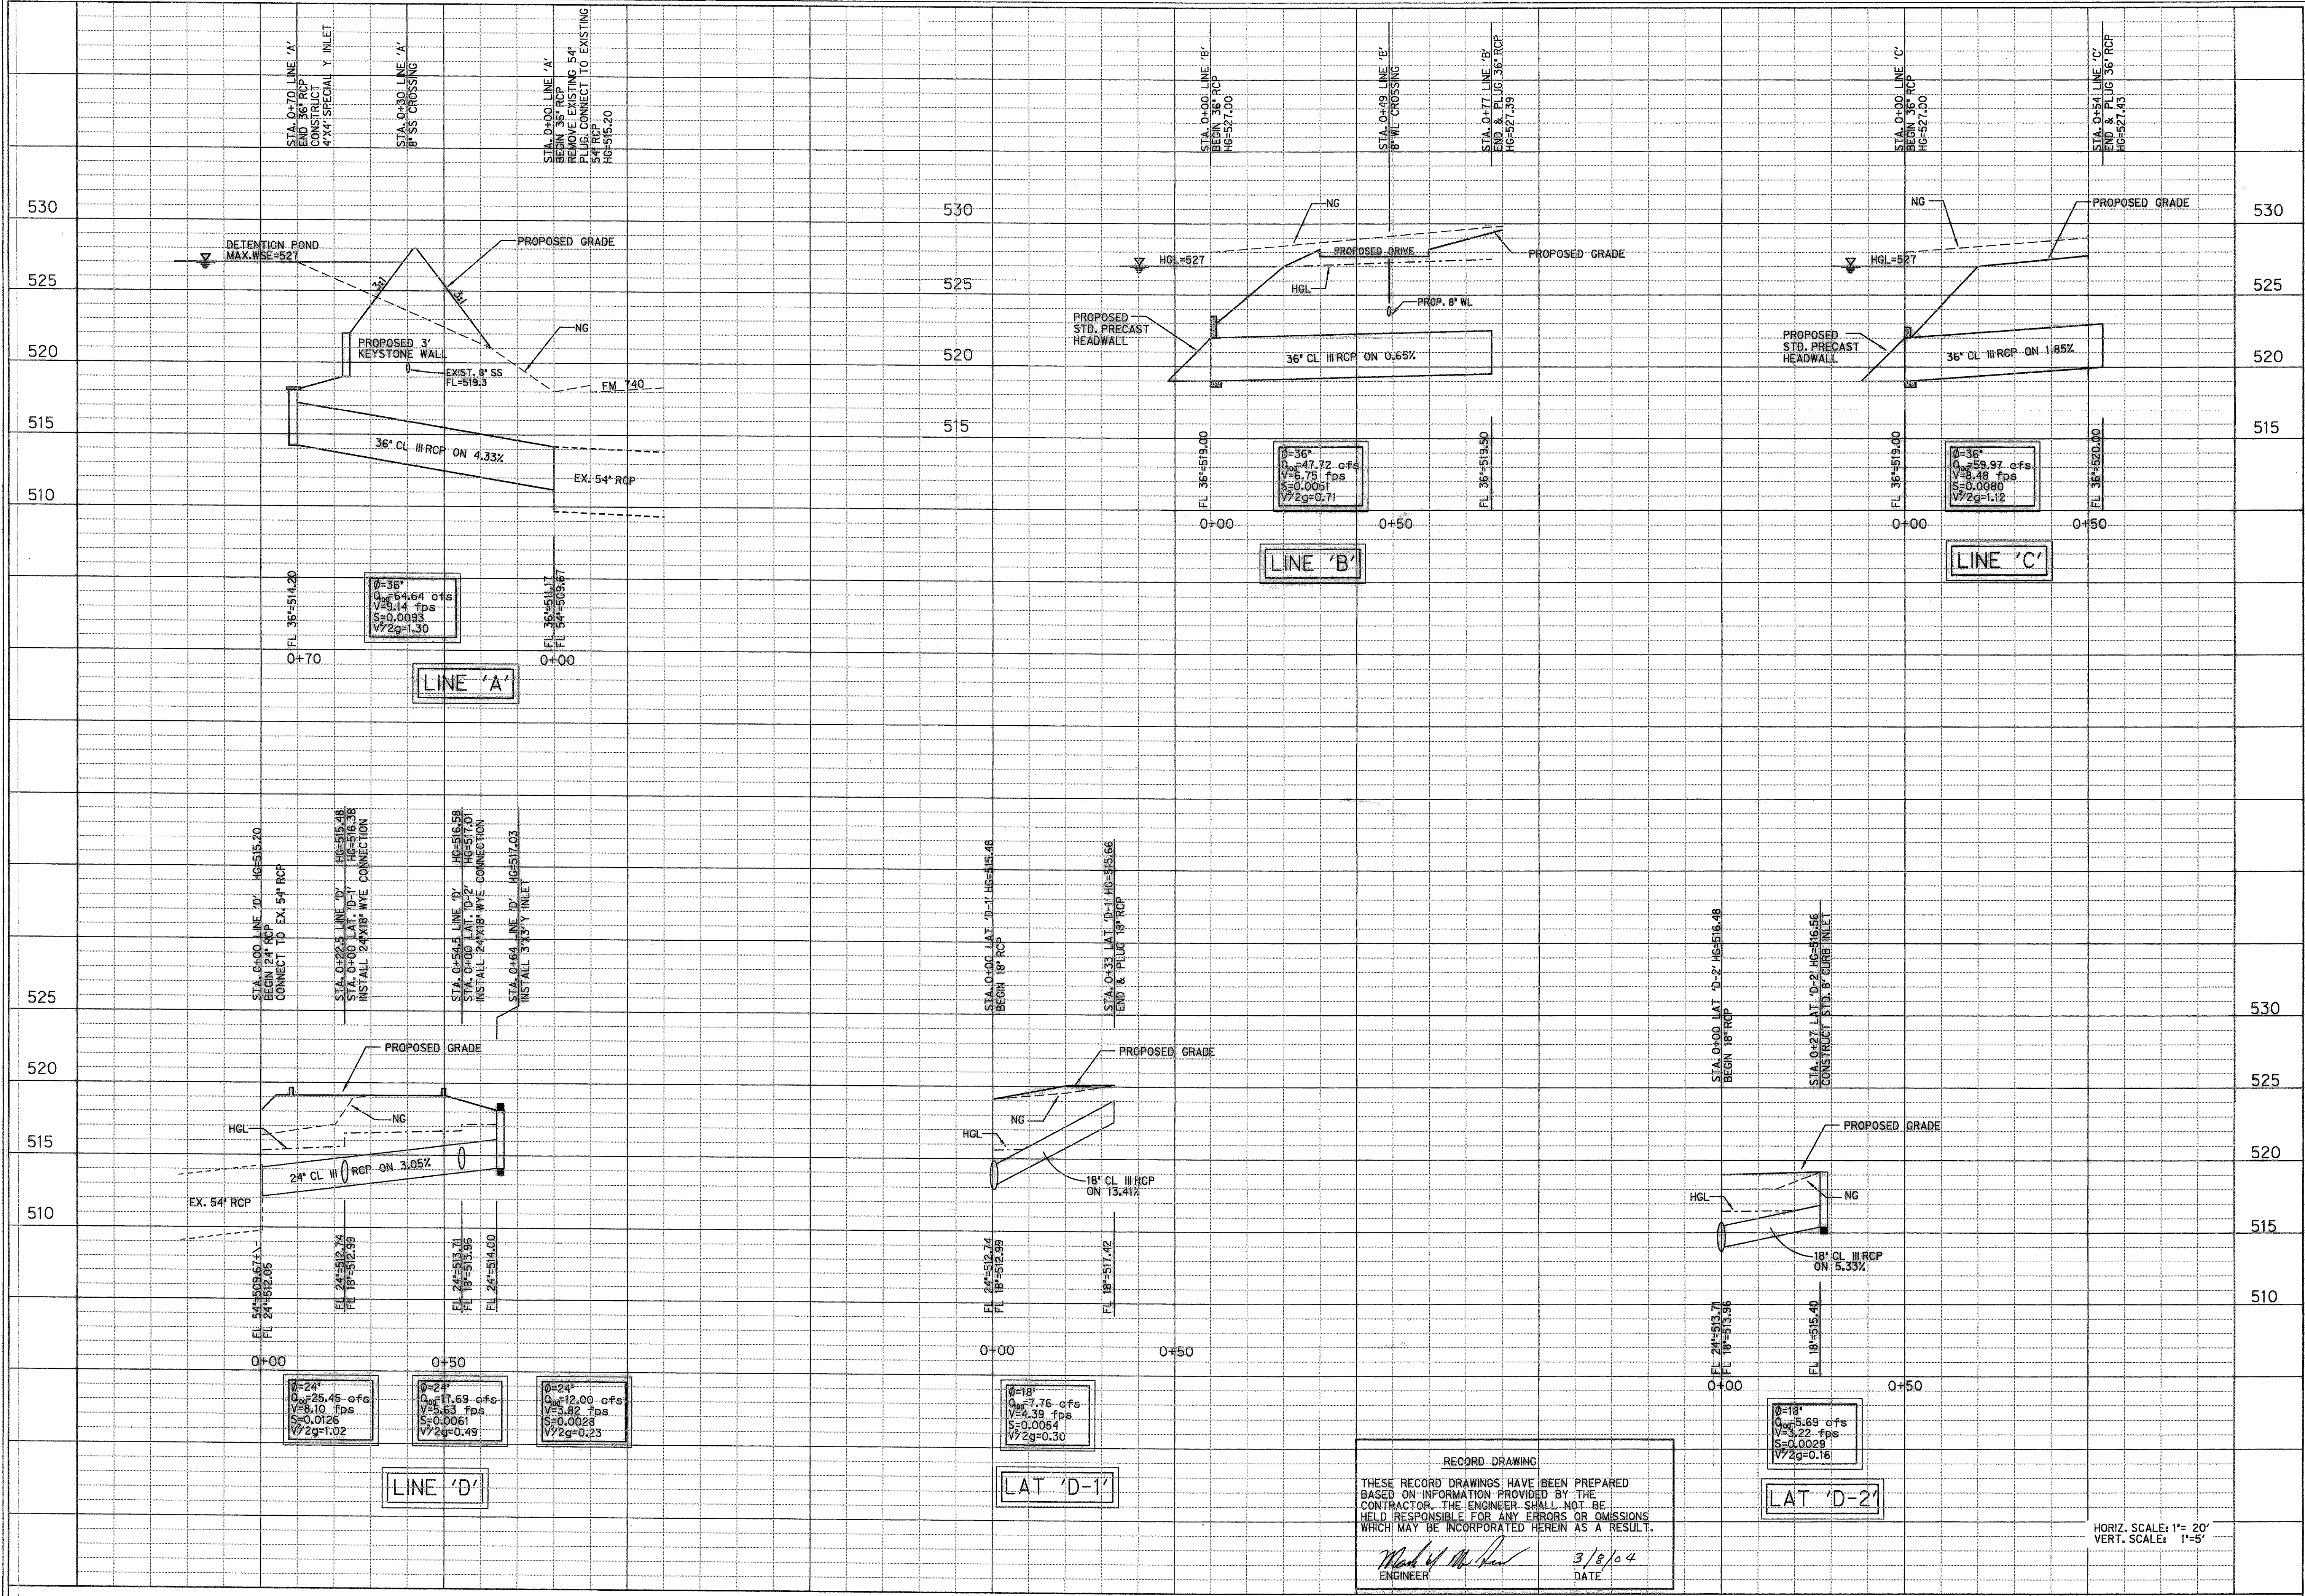

RIDGE ROAD
TOWN
CENTRE
ROCKWALL, TEXAS

Vigor
PROPERTIES INC.

Ridge Road Town Centre
Partners, L.P.
by its General Partners:
RIDGE ROAD
PARTNERS L.L.C.

THE SEAL APPEARING ON THIS DOCUMENT WAS AUTHORIZED BY THE BOARD OF SURVEYORS OF THE STATE OF TEXAS, DALLAS COUNTY, TEXAS, ON 1/21/03. IT IS HEREBY CERTIFIED THAT THE ENGINEER HAS COMPLETED THE WORK AND THAT THE DRAWING IS A TRUE AND CORRECT REPRESENTATION OF THE WORK DONE. THE SEAL OF THE ENGINEER IS NOT VALID WITHOUT THE SEAL OF THE BOARD OF SURVEYORS OF THE STATE OF TEXAS, DALLAS COUNTY, TEXAS, ON 1/21/03.

1-21-03

Half Associates, Inc.
ENGINEERS • ARCHITECTS • SCIENTISTS • PLANNERS • SURVEYORS
8616 NORTHWEST PLAZA DRIVE
DALLAS, TEXAS 75225
TEL (214) 346-0200
FAX (214) 759-0095

Project No: AVO # 20633
Issued: _____
Revisions:

No.	Date	Description
1	8-05-02	FIRST SUBMITTAL
2	9-25-02	SECOND SUBMITTAL
3	10-30-02	THIRD SUBMITTAL
4	12-10-02	FOURTH SUBMITTAL
5	1-7-03	FIFTH SUBMITTAL
6	1-21-03	SIXTH SUBMITTAL

Drawn by: _____
Checked by: _____
Sheet Title

UTILITY PROFILE