



N:\ROCKWALL.GM\PERMIT\9838QRD.DWG Mon Nov 20 16:11:05 2000 STATION=11 STD

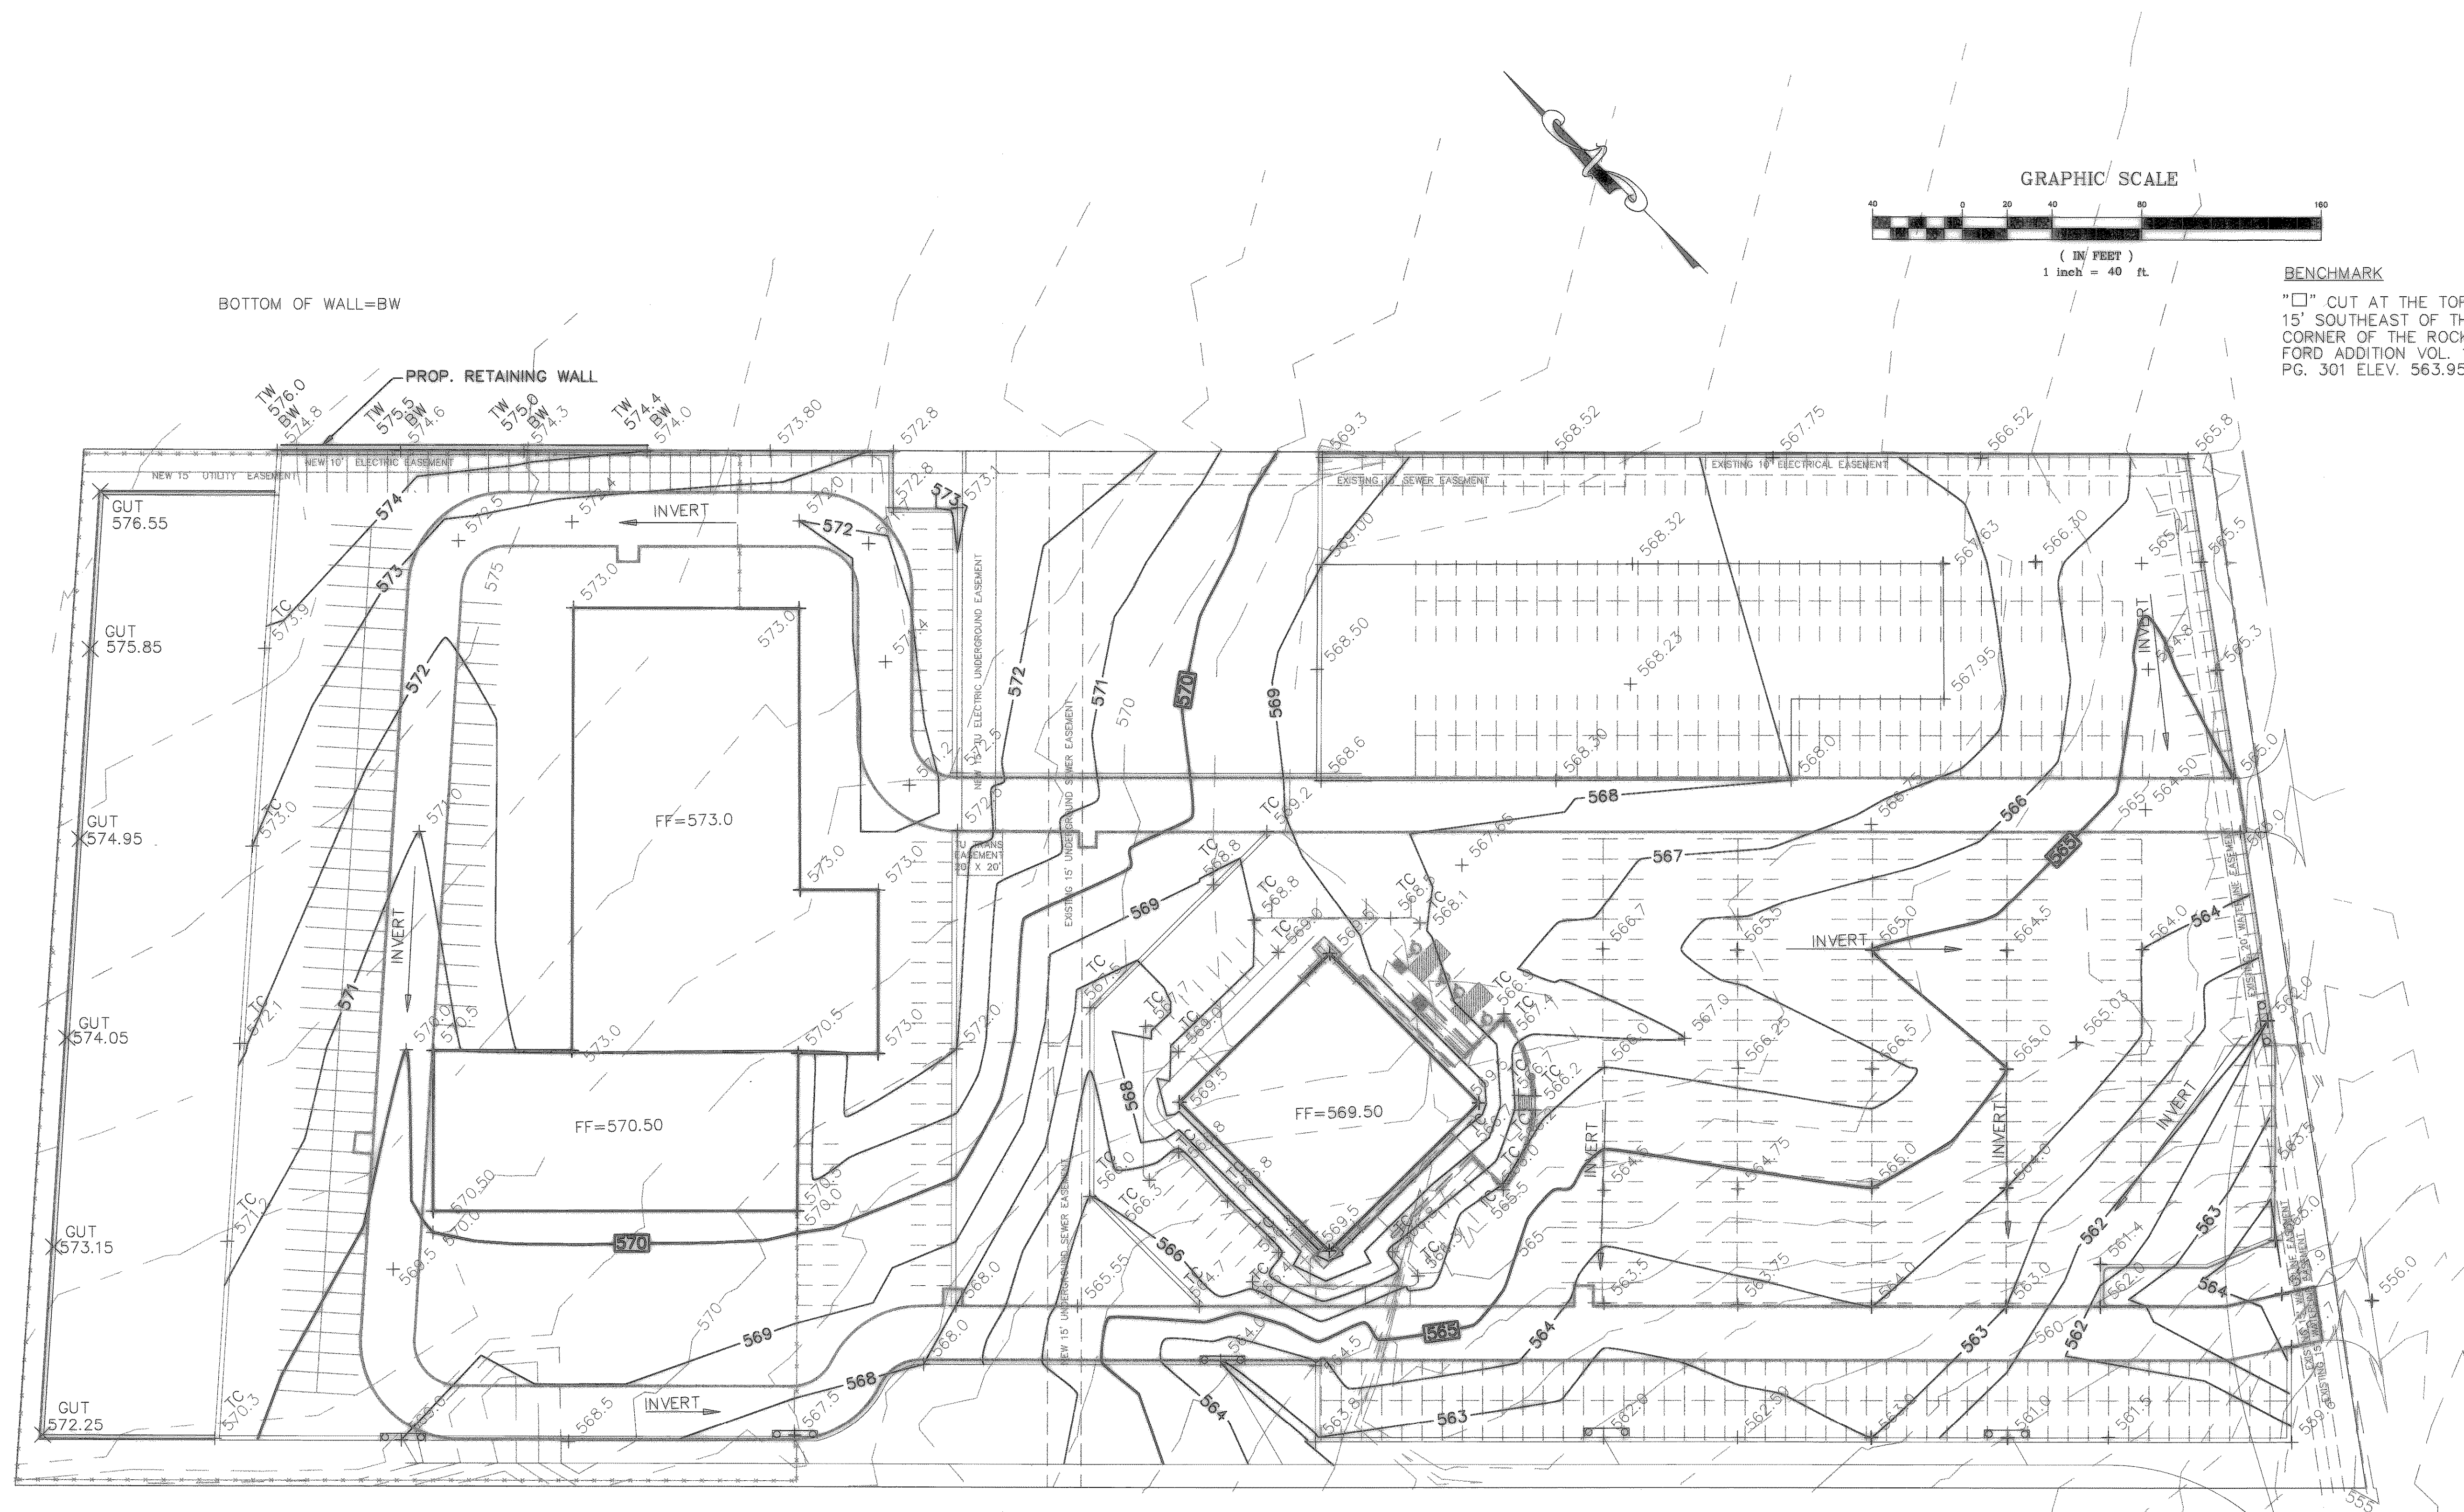


GRAPHIC SCALE

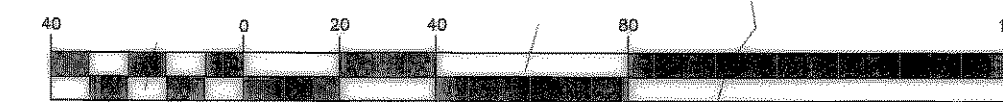

(IN/ FEET)
1 inch = 40 ft.

BENCHMARK

"□" CUT AT THE TOP OF CURB
15' SOUTHEAST OF THE EAST
CORNER OF THE ROCKWALL
FORD ADDITION VOL. 1375
PG. 301 ELEV. 563.95

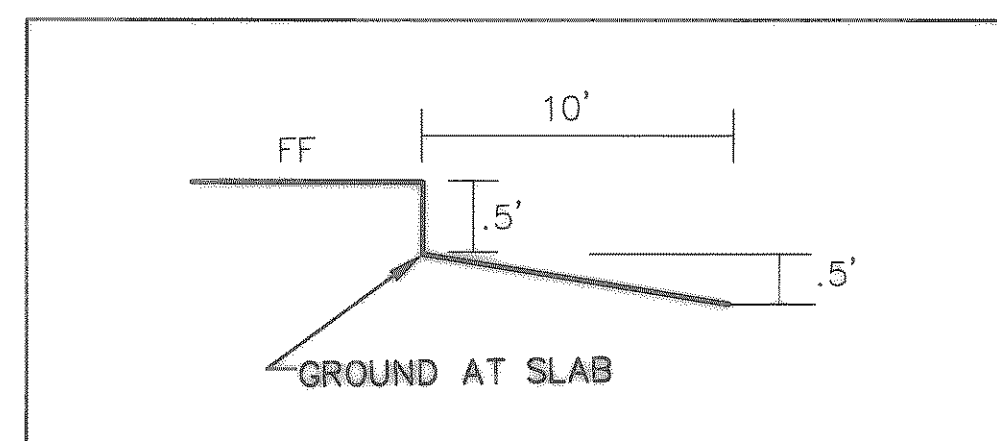

GRADING AROUND SLAB

LEGEND

- | | |
|--|-----------------------|
| | PROP. MAJOR CONTOURS |
| | PROP. MINOR CONTOURS |
| | EXIST. MAJOR CONTOURS |
| | EXIST. MAJOR CONTOURS |

DOUPHRADE & ASSOCIATES, INC.
2231 RIDGE RD., # 200 ROCKWALL, TEXAS 75087
PHONE: (972)771-9004 FAX: (972)771-9005

GRADING PLAN
ROCKWALL
FORD EXPANSION
ROCKWALL, ROCKWALL COUNTY, TEXAS

REVISION
W.L.D.
CHECKED
A.J.W.
DRAWN
6/15/99
DATE
9838QRD-C
PROJECT