


BENCHMARK
"□" CUT AT THE TOP OF CURE
15' SOUTHEAST OF THE EAST
CORNER OF THE ROCKWALL
FORD ADDITION VOL. 1375
PG. 301 ELEV. 563.95

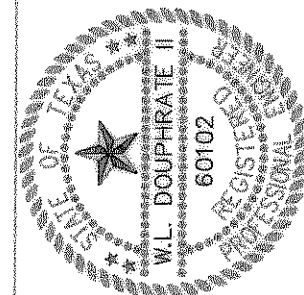

THE SEAL APPEARING ON THIS
DOCUMENT WAS AUTHORIZED BY
W.L. DOUPHRAITE II TEXAS P.E.
NO. 60102 ON

DOUPHRATE & ASSOCIATES, INC.

2231 RIDGE RD., # 200 ROCKWALL, TEXAS 75087
PHONE: (972)771-9004 FAX: (972)771-9005

LINE A & B
STORM SEWER
FORD EXPANSION
ROCKWALL, ROCKWALL COUNTY, TEXAS

REVISION

W.L.D.
CHECKED

A.J.W.

6/15/99

DATE _____

9838ST

1
OF
1