

CONSTRUCTION PLANS

MEDICAL OFFICE BUILDING

LOT 7, BLOCK A

PRESBYTERIAN HOSPITAL OF ROCKWALL ADDITION

AN ADDITION TO

THE CITY OF ROCKWALL, TEXAS

PLANS PREPARED FOR:

Lakeside Surgery Land Holdings, LLC
2003 Sleepy Hollow Lane
Heath, Texas 75032
(214)676-3099
Contact: Kate Makohon, MD


CIVIL ENGINEER

Brockette/Davis/Drake, Inc.
Texas Registered Engineering Firm F-841
4144 North Central Expressway
Suite 1100
Dallas, Texas 75204
(214)824-3647
Contact: Jim Riley


Sheet List Table	
SHEET NUMBER	SHEET TITLE
C1	COVER SHEET
C2	ALTA SURVEY
C3	DIMENSIONAL CONTROL PLAN
C4	PAVING PLAN
C5	GRADING PLAN
C6	DRAINAGE AREA MAP
C7	STORM SEWER PLAN
C8	EROSION CONTROL PLAN
C9	WATER & SANITARY SEWER PLAN
C10	SANITARY SEWER PROFILES
L1.0	LANDSCAPE PLAN

NOTES:

- ALL CONSTRUCTION SHALL BE DONE IN COMPLIANCE WITH STANDARD DETAILS AND SPECIFICATIONS FOR PUBLIC WORKS, NORTH CENTRAL TEXAS THIRD EDITION AND CITY OF ROCKWALL STANDARDS OF DESIGN AND CONSTRUCTION.
- ALL RESPONSIBILITY FOR ADEQUACY OF DESIGN REMAINS WITH THE DESIGN ENGINEER. THE CITY OF ROCKWALL, IN REVIEWING AND RELEASING PLANS FOR CONSTRUCTION, ASSUMES NO RESPONSIBILITY FOR ADEQUACY OR ACCURACY OF DESIGN.
- CONSTRUCTION START DATE SHALL BE SPRING, 2013.

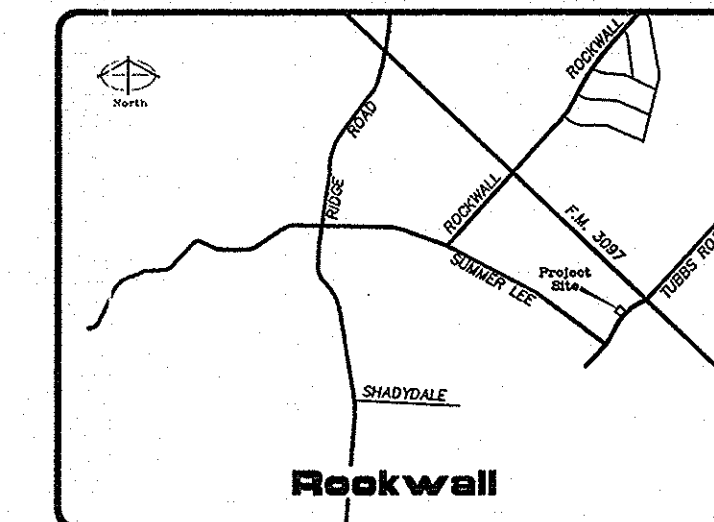

VICINITY MAP
(NOT TO SCALE)
MAPSCO: 300-K

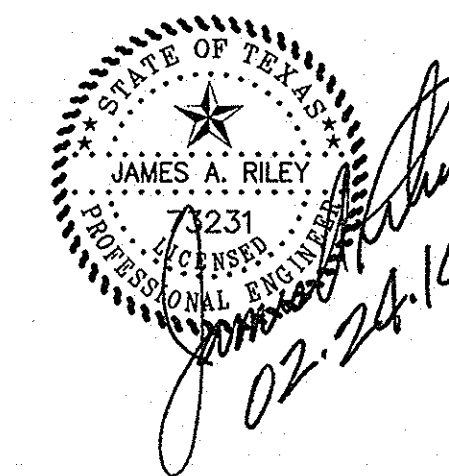

RECORD DRAWING

02/24/14

NOTE:
TO THE BEST OF OUR KNOWLEDGE BROCKETTE
DAVIS DRAKE, INC., HEREBY STATES THAT THIS
PLAN IS AS-BUILT. THIS INFORMATION PROVIDED
IS BASED ON SURVEYING AT THE SITE AND
INFORMATION PROVIDED BY THE CONTRACTOR.

No.	Revision	Date