

# MEDICAL OFFICES DEVELOPMENT

1.46 ACRES PORTION OF  
LOT 2, BLOCK "A" ROCKWALL ASSISTED LIVING ADDITION  
CITY OF ROCKWALL, ROCKWALL COUNTY, TX



No.	DATE	DESCRIPTION
1	05/25/2015	FINAL ASBUILT SUBMITTAL




MEDICAL OFFICE  
3018 RIDGE ROAD  
ROCKWALL, TEXAS

PROJECT No:	DATE:	DRAWN BY:	CHECKED BY:
13-035	06/25/2015	KP	KP

SHEET # **9.1** REVISION #

ASBUILT DRAWINGS:  
TO THE BEST OF OUR KNOWLEDGE TRIANGLE ENGINEERING LLC, HEREBY STATES THAT THIS PLAN IS ASBUILT. THE INFORMATION PROVIDED IS BASED ON SURVEYING AT THE SITE AND INFORMATION PROVIDED BY THE CONTRACTOR.

KARTAVYA S. PATEL P.E. NO. 97534

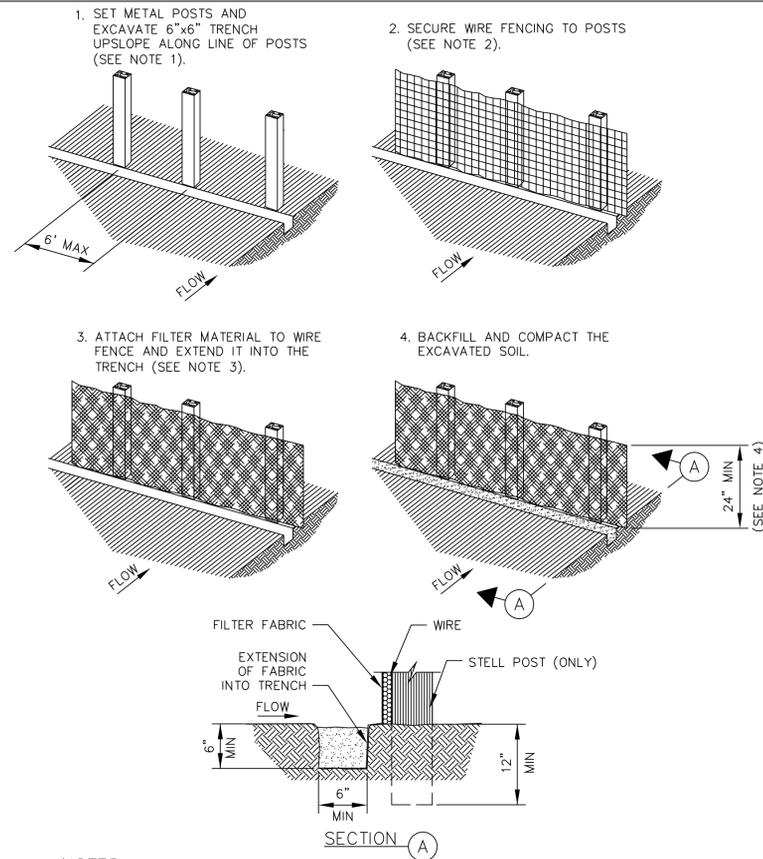


### NOTES

1. SET STEEL POST (ONLY) SPACE A MAX OF 6 FEET APART AND EMBEDDED A MIN OF 12 INCHES.
2. WOVEN WIRE FENCE TO BE FASTENED SECURELY TO FENCE POSTS WITH STAPLES.
3. FILTER CLOTH TO BE FASTENED SECURELY TO WOVEN WIRE FENCE, WITH TIES SPACED EVERY 24 INCHES AT TOP AND MIDSECTION.
4. MINIMUM HEIGHT OF FILTER SHOULD BE 24 INCHES AND A MAXIMUM OF 36 INCHES ABOVE NATURAL GROUND.
5. WHEN TWO SECTIONS OF FILTER CLOTH ADJOIN EACH OTHER THEY SHALL BE OVERLAPPED 6 INCHES AT THE POSTS AND FOLDED.


**1** SILT FENCE DETAILS  
9.1 N.T.S.

### STABILIZED CONSTRUCTION ENTRANCE GENERAL NOTES

1. STABILIZED CONSTRUCTION ENTRANCES SHALL CONFORM TO CITY OF ROCKWALL CRITERIA MANUAL.
  2. STONE SIZE SHALL BE 4" - 8" OPEN GRADED ROCK (NO CRUSHED CONCRETE ALLOWED).
  3. THICKNESS OF CRUSHED STONE PAD TO BE NOT LESS THAN 12".
  4. LENGTH SHALL BE A MINIMUM OF 50' FROM ACTUAL ROADWAY, AND WIDTH NOT LESS THAN FULL WIDTH OF INGRESS/EGRESS.
  5. ENTRANCE SHALL BE PROPERLY GRADED TO PREVENT RUNOFF FROM LEAVING THE CONSTRUCTION SITE.
- THE ENTRANCE SHALL BE MAINTAINED IN A CONDITION WHICH WILL PREVENT TRACKING OR FLOWING OF SEDIMENT ONTO PUBLIC RIGHTS OF WAY. ALL SEDIMENT SPILLED, DROPPED, WASHED OR TRACKED ONTO PUBLIC RIGHTS OF WAY MUST BE REMOVED IMMEDIATELY BY CONTRACTOR. AS NECESSARY, WHEELS MUST BE CLEANED TO REMOVE SEDIMENT PRIOR TO ENTRANCE ONTO PUBLIC RIGHT OF WAY. WHEN WASHING IS REQUIRED, IT SHALL BE DONE ON AN AREA STABILIZED WITH CRUSHED STONE WHICH DRAINS INTO AN APPROVED SEDIMENT TRAP OR SEDIMENT BASIN. ALL SEDIMENT SHALL BE PREVENTED FROM ENTERING ANY STORM DRAIN, DITCH OR WATERCOURSE USING APPROVED METHODS.

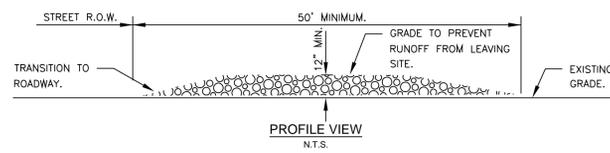


**4** CONSTRUCTION ENTRANCE DETAILS  
9.1 N.T.S.

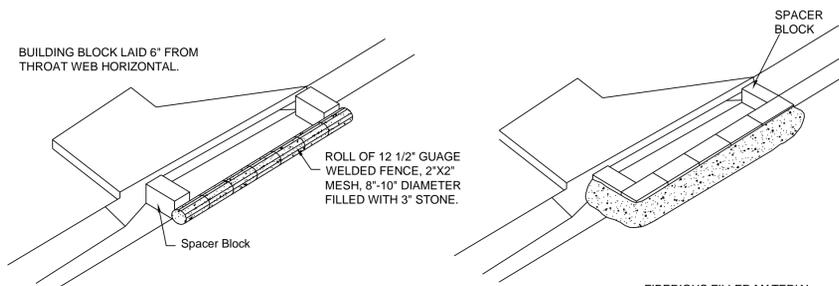

### NOTES:

1. FIBEROUS FILLER MATERIAL IN FRONT OF BLOCK PREVENTS GRAVEL FROM WASHING INTO STRUCTURE.
2. 2"x4" BEHIND BLOCK AND ACROSS THROAT HELPS KEEP BLOCK IN PLACE. PLACE IN OUTER HOLE OF SPACER BLOCK.
3. BALES OF HAY AND SOD, SIMILARLY PLACED, MAY ALSO BE USED.

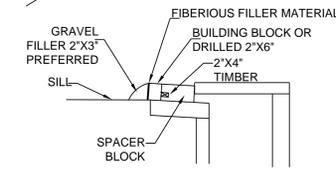

**3** CURB INLET PROTECTION DETAILS  
9.1 N.T.S.

\*ALL RESPONSIBILITY FOR ADEQUACY OF DESIGN REMAINS WITH THE DESIGN ENGINEER. THE CITY OF ROCKWALL, IN REVIEWING AND RELEASING PLANS FOR CONSTRUCTION, ASSUMES NO RESPONSIBILITY FOR ADEQUACY OR ACCURACY OF DESIGN.\*