
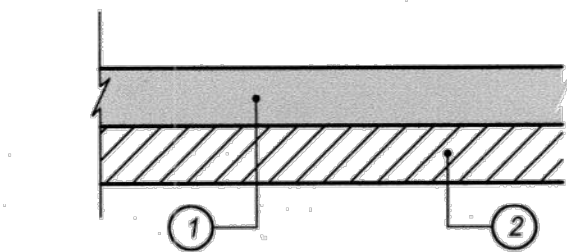




I.H.-30 EAST BOUND ACCESS ROAD

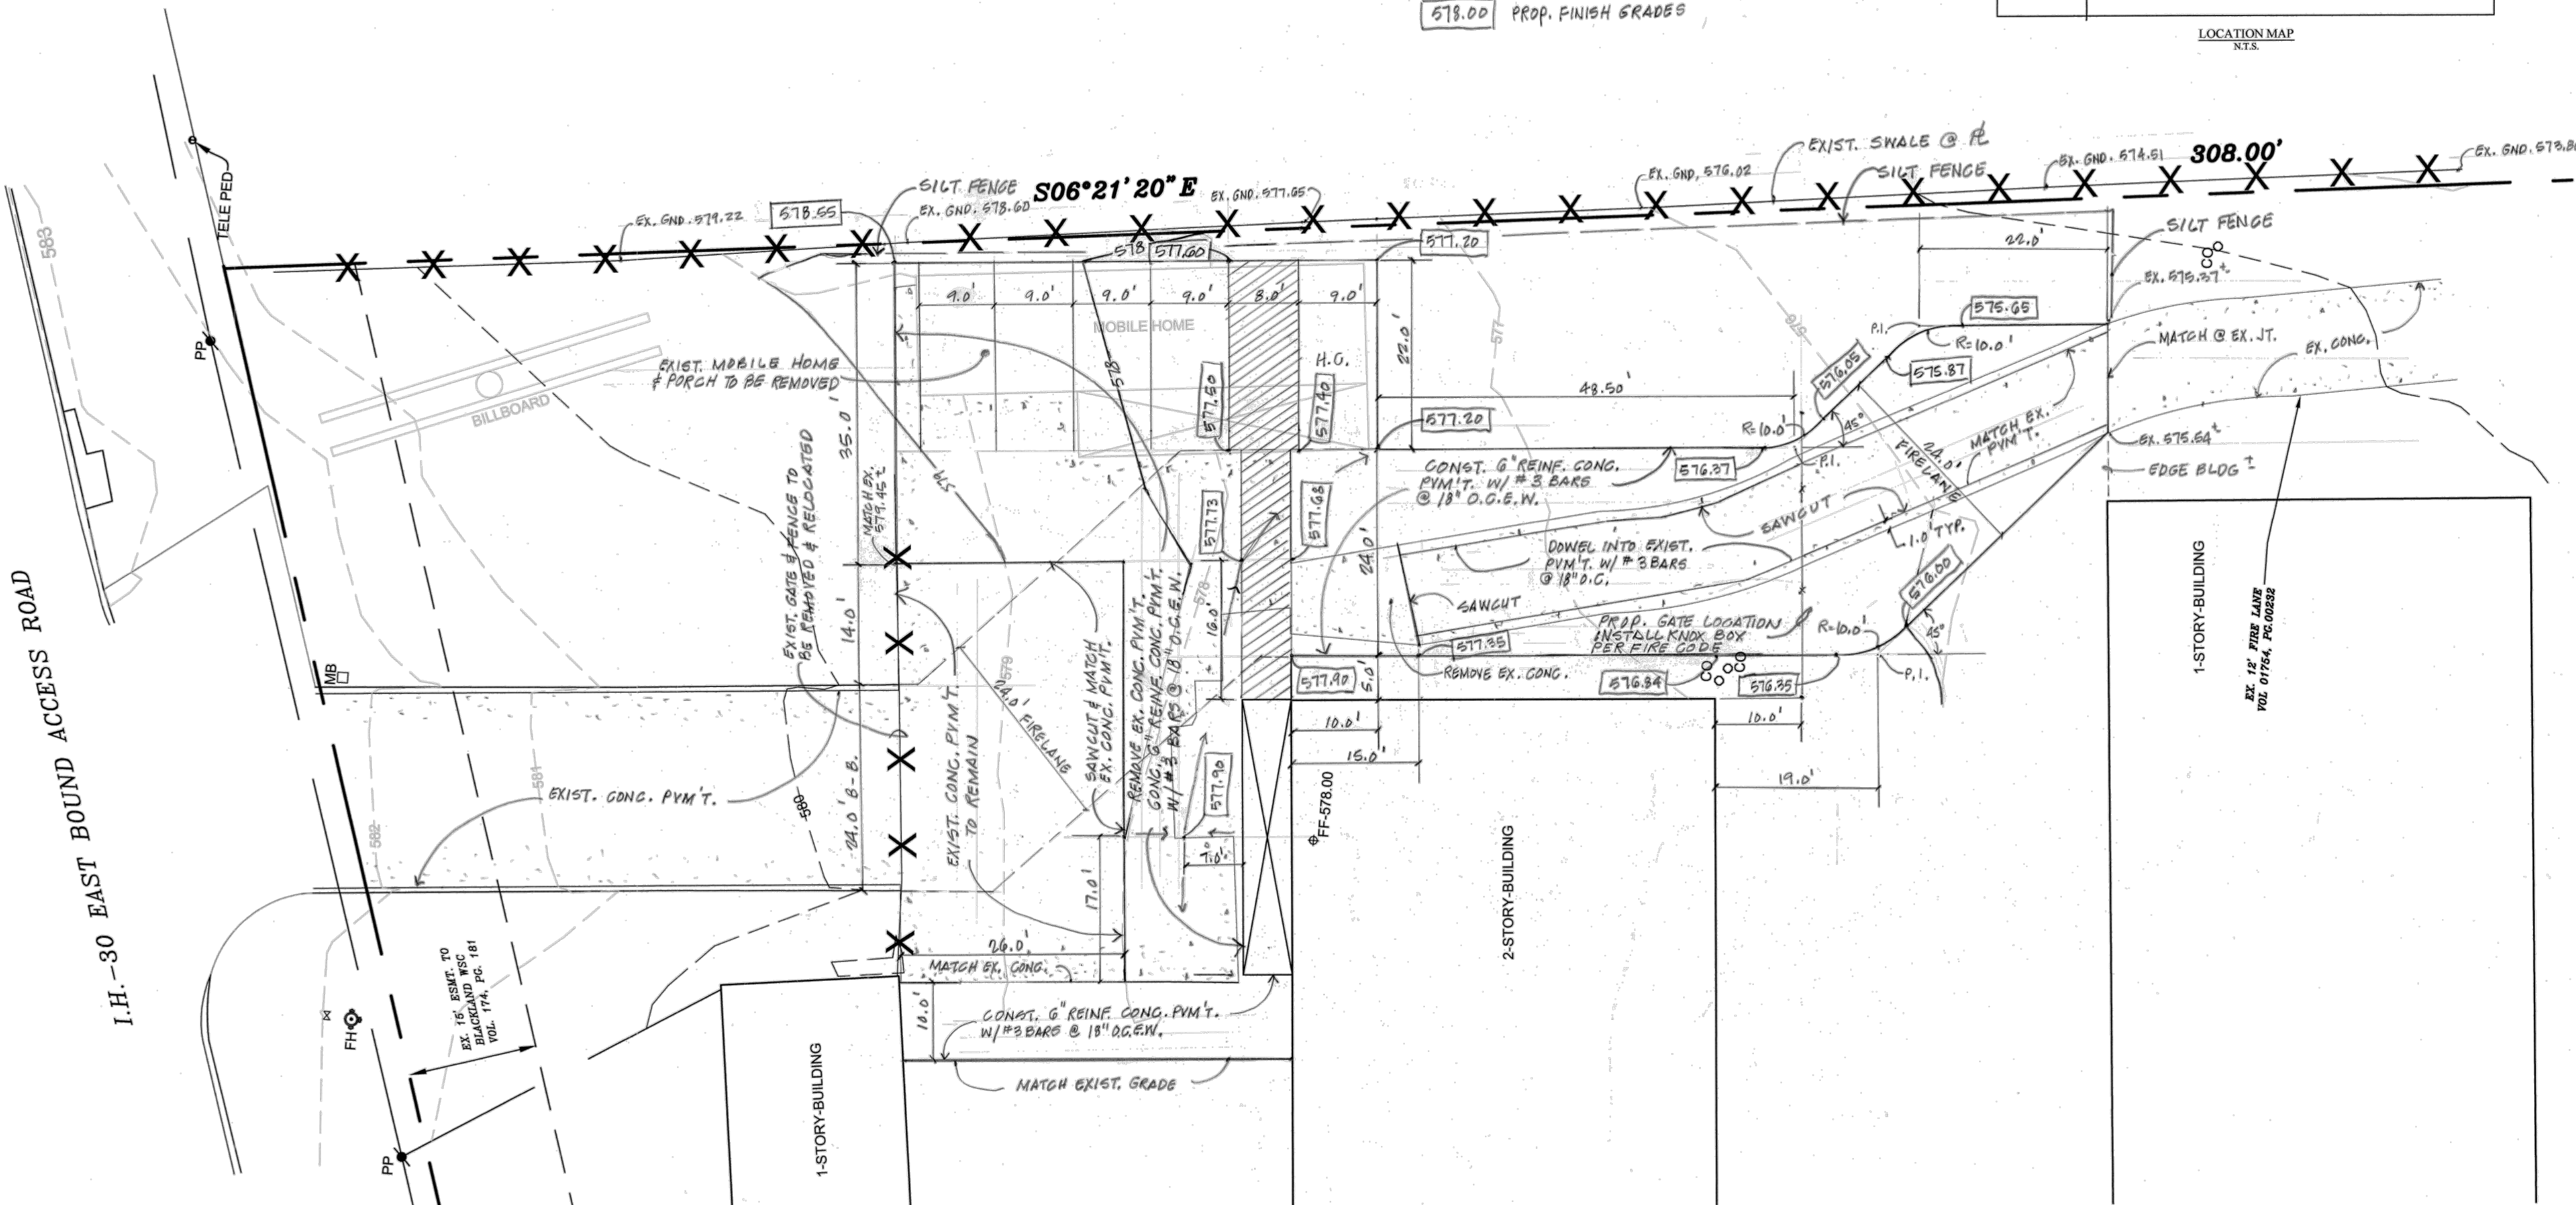

PARKING AREA PAVEMENT SECTION
NTS

- 6"-3,600 PSI CONCRETE PAVEMENT WITH NO. 3 BARS 18" ON CENTER BOTH WAYS. (6 SACK MIN. FOR MACHINE PLACE, 6.5 SACK MIN. FOR HAND PLACE)
- 6" COMPACTED LIME STABILIZED SUBGRADE. SCARIFY 6" DEEP AND COMPACT TO A STANDARD PROCTOR MAXIMUM DRY DENSITY NOT LESS THAN 95% AND WITHIN 2% BELOW AND 5% ABOVE OPTIMUM MOISTURE CONTENT. NO SAND ALLOWED. ALL GENERAL FILL TO BE COMPACTED WITH A SHEEP'S FOOT ROLLER.

578.00 PROP. FINISH GRADES

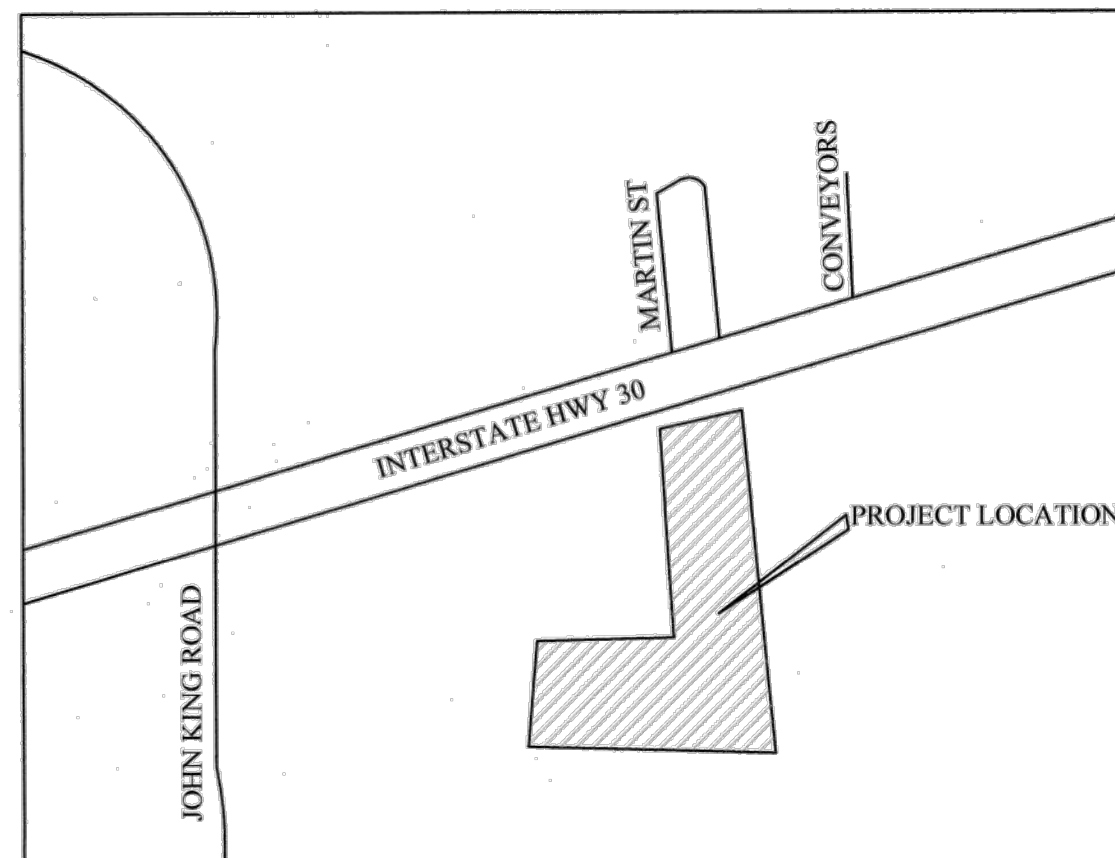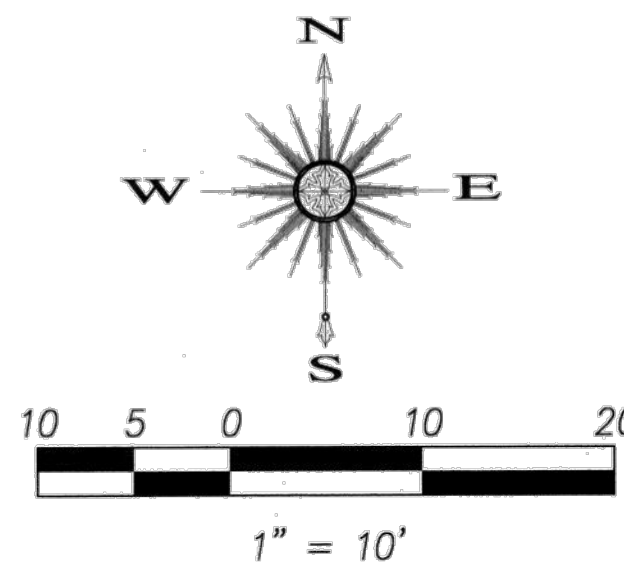

LOCATION MAP
N.T.S.


Revision	Date	Description

Owner:

DA Thacker, LLC. and Joshua Alan Thacker
P.O. Box 8693 • Greenville, TX 75404

ROCKWALL MINI STORAGE
I-30 EAST
Rockwall, Texas

Civil Engineer ~
F.C. CUNY CORPORATION
#2 Horizon Court • Heath, Texas 75032 • (409) 402-7700
Texas Registered Engineering Firm F-7449

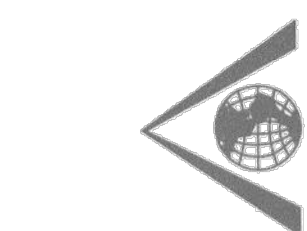

12/6/2017



Drawn By: F.C. CUNY	Checked By: F.C. CUNY
Date: 04/17	Project No.: -
Sheet Title: Site and Grading Plan	
Scale: 1"=10'	Sheet No.: 1 of 1

This drawing is proprietary and may not be copied or used in any way without the written permission of FC Cuny Corporation - © Copyright - FC Cuny Corporation

RECORD DRAWING