
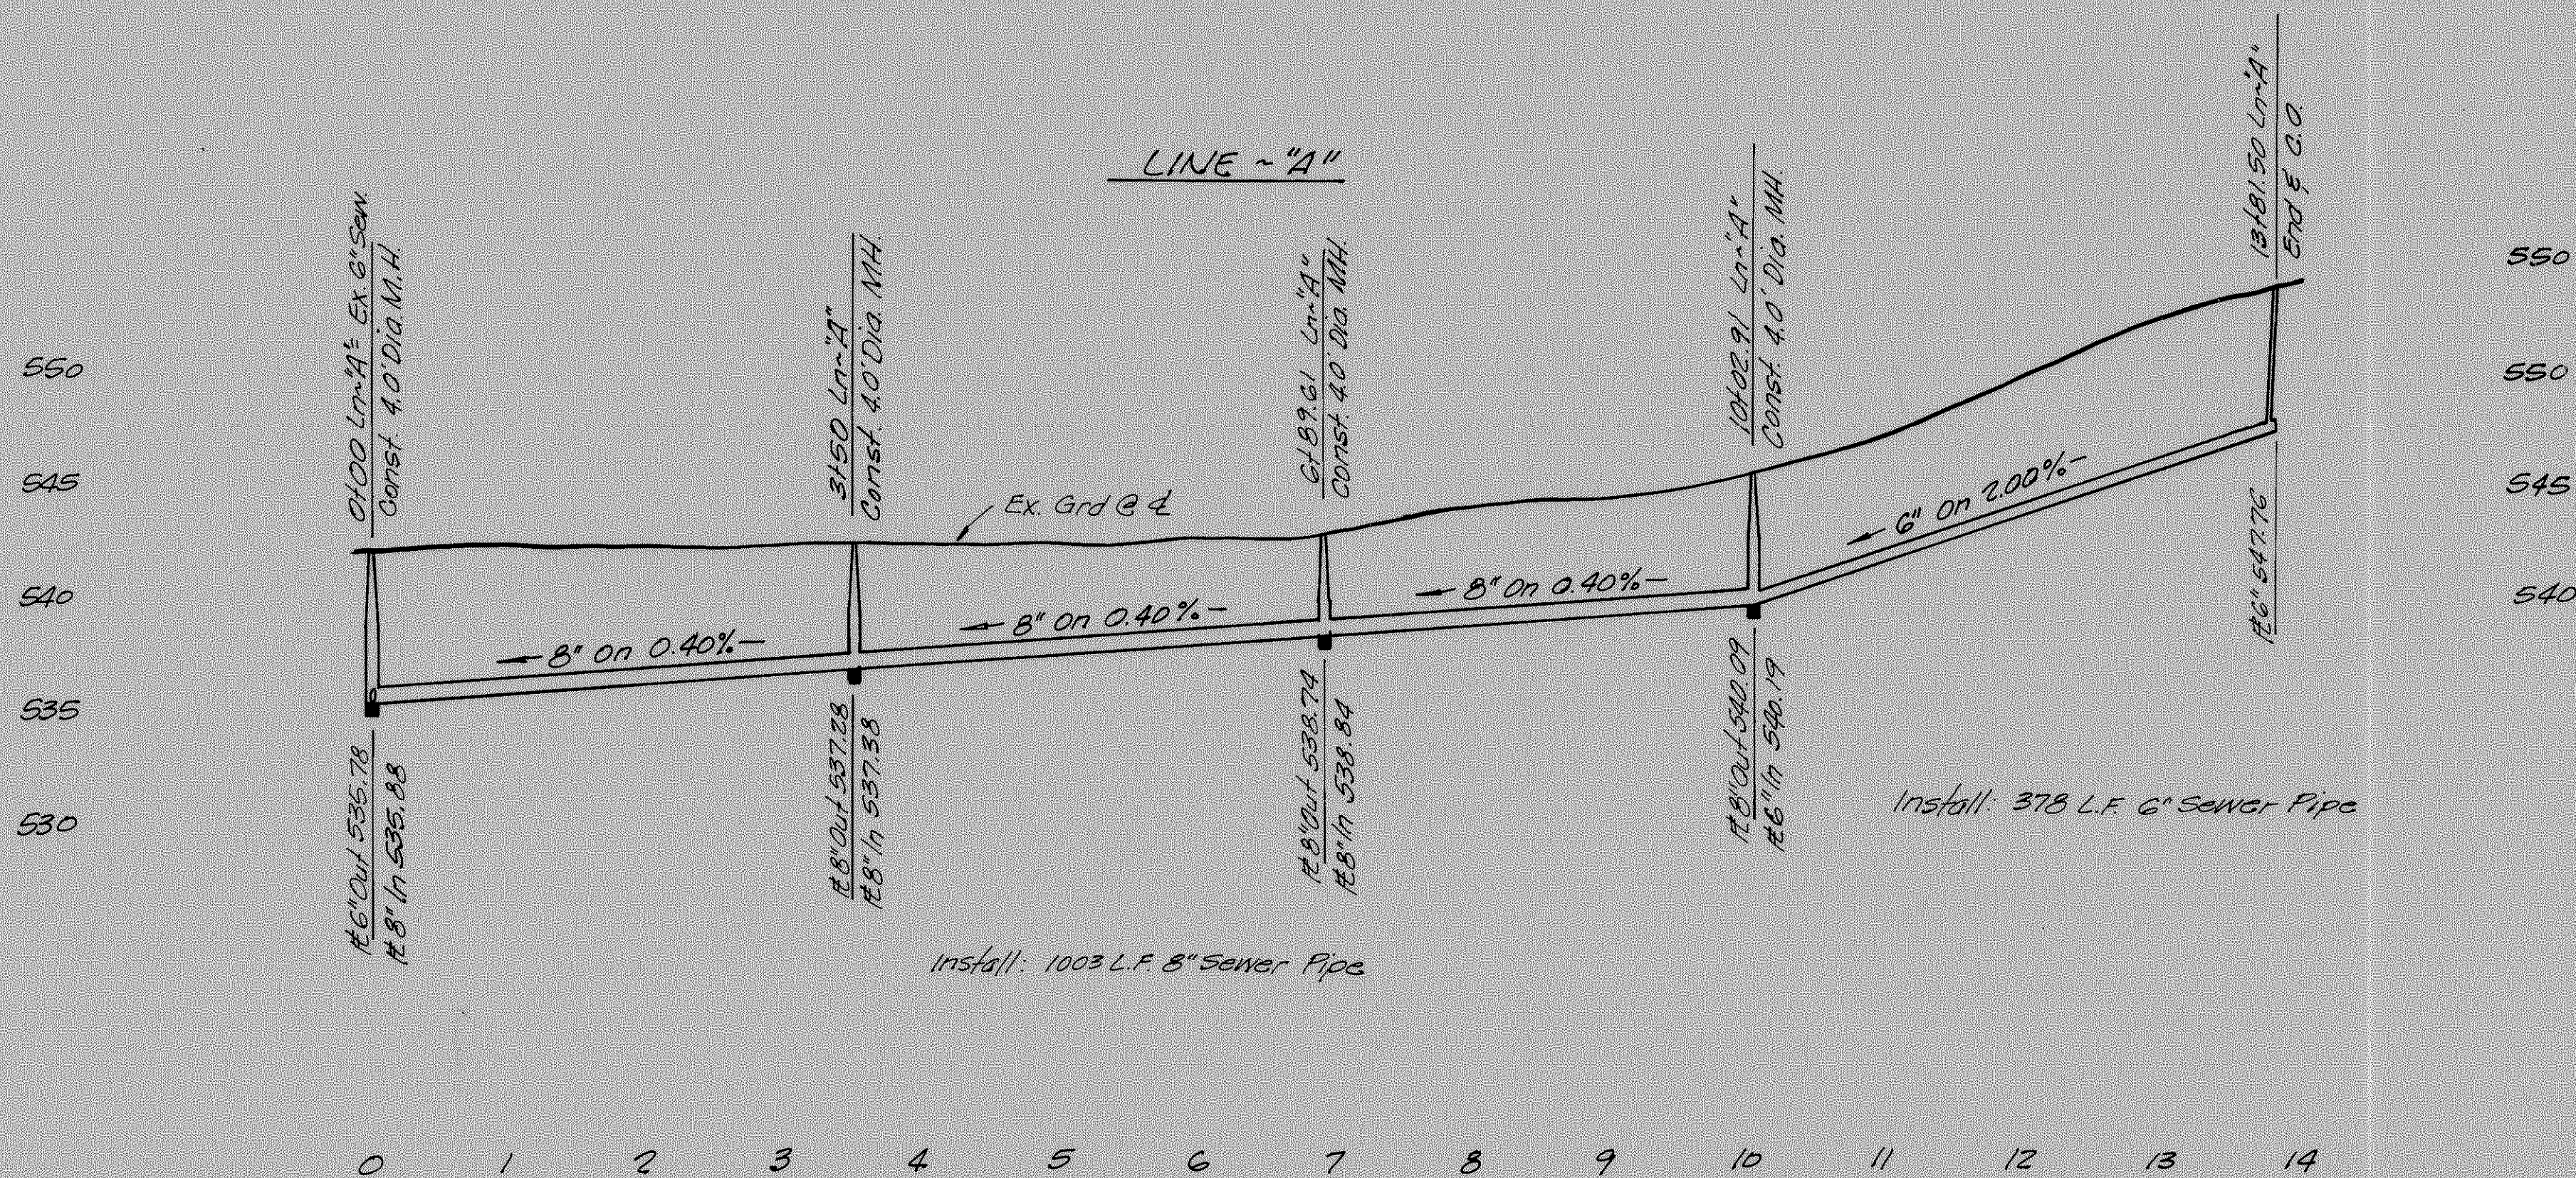


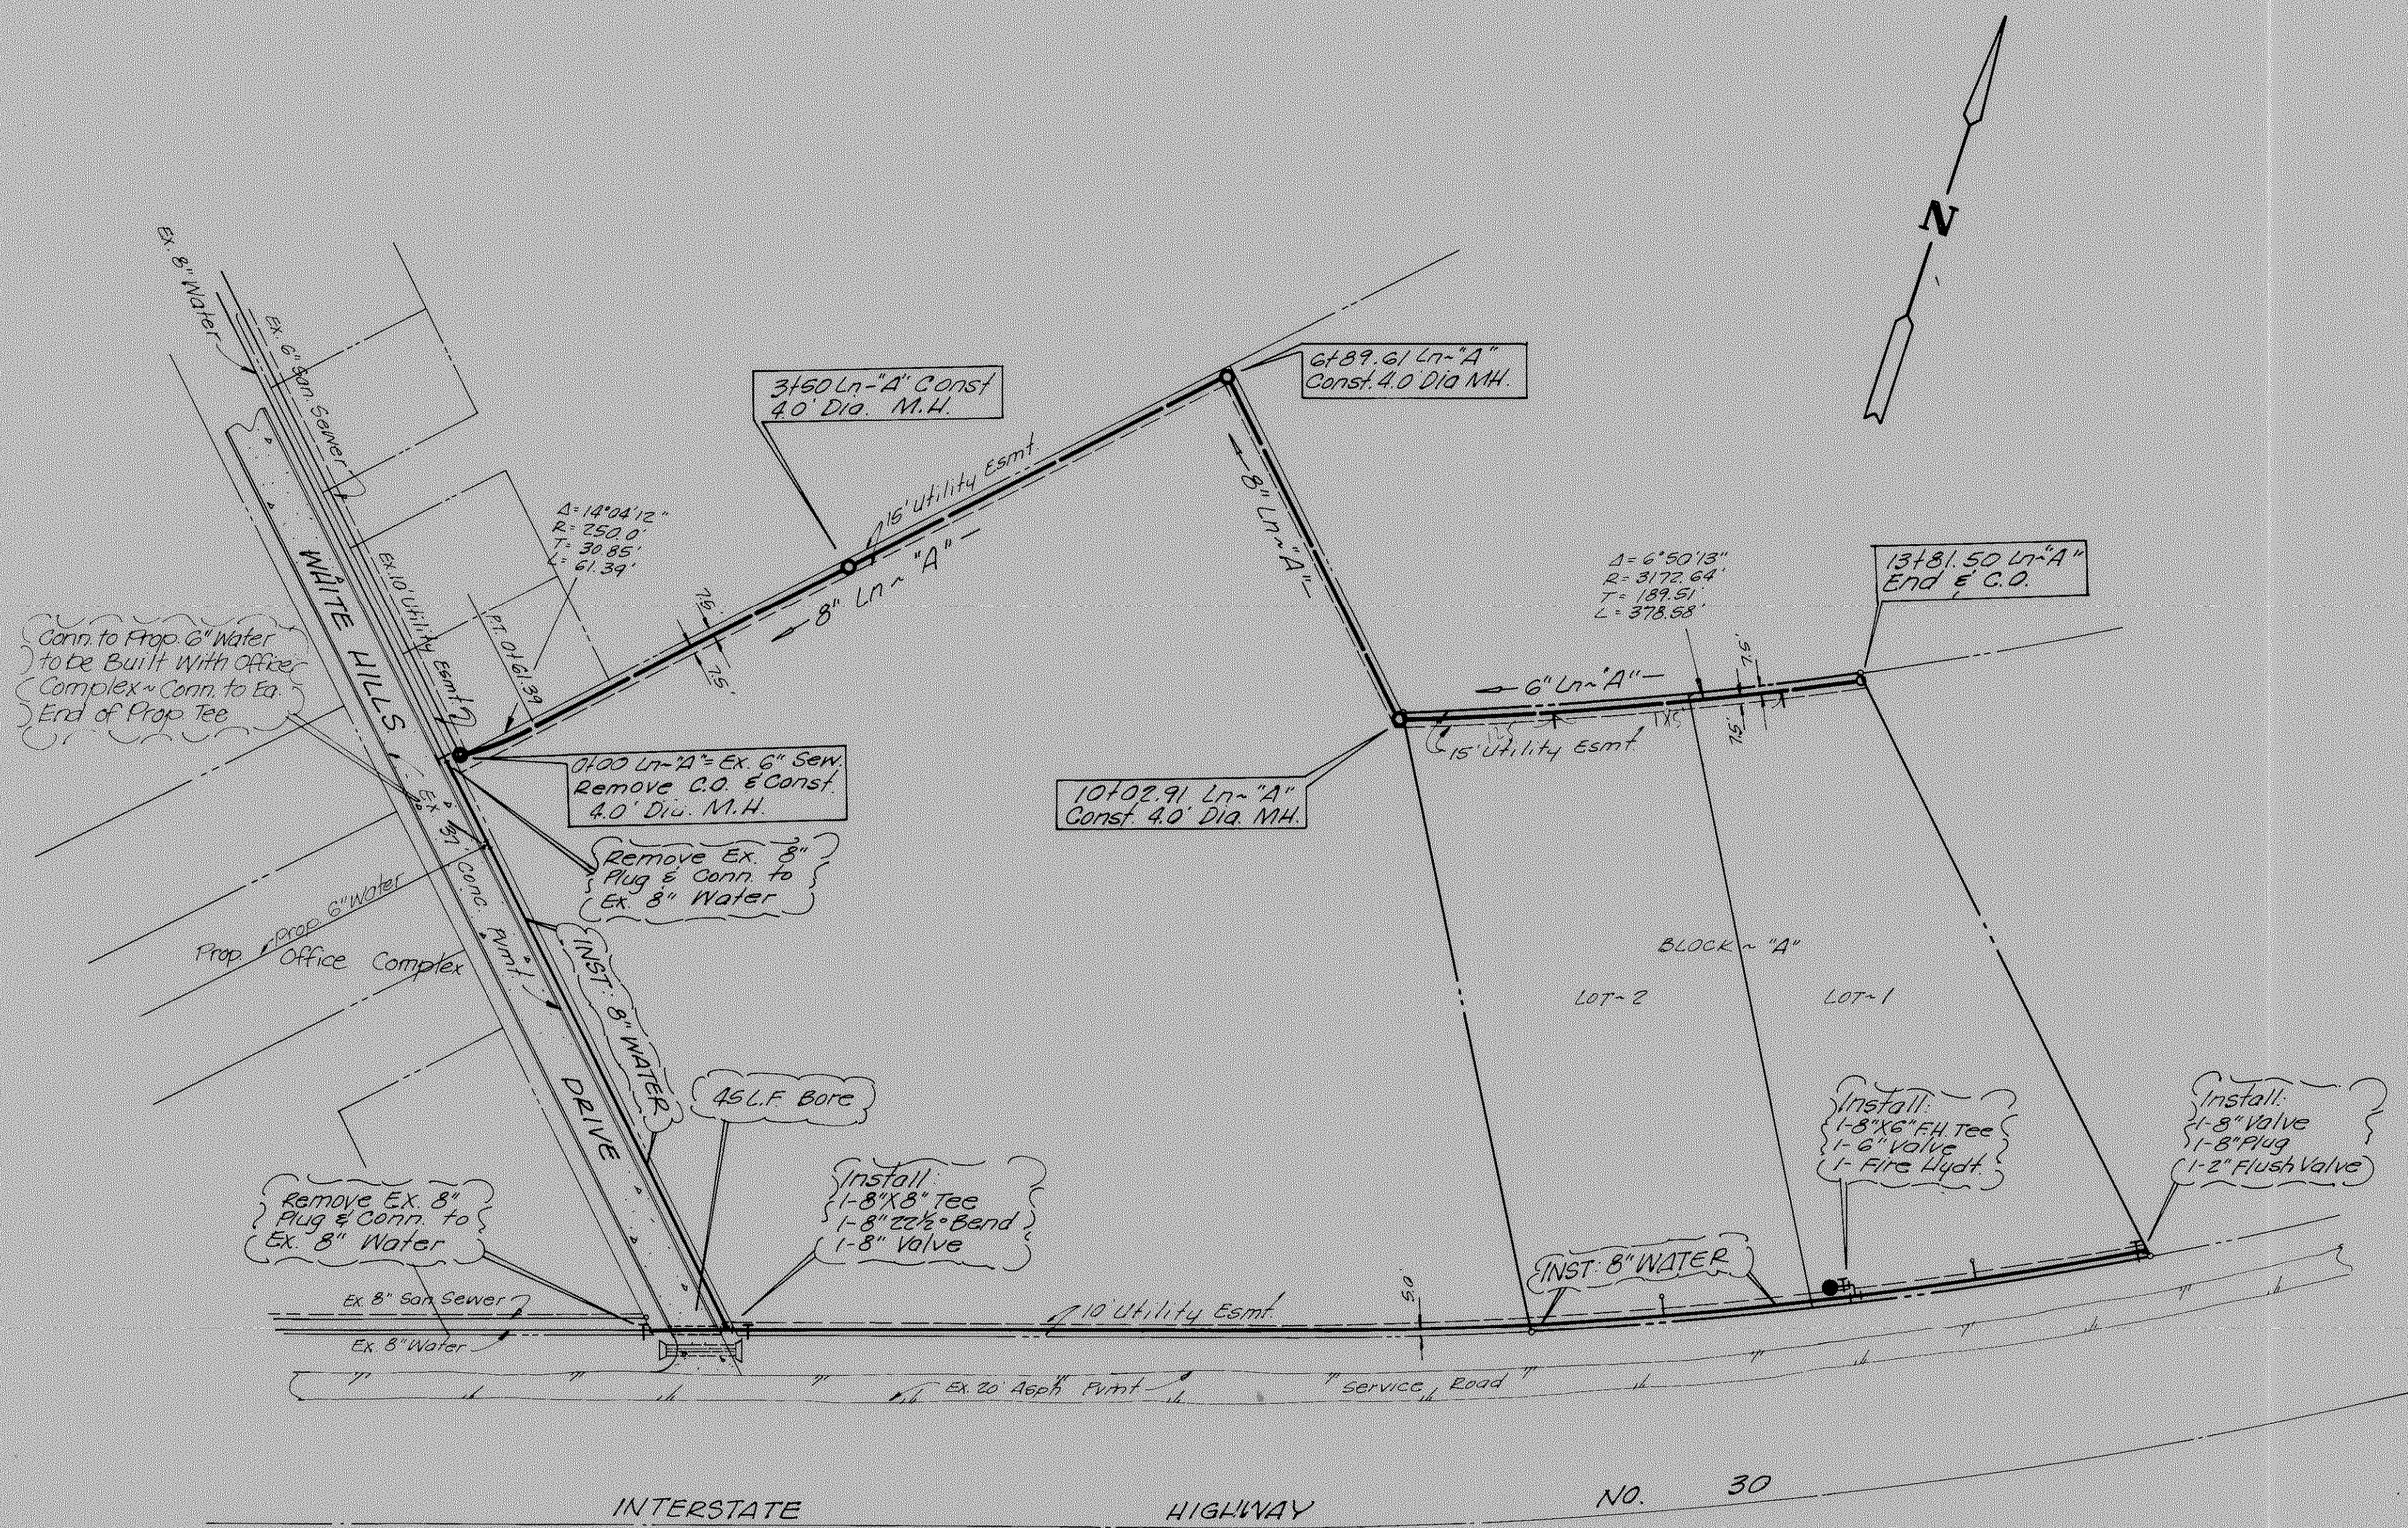

AS BUILT

1 OF 1

UTILITY PLAN						
ROCKWALL PLAZA						
DALE LANE & JIM HUNT ~ OWNERS						
ROCKWALL, ROCKWALL COUNTY, TEXAS						
HAROLD L. EVANS ~ CONSULTING ENGINEER						
DESIGN	DRAWN	DATE	SCALE	NOTES	FILE	NO.
P.N.	P.N.	7-4-83	1/4" = 100' H. 1" = 6' V.			8325