

PAVEMENT BAR

NEW PAVEMENT

ALL WORK BETWEEN HEADERS TO BE DONE BY OTHERS UNLESS OTHERWISE SPECIFIED.

STANDARD SPECIFICATION REFERENCE

305.4

STREET HEADER FOR FUTURE PAVEMENT

STREET HEADER AT EXISTING PAVEMENT

EXISTING PAVEMENT

HOLES BLOWN
CLEAN & DOWELS
COATED WITH
EPOXY RESIN

SPECIFIED IN PAVEMENT REINFORCEMENT


STREET HEADERS


NOTES:


1. PAVEMENT BARS TO BE BENT DOWN INTO HEADER.


STREET HEADER AT RAILROAD

REINFORCED CONCRETE PAVEMENT Marth Central Tensor Consoil of Consentration

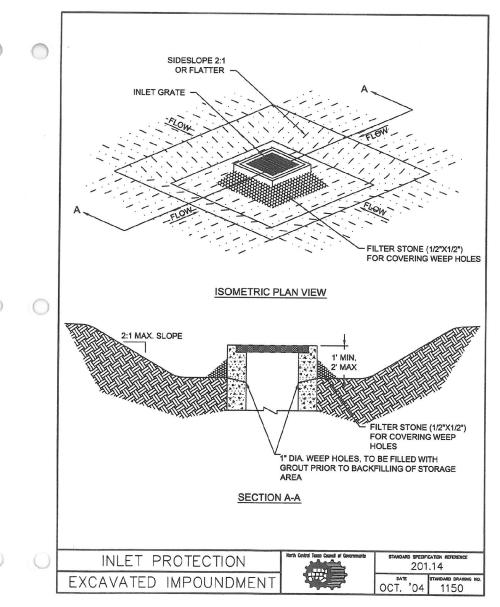


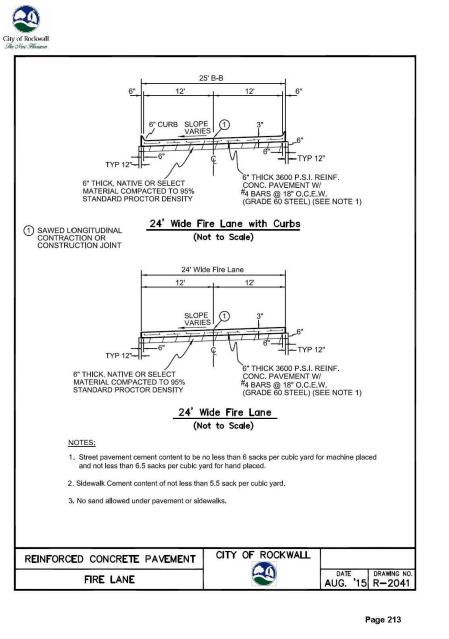


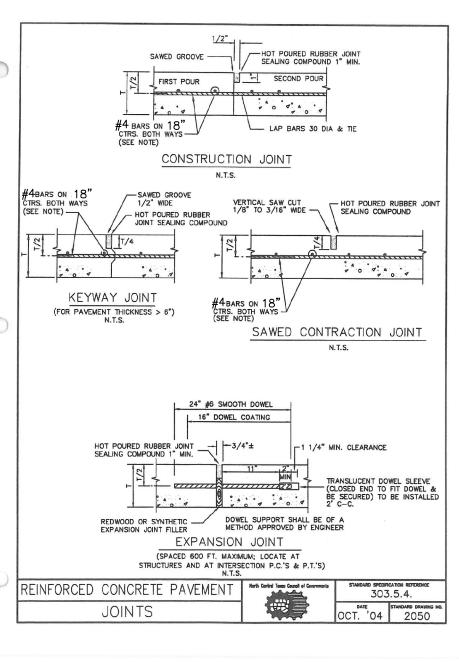


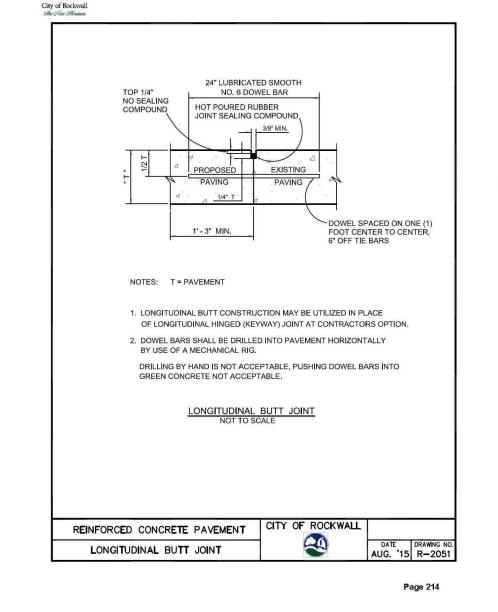



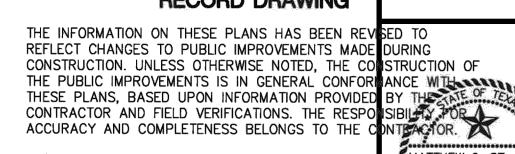

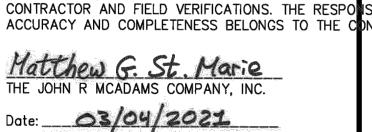

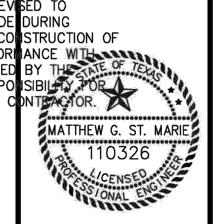

ON All

ن اُ

RD (

Ö.

SWBC ROCKW


MCADAMS	
TBPE: 19762	


TBPE: 19762				
Drawn By: ASC				
Date: 12/19/2017				
Scale: N.T.S.	ď			
Revisions:				
03/23/2018 AS-BUILTS	S:			
05/16/2018 03/04/20	21			
07/16/2018				
08/13/2018				
10/12/2018				
11/07/2018				
12/14/2018				
10 /00 /0010				


8/13/2018	
0/12/2018	
1/07/2018	
2/14/2018	
2/26/2018	
····	


17193

C38

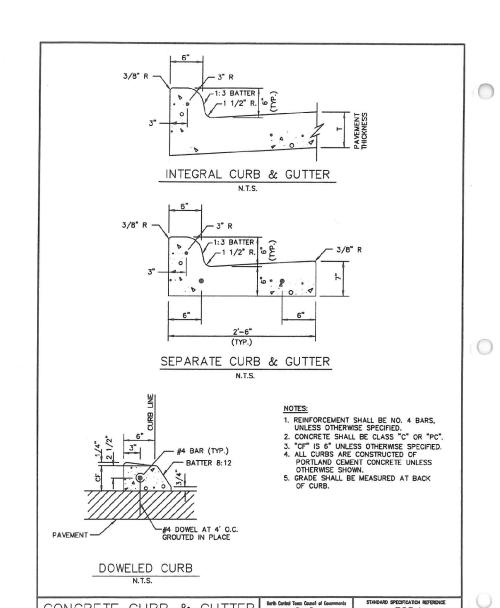

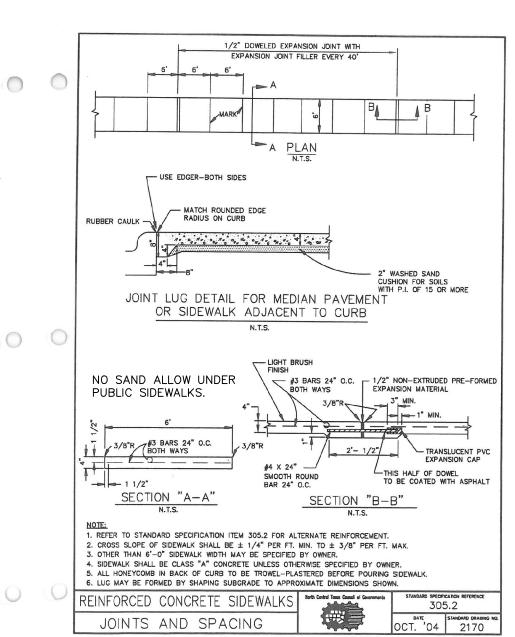

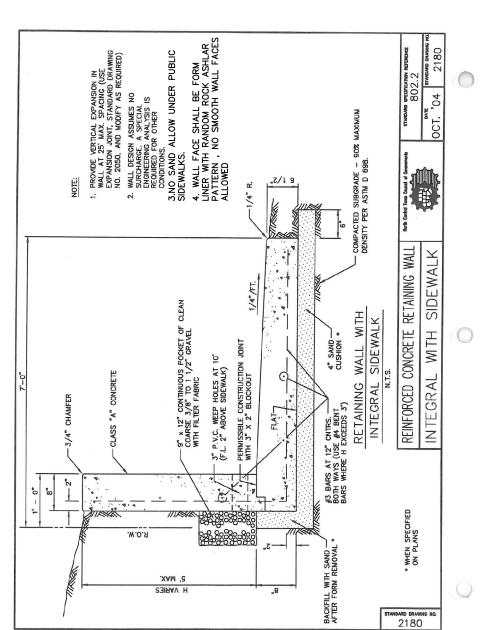


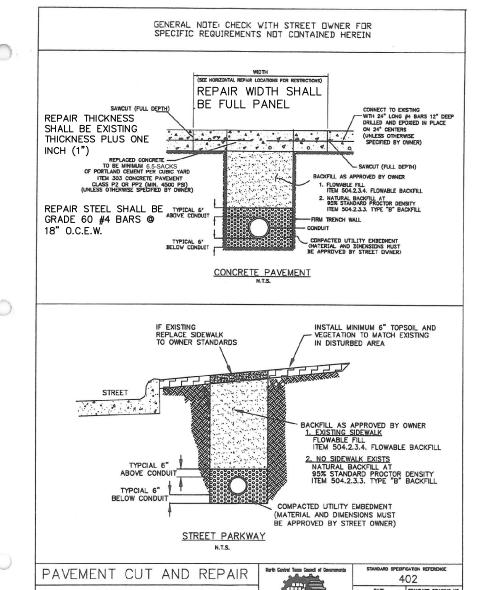



GENERAL NOTES CONTRACTOR TO USE DETAILS AS OUTLINED IN THE STANDARD SPECIFICATIONS FOR PUBLIC WORKS CONSTRUCTION, NORTH CENTRAL TEXAS, THIRD EDITION AND CITY OF ROCKWALL

STANDARDS OF DESIGN AND CONSTRUCTION. SOME OF THE DETAILS IN THE STANDARD SPECIFICATIONS FOR PUBLIC WORKS CONSTRUCTION, NORTH CENTRAL TEXAS, FOURTH EDITION HAVE BEEN ADJUSTED PER THE CITY OF ROCKWALL'S STANDARDS OF DESIGN AND CONSTRUCTION SECTION 8

NCTCOG'S STANDARD WORKS CONSTRUCTION **OWNER/DEVELOPER SWBC BUILDERS** DALLAS, TX 75225 Ph. (214) 987-6317

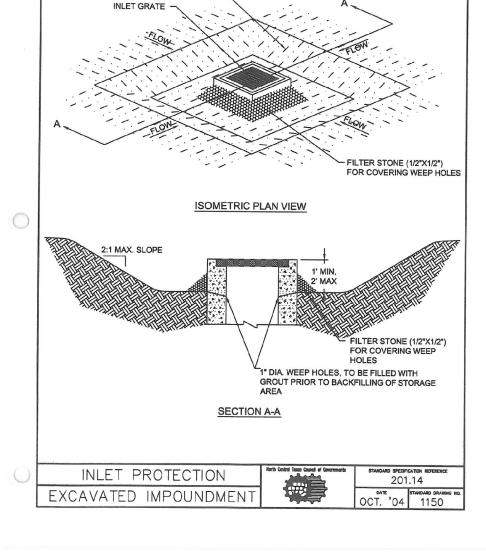

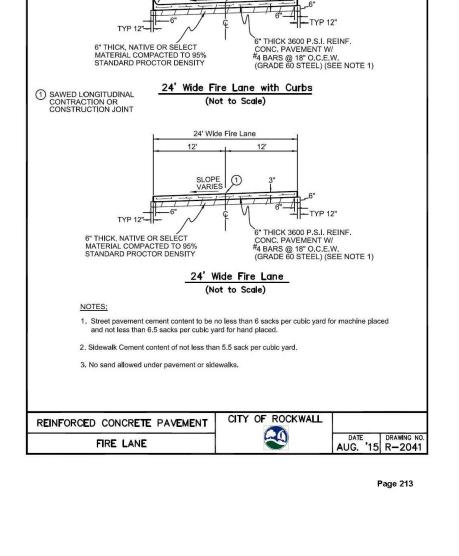

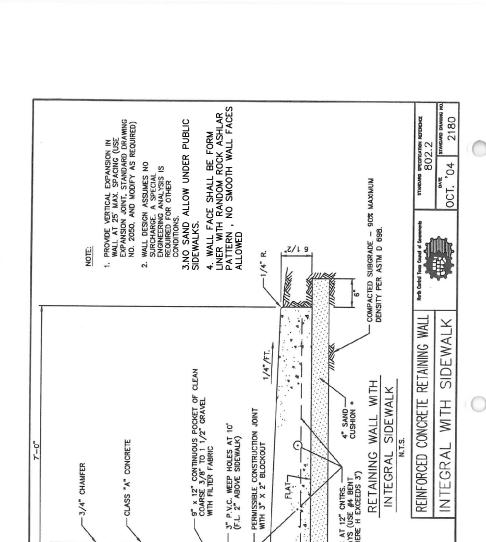

NTEGRAL, SEPARATE. & DOWELFD

STANDARD SPECIFICATION REFERENCE 305.1

CONCRETE AND PARKWAY

SPECIAL PROVISIONS TO THE SPECIFICATIONS FOR PUBLIC STANDARDS.

5949 SHERRY LANE #750 **Contact: SPENCER BYINGTON**