


CITY OF ROCKWALL, TEXAS
AS-BUILT CONSTRUCTION PLANS
for
EAST BUFFALO CREEK
TRUNK SEWER
ROCKWALL COUNTY, TEXAS

SEPTEMBER 2020

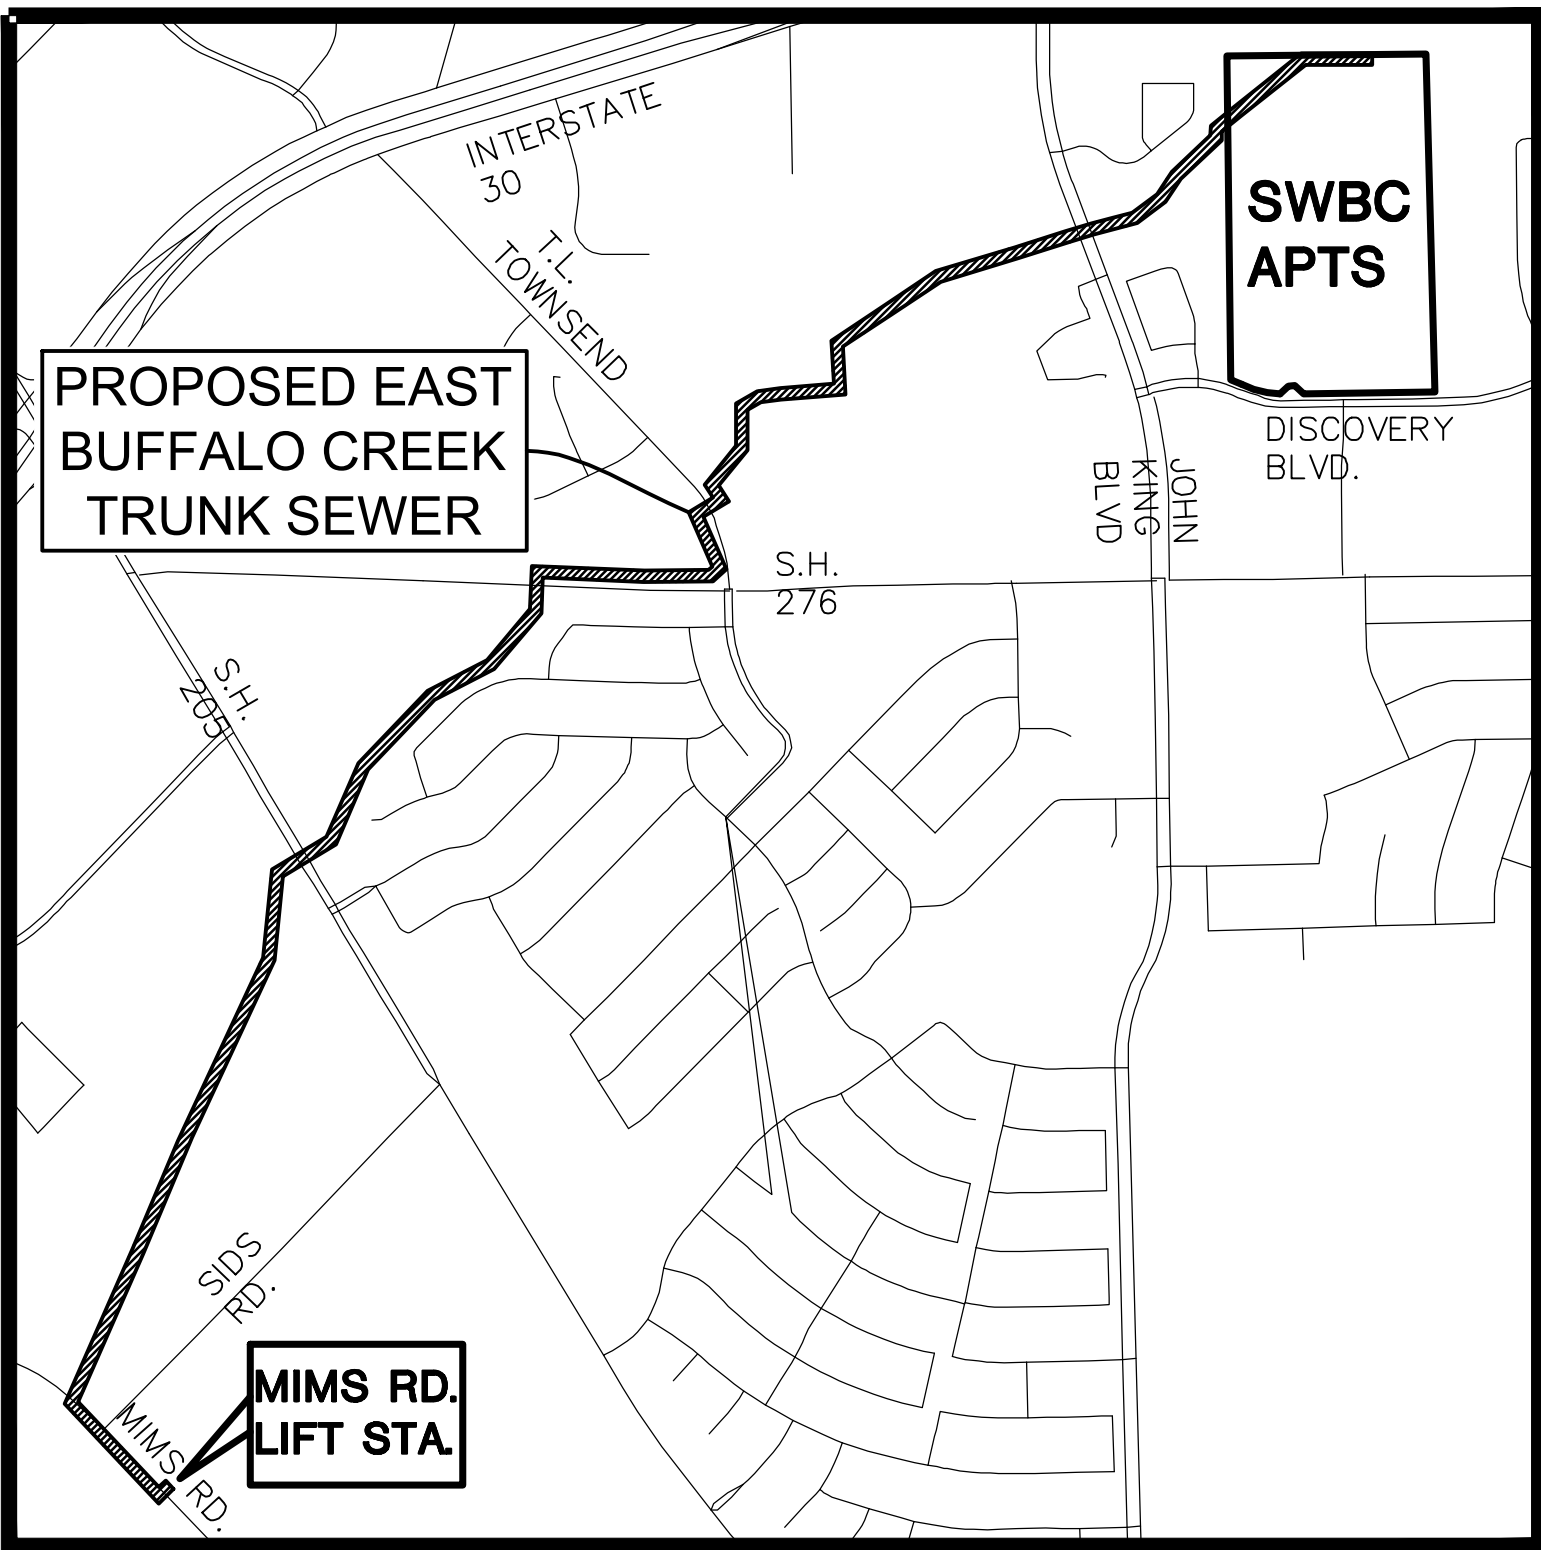

Vicinity Map 1"=1000'

DEVELOPER
SWBC BUILDERS
5949 SHERRY LANE #750
DALLAS, TX 75225
Ph. (214) 987-6317
Contact: SPENCER BYINGTON



The John R. McAdams
Company, Inc.
111 Hillside Drive
Lewisville, Texas 75057
972.436.9712
201 Country View Drive
Roanoke, Texas 76262
940.240.1012
www.mcadamsco.com

Contact: Matthew G. St. Marie, P.E.

Sheet List Table

C	COVER SHEET
C1	GENERAL NOTES
C2	OVERALL SANITARY SEWER PLAN
C3	OVERALL DRAINAGE BASIN
C4	SANITARY SEWER PLAN & PROFILE STA. 0+00-7+00
C5	SANITARY SEWER PLAN & PROFILE STA. 7+00-17+00
S-1.0	STRUCTURAL PLAN AND DETAILS - MIMS ROAD
S-1.1	STRUCTURAL DETAILS - MIMS ROAD
C6	SANITARY SEWER PLAN & PROFILE STA. 17+00-27+00
C7	SANITARY SEWER PLAN & PROFILE STA. 27+00-36+00
C8	SANITARY SEWER PLAN & PROFILE STA. 36+00-42+00
C9	SANITARY SEWER PLAN & PROFILE STA. 42+00-49+00
C10	SANITARY SEWER PLAN & PROFILE STA. 49+00-58+75
C11	SANITARY SEWER PLAN & PROFILE STA. 58+75-67+00
C12	SANITARY SEWER PLAN & PROFILE STA. 67+00-77+00
C13	SANITARY SEWER PLAN & PROFILE STA. 77+00-87+00
S-2.0	STRUCTURAL PLAN LAYOUT - TL TOWNSEND
S-2.1	STRUCTURAL DETAILS - TL TOWNSEND
C14	SANITARY SEWER PLAN & PROFILE STA. 87+00-95+00
C15	SANITARY SEWER PLAN & PROFILE STA. 95+00-104+00
C16	SANITARY SEWER PLAN & PROFILE STA. 104+00-113+00
C17	SANITARY SEWER PLAN & PROFILE STA. 113+00-120+37
C18	SANITARY SEWER LATERAL PLAN & PROFILE
C19	EROSION CONTROL PLAN
C20	EROSION CONTROL PLAN
C21	STANDARD DETAILS
C22	STANDARD DETAILS 2

AS-BUILT
RECORD DRAWING

THE INFORMATION ON THESE PLANS HAS BEEN REVISED TO REFLECT CHANGES TO PUBLIC IMPROVEMENTS MADE DURING CONSTRUCTION. UNLESS OTHERWISE NOTED, THE CONSTRUCTION OF THE PUBLIC IMPROVEMENTS IS IN GENERAL CONFORMANCE WITH THESE PLANS, BASED UPON INFORMATION PROVIDED BY THE CONTRACTOR AND FIELD VERIFICATIONS. THE RESPONSIBILITY FOR ACCURACY AND COMPLETENESS BELONGS TO THE CONTRACTOR.

Matthew G. St. Marie
THE JOHN R. MCADAMS COMPANY, INC.

Date: 11/25/2020

COVER SHEET

EAST BUFFALO CREEK
TRUNK SEWER

In the
W. BARNES SURVEY, ABSTRACT NO. 26; J.D. MCFARLAND SURVEY, ABSTRACT NO. 145; JAMES CADLE SURVEY, ABSTRACT NO. 68; F. HENDERSON SURVEY, ABSTRACT NO. 118; N.M. BALLARD SURVEY, ABSTRACT NO. 24; J.M. ALLEN SURVEY, ABSTRACT NO. 2
CITY OF ROCKWALL
ROCKWALL COUNTY, TEXAS



McADAMS

The John R. McAdams
Company, Inc.
111 Hillside Drive
Lewisville, Texas 75057
972.436.9712
201 Country View Drive
Roanoke, Texas 76262
940.240.1012
TBPE: 19762 TBPLS: 10194440
www.mcadamsco.com

17193A

C