
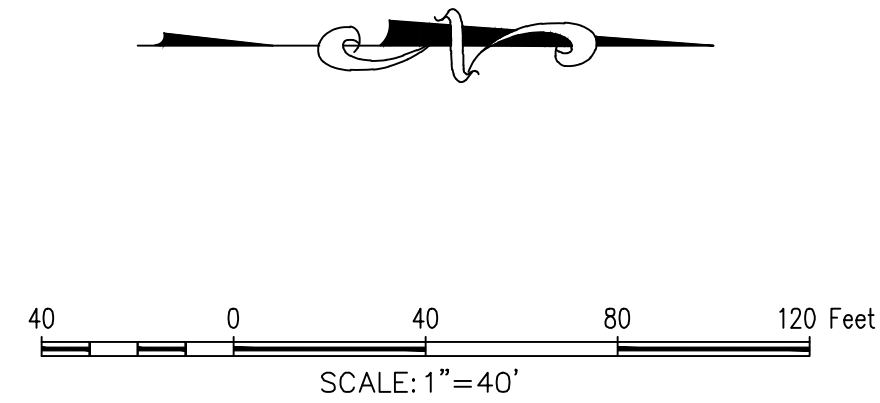
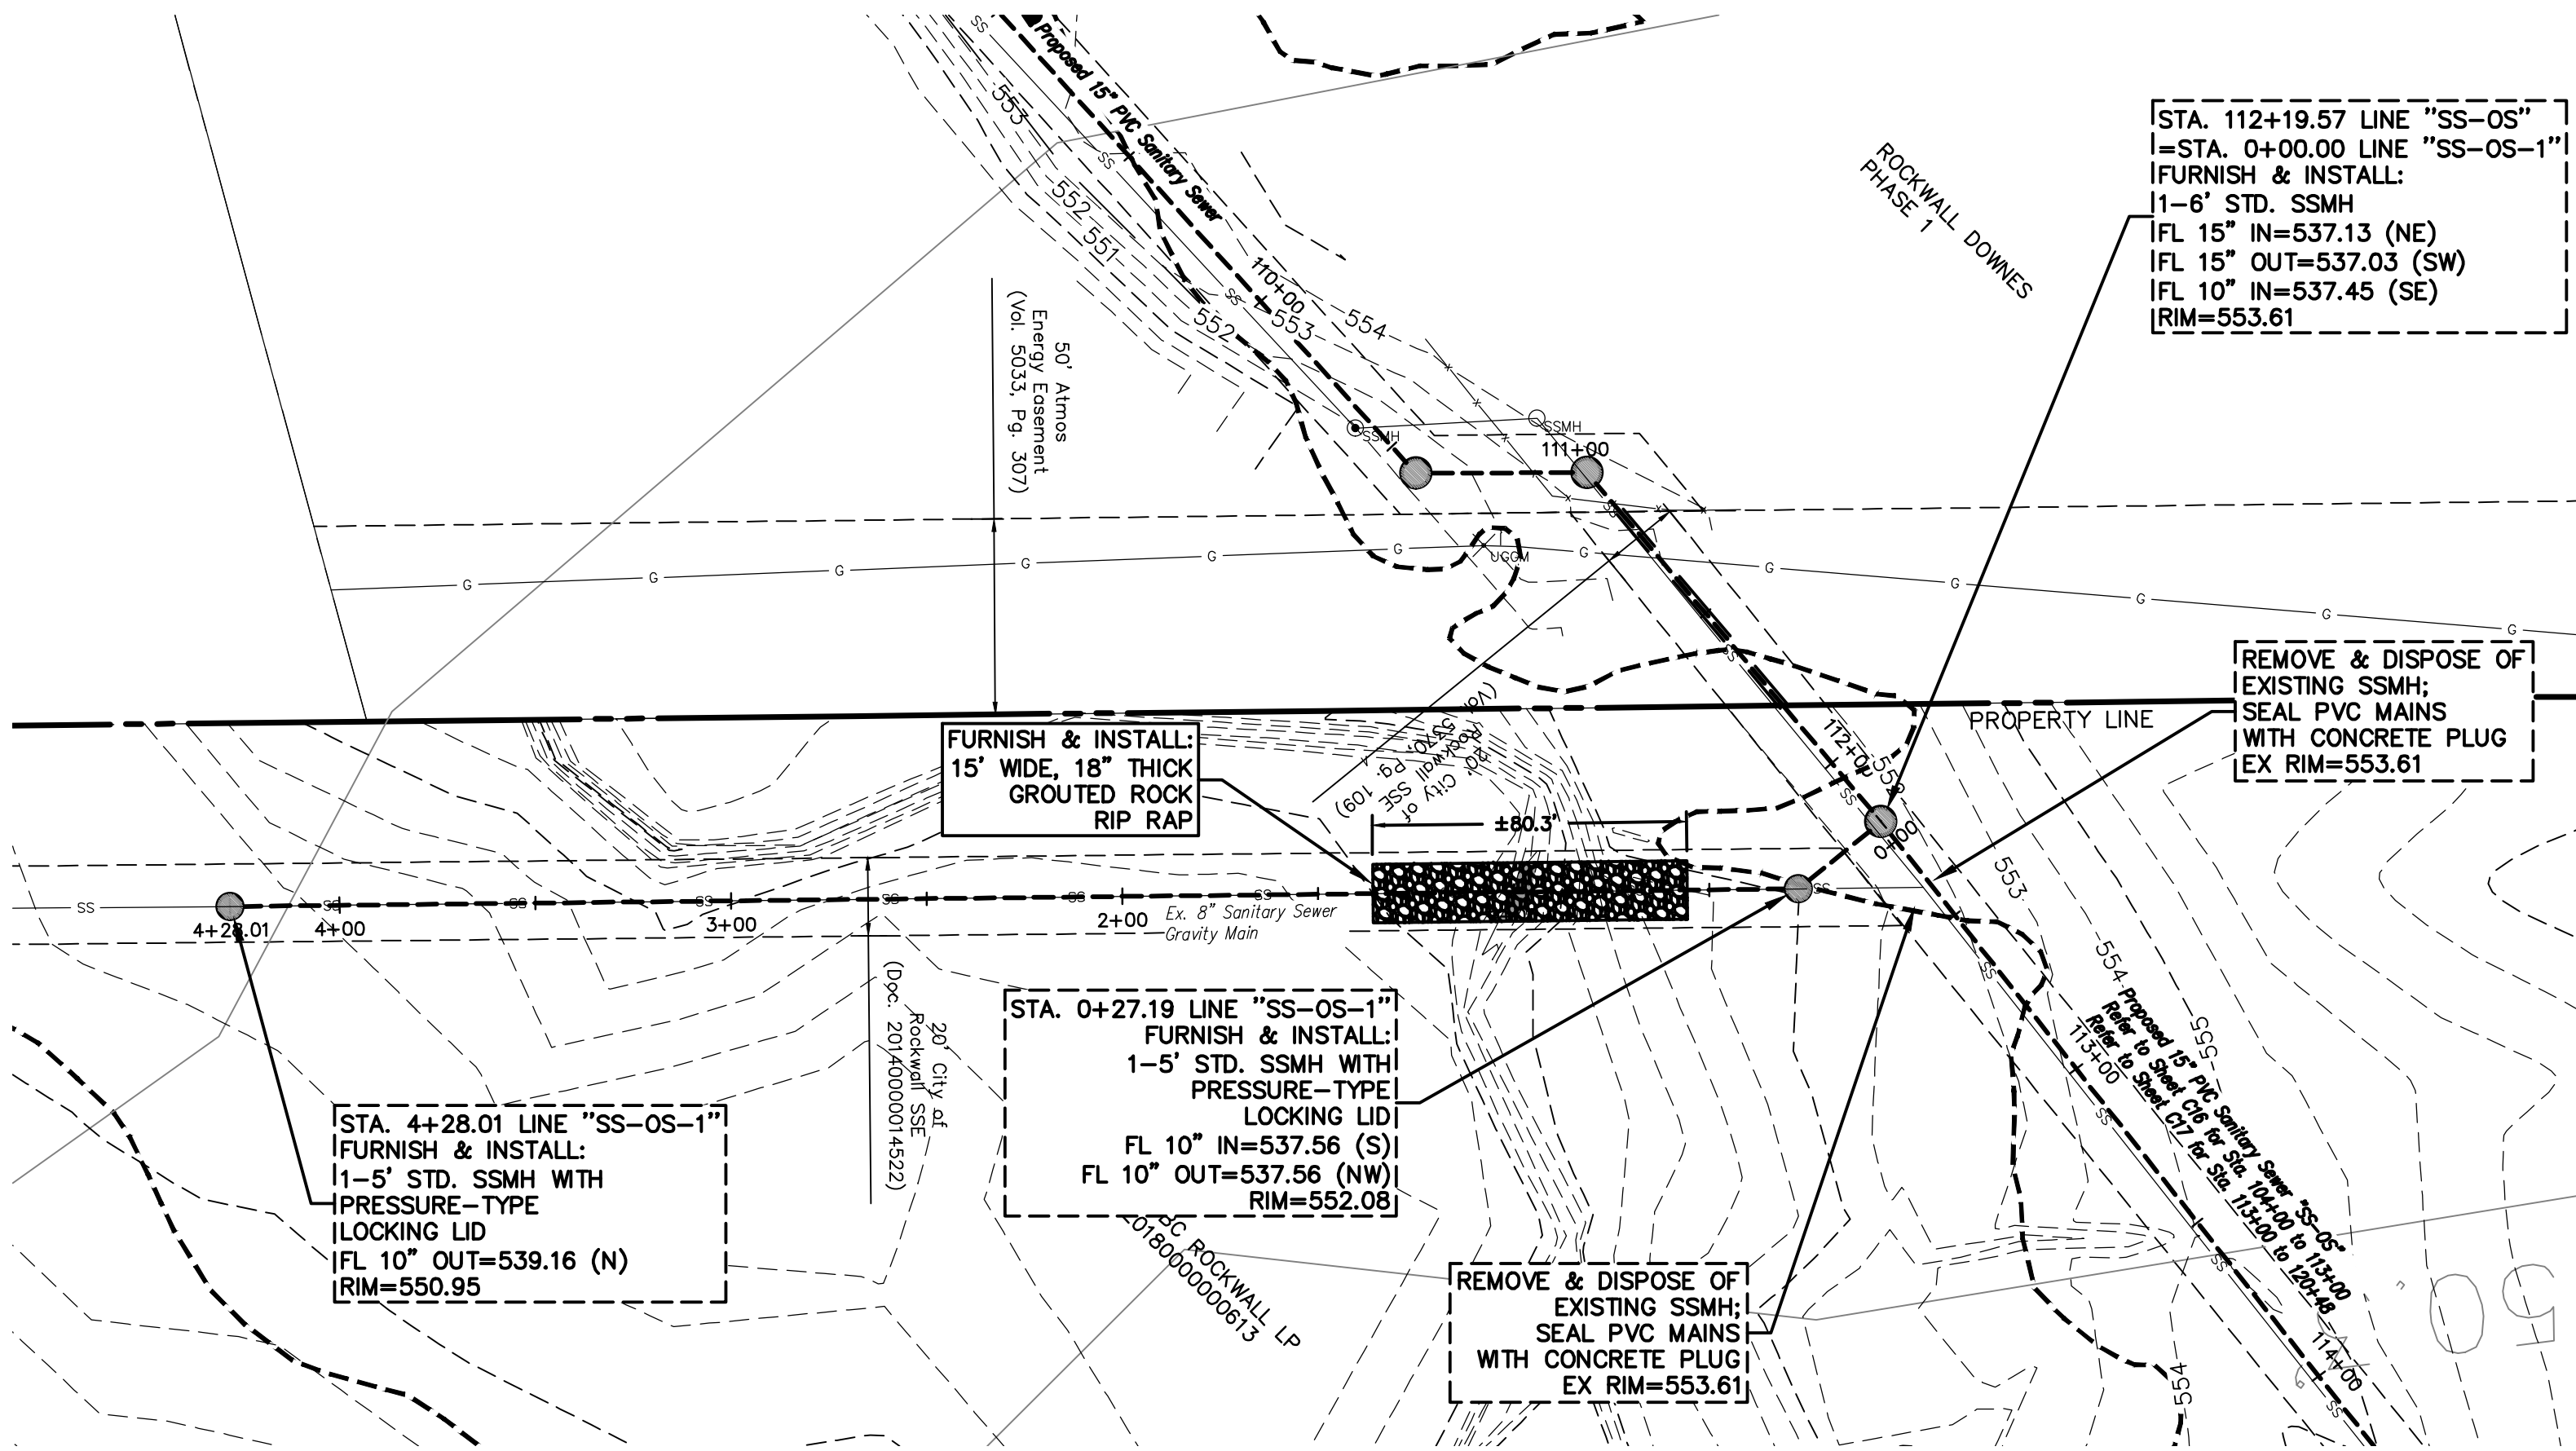


File: Z:\2017\1719\Sanitary Sewer\1719 Sanitary Sewer\1719 Sanitary Sewer.dwg
Plotted: 12/10/2020 11:29 AM by: M. Morris
Scale: 1"=40'

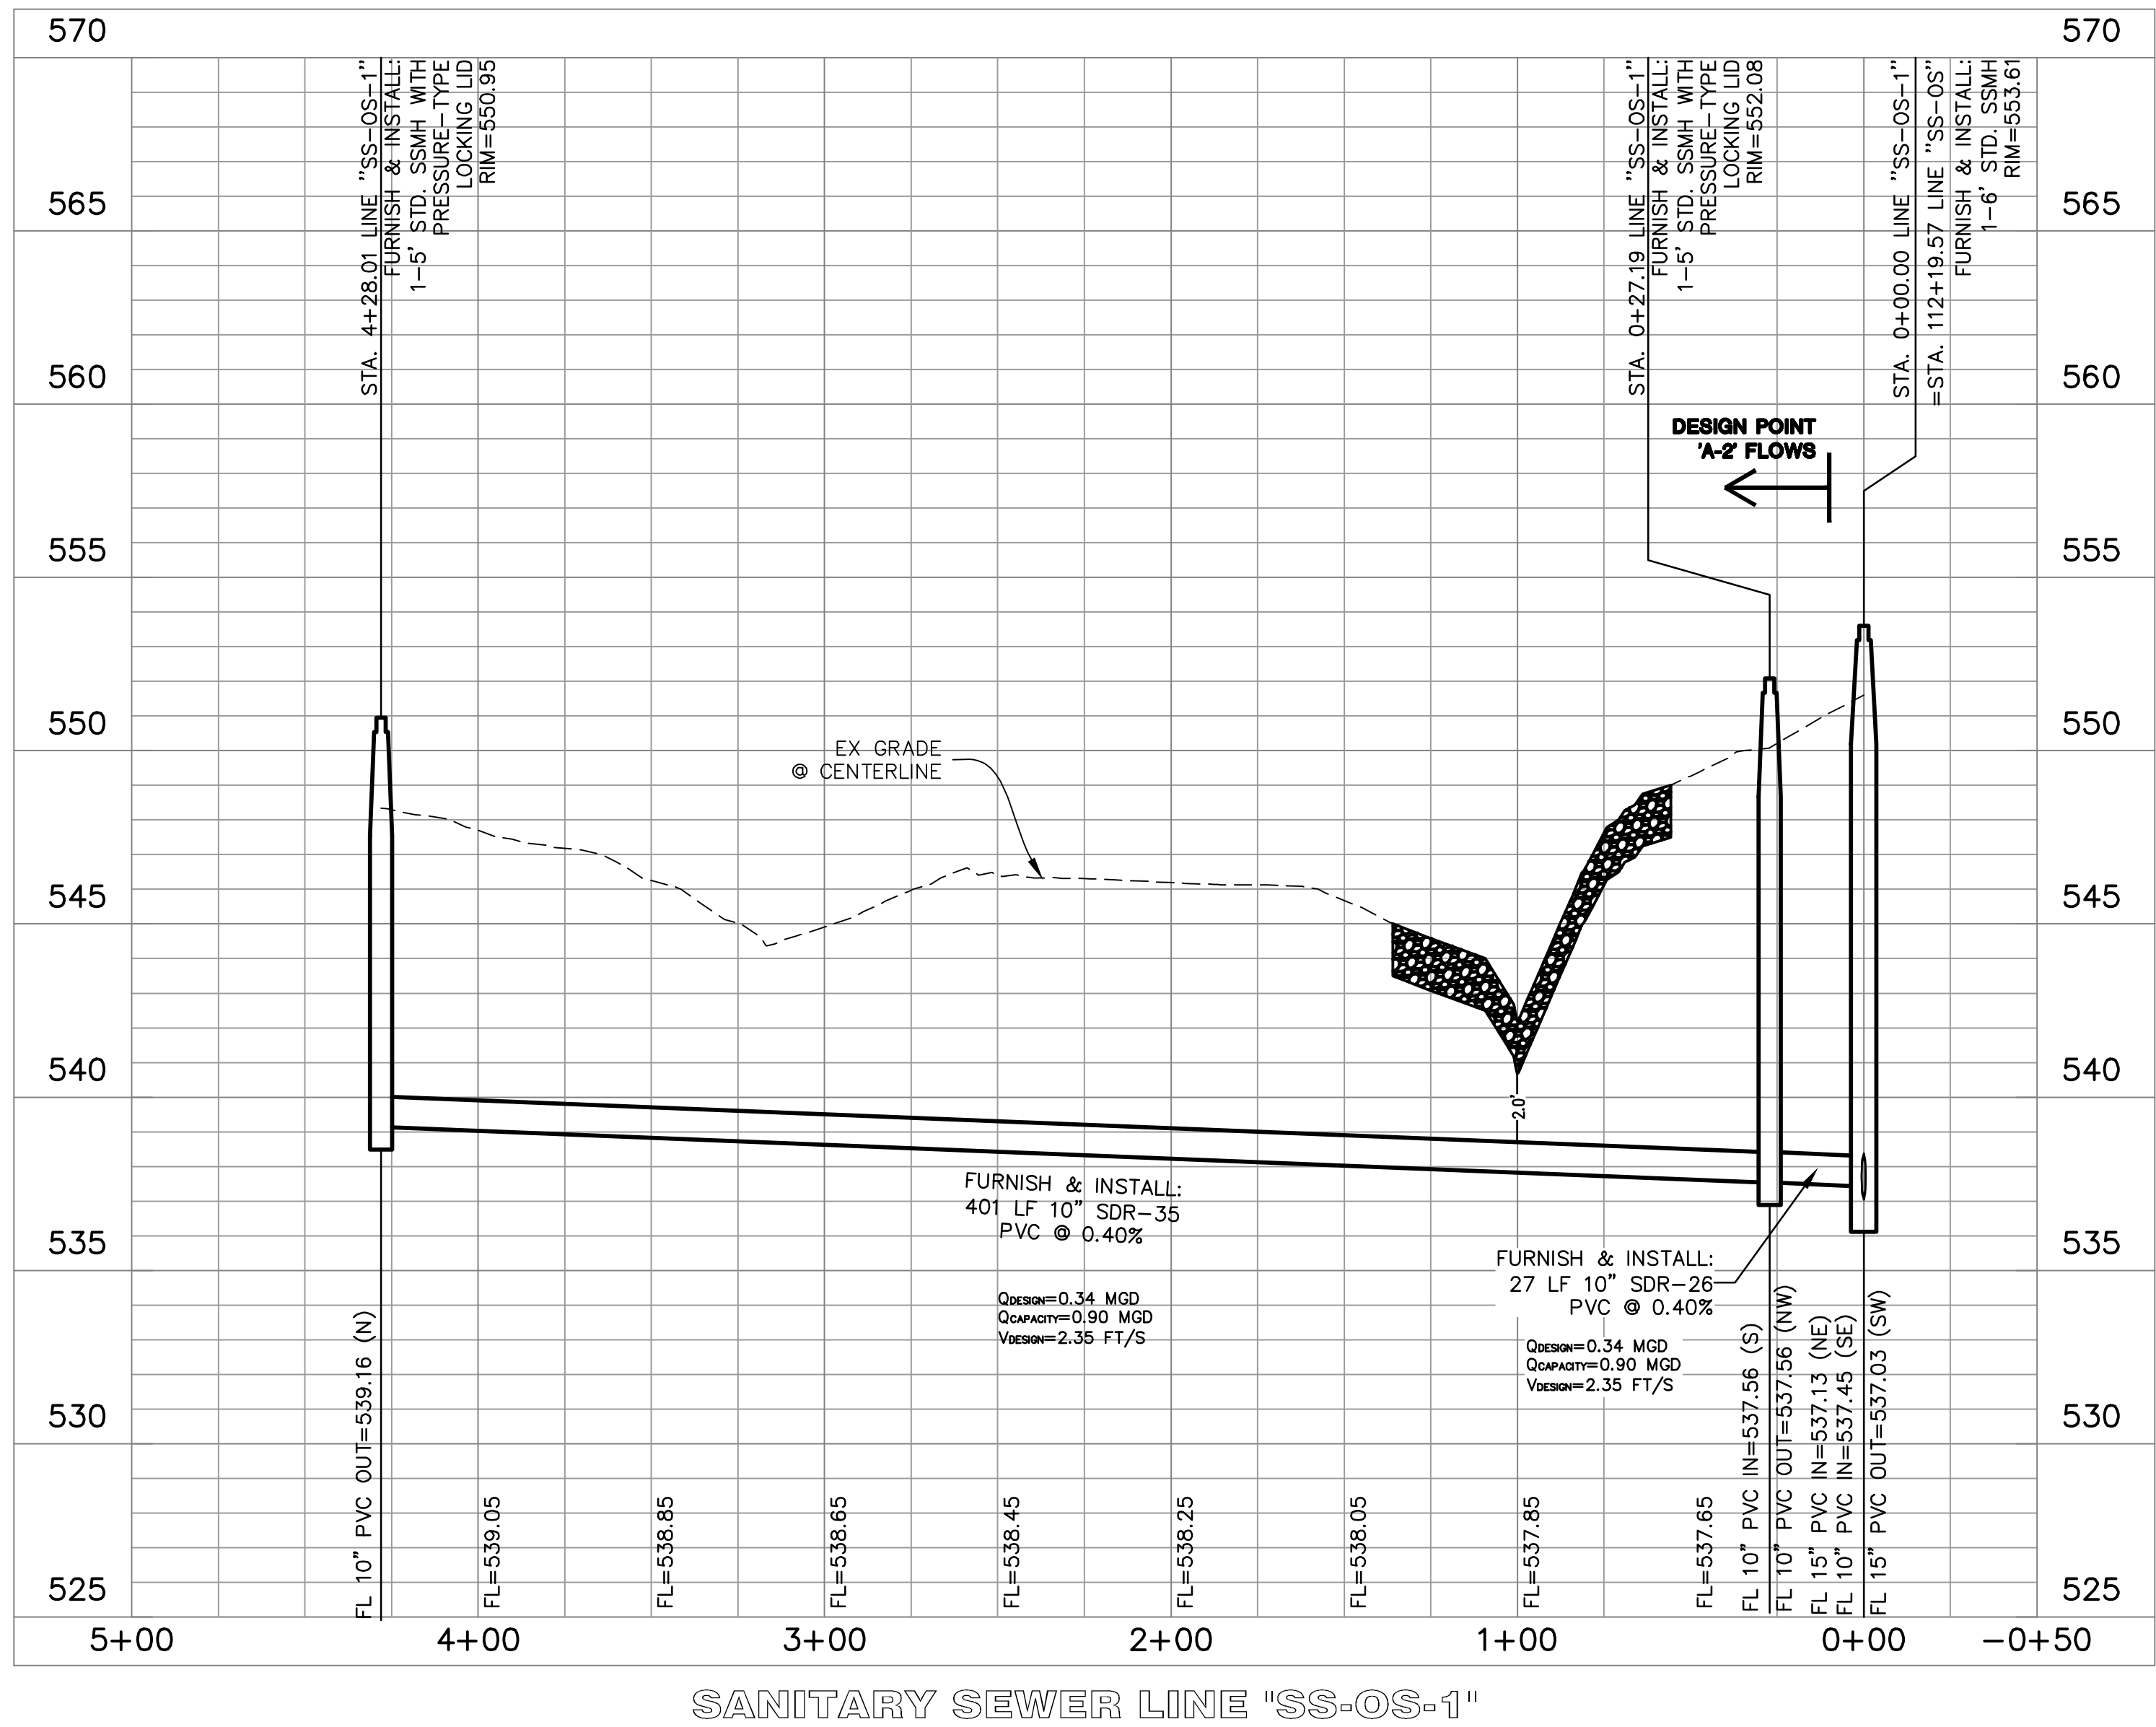

TBM: "X" CUT ON CURB INLET ALONG NORTHSIDE OF DISCOVERY BLVD. APPROXIMATELY 570 FEET FROM EAST PROPERTY LINE. ELEV.= 564.92

BM: CITY OF ROCKWALL CONTROL MONUMENT "N1495", CALLED ELEV.= 566.71.
MEASURED ELEV. = 566.83

GENERAL NOTES


1. ALL RESPONSIBILITY FOR ADEQUACY OF DESIGN REMAINS WITH THE DESIGN ENGINEER. THE CITY OF ROCKWALL, IN REVIEWING AND RELEASING PLANS FOR CONSTRUCTION, ASSUMES NO RESPONSIBILITY FOR ADEQUACY OR ACCURACY OF DESIGN.

AS-BUILT RECORD DRAWING

THE INFORMATION ON THESE PLANS HAS BEEN REVISED TO REFLECT CHANGES TO PUBLIC IMPROVEMENTS MADE DURING CONSTRUCTION. UNLESS OTHERWISE NOTED, THE CONSTRUCTION OF THE PUBLIC IMPROVEMENTS IS IN GENERAL CONFORMANCE WITH THESE PLANS, BASED UPON INFORMATION PROVIDED BY THE CONTRACTOR AND FIELD VERIFICATIONS. THE RESPONSIBILITY FOR ACCURACY AND COMPLETENESS BELONGS TO THE CONTRACTOR.

Matthew G. St. Marie
THE JOHN R. MCADAMS COMPANY, INC.

Date: 11/25/2020

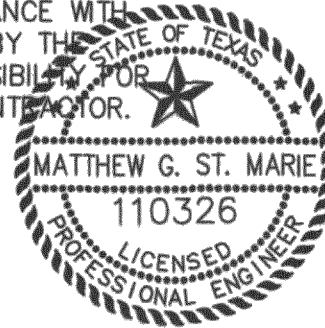

MCADAMS
TBPE: 19762

Drawn By: ASC
Date: 04/12/2018
Scale: H1=40'; V1=4'
Revisions:
09/19/18
12/26/18
02/06/19
03/29/19
08/12/19
11/25/20 - AS BUILTS

17193A

C18

DEVELOPER
SWBC BUILDERS
5949 SHERRY LANE #750
DALLAS, TX 75225
Ph. (214) 967-6317
Contact: SPENCER BYINGTON

EAST BUFFALO CREEK
TRUNK SEWER

In the
W. BARNES SURVEY, ABSTRACT NO. 28; J.D. MCFARLAND SURVEY,
ABSTRACT NO. 46; JAMES CADLE SURVEY, ABSTRACT NO. 66; F.
HENDERSON SURVEY, ABSTRACT NO. 118; M.M. BALLARD SURVEY,
ABSTRACT NO. 24; J.M. ALLEN SURVEY, ABSTRACT NO. 2
CITY OF ROCKWALL
ROCKWALL COUNTY, TEXAS



MCADAMS

The John R. McAdams
Company, Inc.
111 Hillside Drive
Lewisville, Texas 75057
972.436.9712
201 County View Drive
Rockwall, Texas 75087
940.240.1012
TBPE: 19762 TBPE.S: 10184440
www.mcadams.com

EAST BUFFALO CREEK TRUNK SEWER