




IE INFORMATION ON THESE PLANS HAS BEEN REVISED TO EFLECT CHANGES TO PUBLIC IMPROVEMENTS MADE DURING DISTRUCTION. UNLESS OTHERWISE NOTED, THE CONSTRUCTION OF IE PUBLIC IMPROVEMENTS IS IN GENERAL CONFORMANCE WITH IESE PLANS, BASED UPON INFORMATION PROVIDED BY THE OF TEXT DISTRICTOR AND FIELD VERIFICATIONS. THE RESPONSIBILARY FOR CCURACY AND COMPLETENESS BELONGS TO THE CONTRACTOR.

Hatthew St. Morro
IE JOHN R MCADAMS COMPANY, INC.

1te: 11/25/2020

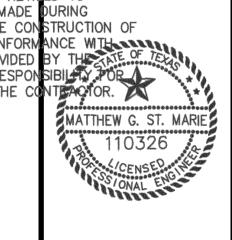

MCADAMS

MCADAMS TBPE: 19762 wn By: ASC e: 04/12/2018 le: N.T.S. isions: '19/18

Date: 04/12/2018
Scale: N.T.S.
Revisions:
09/19/18
12/26/18
02/06/19
03/29/19
08/12/19
11/25/20 - AS BUILTS

17193A

C21

DEVELOPER
SWBC BUILDERS
5949 SHERRY LANE #750
DALLAS, TX 75225
Ph. (214) 987-6317
Contact: SPENCER BYINGTON

ON OF THE OF THE

TRUNK

CREEK

T BUFF