

VICINITY MAP N.T.S.

CONTACT INFORMATION:

Rockwall Salons, LLC, dba Salons Elite Owner:

P.O. Box 846, Seagoville, TX 75159

c/o Carol Inman (972) 768-4345

Jackson Hunter, Inc, dba Parkview Homes Contractor:

503 Stonebridge Dr., Rockwall, TX 75087

c/o Tommy Satterfield (972) 226-7489

LKS Designs Woods-Stovall Architect:

2201 Dottie Lynn Pkwy., Ste. 145,

Fort Worth, TX 76120

c/o Lance Stovall (817) 548-8714

Landscape Architect: T.H. Pritchett / Associates 1218 Camino Lago, Irving, TX 75039

c/o Tom Pritchett (972) 869-3535

Geotechnical Engineer: Hooper Group Consultants, Ltd

5729 Palo Pinto Ave., Dallas, TX 75206

c/o David Hooper (214) 824-1932

TerraCorp Associates, LLC Surveyor:

3960 Broadway Blvd., Ste. 236

Garland, TX 75043

c/o Ryan Alspaugh (972) 658-7008

Civil Engineer: Weldon Brown Engineering, LC

297 Waterford Way, Montgomery, TX 77356 c/o Reese Brown (832) 691-1581


PFEFFER/INMAN ADDITION

2 LOTS - 1.6989 ACRES J.D. McFARLAND SURVEY, ABSTRACT NO. 145 CITY OF ROCKWALL, ROCKWALL COUNTY, TEXAS

CIVIL ENGINEERING PLAN SHEET INDEX:

PLT	FINAL PLAT
	SITE PLAN
C-2	DRAINAGE AREA MAP
C-3	DIMENSION & PAVING PLAN
C-4	GRADING PLAN
C-5	STORM SEWER PROFILE
C-6	SANITARY & SWALE PROFILES
C-7	WATERLINE LAYOUT MAP



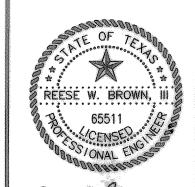

ROCKWALL dba SALONS

ADDITION PFEFFER/INMAN

SHEET TITLE:

AS-BUILT