

DRAINAGE TABLE

DRAINAGE AREA NO.	ACRES	T.C.	С	1 100 YR.	100 YR.	SUM Q 100 YR.
j i	0.34		0.5	9.8	1.67	
2	0.70		,,	*	3.43	

LEGEND

EXIST. CONTOURS


PROPOSED FINISHED GRADES

PROPOSED PAD CRADES FLOW ARROWS

1. City of Rockwall Monument No. 5 located in the grass median of Summit Ridge Drive just West of F.M. 740
Elevation = 578.708'

2. Found cut square on top of curb at NE corner of the intersection of Bourn and Alamo Road.

Elevation = 589.11'

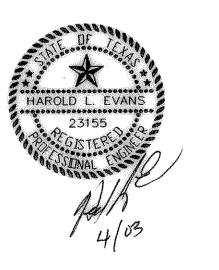

REV.

REVISION DESCRIPTION

SANGER BROTHERS ADDITION

HAROLD L. EVANS CONSULTING ENGINEER P.O. BOX 28355 2331 GUS THOMASSON ROAD, SUITE 102

3/26/03

DATE

3/14/03

SCALE

DALLAS, TEXAS 75228, ( 214 ) 328-8133

DESIGN

H.L.E.

DRAWN

DRAINAGE AREA MAP REPLAT LOTS 5-8, & WEST 57 FEET

OF LOTS 3&4, BLOCK M CITY OF ROCKWALL

JOB NO. 02060

SHEET NO.