

HORIZON ROAD (FM 3097)

BURIED PIPE

(3)8' x 22' PARALLEL SPACES

BM: ELEV: 562.62

BENCHMARK

TOP OF EXIST. SAN. SEW. MH ON SITE NEAR INTERSECTION OF HORIZON & RIDGE ROADS.

BM: ELEV: 562.62

SIDEWALK

SITE PLAN

SBL

FAST, SELIER - 4

EXIST. R=10'



(3 ) 8 × 22 PARALLEL SPACES

N44°54'27" W 351.55'


R=15'

SCALE: 1"=20"

REVISIONS BY

1-8/17/98 WLS

2-10/20/98 LKS

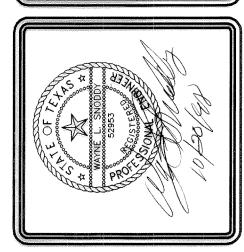

SCOTTIES CONV. STORE ADDRESS RD: F.M. 140

HORIZON RD: RIDGE RD: F.M. 140

WATERICAN CANOPIES

DRAWN BY
HDY
CHECKED BY
WLS
DATE
06/05/98
FIT
SCOT-SITE
JOB NO.
0605-98
SHEET