


ENGINEERING PLANS

FOR

The Shores HOA

CLUB HOUSE

LOT 2 - BLOCK "H" - THE SHORES CLUB HOUSE, PHASE 2
2600 CHAMPIONS DRIVE
ROCKWALL, TEXAS 75087

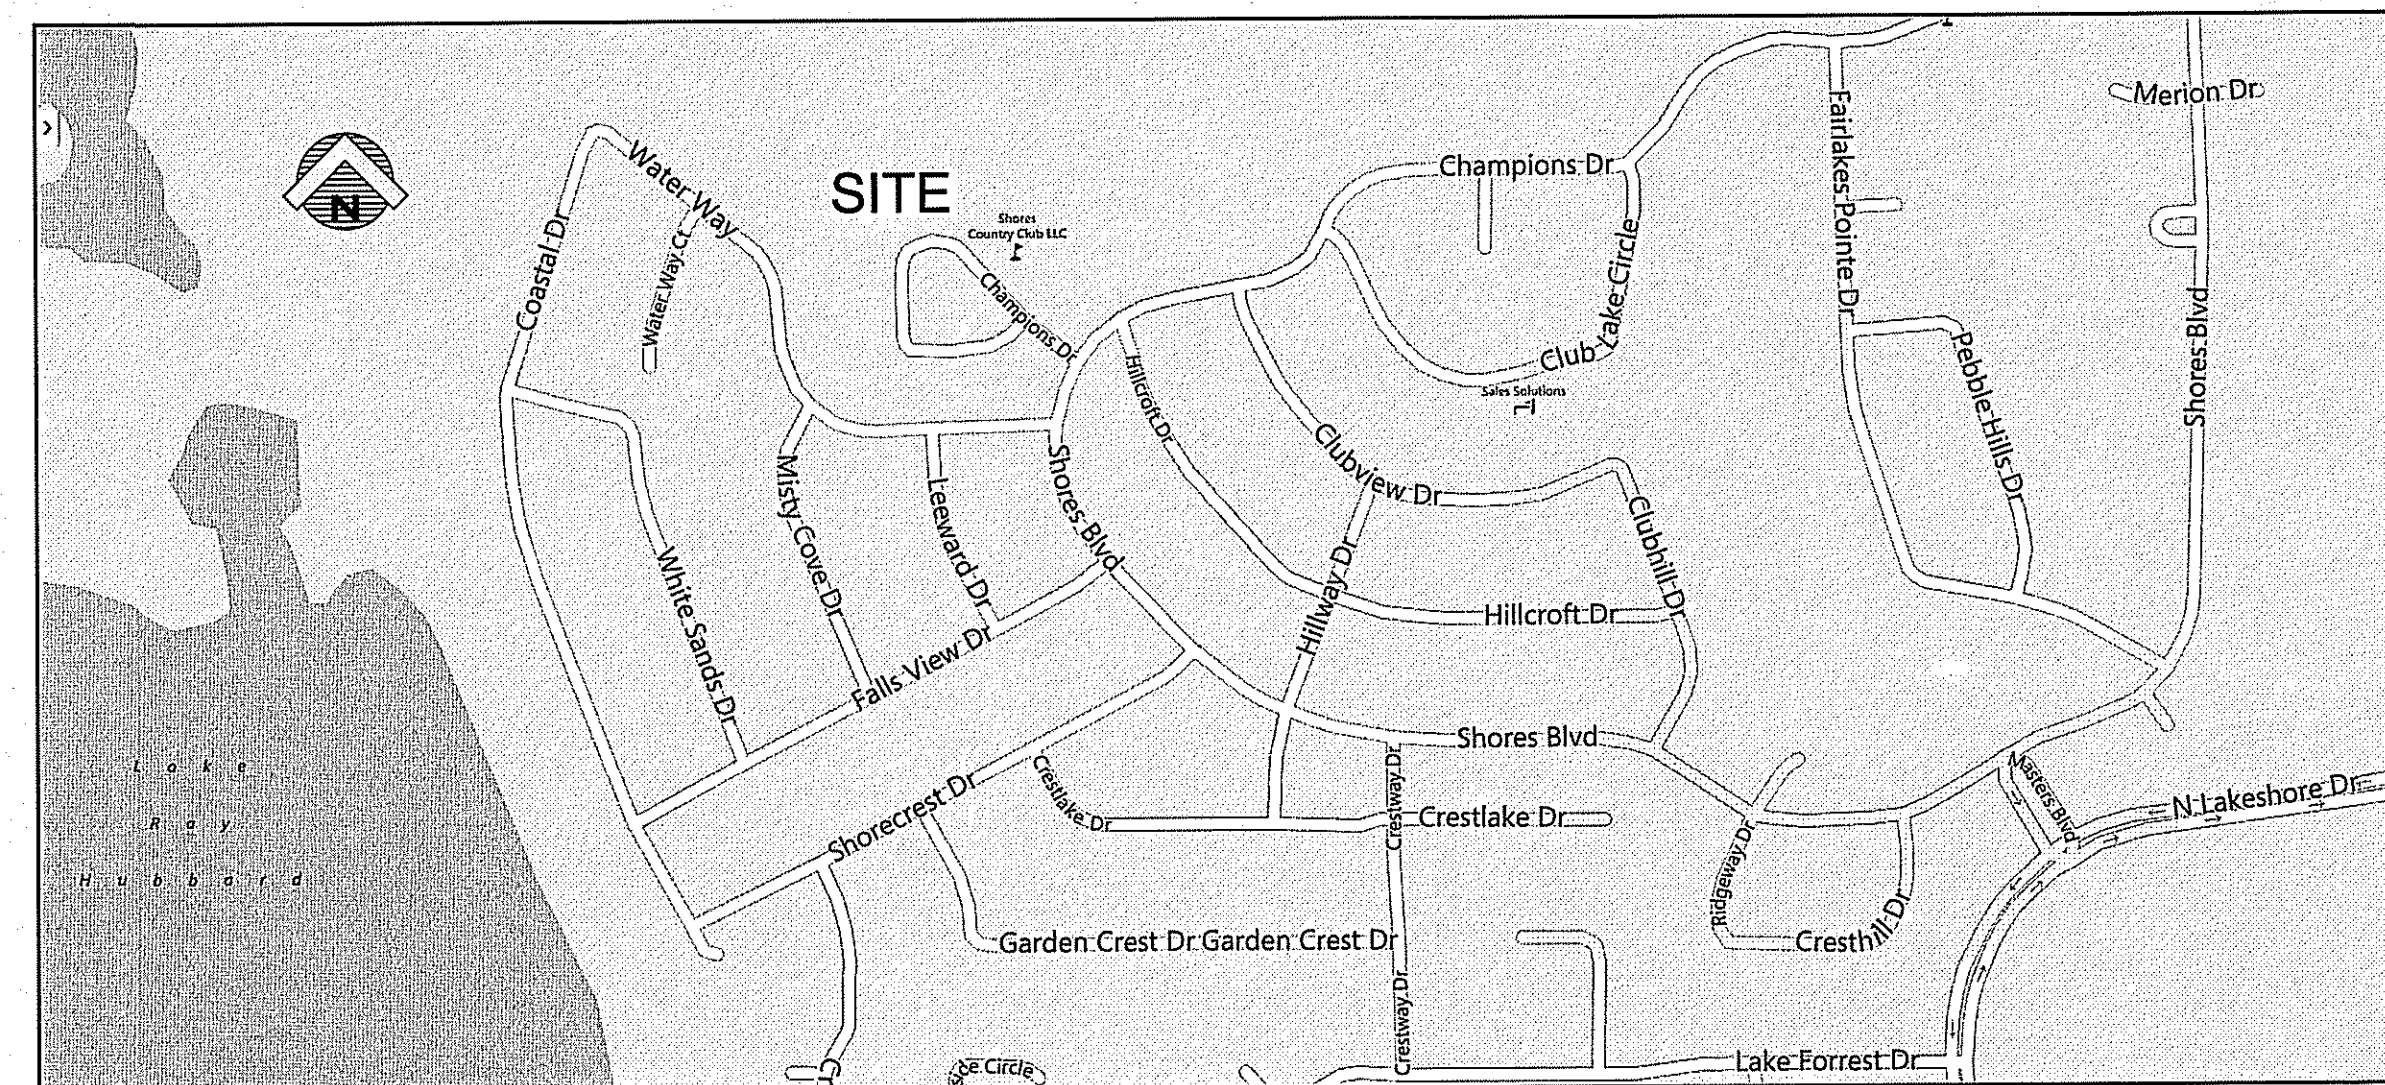

LOCATION MAP

1" = 1000'

GENERAL NOTE:

CONTRACTOR TO UTILIZE CITY APPROVED CONSTRUCTION PLANS FOR CONSTRUCTION OF ALL CIVIL RELATED FACILITIES. CONTRACTOR TO NOTIFY ARCHITECT/ENGINEER IMMEDIATELY OF ANY DISCREPANCIES BETWEEN THE CITY APPROVED SET AND BID SET WITH LATEST ADDENDUMS.

TABLE OF CONTENTS

| SHEET NO | TITLE |
|----------|----------------------|
| C 1.01 | COVER SHEET |
| C 1.02 | TOPOGRAPHIC SURVEY |
| C 1.03 | FINAL PLAT - SHEET 1 |
| C 1.04 | FINAL PLAT - SHEET 2 |
| C 1.05 | FINAL PLAT - SHEET 3 |
| CD 1.01 | DEMOLITION PLAN |
| CS 1.01 | SITE PLAN |
| CG 1.01 | GRADING PLAN |
| CG 1.02 | DRAINAGE AREA MAP |
| CG 1.03 | SWPPP PLAN |
| CG 1.04 | SWPPP DETAILS |
| CU 1.01 | UTILITY PLAN |
| CP 1.01 | PAVING PLAN |
| CP 1.02 | PAVING DETAILS |

OWNER

ROCKWALL GOLF AND ATHLETIC CLUB
2600 CHAMPIONS DRIVE
ROCKWALL, TEXAS 75087
972-771-0000
CONTACT: JAMES HAVEN

ARCHITECT

JOHNSON - RAMSEY
2235 RIDGE ROAD, SUITE 200
ROCKWALL, TEXAS 75087
972-771-1323

ENGINEER

GLENN ENGINEERING CORP.
105 DECKER COURT, SUITE 910
IRVING, TEXAS 75062
972-717-5151

RECORD DRAWING

This is to certify that changes and corrections have been made to conform to the contractor's record of this project.

Signed  Date

12-03-2015

Glenn Engineering Corporation



**GLENN
ENGINEERING**


TEXAS REGISTRATION NUMBER: F-303
PHONE 972-717-5151 FAX 972-717-5151
105 DECKER COURT, SUITE 910 IRVING, TEXAS 75062

SUBMISSION OF BID WILL BE CONSIDERED ACKNOWLEDGMENT THAT THE CONTRACTOR HAS VISITED THE SITE AND HAS VERIFIED ALL EXISTING JOB CONDITIONS AND INCLUDED ANY NECESSARY MODIFICATION TO EXISTING AND NEW WORK REQUIRED FOR INSTALLATION OF A COMPLETE AND WORKING SYSTEM.

JOHNSTON-RAMSAY

ARCHITECTURE - MANAGEMENT

2235 RIDGE RD. STE. 200 ROCKWALL, TEXAS 75087

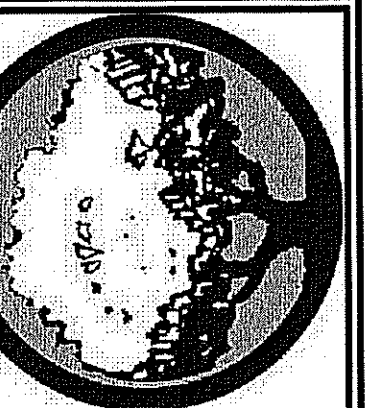

The Shores HOA Clubhouse
2601 Champions Dr. ROCKWALL, TEXAS 75087

©COPYRIGHT 2011. ALL RIGHTS RESERVED
*ALL ELEMENTS OF THIS DRAWING ARE THE INTELLECTUAL
PROPERTY OF JOHNSTON-RAMSAY

DATE
04/24/14


PROJECT
011112

C 1.01
COVER
SHEET


SEPTEMBER 2013

NOTE: THE CITY OF ROCKWALL CONSTRUCTION STANDARDS APPLY, WHETHER INDICATED ON THESE PLANS OR NOT.

CASE # SP 2013-018 LOT 2 - BLOCK H - THE SHORES CLUB HOUSE, PHASE 2

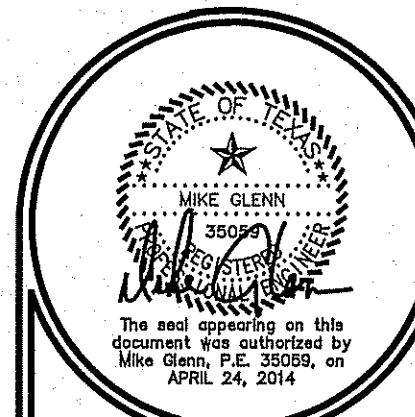


JOHNSTON-RAMSAY
ARCHITECTURE - MANAGEMENT
2235 RIDGE RD. STE. 200 ROCKWALL, TEXAS 75087

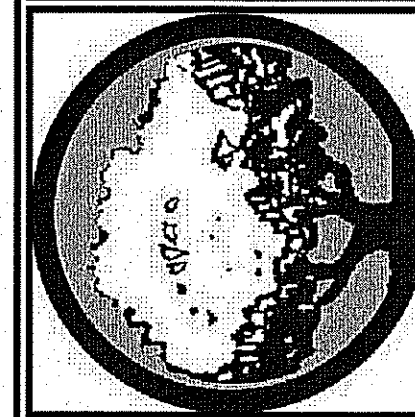

The Shores HOA Clubhouse
2601 Champions Dr. ROCKWALL, TEXAS 75087
©COPYRIGHT 2011. ALL RIGHTS RESERVED
*ALL ELEMENTS OF THIS DRAWING ARE THE INTELLECTUAL PROPERTY OF JOHNSTON-RAMSAY

DATE
04/24/14
PROJECT
011112
C102
TOPOGRAPHIC
SURVEY

CASE # SP 2013-018 LOT 2 - BLOCK H - THE SHORES CLUB HOUSE, PHASE 2

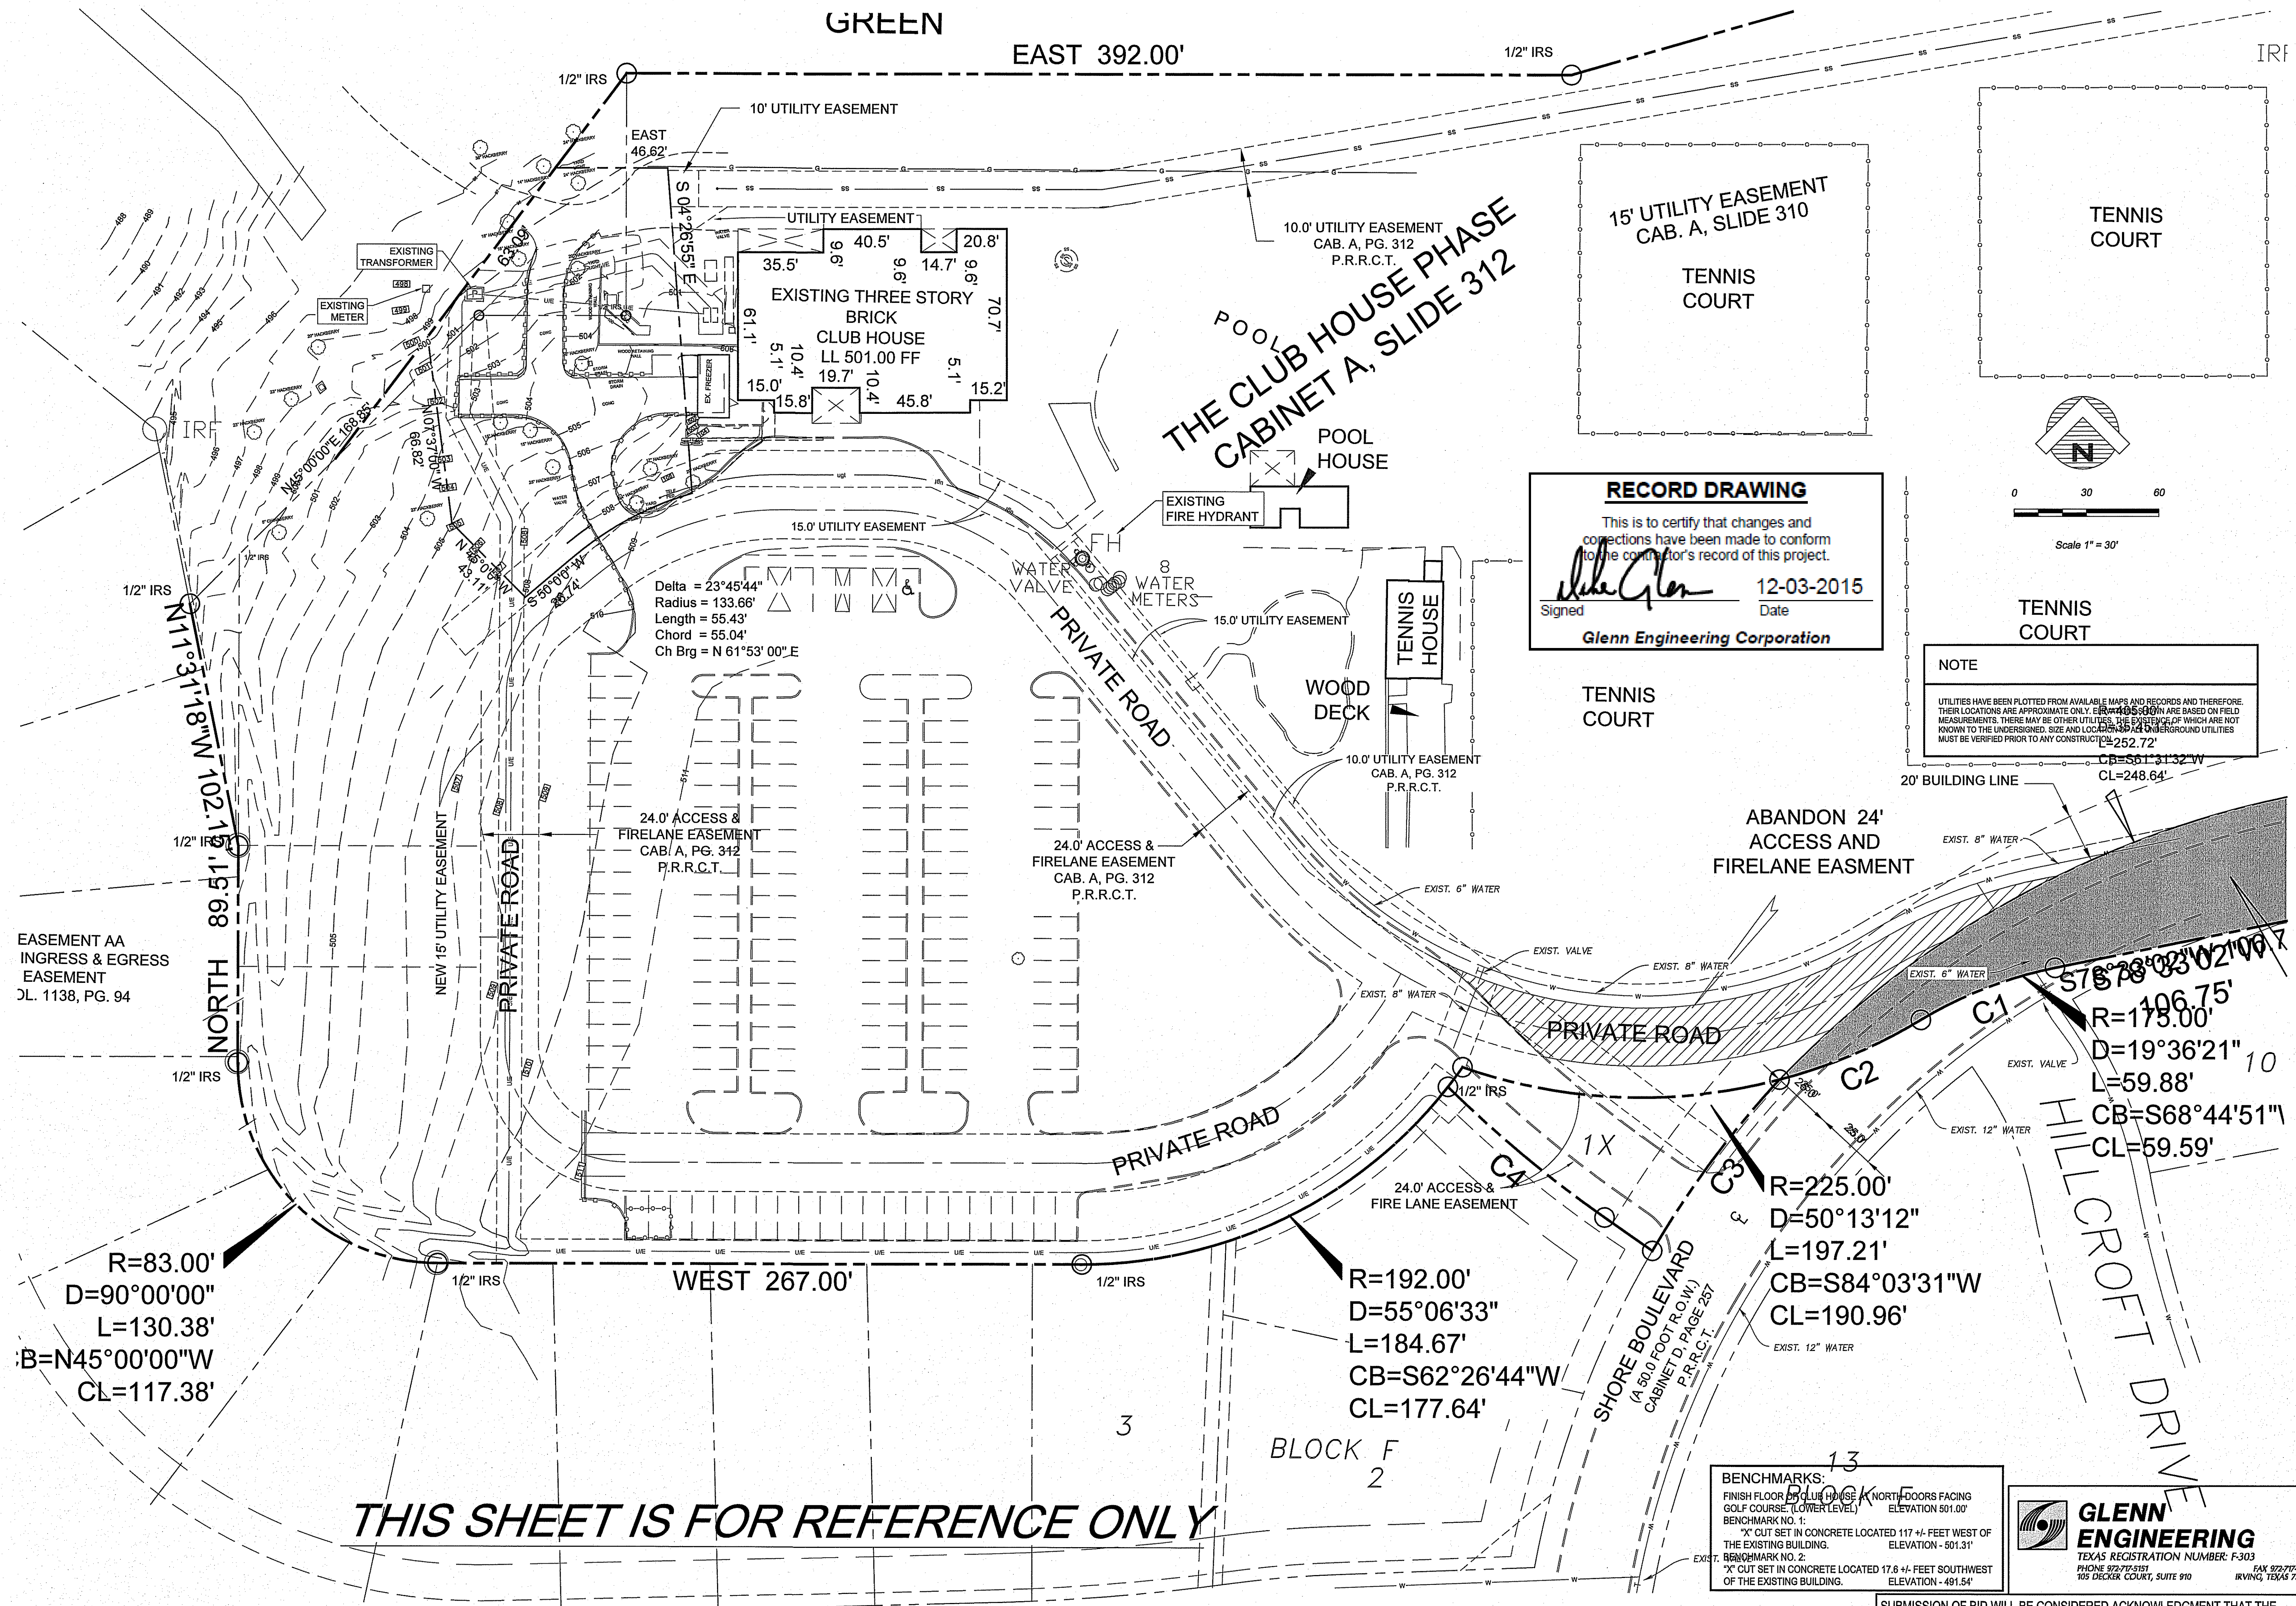

RECORD DRAWING
This is to certify that changes and corrections have been made to conform to the contractor's record of this project.
Signed *Mike Glenn* Date 12-03-2015
Glenn Engineering Corporation

NOTE
UTILITIES HAVE BEEN PLOTTED FROM AVAILABLE MAPS AND RECORDS AND THEREFORE THEIR LOCATIONS ARE APPROXIMATE ONLY. EIR 44053000 ARE BASED ON FIELD MEASUREMENTS. THERE MAY BE OTHER UTILITIES, THE EXISTENCE OF WHICH ARE NOT KNOWN TO THE UNDERSIGNED. SIZE AND LOCATION OF ANY UNDERGROUND UTILITIES MUST BE VERIFIED PRIOR TO ANY CONSTRUCTION.
L=252.72'
CB=S61°31'32"W
CL=248.64'


BENCHMARKS:
FINISH FLOOR OF CLUB HOUSE & NORTH DOORS FACING GOLF COURSE (LOWER LEVEL) ELEVATION 501.00'
BENCHMARK NO. 1:
"X" CUT SET IN CONCRETE LOCATED 117 +/- FEET WEST OF THE EXISTING BUILDING. ELEVATION - 501.31'
BENCHMARK NO. 2:
"X" CUT SET IN CONCRETE LOCATED 17.6 +/- FEET SOUTHWEST OF THE EXISTING BUILDING. ELEVATION - 491.54'

GLENN ENGINEERING
TEXAS REGISTRATION NUMBER: F-303
PHONE 972-717-5151 FAX 972-717-2176
105 DECKER COURT, SUITE 910 IRVING, TEXAS 75062


SUBMISSION OF BID WILL BE CONSIDERED ACKNOWLEDGMENT THAT THE CONTRACTOR HAS VISITED THE SITE AND HAS VERIFIED ALL EXISTING JOB CONDITIONS AND INCLUDED ANY NECESSARY MODIFICATION TO EXISTING AND NEW WORK REQUIRED FOR INSTALLATION OF A COMPLETE AND WORKING SYSTEM.

NOTE: THE CITY OF ROCKWALL CONSTRUCTION STANDARDS APPLY, WHETHER INDICATED ON THESE PLANS OR NOT.

Apr 24, 2014 - 4:57pm User: Robert
C:\Users\Public\Bob's Projects\JIMMY STROHMETER\SHORES\SHORES ENG 17.dwg

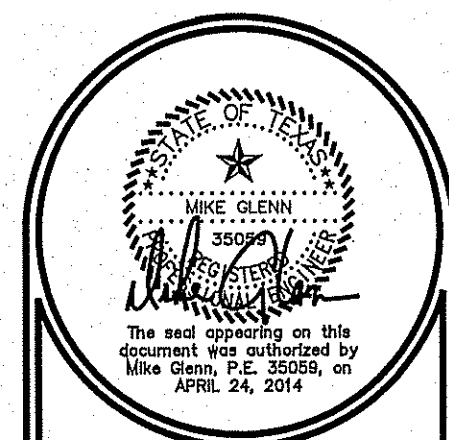


JOHNSTON-RAMSAY
ARCHITECTURE - MANAGEMENT
2235 RIDGE RD. STE. 200 ROCKWALL, TEXAS 75087

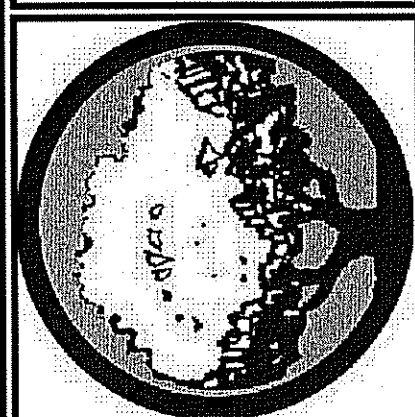

The Shores HOA Clubhouse
2601 Champions Dr. ROCKWALL, TEXAS 75087
©COPYRIGHT 2011. ALL RIGHTS RESERVED
*ALL ELEMENTS OF THIS DRAWING ARE THE INTELLECTUAL
PROPERTY OF JOHNSTON-RAMSAY

DATE
04/24/14
PROJECT
011112
C 103
FINAL PLAT
SHEET 1

CASE # SP 2013-018 LOT 2 - BLOCK H - THE SHORES CLUB HOUSE, PHASE 2

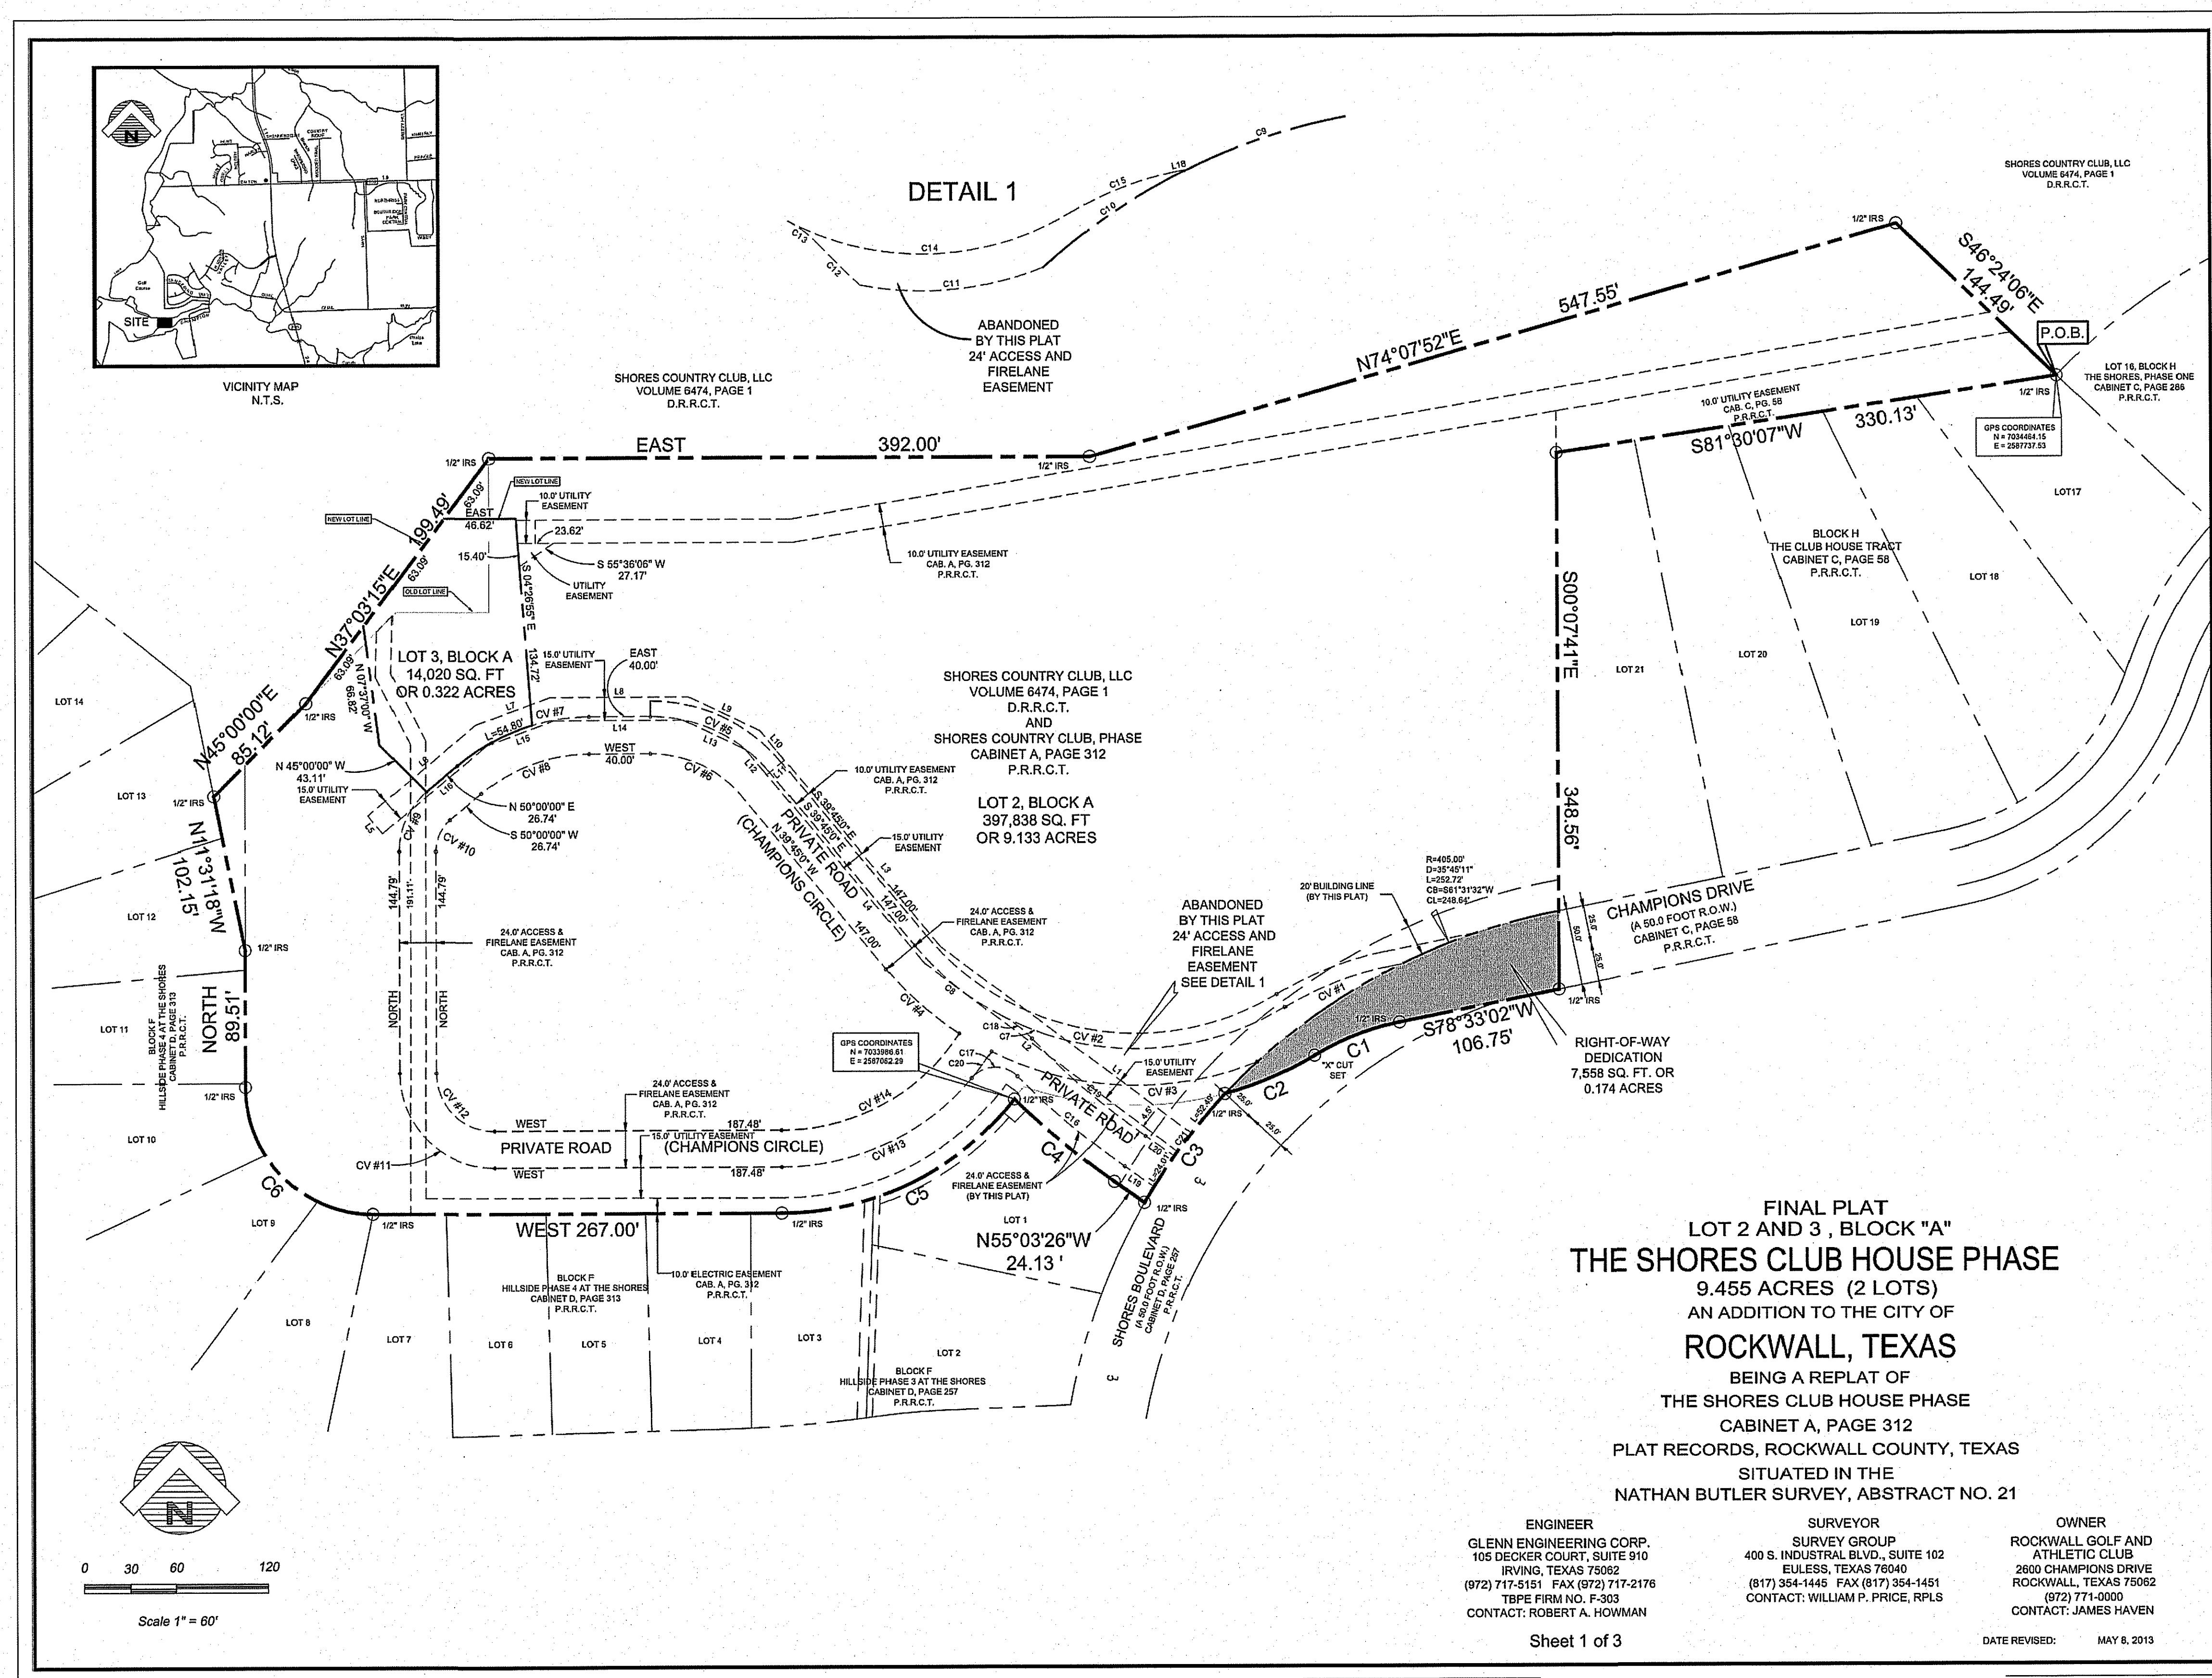

THIS SHEET IS FOR REFERENCE ONLY


RECORD DRAWING
This is to certify that changes and corrections have been made to conform to the contractor's record of this project.
Mike Glenn
Signed Date
Glenn Engineering Corporation
12-03-2015

GLENN ENGINEERING
TEXAS REGISTRATION NUMBER: F-303
PHONE 972-717-5151 FAX 972-717-5152
105 DECKER COURT, SUITE 910 IRVING, TEXAS 75039

SUBMISSION OF BID WILL BE CONSIDERED ACKNOWLEDGMENT THAT THE CONTRACTOR HAS VISITED THE SITE AND HAS VERIFIED ALL EXISTING JOB CONDITIONS AND INCLUDED ANY NECESSARY MODIFICATION TO EXISTING AND NEW WORK REQUIRED FOR INSTALLATION OF A COMPLETE AND WORKING SYSTEM.

NOTE: THE CITY OF ROCKWALL CONSTRUCTION STANDARDS APPLY, WHETHER INDICATED ON THESE PLANS OR NOT.


Apr 24, 2014 - 5:18pm User: Robert
C:\Users\Public\Bob's Projects\JOHNSTON-RAMSAY\SHORES ENG 17.dwg

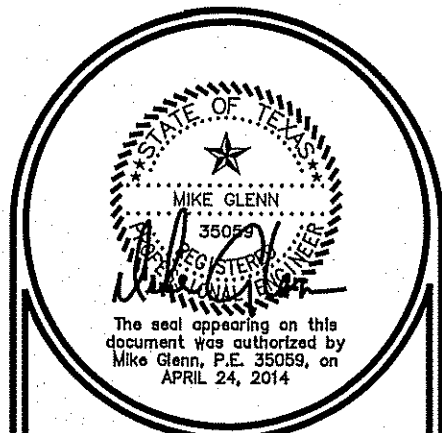

JOHNSTON-RAMSAY

ARCHITECTURE - MANAGEMENT

2235 RIDGE RD. STE. 200 ROCKWALL, TEXAS 75087

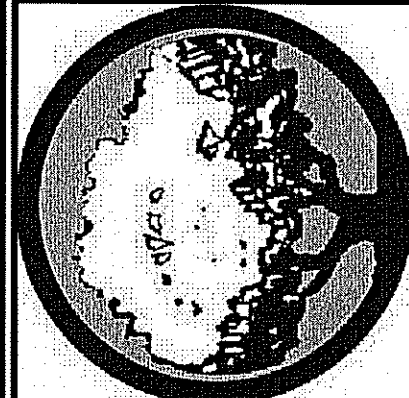

The Shores HOA Clubhouse
2601 Champions Dr. ROCKWALL, TEXAS 75087

©COPYRIGHT 2011. ALL RIGHTS RESERVED
*ALL ELEMENTS OF THIS DRAWING ARE THE INTELLECTUAL
PROPERTY OF JOHNSTON-RAMSAY

DATE
04/24/14

PROJECT
011112

C 104
FINAL PLAT
SHEET 2

CASE # SP 2013-018 LOT 2 - BLOCK H - THE SHORES CLUB HOUSE, PHASE 2

OWNER'S CERTIFICATE

STATE OF TEXAS
COUNTY OF ROCKWALL

WHEREAS, Rockwall Golf and Athletic Club, LLC is the owner of a tract of land in the County of Rockwall, State of Texas, said tract being described as follows:

Being a 9.455 acre tract of land situated in the Nathan Butler Survey, Abstract No. 21 in the City of Rockwall, Rockwall County, Texas, being a portion of that certain tract of land conveyed to Shores Country Club, LLC by deed as recorded in Volume 6474, Page 1, Deed Records, Rockwall County, Texas and being a portion of The Shores Club House Phase, Replat, an addition to the City of Rockwall, according to the plat thereof recorded in Cabinet A, Page 312, Plat Records, Rockwall County, Texas;

BEGINNING at a 1/2 inch iron rod found for corner, said point being at the northeast corner of Lot 17, Bloc H, The Club House Tract Addition, Replat, an addition to the City of Rockwall, Rockwall County, Texas, according to the plat thereof recorded in Cabinet C, Page 68, Plat Records, Rockwall County, Texas, same point being the northwest corner of Lot 16, Block H, The Shores Addition, Phase One, and addition to the City of Rockwall, Rockwall County, Texas, according to the plat thereof recorded in Cabinet A, Slide 286, Plat Records, Rockwall County, Texas, said point also being the most easterly southeast corner of said 9.455 acre tract of land being described;

THENCE South 81 degrees 30 minutes 07 seconds West, along the common line of said The Club House Tract Addition and said 9.455 acre tract of land being described, a distance of 330.13 feet to a 1/2 inch iron rod set for corner, said point being the northwest corner of Lot 21, Block H, The Club House Tract Addition, Replat, an addition to the City of Rockwall, Rockwall County, Texas, according to the plat thereof recorded in Cabinet C, Page 68, Plat Records, Rockwall County, Texas, same point being at an ei corner of said 9.455 acre tract of land being described;

THENCE South 00 degrees 07 minutes 41 seconds East, along the common line of said Lot 21, Block H and said 9.455 acre tract of land being described, a distance of 348.56 feet to a 1/2 inch iron rod set for corner, said point being the most southerly southeast corner of said 9.455 acre tract of land being described, same point being in the south line of said Champions Drive (a 50.0 foot right-of-way);

THENCE South 78 degrees 33 minutes 02 seconds West, along the south line of said 9.455 acre tract of land being described, a distance of 108.75 feet to a 1/2 inch iron rod set for corner, said point being the beginning of a curve to the left having a radius of 175.00 feet a delta angle of 19 degrees 36 minutes 21 seconds, and a chord bearing and distance of South 68 degrees 44 minutes 51 seconds West, 59.59 feet;

THENCE in a southwesterly direction along said curve to the left and along said south line of said 9.455 acre tract of land being described, an arc distance of 59.88 feet to an "X" cul set for corner, said point being at the centerline of Shores Boulevard (a 50.0 foot right-of-way), said point being the beginning of a reverse curve to the right having a radius of 225.00 feet, a delta angle of 16 degrees 14 minutes 02 seconds, and a chord bearing and distance of South 67 degrees 03 minutes 56 seconds West, 63.54 feet;

THENCE in a southwesterly direction along said curve to the right, an arc distance of 63.75 feet to a 1/2 inch iron rod set for corner, said point being in the north line of said Shores Boulevard, said point being the beginning of a curve to the left having a radius of 405.00 feet a delta angle of 12 degrees 31 minutes 28 seconds, and a chord bearing and distance of South 36 degrees 30 minutes 29 seconds West, 88.35 feet;

THENCE in a southwesterly direction along said curve to the left and along said north line of said Shores Boulevard, an arc distance of 88.53 feet to 1/2 inch iron rod set for corner, said point being the most southerly southwest corner of said 9.455 acre tract of land being described, said point being the east corner of Lot 1, Block F, Hillside Phase 3 at The Shores Addition, an addition to the City of Rockwall, Rockwall County, Texas, according to the plat thereof recorded in Cabinet D, Page 257, Plat Records, Rockwall County, Texas;

THENCE North 55 degrees 03 minutes 26 seconds West, departing the north line of said Shores Boulevard and along the common line of said Lot 1 and said 9.455 acre tract of land being described, a distance of 24.13 feet to a 1/2 inch iron rod set for corner, said point being the beginning of a curve to the right having a radius of 510.00 feet a delta angle of 09 degrees 30 minutes 50 seconds, and a chord bearing and distance of North 50 degrees 18 minutes 01 seconds West, 84.59 feet;

THENCE in a northwesterly direction along said curve to the right and continuing along said common line of said Lot 1 and said 9.455 acre tract of land being described, an arc distance of 84.68 feet to 1/2 inch iron rod set for corner, said point being the northeast corner of said Lot 1, Block F, same point being the beginning of a non-tangent curve to the right having a radius of 192.00 feet, a delta angle of 52 degrees 05 minutes 10 seconds, and a chord bearing and distance of South 63 degrees 57 minutes 25 seconds West, 168.59 feet;

THENCE in a southwesterly direction and along said curve to the right, and along the common line of said 9.455 acre tract of land being described and said Hillside Phase 4 at The Shores Addition, an arc distance of 174.54 feet to a 1/2 inch iron rod set for corner;

THENCE South 90 degrees 00 minutes 00 seconds West, continuing along the common line of said 9.455 acre tract of land being described and said Hillside Phase 4 at The Shores Addition, a distance of 267.00 feet to a 1/2 inch iron rod set for corner, said point being in the north line of Lot 7, Block F, Hillside Phase 4 at The Shores Addition, an addition to the City of Rockwall, Rockwall County, Texas, according to the plat thereof recorded in Cabinet D, Page 257, Plat Records, Rockwall County, Texas, same point being the beginning of a curve to the right having a radius of 83.00 feet a delta angle of 90 degrees 00 minutes 00 seconds, and a chord bearing and distance of North 45 degrees 00 minutes 00 seconds West, 117.38 feet;

THENCE in a northwesterly direction and along said curve to the right, and continuing along the common line of said 9.455 acre tract of land being described and said Hillside Phase 4 at The Shores Addition, an arc distance of 130.38 feet to a 1/2 inch iron rod set for corner;

THENCE North 00 degrees 00 minutes 00 seconds East, continuing along the common line of said 9.455 acre tract of land being described and said Hillside Phase 4 at The Shores Addition, a distance of 89.51 feet to a 1/2 inch iron rod set for corner;

THENCE North 11 degrees 31 minutes 18 seconds West, continuing along the common line of said 9.455 acre tract of land being described and said Hillside Phase 4 at The Shores Addition, a distance of 102.15 feet to a 1/2 inch iron rod set for corner, said point being the most westerly northwest corner of said The Shores Club House Phase;

THENCE North 45 degrees 00 minutes 00 seconds East, departing the east line of said Hillside Phase 4 at The Shores Addition and along the north line of said The Shores Club House Phase, a distance of 85.12 feet to a 1/2 inch iron rod set for corner;

THENCE North 37 degrees 03 minutes 15 seconds East, a distance of 199.49 feet to a 1/2 inch iron rod set for corner;

THENCE North 90 degrees 00 minutes 00 seconds East, along the north line of said The Shores Club House Phase, a distance of 392.00 feet to a 1/2 inch iron rod set for corner;

THENCE North 74 degrees 07 minutes 52 seconds East, continuing along the north line of said The Shores Club House Phase, a distance of 547.55 feet to a 1/2 inch iron rod set for corner, said point being the northeast corner of said The Shores Club House Phase;

THENCE South 46 degrees 24 minutes 06 seconds East, continuing along the north line of said The Shores Club House Phase, a distance of 144.49 feet to the POINT OF BEGINNING and containing 411,858 square feet or 9.455 acre of computed land

OWNER'S DEDICATION

NOW, THEREFORE, KNOW ALL MEN BY THESE PRESENTS:

STATE OF TEXAS
COUNTY OF ROCKWALL

We Rockwall Golf and Athletic Club, LLC the undersigned owner of the land shown on this plat, and designated herein as the THE SHORES CLUB HOUSE, PHASE 2 ADDITION, REPLAT subdivision to the City of Rockwall, Texas, and whose name is subscribed hereto, hereby dedicate to the use of the public forever all streets, alleys, parks, water courses, drains, easements and public places thereon shown on the purpose and consideration therein expressed. We further certify that all other parties who have a mortgage or lien interest in the THE SHORES CLUB HOUSE, PHASE 2 ADDITION, REPLAT subdivision have been notified and signed this plat.

We understand and do hereby reserve the easement strips shown on this plat for the purposes stated and for the mutual use and accommodation of all utilities desiring to use or using same. We also understand the following;

- No buildings shall be constructed or placed upon, over, or across the utility easements as described herein.
- Any public utility shall have the right to remove and keep removed all or part of any buildings, fences, trees, shrubs, or other growths or improvements which in any way endanger or interfere with construction, maintenance or efficiency of their respective system on any of these easement strips; and any public utility shall at all times have the right of ingress or egress to, from and upon the said easement strips for purpose of construction, reconstruction, inspecting, patrolling, maintaining, and either adding to or removing all or part of their respective system without the necessity of, at any time, procuring the permission of anyone.
- The City of Rockwall will not be responsible for any claims of any nature resulting from or occasioned by the establishment of grade of streets in the subdivision.
- The developer and subdivision engineer shall bear total responsibility for storm drain improvements.
- The developer shall be responsible for the necessary facilities to provide drainage patterns and drainage controls such that properties within the drainage area are not adversely affected by storm drainage from the development.
- No house dwelling unit, or other structure shall be constructed on any lot in this addition by the owner or any other person until the developer and/or owner has complied with all requirements of the Subdivision Regulations of the City of Rockwall regarding improvements with respect to the entire block on the street or streets on which property abuts, including the actual installation of streets with the required base and paving, curb and gutter, water and sewer, drainage structures, storm structures, storm sewers, and alleys, all according to the specifications of the City of Rockwall; or

Until an escrow deposit, sufficient to pay for the cost of such improvements, as determined by the city's engineer and/or city administrator, computed on a private commercial rate basis, has been made with the city secretary, accompanied by an agreement signed by the developer and/or owner, authorizing the city to make such improvements at prevailing private commercial rates, or have the same made by a contractor and pay for the same out of the escrow deposit, should the developer and/or owner fail or refuse to install the required improvements within the time stated in such written agreement, but in no case shall the City be obligated to make such improvements itself. Such deposit may be used by the owner and/or developer as progress payments as the work progresses in making such improvements by making certified requisitions to the city secretary, supported by evidence of work done; or

Until the developer and/or owner files a corporate surety bond with the city secretary in a sum equal to the cost of such improvements for the designated area, guaranteeing the installation thereof within the time stated in the bond, which time shall be fixed by the city council of the City of Rockwall.

We further acknowledge that the dedications and/or exaction's made herein are proportional to the impact of the Subdivision upon the public services required in order that the development will comport with the present and future growth needs of the City; We our successors and assigns hereby waive any claim, damage, or cause of action that we may have as a result of the dedication of exactions made herein.

Owners

STATE OF TEXAS
COUNTY OF ROCKWALL

Before me, the undersigned authority, on this day personally appeared _____, known to me to be the person whose name is subscribed to the foregoing instrument, and acknowledged to me that he executed the same for the purpose and consideration therein stated.

Given upon my hand and seal of office this _____ day of _____, 2014

Notary Public in and for the State of Texas My Commission Expires:

Signature of Party with Mortgage or Lien Interest

STATE OF TEXAS
COUNTY OF ROCKWALL

Before me, the undersigned authority, on this day personally appeared _____, known to me to be the person whose name is subscribed to the foregoing instrument, and acknowledged to me that he executed the same for the purpose and consideration therein stated.

Given upon my hand and seal of office this _____ Day of _____

Notary Public in and for the State of Texas My Commission Expires:

NOTE: It shall be the policy of the City of Rockwall to withhold issuing building permits until all streets, water, sewer and storm drainage systems have been accepted by the City. The approval of a plat by the City does not constitute any representation, assurance or guarantee that any building within such plat shall be approved, authorized or permit therefore issued, nor shall such approval constitute any representation, assurance or guarantee by the City of the adequacy and availability for water for personal use and fire protection within such plat, as required under Ordinance 85-54.

SURVEYOR'S CERTIFICATE

NOW, THEREFORE KNOW ALL MEN BY THESE PRESENTS:

THAT I, William P. Price, do hereby certify that I prepared this plat from an actual and accurate survey of the land, and that the corner monuments shown thereon were properly placed under my personal supervision.

William P. Price
Registered Public Surveyor No.3047

STATE OF TEXAS
COUNTY OF ROCKWALL

Before me, the undersigned authority, on this day personally appeared William P. Price, known to me to be the person whose name is subscribed to the foregoing instrument, and acknowledged to me that he executed the same for the purpose and consideration therein stated.

Given upon my hand and seal of office this _____ Day of _____, 2014.

Notary Public in and for the State of Texas My Commission Expires:

RECOMMENDED FOR FINAL APPROVAL

Planning and Zoning Commission Date

APPROVED

I hereby certify that the above and foregoing plat of an addition to the City of Rockwall, Texas, was approved by the City Council of the City of Rockwall on the _____ day of _____, 2013.

This approval shall be invalid unless the approved plat for such addition is recorded in the office of the County Clerk of Rockwall, County, Texas, within on hundred eighty (180) days from said date of final approval.

WITNESS OUR HANDS, this _____ day of _____, 2014.

Mayor, City of Rockwall City Secretary City Engineer

NOTES:

P.R.R.C.T. - PLAT RECORDS ROCKWALL COUNTY TEXAS
D.R.R.C.T. - DEED RECORDS ROCKWALL COUNTY TEXAS
P.O.B. - POINT OF BEGINNING
P.O.C. - POINT OF COMMENCING
1. IRF - Iron Rod Found
2. IRFC - Iron Rod Found Capped
3. IRS - Iron Rod Set
4. C.M. - Controlling Monument
6. Basis of Bearing - The Basis of Bearing of this survey is N 90°00'00" East, as shown hereon, based on the north line of The Shores Club House Phase, an addition to the City of Rockwall, according to the plat thereof recorded in Cabinet A, Page 312, Plat Records, Rockwall County, Texas.

FINAL PLAT
LOT 2 AND 3 , BLOCK "A"
THE SHORES CLUB HOUSE PHASE
9.455 ACRES (2 LOTS)
AN ADDITION TO THE CITY OF
ROCKWALL, TEXAS
BEING A REPLAT OF
THE SHORES CLUB HOUSE PHASE
CABINET A, PAGE 312
PLAT RECORDS, ROCKWALL COUNTY, TEXAS
SITUATED IN THE
NATHAN BUTLER SURVEY, ABSTRACT NO. 21

ENGINEER
GLENN ENGINEERING CORP.
105 DECKER COURT, SUITE 910
IRVING, TEXAS 75062
(972) 717-5151 FAX (972) 717-2176
TBE FIRM NO. F-303
CONTACT: ROBERT A. HOWMAN

SURVEYOR
SURVEY GROUP
400 S. INDUSTRIAL BLVD., SUITE 102
EULESS, TEXAS 75040
(817) 354-1445 FAX (817) 354-1451
CONTACT: WILLIAM P. PRICE, RPLS

OWNER
ROCKWALL GOLF AND
ATHLETIC CLUB
2800 CHAMPIONS DRIVE
ROCKWALL, TEXAS 75082
(972) 771-0000
CONTACT: JAMES HAVEN

Sheet 2 of 3

DATE REVISED: MAY 8, 2013

RECORD DRAWING

This is to certify that changes and corrections have been made to conform to the contractor's record of this project.

Signed _____ Date 12-03-2015

Glenn Engineering Corporation



GLENN
ENGINEERING

TEXAS REGISTRATION NUMBER: F-303
PHONE 972-717-5151 FAX 972-717-2176
105 DECKER COURT, SUITE 910 IRVING, TEXAS 75062

SUBMISSION OF BID WILL BE CONSIDERED ACKNOWLEDGMENT THAT THE CONTRACTOR HAS VISITED THE SITE AND HAS VERIFIED ALL EXISTING JOB CONDITIONS AND INCLUDED ANY NECESSARY MODIFICATION TO EXISTING AND NEW WORK REQUIRED FOR INSTALLATION OF A COMPLETE AND WORKING SYSTEM.

THIS SHEET IS FOR REFERENCE ONLY

NOTE: THE CITY OF ROCKWALL CONSTRUCTION STANDARDS APPLY, WHETHER INDICATED ON THESE PLANS OR NOT.

Apr 24, 2014 - 5:10pm User: Robert
C:\Users\Public\Jobs\Projects\JIMMY STROHMAYER\SHORES\BIDSET\SHORES ENG 17.dwg

THIS SHEET IS FOR REFERENCE ONLY

NOTE: THE CITY OF ROCKWALL CONSTRUCTION STANDARDS APPLY, WHETHER INDICATED ON THESE PLANS OR NOT.

| CURVE TABLE | | | | | |
|-------------|-----------|-----------|-------------|----------------|-----------|
| C= | R= | L= | D= | CB= | CL= |
| C1 | R=175.00' | L=59.88' | D=19°36'21" | CB=S68°44'51"W | CL=59.59 |
| C2 | R=225.00' | L=63.75' | D=16°14'02" | CB=S67°03'56"W | CL=63.54 |
| C3 | R=405.00' | L=88.53' | D=12°31'28" | CB=S36°30'29"W | CL=88.35 |
| C4 | R=510.00' | L=84.69' | D=9°30'51" | CB=N50°18'01"W | CL=84.59 |
| C5 | R=192.00' | L=174.54' | D=32°05'10" | CB=S63°57'25"W | CL=168.59 |
| C6 | R=83.00' | L=130.38' | D=90°00'00" | CB=N45°00'00"W | CL=117.38 |
| C7 | R=188.00' | L=15.00' | D=4°34'22" | CB=S69°13'52"E | CL=15.00 |
| C8 | R=188.00' | L=73.56' | D=22°25'02" | CB=S50°57'14"E | CL=73.09 |
| C9 | R=405.00' | L=109.10' | D=15°26'05" | CB=S71°41'04"W | CL=108.77 |
| C10 | R=405.00' | L=113.94' | D=16°07'11" | CB=S55°54'26"W | CL=113.57 |
| C11 | R=212.00' | L=121.82' | D=32°55'25" | CB=S84°38'35"W | CL=120.15 |
| C12 | R=474.00' | L=38.30' | D=4°37'45" | CB=N45°31'42"W | CL=38.29 |
| C13 | R=75.00' | L=24.80' | D=18°56'54" | CB=N52°41'17"W | CL=24.69 |
| C14 | R=188.00' | L=193.23' | D=58°53'21" | CB=N68°23'36"E | CL=184.83 |
| C15 | R=212.00' | L=72.54' | D=19°36'21" | CB=N68°44'52"E | CL=72.19 |
| C16 | R=498.00' | L=91.62' | D=10°32'29" | CB=N49°47'12"W | CL=91.49 |
| C17 | R=20.00' | L=33.31' | D=95°25'36" | CB=S87°46'14"W | CL=29.59 |
| C18 | R=75.00' | L=24.80' | D=18°56'54" | CB=S52°41'17"E | CL=24.69 |
| C19 | R=474.00' | L=97.98' | D=11°50'38" | CB=S49°08'08"E | CL=97.80 |
| C20 | R=162.00' | L=21.44' | D=7°35'04" | CB=N36°15'54"E | CL=21.43 |
| C21 | R=405.00' | L=15.00' | D=02°07'20" | CB=N36°54'22"W | CL=15.00 |

| LINE TABLE | | |
|------------|--------|-------------|
| LINE | LENGTH | BEARING |
| L1 | 204.57 | S53°05'38"E |
| L2 | 206.32 | N53°05'38"W |
| L3 | 164.98 | S39°45'00"E |
| L4 | 166.74 | N39°45'00"W |
| L5 | 15.00 | N40°00'00"W |
| L6 | 91.94 | N50°00'00"E |
| L7 | 51.53 | N70°00'00"E |
| L8 | 90.68 | N90°00'00"E |
| L9 | 51.33 | S64°52'30"E |
| L10 | 25.04 | S39°45'00"E |
| L11 | 15.00 | S50°15'00"W |
| L12 | 21.69 | N39°45'00"W |
| L13 | 44.65 | N64°52'30"W |
| L14 | 84.69 | S90°00'00"W |
| L15 | 46.24 | S70°00'00"W |
| L16 | 89.30 | S50°00'00"W |
| L17 | 28.12 | N20°46'08"E |
| L18 | 8.77 | S78°33'02"W |
| L19 | 23.33 | S55°03'28"E |
| L20 | 22.78 | S55°03'28"E |

PRIVATE ROAD CURVE TABLE

| | | | | |
|--|---|---|---|---|
| CV #1 Delta = 19°36'21" Radius = 212.00 Length = 72.19 Ch Brg = N 68°44'52" E | CV #4 Delta = 17°13'32" Radius = 212.00 Length = 63.74 Ch Brg = S 48°21'30" E | CV #7 Delta = 40°00'00" Radius = 133.66 Length = 93.31 Ch Brg = N 70°00'00" E | CV #10 Delta = 50°00'00" Radius = 26.60 Length = 23.21 Ch Brg = N 25°00'00" E | CV #13 Delta = 57°31'38" Radius = 162.00 Length = 162.65 Ch Brg = S 61°14'11" W |
| CV #2 Delta = 81°18'21" Radius = 188.00 Length = 266.78 Ch Brg = S 80°23'55" E | CV #5 Delta = 50°15'00" Radius = 101.22 Length = 88.77 Ch Brg = S 64°52'30" E | CV #8 Delta = 40°00'00" Radius = 109.68 Length = 76.56 Ch Brg = N 70°00'00" E | CV #11 Delta = 90°00'00" Radius = 62.00 Length = 97.39 Ch Brg = N 45°00'00" W | CV #14 Delta = 57°03'30" Radius = 138.00 Length = 137.43 Ch Brg = S 61°28'15" W |
| CV #3 Delta = 48°20'57" Radius = 212.00 Length = 178.90 Ch Brg = N 87°38'39" W | CV #6 Delta = 50°15'00" Radius = 77.22 Length = 67.72 Ch Brg = S 64°52'30" E | CV #9 Delta = 50°00'00" Radius = 50.60 Length = 44.16 Ch Brg = N 25°00'00" E | CV #12 Delta = 90°00'00" Radius = 38.00 Length = 59.69 Ch Brg = N 45°00'00" W | |

FINAL PLAT
LOT 2 AND 3 , BLOCK "A"
THE SHORES CLUB HOUSE PHASE
9.455 ACRES (2 LOTS)
AN ADDITION TO THE CITY OF
ROCKWALL, TEXAS
BEING A REPLAT OF
THE SHORES CLUB HOUSE PHASE
CABINET A, PAGE 312
PLAT RECORDS, ROCKWALL COUNTY, TEXAS
SITUATED IN THE
NATHAN BUTLER SURVEY, ABSTRACT NO. 21


| | | |
|---|---|--|
| ENGINEER GLENN ENGINEERING CORP. 105 DECKER COURT, SUITE 910 IRVING, TEXAS 75062 (972) 717-5151 FAX (972) 717-2178 TBP FIRM NO. F-303 CONTACT: ROBERT A. HOWMAN | SURVEYOR SURVEY GROUP 400 S. INDUSTRIAL BLVD., SUITE 102 EULESS, TEXAS 76040 (817) 354-1445 FAX (817) 354-1451 CONTACT: WILLIAM P. PRICE, RPLS | OWNER ROCKWALL GOLF AND ATHLETIC CLUB 2600 CHAMPIONS DRIVE ROCKWALL, TEXAS 75062 (972) 771-0000 CONTACT: JAMES HAVEN |
|---|---|--|

Sheet 3 of 3

DATE REVISED: MAY 8, 2013


RECORD DRAWING

This is to certify that changes and corrections have been made to conform to the contractor's record of this project.

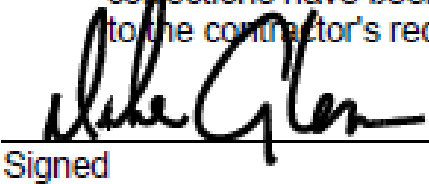
Signed


12-03-2015
Date

Glenn Engineering Corporation


**GLENN
ENGINEERING**

TEXAS REGISTRATION NUMBER: F-303
PHONE 972-717-5151 FAX 972-717-2178
105 DECKER COURT, SUITE 910 IRVING, TEXAS 75062

SUBMISSION OF BID WILL BE CONSIDERED ACKNOWLEDGMENT THAT THE CONTRACTOR HAS VISITED THE SITE AND HAS VERIFIED ALL EXISTING JOB CONDITIONS AND INCLUDED ANY NECESSARY MODIFICATION TO EXISTING AND NEW WORK REQUIRED FOR INSTALLATION OF A COMPLETE AND WORKING SYSTEM.

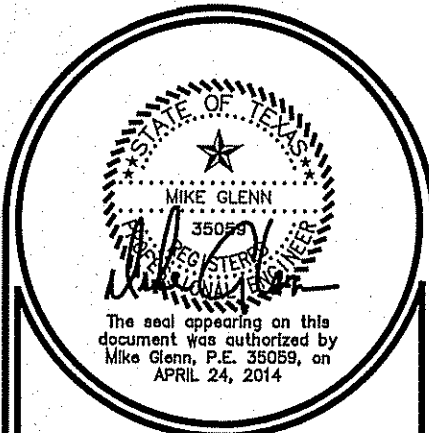

JOHNSTON-RAMSAY
ARCHITECTURE - MANAGEMENT
2235 RIDGE RD. STE. 200 ROCKWALL, TEXAS 75087

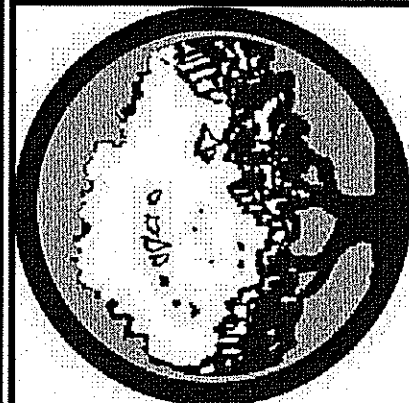


The Shores HOA Clubhouse
2601 Champions Dr. ROCKWALL, TEXAS 75087
*ALL RIGHTS RESERVED
*ALL ELEMENTS OF THIS DRAWING ARE THE INTELLECTUAL
PROPERTY OF JOHNSTON-RAMSAY

DATE
04/24/14

PROJECT
011112

C 1.05
FINAL PLAT
SHEET 3


CASE # SP 2013-018 LOT 2 - BLOCK H - THE SHORES CLUB HOUSE, PHASE 2

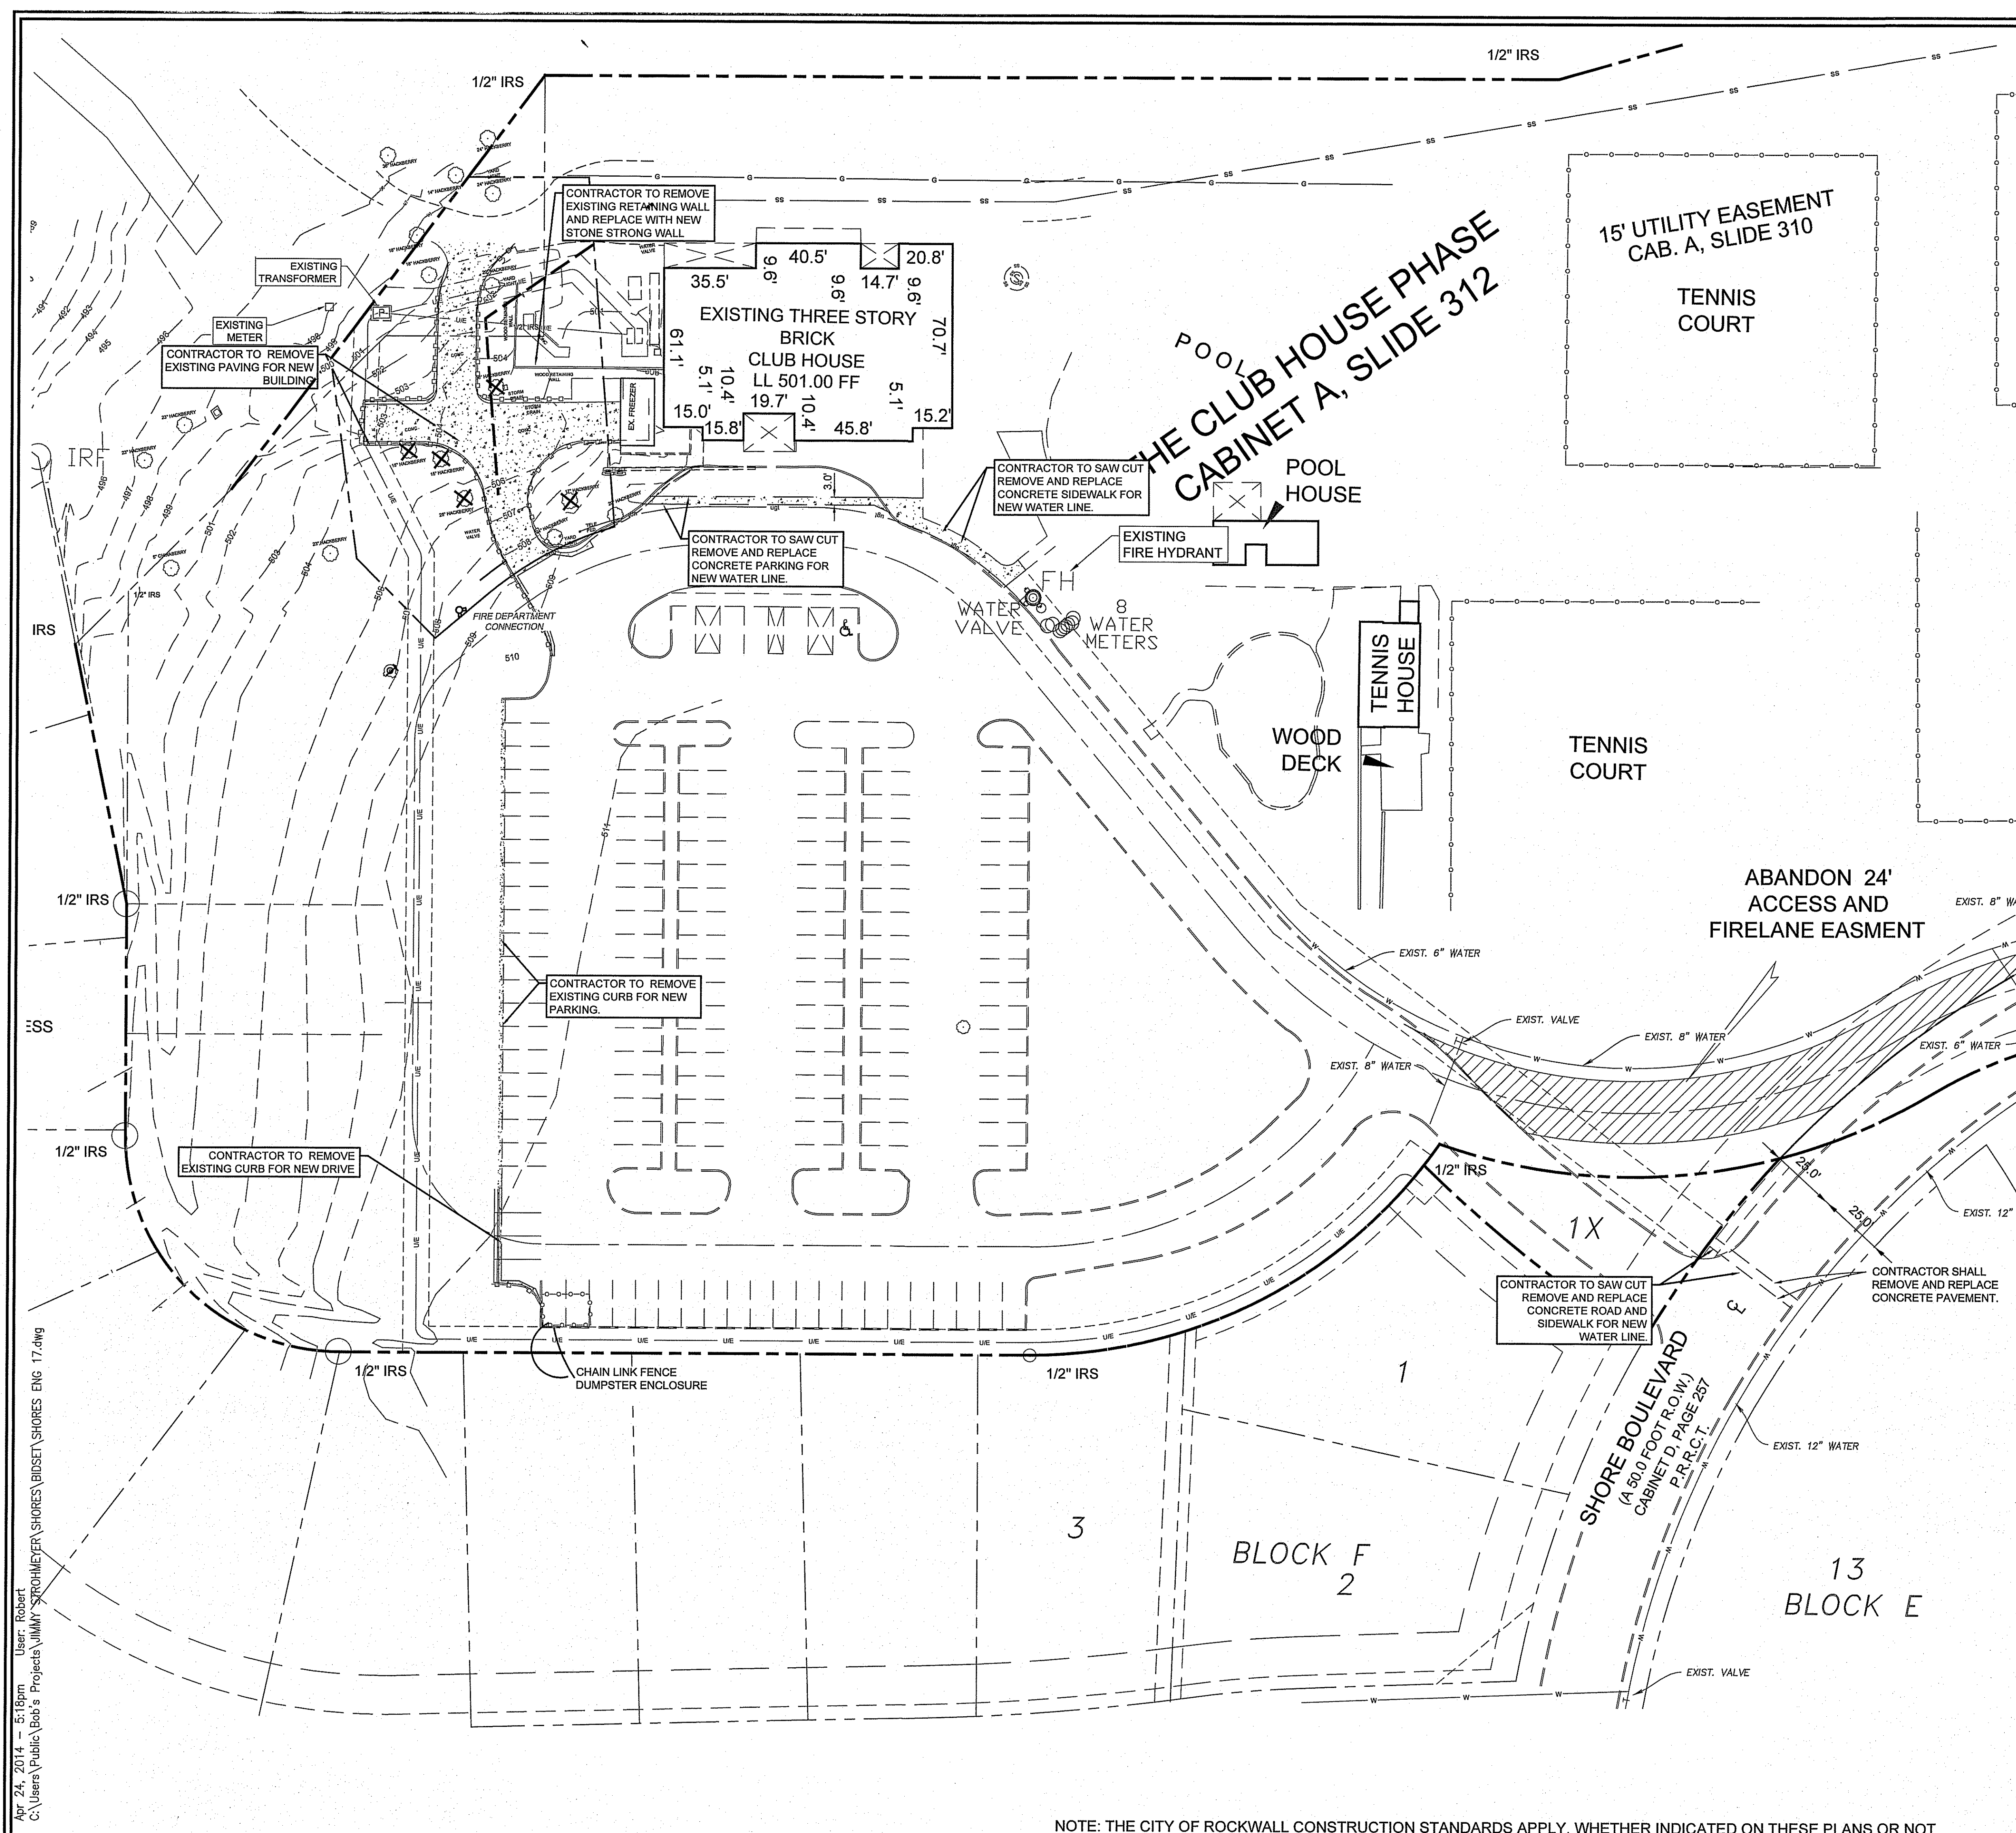

- DEMOLITION NOTES:**
1. CONTRACTOR SHALL CONSULT ALL UTILITY COMPANIES AND VERIFY LOCATION OF ALL UNDERGROUND UTILITIES PRIOR TO DEMOLITION. REMOVAL AND RELOCATION OF ALL UTILITY LINES, METERS, VALVES, ETC. SHALL BE PERFORMED PER REQUIREMENTS OF THE CITY OF ROCKWALL & UTILITY COMPANIES. ANY DAMAGE TO PUBLIC UTILITIES SHALL BE THE GENERAL CONTRACTOR'S RESPONSIBILITY TO CORRECT.
 2. ALL DEMOLITION AND CONSTRUCTION TO BE KEPT WITHIN THE BOUNDARIES OF THE SITE OR AS DESIGNATED BY CONSTRUCTION ENGINEER. ANY DAMAGE BY CONTRACTOR TO ADJOINING PROPERTIES OR ITEMS NOT IN THE DESIGNATED DEMOLITION AREA SHALL BE THE GENERAL CONTRACTOR'S RESPONSIBILITY TO CORRECT.
 3. REMOVE SURFACE PAVING AS NEEDED TO COMPLETE PAVING PLAN.
 4. REMOVE EXISTING SIGNAGE, INCLUDING POSTS AND FOUNDATIONS.
 5. REMOVE ANY OTHER ITEMS NOT INDICATED ABOVE BUT WHICH MUST BE DEMOLISHED TO COMPLETE PROJECT AS DESIGNATED BY SITE PLAN.

SPRINKLER NOTES:

NOTE:
Contractor shall terminate/cap off all irrigation lines as required. The Contractor is responsible for making all necessary changes to the irrigation system that are required to keep the remaining areas outside the construction areas in working order. This includes relocation of any valves, piping, controls, etc. to operate the system.
At the completion of the construction project, this contractor is responsible for installation of an irrigation system throughout the areas that were involved in the construction. Equipment installed shall be the same as that which was removed. Owner will provide the equipment that was removed to the contractor. Any additional equipment required will be by the contractor.

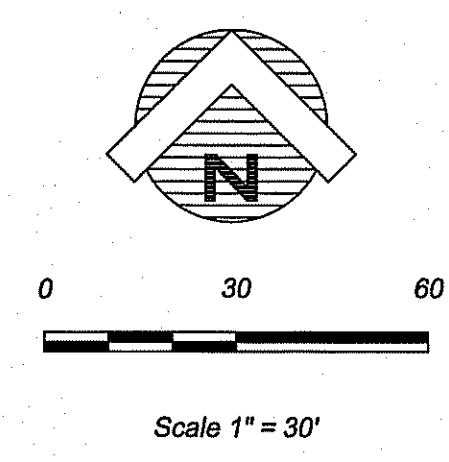

DEMOLITION LEGEND:

| | |
|--|--|
| | EXISTING CONCRETE TO BE REMOVED AND HAULED OFF |
| | EXISTING TREE TO BE REMOVED AND HAULED OFF |

RECORD DRAWING


This is to certify that changes and corrections have been made to conform to the contractor's record of this project.

12-03-2015
Signed Date
Glenn Engineering Corporation


GLENN ENGINEERING
TEXAS REGISTRATION NUMBER: F-303
PHONE 972-717-5151 FAX 972-717-5175
105 DECKER COURT, SUITE 910 IRVING, TEXAS 75062

SUBMISSION OF BID WILL BE CONSIDERED ACKNOWLEDGMENT THAT THE CONTRACTOR HAS VISITED THE SITE AND HAS VERIFIED ALL EXISTING JOB CONDITIONS AND INCLUDED ANY NECESSARY MODIFICATION TO EXISTING AND NEW WORK REQUIRED FOR INSTALLATION OF A COMPLETE AND WORKING SYSTEM.

NOTE: THE CITY OF ROCKWALL CONSTRUCTION STANDARDS APPLY, WHETHER INDICATED ON THESE PLANS OR NOT.

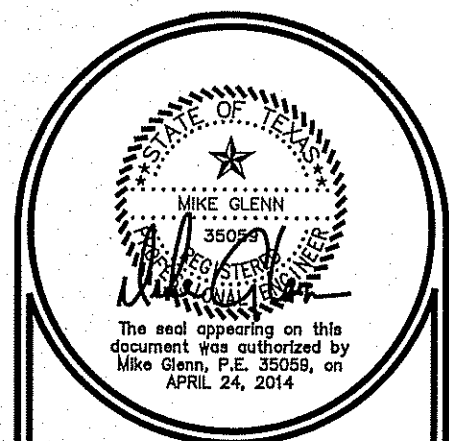

JOHNSTON-RAMSAY
ARCHITECTURE - MANAGEMENT
2235 RIDGE RD. STE. 200 ROCKWALL, TEXAS 75087

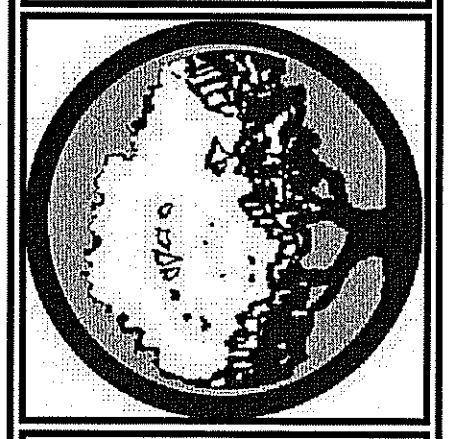

The Shores HOA Clubhouse
2601 Champions Dr. ROCKWALL, TEXAS 75087

©COPYRIGHT 2011. ALL RIGHTS RESERVED
*ALL ELEMENTS OF THIS DRAWING ARE THE INTELLECTUAL PROPERTY OF JOHNSTON-RAMSAY

DATE
04/24/14


PROJECT
011112

CD 1.01
DEMOLITION PLAN

CASE # SP 2013-018 LOT 2 - BLOCK H - THE SHORES CLUB HOUSE, PHASE 2

Apr 24, 2014 - 5:16pm
User: Robert
C:\Users\Public\Bob's Projects\JIMMY STROHMEYER\SHORES\BIDSET\SHORES ENG 17.dwg

Apr 24, 2014 - 5:18pm
C:\Users\Public\Bob's Projects\JIMMY STROHMEYER\SHORES\BIDSET\SHORES ENG 17.dwg
User: Robert

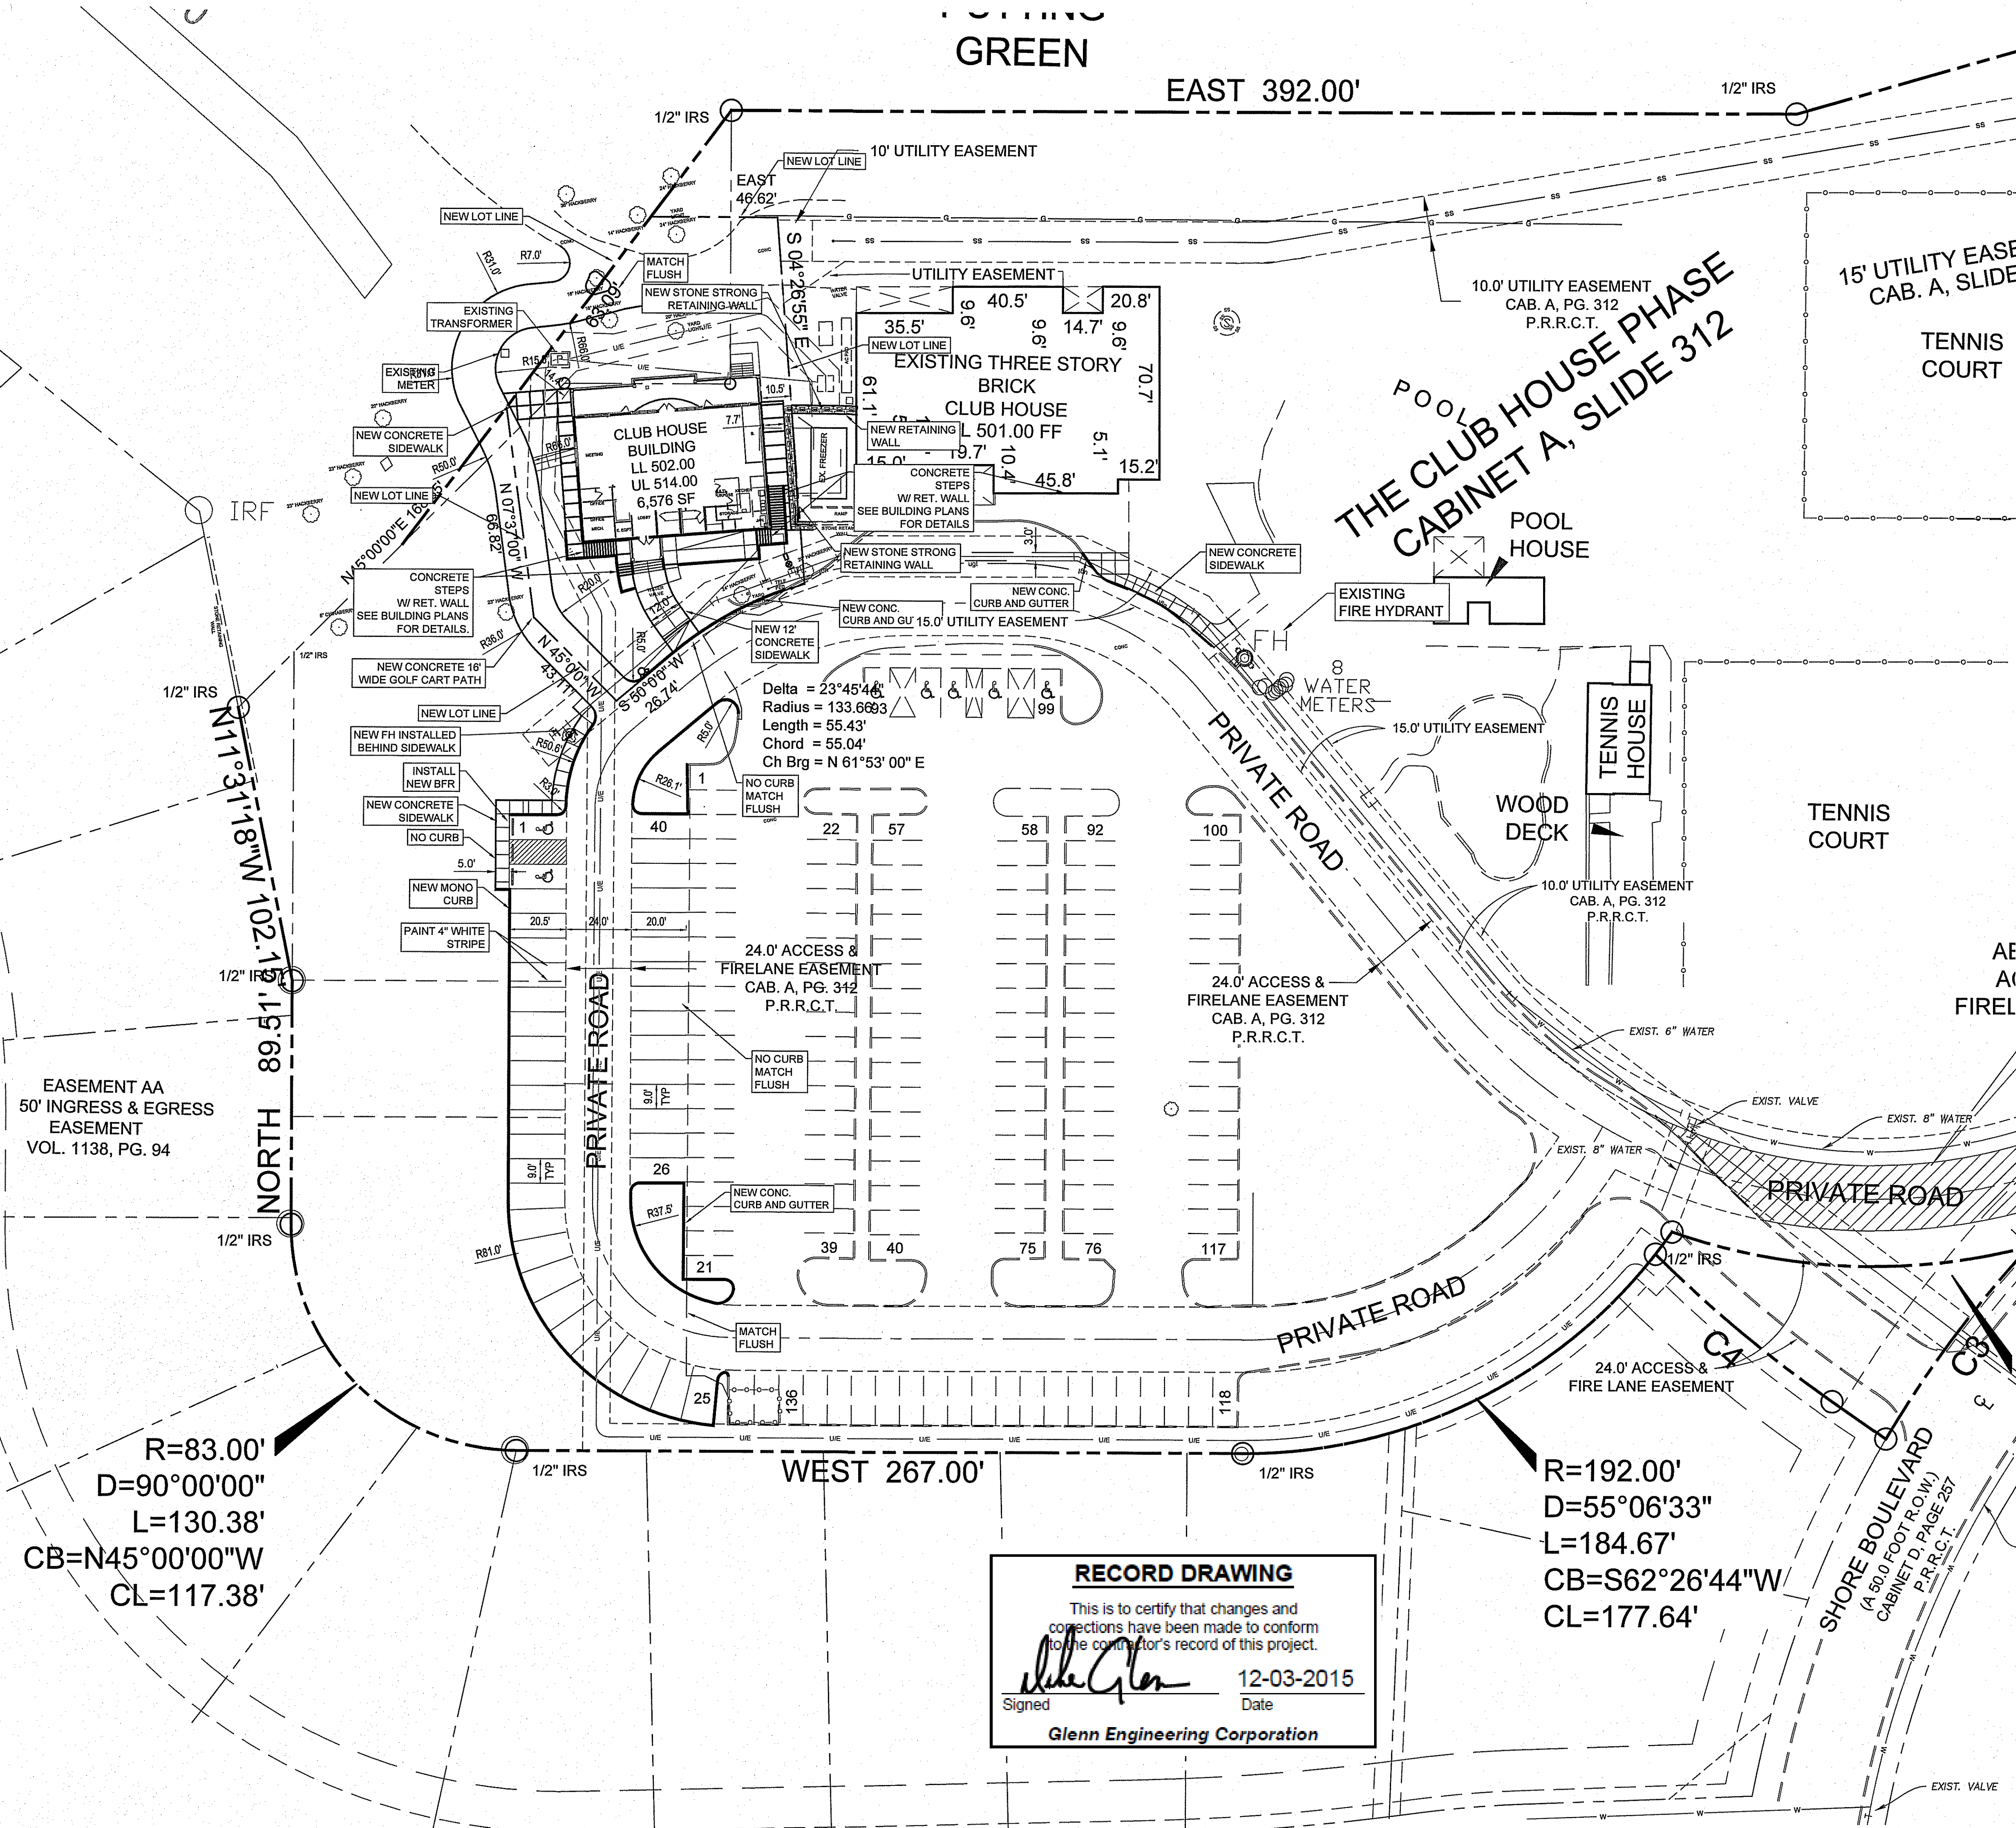

GENERAL NOTES:

1. PRIOR TO ANY CONSTRUCTION THE CONTRACTOR SHALL FAMILIARIZE HIMSELF WITH THE CONTRACT DOCUMENTS AND SPECIFICATIONS. THE PLANS INCLUDING ALL NOTES, THE CITY'S SPECIFICATIONS AND ANY OTHER APPLICABLE STANDARDS OR SPECIFICATIONS RELEVANT TO THE PROPER COMPLETION OF THE WORK SPECIFIED. FAILURE ON THE PART OF THE CONTRACTOR TO FAMILIARIZE HIMSELF WITH ALL STANDARDS OR SPECIFICATIONS PERTAINING TO THIS WORK SHALL IN NO WAY RELIEVE THE CONTRACTOR OF RESPONSIBILITY FOR PERFORMING THE WORK IN ACCORDANCE WITH ALL SUCH APPLICABLE STANDARDS AND SPECIFICATIONS.
2. CONTRACTOR SHALL HAVE IN HIS POSSESSION, PRIOR TO CONSTRUCTION, ALL NECESSARY PERMITS, LICENSES, ETC. CONTRACTOR SHALL HAVE AT LEAST ONE SET OF APPROVED ENGINEERING PLANS AND SPECIFICATIONS ON-SITE AT ALL TIMES.
3. ALL WORK SHALL CONFORM TO THE CITY OF ROCKWALL SPECIFICATIONS, STANDARDS, AND DETAILS AND N.C.T.C.O.G., 3rd ADDITION.
4. IF UNFORESEEN PROBLEMS OR CONFLICTS ARE ENCOUNTERED IN THE CONSTRUCTION, FOR WHICH AN IMMEDIATE SOLUTION IS NOT APPARENT, THE ENGINEER AND OWNER SHALL BE NOTIFIED IMMEDIATELY.
5. IT WILL BE THE RESPONSIBILITY OF EACH CONTRACTOR TO PROTECT ALL EXISTING PUBLIC AND PRIVATE UTILITIES THROUGHOUT THE CONSTRUCTION OF THIS PROJECT. CONTRACTOR SHALL CONTACT THE APPROPRIATE UTILITY COMPANIES FOR LINE LOCATIONS, PRIOR TO COMMENCEMENT OF CONSTRUCTION AND SHALL ASSUME FULL LIABILITY TO THOSE COMPANIES FOR ANY DAMAGES CAUSED TO THEIR FACILITIES.
6. CONTRACTORS SHALL BE RESPONSIBLE FOR FIELD LOCATING EXISTING UTILITIES AND IMPROVEMENTS PRIOR TO CONSTRUCTION.

GENERAL NOTES:

1. STRIPING & SIGNAGE DIMENSIONS ARE FROM FACE OF CURB.
2. CONCRETE SIDEWALKS SHALL BE A MINIMUM OF 4 INCHES THICK, CONSTRUCTED OF 3,600 PSI, 6.5 SACK MIX, 28 DAYS CONCRETE WITH 4-6% ENTRAINED AIR AND REINFORCED WITH #3 BARS AT 18" O.C.E.W. TOOLED CONSTRUCTION JOINTS SHALL BE 5'-0" O.C. ONE-HALF INCH EXPANSION JOINTS SHALL BE PLACED EVERY 40 FEET AND WHERE NEW WORK IS CONSTRUCTED ADJACENT TO OTHER CONCRETE WORK (WALLS, FOUNDATION, CURB, ETC.), THE JOINTS SHALL BE FILLED WITH 1/2 INCH PRE-MOLDED GRAY BITUMINOUS EXPANSION JOINT FILLER AND SHALL EXTEND THE ENTIRE DEPTH AND WIDTH OF THE CONCRETE SECTION. ALL HC RAMPS TO BE TRUNCATED DOME PLATES, COLOR TO MATCH CITY SPECIFICATIONS.
- FINISH OF SIDEWALKS SHALL BE WITH A BROOM FINISH PER ENGINEER WALKS SHALL HAVE TOOLED CURB EDGES.
3. ANY PAVEMENT DAMAGED DURING CONSTRUCTION SHALL BE REPLACED BY CONTRACTOR TO MEET OR EXCEED EXISTING CONDITIONS.

ALL RESPONSIBILITY FOR ADEQUACY OF DESIGN REMAINS WITH THE DESIGN ENGINEER. THE CITY OF ROCKWALL, IN REVIEWING THE PLANS FOR CONSTRUCTIONS, ASSUMES NO RESPONSIBILITY FOR THE ADEQUACY OR ACCURACY OF DESIGN.

CONTRACTOR SHALL VERIFY ALL EXISTING INVERTS AND ELEVATIONS PRIOR TO CONSTRUCTION.

ZONING

ZONED PD-3

BUILDING DATA

2 - STORY
MAX. BUILDING HEIGHT - 28'-0"

TOTAL SQUARE FEET (BOTH FLOORS) - 6,576 SF

USE - CLUB HOUSE


| LOT 2 LAND COVERAGE 0.32 ACRES | | |
|--------------------------------|-------------|--------------|
| TOTAL LAND AREA | 14,020 S.F. | |
| OPEN SPACE | 5,916 S.F. | 42.2 PERCENT |
| BUILDING FOOTPRINT | 6,576 S.F. | 46.9 PERCENT |
| PAVING AND WALKS | 1,528 S.F. | 10.9 PERCENT |

IMPERVIOUS CALCULATION

| | |
|------------------------------------|-----------------------|
| BUILDING, SIDEWALKS AND PAVING | 8,104 SF |
| EXISTING CART PATH (TO BE REMOVED) | 3,601 SF |
| NET IMPERVIOUS AREA ADDED | 4,503 SF. OR 0.10 AC. |

PARKING TABULATIONS PROVIDED


| | |
|--|-----|
| EXISTING PARKING PROVIDED = VISITOR/STAFF REGULAR (9' X 18.0') | 131 |
| VISITOR/STAFF HANDICAP | + 5 |
| EXISTING PARKING PROVIDED | 136 |
| PROPOSED PARKING PROVIDED = VISITOR/STAFF REGULAR (9' X 18.0') | 38 |
| VISITOR/STAFF HANDICAP | + 2 |
| PROPOSED PARKING PROVIDED | 40 |
| TOTAL PARKING PROVIDED | 176 |

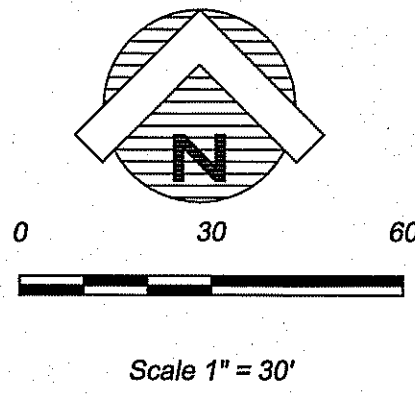


RECORD DRAWING
This is to certify that changes and corrections have been made to conform to the contractor's record of this project.
[Signature]
Signed _____ Date 12-03-2015
Glenn Engineering Corporation

GLENN ENGINEERING
TEXAS REGISTRATION NUMBER: F-303
PHONE 972-717-5151 105 DECKER COURT, SUITE 910 IRVING, TEXAS 75062
FAX 972-717-5176

SUBMISSION OF BID WILL BE CONSIDERED ACKNOWLEDGMENT THAT THE CONTRACTOR HAS VISITED THE SITE AND HAS VERIFIED ALL EXISTING JOB CONDITIONS AND INCLUDED ANY NECESSARY MODIFICATION TO EXISTING AND NEW WORK REQUIRED FOR INSTALLATION OF A COMPLETE AND WORKING SYSTEM.

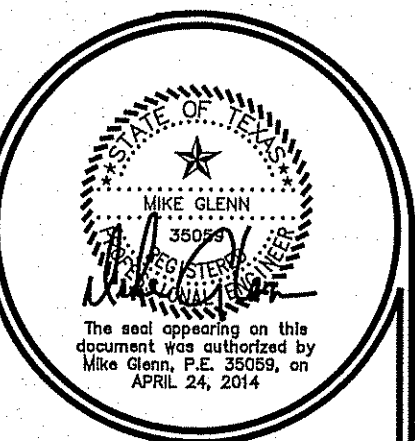

JOHNSTON-RAMSAY
ARCHITECTURE - MANAGEMENT
2235 RIDGE RD. STE. 200 ROCKWALL, TEXAS 75087

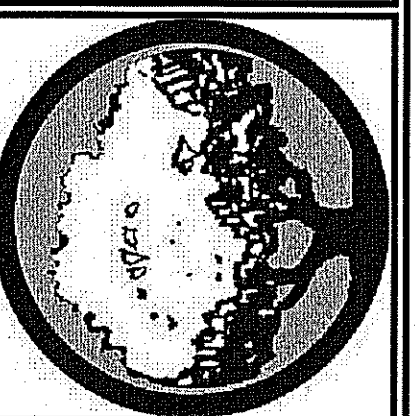

The Shores HOA Clubhouse
2601 Champions Dr. ROCKWALL, TEXAS 75087
©COPYRIGHT 2011. ALL RIGHTS RESERVED
*ALL ELEMENTS OF THIS DRAWING ARE THE INTELLECTUAL PROPERTY OF JOHNSTON-RAMSAY

DATE 04/24/14
PROJECT 011112
CS 1.01
SITE PLAN

NOTE: THE CITY OF ROCKWALL CONSTRUCTION STANDARDS APPLY, WHETHER INDICATED ON THESE PLANS OR NOT.

CASE # SP 2013-018 LOT 2 - BLOCK H - THE SHORES CLUB HOUSE, PHASE 2

ALL FILL MATERIAL PLACED EITHER ON-SITE OR OFF-SITE SHALL BE COMPACTED TO A MINIMUM OF 95% STANDARD PROCTOR DENSITY IN 8 INCH LIFTS PER GEOTECHNICAL REPORT, USING A SHEEP'S FOOT ROLLER.

FINISHED GRADE TO BE LEVEL WITH PROPOSED PAVEMENT WHEN ON UPSTREAM SIDE.

FINISHED GRADE TO BE 2" BELOW PROPOSED PAVEMENT WHEN ON DOWNSTREAM SIDE OF PAVEMENT. TOP OF SOD WILL BE LEVEL WITH PAVEMENT.

ALL CONSTRUCTION SHALL BE PER CITY OF ROCKWALL STANDARDS

CONTRACTOR SHALL VERIFY ALL EXISTING INVERTS AND ELEVATIONS PRIOR TO CONSTRUCTION.

ALL RESPONSIBILITY FOR ADEQUACY OF DESIGN REMAINS WITH THE DESIGN ENGINEER. THE CITY OF ROCKWALL, IN REVIEWING THE PLANS FOR CONSTRUCTIONS, ASSUMES NO RESPONSIBILITY FOR THE ADEQUACY OR ACCURACY OF DESIGN.

GRADING DETAIL FOR PAVEMENT WITHOUT CURB

nts

PUTTING GREEN

1/2" IRS

1/2" IRS

10' UTILITY EASEMENT

UTILITY EASEMENT

10.0' UTILITY EASEMENT
CAB. A, PG. 312
P.R.R.C.T.

POOL
THE CLUB HOUSE PHASE
CABINET A, SLIDE 312

FF = 501.00

15.0' UTILITY EASEMENT

PRIVATE ROAD

WOOD DECK

10.0' UTILITY EASEMENT
CAB. A, PG. 312
P.R.R.C.T.

24.0' ACCESS & FIRELANE EASEMENT
CAB. A, PG. 312
P.R.R.C.T.

24.0' ACCESS & FIRELANE EASEMENT
CAB. A, PG. 312
P.R.R.C.T.

24.0' ACCESS & FIRE LANE EASEMENT

EASEMENT AA
50' INGRESS & EGRESS
EASEMENT
VOL. 1138, PG. 94

1/2" IRS

1/2" IRS

1/2" IRS


1/2" IRS

GENERAL GRADING AND DRAINAGE NOTES

- ALL CONSTRUCTION TO BE IN ACCORDANCE WITH THESE PLANS AND CITY OF ROCKWALL STANDARDS AND SPECIFICATIONS AND N.C.T.C.O.G., 3RD EDITION.
- PRIOR TO STARTING CONSTRUCTION, THE CONTRACTOR SHALL MAKE CERTAIN THAT ALL REQUIRED PERMITS AND APPROVALS HAVE BEEN OBTAINED. NO CONSTRUCTION OR FABRICATION SHALL BEGIN UNTIL THE CONTRACTOR HAS RECEIVED AND THOROUGHLY REVIEWED ALL PLANS AND OTHER DOCUMENTS APPROVED BY ALL OF THE PERMITTING AUTHORITIES.
- ALL WORK SHALL BE PERFORMED IN ACCORDANCE WITH THESE PLANS AND SPECIFICATIONS AND THE REQUIREMENTS AND STANDARDS OF THE LOCAL GOVERNING AUTHORITY.
- IN THE EVENT AN ITEM IS NOT COVERED IN THE CITY OF ROCKWALL SPECIFICATIONS, THE CITY ENGINEER'S DECISION SHALL APPLY.
- BARRICADING, TRAFFIC CONTROL, AND PROJECT SIGNS SHALL CONFORM TO "STATE DEPARTMENT OF HIGHWAYS AND PUBLIC TRANSPORTATION BARRICADING AND CONSTRUCTION STANDARDS".
- THE GENERAL CONTRACTOR AND ALL SUB-CONTRACTORS SHALL VERIFY THE SUITABILITY OF ALL EXISTING AND PROPOSED SITE CONDITIONS INCLUDING GRADES AND DIMENSIONS BEFORE COMMENCEMENT OF ANY CONSTRUCTION. IN THE EVENT OF ANY CONFLICT AND PRIOR TO COMMENCEMENT OF ANY CONSTRUCTION, IMMEDIATELY NOTIFY ENGINEER. MINOR ADJUSTMENTS OF FINISH GRADE TO ACCOMPLISH SPOT DRAINAGE ARE ACCEPTABLE, IF NECESSARY, UPON PRIOR APPROVAL OF ENGINEER. PAVING INSTALLED SHALL FLUSH OUT AT ANY JUNCTURE WITH EXISTING PAVING.
- THE LOCATIONS OF UNDERGROUND UTILITIES SHOWN ON THIS PLAN ARE BASED ON FIELD SURVEYS AND LOCAL UTILITY COMPANY RECORDS. IT SHALL BE THE CONTRACTOR'S FULL RESPONSIBILITY TO CONTACT THE VARIOUS UTILITY COMPANIES TO LOCATE THEIR UTILITIES PRIOR TO STARTING CONSTRUCTION.
- CONTRACTOR SHALL VERIFY ALL EXISTING INVERTS AND RIM ELEVATIONS PRIOR TO CONSTRUCTION.
- ALL PROPOSED CONTOURS ARE APPROXIMATE. PROPOSED SPOT ELEVATIONS AND DESIGNATED GRADIENT ARE TO BE USED IN THE EVENT OF ANY DISCREPANCIES.
- IT IS THE CONTRACTOR'S RESPONSIBILITY TO LOCATE AND/OR ESTABLISH A BENCHMARK (BASE UPON EXISTING CONDITION SHOWN ON THIS PLAN) PRIOR TO CONSTRUCTION.
- AT ALL DOORWAYS CONCRETE SIDEWALK SHALL MEET FLUSH WITH FOUNDATION SLAB AND MEET ALL ADA AND TDLR REQUIREMENTS.
- ALL EXISTING UTILITIES SHALL BE ADJUSTED BY THE CONTRACTOR DUE TO CONSTRUCTION.


LEGEND

- 756.40 TW - PROPOSED TOP OF WALK
- 753.80 TP - PROPOSED TOP OF PAVEMENT
- 754.00 TC - PROPOSED TOP OF CURB
- 753.50 GR - PROPOSED TOP OF GROUND
- 757.00 TS - PROPOSED TOP OF SLAB
- 750 - EXISTING CONTOUR
- 435.77XGR - EXISTING SHOTS
- 435.77XTI - EXISTING TOP INLET
- 435.77XTC - EXISTING TOP CURB
- - - - - DIRECTION OF FLOW

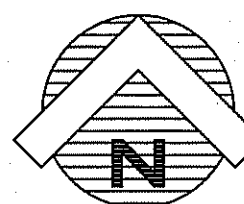

0 30 60


Scale 1" = 30'

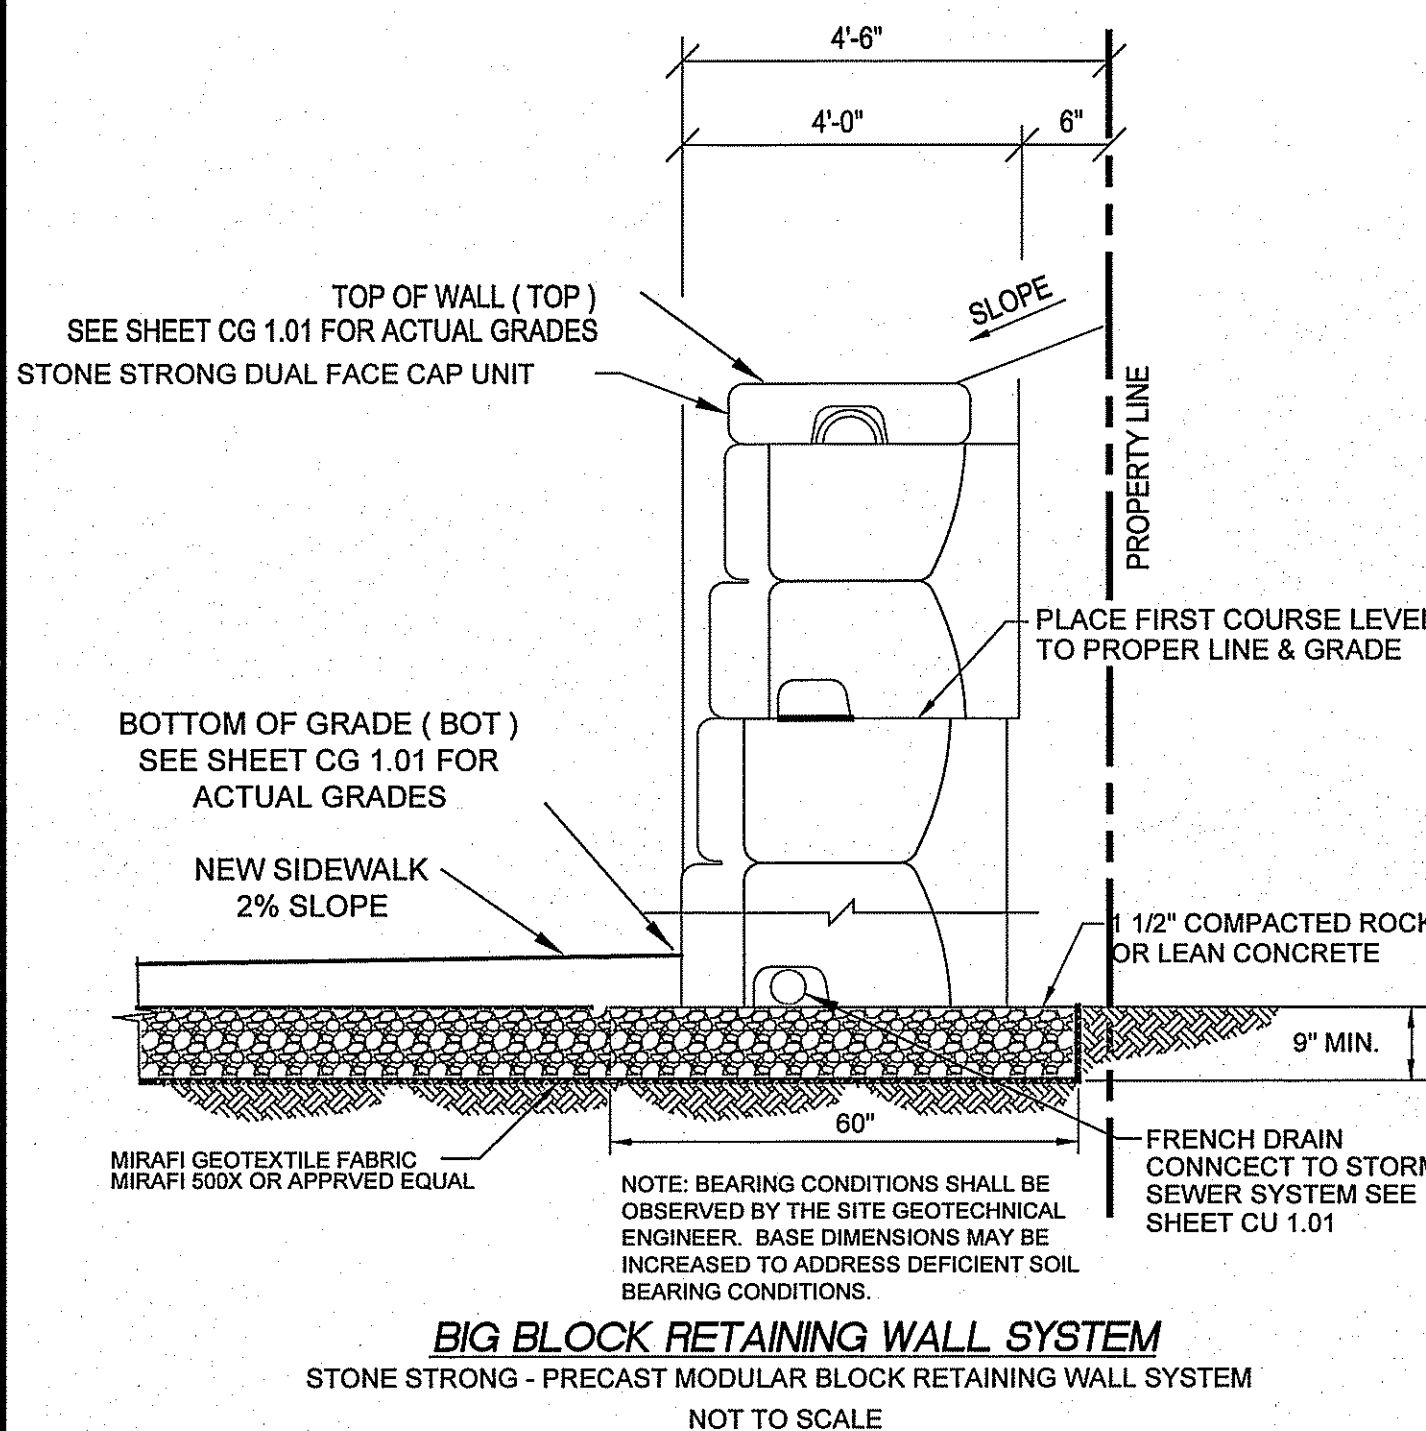

RECORD DRAWING

This is to certify that changes and corrections have been made to conform to the contractor's record of this project.

Signed *Glenn* Date 12-03-2015
Glenn Engineering Corporation

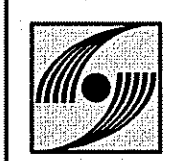

GLENN ENGINEERING
TEXAS REGISTRATION NUMBER: F-303
PHONE 972-717-2151 FAX 972-717-2176
105 DECKER COURT, SUITE 910 IRVING, TEXAS 75062


SUBMISSION OF BID WILL BE CONSIDERED ACKNOWLEDGMENT THAT THE CONTRACTOR HAS VISITED THE SITE AND HAS VERIFIED ALL EXISTING JOB CONDITIONS AND INCLUDED ANY NECESSARY MODIFICATION TO EXISTING AND NEW WORK REQUIRED FOR INSTALLATION OF A COMPLETE AND WORKING SYSTEM.



JOHNSTON-RAMSAY

ARCHITECTURE - MANAGEMENT

2235 RIDGE RD. STE. 200 ROCKWALL, TEXAS 75087

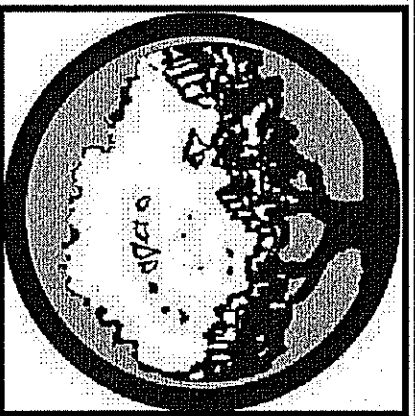

The Shores HOA Clubhouse
2601 Champions Dr. ROCKWALL, TEXAS 75087

*ALL ELEMENTS OF THIS DRAWING ARE THE INTELLECTUAL PROPERTY OF JOHNSTON-RAMSAY

DATE

04/24/14

PROJECT

011112


CQ 1.01

GRADING PLAN

CASE # SP 2013-018 LOT 2 - BLOCK H - THE SHORES CLUB HOUSE, PHASE 2

NOTE: THE CITY OF ROCKWALL CONSTRUCTION STANDARDS APPLY, WHETHER INDICATED ON THESE PLANS OR NOT.

Apr. 24, 2014 - 5:20pm User: Robert
C:\Users\Public\Bob's Projects\JOHNSTON RAMSAY\STROHMEYER SHORES\BIDSET\SHORES ENG 6 DA MAP.DWG

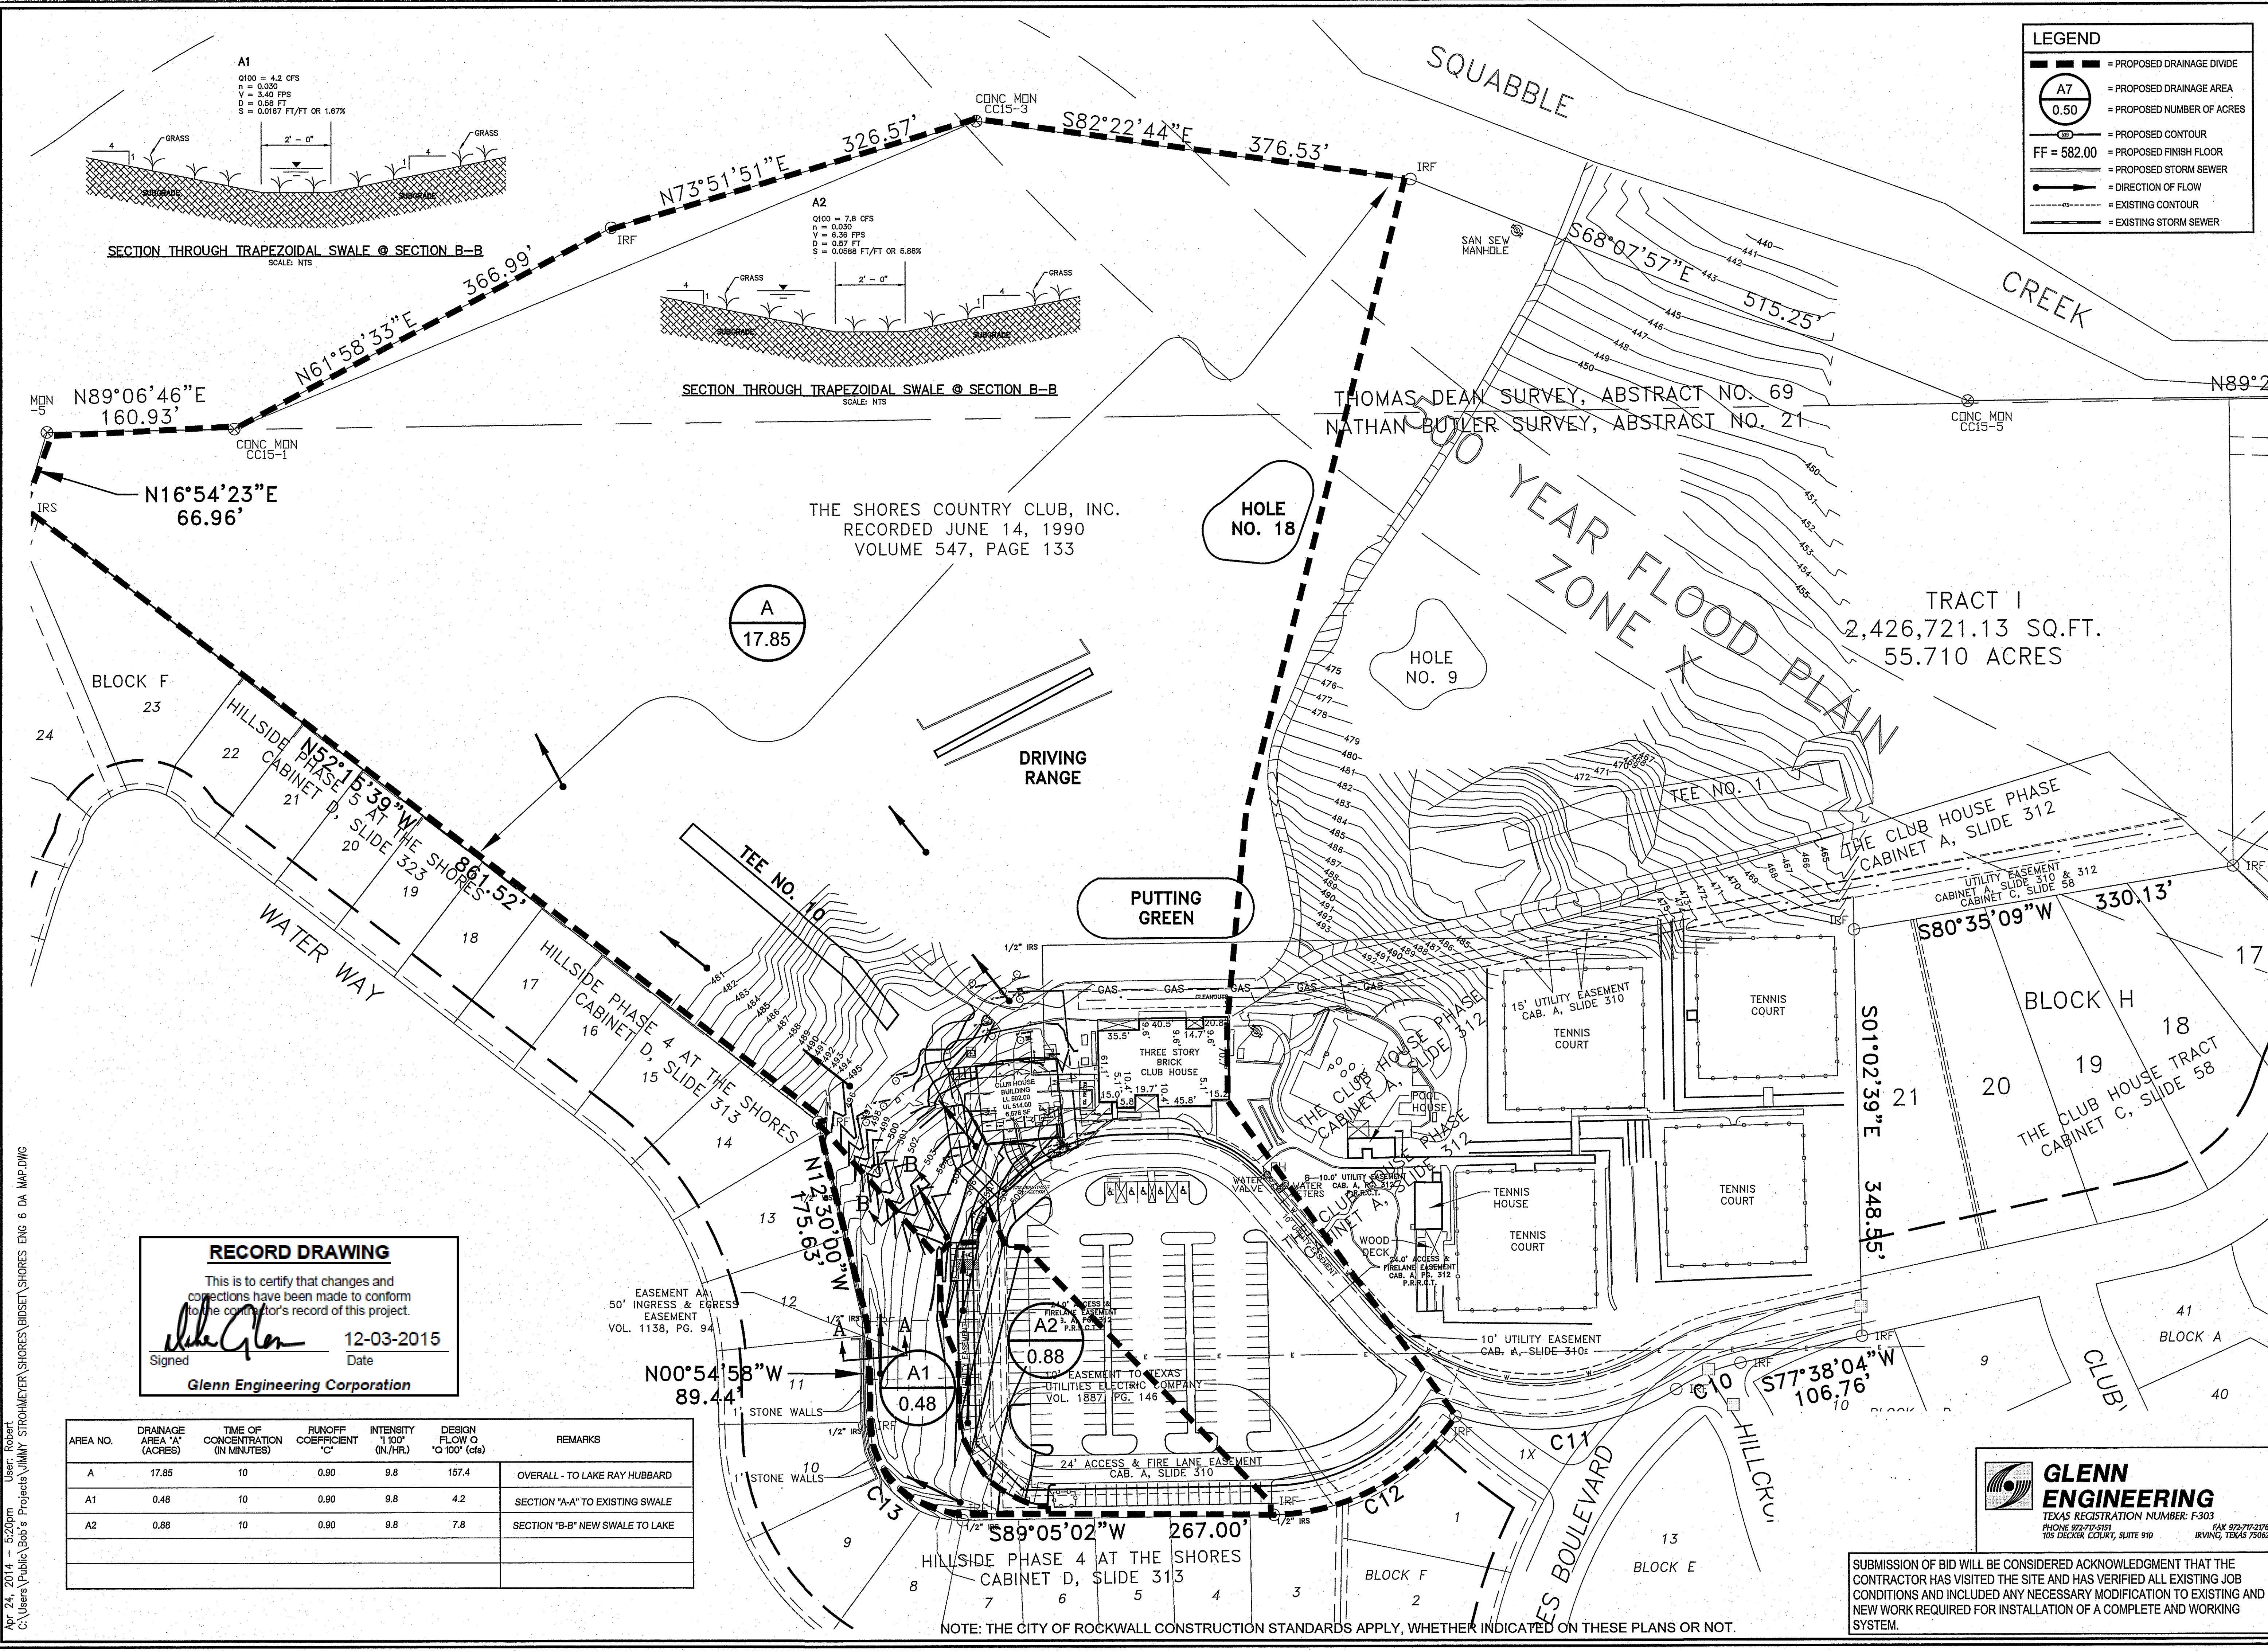

JOHNSTON-RAMSAY
ARCHITECTURE - MANAGEMENT
2235 RIDGE RD. STE. 200 ROCKWALL, TEXAS 75087


The Shores HOA Clubhouse
2601 Champions Dr. ROCKWALL, TEXAS 75087
©COPYRIGHT 2011. ALL RIGHTS RESERVED
*ALL ELEMENTS OF THIS DRAWING ARE THE INTELLECTUAL PROPERTY OF JOHNSTON-RAMSAY

DATE
04/24/14


PROJECT
011112

CG 102
DRAINAGE
AREA MAP

CASE # SP 2013-018 LOT 2 - BLOCK H - THE SHORES CLUB HOUSE, PHASE 2

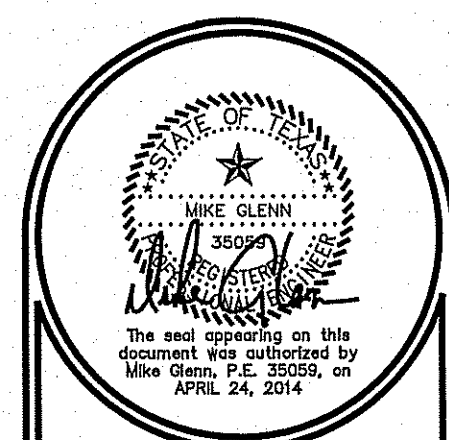

JOHNSTON-RAMSAY
ARCHITECTURE - MANAGEMENT
2235 RIDGE RD. STE. 200 ROCKWALL, TEXAS 75087

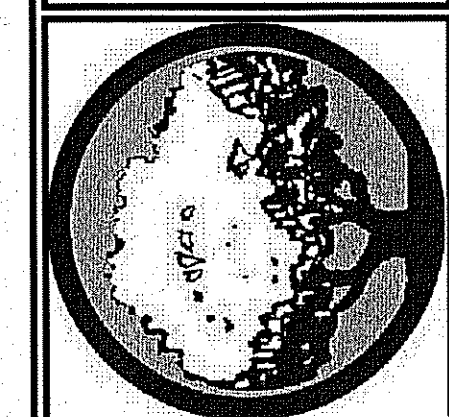

The Shores HOA Clubhouse
2601 Champions Dr. ROCKWALL, TEXAS 75087
©COPYRIGHT 2011. ALL RIGHTS RESERVED
*ALL ELEMENTS OF THIS DRAWING ARE THE INTELLECTUAL PROPERTY OF JOHNSTON-RAMSAY

DATE
04/24/14
PROJECT
011112
CQ 103
SWPPP PLAN

SEDIMENT CONTROL NOTES

1. CONTRACTOR TO CHOOSE LOCATION OF CONSTRUCTION ENTRANCE. THIS ENTRANCE MUST BE USED BY ALL TRAFFIC ENTERING OR EXITING THE SITE. SEE SHEET FOR STABILIZED CONSTRUCTION ENTRANCE DETAILS.
2. SEDIMENT CONTROL DEVICES SHALL BE INSTALLED ACCORDING TO THE CONTRACT DOCUMENTS AND AS DIRECTED BY THE ENGINEER. ALL DEVICES SHALL BE MAINTAINED SUCH THAT THEY FUNCTION AS INTENDED THROUGHOUT THE ENTIRE CONSTRUCTION PERIOD.
3. CURB INLET PROTECTION SHALL BE INSTALLED AS SOON AS STORM DRAINAGE HAS BEEN CONSTRUCTED.
4. PLYWOOD INLET PROTECTION TO BE PLACED AT UPSTREAM END OF ALL UNFINISHED PIPING AT DAYS END.
5. ALL SEDIMENT CONTROL MEASURES TO REMAIN IN PLACE UNTIL ENTIRE SITE IS STABILIZED.
6. THE EXTENT AND DURATION OF DISTURBANCE TO THE DRAINAGEWAYS SHALL BE MINIMIZED. THE FOLLOWING CONSTRUCTION SEQUENCE SHALL BE FOLLOWED:
 - A. INSTALL STABILIZED CONSTRUCTION ENTRANCE.
 - B. INSTALL SILT FENCE PRIOR TO DISTURBING SOIL. PERIMETER SILT FENCE TO BE INSTALLED OUTSIDE OF ANY POINT TO BE DISTURBED.
 - C. DURING CONSTRUCTION, INLET PROTECTION SHALL BE INSTALLED AS NEEDED. ALL SEDIMENT CONTROL MEASURES SHALL BE INSPECTED AND MAINTAINED PER CONTRACT REQUIREMENTS. ALL DISTURBED AREAS WHICH ARE INACTIVE FOR LONG PERIODS OF TIME SHALL BE VEGETATED.
 - D. ONLY WHEN ENTIRE SITE IS STABILIZED AND CONSTRUCTION IS COMPLETED, SHALL SEDIMENT CONTROL MEASURES BE REMOVED.
7. CONTRACTOR SHALL CONTROL MUD ACCUMULATION ON ALL STREETS SURROUNDING THE PROJECT. NO MUD ACCUMULATION WILL BE ALLOWED IN PUBLIC STREETS.
8. MAINTAIN ALL FILTERS DURING CONSTRUCTION TO PREVENT ANY BLOCKAGES FROM ACCUMULATED SEDIMENT. ADDITIONAL HAY BALES MAY BE REQUIRED DURING CONSTRUCTION AS SPECIFIED BY ENGINEER OR CITY INSPECTOR.
9. ALL PROPOSED PARKING AREAS TO BE PAVED AS SOON AS POSSIBLE AFTER SUBGRADE IS PREPARED.
10. CONTRACTOR SHALL REMOVE ALL TEMPORARY EROSION AND SEDIMENT CONTROLS ONLY WHEN THERE IS A SUFFICIENT GROWTH OF GROUND COVER TO PREVENT FURTHER EROSION.
11. GROUND COVER (VEGETATION) SHALL BE ESTABLISHED IMMEDIATELY UPON ESTABLISHING FINAL GRADE AT ANY LOCATION.
12. ALL POSSIBLE EROSION CONTROL DEVICES SHALL BE INSTALLED BEFORE ANY OTHER LAND DISTURBING ACTIVITY OCCURS.
13. 75% - 80% OF ALL DISTURBED AREAS TO HAVE A MINIMUM OF 1" STAND OF GRASS PRIOR TO ENGINEERING ACCEPTANCE.

ALL RESPONSIBILITY FOR ADEQUACY OF DESIGN REMAINS WITH THE DESIGN ENGINEER. THE CITY OF ROCKWALL, IN REVIEWING THE PLANS FOR CONSTRUCTIONS, ASSUMES NO RESPONSIBILITY FOR THE ADEQUACY OR ACCURACY OF DESIGN.

LEGEND

- INSTALL SILT FENCE
- INSTALL ROCK CHECK DAM
- INSTALL CURB INLET PROTECTION
- INSTALL AREA DRAIN INLET PROTECTION
- INSTALL SEDIMENT POND AT CURB INLET OR AREA DRAIN

RECORD DRAWING

This is to certify that changes and corrections have been made to conform to the contractor's record of this project.

Signed *Mike Glenn* Date 12-03-2015
Glenn Engineering Corporation

GLENN ENGINEERING
TEXAS REGISTRATION NUMBER: F-303
PHONE 972/717-5151 FAX 972/717-2076
705 DESIGN COURT, SUITE 910 ROCKWALL, TEXAS 75087

SUBMISSION OF BID WILL BE CONSIDERED ACKNOWLEDGMENT THAT THE CONTRACTOR HAS VISITED THE SITE AND HAS VERIFIED ALL EXISTING JOB CONDITIONS AND INCLUDED ANY NECESSARY MODIFICATION TO EXISTING AND NEW WORK REQUIRED FOR INSTALLATION OF A COMPLETE AND WORKING SYSTEM.


NOTE:
SEE SEDIMENT CONTROL DETAIL SHEET

ALL CONSTRUCTION SHALL BE PER CITY OF ROCKWALL STANDARDS AND N.C.T.C.O.G. 3RD EDITION.

CONTRACTOR SHALL VERIFY ALL EXISTING INVERTS AND ELEVATIONS PRIOR TO CONSTRUCTION.


LEGEND

- INSTALL SILT FENCE
- INSTALL ROCK CHECK DAM
- INSTALL CURB INLET PROTECTION
- INSTALL AREA DRAIN INLET PROTECTION
- INSTALL SEDIMENT POND AT CURB INLET OR AREA DRAIN

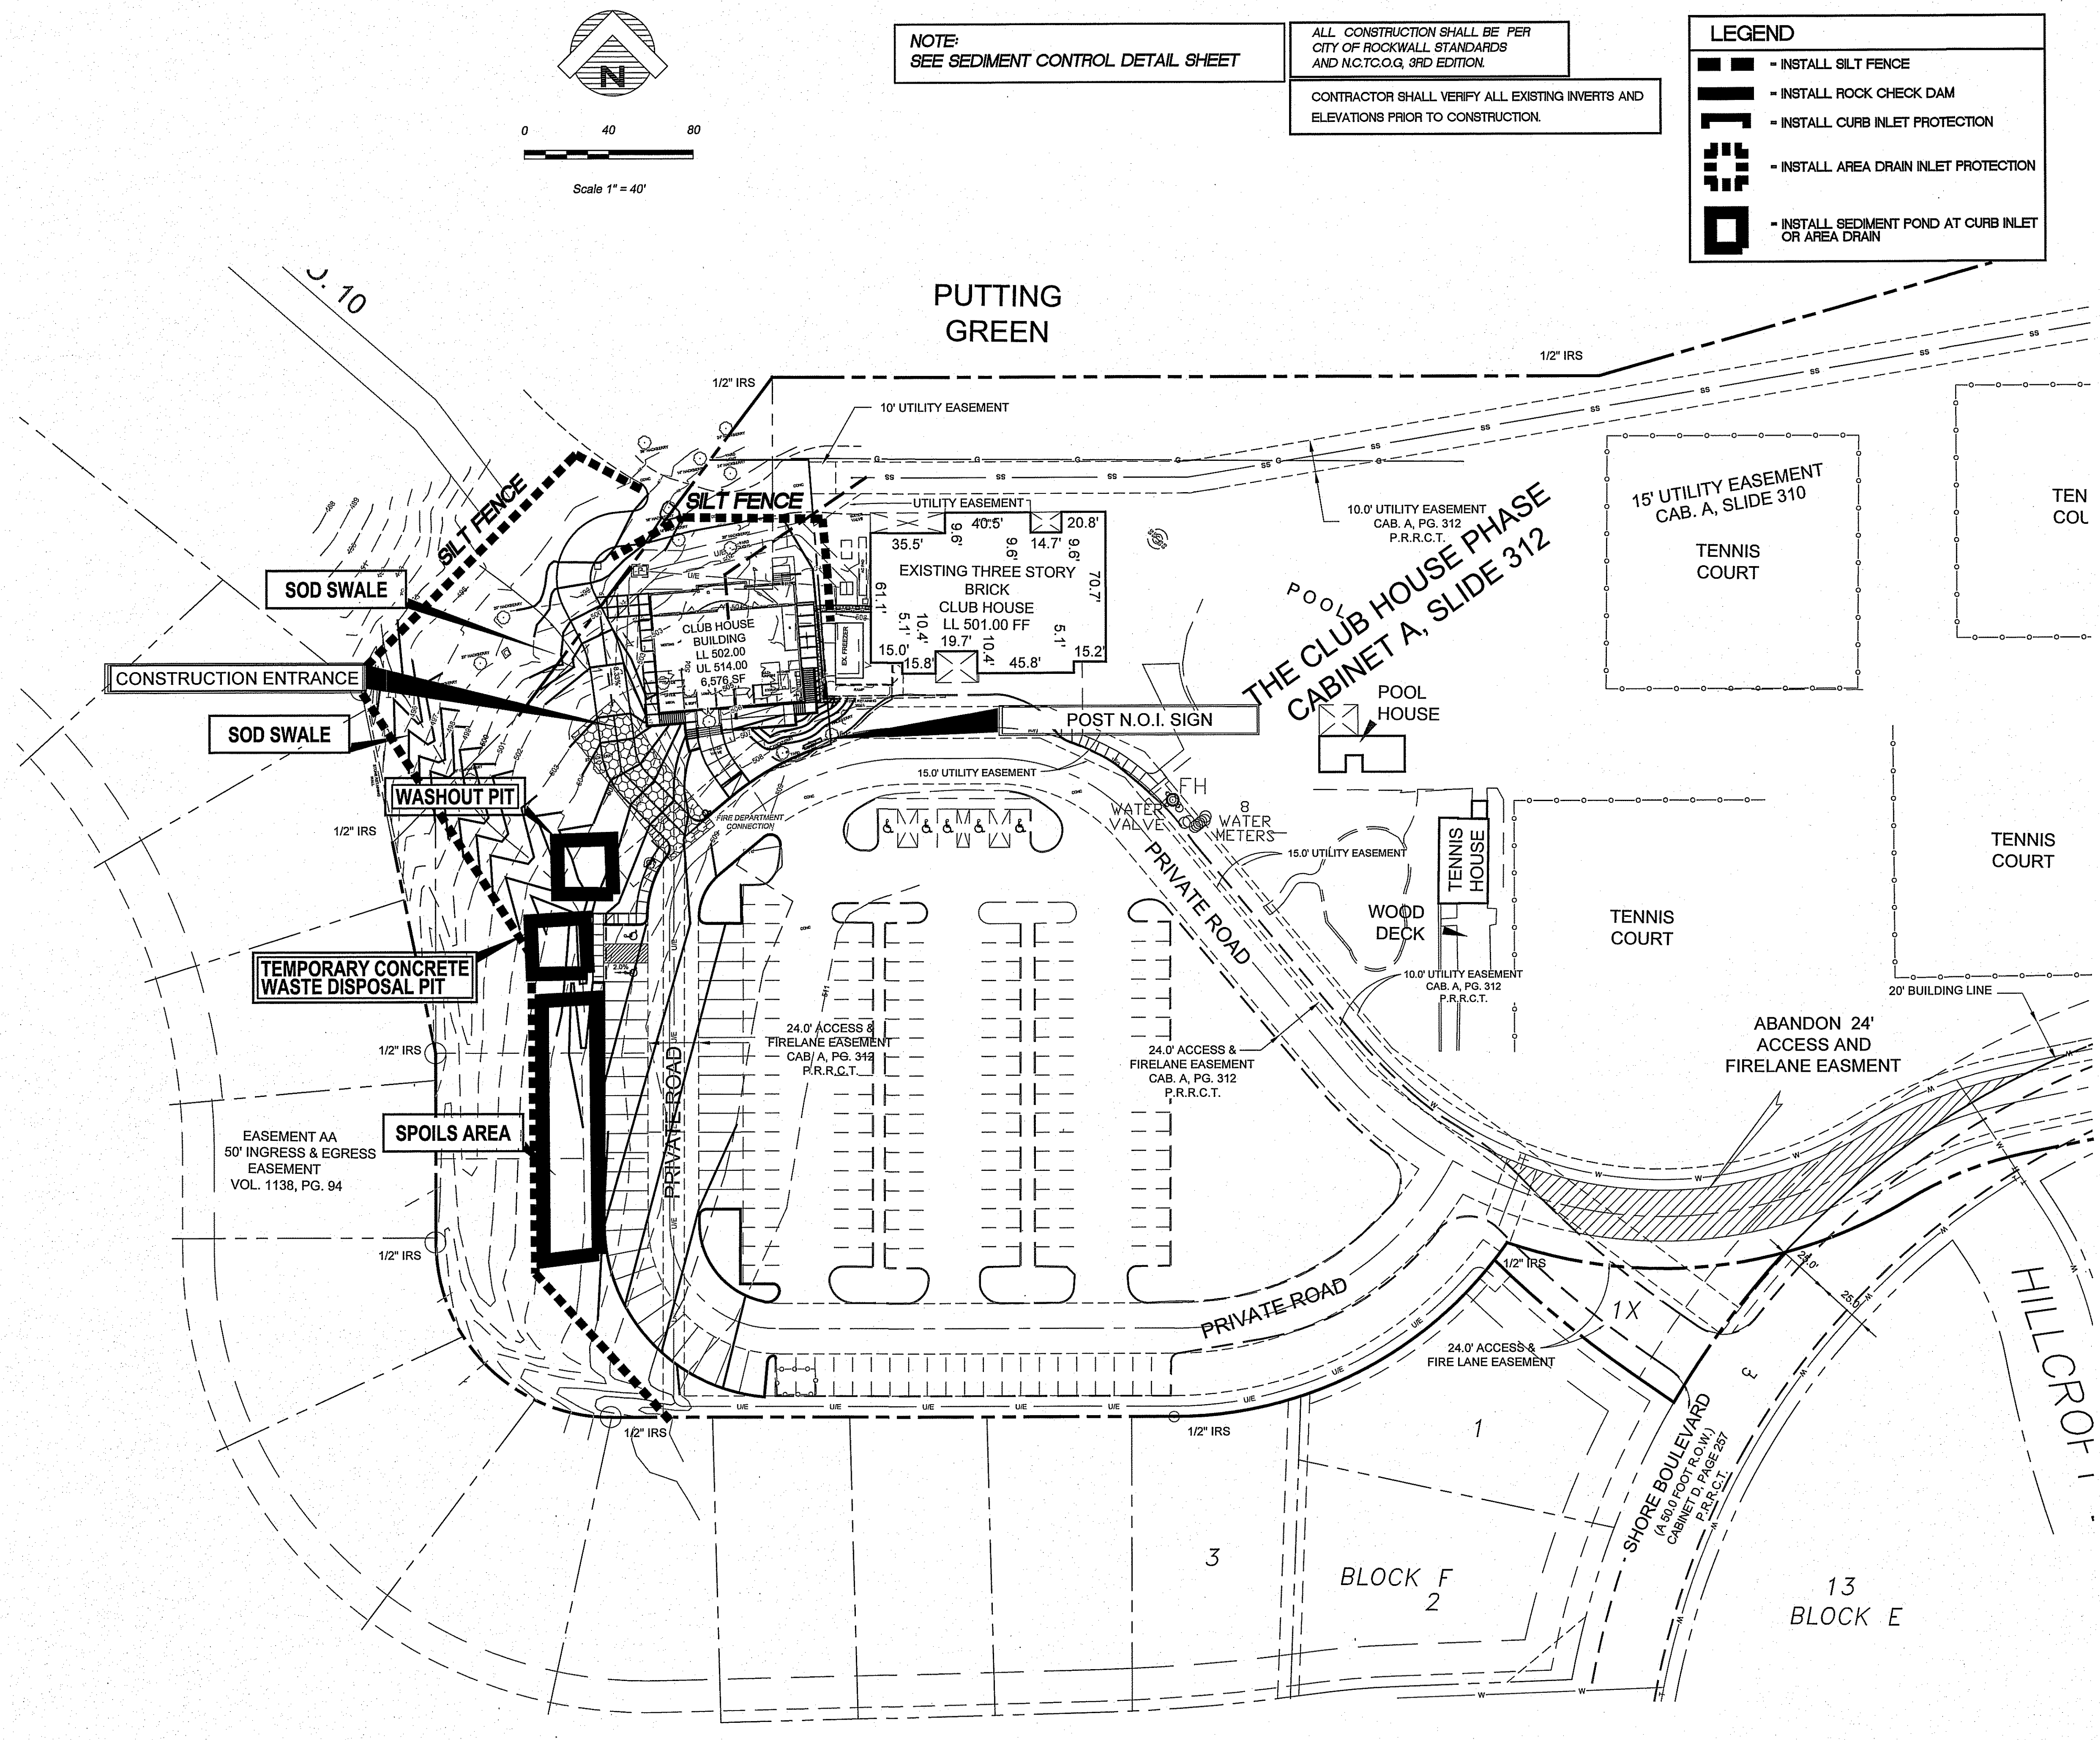


NOTE: THE CITY OF ROCKWALL CONSTRUCTION STANDARDS APPLY, WHETHER INDICATED ON THESE PLANS OR NOT.

Apr 24, 2014 - 5:21pm User: Robert
C:\Users\Public\Bob's Projects\JIMMY STROHMEYER\SHORES\BIDSET\SHORES ENG 17.dwg

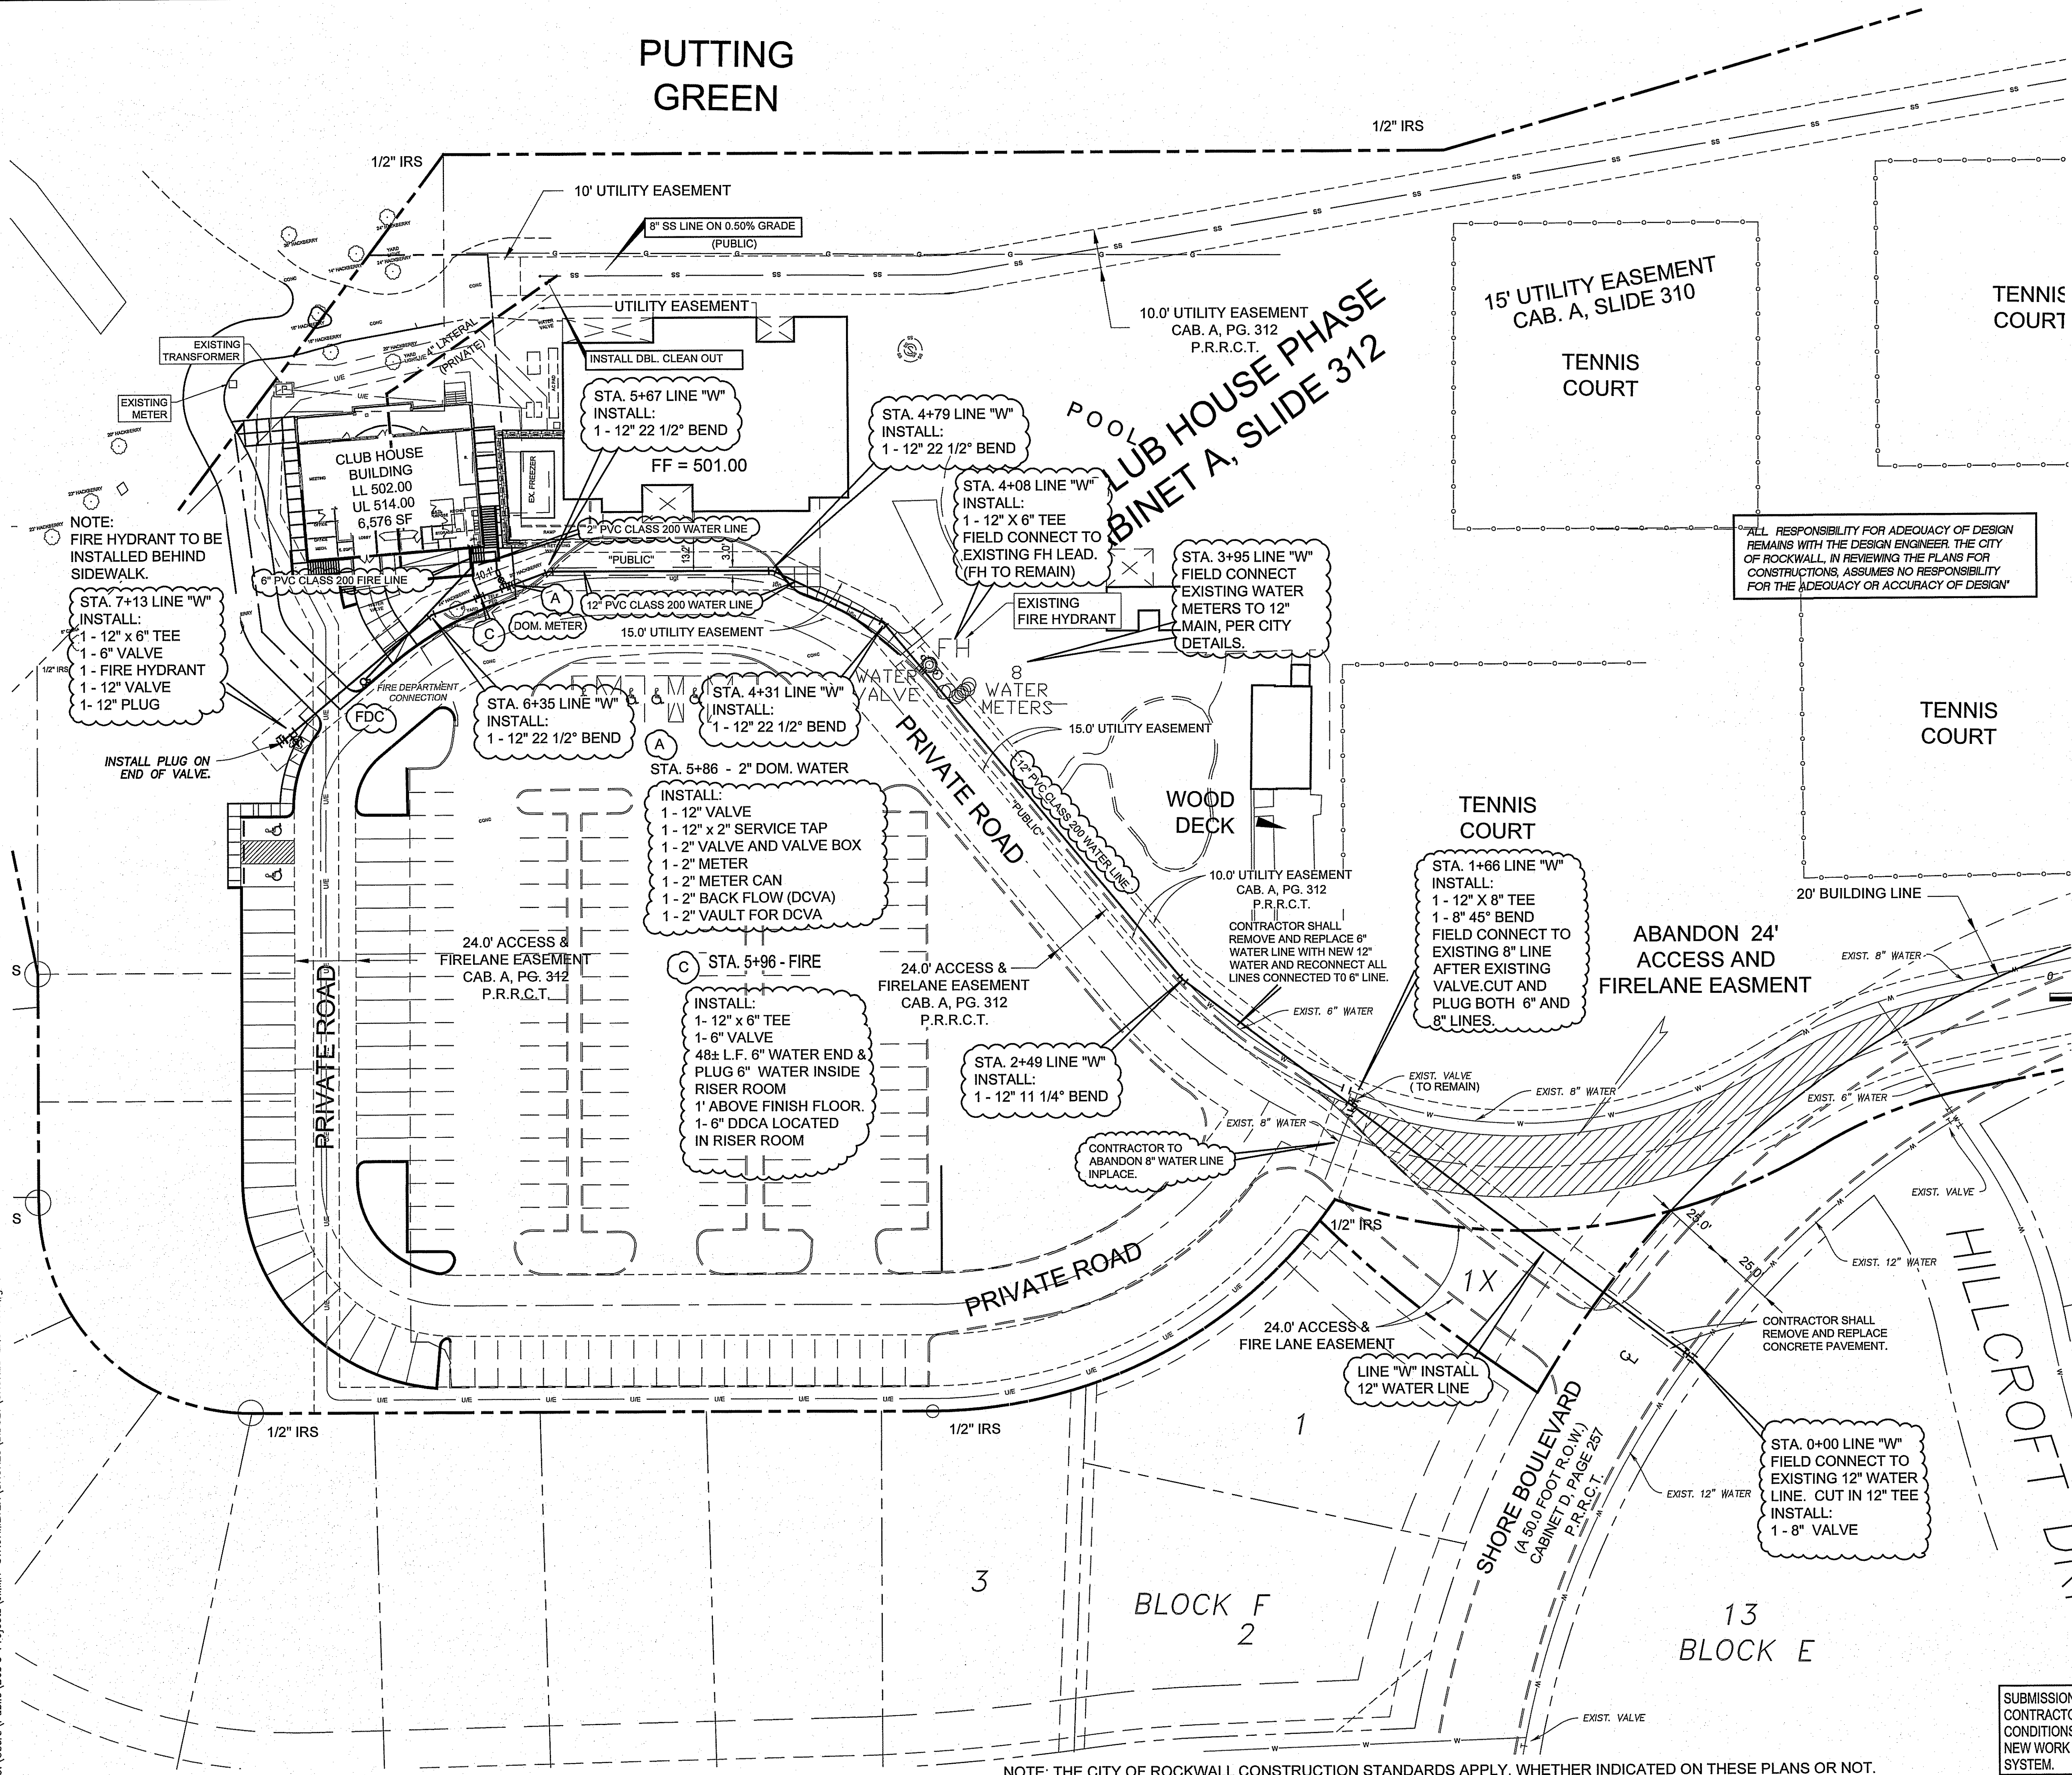

- GENERAL WATER NOTES**
1. WATER DISTRIBUTION SYSTEM MATERIAL AND CONSTRUCTION SHALL COMPLY WITH THE CITY OF ROCKWALL CONSTRUCTION STANDARDS, WHETHER INDICATED ON THESE PLANS OR NOT.
 2. CONCRETE BLOCKING SHALL BE INSTALLED AT ALL BENDS, VALVES AND FIRE HYDRANTS.
 3. ALL MAINS SHALL BE BURIED A MINIMUM DEPTH OF 42" BELOW TOP OF ADJACENT CURB OR AS DIRECTED BY THE ENGINEER.
 4. WATER PIPE SHALL BE PVC CLASS 200.
 5. CONTRACTOR SHALL NOTIFY ALL UTILITY COMPANIES PRIOR TO COMMENCING CONSTRUCTION. DAMAGE TO EXISTING UTILITIES SHALL BE REPAIRED AT CONTRACTOR'S EXPENSE.
 6. ALL FIRE HYDRANTS SHALL CONFORM TO THE REQUIREMENTS OF THE CITY OF ROCKWALL. CONTRACTOR SHALL NOTIFY ROCKWALL FIRE DEPARTMENT PRIOR TO PLACING OF PIPE TO ARRANGE FOR REQUIRED INSPECTIONS.
 7. CONTRACTOR TO VERIFY LOCATION OF ALL EXISTING WATER VALVES PRIOR CONNECTION TO EXISTING WATER SYSTEM.
 8. CONTRACTOR TO INSTALL "KNOX" PADLOCKS ON ALL GATES ACROSS FIRE LANE.
 9. CONTRACTOR TO REMOVE ALL INACTIVE UTILITY LINES INCLUDING WATER, SANITARY, STORM AND ROAD DRAIN LINES FROM UNDER NEW BUILDINGS. REMOVE AND RECOMPACT SUBGRADE TO 95% STANDARD PROCTOR PER CITY OF ROCKWALL STANDARDS.
- GENERAL SANITARY SEWER NOTES**
1. CONTRACTOR SHALL NOTIFY ALL UTILITY COMPANIES AND OTHERS WHO MAY HAVE BURIED EQUIPMENT OR PIPELINES IN THE VICINITY OF CONSTRUCTION PRIOR TO COMMENCING CONSTRUCTION. DAMAGE TO EXISTING UTILITIES SHALL BE REPAIRED AT THE CONTRACTOR'S EXPENSE.
 2. CONTRACTOR SHALL VERIFY THE LOCATION AND DEPTH OF TIE-IN TO EXISTING SEWER SYSTEM. IF GRADES NEED ADJUSTMENT DUE TO UNFORESEEN CONFLICTS, CONTRACTOR SHALL NOTIFY THE ENGINEER PRIOR TO LAYING PIPE.
 3. ALL SANITARY SEWER PIPE, MANHOLES, AND RELATED APPURTENANCES SHALL CONFORM TO THE MATERIAL AND CONSTRUCTION SPECIFICATIONS SHALL COMPLY WITH THE CITY OF ROCKWALL CONSTRUCTION STANDARDS, WHETHER INDICATED ON THESE PLANS OR NOT.
 4. PARTICULAR ATTENTION SHALL BE PAID TO THE INSTALLATION, EMBEDMENT AND BACKFILL OF SEWER PIPE. ALL EMBEDMENT SHALL CONFORM TO THE CITY OF ROCKWALL STANDARDS.
 5. SPECIAL CARE SHALL BE TAKEN IN ADHERING TO THOSE SPECIFICATIONS REGARDING PIPE JOINTS, PIPE EMBEDMENT AND TESTING OF INSTALLED WATER AND SANITARY SEWER PIPES.
 6. SEWER PIPE SHALL BE PVC SDR 35.
 7. SERVICES SHALL BE 4" PVC, SDR 35 AND SHALL BE INSTALLED AS SHOWN.
 8. CONTRACTOR SHALL MEET ALL O.S.H.A. REQUIREMENTS REGARDING TRENCH SAFETY IN THE CONSTRUCTION OF THIS SEWER SERVICE.
 9. ALL SANITARY SEWER WORK DESIGNATED AS "PRIVATE" IN THIS SET OF PLANS SHALL BE INSTALLED IN ACCORDANCE WITH THE INTERNATIONAL PLUMBING CODE, PERMITTED AND INSPECTED BY THE CITY BUILDING INSPECTION DEPARTMENT AND INSTALLED BY A LICENSED PLUMBER.
- ALL CONSTRUCTION SHALL BE PER CITY OF ROCKWALL STANDARDS AND N.C.T.C.O.G. 3RD EDITION.
- CONTRACTOR SHALL VERIFY ALL EXISTING INVERTS AND ELEVATIONS PRIOR TO CONSTRUCTION.

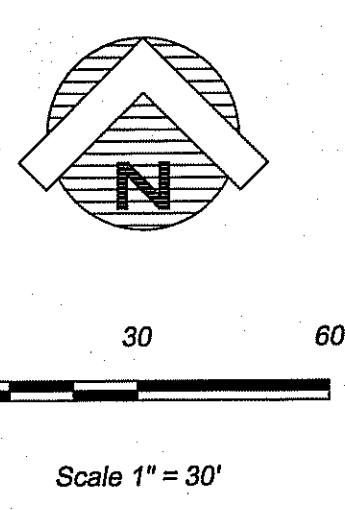

RECORD DRAWING

This is to certify that changes and corrections have been made to conform to the contractor's record of this project.


Glenn Signed _____ Date 12-03-2015

Glenn Engineering Corporation

GLENN ENGINEERING

TEXAS REGISTRATION NUMBER: F-303
PHONE 972.717.5151 FAX 972.717.2176
105 DECKER COURT, SUITE 910 IRVING, TEXAS 75062


SUBMISSION OF BID WILL BE CONSIDERED ACKNOWLEDGMENT THAT THE CONTRACTOR HAS VISITED THE SITE AND HAS VERIFIED ALL EXISTING JOB CONDITIONS AND INCLUDED ANY NECESSARY MODIFICATION TO EXISTING AND NEW WORK REQUIRED FOR INSTALLATION OF A COMPLETE AND WORKING SYSTEM.

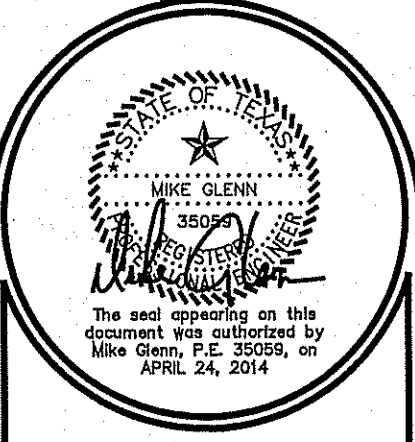

JOHNSTON-RAMSAY

ARCHITECTURE - MANAGEMENT

2235 RIDGE RD. STE. 200 ROCKWALL, TEXAS 75087

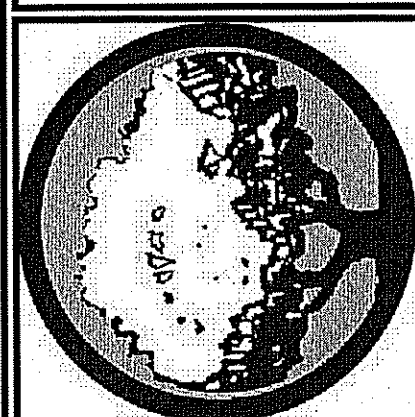


The Shores HOA Clubhouse
2601 Champions Dr. ROCKWALL, TEXAS 75087

©COPYRIGHT 2011. ALL RIGHTS RESERVED
*ALL ELEMENTS OF THIS DRAWING ARE THE INTELLECTUAL PROPERTY OF JOHNSTON-RAMSAY

DATE 04/24/14
PROJECT 011112
CU 1.01
UTILITY PLAN

CASE # SP 2013-018 LOT 2 - BLOCK H - THE SHORES CLUB HOUSE, PHASE 2

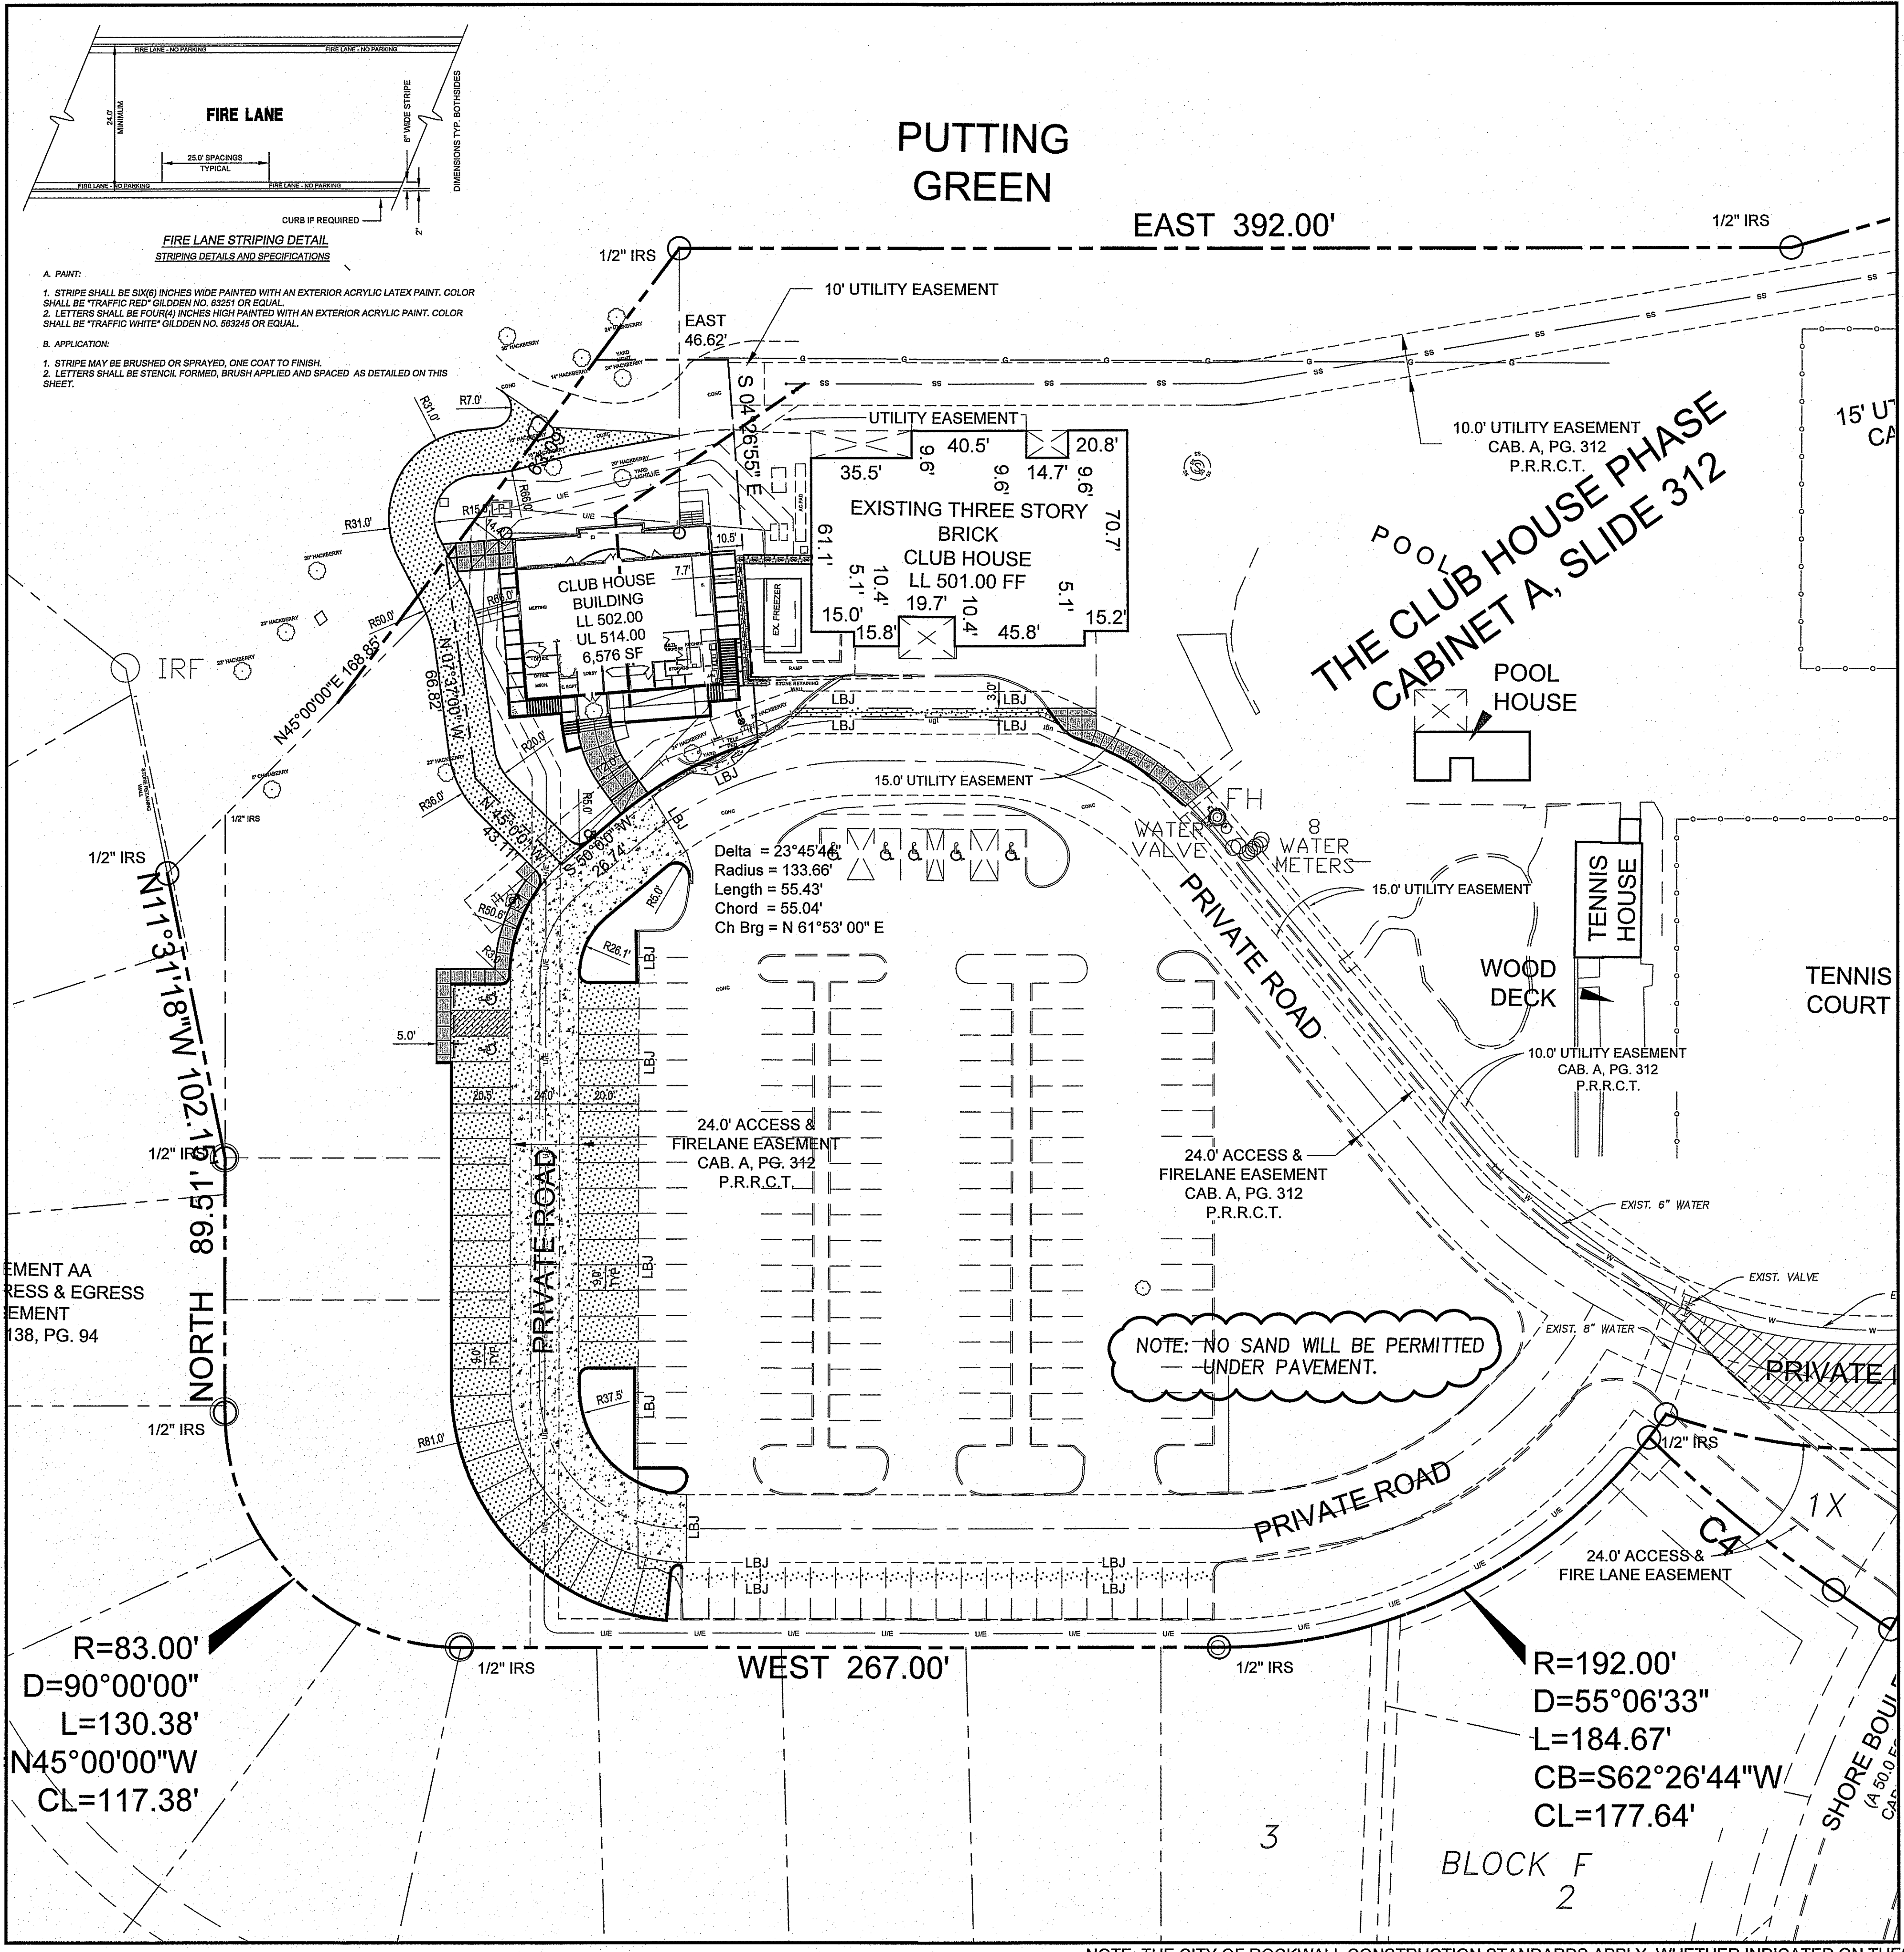

PAVING NOTES:

THE INITIAL SOIL TEST AND REPORT BY TERRACON CONSULTANTS, INC. PROJECT NO. 94105209 & ANY AND ALL SUBSEQUENT REPORTS PREPARED FOR THIS PROJECT BY TERRACON OR BY OTHER FIRM, AGENCY OR ENTITY, EVEN THOUGH CONTAINED IN THE PLANS AND/OR SPECIFICATIONS FOR THIS PROJECT, ARE MADE A PART OF THIS PLAN. A COPY CAN BE OBTAINED THROUGH THE ARCHITECT OR ENGINEER.

I. PAVEMENT SUB GRADE FOR A & B, BELOW:

SINCE THE NEW ADDITIONS WILL BE SUPPORTED ABOVE GRADE, SITE PREPARATION FOR THE NEW ADDITIONS IS EXPECTED TO BE LIMITED. HOWEVER, THE EXISTING SUBGRADE SHOULD BE PROPERLY PREPARED IN AREAS TO RECEIVE NEW FILL.

AFTER COMPLETION OF NECESSARY STRIPPING, CLEARING, AND EXCAVATING AND PRIOR TO PLACING ANY REQUIRED FILL, THE EXPOSED SUBGRADE SHOULD BE CAREFULLY EVALUATED BY PROBING AND TESTING. ANY UNDESIRABLE MATERIAL (ORGANIC MATERIAL, WET, SOFT, OR LOOSE SOIL) STILL IN PLACE SHOULD BE REMOVED.

THE EXPOSED SOIL SUBGRADE SHOULD BE FURTHER EVALUATED BY PROOF-ROLLING WITH A HEAVY PNEUMATIC TIRE ROLLER, LOADED DUMP TRUCK OR SIMILAR EQUIPMENT WEIGHING APPROXIMATELY 20 TONS TO CHECK FOR POCKETS OF SOFT OR LOOSE MATERIAL HIDDEN BENEATH A THIN CRUST OF POSSIBLY BETTER SOIL.

PROOF-ROLLING PROCEDURES SHOULD BE OBSERVED ROUTINELY BY A PROFESSIONAL ENGINEER OR HIS DESIGNATED REPRESENTATIVE.

ANY UNDESIRABLE MATERIAL (ORGANIC MATERIAL, WET, SOFT, OR LOOSE SOIL) EXPOSED SHOULD BE REMOVED AND REPLACED WITH WELL-COMPACTED MATERIAL.

PRIOR TO PLACEMENT OF ANY FILL, THE EXPOSED SOIL SUBGRADE SHOULD THEN BE SCARIFIED TO A MINIMUM DEPTH OF 6 INCHES AND RECOMPACTED.

DUE TO THE NATURE OF THE CLAYEY SOILS FOUND NEAR THE SURFACE AT THE BORINGS, TRAFFIC OF HEAVY EQUIPMENT (INCLUDING HEAVY COMPACTION EQUIPMENT) MAY CREATE PUMPING AND GENERAL DETERIORATION OF SHALLOW SOILS. THEREFORE, SOME CONSTRUCTION DIFFICULTIES SHOULD BE ANTICIPATED DURING PERIODS WHEN THESE SOILS ARE SATURATED.

SANDY/SILT CLAY MATERIALS WITH A PLASTICITY INDEX BELOW 25 SHOULD BE COMPACTED TO A DRY DENSITY OF AT LEAST 95 PERCENT OF STANDARD PROCTOR MAXIMUM DRY DENSITY (ASTM D 698) AND WITHIN THE RANGE OF 1 PERCENTAGE POINT BELOW TO 3 PERCENTAGE POINTS ABOVE THE MATERIAL'S OPTIMUM MOISTURE CONTENT.

CLAY, SANDY CLAY, AND SHALY CLAY SOILS WITH A PLASTICITY INDEX EQUAL TO OR GREATER THAN 25 SHOULD BE COMPACTED TO A DRY DENSITY BETWEEN 93 AND 98 PERCENT OF STANDARD PROCTOR MAXIMUM DRY DENSITY (ASTM D 698). THE COMPACTED MOISTURE CONTENT OF THE CLAYS DURING PLACEMENT SHOULD BE WITHIN THE RANGE OF 2 TO 6 PERCENTAGE POINTS ABOVE OPTIMUM.

CLAYEY MATERIALS USED AS FILL SHOULD BE PROCESSED AND THE LARGEST PARTICLE OF CLOD SHOULD BE LESS THAN 6 INCHES PRIOR TO COMPACTION.

COMPACTION SHOULD BE ACCOMPLISHED BY PLACING FILL IN ABOUT 8-INCH THICK LOOSE LIFTS AND COMPACTING EACH LIFT TO A LEAST THE SPECIFIED MINIMUM DRY DENSITY. FIELD DENSITY AND MOISTURE CONTENT TESTS SHOULD BE PERFORMED ON EACH LIFT. AS A GUIDE, ONE TEST PER 2,500 SQ. FT. PER LIFT IS RECOMMENDED IN BUILDING AREA. UTILITY TRENCH BACKFILL SHOULD BE TESTED AT A RATE OF ONE TEST PER 300 LINEAL FEET OF TRENCH LIFT PER EACH.

B. ON-SITE SIDEWALKS

CONCRETE SIDEWALKS SHALL BE A WIDTH AS DESIGNATED ON SITE PLAN AND A MINIMUM OF 4 INCHES THICK, CONSTRUCTED OF 3,600 P.S.I. IN 28 DAYS CONCRETE WITH 4-#4 ENGRAINED IRON AND REINFORCED WITH #4 BARS AT 18" O.C.E.W. SUPPORTED WITH PROPER SUPPORT CHAIRS. EXPANSION JOINTS SHALL BE AT 60' MAXIMUM O.C. AND SAWCUT CONTRACTION JOINTS AT MAXIMUM 15' O.C. ALL JOINTS TO BE CLEANED AND FILLED WITH HOT FLOURED RUBBER (GRAY) WITH #3 BARS AT 18" O.C.E.W. TOOLED CONSTRUCTION JOINTS SHALL BE 5'-0" O.C. ONE-HALF INCH EXPANSION JOINT SHALL BE PLACED EVERY 60 FEET AND WHERE NEW WORK IS CONSTRUCTED ADJACENT TO OTHER CONCRETE WORK (WALLS, FOUNDATION, CURB, ETC.), THE JOINTS SHALL BE FILLED WITH 1/2-INCH PRE-MOLDED GRAY BITUMINOUS EXPANSION JOINT FILLER AND SHALL EXTEND THE ENTIRE DEPTH AND WIDTH OF THE CONCRETE SECTION.

FINISH OF SIDEWALKS SHALL BE WITH A BROOM FINISH PER ENGINEER. WALKS SHALL HAVE TOOLED CURB EDGES & TOOLED JOINTS. (SAW CUTTING WILL BE PERMITTED.)

WALKS SHALL HAVE TOOLED CURB EDGES & TOOLED JOINTS.

III. FINISHING FOR CONCRETE DRIVEWAY, PARKING LOT AND STREET CURBS

THE EXPOSED SURFACES OF DRIVEWAYS AND PARKING LOT SHALL HAVE A MONOLITHIC FINISH BY FLOATING WITH A WOODEN FLAT UNTIL A SLIGHT EXCESS OF SAND APPEARS ON THE SURFACES. IN NO CASE SHALL THE SURFACE BE LEFT THICK OR WITH A CLOUSY FINISH. EXPOSED SURFACES OF SIDEWALKS SHALL HAVE A MONOLITHIC FINISH BY TROWLING WITH A STEEL TROWEL AND BRUSHED LIGHTLY WITH AN APPROVED BROOM. THE EDGE OF ALL CONCRETE SHALL BE NEATLY ROUNDED TO THE REQUIRED RADI WITH AN EDGING TOOL.

THE EXPOSED SURFACE OF CURBS AND CURBS WITH GUTTER SHALL BE SHAPED WITH A "MULE" AND BRUSHED WITH A WET BRUSH AT RIGHT ANGLE TO THE LINE OF THE CURB TO PRODUCE A UNIFORM TEXTURED SURFACE. THE EDGES SHALL BE NEATLY ROUNDED OFF TO THE REQUIRED RADI. USE OF GROUT OVER A ROUGH FINISHED TEXTURE WILL NOT BE ALLOWED.

GENERAL PAVING NOTES

- REMOVE AND STORE BRICK PAVERS. BRICK PAVERS TO BE RE-SET BACK TO THEIR ORIGINAL LOCATIONS AFTER REPAIR OF THE ROOF DRAIN LINES AND REGRADING OF THE COURTYARDS. ALTERNATE TO REPLACE BRICK PAVERS WITH SAME SIZE 4" CONCRETE PADS.
- ALL EXISTING PAVEMENT CAULK SHALL BE REMOVED. JOINTS SHALL BE CLEANED AND FREE OF DEBRIS. ALL JOINTS THEN SHALL BE RECAULKED PER SPECIFICATIONS. (BOTH PAVEMENT AND SIDEWALKS / ALL JOINTS)
- ALL CONSTRUCTION SHALL BE PERFORMED IN ACCORDANCE WITH THE CITY OF ROCKWALL STANDARD DETAILS AND SPECIFICATIONS AND N.C.T.C.O.G., 3RD EDITION.
- CONTRACTOR TO VERIFY EXISTING PAVEMENT ELEVATIONS PRIOR TO CONSTRUCTION.
- NEW PAVING INSTALLED SHALL "FLUSH-OUT" AT ANY JUNCTURE WITH EXISTING PAVING.
- BARRIER FREE RAMPS SHALL COMPLY WITH CITY'S STANDARD DETAILS. (TRUNCATED DOME PLATES)
- ALL SUBGRADE UNDER PAVEMENT SHALL BE COMPACTED TO 95% OF ASTM D-698 AND MOISTURE CONDITIONED.
- ALL FIRE LANES SHALL PER STRIPED OR RESTRIPTED IN ACCORDANCE WITH CITY STANDARDS.

PAVING LEGEND

LBJ = LONGITUDINAL BUTT JOINT PER CITY STANDARD DETAIL

PROPOSED 7" 3,600 P.S.I. - MIN. 6.5 SACK REINFORCED CONCRETE PAVEMENT OVER 6" OF LIME OR CEMENT STABILIZED SUBGRADE WITH #4 REBARS ON 18" CENTERS EACH WAY.

PROPOSED 6" 3,600 P.S.I. - MIN. 6.5 SACK REINFORCED CONCRETE PAVEMENT OVER UNTREATED SUBGRADE STABILIZATION COMPACTED TO 95% DENSITY WITH #4 REBARS ON 18" CENTERS EACH WAY.

PROPOSED 4" 3,600 P.S.I. - MIN. 6.5 SACK REINFORCED CONCRETE SIDEWALK PAVEMENT OVER UNTREATED SUBGRADE STABILIZATION COMPACTED TO 95% DENSITY WITH #3 REBARS ON 18" CENTERS EACH WAY.

NOTE: SOIL STABILIZATION MAY VARY BASED ON LOCATION OF PAVEMENT. REFERENCE GEOTECHNICAL REPORT FOR RECOMMENDATIONS.

RECORD DRAWING

This is to certify that changes and corrections have been made to conform to the contractor's record of this project.

Signed: *[Signature]* Date: 12-03-2015

Glenn Engineering Corporation

Glenn Engineering Corporation
TEXAS REGISTRATION NUMBER: F-303
PHONE 972.775.5151 FAX 972.775.5152
105 DUCKER COURT, SUITE 910 IRVING, TEXAS 75062

SUBMISSION OF BID WILL BE CONSIDERED ACKNOWLEDGMENT THAT THE CONTRACTOR HAS VISITED THE SITE AND HAS VERIFIED ALL EXISTING JOB CONDITIONS AND INCLUDED ANY NECESSARY MODIFICATION TO EXISTING AND NEW WORK REQUIRED FOR INSTALLATION OF A COMPLETE AND WORKING SYSTEM.

JOHNSTON-RAMSAY

ARCHITECTURE - MANAGEMENT

2235 RIDGE RD. STE. 200 ROCKWALL, TEXAS 75087

The Shores HOA Clubhouse
2601 Champions Dr. ROCKWALL, TEXAS 75087

©COPYRIGHT 2011. ALL RIGHTS RESERVED
*ALL ELEMENTS OF THIS DRAWING ARE THE INTELLECTUAL PROPERTY OF JOHNSTON-RAMSAY

DATE
04/24/14


PROJECT
011112

CP 101
PAVING
PLAN

CASE # SP 2013-018

LOT 2 - BLOCK H - THE SHORES CLUB HOUSE, PHASE 2

Apr 24, 2014 - 5:21 pm User: Robert
C:\Users\Public\Bob's Projects\JIMMY STROHMAYER\SHORES\BIDSET\SHORES ENG 17.dwg

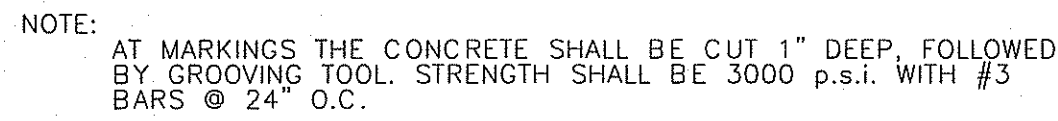

6'

TOOL RADIUS
ALL EDGES

TOP PVMT.

SLOPE 1/4" PER FT. TO STREET


#3 BARS AT 24"

SUBBASE

#3 BARS @ 24" EACH WAY
"KYLE DRIVE" - #4 BARS @ 24" EACH WAY

**SIDEWALK
TYPICAL SECTION**

NOT TO SCALE

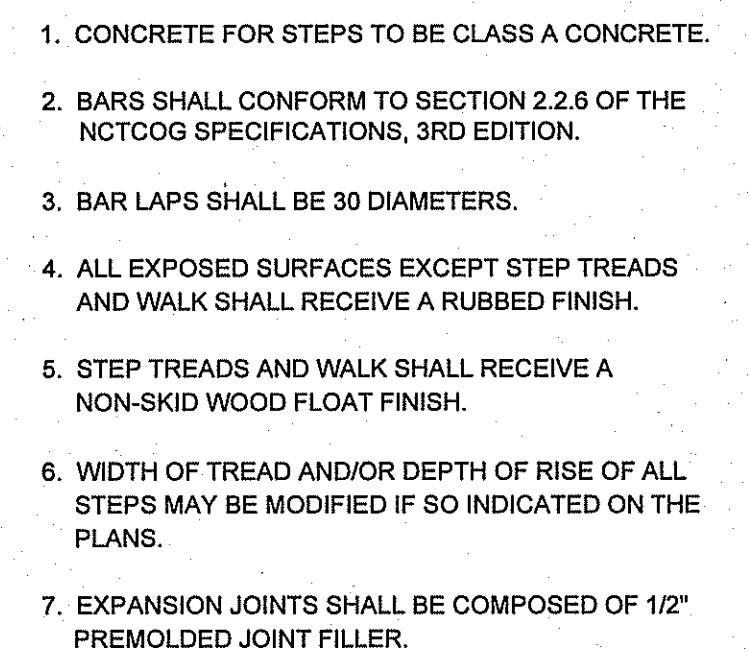


TO BE USED WHERE PROPOSED CONCRETE PAVEMENT
MEETS EXISTING CONCRETE PAVEMENT

NOTES:

1. NO. 5 SMOOTH DOWEL BAR MAY BE USED IN 5", 6" AND 7" PAVEMENT THICKNESS.
 2. LONGITUDINAL BUTT CONSTRUCTION MAY BE UTILIZED IN PLACE OF LONGITUDINAL HINGED (KEYWAY) JOINT AT CONTRACTOR'S OPTION.
 3. DOWEL BARS SHALL BE DRILLED INTO PAVEMENT HORIZONTALLY BY USE OF A MECHANICAL RIG.
- DRILLING BY HAND IS NOT APPLICABLE,
PUSHING DOWEL BARS INTO GREEN CONCRETE IS NOT ACCEPTABLE.



1. INSTALL TRUNCATED DOME PLATES, PER MANUFACTURE DETAILS AND SPECIFICATIONS. SIDEWALK PAVING STRENGTH SHALL BE 3600 p.s.i. WITH #3 BARS @ 18" O.C.
2. SEE HANDICAP DETAIL ABOVE.

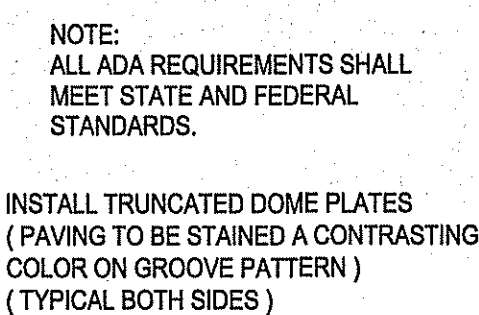

This is to certify that changes and corrections have been made to conform to the contractor's record of this project.

Signed _____

Glenn Engineering Corporation

ALL RESPONSIBILITY FOR ADEQUACY OF DESIGN REMAINS WITH THE DESIGN ENGINEER. THE CITY OF ROCKWALL, IN REVIEWING THE PLANS FOR CONSTRUCTIONS, ASSUMES NO RESPONSIBILITY FOR THE ADEQUACY OR ACCURACY OF DESIGN*

**GLENN
ENGINEERING**

TEXAS REGISTRATION NUMBER: F-303
PHONE 972-717-5151 FAX 972-717-2176
105 DECKER COURT, SUITE 910 IRVING, TEXAS 75062

SUBMISSION OF BID WILL BE CONSIDERED ACKNOWLEDGMENT THAT THE CONTRACTOR HAS VISITED THE SITE AND HAS VERIFIED ALL EXISTING JOB CONDITIONS AND INCLUDED ANY NECESSARY MODIFICATION TO EXISTING AND NEW WORK REQUIRED FOR INSTALLATION OF A COMPLETE AND WORKING SYSTEM.



ARCHITECTURE - MANAGEMENT

2235 RIDGE RD. STE. 200 ROCKWALL, TEXAS 75087



©COPYRIGHT 2011. ALL RIGHTS RESERVED
*ALL ELEMENTS OF THIS DRAWING ARE THE INTELLECTUAL
PROPERTY OF JOHNSTON-RAMSAY

CASE # SP 2013-018 LOT 2 - BLOCK H - THE SHORES CLUB HOUSE, PHASE 2

DATE
4/24/14

PROJECT
011112


CP 1.02
PAVING
DETAILS

GENERAL GRADING AND DRAINAGE NOTES


1. ALL CONSTRUCTION TO BE IN ACCORDANCE WITH THESE PLANS AND LOCAL GOVERNING AUTHORITIES STANDARDS AND SPECIFICATIONS. —

NOTE: THE CITY OF ROCKWALL CONSTRUCTION STANDARDS APPLY, WHETHER INDICATED ON THESE PLANS OR NOT.

Typical 6" Curb

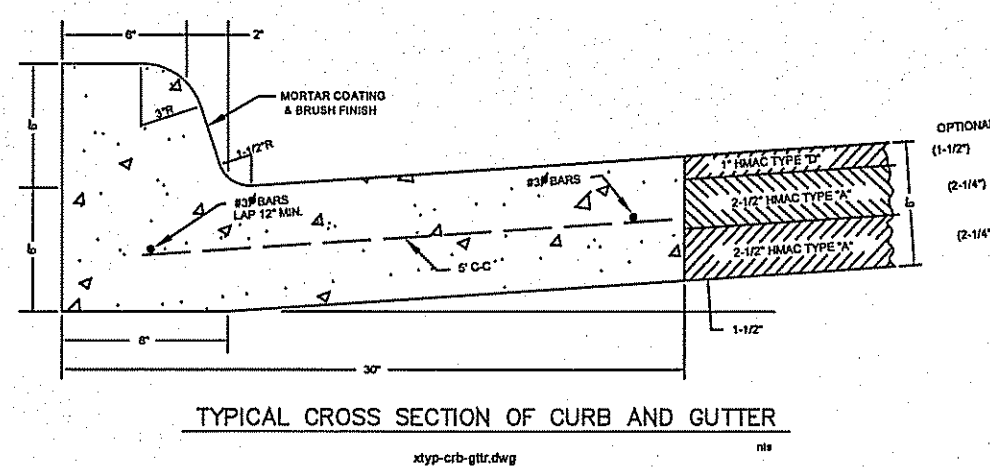

Anchor Joint Exhibit

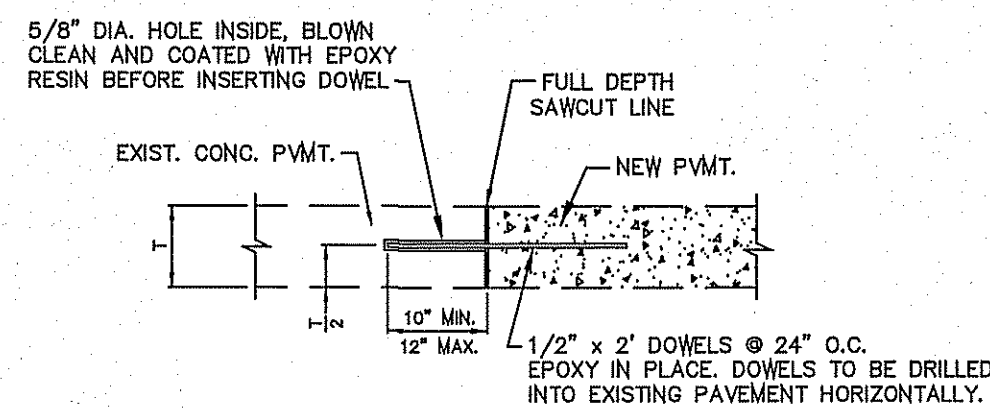

"ANCHOR JOINT"
DOWEL-ON DETAIL

N.T.S

STANDARD METHOD FOR JOINING NEW REINFORCED CONCRETE PAVEMENT TO EXISTING CONCRETE PAVEMENT

Apr 24, 2014 - 5:21pm User: Robert
C:\Users\Public\Bob's Projects\JIMMY STROHMMEYER\SHORES\BIDSET\SHORES ENG 17.dwg