


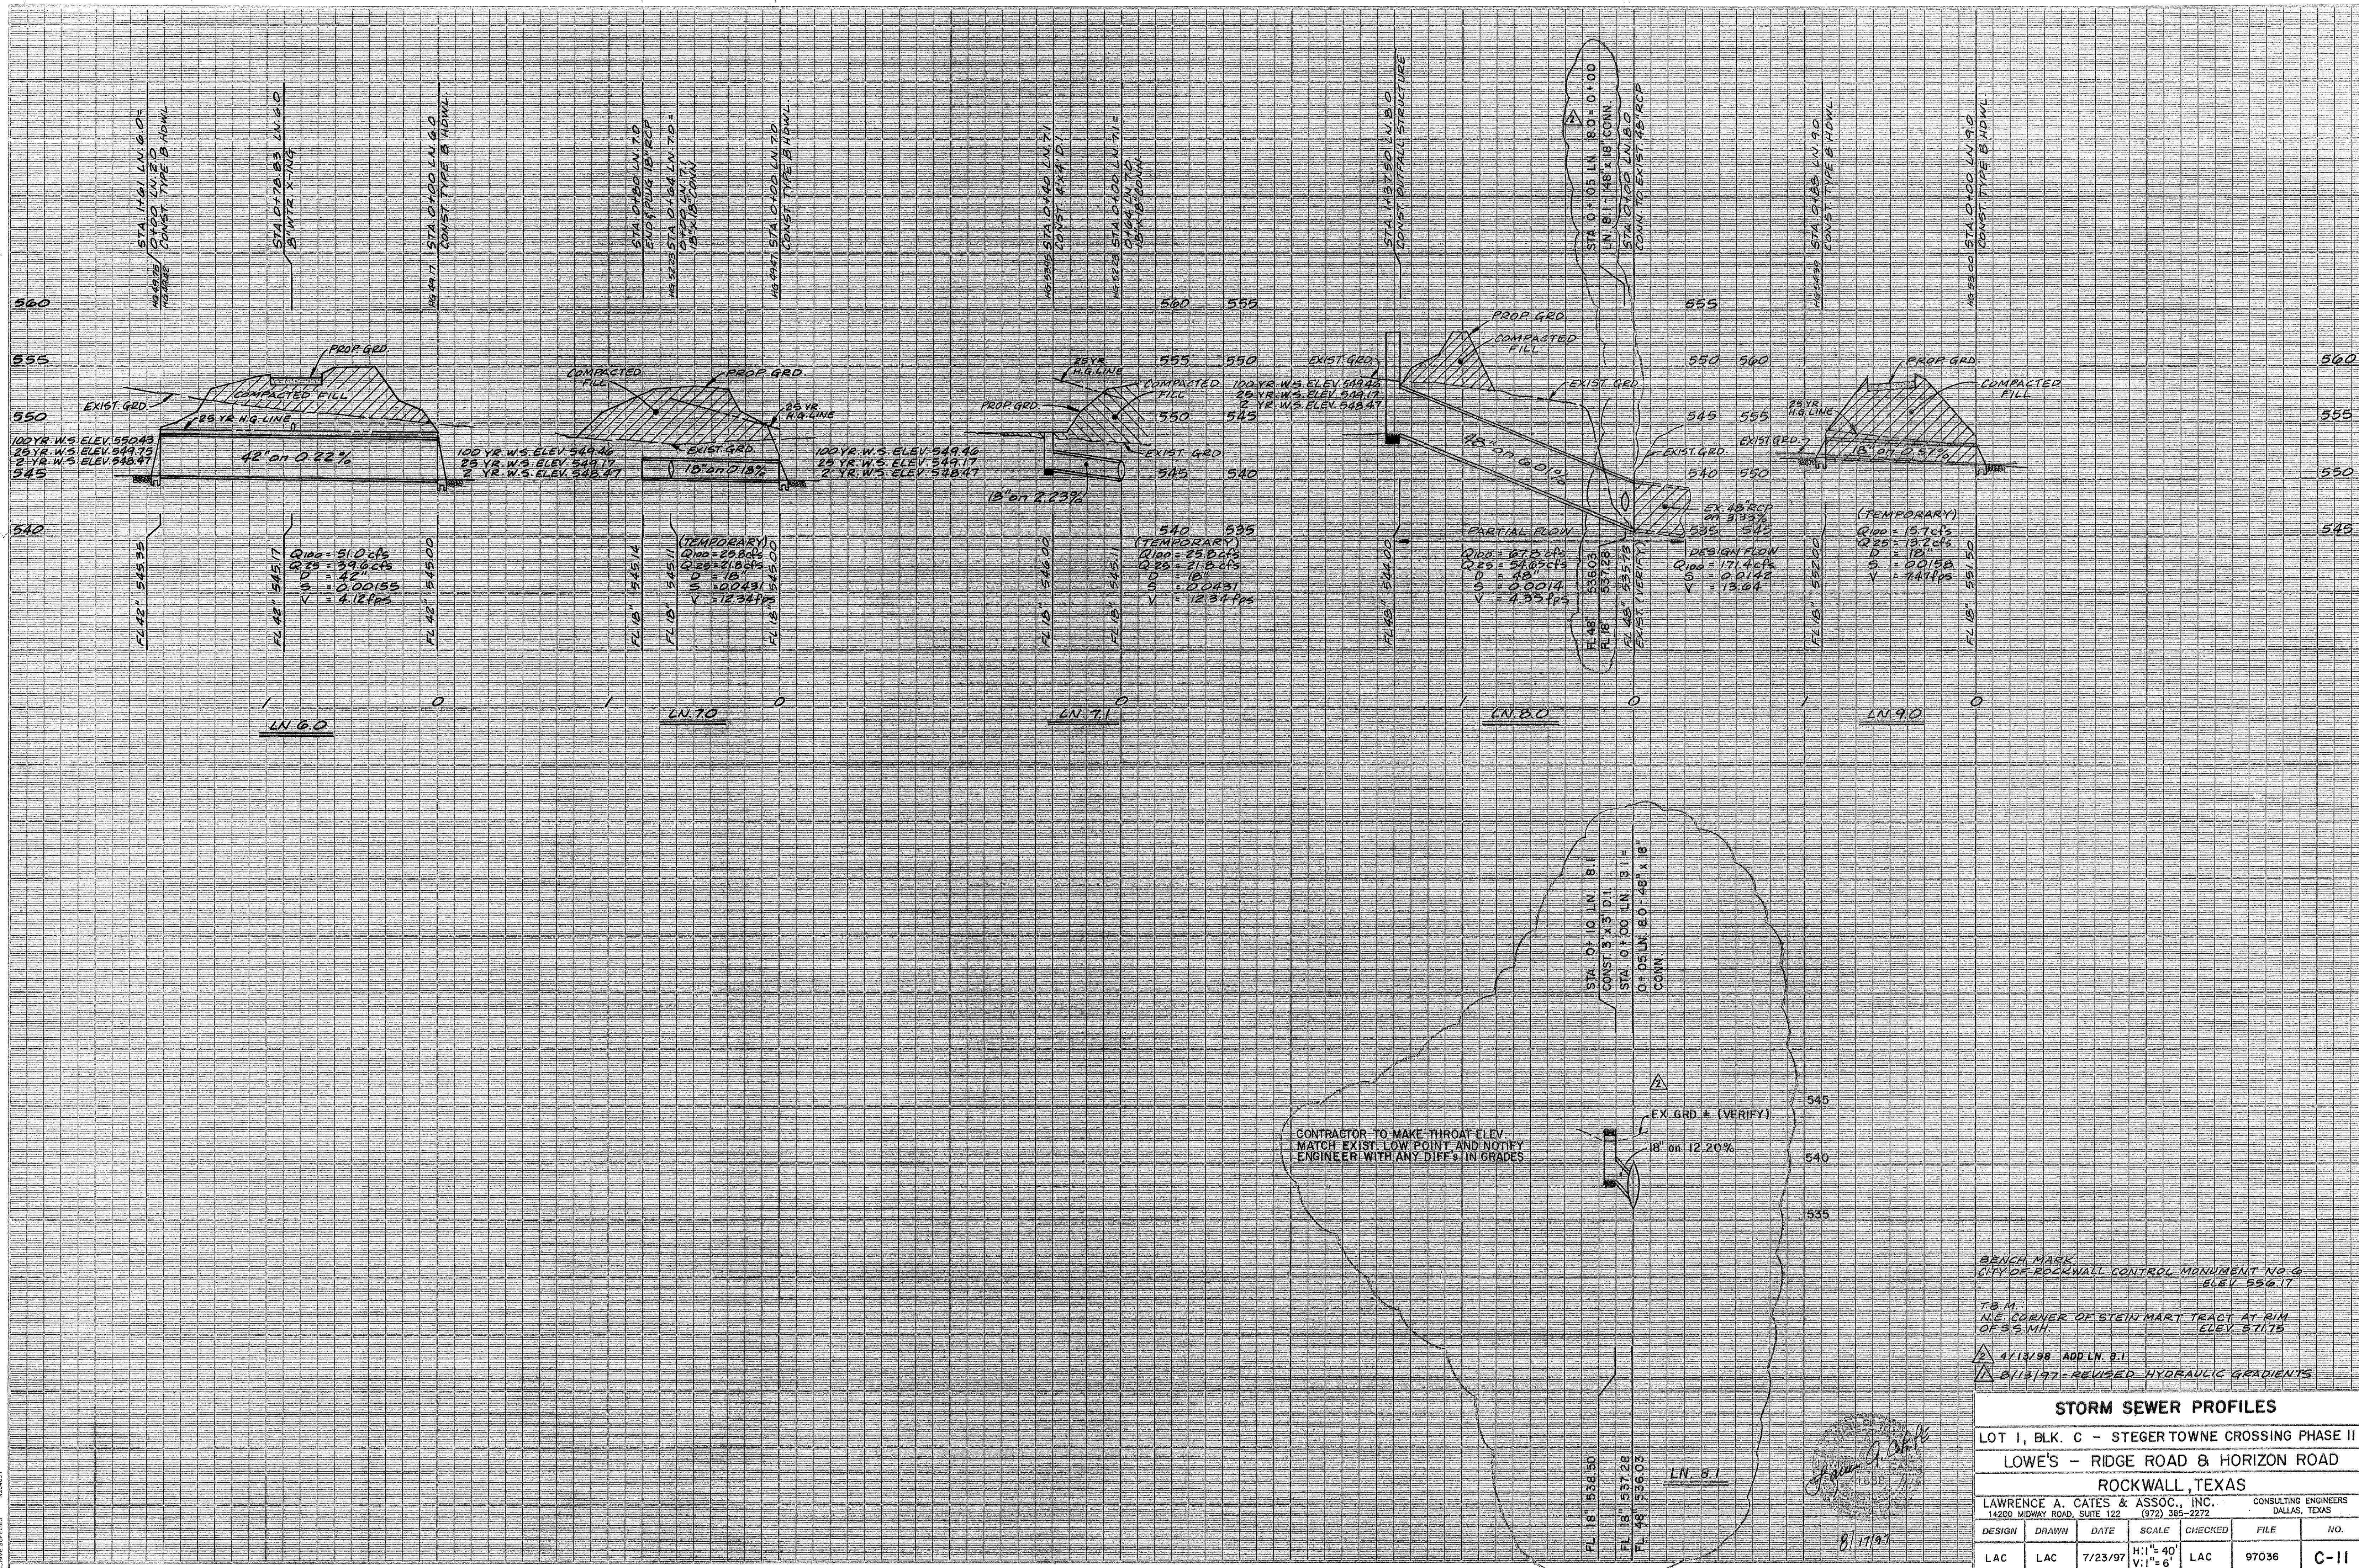

BENCH MARK  
CITY OF ROCKWALL CONTROL MONUMENT NO. 6  
ELEV. 556.17

T.B.M.  
N.E. CORNER OF STEIN MART TRACT AT RIM  
OF S.S. MH.  
ELEV. 571.75

1/13/98 ADD LN. 8.1

8/13/97 REVISED HYDRAULIC GRADIENTS

| STORM SEWER PROFILES                                                                                               |       |         |                     |         |       |
|--------------------------------------------------------------------------------------------------------------------|-------|---------|---------------------|---------|-------|
| LOT 1, BLK. C - STEGERTOWNE CROSSING PHASE II                                                                      |       |         |                     |         |       |
| LOWE'S - RIDGE ROAD & HORIZON ROAD                                                                                 |       |         |                     |         |       |
| ROCKWALL, TEXAS                                                                                                    |       |         |                     |         |       |
| LAWRENCE A. CATES & ASSOC., INC.<br>14200 MIDWAY ROAD, SUITE 122 (972) 385-2272 CONSULTING ENGINEERS DALLAS, TEXAS |       |         |                     |         |       |
| DESIGN                                                                                                             | DRAWN | DATE    | SCALE               | CHECKED | FILE  |
| LAC                                                                                                                | LAC   | 7/23/97 | H:1"=40'<br>V:1"=6' | LAC     | 97036 |
|                                                                                                                    |       |         |                     |         | NO.   |
|                                                                                                                    |       |         |                     |         | C-11  |