


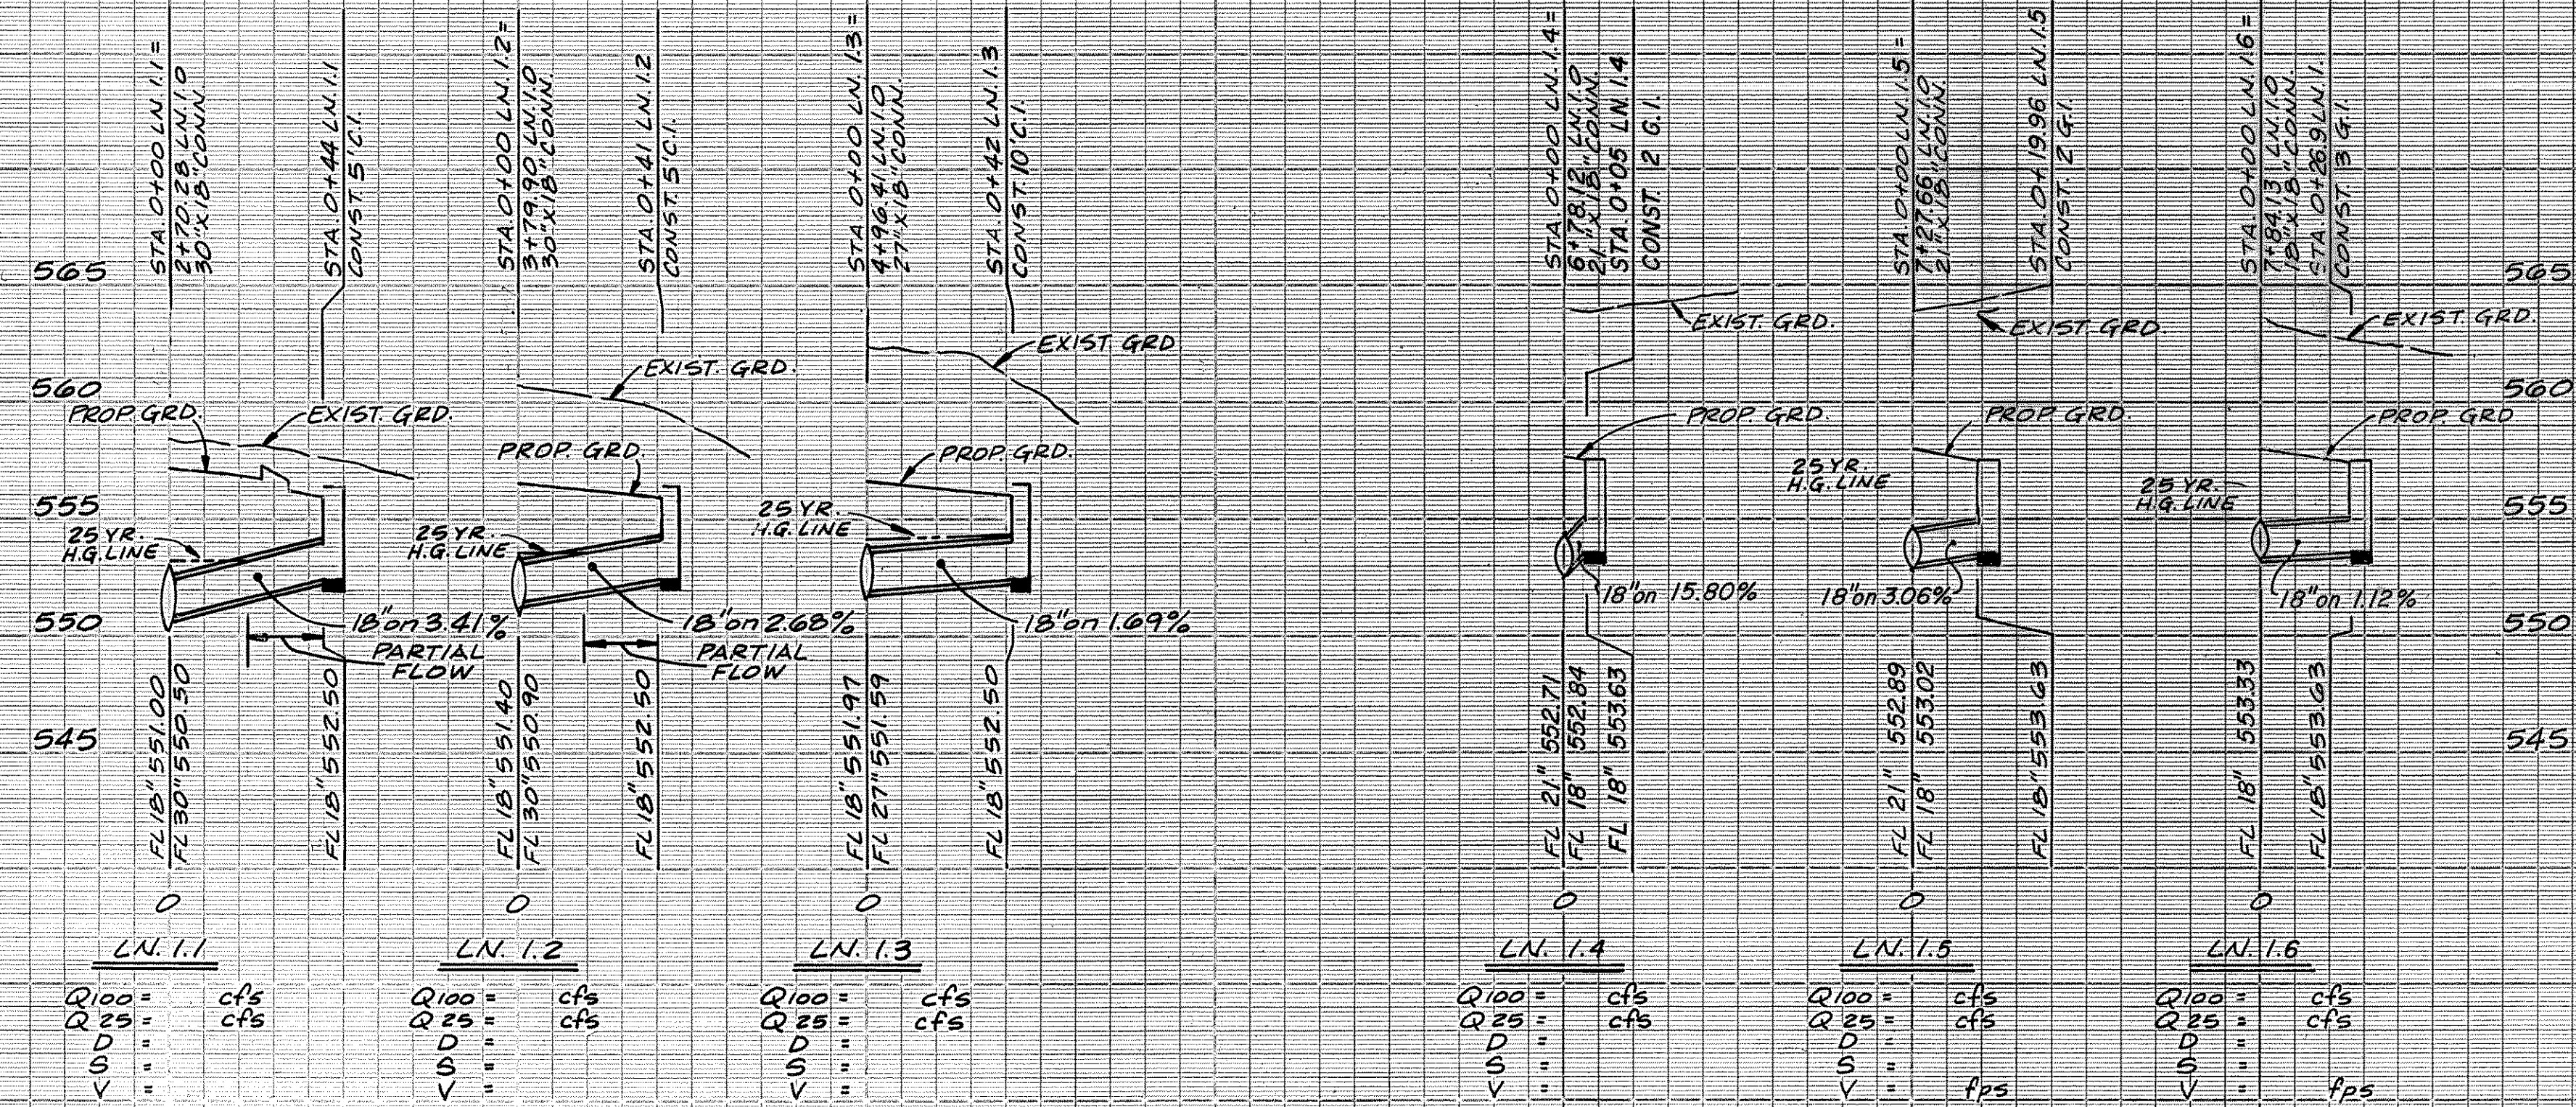

T.B.M.:
N.E. CORNER OF STEIN MART TRACT AT RIM
OF S.S. MH. ELEV 571.75

LAC	LAC	7/23/97	V.I. = 6'	LAC	97036	C-8
-----	-----	---------	-----------	-----	-------	-----

07/23/97