


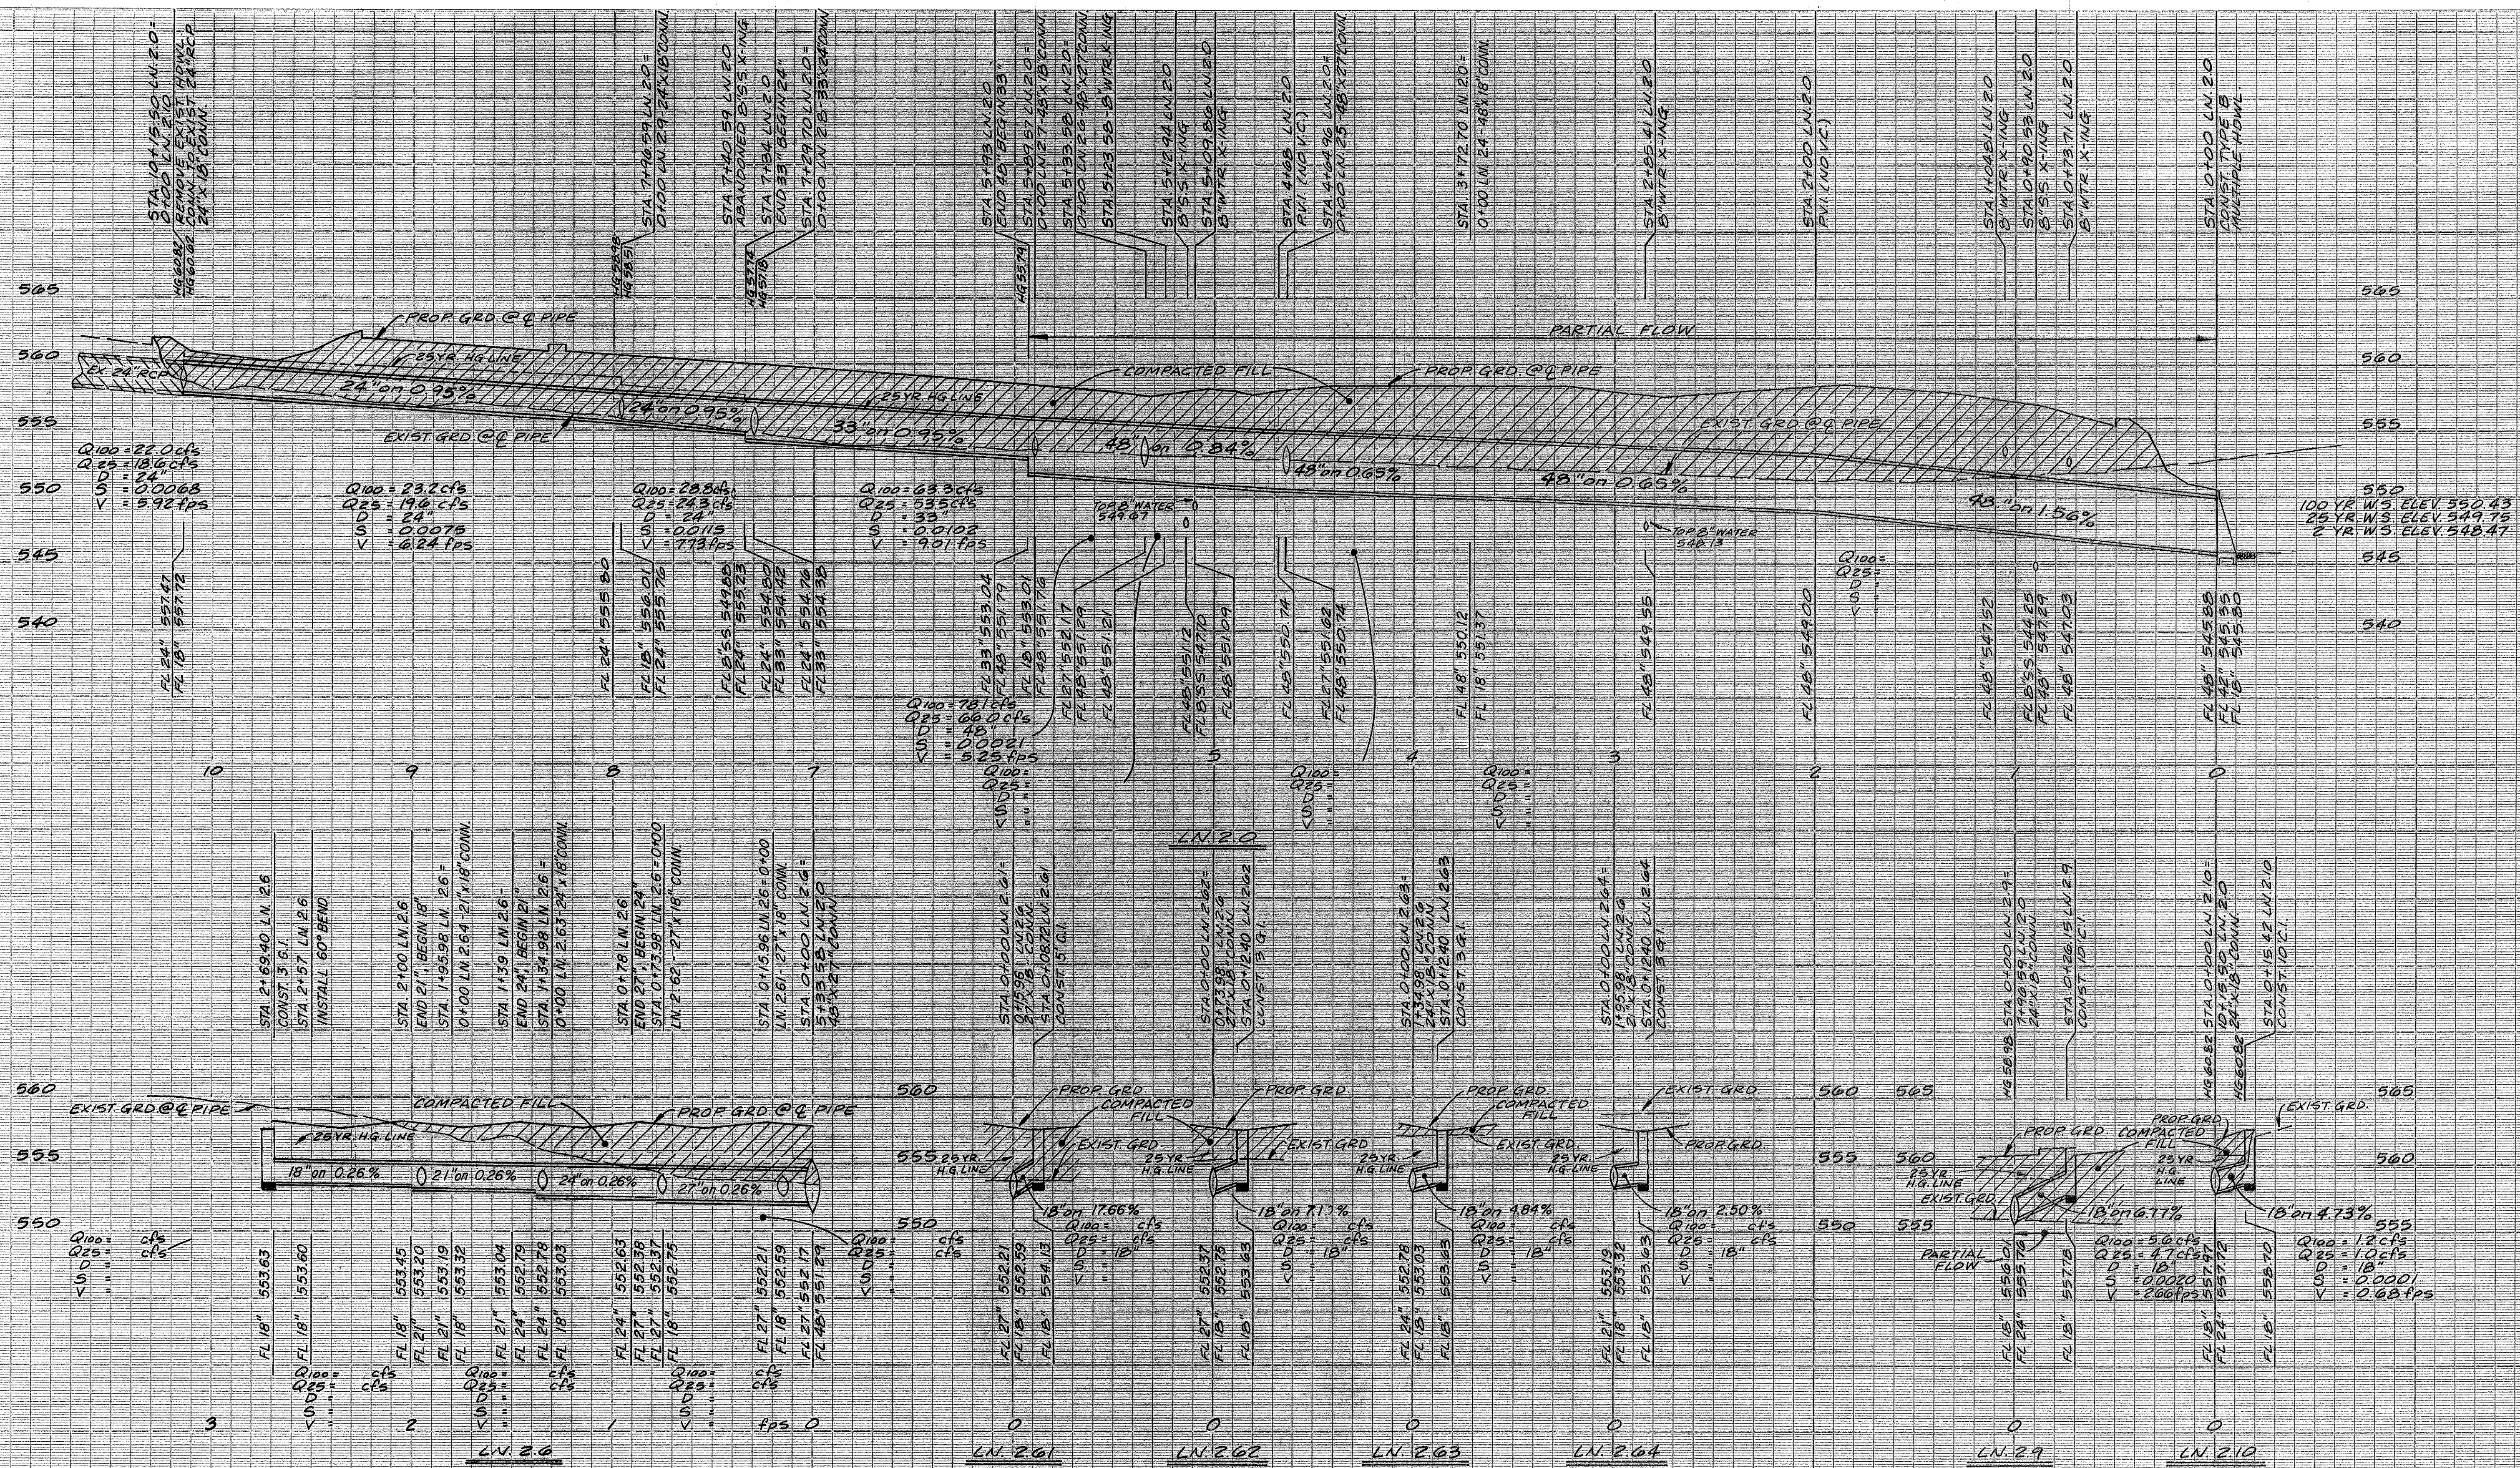

BENCH MARK:
CITY OF ROCKWALL CONTROL MONUMENT NO. 6
ELEV. 556.17

T.B.M.
N.E. CORNER OF STEIN MART TRACT AT RIM
OF S.S. MH.
ELEV. 571.75

8/13/97 - REVISED HYDRAULIC GRADIENTS

STORM SEWER PROFILES					
LOT 1, BLK. C -- STEGER TOWNE CROSSING PHASE II					
LOWE'S - RIDGE ROAD & HORIZON ROAD					
ROCKWALL, TEXAS					
LAWRENCE A. CATES & ASSOC., INC.					
14200 MIDWAY ROAD, SUITE 122 DALLAS, TEXAS					
DESIGN	DRAWN	DATE	SCALE	CHECKED	FILE
LAC	LAC	7/23/97	H:1"=40' V:1"=6'	LAC	97036
					NO.
					C-9