


LEGEND

- PD 102.1 PROPOSED POOL DECK SPOT ELEVATION
- PC 102.1 PROPOSED POOL COPING SPOT ELEVATION
- PS 102.1 PROPOSED SIDEWALK SPOT ELEVATION
- RIM 102.1 PROPOSED RIM ELEVATION OF AREA DRAIN
- TC 102.1 PROPOSED TOP OF CURB SPOT ELEVATION
- TP 102.1 PROPOSED TOP OF PAVING SPOT ELEVATION
- TPS 102.1 PROPOSED TOP OF PLAY SURFACE SPOT ELEVATION
- TPE 102.1 PROPOSED TOP OF PLAY EDGE SPOT ELEVATION
- BDI 102.1 PROPOSED BOTTOM OF DRAIN INLET SPOT ELEVATION
- TW 102.1 PROPOSED TOP OF WALL SPOT ELEVATION
- BW 102.1 PROPOSED BOTTOM OF WALL SPOT ELEVATION
- CPI 102.1 PROPOSED CURB POINT INTERSECTION SPOT ELEVATION
- FFE 102.1 PROPOSED FINISH FLOOR ELEVATION

- 638 PROPOSED CONTOUR
- 638 EXISTING CONTOUR
- FIRE LANE
- 6" REINFORCED CONCRETE AT 3600 PSI CONCRETE WITH LIME STABILIZED SOILS OR 8" REINFORCED CONCRETE AT 3600 PSI WITH NO LIME STABILIZATION
- 6" REINFORCED CONCRETE AT 3600 PSI CONCRETE WITH LIME STABILIZED SOILS OR 8" REINFORCED CONCRETE AT 3600 PSI WITH NO LIME STABILIZATION

*NOTE:
TO THE BEST OF OUR KNOWLEDGE STUDIO 13 DESIGN GROUP, HEREBY STATES THAT THIS PLAN IS AS-BUILT. THIS INFORMATION PROVIDED IS BASED ON SURVEYING AT THE SITE AND INFORMATION PROVIDED BY THE CONTRACTOR.

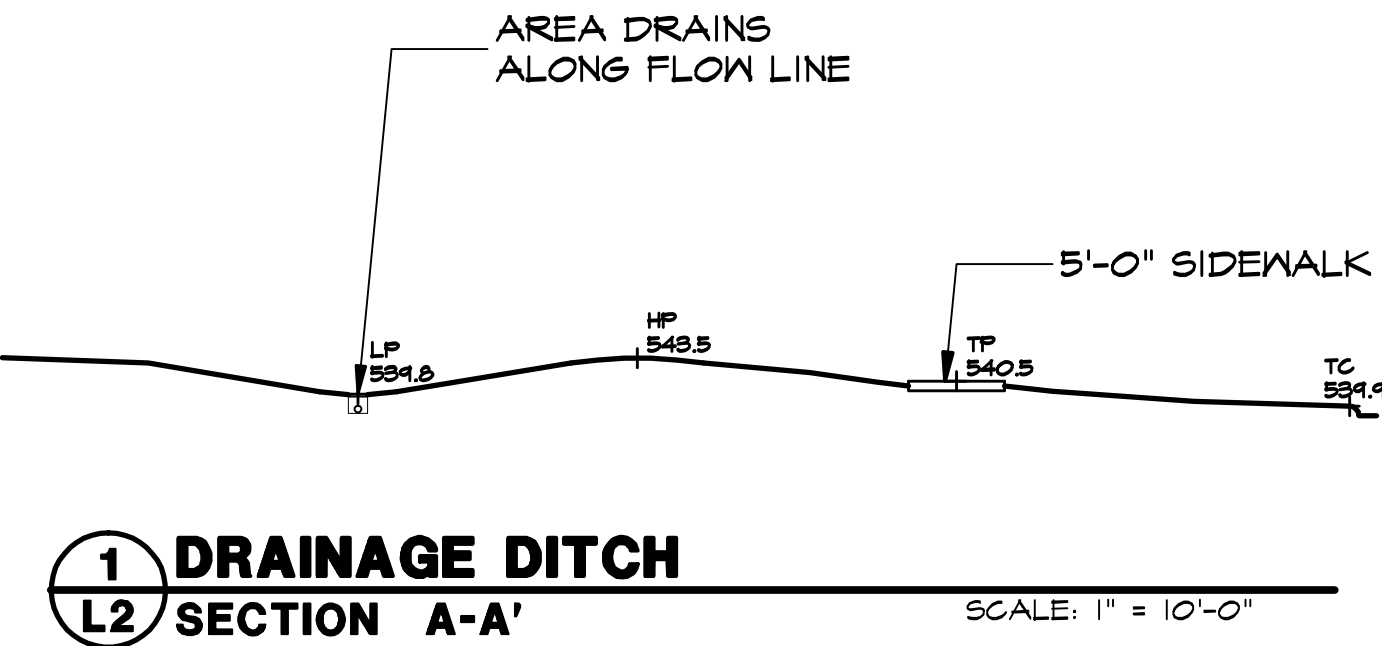

30 15 0 30 60
1" = 30' - 0"

RECORD DRAWING
LEONARD L. REEVES RLA #1977

STUDIO 13
DESIGN GROUP
Studio 13 Design Group, PLLC.
1740 Midway Rd.
Lewisville, Texas 75056
469-635-1900

#	PLAN REVIEW REVISIONS	BY	DATE
1	PER CITY COMMENTS	GEB	02/04/2009

#	CONSTRUCTION REVISIONS	BY	DATE
1	ISSUED FOR CONSTRUCTION	LWR	03/04/2009

AMENITY CENTER PLAN		PROJECT
GRADING PLAN		SKO005
STONECREEK		SHEET
City of Rockwall, Rockwall County, Texas		L2