


DEVELOPMENT PLANS
FOR
STONE CREEK
PHASE X
CITY OF ROCKWALL, TEXAS

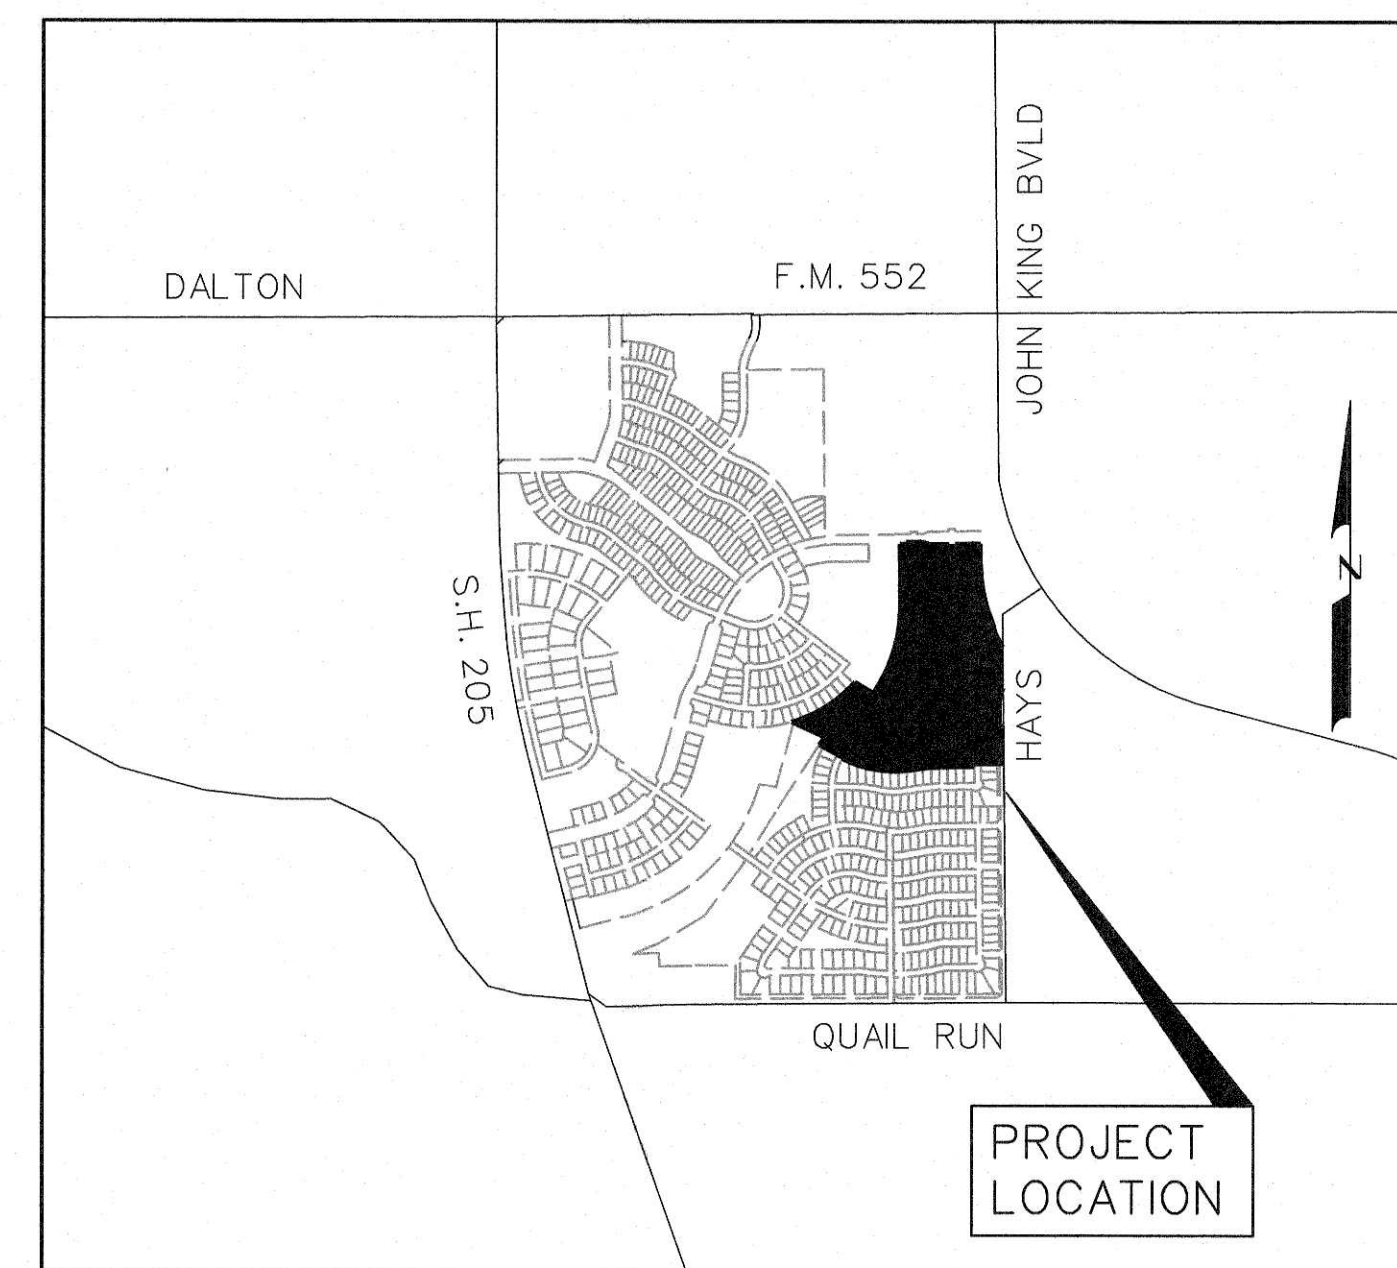

LOCATION MAP

PREPARED FOR
STONE CREEK PHASE 10, LTD.

8214 WESTCHESTER DRIVE, SUITE 710, DALLAS, TEXAS 75225

CORWIN ENGINEERING, INC. — CONSULTING ENGINEERS

200 W. BELMONT, SUITE E

TBPE FIRM #5951

ALLEN, TEXAS 75013

INDEX

- 1 TITLE
- 2 PLAT
- 3 PLAT
- 4 NAUTILUS DRIVE (STA. 6+36 TO 17+00)
- 5 NAUTILUS DRIVE (STA. 17+00 TO END)
- 6 MELODY MEADOW DRIVE
- 7 ALBATROSS DRIVE
- 8 PETREL DRIVE
- 9 GOOSE LAKE DRIVE & BRIDLE RANCH DRIVE
- 10 TOPAZ DRIVE (STA. 2+59 TO 13+00)
- 11 TOPAZ DRIVE (STA. 13+00 TO END)
- 12 HAYS ROAD
- 13 WATER AND SANITARY SEWER PLAN
- 14 SANITARY SEWER PROFILES
- 15 SANITARY SEWER PROFILES
- 16 SANITARY SEWER PROFILES
- 17 EXISTING CONDITIONS DRAINAGE AREA MAP
- 17A DRAINAGE AREA MAP
- 18 DRAINAGE CALCULATIONS
- 19 STORM SEWER PLAN AND PROFILE LINE 'D-1'
- 20 STORM SEWER PLAN AND PROFILE LINE 'D-2'
- 21 STORM SEWER PLAN AND PROFILE LINES 'D-3' & 'D-4'
- 22 STORM SEWER PLAN AND PROFILE LINE 'D-5'
- 23 STORM SEWER PLAN AND PROFILE LINE 'D-6'
- 24 EXISTING POND ANALYSIS
- 25 STORM SEWER PROFILES
- 26 STORM SEWER PROFILES
- 27 GRADING PLAN
- 28 GRADING PLAN
- 29 EROSION CONTROL PLAN
- 30 SIGN AND LIGHT PLAN
- 31 STREET SIGN DETAILS
- 32 DECORATIVE SIGN POLE DETAILS



Warren L. Corwin
12-16-2020

AS-BUILT DECEMBER 2020

INFORMATION PROVIDED
BY CONTRACTORS
(NOT FIELD VERIFIED)

BENCHMARK:

CITY OF ROCKWALL SURVEY MONUMENT ON AN INLET
AT THE NORTHWEST CORNER OF FEATHERSTONE DR. AND
HARVARD DR.
ELEV.- 525.31

NOTE:

CITY OF ROCKWALL STANDARDS
AND NCTCOG 4th ADDITION STANDARDS
SHALL BE USED FOR REFERENCE.

3	CITY COMMENTS	8-7-19
2	CITY COMMENTS	7-17-19
1	CITY COMMENTS	6-13-19
NO.	REVISIONS	DATE

APRIL 2019

LEGAL DESCRIPTION

BEING, a tract of land situated in the W.T. DeWeese Survey, Abstract No. 71 and the S. King Survey, Abstract No. 131, both in the City of Rockwall, Texas, and being more particularly described as follows:

BEGINNING, at a 1/2 inch iron rod found at the northeast corner of Stone Creek Phase IX, an addition to the City of Rockwall, as described in Doc No. 20180000004513 in the Plat Records of Rockwall County, Texas, and being in Hays Road;

THENCE, South 89° 24' 25" West, along the north line of said Stone Creek Phase IX, for a distance of 222.00 feet, to a 1/2 inch iron rod found;

THENCE, South 00° 35' 35" East, continuing along said north line, for a distance of 211.11 feet, to a 1/2 inch iron rod found;

THENCE, South 89° 24' 25" West, continuing along said north line, for a distance of 226.33 feet, to a 1/2 inch iron rod found, at the point of curvature of a curve to the left, having a radius of 1560.00 feet, a central angle of 08° 38' 43";

THENCE, continuing along said north line and with said curve to the left for an arc distance of 235.39 feet (Chord Bearing South 83° 05' 03" West - 235.16 feet), to a 1/2 inch iron rod found at the point of reverse curvature of a curve to the right, having a radius of 880.00 feet, a central angle of 36° 03' 38";

THENCE, continuing along said north line and with said curve to the right for an arc distance of 553.85 feet (Chord Bearing North 81° 12' 30" West - 544.75 feet), to a 1/2 inch iron rod found on a non-tangent curve to the right, having a radius of 475.00 feet, a central angle of 01° 01' 09";

THENCE, continuing along said north line and with said curve to the right for an arc distance of 8.45 feet (Chord Bearing North 20° 02' 57" East - 8.45 feet), to a 1/2 inch iron rod found;

THENCE, North 61° 28' 29" West, continuing along said north line, for a distance of 201.15 feet, to a 1/2 inch iron rod found, at the northeast corner of said Stone Creek Phase IX, as described in Cabinet G, Pages 317-318, in said Plat Records and being the northwest corner of said Stone Creek Phase IX;

THENCE, North 32° 48' 57" East, along the east line of said Stone Creek Phase IX, for a distance of 68.36 feet, to a 1/2 inch rod found at the most easterly northeast corner of said Stone Creek Phase IX;

THENCE, North 65° 00' 04" West, along the north line of said Stone Creek Phase IX, for a distance of 283.02 feet, to a 1/2 inch iron rod found, being in a south line of Stone Creek Phase I, an addition to the City of Rockwall, as described in Cabinet G, Pages 359-365 said Plat Records, being on a non-tangent curve to the left, having a radius of 1430.00 feet, a central angle of 37° 07' 00";

THENCE, departing the north line of said Stone Creek Phase IX and along the south line of said Stone Creek Phase I, an addition to the City of Rockwall, as described in Cabinet G, Pages 359-365 said Plat Records, being on a non-tangent curve to the left, having a radius of 1430.00 feet, a central angle of 37° 07' 00";

THENCE, continuing along said north line and with said curve to the left for an arc distance of 90.28 feet, to a 1/2 inch iron rod found, being the southeast corner of Lot 10 Block 1 out of said Stone Creek Phase I, some being in said Stone Creek Phase I, an addition to the City of Rockwall, as described in Cabinet H, Pages 293-294;

THENCE, South 30° 40' 49" East, along the east line of said Stone Creek Phase I, an addition to the City of Rockwall, as described in Cabinet H, Pages 293-294, for a distance of 1125.00 feet, to a 1/2 inch iron rod found, being the point of curvature of a curve to the left, having a radius of 1125.00 feet, a central angle of 31° 16' 25";

THENCE, continuing along said east line and with said curve to the left for an arc distance of 614.05 feet (Chord Bearing North 15° 02' 37" East - 606.46 feet), to a 1/2 inch iron rod found along the south line of said Stone Creek Phase I, an addition to the City of Rockwall, as described in Cabinet H, Pages 293-294;

THENCE, South 30° 40' 49" East, along the east line of said Stone Creek Phase I, an addition to the City of Rockwall, as described in Cabinet H, Pages 293-294, for a distance of 480.08 feet, to a 1/2 inch iron rod found, being the point of tangency;

THENCE, North 00° 35' 35" West, continuing along said south line, for a distance of 50.00 feet, to a 1/2 inch iron rod found;

THENCE, North 00° 35' 35" West, continuing along said south line, for a distance of 133.20 feet, to a 1/2 inch iron rod found, being on a curve to the left, having a radius of 110.00 feet, a central angle of 34° 10' 45";

THENCE, continuing along said south line and with said curve to the left for an arc distance of 65.82 feet (Chord Bearing South 73° 29' 23" East - 64.65 feet), to a 1/2 inch iron rod found, being the point of tangency;

THENCE, North 89° 25' 13" East, continuing along said south line, for a distance of 125.01 feet, to a 1/2 inch iron rod found;

THENCE, South 00° 35' 35" East, continuing along said south line, for a distance of 15.00 feet, to a 1/2 inch iron rod found;

THENCE, North 00° 35' 35" East, continuing along said south line, for a distance of 50.00 feet, to a 1/2 inch iron rod found;

THENCE, North 00° 35' 35" West, continuing along said south line, for a distance of 15.00 feet, to a 1/2 inch iron rod found;

THENCE, North 89° 25' 13" East, continuing along said south line, for a distance of 133.20 feet, to a 1/2 inch iron rod found, being on a curve to the left, having a radius of 110.00 feet, a central angle of 34° 10' 45";

THENCE, continuing along said south line and with said curve to the left for an arc distance of 118.77 feet (Chord Bearing South 27° 58' 55" East - 118.72 feet), to a nail found in the east line of said Stone Creek Balance, being in said Hays Road;

THENCE, departing the east line of said Stone Creek Balance and continuing along Hays Road with the west line of said Part 1, tract and along said curve to the left having an arc distance of 143.39 feet (Chord Bearing South 10° 30' 40" West - 143.45 feet), to a 1/2 inch iron rod found;

THENCE, South 00° 35' 35" East, continuing along said south line, for a distance of 136.79 feet, to a nail found at the southeast corner of said Part 2, tract;

THENCE, North 89° 38' 02" East, along the south line of said Part 2, tract for a distance of 30.11 feet, to a nail found at the southeast corner of said Part 2, tract, being in east line of said Stone Creek Balance tract and said Hays Road;


THENCE, South 00° 35' 35" East, along the east line of said Stone Creek Balance tract and with Hays Road, for a distance of 287.09 feet, to the POINT OF BEGINNING and containing 36.428 acres of land.

SURVEYOR CERTIFICATE

I, WARREN L. CORWIN, do hereby certify that the plat shown hereon accurately represents the results of an on-the-ground survey made under my direction and supervision and all corners are as shown hereon and there are no encroachments, conflicts, protrusions or visible utilities on the ground except as shown and said plat has been prepared in accordance with the plotting rules and regulations of the City Plan Commission of the City of Rockwall, Texas.

DATED the this 2 day of Nov, 2020.


WARREN L. CORWIN
R.P.L.S. No. 4621

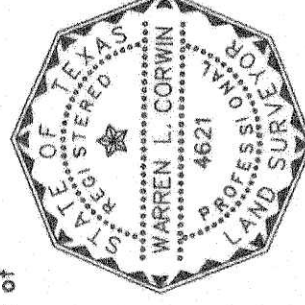

THE STATE OF TEXAS
COUNTY OF COLLIN

BEFORE ME, the undersigned, a Notary Public in and for the State of Texas, on this day personally appeared WARREN L. CORWIN, known to me to be the person whose name is subscribed to the foregoing instrument, and acknowledged to me that he executed the same in the capacity therein stated and for the purposes and considerations therein expressed.

WITNESS MY HAND AND SEAL OF OFFICE, this the 2 day of Nov, 2020.

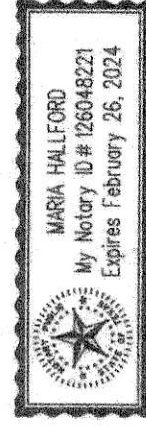

Maria Hallford
Notary Public in and for the State of Texas

FINAL PLAT

STONE CREEK
OF
PHASE X

TOTAL LOTS 118 TOTAL ACRES 36.428

OUT OF THE

S. KING SURVEY, ABSTRACT NO. 131
W.T. DEWEESE SURVEY, ABSTRACT NO. 71
IN THE

CITY OF ROCKWALL
ROCKWALL COUNTY, TEXAS

OWNER

STONE CREEK PHASE X, LTD.
8214 WESTCHESTER DRIVE, SUITE 710
DALLAS, TEXAS 75225
214-522-4943

PREPARED BY
CORWIN ENGINEERING, INC.
TBPLS #10031700

200 W. BELMONT, SUITE E
ALLEN, TEXAS 75013
972-396-1200

JANUARY 2020



CASE NO. P2019-045

SHEET 3 OF 3

Filed and Recorded
Official Public Records
Sally Miller, County Clerk
11/23/2020 09:45:25 AM
\$150.00
202001222452




Miller

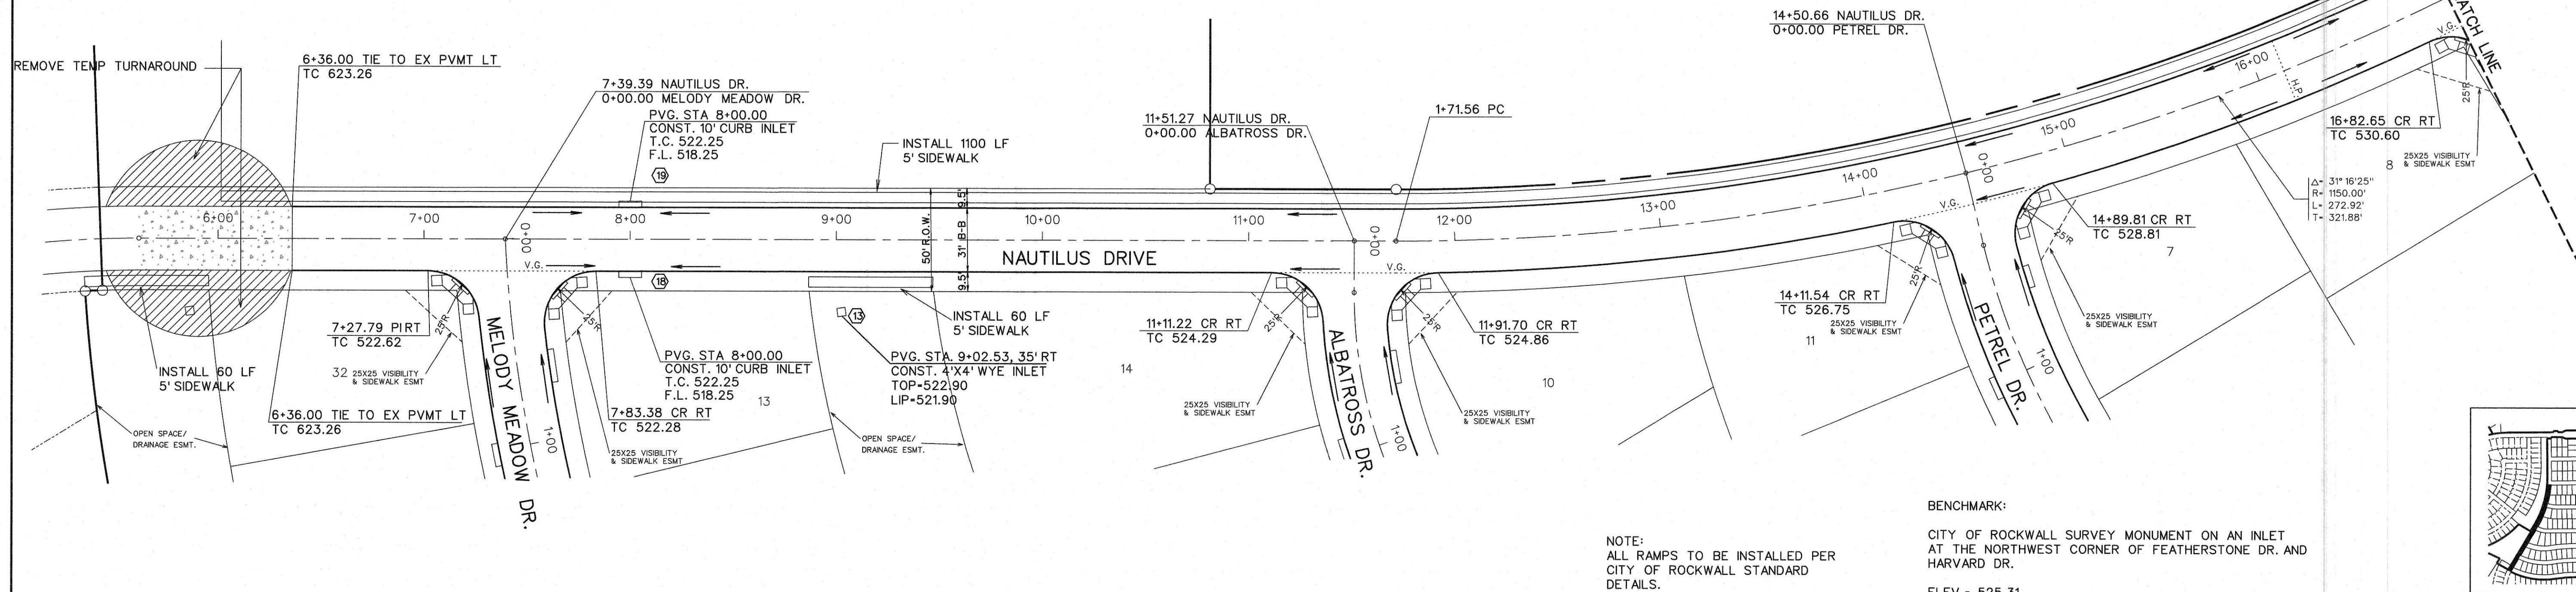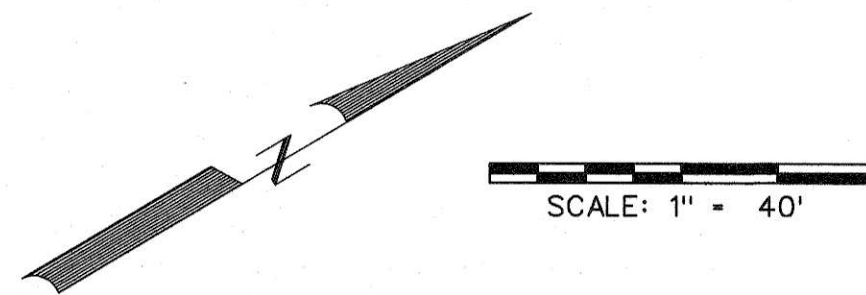


NOTE:
ALL RAMPS TO BE INSTALLED PER
CITY OF ROCKWALL STANDARD
DETAILS.

BENCHMARK:
CITY OF ROCKWALL SURVEY MONUMENT ON AN INLET
AT THE NORTHWEST CORNER OF FEATHERSTONE DR. AND
HARVARD DR.
ELEV. = 525.31

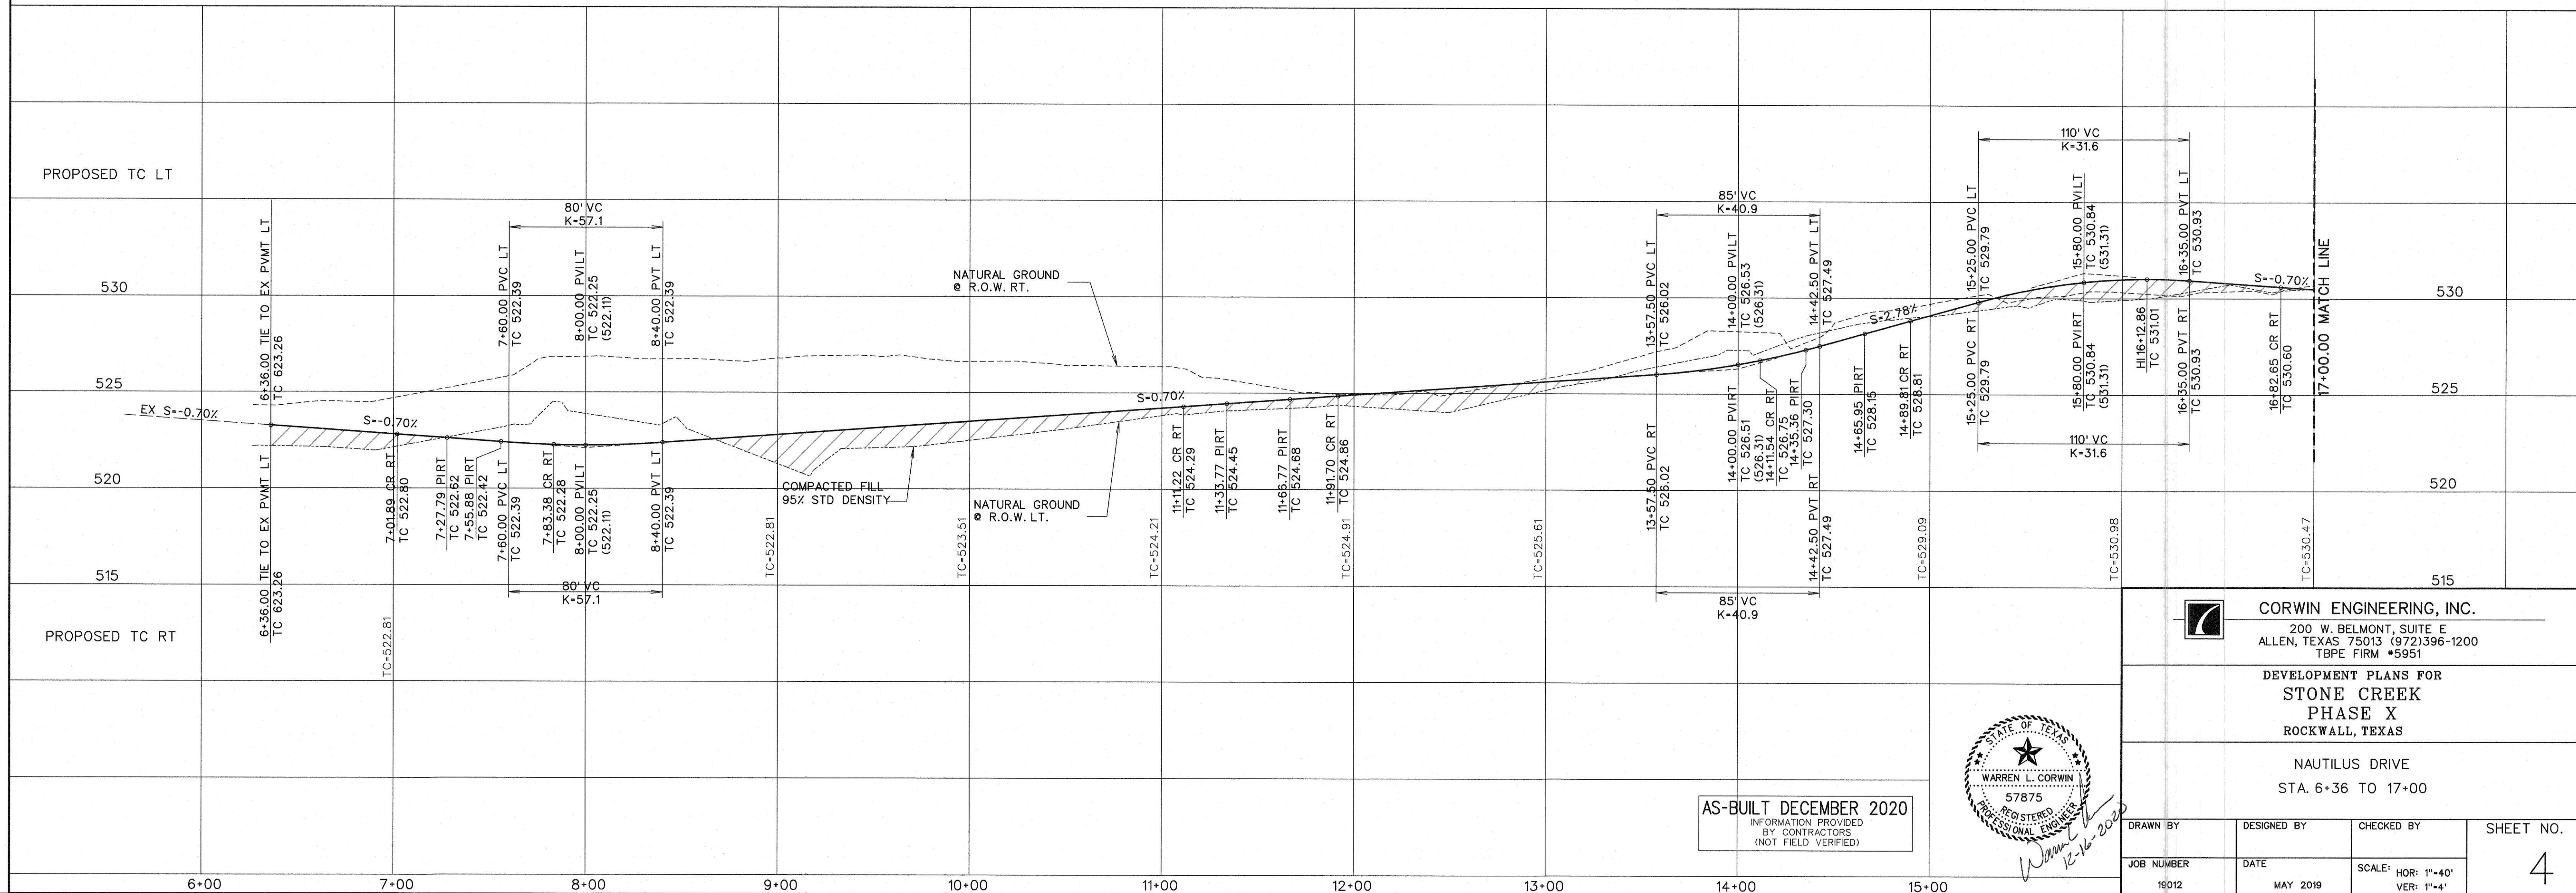

AS-BUILT DECEMBER 2020
INFORMATION PROVIDED
BY CONTRACTORS
(NOT FIELD VERIFIED)




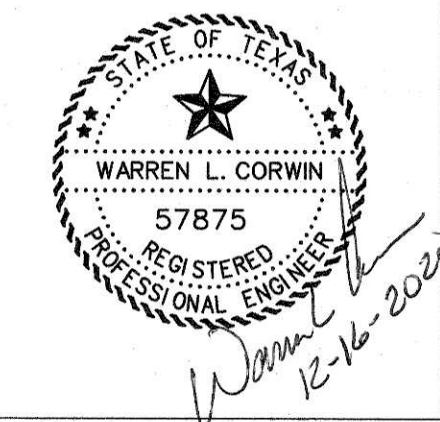


CORWIN ENGINEERING, INC.
200 W. BELMONT, SUITE E
ALLEN, TEXAS 75013 (972)396-1200
TBPE FIRM #5951

DEVELOPMENT PLANS FOR
STONE CREEK
PHASE X
ROCKWALL, TEXAS

NAUTILUS DRIVE
STA. 6+36 TO 17+00

DRAWN BY	DESIGNED BY	CHECKED BY	SHEET NO. 4
JOB NUMBER 19012	DATE MAY 2019	SCALE: HOR: 1"=40' VER: 1"=4'	

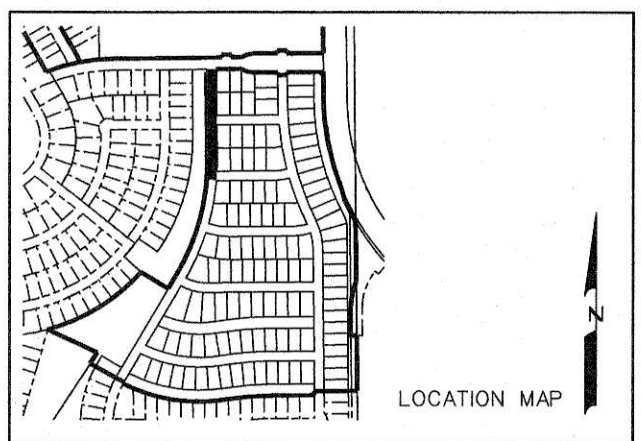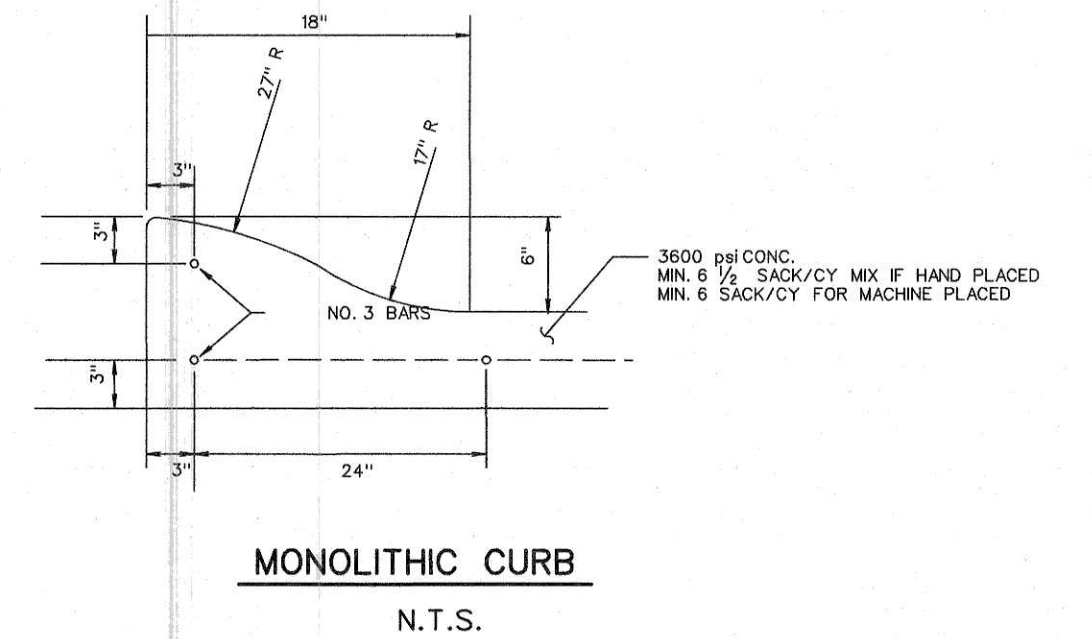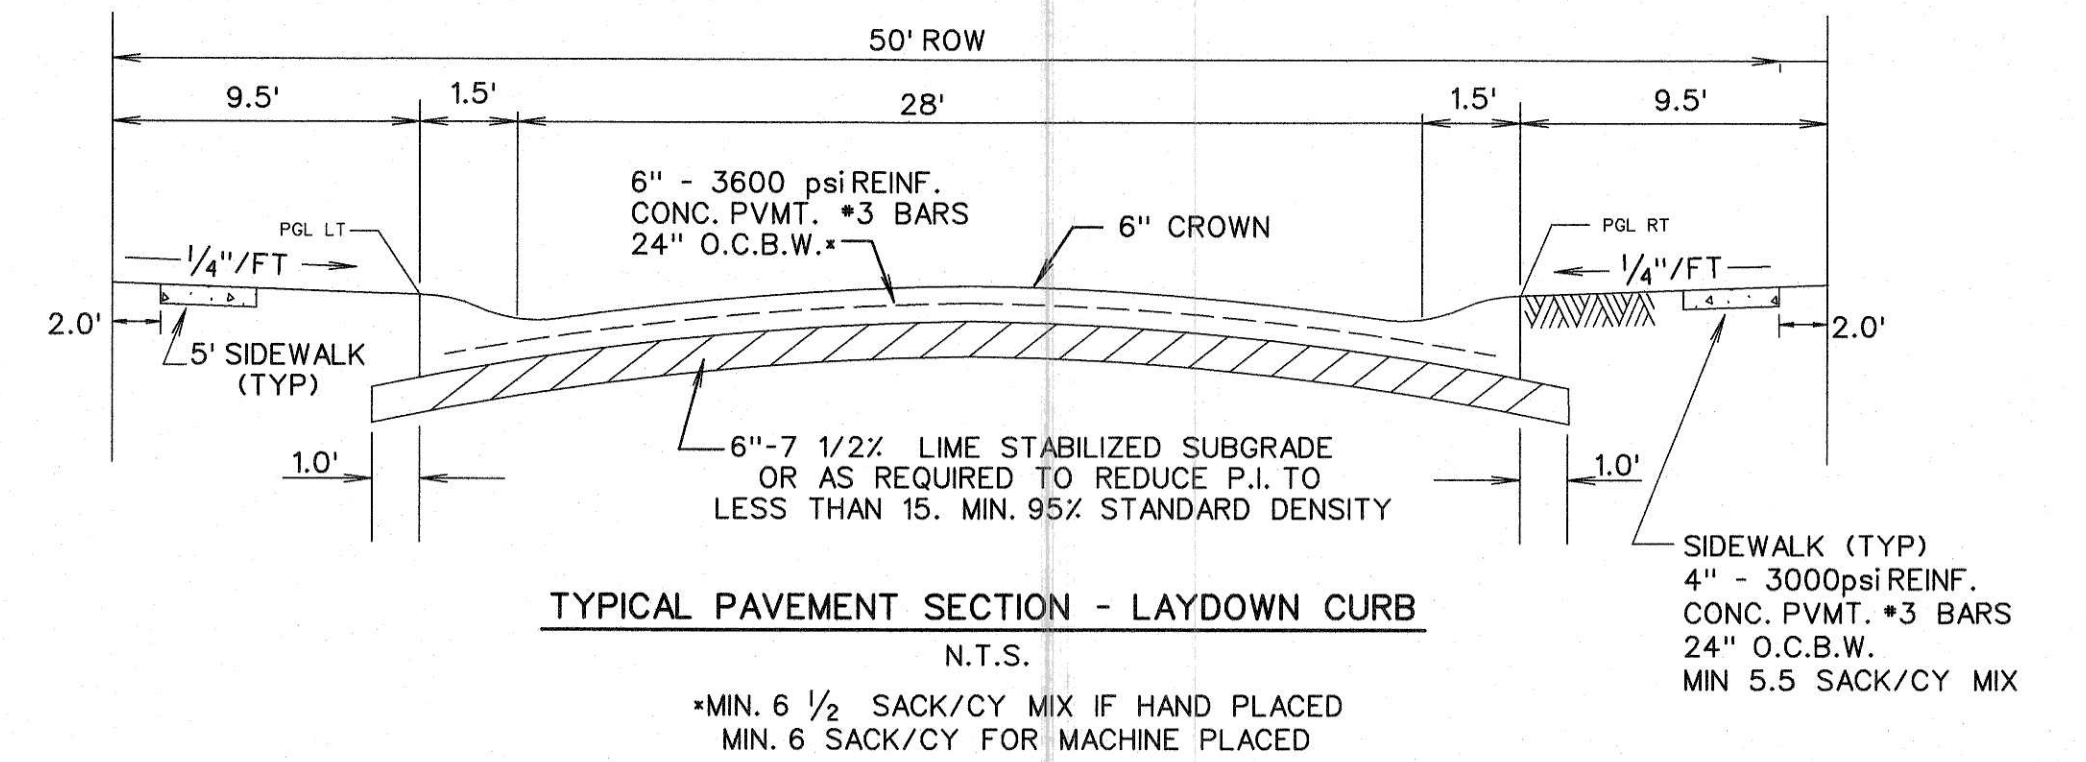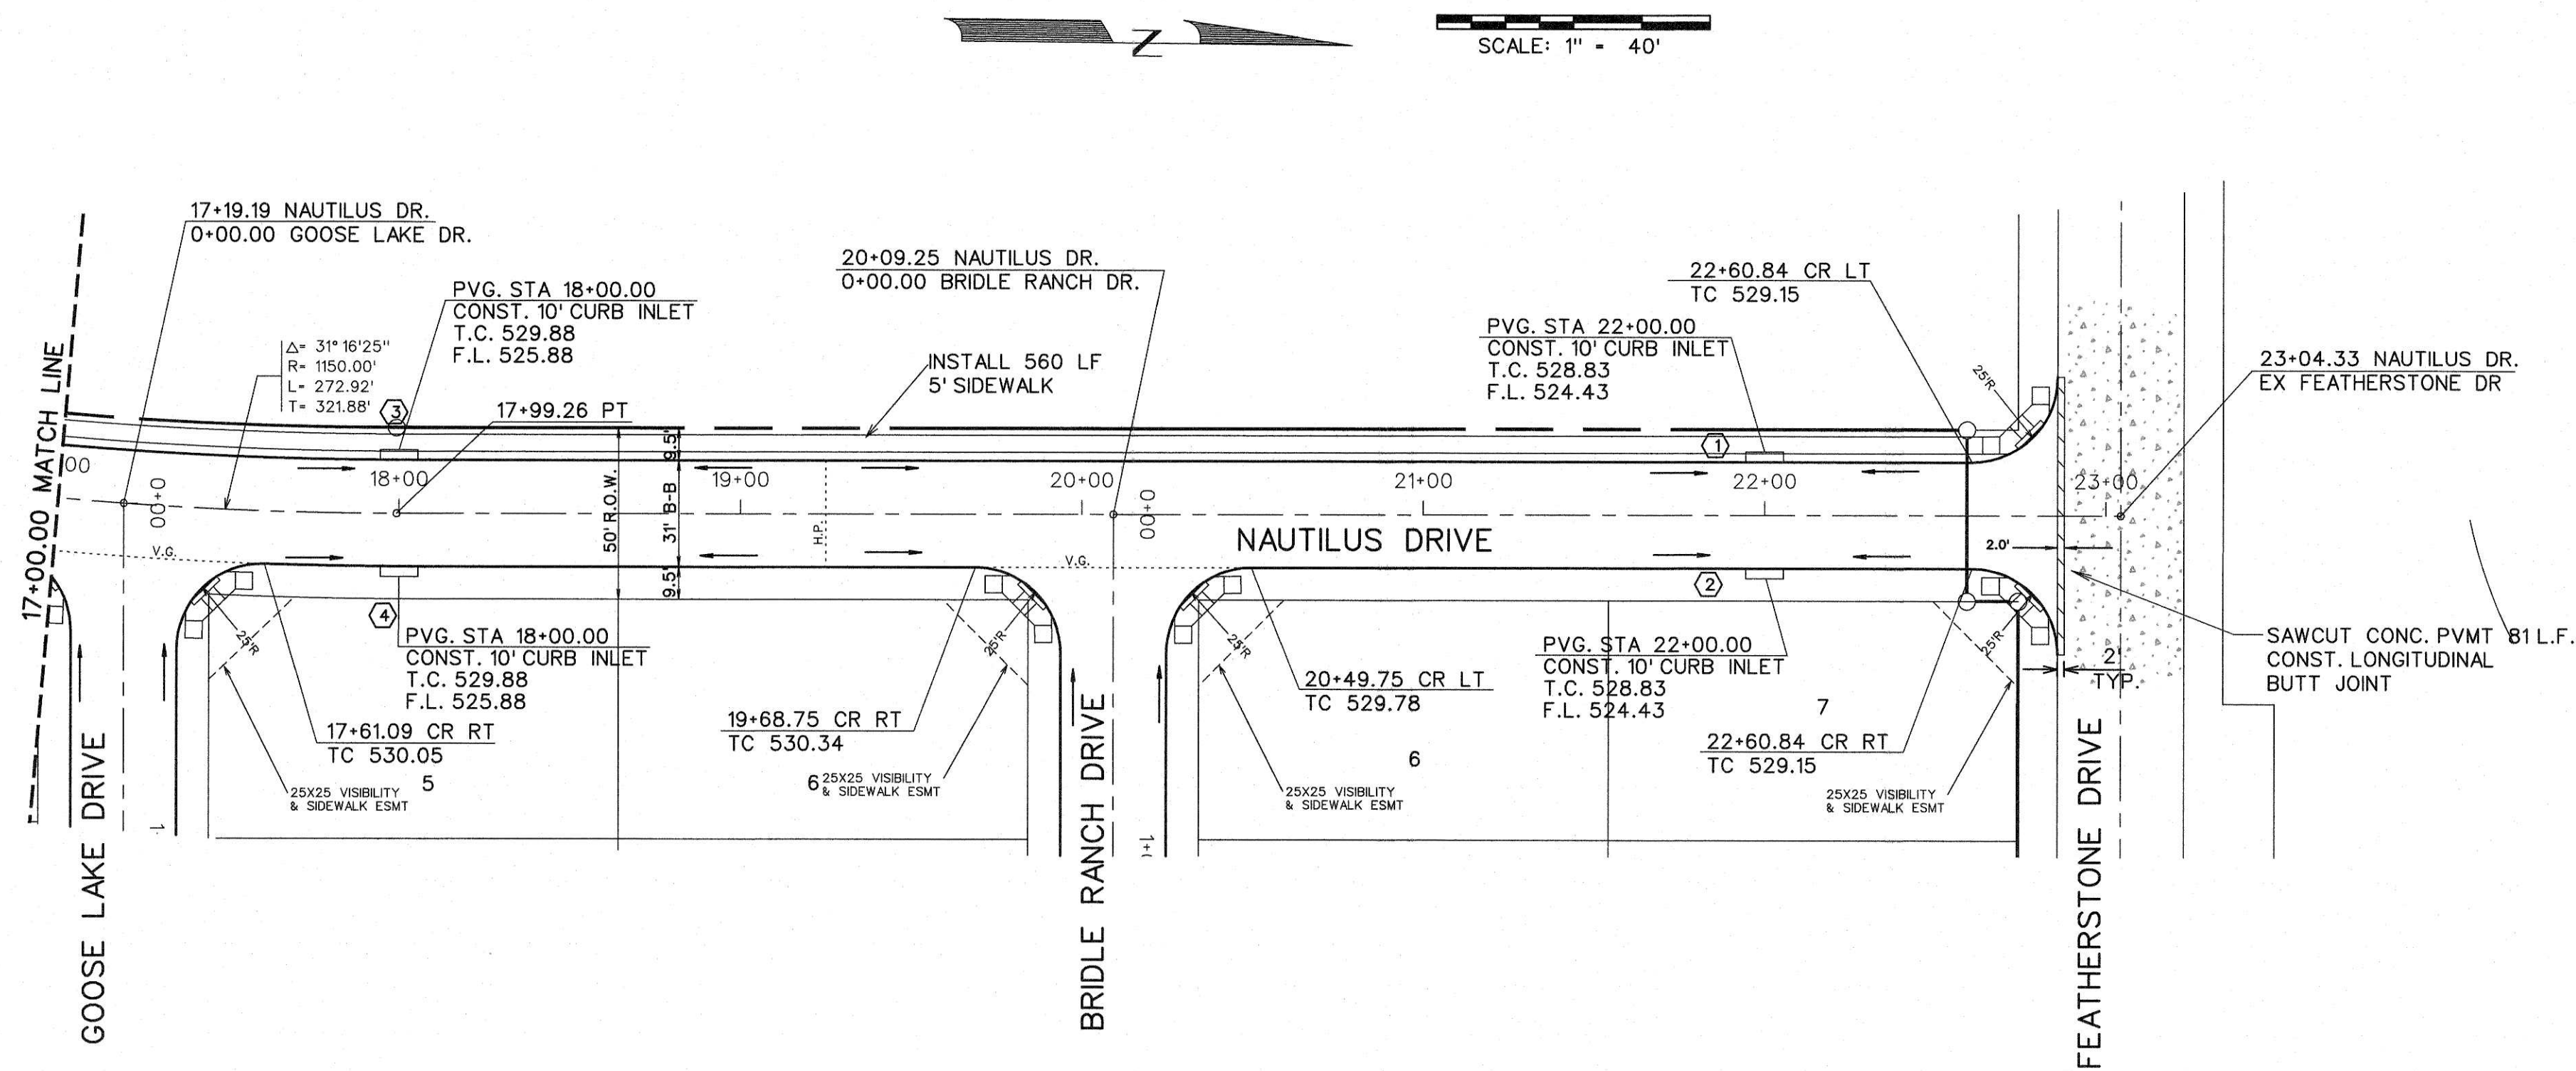

NOTE:
ALL RAMPS TO BE INSTALLED PER
CITY OF ROCKWALL STANDARD DETAIL.


BENCHMARK:

CITY OF ROCKWALL SURVEY MONUMENT ON AN INLET
AT THE NORTHWEST CORNER OF FEATHERSTONE DR. AND
HARVARD DR.


ELEV.- 525.31

PROPOSED TC LT

PROPOSED TC RT

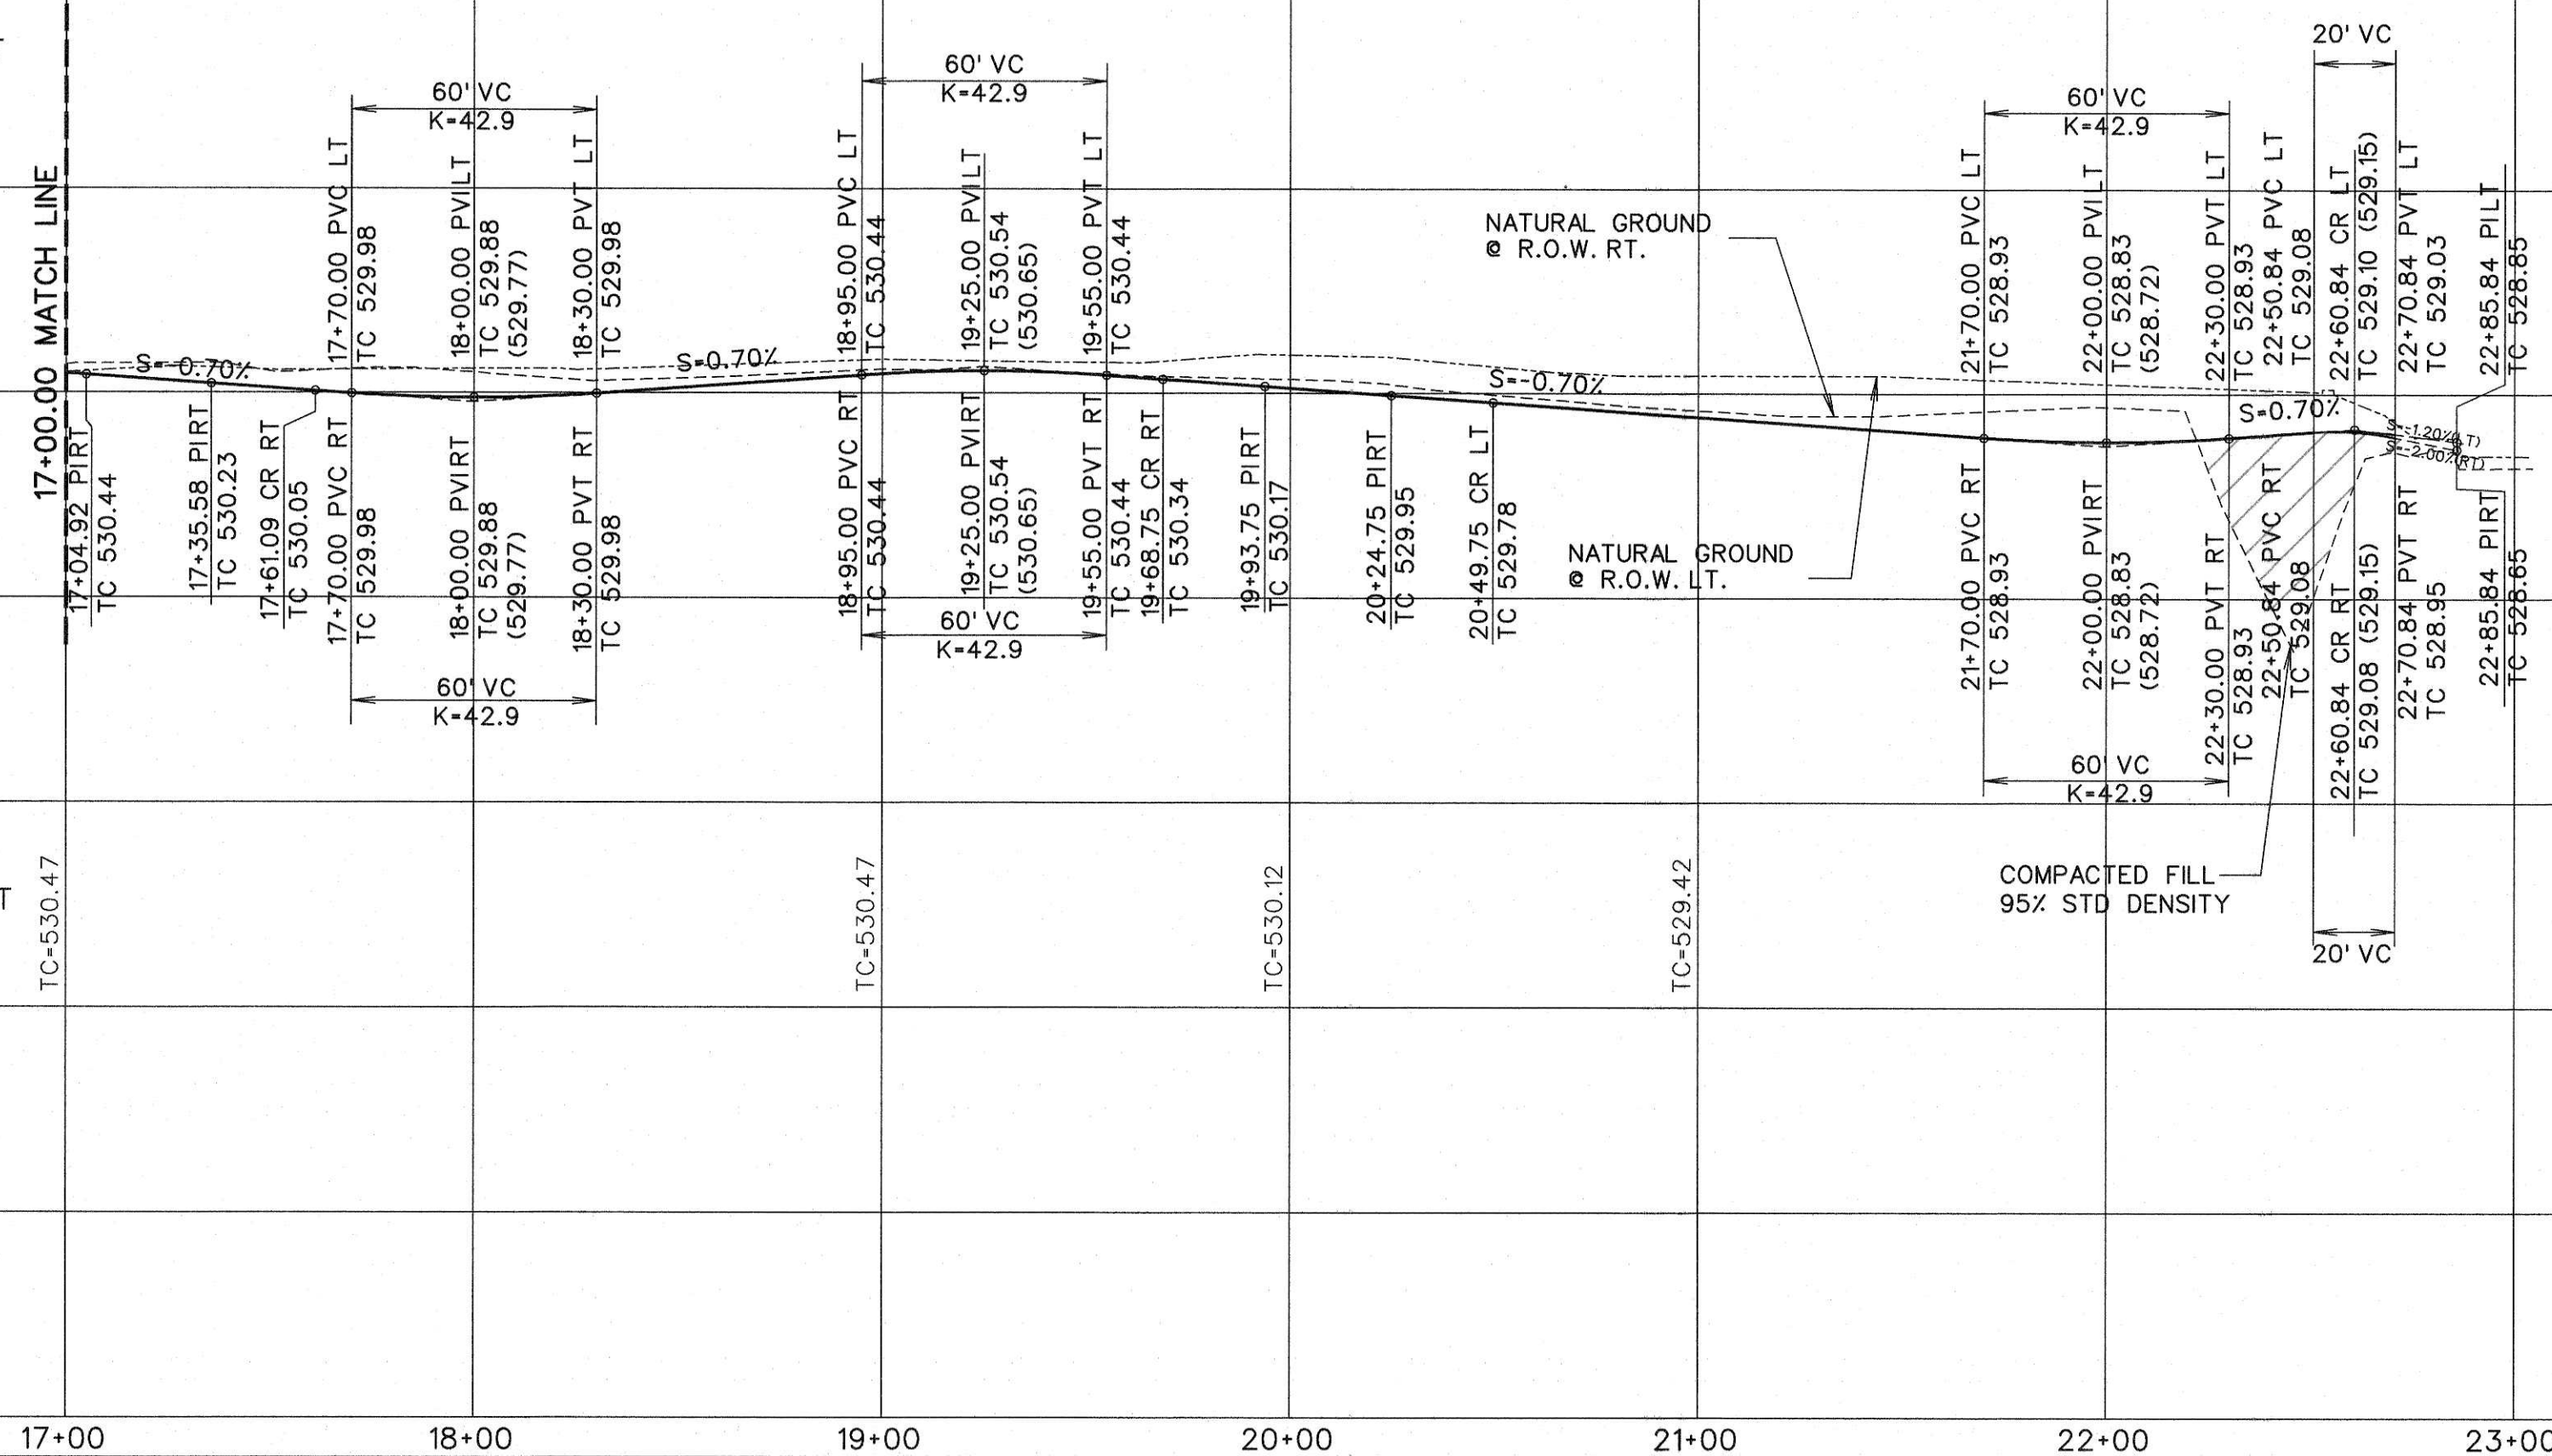

AS-BUILT DECEMBER 2020
INFORMATION PROVIDED
BY CONTRACTORS
(NOT FIELD VERIFIED)

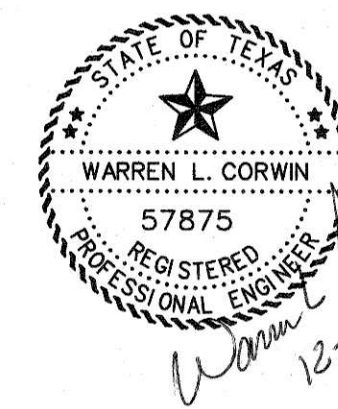

CORWIN ENGINEERING, INC.
200 W. BELMONT, SUITE E
ALLEN, TEXAS 75013 (972)396-1200
TBP FIRM #5951

DEVELOPMENT PLANS FOR
STONE CREEK
PHASE X
ROCKWALL, TEXAS



NAUTILUS DRIVE
STA. 17+00 TO END

DRAWN BY	DESIGNED BY	CHECKED BY	SHEET NO.
JOB NUMBER	DATE	SCALE	
19012	MAY 2019	HOR: 1"=40' VER: 1"=4'	5




NOTE:
ALL RAMPS TO BE INSTALLED PER
CITY OF ROCKWALL STANDARD
DETAILS.

BENCHMARK:
" X " Cut on top of curb on east side of John King Blvd.
approx. 48' north of the centerline of Pleasant View Dr.
ELEVATION = 505.61

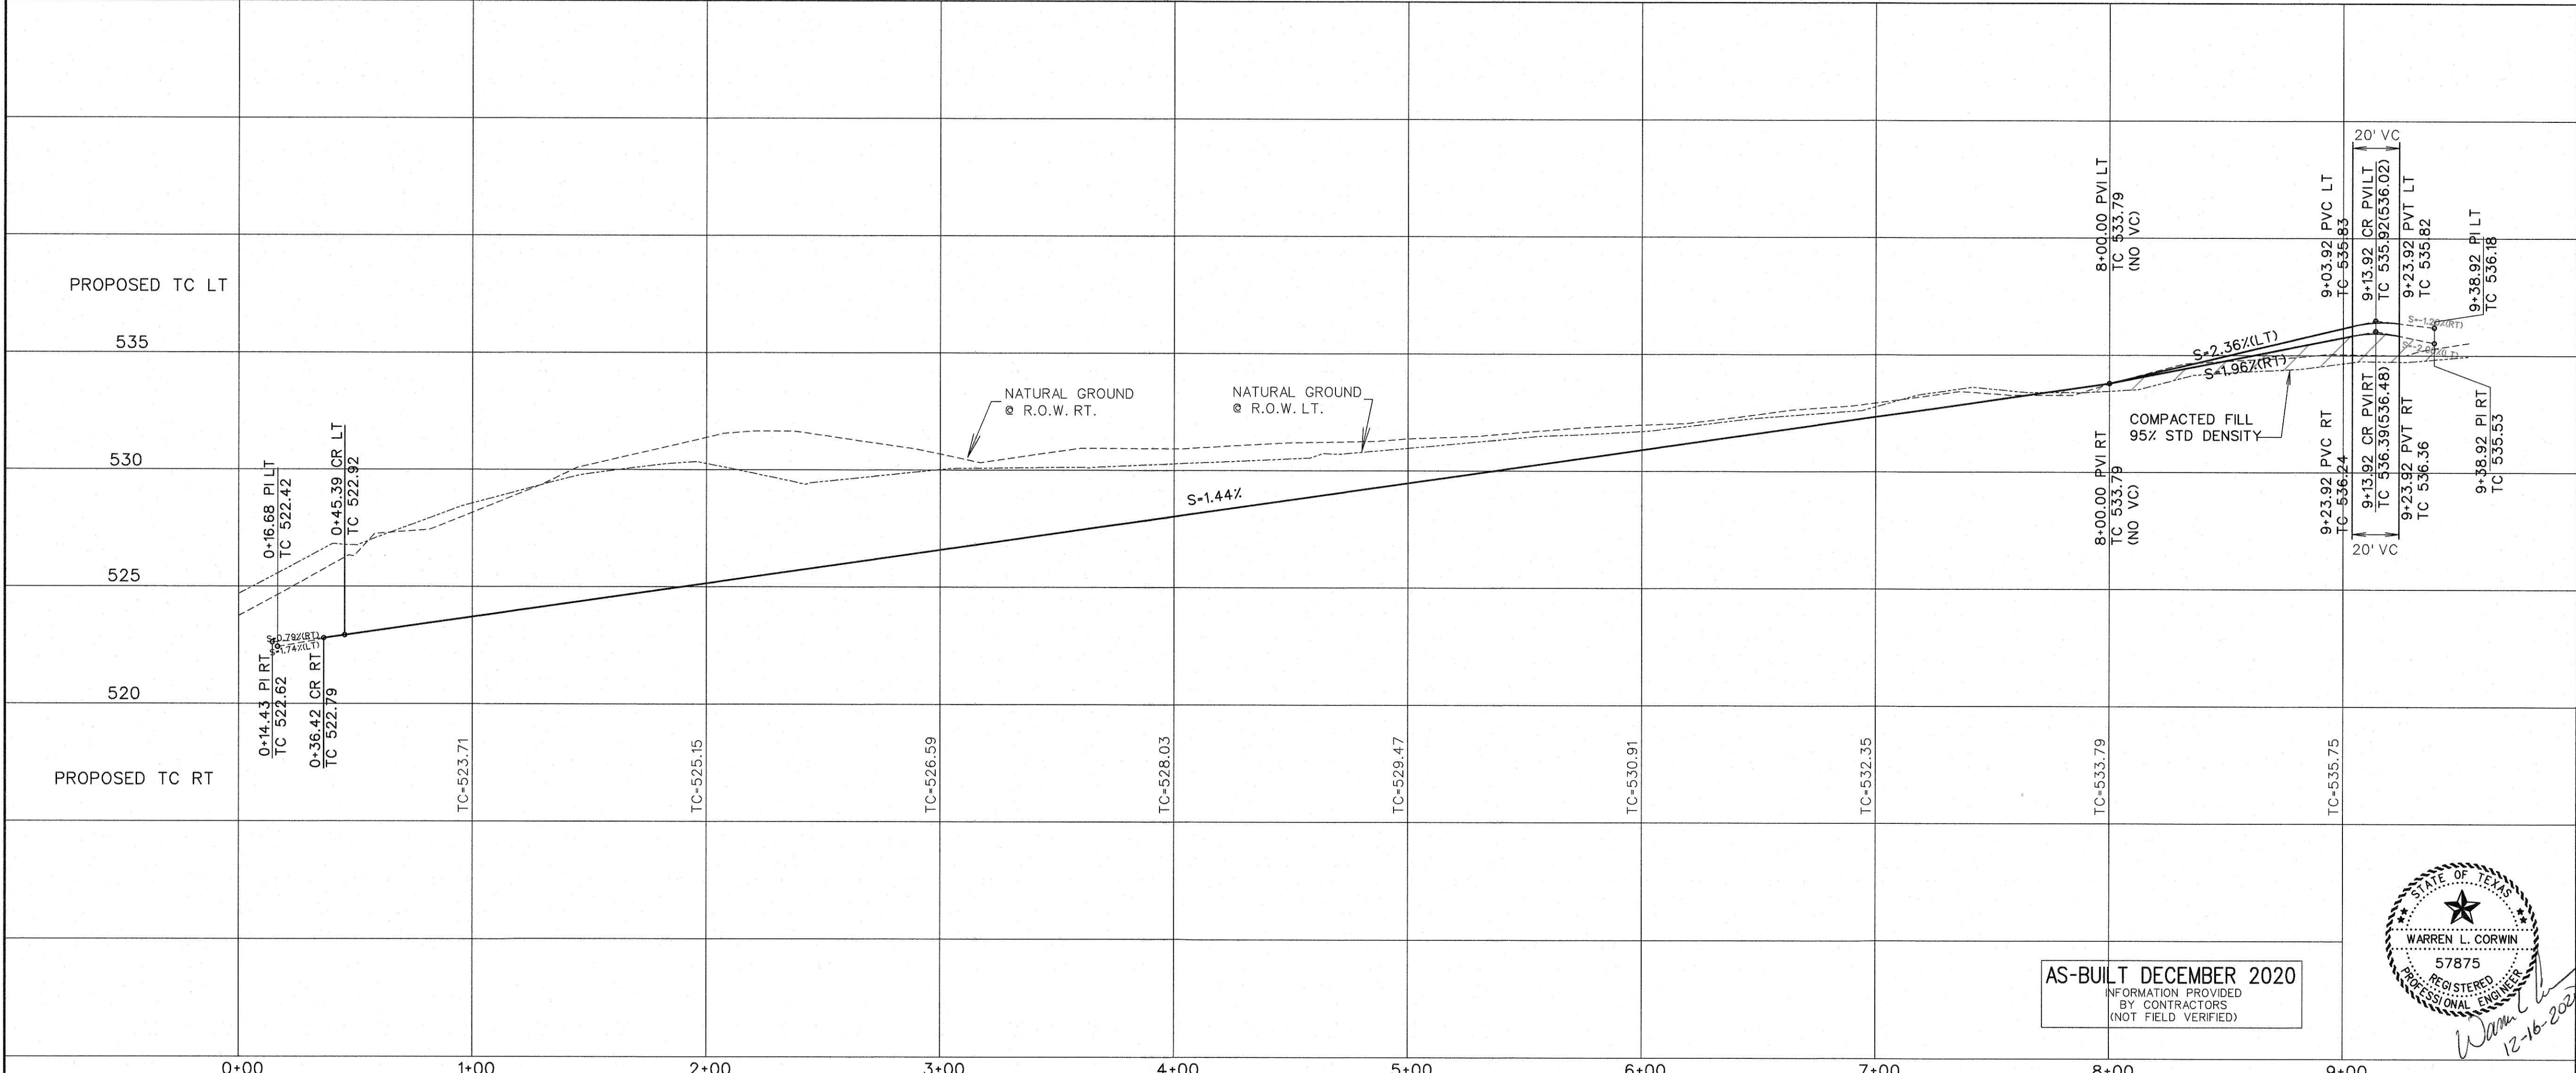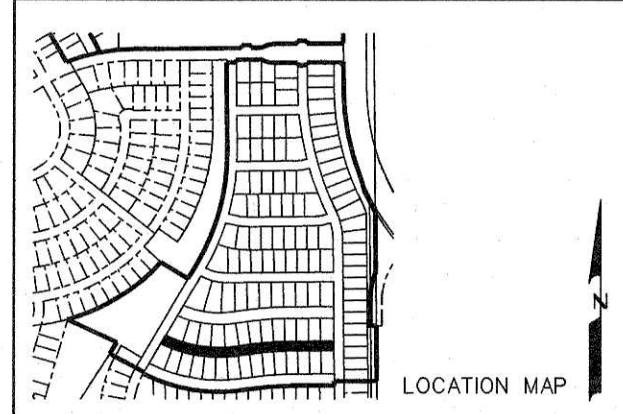


AS-BUILT DECEMBER 2020
INFORMATION PROVIDED
BY CONTRACTORS
(NOT FIELD VERIFIED)

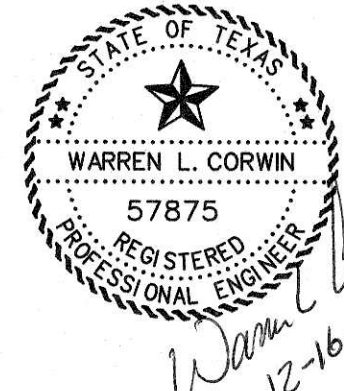



 CORWIN ENGINEERING, INC. 200 W. BELMONT, SUITE E ALLEN, TEXAS 75013 (972)396-1200 TBPE FIRM #5951			
DEVELOPMENT PLANS FOR STONE CREEK PHASE X ROCKWALL, TEXAS			
MELODY MEADOW DRIVE			
DRAWN BY	DESIGNED BY	CHECKED BY	SHEET NO.
JOB NUMBER 19012	DATE MAY 2019	SCALE: HOR: 1"=40' VER: 1"=4'	6

0
SCALE: 1" = 40'

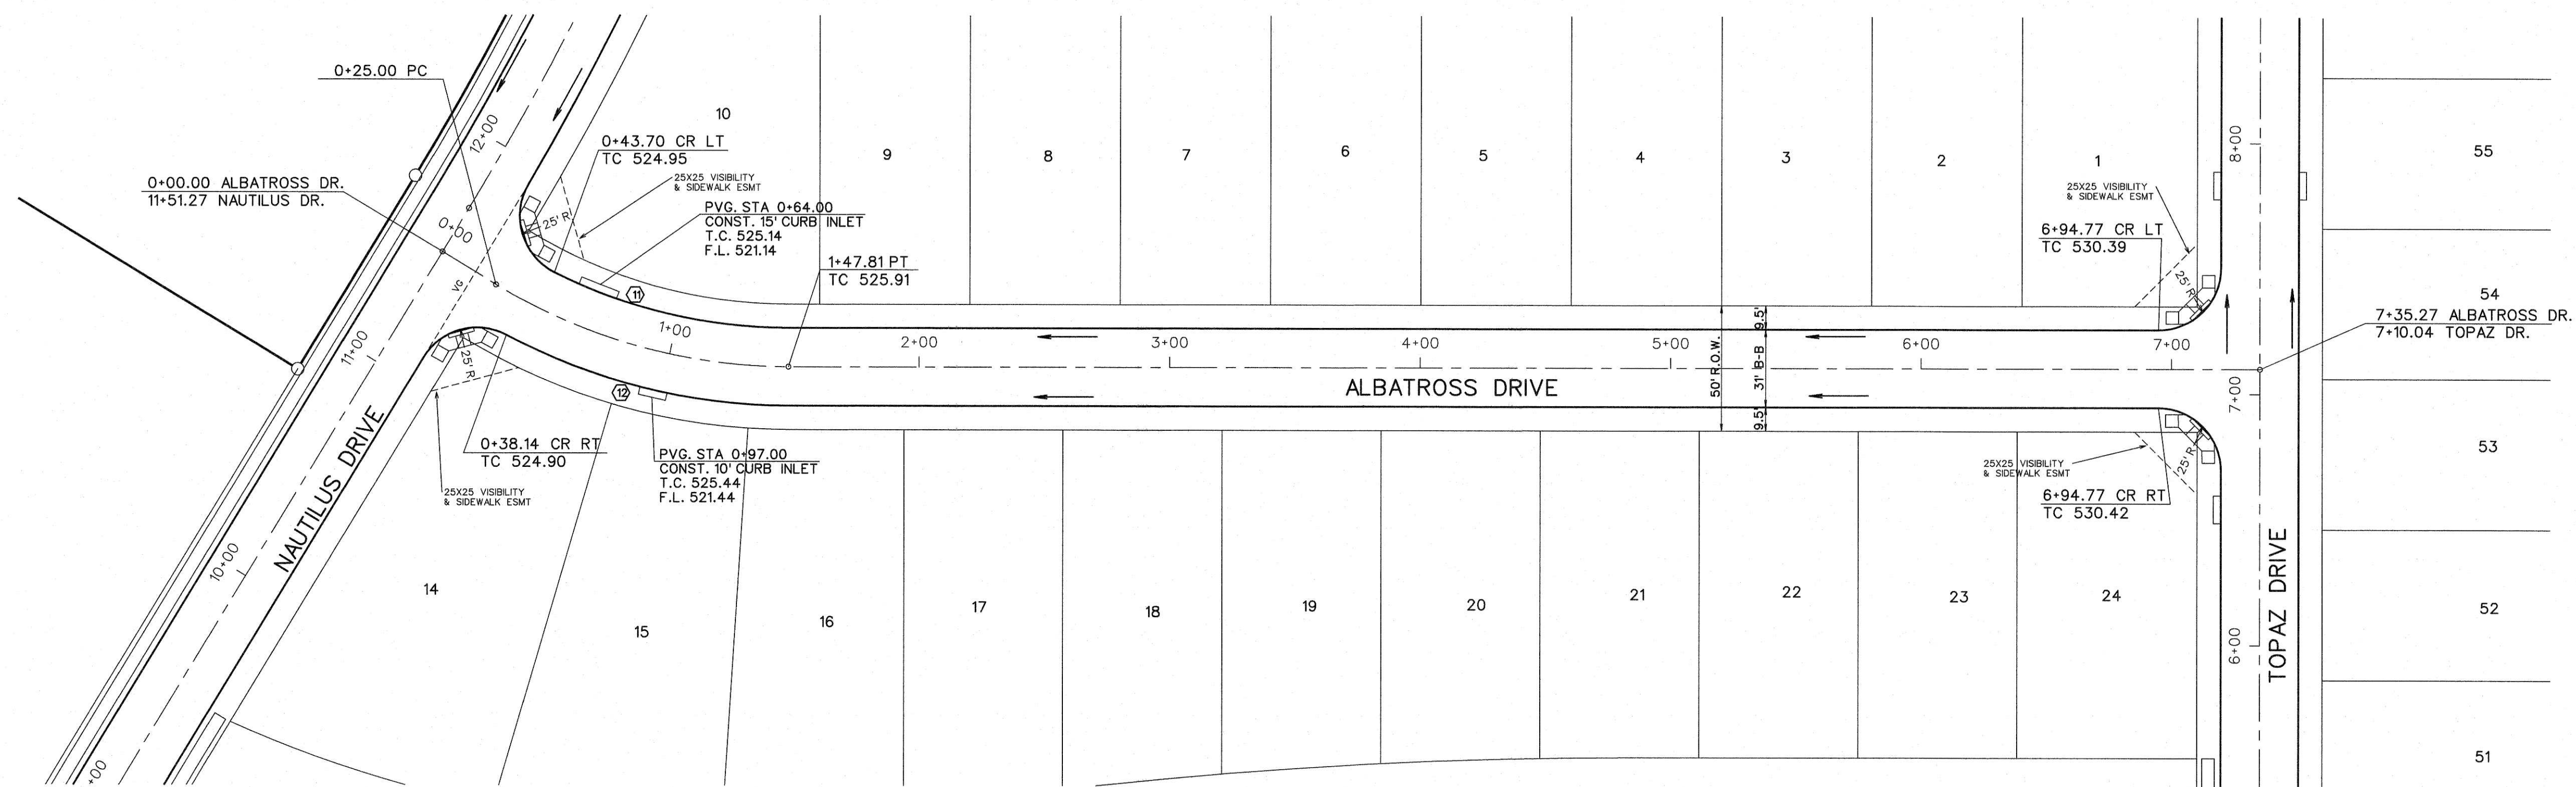


NOTE:
ALL RAMP TO BE INSTALLED PER
CITY OF ROCKWALL STANDARD
DETAILS.

BENCHMARK:
" X " Cut on top of curb on east side of John King Blvd.
approx. 48' north of the centerline of Pleasant View Dr.
ELEVATION = 505.61

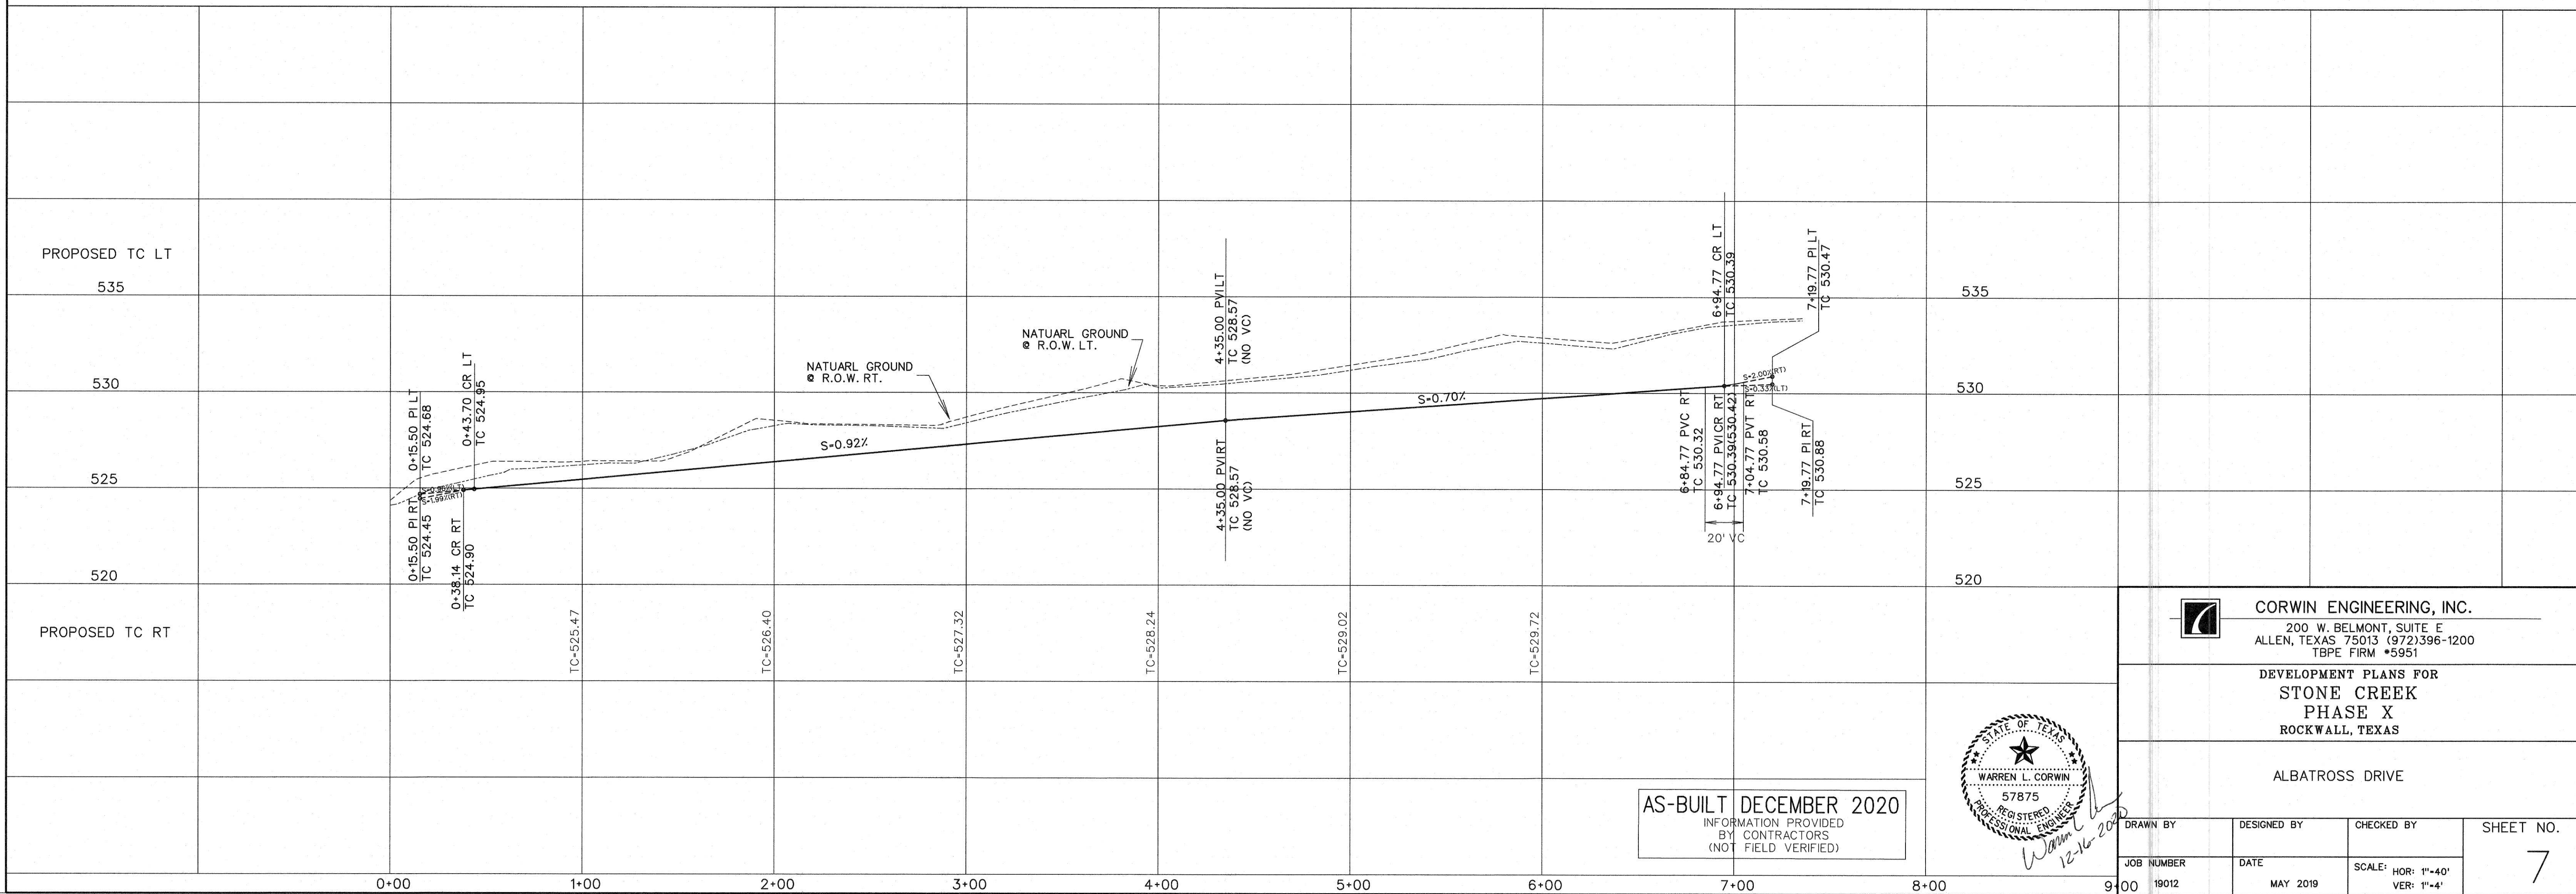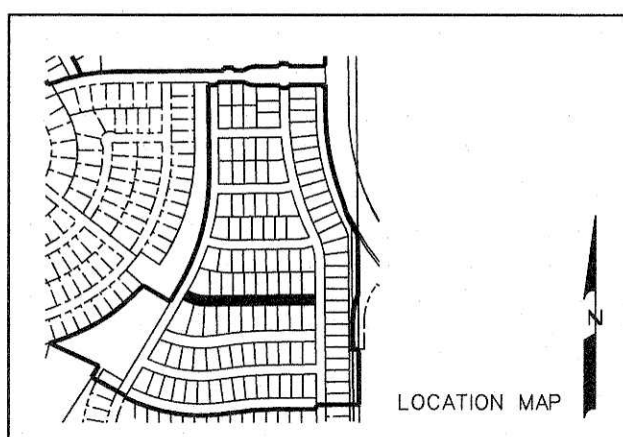

AS-BUILT DECEMBER 2020
INFORMATION PROVIDED
BY CONTRACTORS
(NOT FIELD VERIFIED)




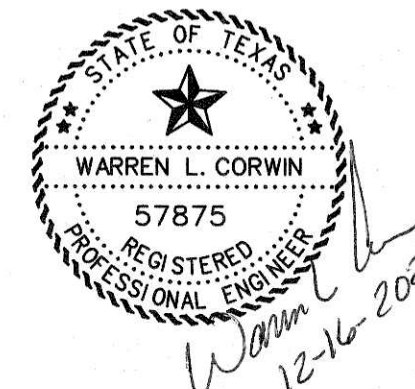


 **CORWIN ENGINEERING, INC.**
200 W. BELMONT, SUITE E
ALLEN, TEXAS 75013 (972)396-1200
TBP# FIRM #5951

DEVELOPMENT PLANS FOR
STONE CREEK
PHASE X
ROCKWALL, TEXAS


ALBATROSS DRIVE

DRAWN BY	DESIGNED BY	CHECKED BY	SHEET NO.
JOB NUMBER	DATE	SCALE: HOR: 1"=40' VER: 1"=4'	7

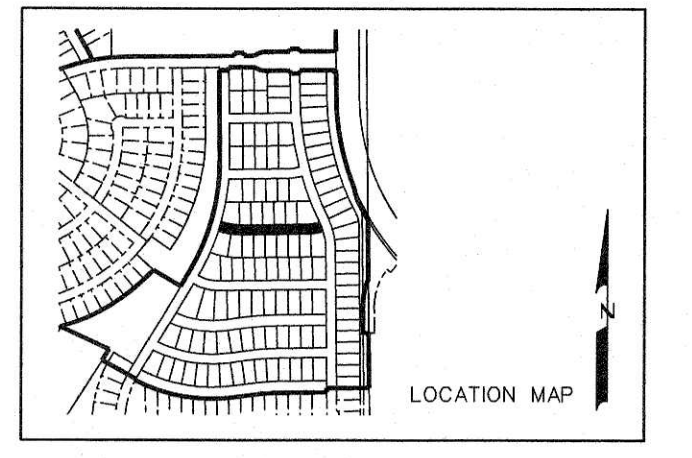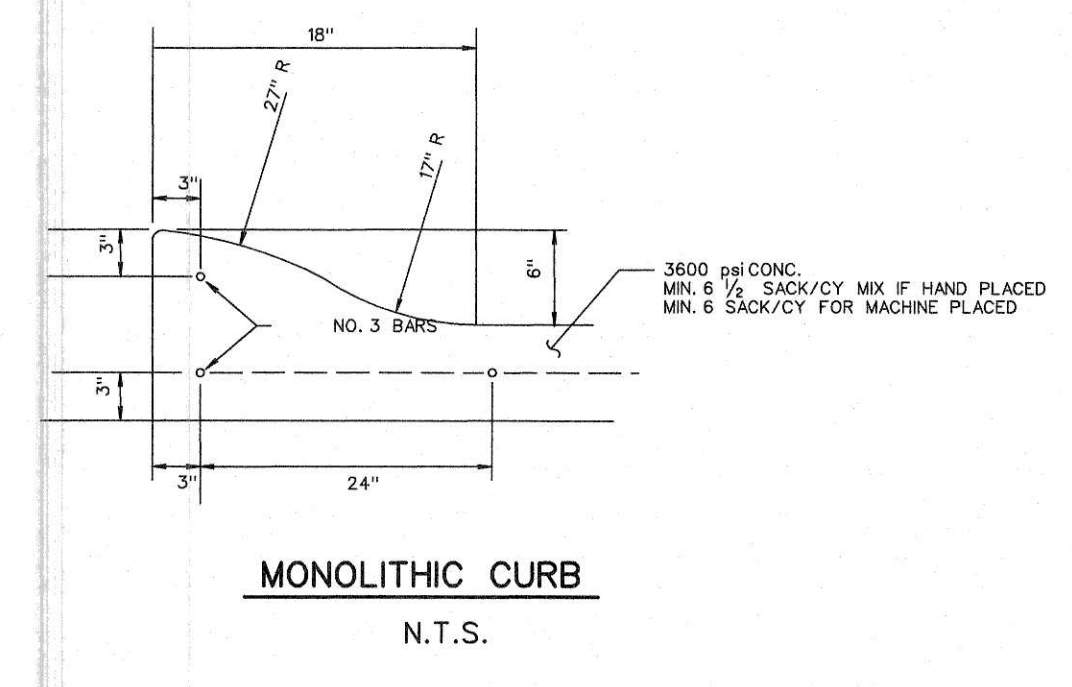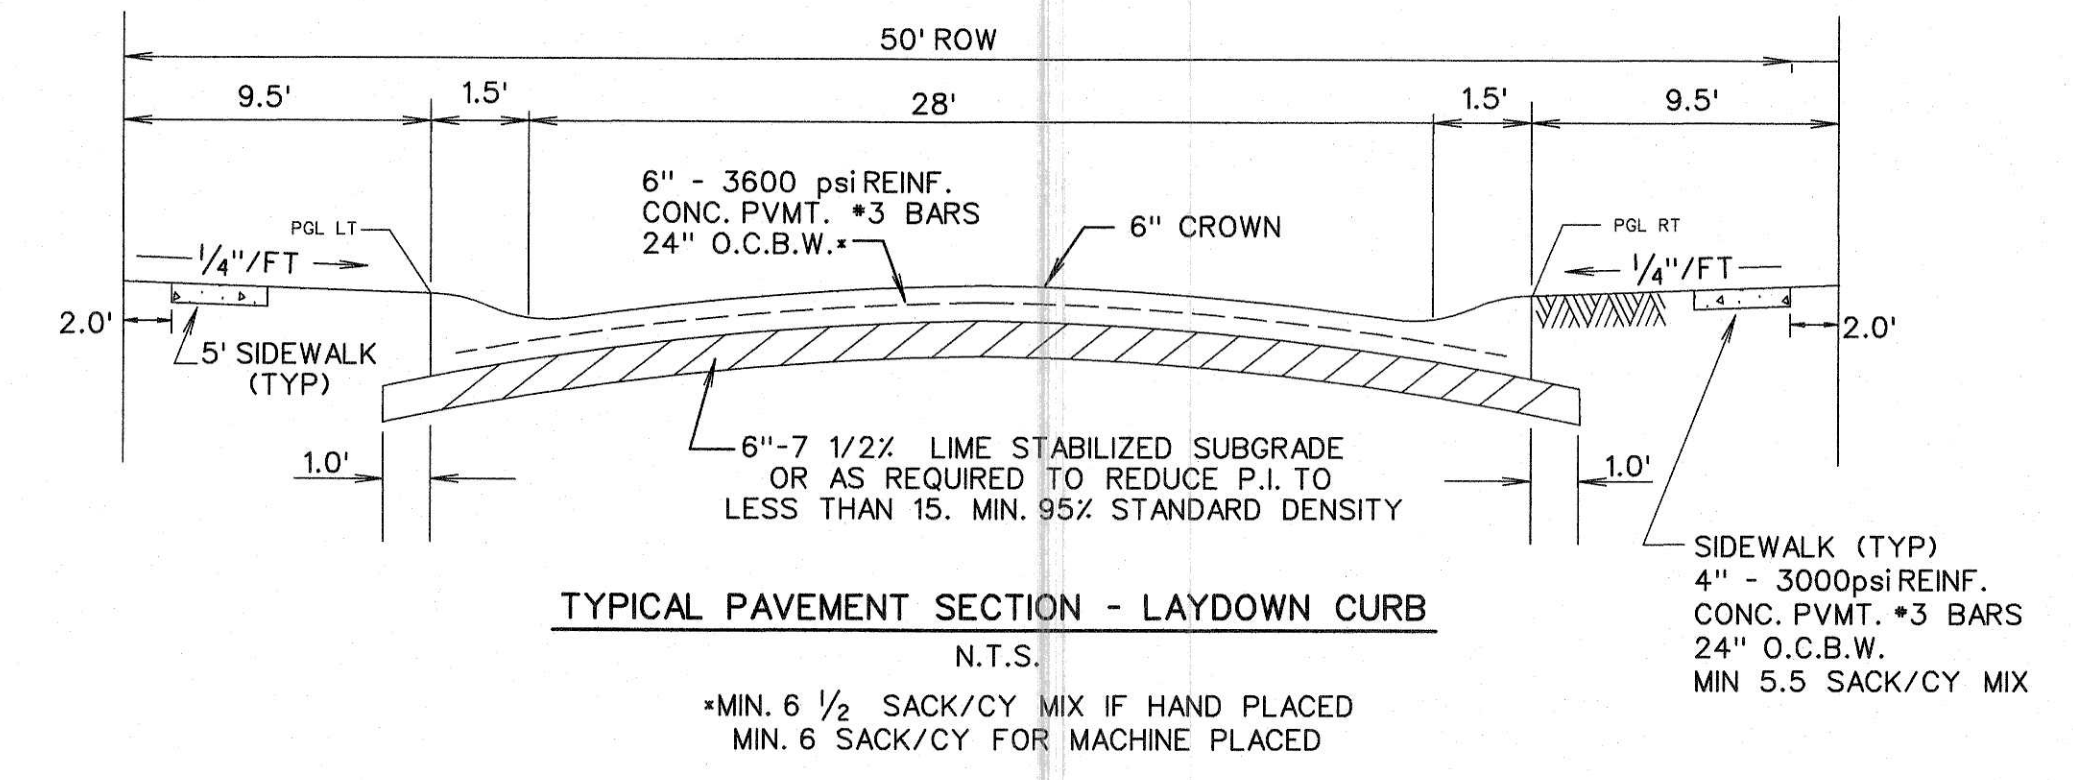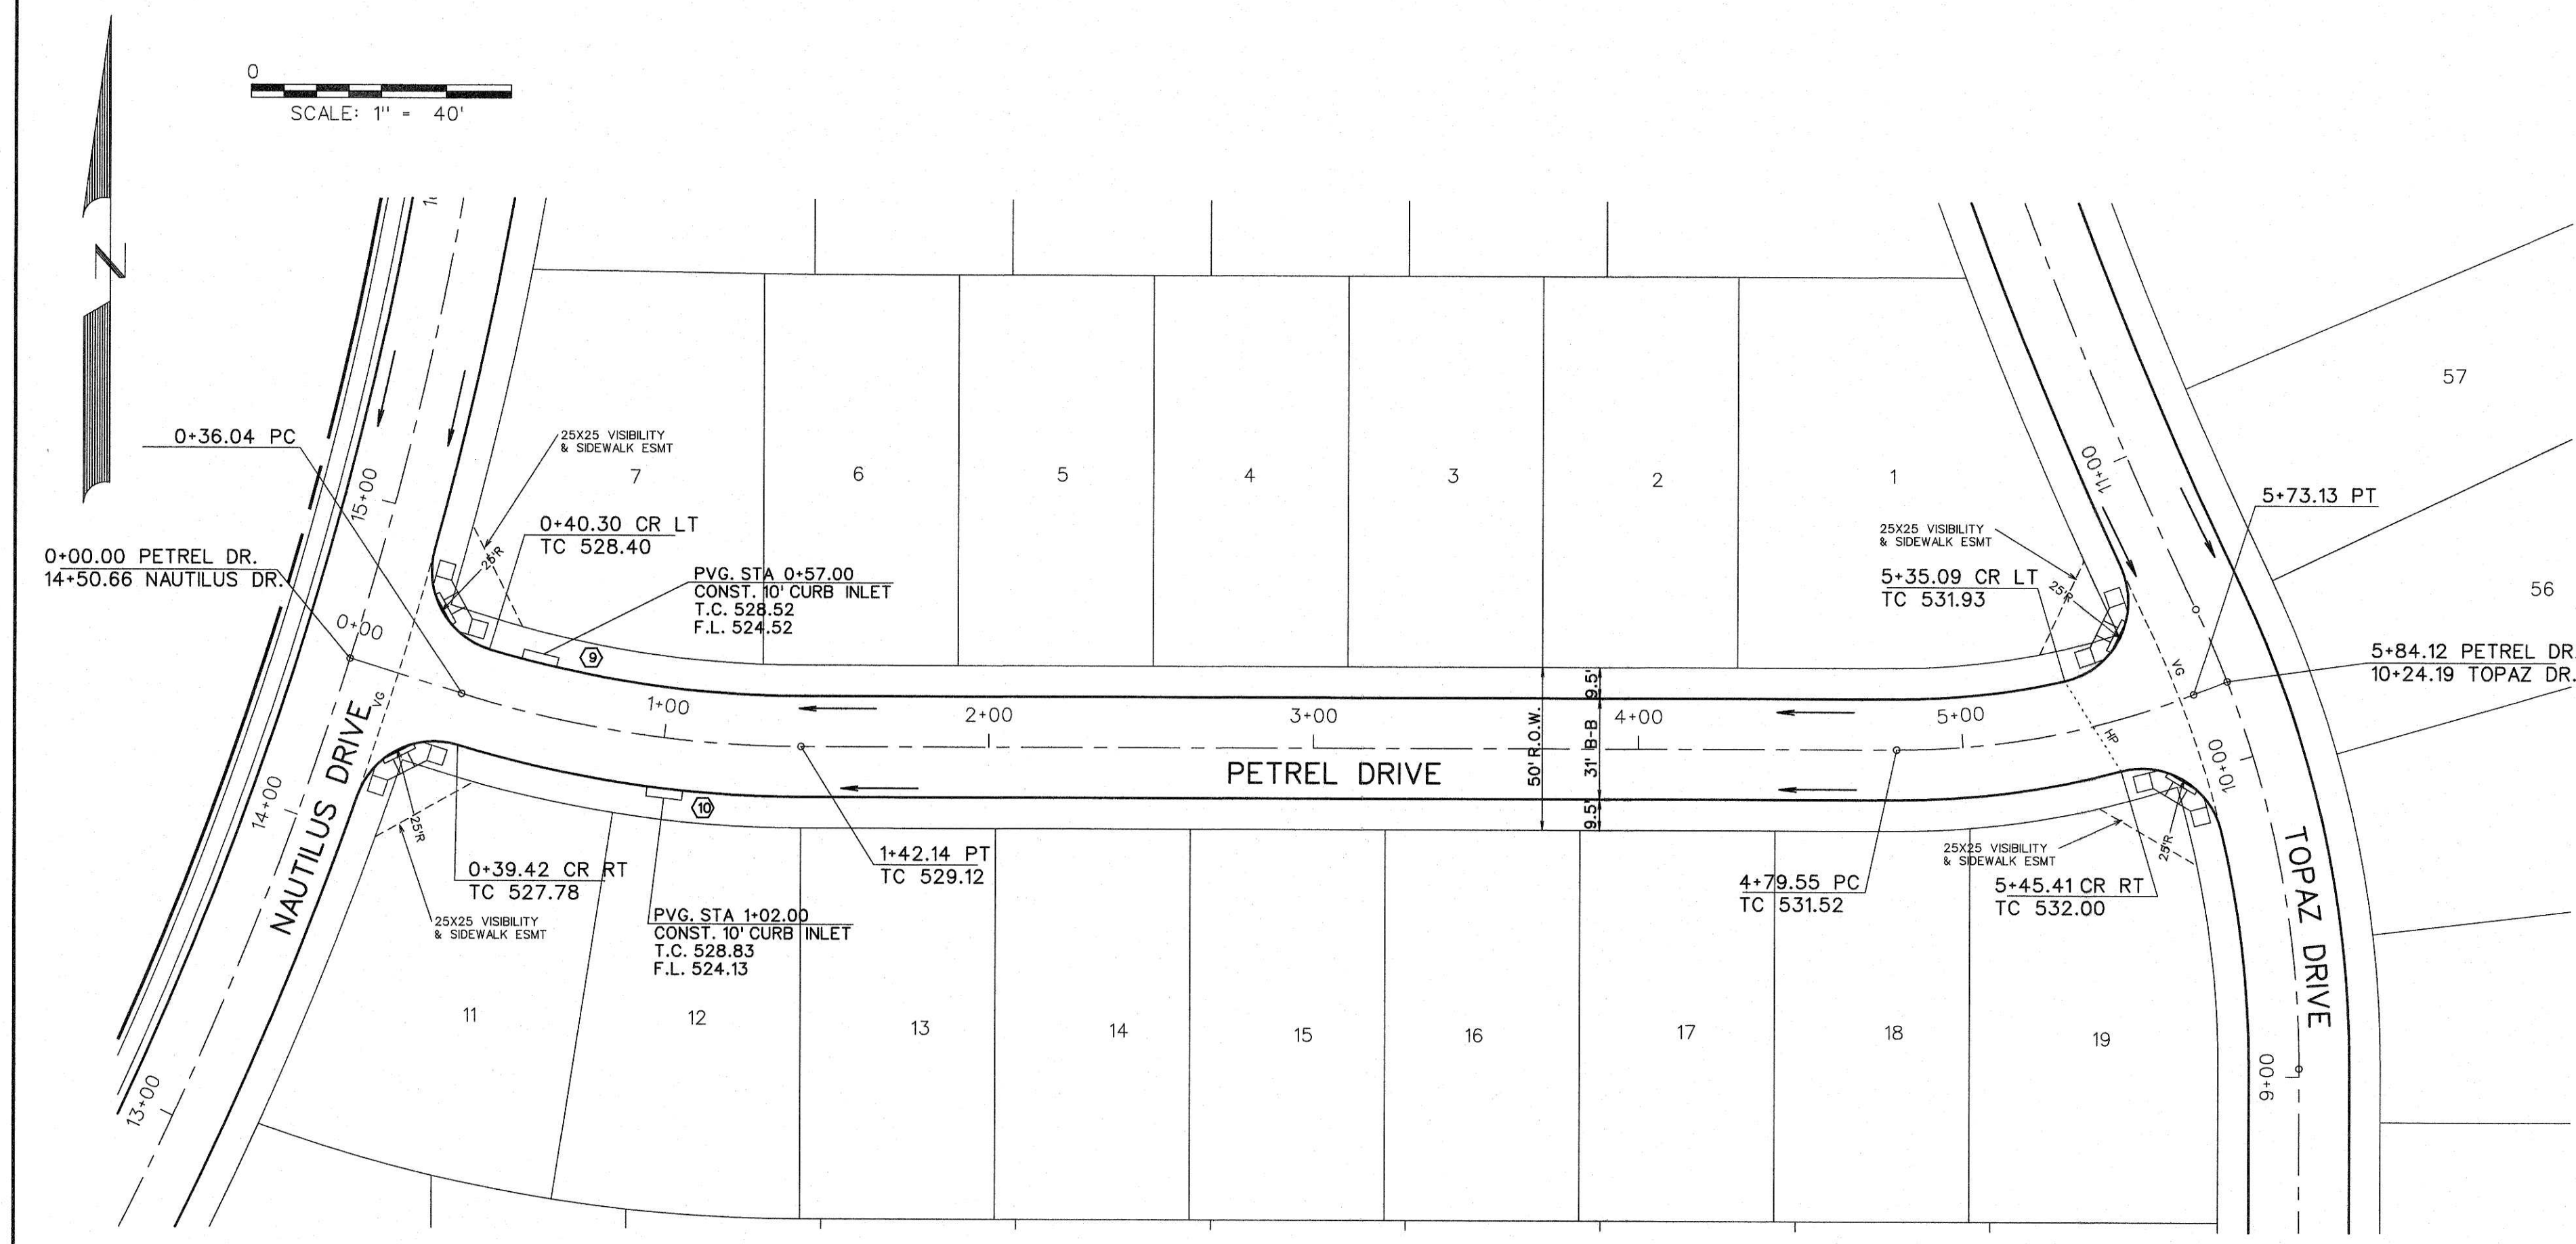


NOTE:
ALL RAMPS TO BE INSTALLED PER
CITY OF ROCKWALL STANDARD
DETAILS.




BENCHMARK:
" X " Cut on top of curb on east side of John King Blvd.
approx. 48' north of the centerline of Pleasant View Dr.
ELEVATION = 505.61

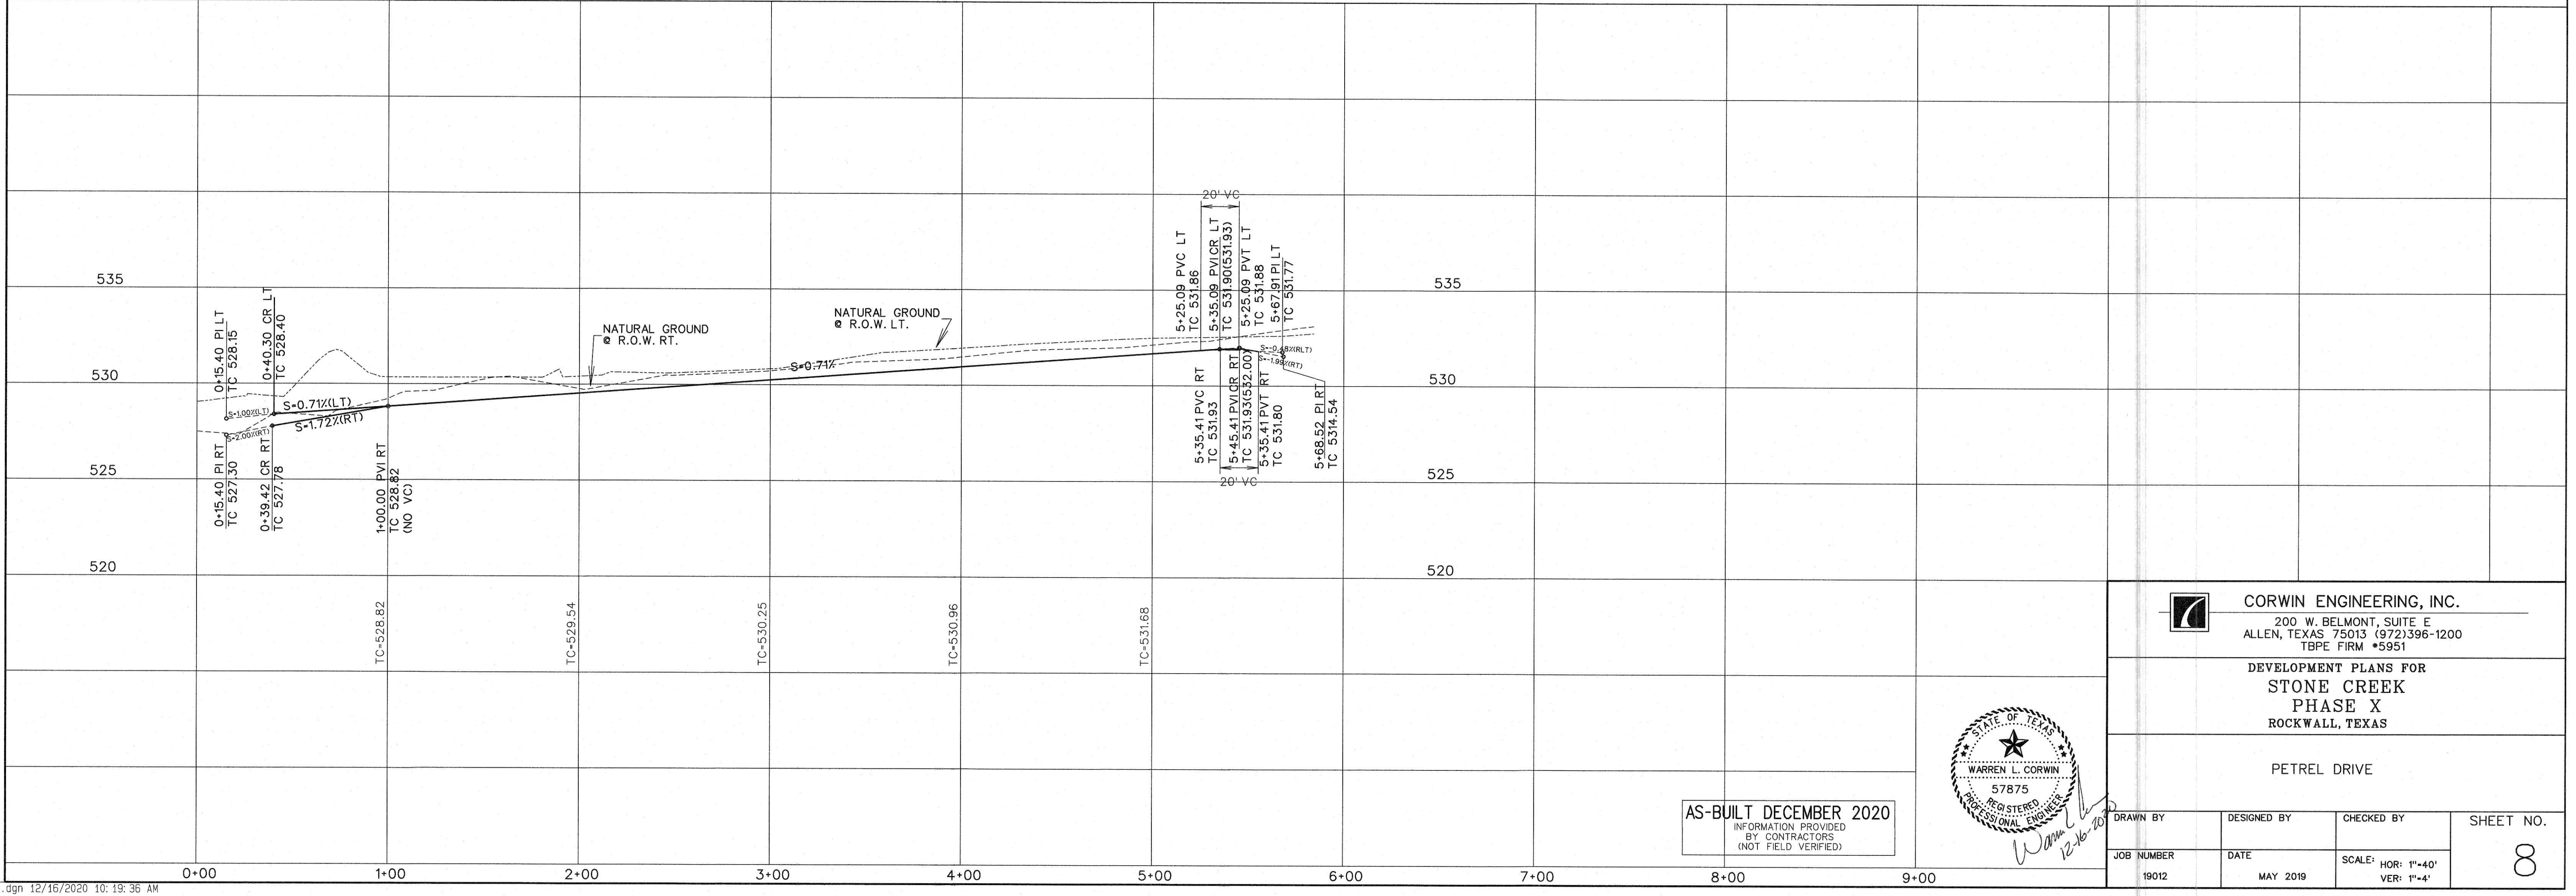



AS-BUILT DECEMBER 2020
INFORMATION PROVIDED
BY CONTRACTORS
(NOT FIELD VERIFIED)

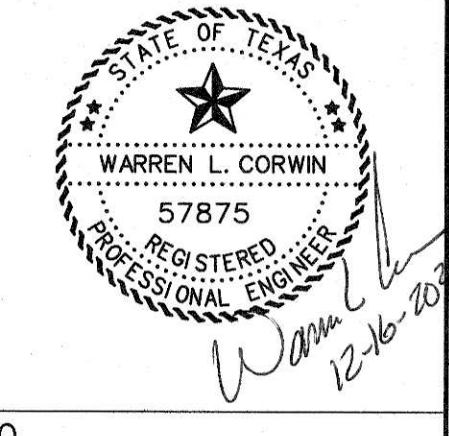


CORWIN ENGINEERING, INC. 200 W. BELMONT, SUITE E ALLEN, TEXAS 75013 (972)396-1200 TBPE FIRM #5951			
DEVELOPMENT PLANS FOR STONE CREEK PHASE X ROCKWALL, TEXAS			
PETREL DRIVE			
DRAWN BY	DESIGNED BY	CHECKED BY	SHEET NO. 8
JOB NUMBER 19012	DATE MAY 2019	SCALE: HOR: 1"=40' VER: 1"=4'	

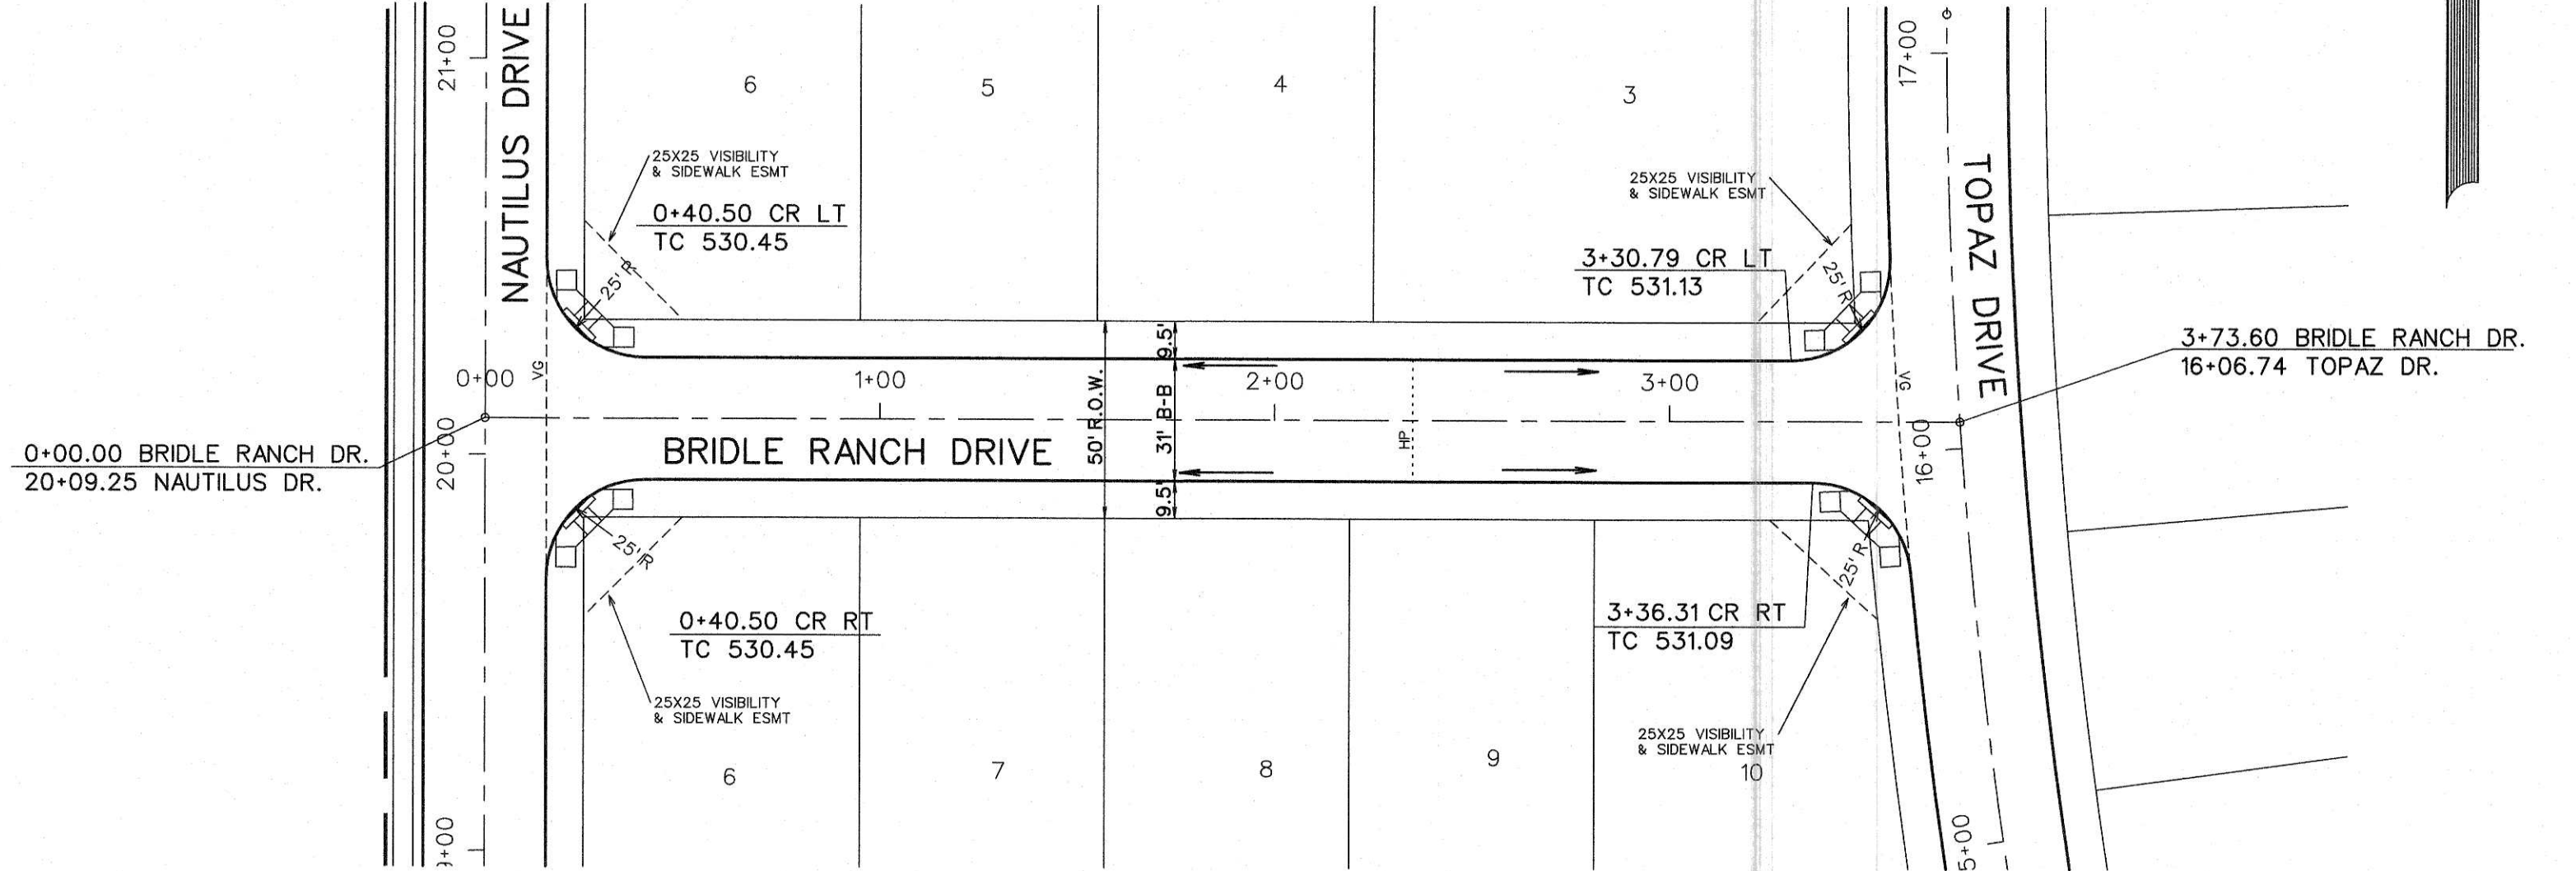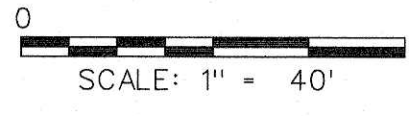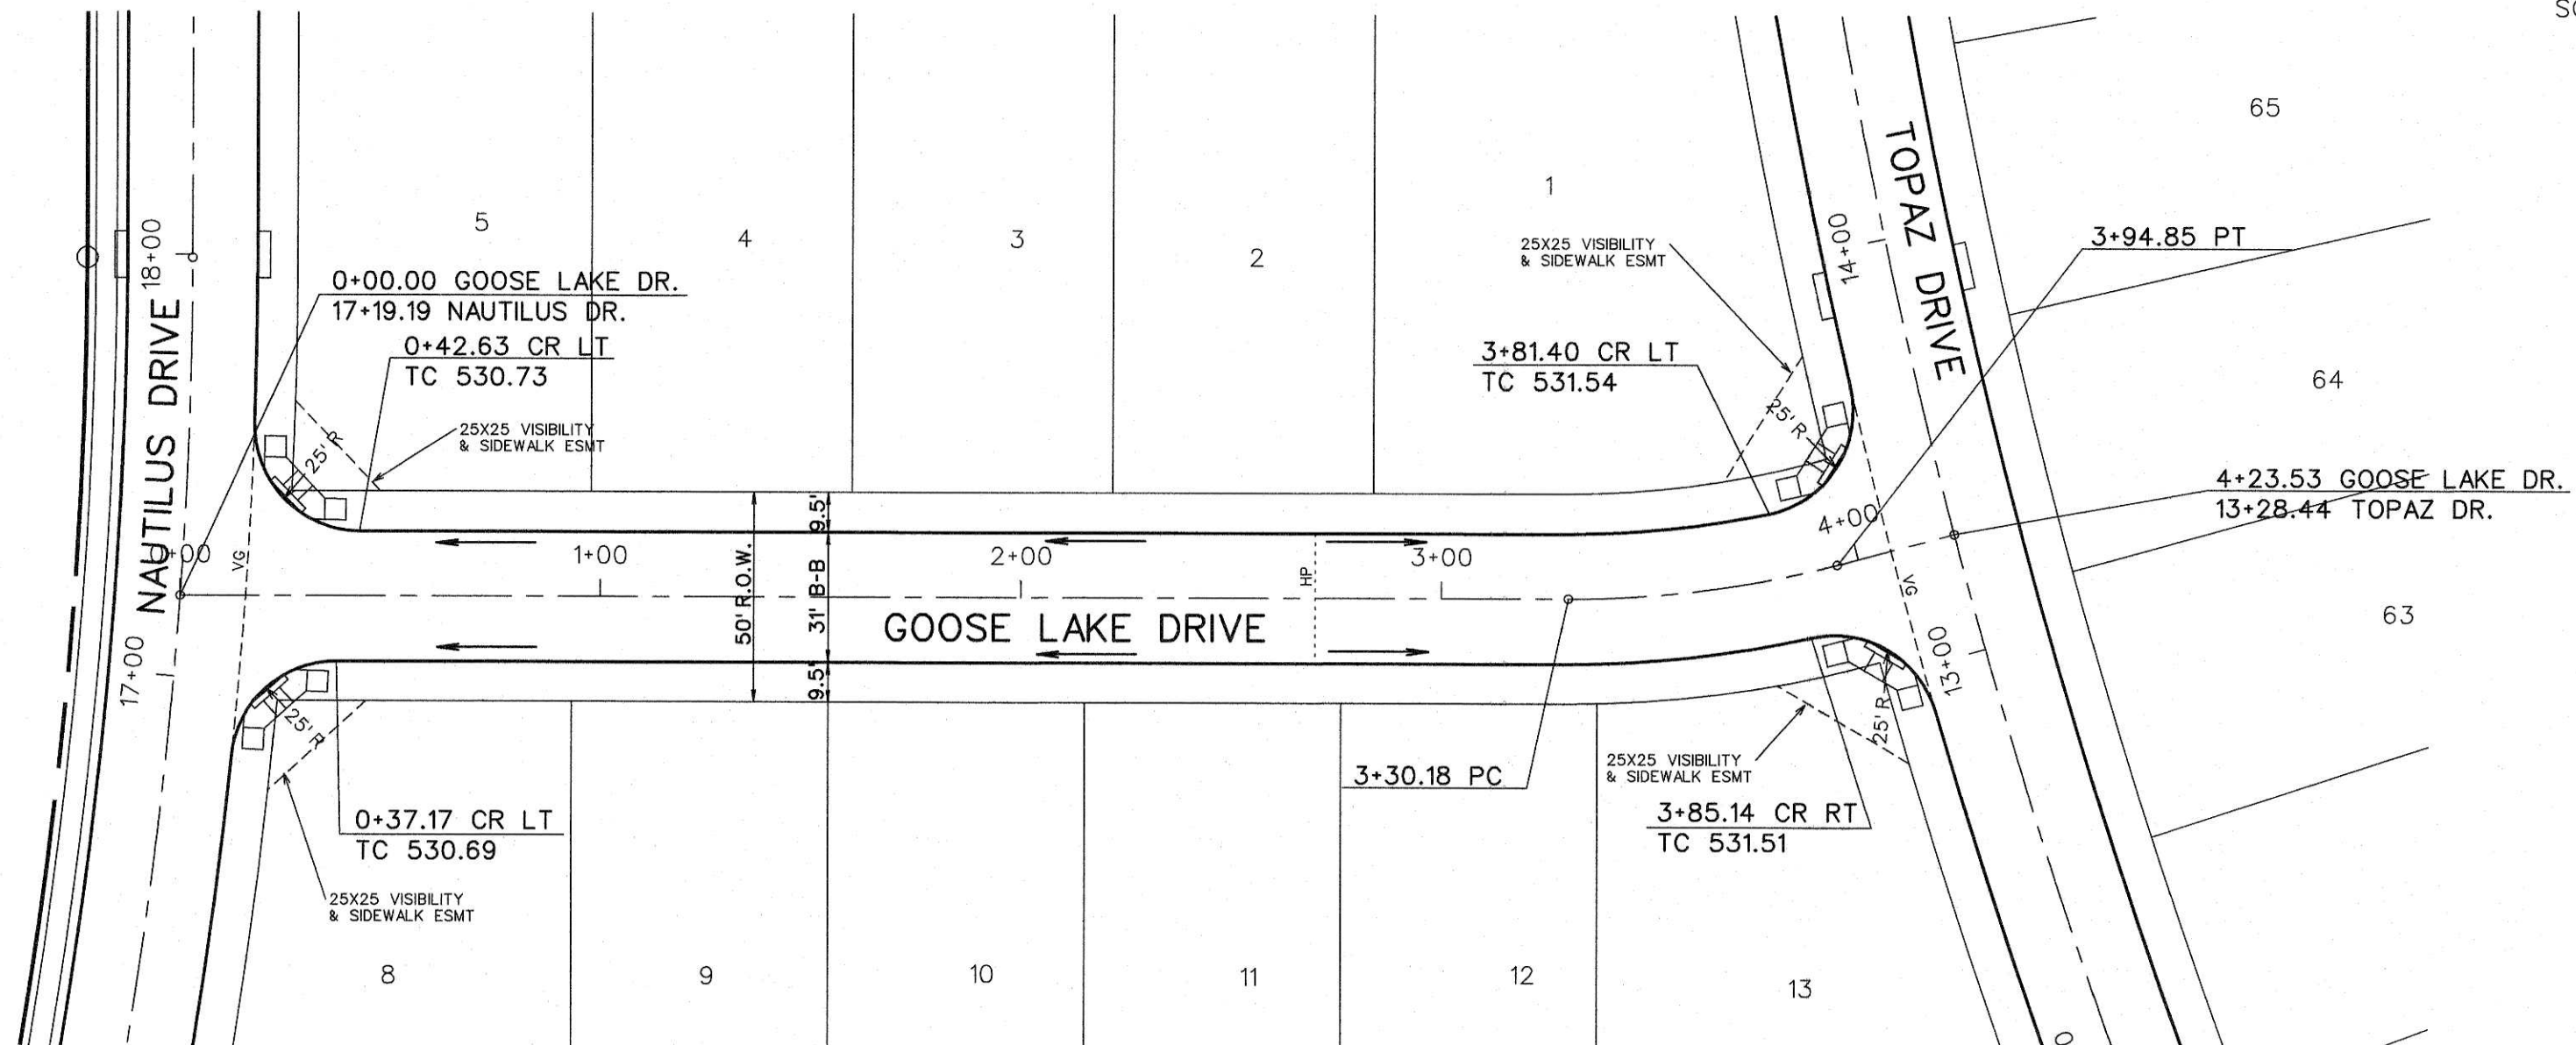


BENCHMARK:
"X" Cut on top of curb on east side of John King Blvd.
approx. 48' north of the centerline of Pleasant View Dr.
ELEVATION = 505.61

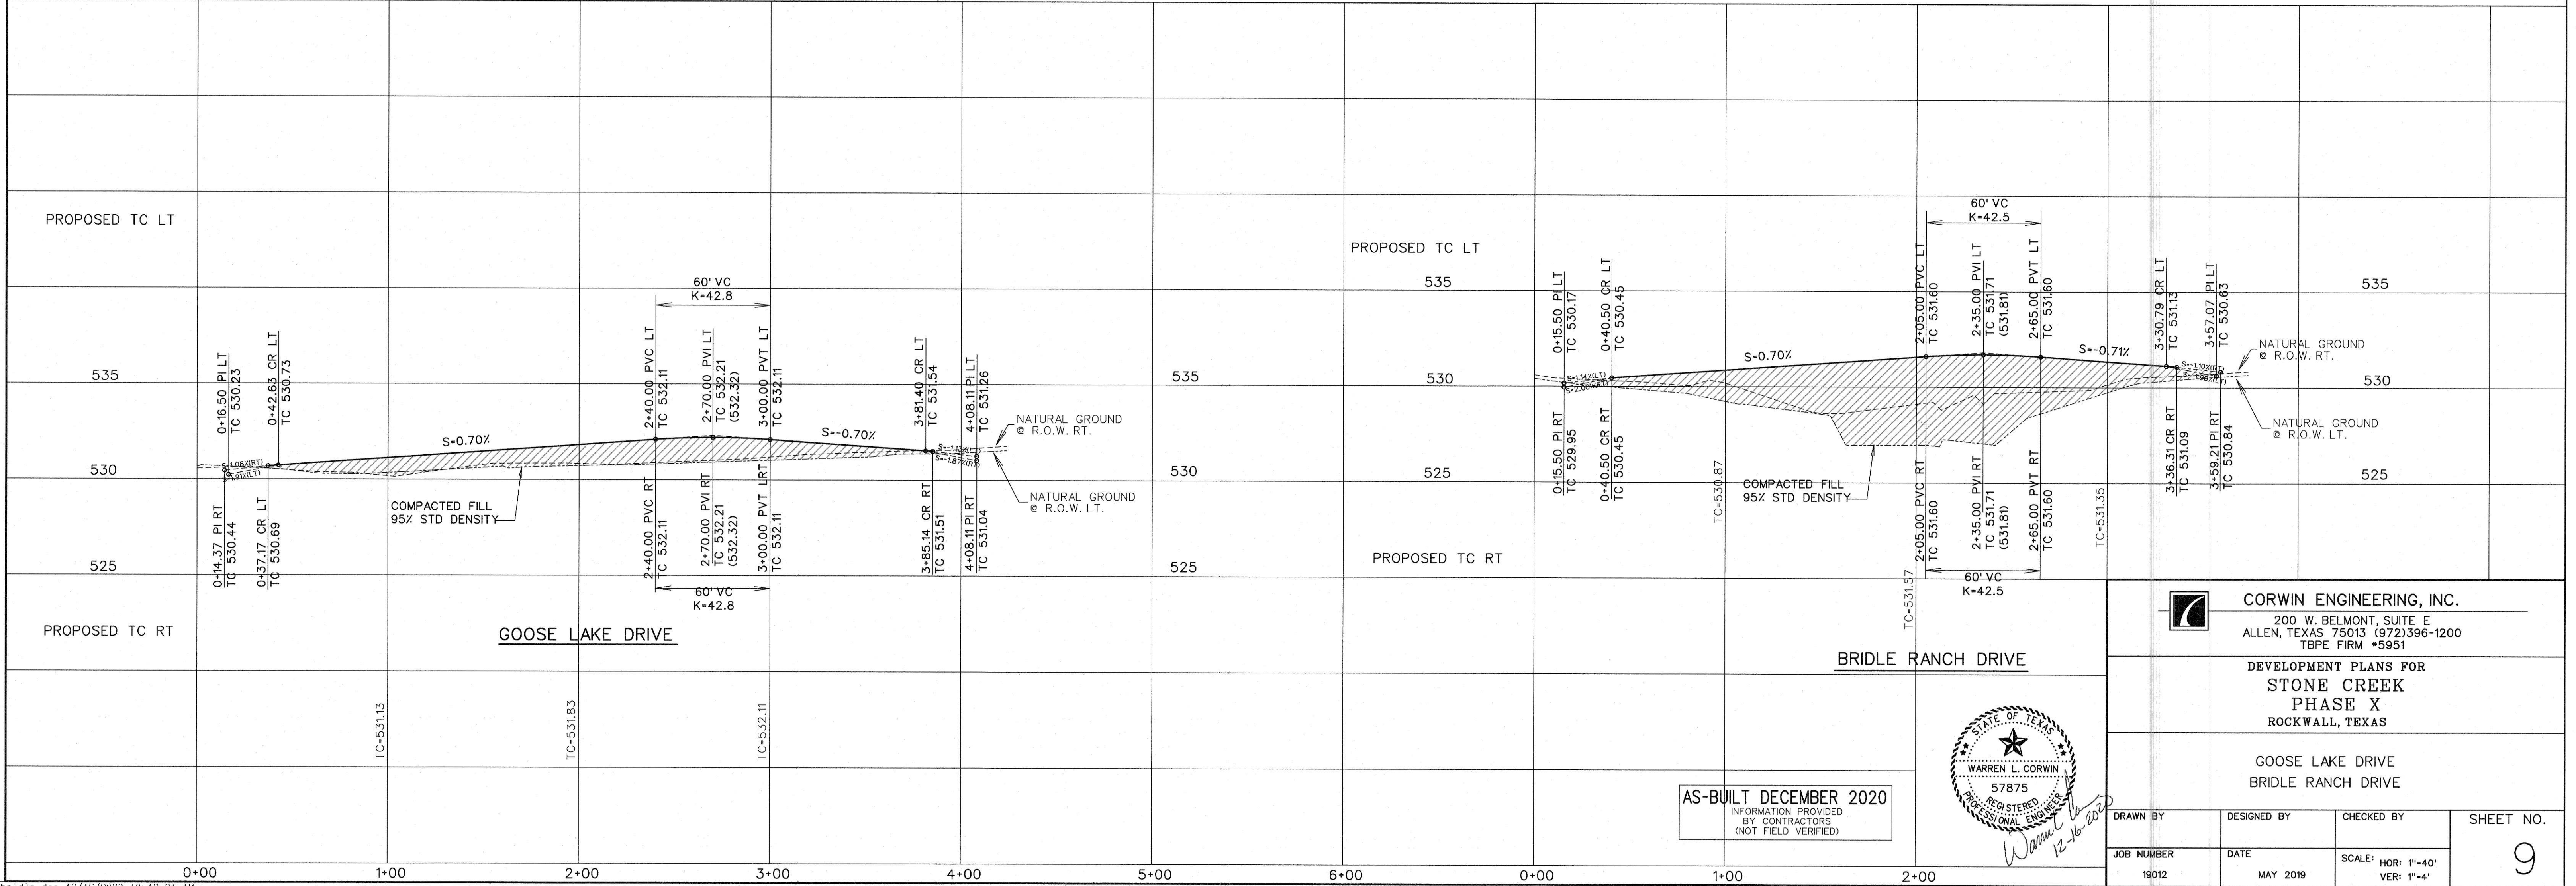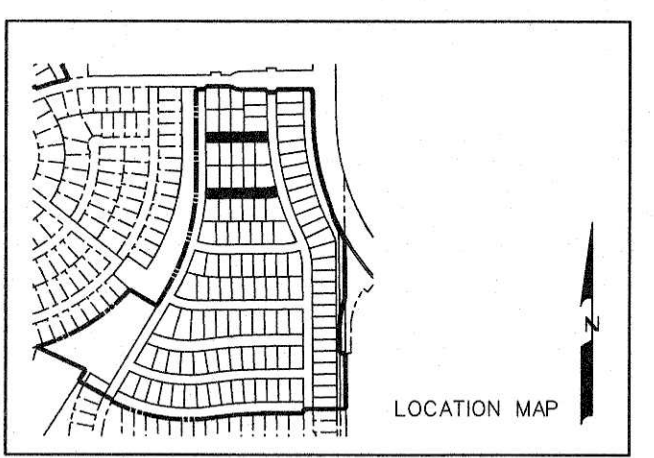


AS-BUILT DECEMBER 2020
INFORMATION PROVIDED
BY CONTRACTORS
(NOT FIELD VERIFIED)


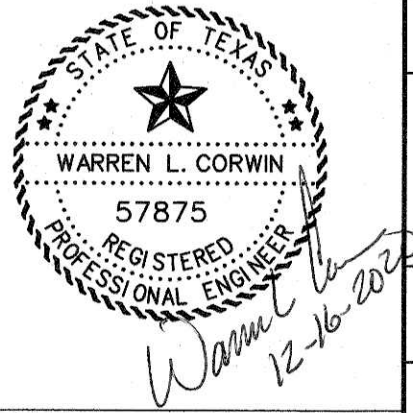


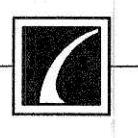 CORWIN ENGINEERING, INC. 200 W. BELMONT, SUITE E ALLEN, TEXAS 75013 (972)396-1200 TBP FIRM #5951			
DEVELOPMENT PLANS FOR STONE CREEK PHASE X ROCKWALL, TEXAS			
GOOSE LAKE DRIVE BRIDLE RANCH DRIVE			
DRAWN BY	DESIGNED BY	CHECKED BY	SHEET NO. 9
JOB NUMBER 19012	DATE MAY 2019	SCALE: HOR: 1"=40' VER: 1"=4'	


BENCHMARK:
" X " Cut on top of curb on east side of John King Blvd.
approx. 48' north of the centerline of Pleasant View Dr.
ELEVATION = 505.61

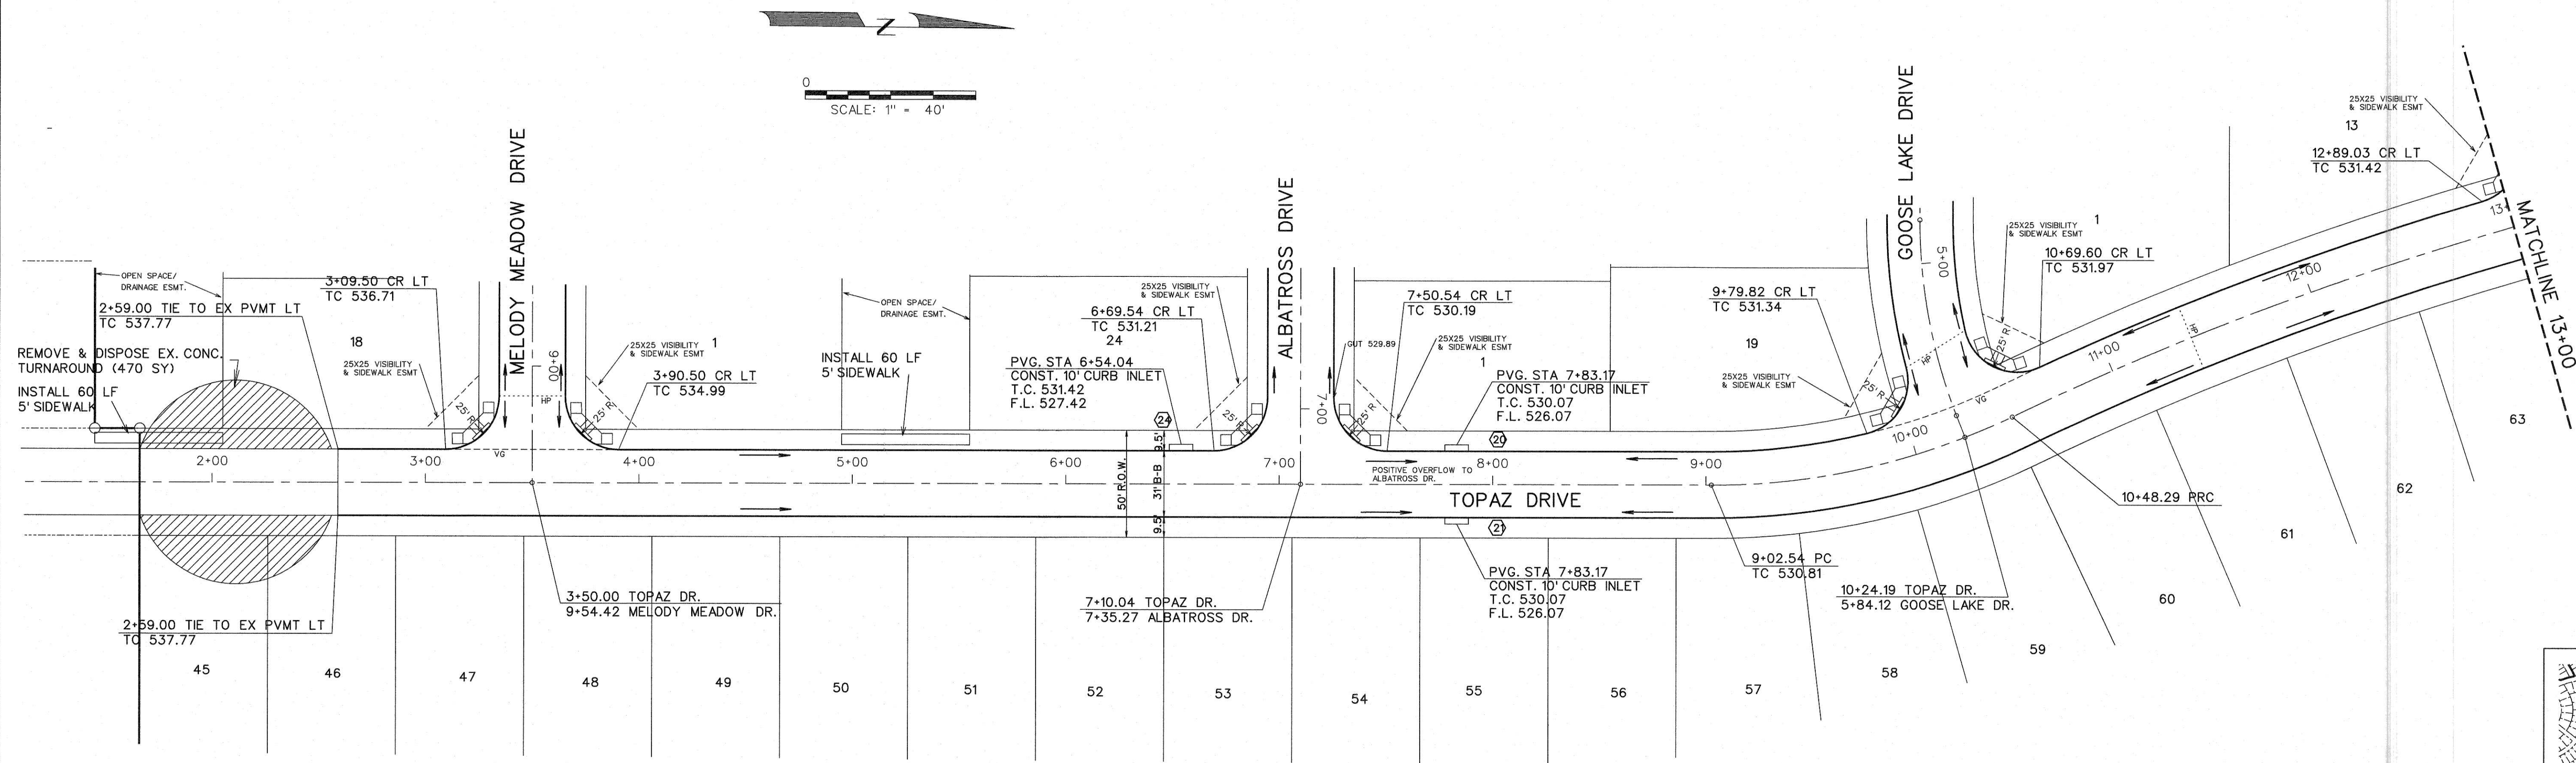

NOTE:
ALL RAMPS TO BE INSTALLED PER
CITY OF ROCKWALL STANDARD
DETAILS.

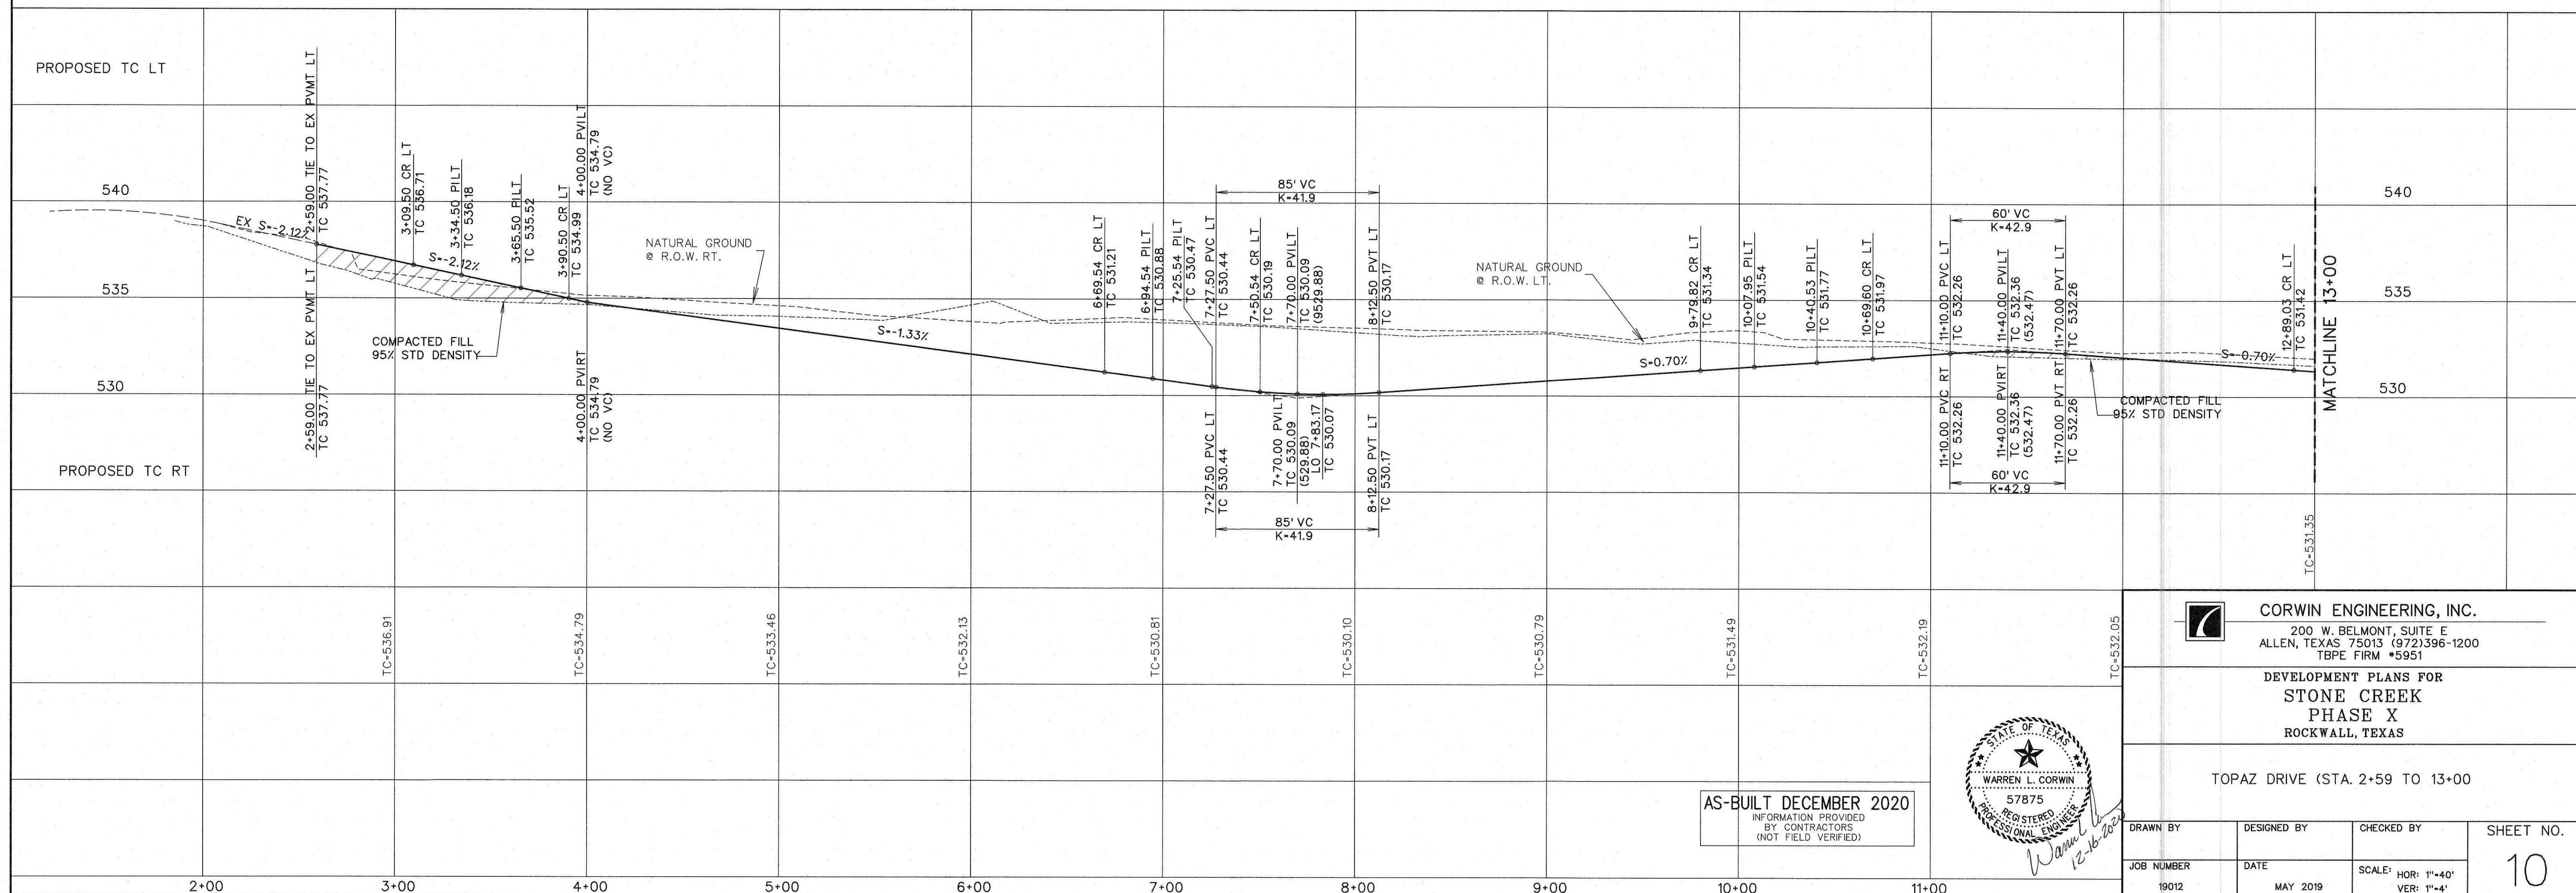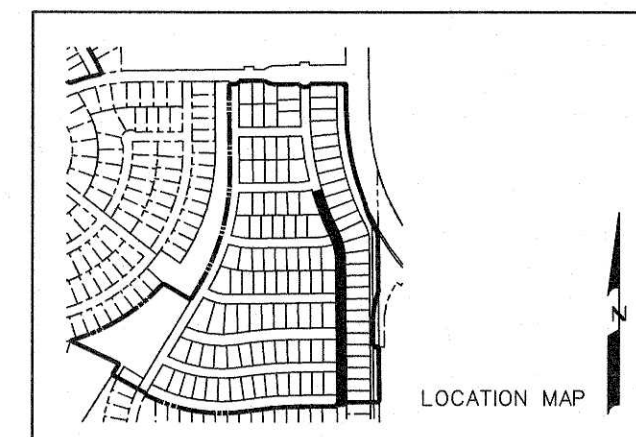

AS-BUILT DECEMBER 2020
INFORMATION PROVIDED
BY CONTRACTORS
(NOT FIELD VERIFIED)


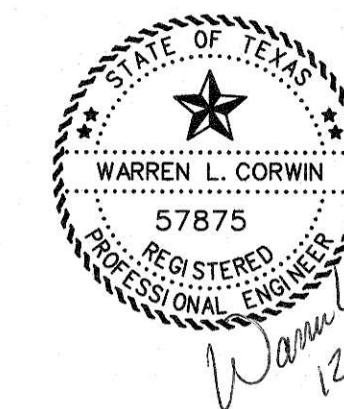


CORWIN ENGINEERING, INC.
200 W. BELMONT, SUITE E
ALLEN, TEXAS 75013 (972)396-1200
TBPE FIRM #5951

DEVELOPMENT PLANS FOR
STONE CREEK
PHASE X
ROCKWALL, TEXAS



TOPAZ DRIVE (STA. 2+59 TO 13+00)

DRAWN BY	DESIGNED BY	CHECKED BY	SHEET NO.
JOB NUMBER	DATE	SCALE: HOR: 1"=40' VER: 1"=4'	10
19012	MAY 2019		

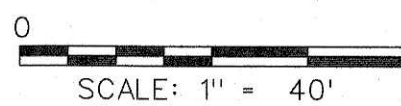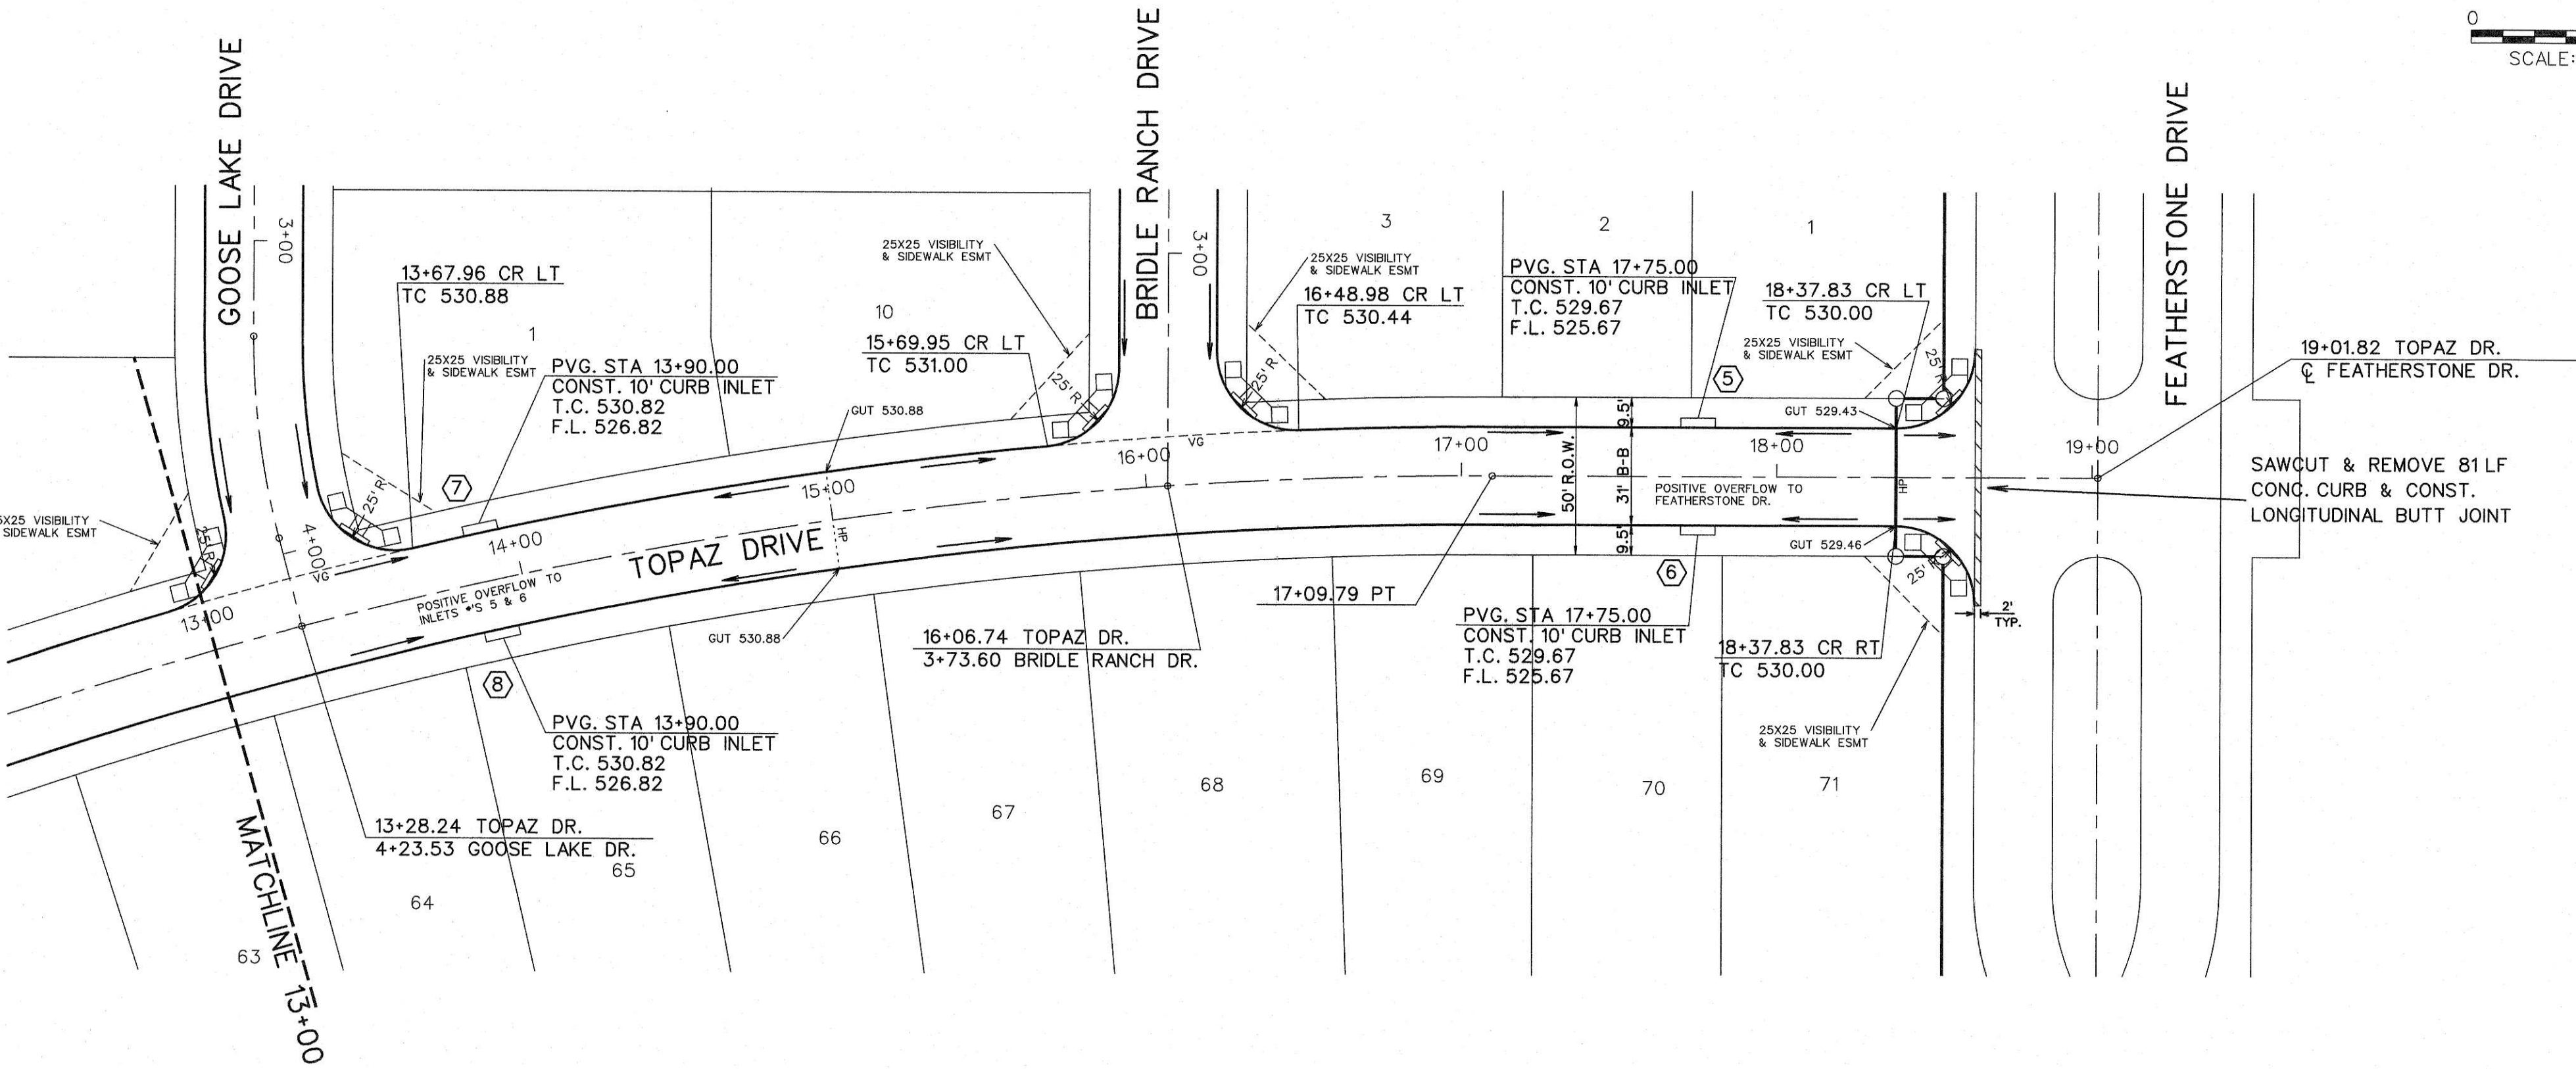

NOTE:
ALL RAMPS TO BE INSTALLED PER
CITY OF ROCKWALL STANDARD
DETAILS.



BENCHMARK:
" X " Cut on top of curb on east side of John King Blvd.
approx. 48' north of the centerline of Pleasant View Dr.
ELEVATION = 505.61

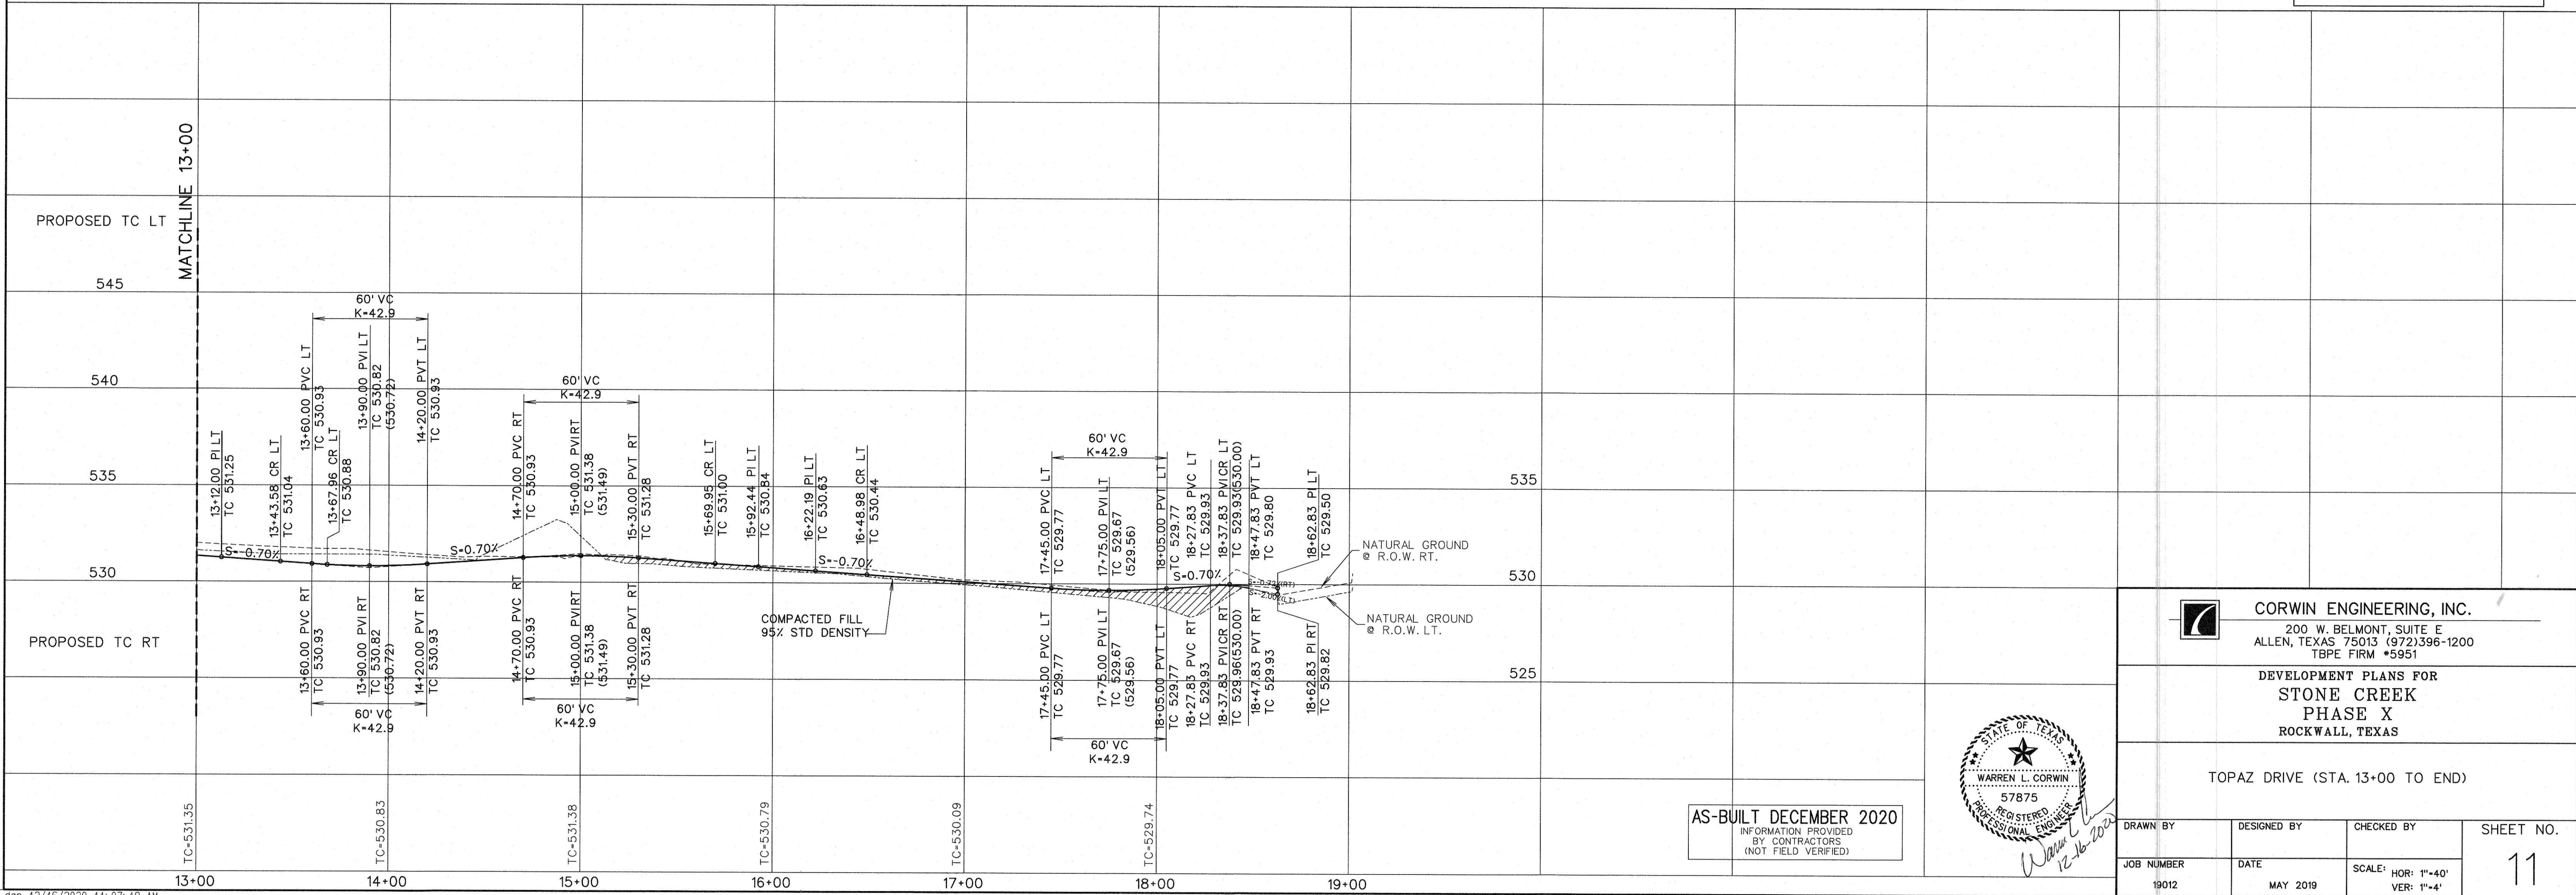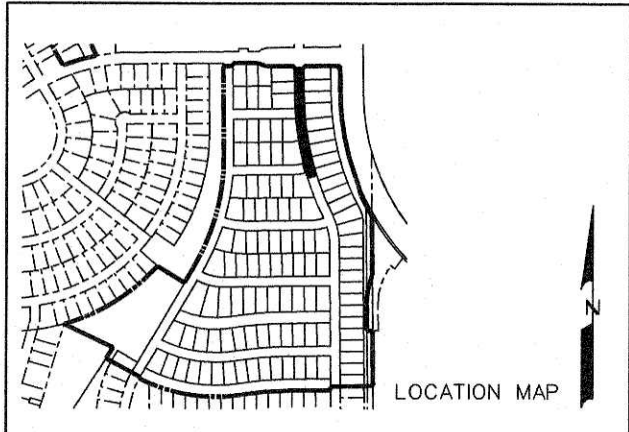

AS-BUILT DECEMBER 2020
INFORMATION PROVIDED
BY CONTRACTORS
(NOT FIELD VERIFIED)






 CORWIN ENGINEERING, INC. 200 W. BELMONT, SUITE E ALLEN, TEXAS 75013 (972)396-1200 TBPE FIRM #5951			
DEVELOPMENT PLANS FOR STONE CREEK PHASE X ROCKWALL, TEXAS			
TOPAZ DRIVE (STA. 13+00 TO END)			
DRAWN BY	DESIGNED BY	CHECKED BY	SHEET NO.
JOB NUMBER	DATE	SCALE: HOR: 1"=40' VER: 1"=4'	11
19012	MAY 2019		

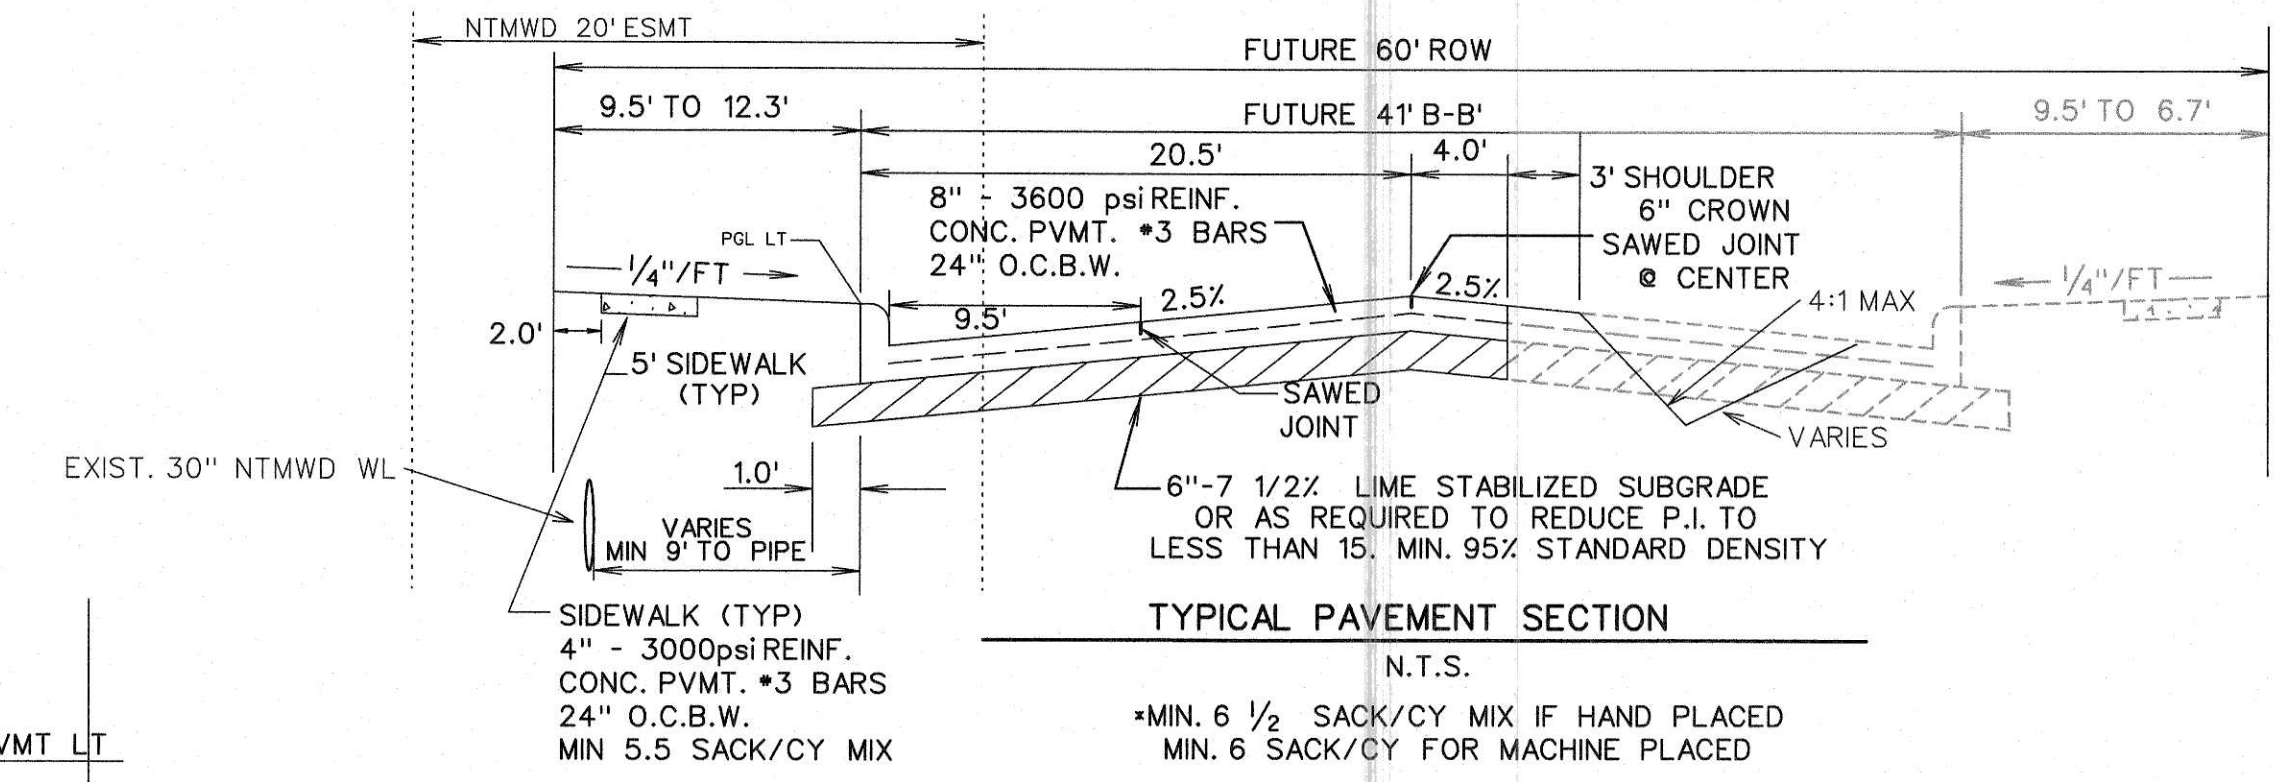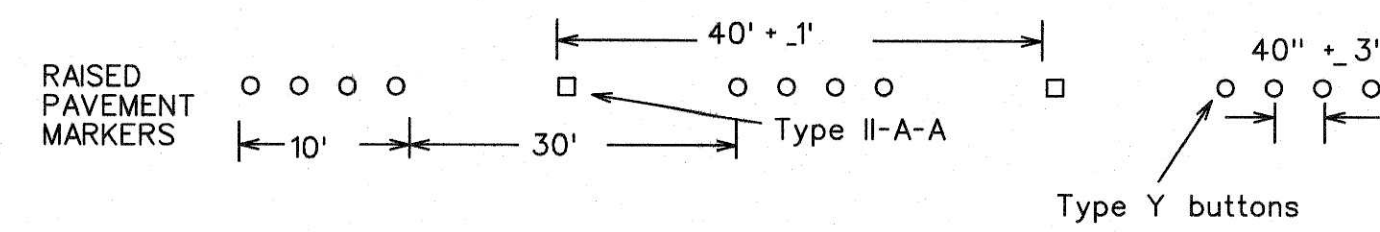


NOTE:

THE CONTRACTOR SHALL CONTACT NTMWD ENGINEERING AT (972) 442-5405 AT LEAST 48 HOURS PRIOR TO PERFORMING ANY WORK IN THE VICINITY OF THE NTMWD FACILITIES.

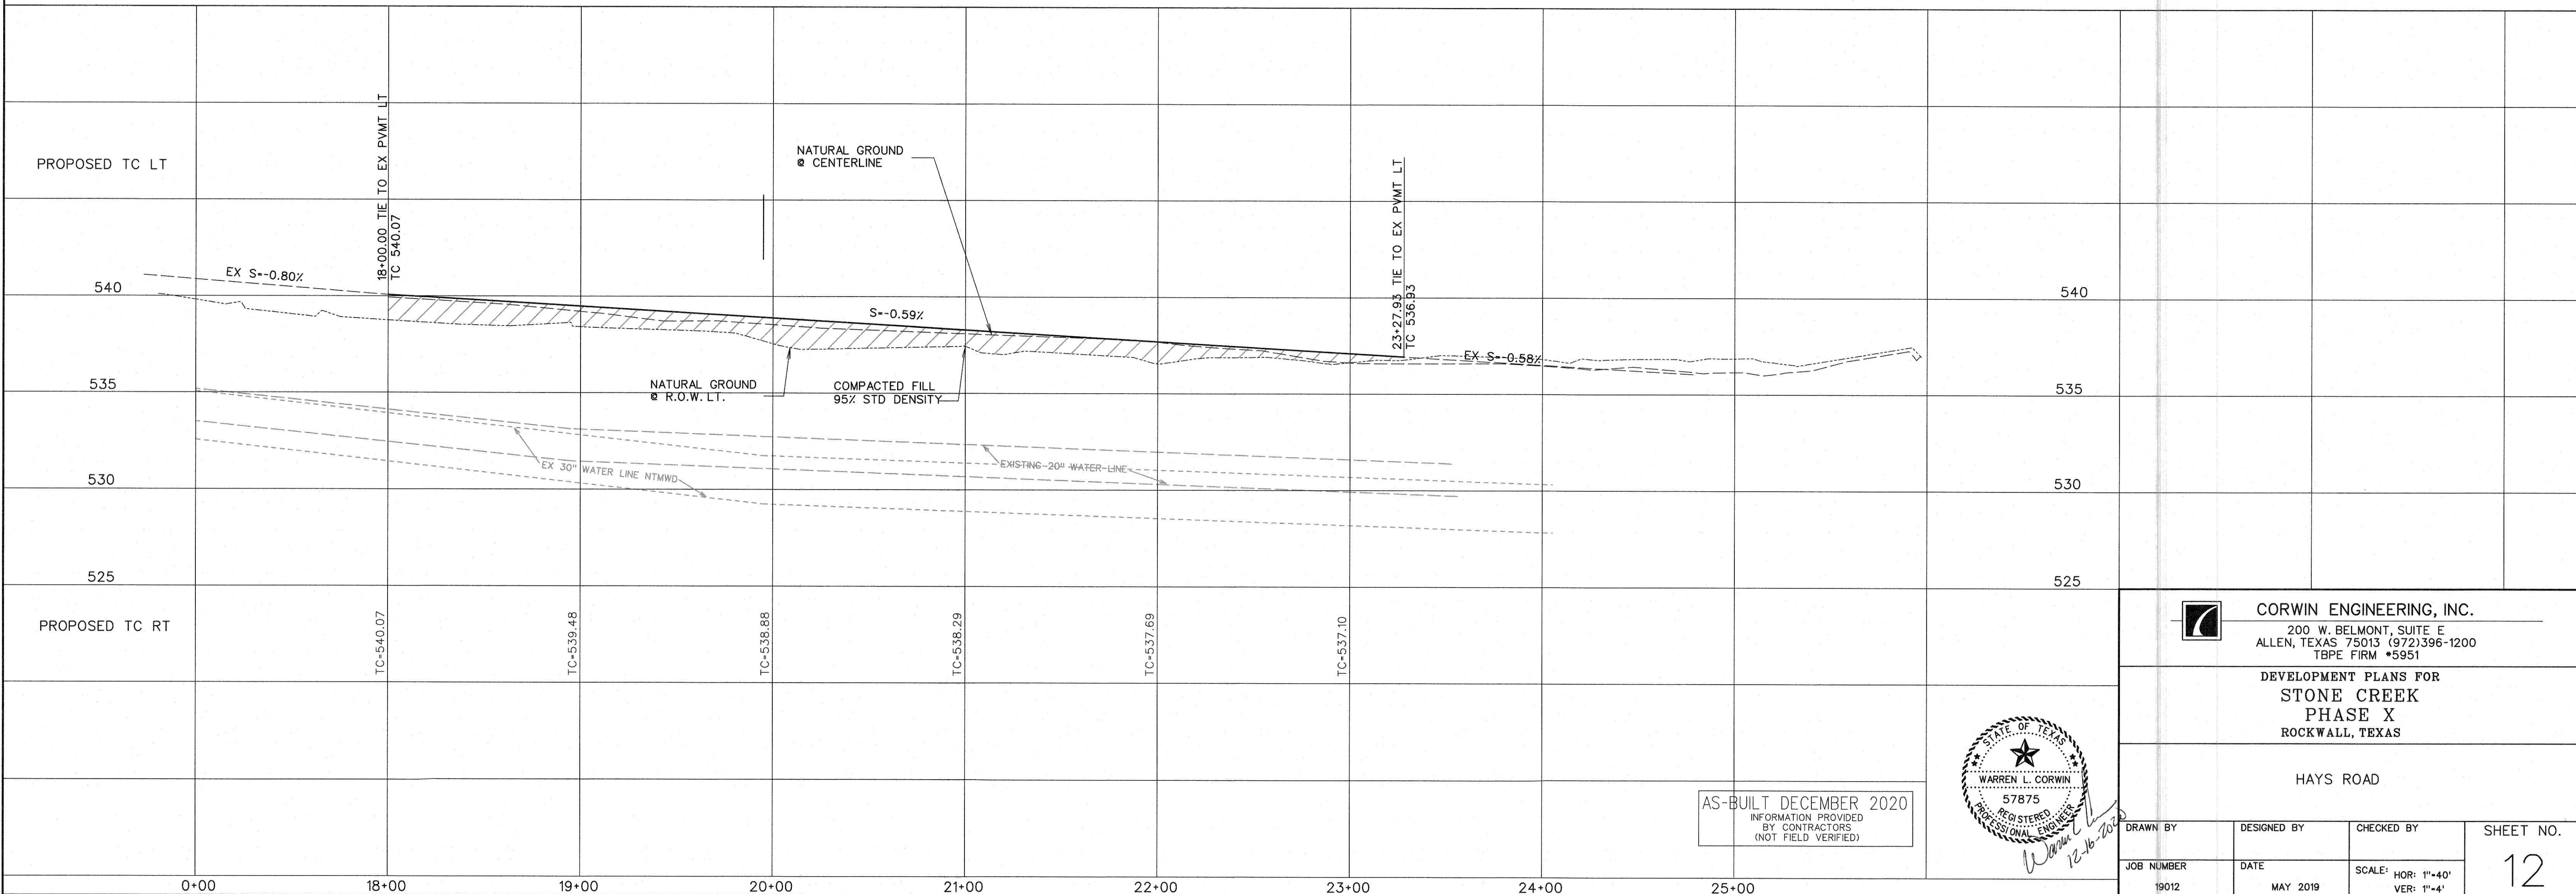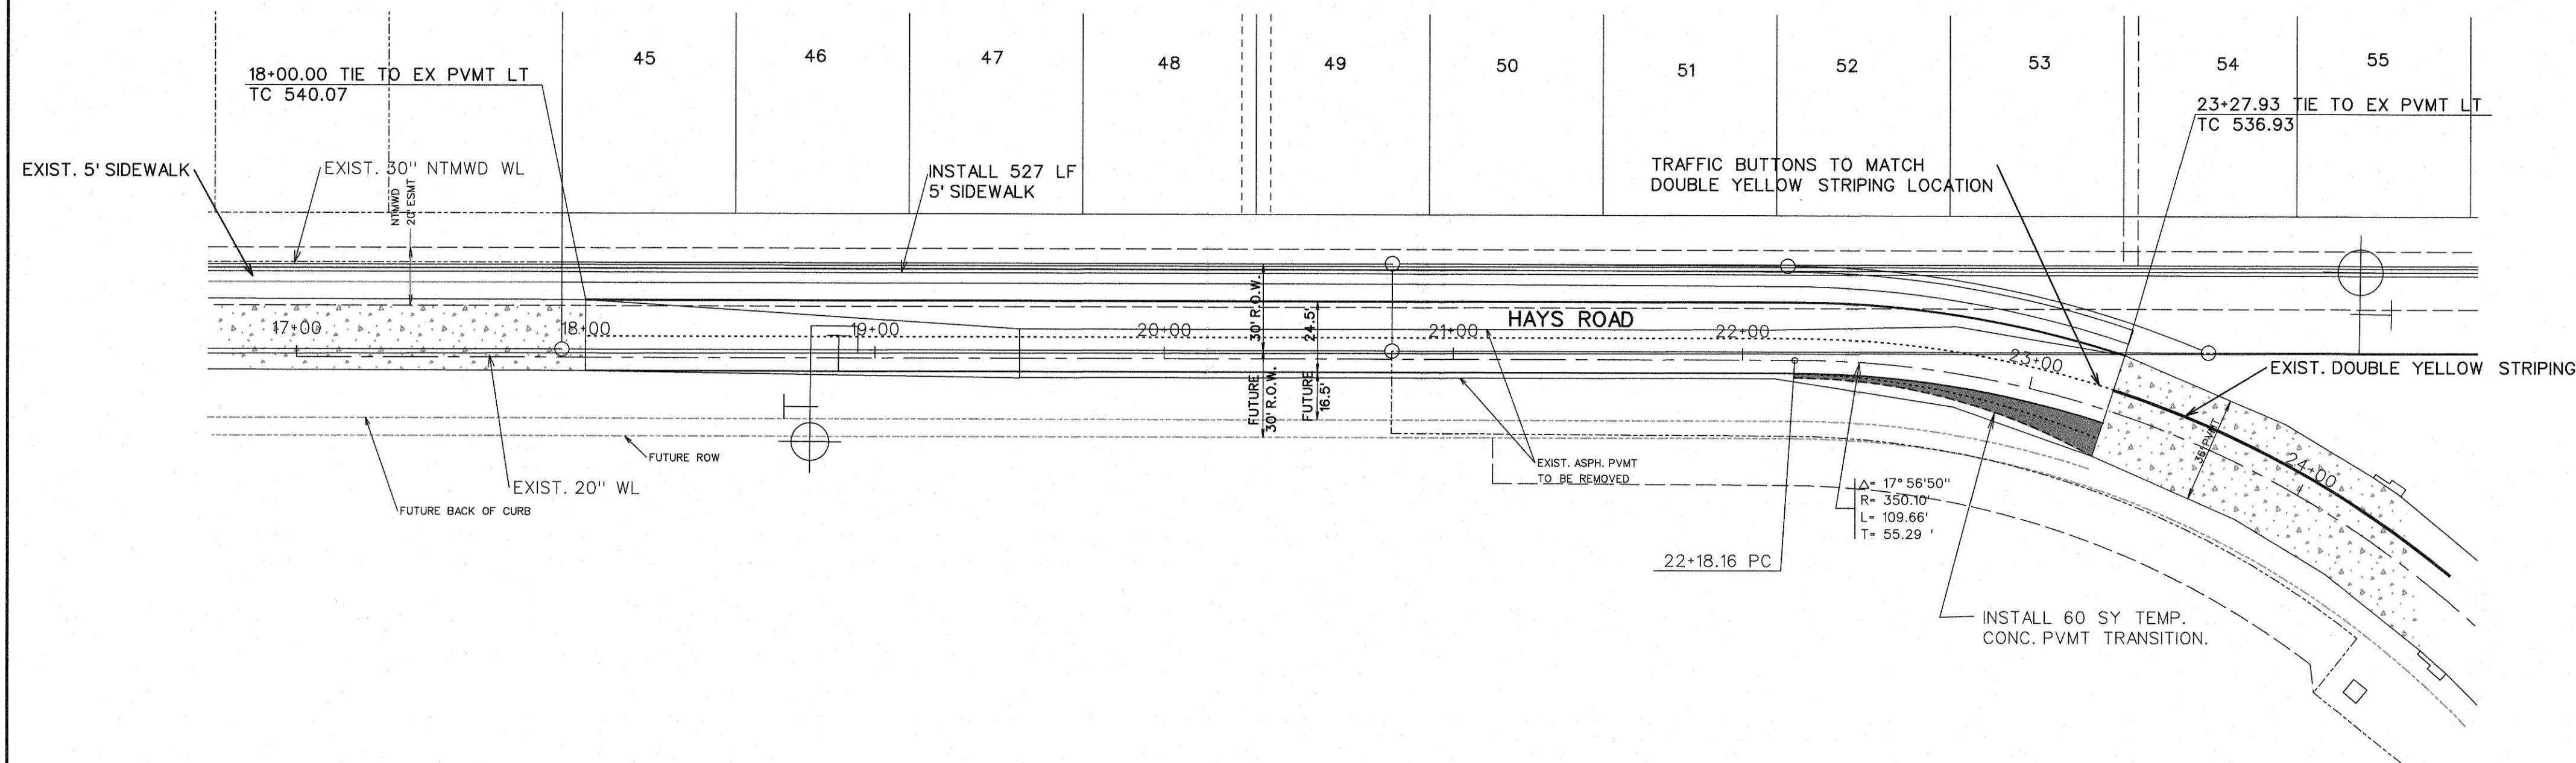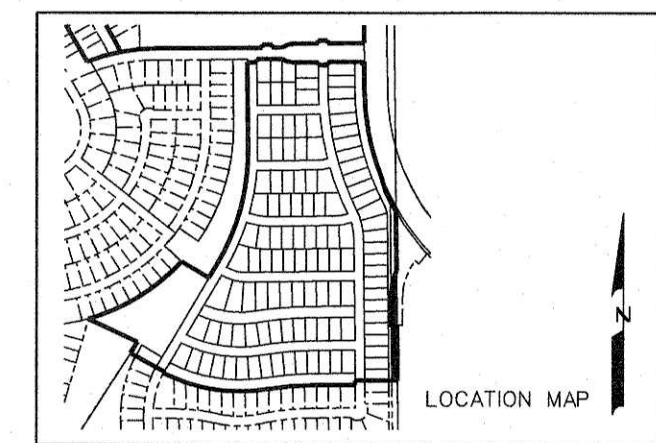

AS-BUILT DECEMBER 2020


INFORMATION PROVIDED BY CONTRACTORS (NOT FIELD VERIFIED)

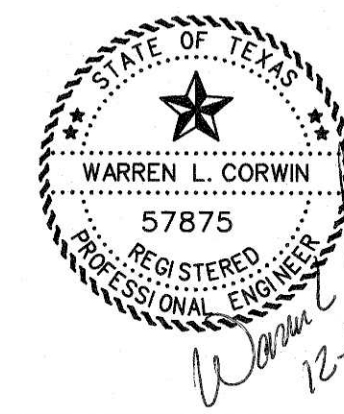

CORWIN ENGINEERING, INC. 200 W. BELMONT, SUITE E ALLEN, TEXAS 75013 (972)396-1200 TBPE FIRM #5951			
DEVELOPMENT PLANS FOR STONE CREEK PHASE X ROCKWALL, TEXAS			
HAYS ROAD			
DRAWN BY	DESIGNED BY	CHECKED BY	SHEET NO.
JOB NUMBER 19012	DATE MAY 2019	SCALE: HOR: 1"=40' VER: 1"=4'	12

BENCHMARK:
CITY OF ROCKWALL SURVEY MONUMENT ON AN INLET
AT THE NORTHWEST CORNER OF FEATHERSTONE DR. AND
HARVARD DR.
ELEV. = 525.31

0 50 100 200
SCALE: 1" = 100'

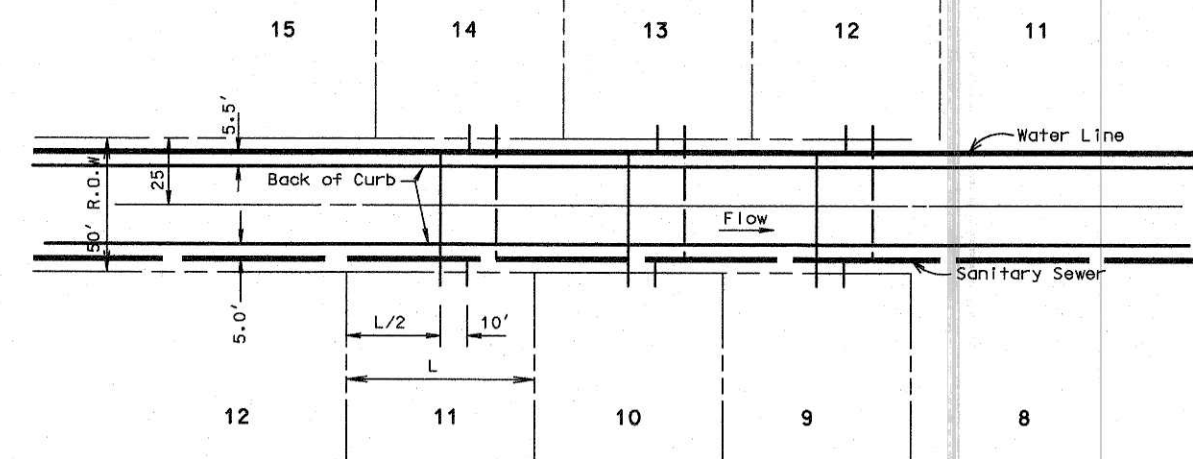


TYPICAL WATER & SEWER
SERVICE LAYOUT
N.T.S.

NOTE:
ALL WATER LINES TO BE CLASS 200 PIPE DR-14 C-900.
ALL SANITARY SEWER PIPE TO BE SDR 35
FOR 5'-10" DEEP AND SDR 26 FOR 10' AND GREATER.
INSTALL BLUE "EMS" DISK ON WATER LINE AT EVERY
250' AND CHANGE IN DIRECTION, VALVE, AND SERVICE.
INSTALL GREEN "EMS" DISK ON SANITARY SEWER
LINE EVERY 250' AND AT EVERY CHANGE IN DIRECTION,
MANHOLE, CLEANOUT, AND SERVICE.
ALL MANHOLES TO BE RAVEN EPOXY LINED AND
SEALED OR APPROVED EQUAL TO BE SPARK AND
PRESSURE TESTED.

SANITARY SEWER CURVE DATA				
CURVE NO.	DELTA	RADIUS	LENGTH	TANGENT
1.	35°23'22"	696.50'	430.20'	222.21'
2.	08°38'43"	1743.50'	263.08'	131.79'
3.	32°05'14"	246.50'	138.05'	10.89'
4.	17°22'05"	371.50'	112.61'	56.74'
5.	07°26'05"	271.50'	35.23'	17.64'
6.	31°16'25"	1171.50'	633.44'	327.90'
7.	15°38'28"	271.50'	74.12'	37.29'
8.	03°12'46"	1453.50'	81.50'	40.76'
9.	09°01'56"	1453.50'	298.13'	114.80'
10.	05°50'03"	1453.50'	148.00'	74.06'
11.	00°46'22"	1453.50'	19.61'	9.80'
12.	25°41'44"	346.50'	155.40'	79.03'

SERVICE SCHEDULE		
TYPE	SIZE	NO.
SANITARY	4"	116
WATER	1"	116
IRRIGATION	1"	4

AS-BUILT DECEMBER 2020
INFORMATION PROVIDED
BY CONTRACTORS
(NOT FIELD VERIFIED)

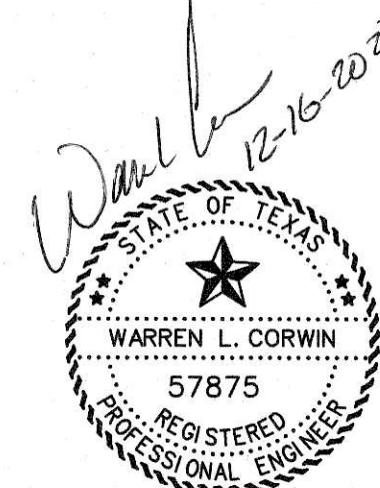


CORWIN ENGINEERING, INC.
200 W. BELMONT, SUITE E
ALLEN, TEXAS 75013 (972)396-1200
TBPE FIRM #5951


DEVELOPMENT PLANS FOR
STONE CREEK
PHASE X
ROCKWALL, TEXAS

WATER AND SANITARY SEWER PLAN


DRAWN BY	DESIGNED BY	CHECKED BY	SHEET NO. 13
JOB NUMBER 19012	DATE MAY 2019	SCALE: 1"=100'	

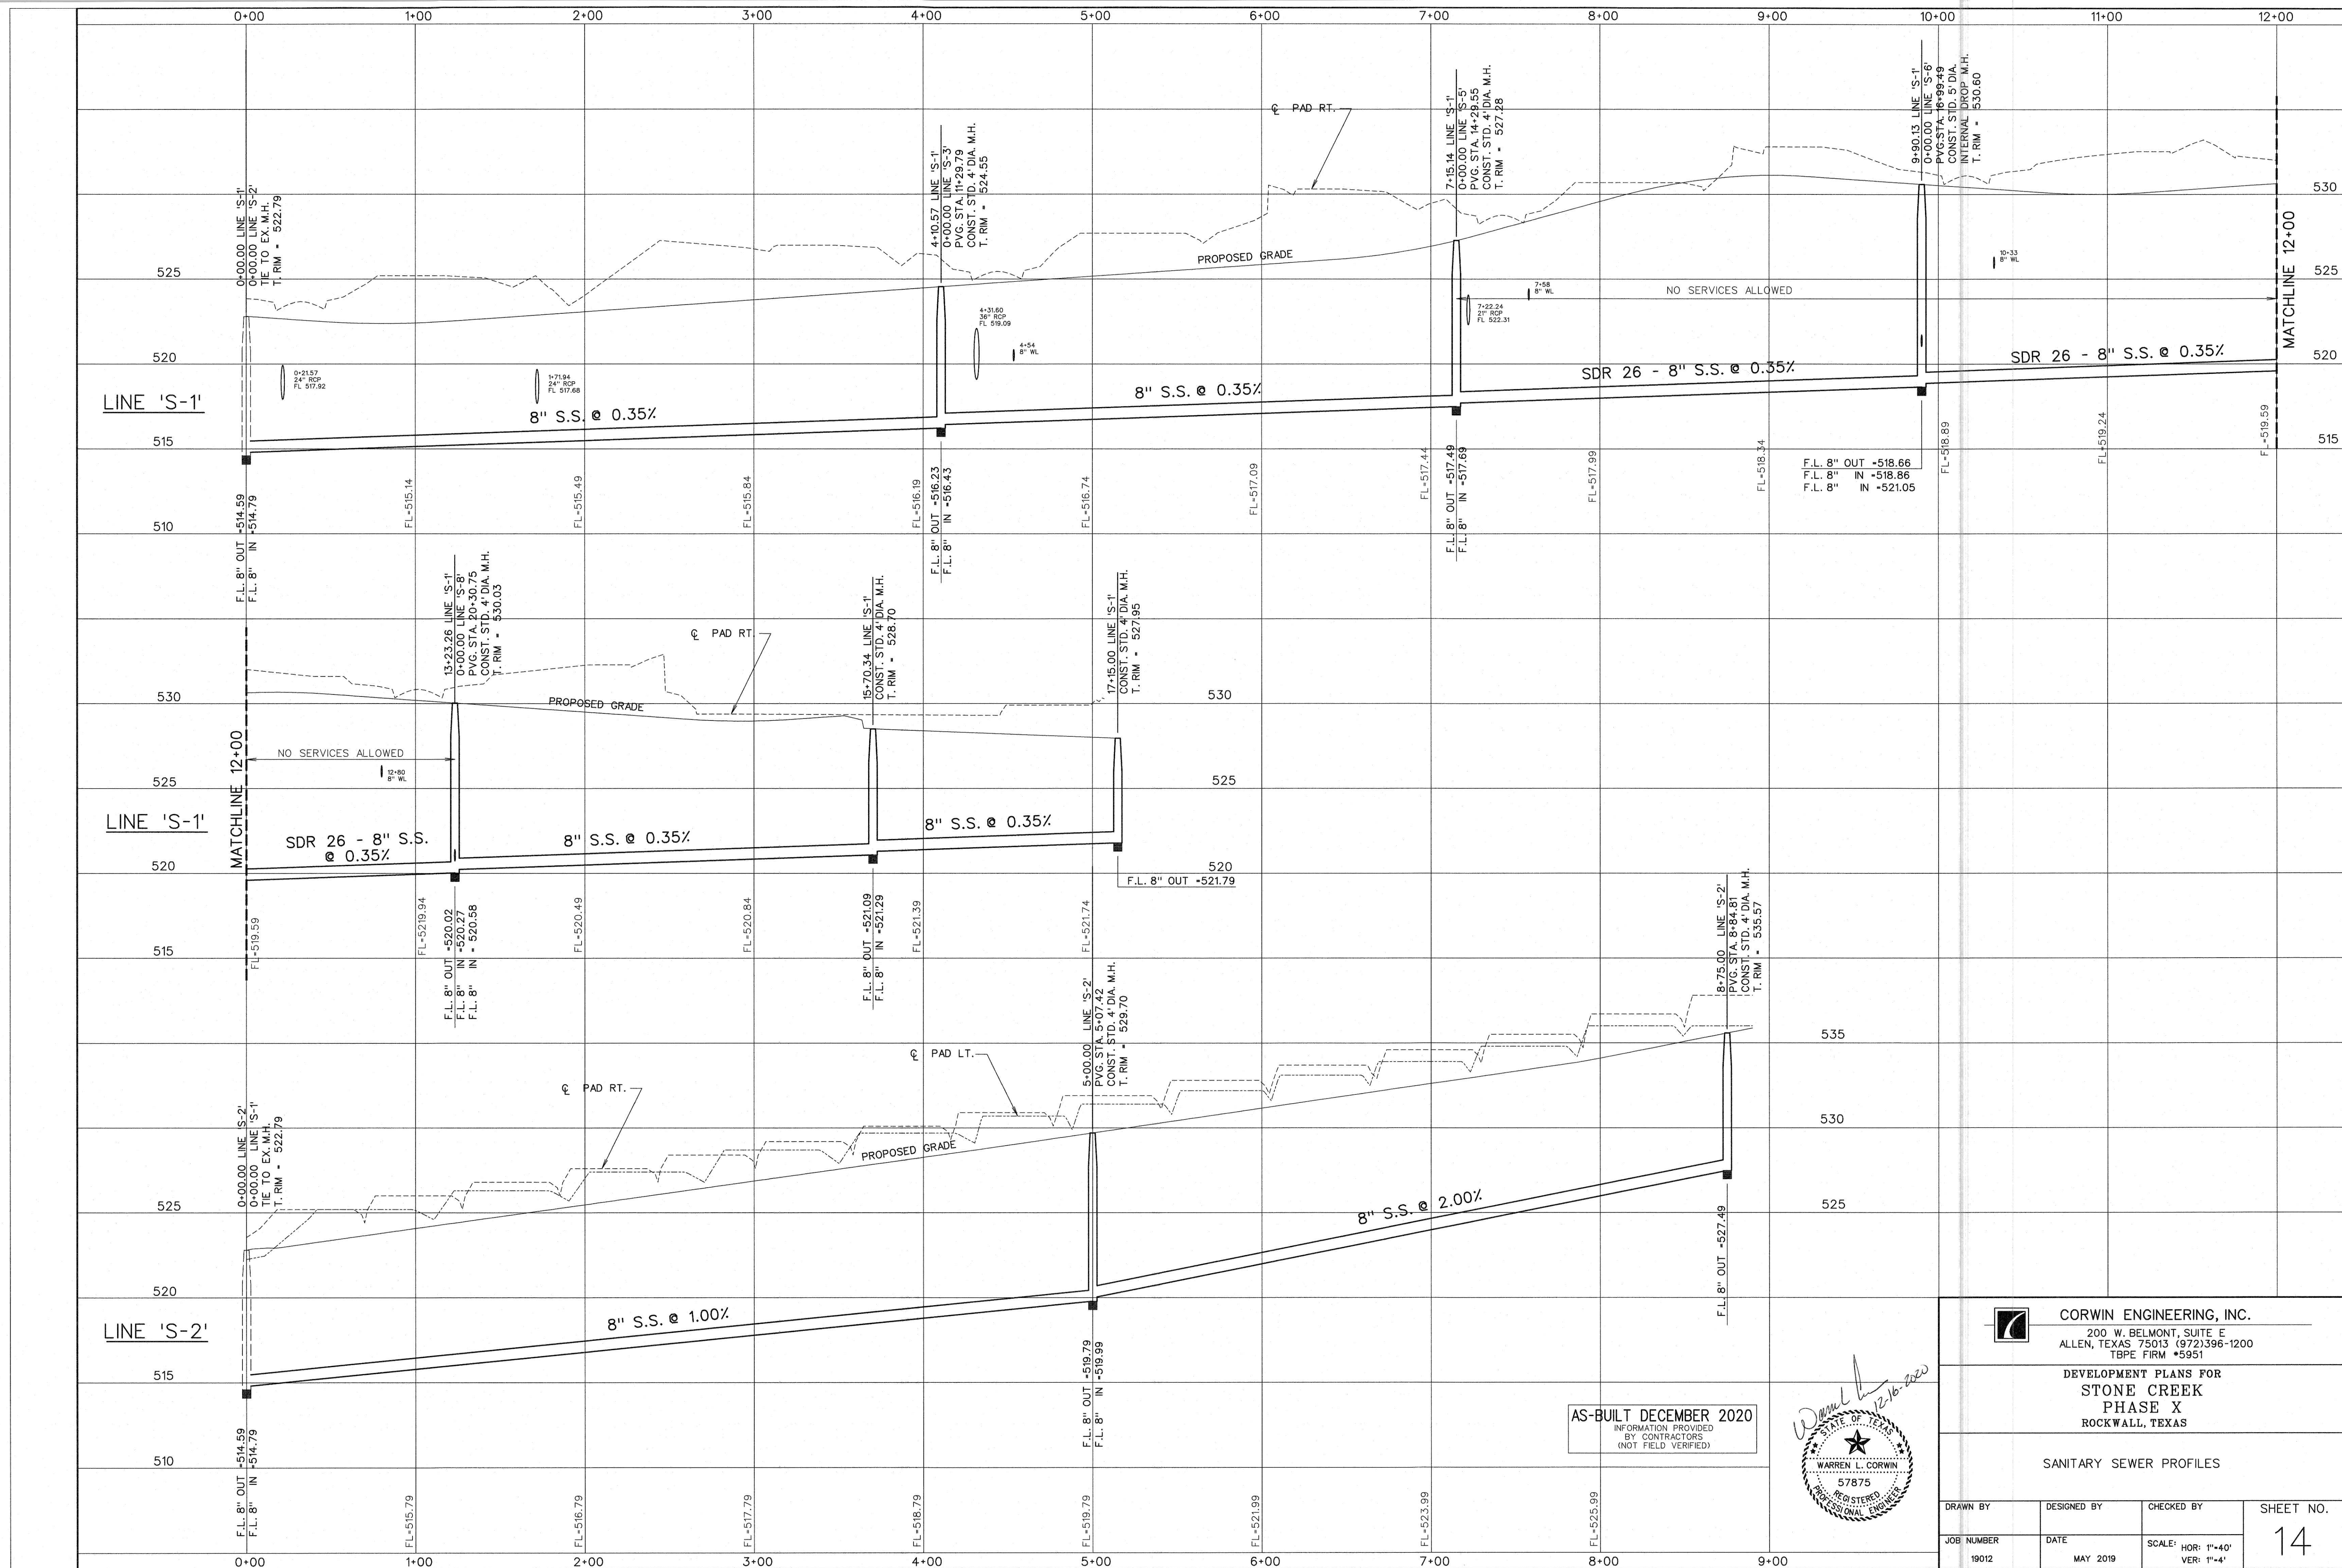

AS-BUILT DECEMBER 2020
INFORMATION PROVIDED
BY CONTRACTORS
(NOT FIELD VERIFIED)

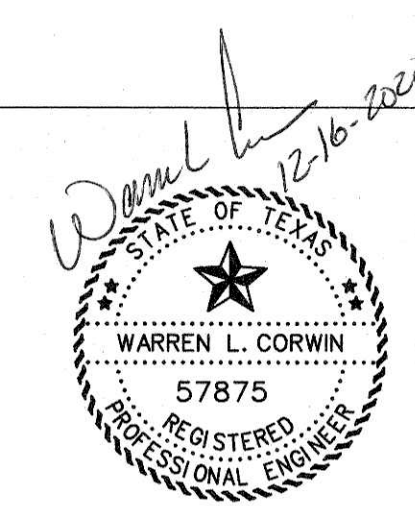


 CORWIN ENGINEERING, INC. 200 W. BELMONT, SUITE E ALLEN, TEXAS 75013 (972)396-1200 TBPE FIRM #5951			
DEVELOPMENT PLANS FOR STONE CREEK PHASE X ROCKWALL, TEXAS			
SANITARY SEWER PROFILES			
DRAWN BY	DESIGNED BY	CHECKED BY	SHEET NO.
JOB NUMBER	DATE	SCALE: HOR: 1"=40' VER: 1"=4'	14
19012	MAY 2019		

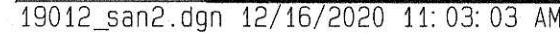

STATE OF TEXAS
WARREN L. CORWIN
57875
REGISTERED
PROFESSIONAL ENGINEER

Warren L. Corwin
12-16

DRAWN BY	DESIGNED BY	CHECKED BY	SHEET NO 15
JOB NUMBER 19012	DATE MAY 2019	SCALE: HOR: 1"=40' VER: 1"=4'	

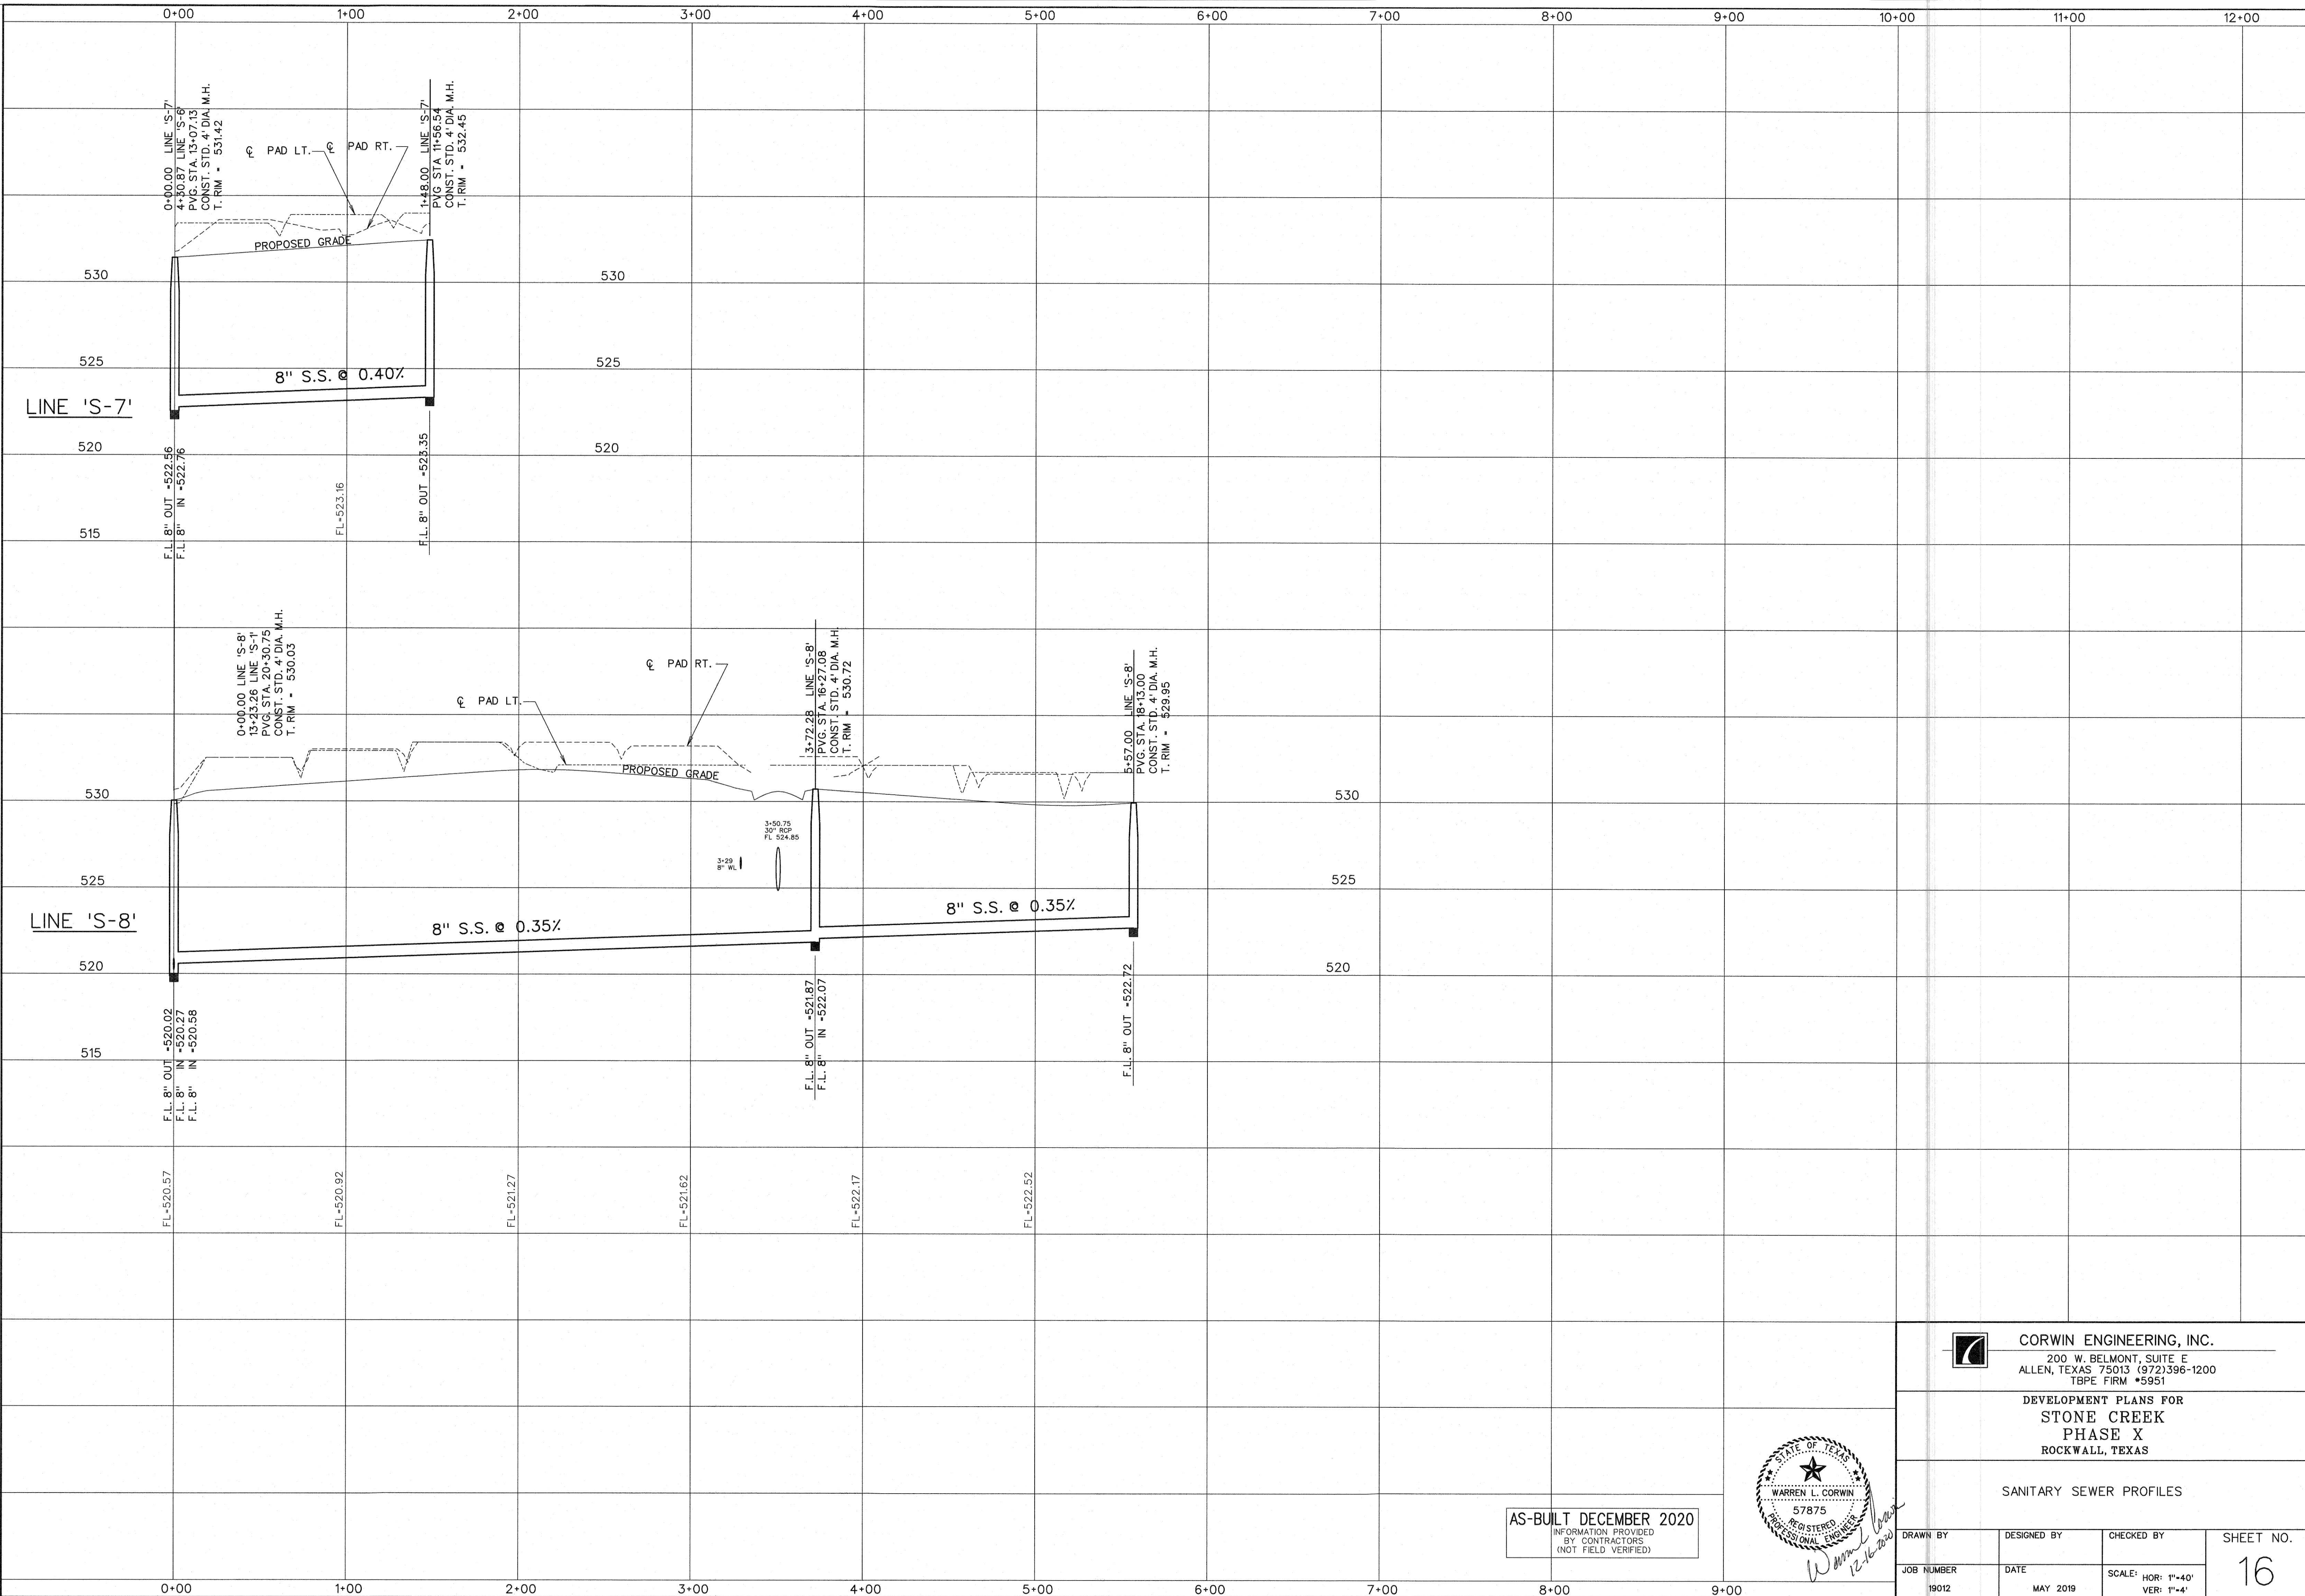

 CORWIN ENGINEERING, INC.
200 W. BELMONT, SUITE E
ALLEN, TEXAS 75013 (972)396-1200
TBP FIRM #5951


DEVELOPMENT PLANS FOR
STONE CREEK
PHASE X
ROCKWALL, TEXAS

SANITARY SEWER PROFILES

AS-BUILT DECEMBER 2020
INFORMATION PROVIDED
BY CONTRACTORS
(NOT FIELD VERIFIED)



DRAWN BY	DESIGNED BY	CHECKED BY	SHEET NO.
JOB NUMBER 19012	DATE MAY 2019	SCALE: HOR: 1"=40' VER: 1"=4'	16

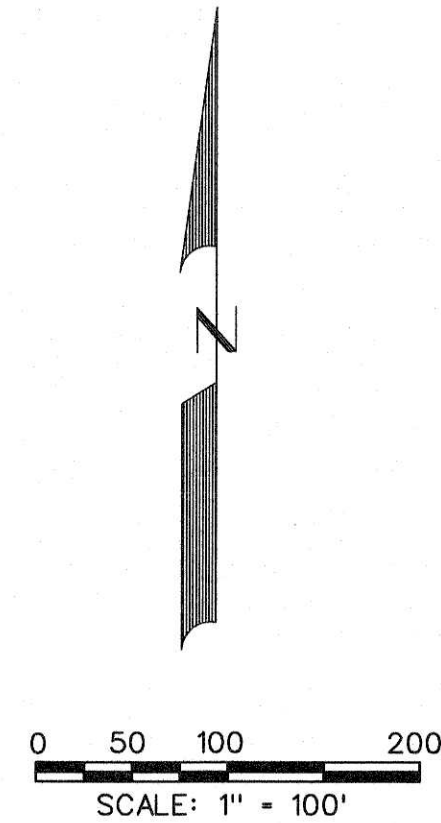

EXISTING CONDITIONS RUNOFF COMPUTATIONS									
Area #	Area (sf)	Area (acres)	Runoff Coefficient	CA	Tc (min)	I(100) (in/hr)	Q(100) (cfs)	Drains To	
EX1	425838	9.78	0.35	3.42	20	8.30	28.4	Ex. North Pond	
EX2	23413	0.54	0.50	0.27	10	9.80	2.6	Ex. North Pond	
EX3A	34933	0.80	0.50	0.40	10	9.80	3.9	Ex. North Pond	
EX3B	88929	2.04	0.50	1.02	10	9.80	10.0	Ex. North Pond	
EX4	347478	7.98	0.35	2.79	20	8.30	23.2	Ex. North Pond	
EX5	1085911	24.9	0.50	12.45	10	9.80	122.2	Ex. SW Det. Pond	
EX6	1356900	31.1	0.35	10.89	20	8.30	90.4	Ex. SW Det. Pond	

LEGEND

- PROP. STORM SEWER
- PROP. CURB INLETS
- PROP. CONC. HEADWALL
- EXIST. STORM SEWER
- DRAINAGE AREA DIVIDE
- FLOW ARROW
- DRAINAGE AREA NO.

AS-BUILT DECEMBER 2020
INFORMATION PROVIDED
BY CONTRACTORS
(NOT FIELD VERIFIED)




CORWIN ENGINEERING, INC.
200 W. BELMONT, SUITE E
ALLEN, TEXAS 75013 (972)396-1200
TBE FIRM #5951

DEVELOPMENT PLANS FOR
STONE CREEK
PHASE X
ROCKWALL, TEXAS

EXISTING CONDITIONS DRAINAGE AREA MAP

DRAWN BY	DESIGNED BY	CHECKED BY	SHEET NO.
JOB NUMBER	DATE	SCALE: HOR: 1"=40' VER: 1"=4'	17
19012	MAY 2019		

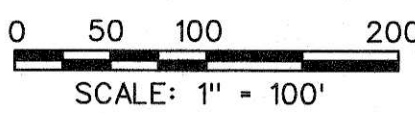

RUNOFF COMPUTATIONS

Area #	Area (sf)	Area (acres)	Runoff Coefficient	CA	To (min)	I(100) (in/hr)	Q(100) (cfs)	Drains To
1	69927	1.61	0.50	0.80	10	9.80	7.9	Inlet 1
2	71007	1.63	0.50	0.82	10	9.80	8.0	Inlet 2
3	7753	0.18	0.50	0.09	10	9.80	0.9	Inlet 3
4	79724	1.83	0.50	0.92	10	9.80	9.0	Inlet 4
5	47931	1.10	0.50	0.55	10	9.80	5.4	Inlet 5
6	64161	1.47	0.50	0.74	10	9.80	7.2	Inlet 6
7	49543	1.14	0.50	0.57	10	9.80	6.6	Inlet 7
8	64980	1.49	0.50	0.75	10	9.80	7.3	Inlet 8
9	61974	1.42	0.50	0.71	10	9.80	7.0	Inlet 9
10	62277	1.43	0.50	0.71	10	9.80	7.0	Inlet 10
11	82290	1.89	0.50	0.94	10	9.80	9.3	Inlet 11
12	97891	2.25	0.50	1.12	10	9.80	11.0	Inlet 12
13	97620	2.24	0.50	1.12	10	9.80	11.0	Inlet 13
14	70318	1.61	0.50	0.81	10	9.80	7.9	Inlet 14
15	84210	1.93	0.50	0.97	10	9.80	9.5	Inlet 15
16	36808	0.82	0.50	0.41	10	9.80	4.0	Inlet 16
17	59887	1.38	0.50	0.69	10	9.80	6.7	Inlet 17
18	96809	2.20	0.50	1.10	10	9.80	10.8	Inlet 18
19	27807	0.64	0.50	0.32	10	9.80	3.1	Inlet 19
20	26167	0.58	0.50	0.29	10	9.80	2.8	Inlet 20
21	162302	3.73	0.50	1.86	10	9.80	18.3	Inlet 21
22	81946	1.87	0.50	0.94	10	9.80	9.2	Ex. Inlet 22
23	318626	7.25	0.50	3.62	10	9.80	36.5	Ex. Pond
24	38362	0.90	0.50	0.45	10	9.80	4.4	Ex. Creek
25	18960	0.44	0.50	0.22	10	9.80	2.1	John King Blvd
26	36131	0.81	0.50	0.41	10	9.80	4.0	Hays Road
27	22204	0.51	0.50	0.26	10	9.80	2.4	John King Blvd
28	38884	0.92	0.50	0.46	10	9.80	4.5	John King Blvd
29	971675	22.31	0.50	11.16	10	9.80	55.4	Ex. Pond
30	20669	0.47	0.50	0.24	10	9.80	2.3	Inlet 24

LEGEND

- PROP. STORM SEWER
- PROP. CURB INLETS
- PROP. CONC. HEADWALL
- EXIST. STORM SEWER
- DRAINAGE AREA DIVIDE
- FLOW ARROW
- DRAINAGE AREA NO.

AS-BUILT DECEMBER 2020
INFORMATION PROVIDED
BY CONTRACTORS
(NOT FIELD VERIFIED)



CORWIN ENGINEERING, INC.
200 W. BELMONT, SUITE E
ALLEN, TEXAS 75013 (972)396-1200
TBP FIRM #5951

**DEVELOPMENT PLANS FOR
STONE CREEK
PHASE X
ROCKWALL, TEXAS**

DRAINAGE AREA MAP

DRAWN BY	DESIGNED BY	CHECKED BY	SHEET NO.
JOB NUMBER	DATE	SCALE: HOR: 1"=40' VER: 1"=4'	17A
19012	MAY 2019		

Upstream Station	Downstream Station	Distance (ft)	AREA (sq ft)	Total Area (Acres)	Picked Up (Acres)	C	CA	Accumulated CA	Tc (Years)	Design Storm (in/hr)	I (ft)	O (ft)	S (ft)	Ripe Size (in)	Partial Flow?	Velocity (fps)	Flow Time (Min)	Velocity Head (ft)	Junction Type	K	Time at DIS (Min)	Minor Losses (ft)	Hydraulic Grade Upstream	Hydraulic Grade Downstream	Proposed Grade	Difference
Line D1 5418.97 5419.25 5419.50 5419.75 5419.90 5420.00	5419.25 5419.75 5420.00 5420.25 5420.50 5420.75	24.72 32.46 36.00 39.54 43.08 46.62	3 DIA DIA DIA DIA DIA	0.18 1.83 1.83 1.83 1.83 1.83	0.18 1.83 1.83 1.83 1.83 1.83	0.50 0.50 0.50 0.50 0.50 0.50	0.08 0.92 0.92 0.92 0.92 0.92	0.09 1.00 1.00 1.00 1.00 1.00	10.00 10.00 10.00 10.00 10.00 10.00	9.80 9.80 9.80 9.80 9.80 9.80	0.9 0.9 0.9 0.9 0.9 0.9	0.0001 0.0018 0.0018 0.0018 0.0018 0.0018	18 24 24 24 24 24	No No No No No Yes	0.5 3.1 3.1 3.1 3.1 5.7	0.83 2.06 2.06 2.06 2.06 0.35	0.00 0.15 0.15 0.15 0.15 0.50	Inlet 60" Wye 60" Wye 60" Wye 60" Wye 60" Wye	1.25 0.35 0.35 0.35 0.35 0.35	10.83 12.90 12.90 12.90 12.90 13.23	0.00 0.15 0.15 0.15 0.15 0.35	527.23 527.26 527.26 527.26 527.26 526.22	527.23 527.08 527.08 527.08 527.08 526.22	528.88 528.88 528.88 528.88 528.88 528.88	2.65 2.80 2.80 2.80 2.80 1.52	
Line D1A 5420.00 5420.00 5420.00 5420.00 5420.00 5420.00	5420.00 5420.00 5420.00 5420.00 5420.00 5420.00	34.07 34.07 34.07 34.07 34.07 34.07	4	1.83 1.83 1.83 1.83 1.83 1.83	0.50 0.50 0.50 0.50 0.50 0.50	0.92 0.92 0.92 0.92 0.92 0.92	0.92 0.92 0.92 0.92 0.92 0.92	10.00 10.00 10.00 10.00 10.00 10.00	9.80 9.80 9.80 9.80 9.80 9.80	9.0 9.0 9.0 9.0 9.0 9.0	0.0073 0.0073 0.0073 0.0073 0.0073 0.0073	18 18 18 18 18 18	No No No No No No	5.1 3.1 3.1 3.1 3.1 3.1	0.10 0.15 0.15 0.15 0.15 0.15	0.40 0.15 0.15 0.15 0.15 0.15	Inlet 60" Wye 60" Wye 60" Wye 60" Wye 60" Wye 60" Wye	1.25 0.35 0.35 0.35 0.35 0.35	10.11 0.00 0.00 0.00 0.00 0.00	0.50 0.00 0.00 0.00 0.00 0.00	527.83 527.08 527.08 527.08 527.08 527.08	527.32 527.08 527.08 527.08 527.08 527.08	529.88 529.88 529.88 529.88 529.88 529.88	2.55 2.55 2.55 2.55 2.55 2.55		
Line D1C 5420.00 5420.00 5420.00 5420.00 5420.00 5420.00	5420.00 5420.00 5420.00 5420.00 5420.00 5420.00	17.90 17.90 17.90 17.90 17.90 17.90	2	1.63 1.63 1.63 1.63 1.63 1.63	0.50 0.50 0.50 0.50 0.50 0.50	0.82 0.82 0.82 0.82 0.82 0.82	0.82 0.82 0.82 0.82 0.82 0.82	10.00 10.00 10.00 10.00 10.00 10.00	9.80 9.80 9.80 9.80 9.80 9.80	9.0 9.0 9.0 9.0 9.0 9.0	0.0058 0.0058 0.0058 0.0058 0.0058 0.0058	18 18 18 18 18 18	No No No No No No	4.5 4.5 4.5 4.5 4.5 4.5	0.02 0.02 0.02 0.02 0.02 0.02	0.32 0.45 0.45 0.45 0.45 0.45	Inlet 60" Wye 60" Wye 60" Wye 60" Wye 60" Wye 60" Wye	1.25 0.35 0.35 0.35 0.35 0.35	10.07 0.00 0.00 0.00 0							

Design Storm Data													Selected Inlets												
Inlet		Design Storm Data		Intensity		Area Runoff Coeff		Area Runoff Coeff		Area Runoff Coeff		Area Runoff Coeff		Area Runoff Coeff		Area Runoff Coeff		Area Runoff Coeff		Area Runoff Coeff		Area Runoff Coeff		Area Runoff Coeff	
Inlet No.	Station	Offset	Street	Tc (years)	(min)	in/hr	C	DA	Area (ac)	Area (sq ft)	Area (sq ft)	Area (sq ft)	Area (sq ft)	Area (sq ft)	Area (sq ft)	Area (sq ft)	Area (sq ft)	Area (sq ft)	Area (sq ft)	Area (sq ft)	Area (sq ft)	Area (sq ft)	Area (sq ft)	Area (sq ft)	
1	25+00.00	0+35.00	LT NAUTILUS	10	10	9.8	0.50	1	1.62	7.9	0.0	7.9	126	0.7%	6' pbi	0.30	0.42	15	12.6	30	STD	0.1	0.0		
2	25+00.00	0+35.00	RT NAUTILUS	10	10	9.8	0.50	1	1.62	7.9	0.0	7.9	126	0.7%	6' pbi	0.30	0.42	15	12.6	30	STD	0.1	0.0		
3	26+00.00	0+35.00	LT NAUTILUS	10	10	9.8	0.50	3	4.86	0.9	0.0	0.9	126	0.9%	6' pbi	0.30	0.42	15	12.6	30	STD	0.1	0.0		
4	38+00.00	0+35.00	RT NAUTILUS	10	10	9.8	0.50	4	6.48	0.0	0.0	0.0	126	0.7%	6' pbi	0.30	0.42	15	12.6	30	STD	0.1	0.0		
5	17+75.00	0+35.00	LT TOPAZ	10	10	9.8	0.50	5	8.10	5.4	0.0	5.4	126	0.7%	6' pbi	0.30	0.36	15	10.8	30	STD	0.1	0.0		
6	17+75.00	0+35.00	RT TOPAZ	10	10	9.8	0.50	5	8.10	5.4	0.0	5.4	126	0.7%	6' pbi	0.30	0.36	15	10.8	30	STD	0.1	0.0		
7	13+00.00	0+35.00	LT TOPAZ	10	10	9.8	0.50	7	11.34	5.6	0.0	5.6	126	0.9%	6' pbi	0.30	0.37	15	11.0	30	STD	0.1	0.0		
8	13+00.00	0+35.00	RT TOPAZ	10	10	9.8	0.50	8	14.88	7.3	0.0	7.3	126	0.9%	6' pbi	0.30	0.41	15	12.2	30	STD	0.1	0.0		
9	0+57.00	0+35.00	LT PETREL	10	10	9.8	0.50	11	14.3	7.0	0.0	7.0	126	0.7%	6' pbi	0.30	0.40	15	12.0	30	STD	0.1	0.0		
10	14+02.00	0+35.00	RT PETREL	10	10	9.8	0.50	12	14.3	7.3	0.0	7.3	126	0.7%	6' pbi	0.30	0.40	15	12.0	30	STD	0.1	0.0		
11	0+64.00	0+35.00	LT AQUATROSS	10	10	9.8	0.50	12	18.9	9.3	0.0	9.3	145	0.5%	6' pbi	0.30	0.42	15	12.7	30	STD	0.1	0.0		
12	0+77.00	0+35.00	RT AQUATROSS	10	10	9.8	0.50	12	2.25	10.0	0.0	10.0	145	0.5%	6' pbi	0.30	0.42	15	12.7	30	STD	0.1	0.0		
13	0+80.00	0+35.00	RT AQUATROSS	10	10	9.8	0.50	12	2.25	10.0	0.0	10.0	145	0.5%	6' pbi	0.30	0.42	15	12.7	30	STD	0.1	0.0		
14	0+80.00	0+35.00	RT AQUATROSS	10	10	9.8	0.50	12	2.25	10.0	0.0	10.0	145	0.5%	6' pbi	0.30	0.42	15	12.7	30	STD	0.1	0.0		
15	0+80.00	0+35.00	RT AQUATROSS	10	10	9.8	0.50	12	2.25	10.0	0.0	10.0	145	0.5%	6' pbi	0.30	0.42	15	12.7	30	STD	0.1	0.0		
16	0+80.00	0+35.00																							



200 W. BELMONT, SUITE E
ALLEN, TEXAS 75013 (972)396-1200
TBPE FIRM #5951

DRAINAGE CALCULATIONS

DESIGNED BY

SHEET NO.

DATE _____

SCALE: UOB: 111.4

18

MAY 2


VER: 1"-4

10


18



STORM SEWER CURVE DATA			
CURVE NO.	①	②	③
Δ	30° 00' 00"	•	•
R	65.00'		
T	17.42'		
L	34.03'		

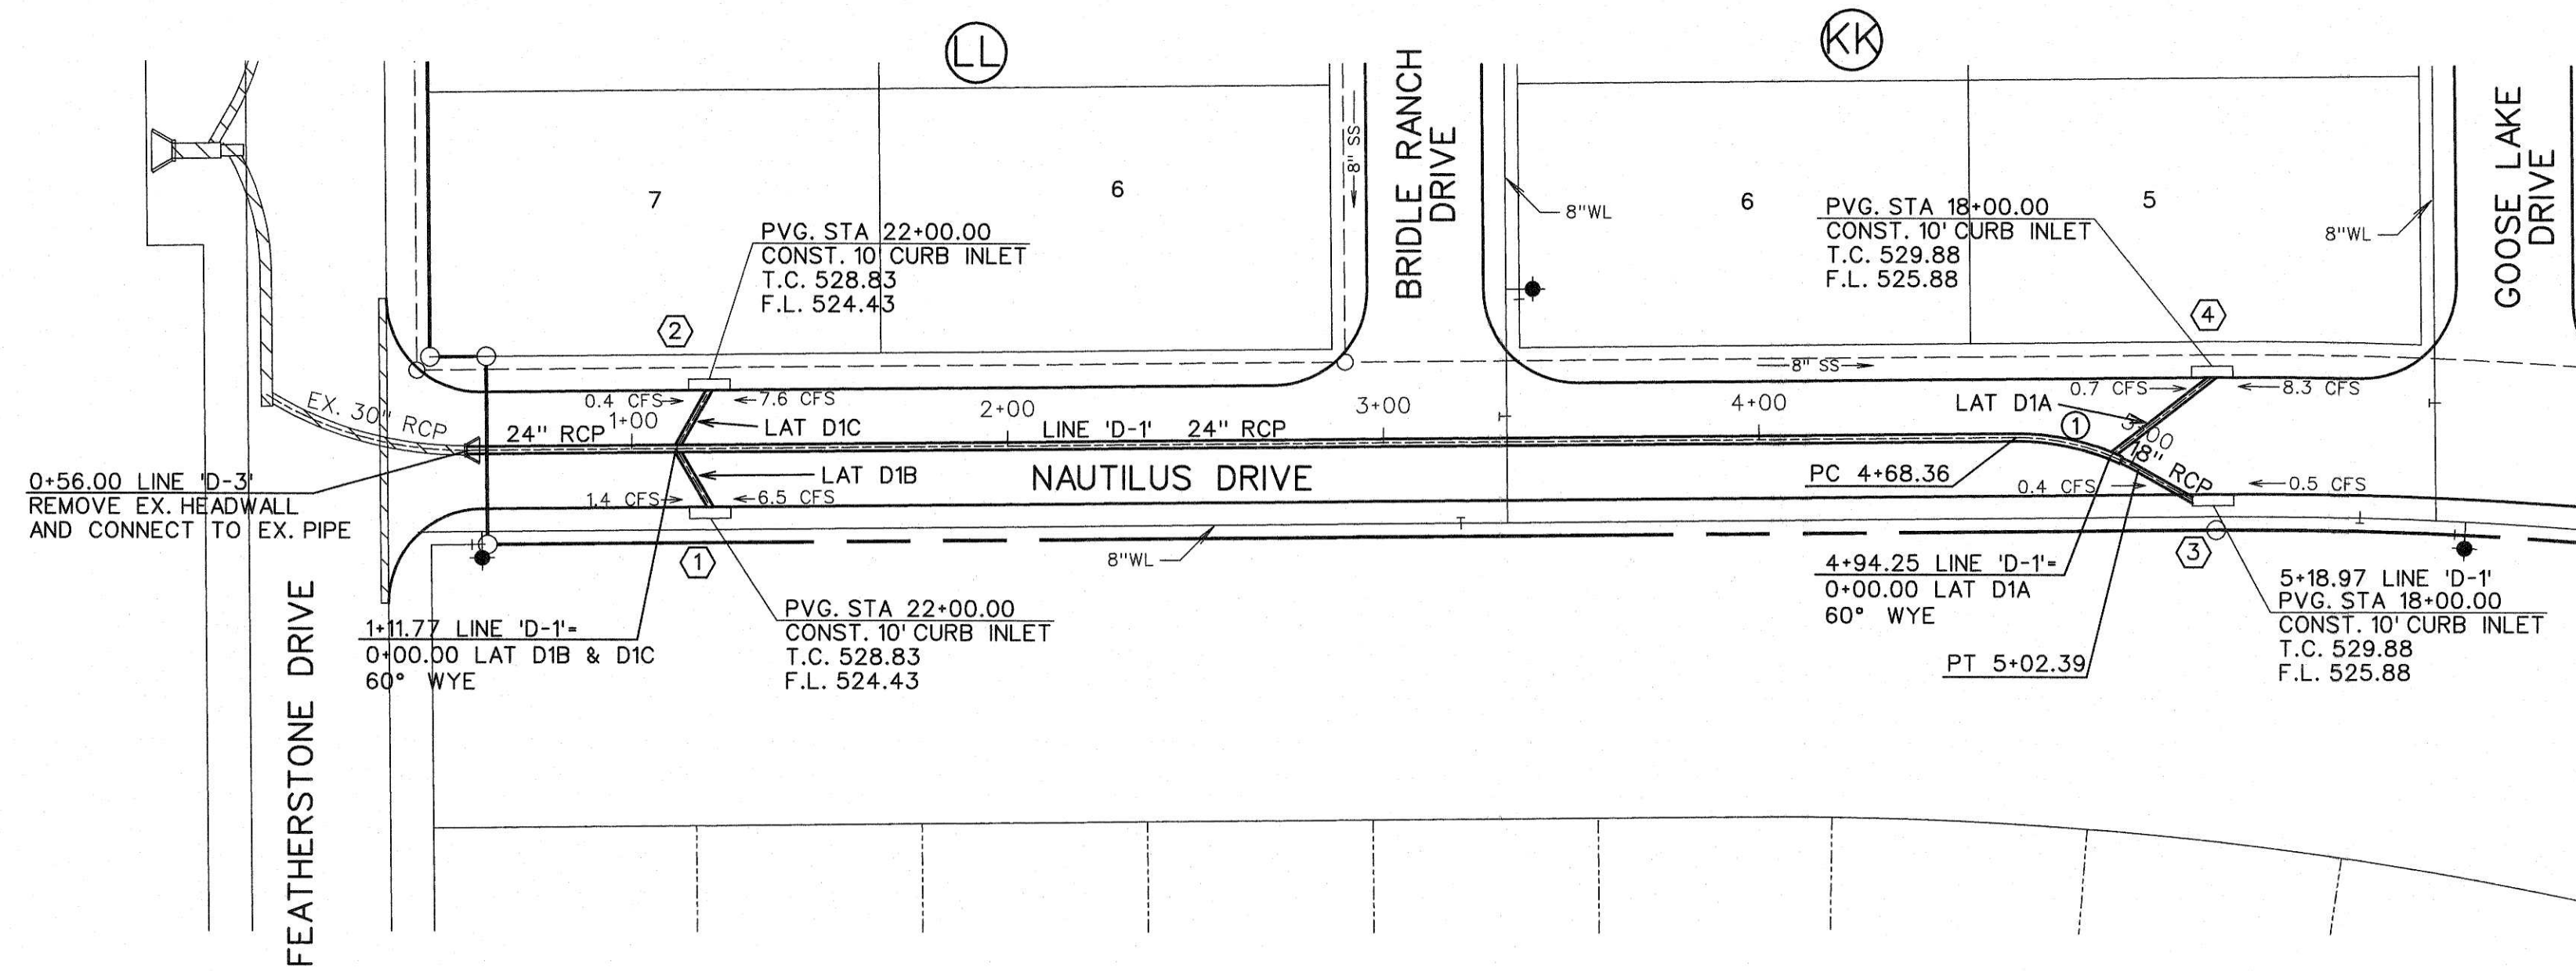

LINE 'D-1'

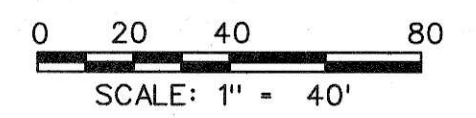

LEGEND

- (B) - BLOCK LABEL
- (19) - INLET NUMBER
- ① - CURVE NUMBER
- - SANITARY SEWER
- +— - WATER
- +— - PROPOSED STORM SEWER
- +— - EXISTING STORM SEWER

30" RCP 24" RCP
Q₁₀₀ = 16.9 cfs Q₁₀₀ = 16.9 cfs
V₁₀₀ = 5.7 fps V₁₀₀ = 5.4 fps
S = 0.0017 S = 0.0056
CAP = 26.3 cfs CAP = 14.5 cfs

24" RCP
Q₁₀₀ = 9.7 cfs
V₁₀₀ = 3.1 fps
S = 0.0018
CAP = 14.5 cfs

18" RCP
Q₁₀₀ = 0.9 cfs
V₁₀₀ = 0.5 fps
S = 0.0001
CAP = 6.7 cfs

0+56.00 LINE 'D-1'
REMOVE EX. HEADWALL
AND CONNECT TO EX. PIPE
HG-525.22
30" RCP @ 0.50%
24" RCP @ 0.41%
1+11.77 LINE 'D-1'
0+00.00 LAT D1B & D1C
60° WYE
HG-525.31
HG-525.37
24" RCP @ 0.41%
18" RCP @ 0.41%
24" FL-523.00
30" FL-523.50
24" FL-523.98
18" FL-523.98

24" RCP @ 0.41%
24" FL-524.64
18" FL-521.70

4+94.25 LINE 'D-1'
0+00.00 LAT D1A
60° WYE
HG-527.08
HG-527.22
4+97.25 LINE 'D-1'
BEGIN 21" RCP
END 24" RCP
5+18.97 LINE 'D-1'
END RCP @ INLET
TC 529.88
HG-527.23
HG-527.23
18" RCP @ 0.41%
24" FL-525.28
18" FL-525.53
24" FL-525.79
18" FL-525.79
18" FL-525.88

LINE 'D-1'

AS-BUILT DECEMBER 2020
INFORMATION PROVIDED
BY CONTRACTORS
(NOT FIELD VERIFIED)





CORWIN ENGINEERING, INC.
200 W. BELMONT, SUITE E
ALLEN, TEXAS 75013 (972) 396-1200
TBE FIRM #5951

DEVELOPMENT PLANS FOR
STONE CREEK
PHASE X
ROCKWALL, TEXAS


STORM SEWER PLAN AND PROFILE
LINE 'D-1'

DRAWN BY	DESIGNED BY	CHECKED BY	SHEET NO.
JOB NUMBER	DATE	SCALE: HOR: 1"=40' VER: 1"=4'	19
19012	MAY 2019		

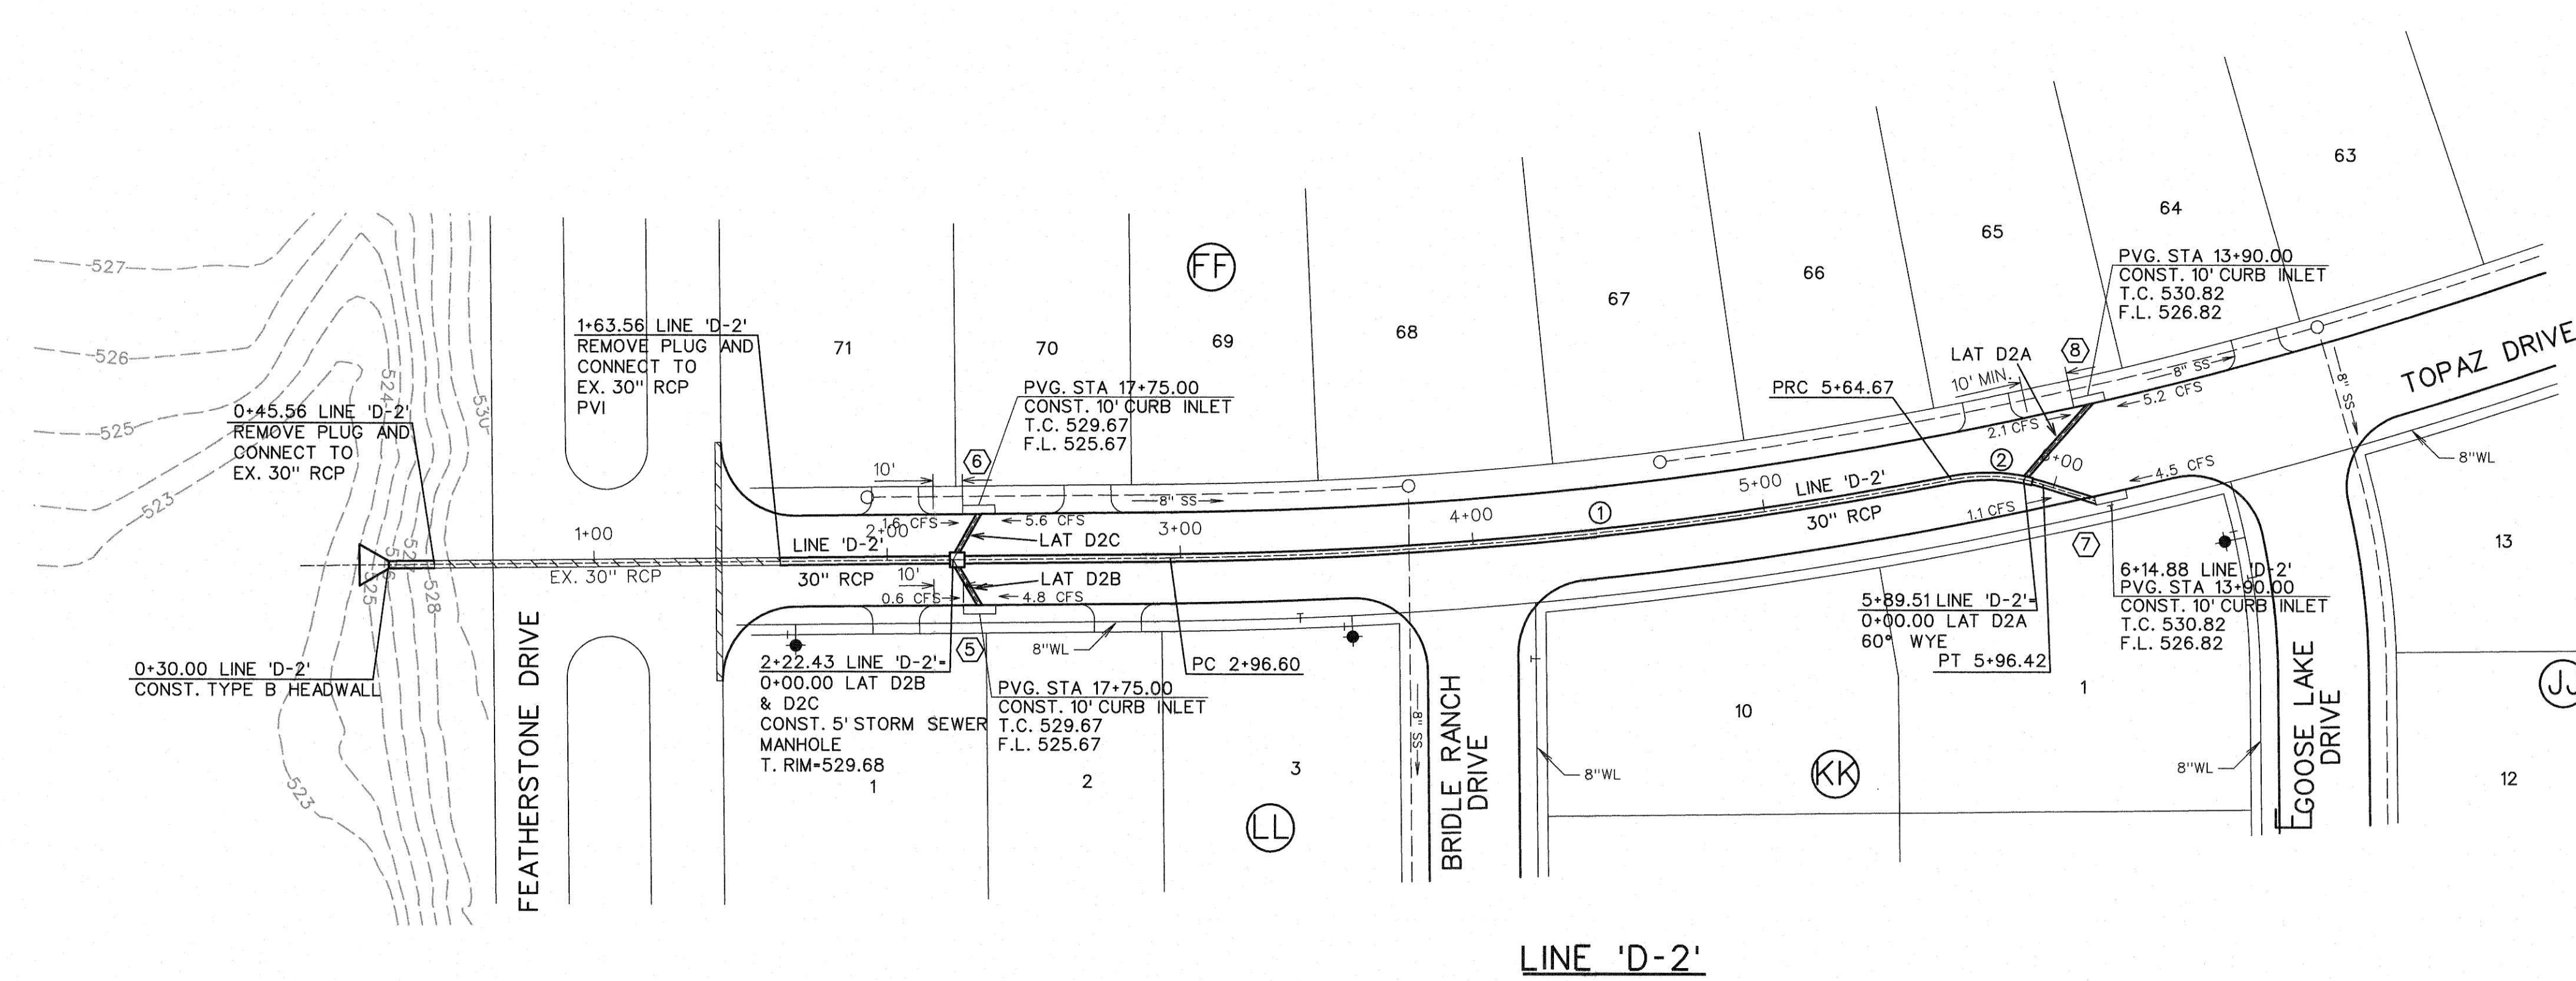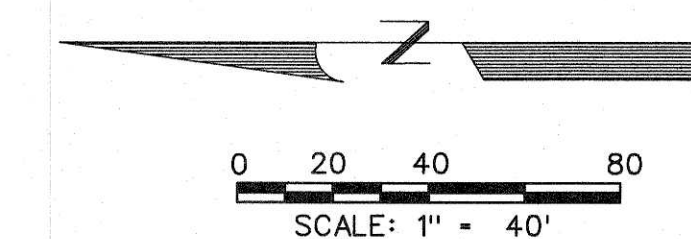

STORM SEWER CURVE DATA			
CURVE NO.	①	②	③
Δ	10° 24' 47"	27° 59' 28"	° ' "
R	1475.00'	65.00'	'
T	134.41'	16.20'	'
L	268.07'	31.75'	'

- LEGEND**
- (B) - BLOCK LABEL
 - (19) - INLET NUMBER
 - ① - CURVE NUMBER
 - - SANITARY SEWER
 - +— - WATER
 - ==== - PROPOSED STORM SEWER
 - - EXISTING STORM SEWER

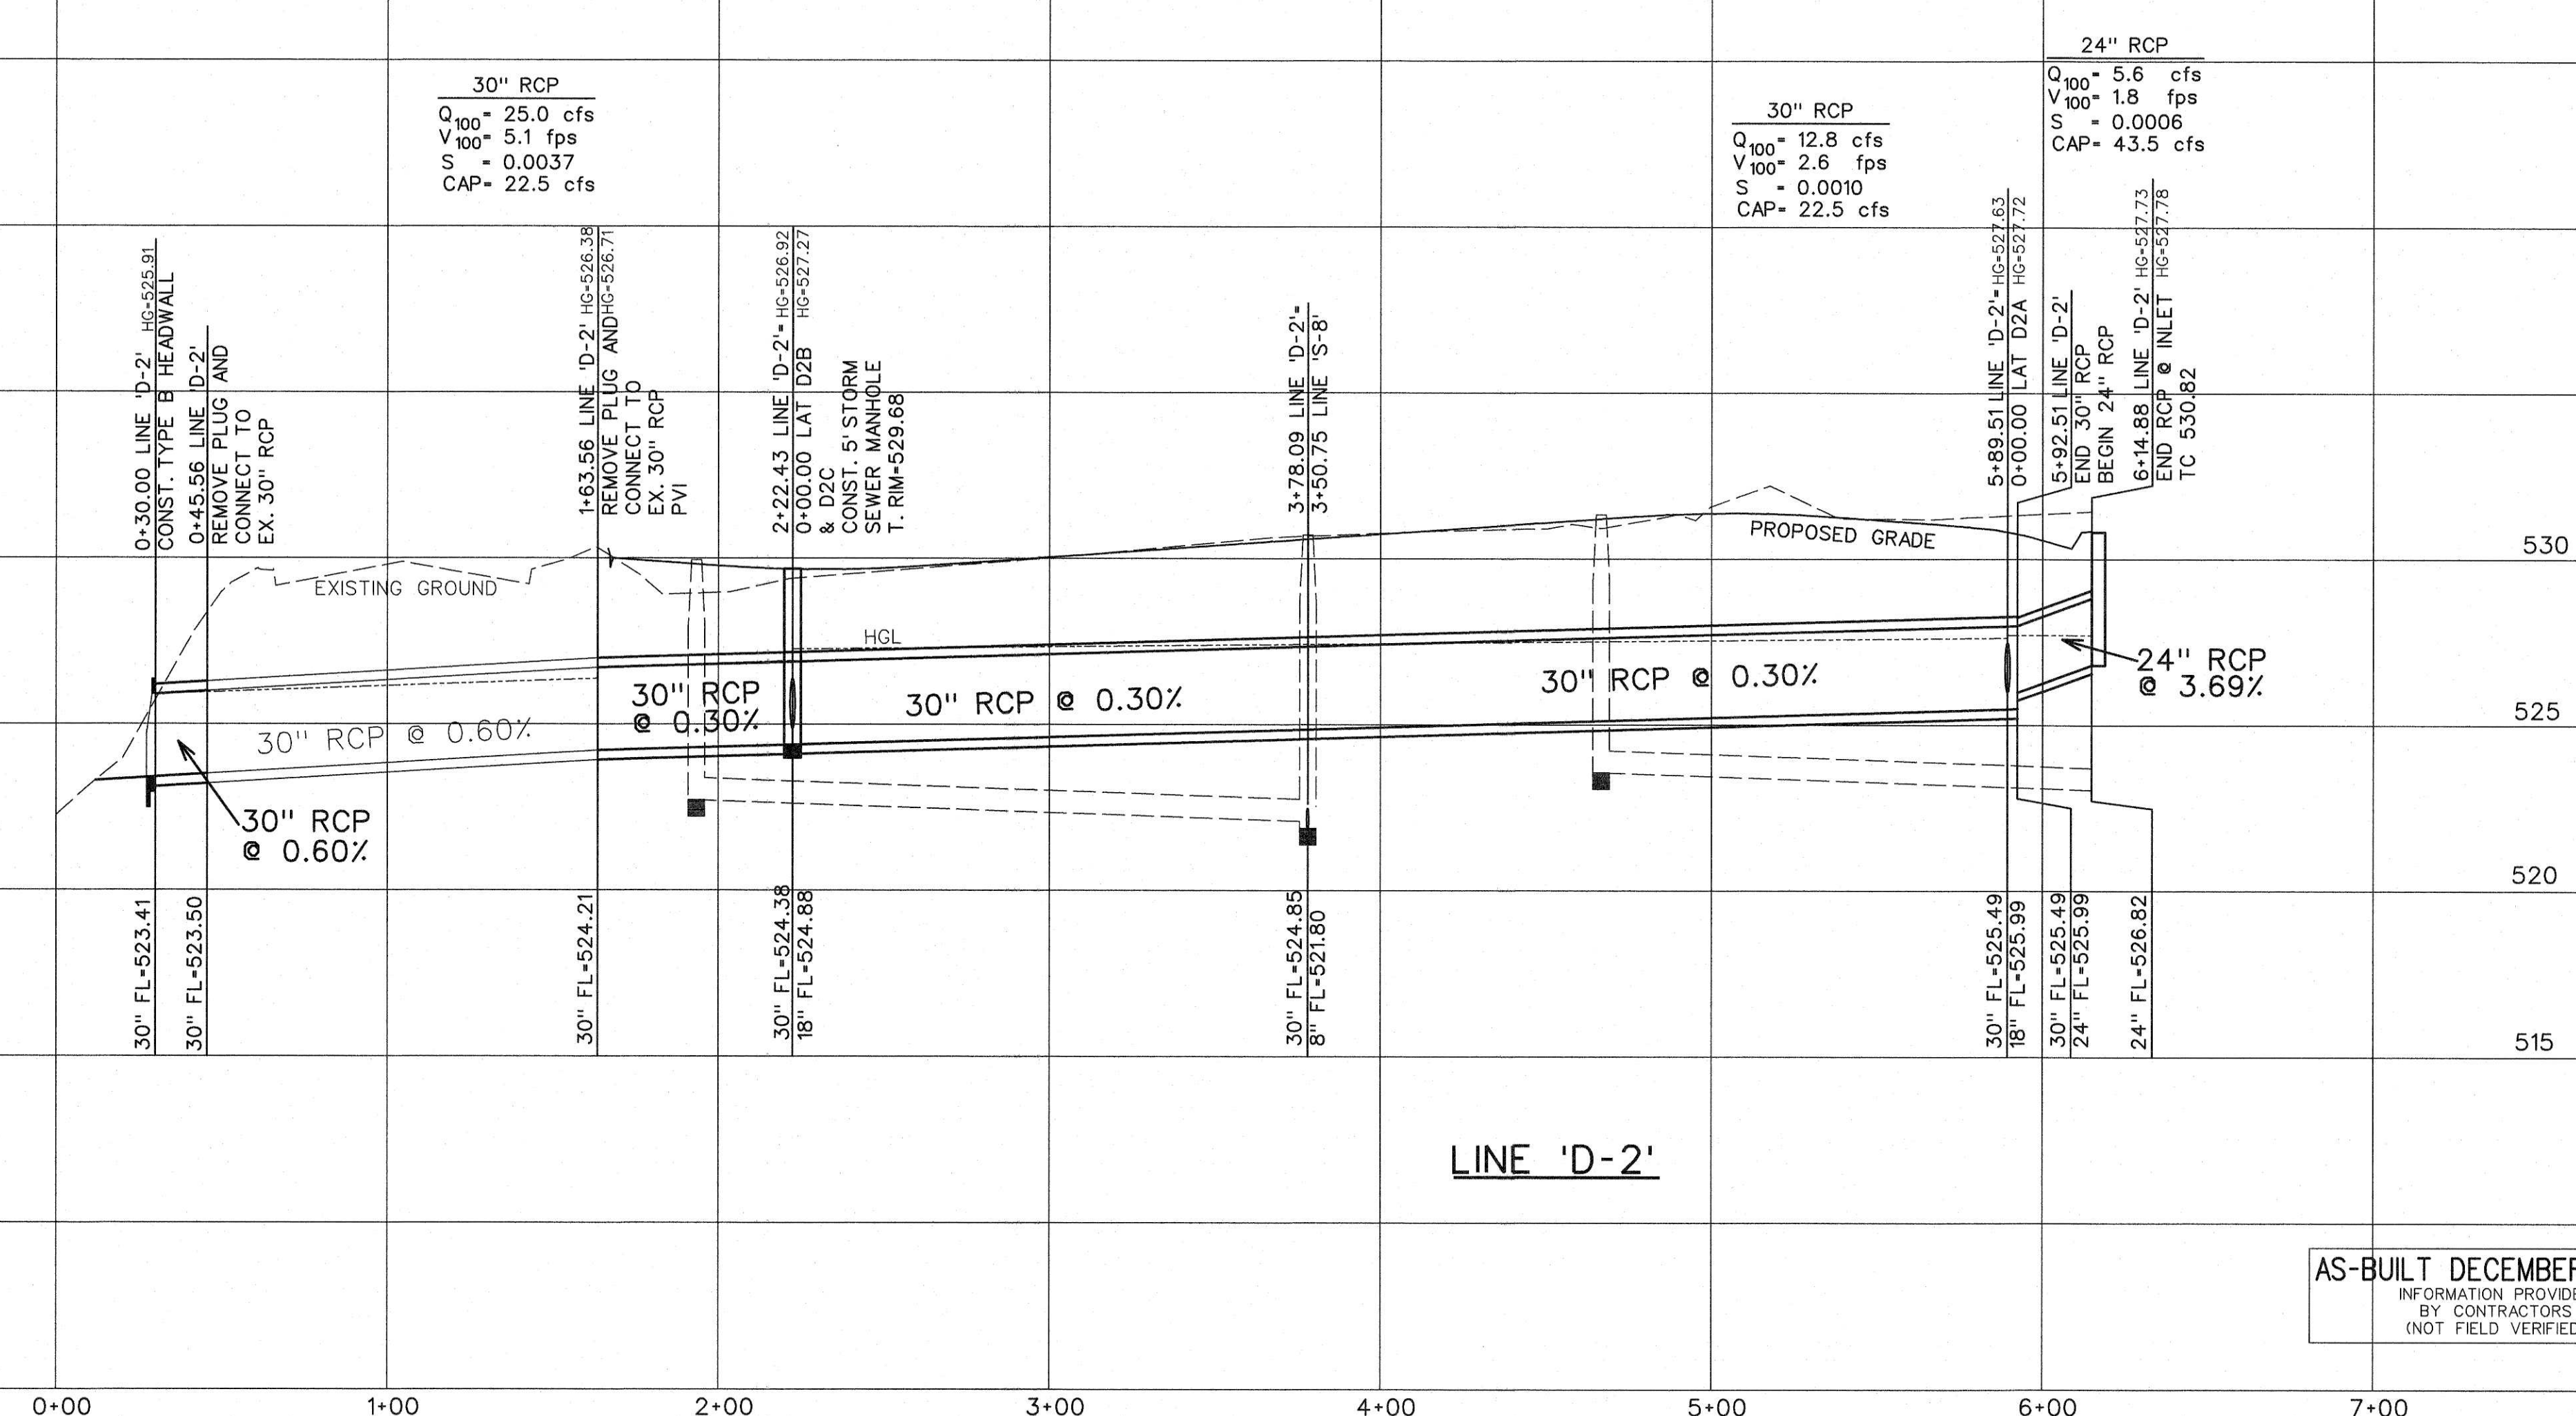

AS-BUILT DECEMBER 2020
INFORMATION PROVIDED
BY CONTRACTORS
(NOT FIELD VERIFIED)




CORWIN ENGINEERING, INC.
200 W. BELMONT, SUITE E
ALLEN, TEXAS 75013 (972)396-1200
TBPE FIRM #5951


DEVELOPMENT PLANS FOR
STONE CREEK
PHASE X
ROCKWALL, TEXAS

STORM SEWER PLAN AND PROFILE
LINE 'D-2'

DRAWN BY	DESIGNED BY	CHECKED BY	SHEET NO.
JOB NUMBER 19012	DATE MAY 2019	SCALE: HOR: 1"=40' VER: 1"=4'	20

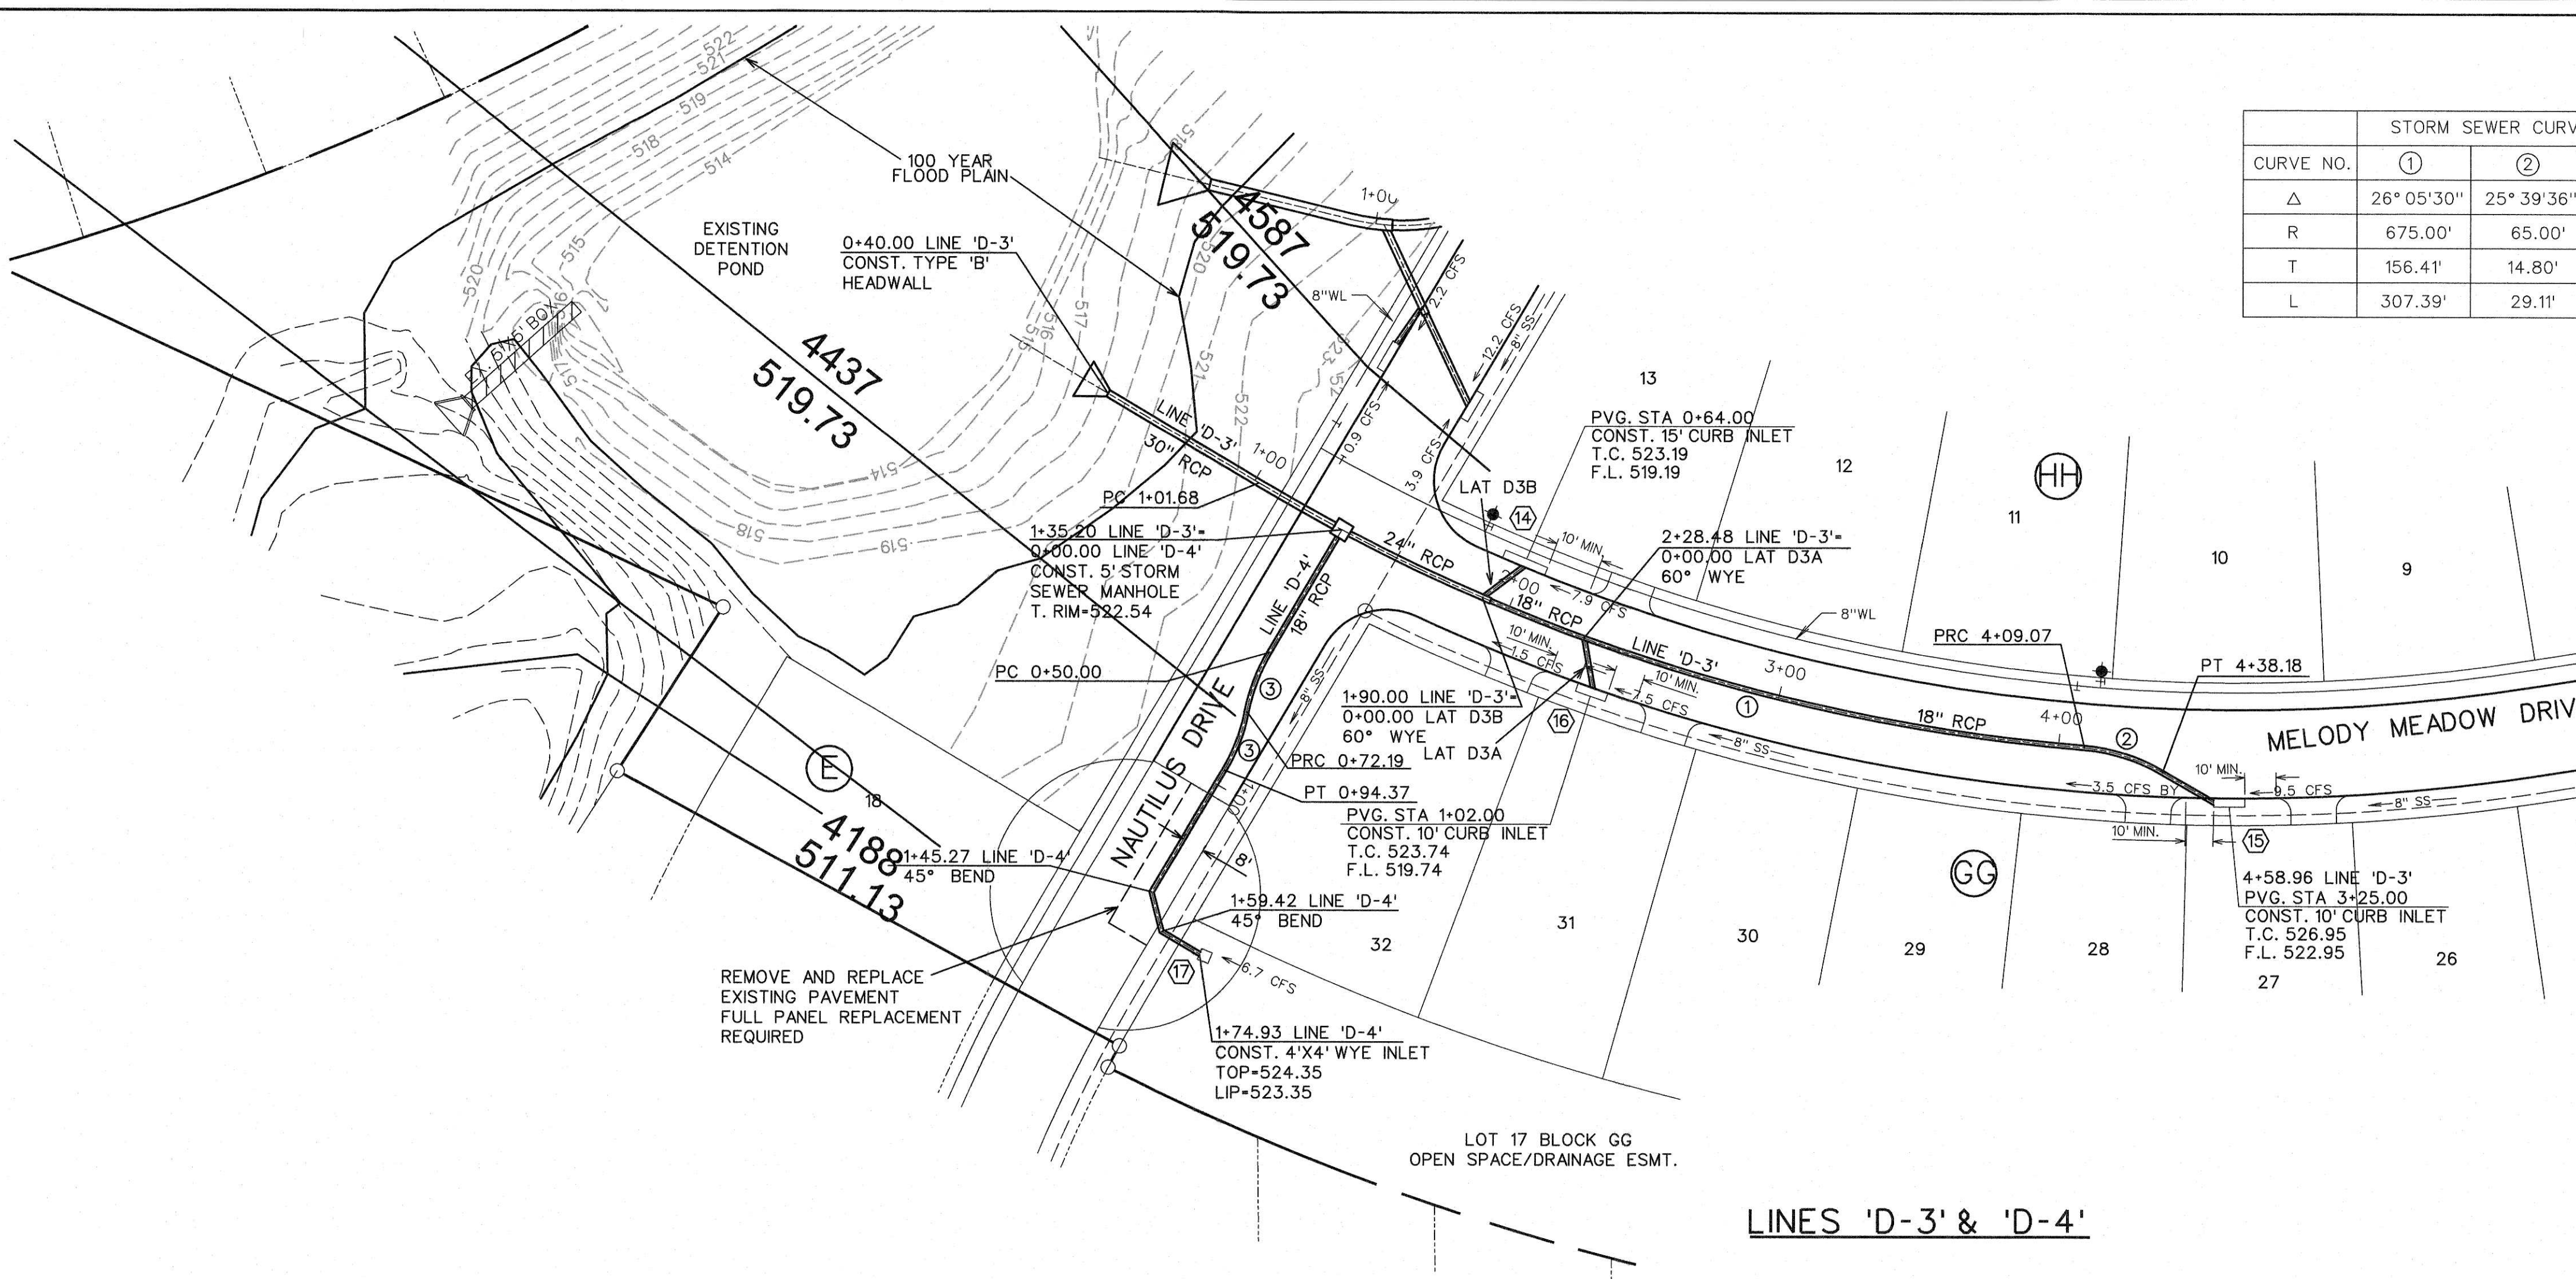


STORM SEWER CURVE DATA			
CURVE NO.	①	②	③
Δ	26° 05' 30"	25° 39' 36"	19° 33' 26"
R	675.00'	65.00'	65.00'
T	156.41'	14.80'	11.20'
L	307.39'	29.11'	22.19'

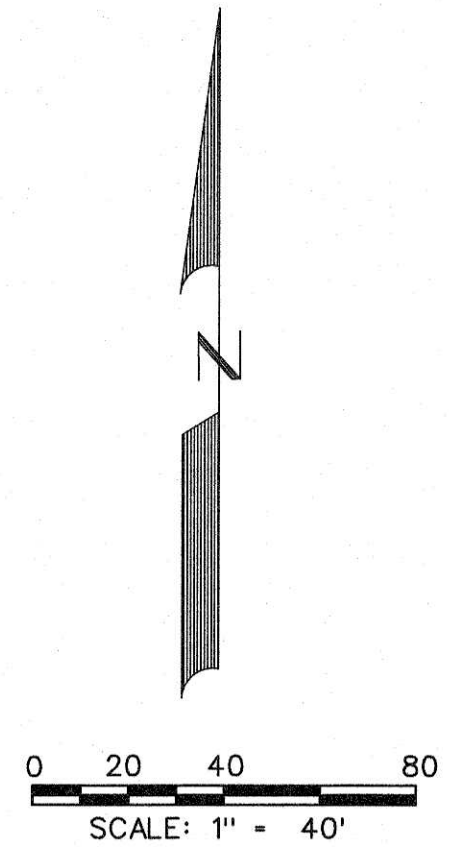

- LEGEND
- (B) - BLOCK LABEL
 - (19) - INLET NUMBER
 - ① - CURVE NUMBER
 - - SANITARY SEWER
 - ⬆ - WATER
 - == - PROPOSED STORM SEWER
 - - EXISTING STORM SEWER

LINES 'D-3' & 'D-4'

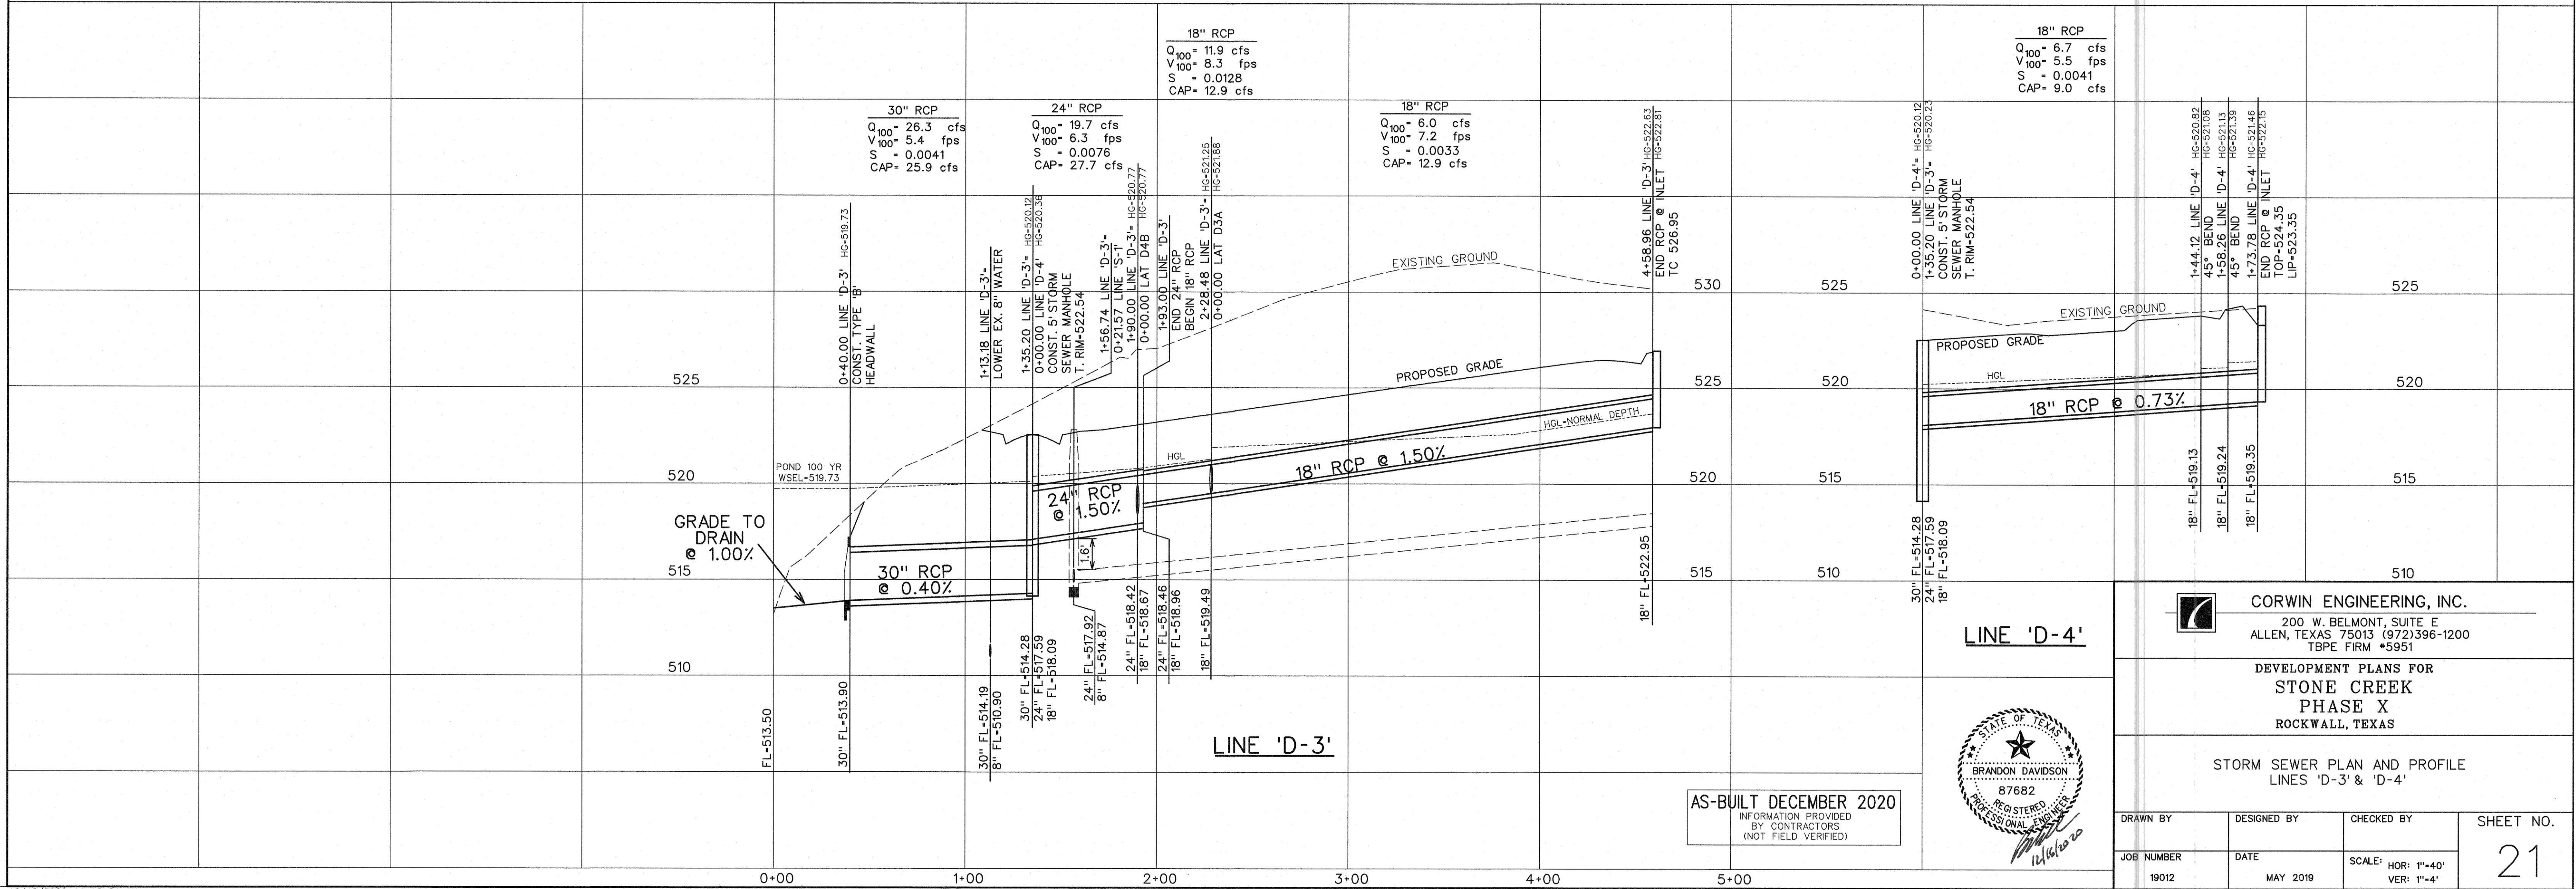

LINE 'D-4'

LINE 'D-3'

AS-BUILT DECEMBER 2020
INFORMATION PROVIDED
BY CONTRACTORS
(NOT FIELD VERIFIED)





CORWIN ENGINEERING, INC.
200 W. BELMONT, SUITE E
ALLEN, TEXAS 75013 (972)396-1200
TBPE FIRM #5951

DEVELOPMENT PLANS FOR
STONE CREEK
PHASE X
ROCKWALL, TEXAS


STORM SEWER PLAN AND PROFILE
LINES 'D-3' & 'D-4'

DRAWN BY	DESIGNED BY	CHECKED BY	SHEET NO.
JOB NUMBER	DATE	SCALE: HOR: 1"=40' VER: 1"=4'	21
19012	MAY 2019		

STORM SEWER CURVE DATA				
CURVE NO.	①	②	③	④
Δ	10° 52'52"	83° 28'24"	03° 04'00"	72° 55'14"
R	1150.00'	65.00'	341.50'	75.00'
T	109.53'	57.99'	9.14'	55.42'
L	218.40'	94.70'	18.28'	95.45'

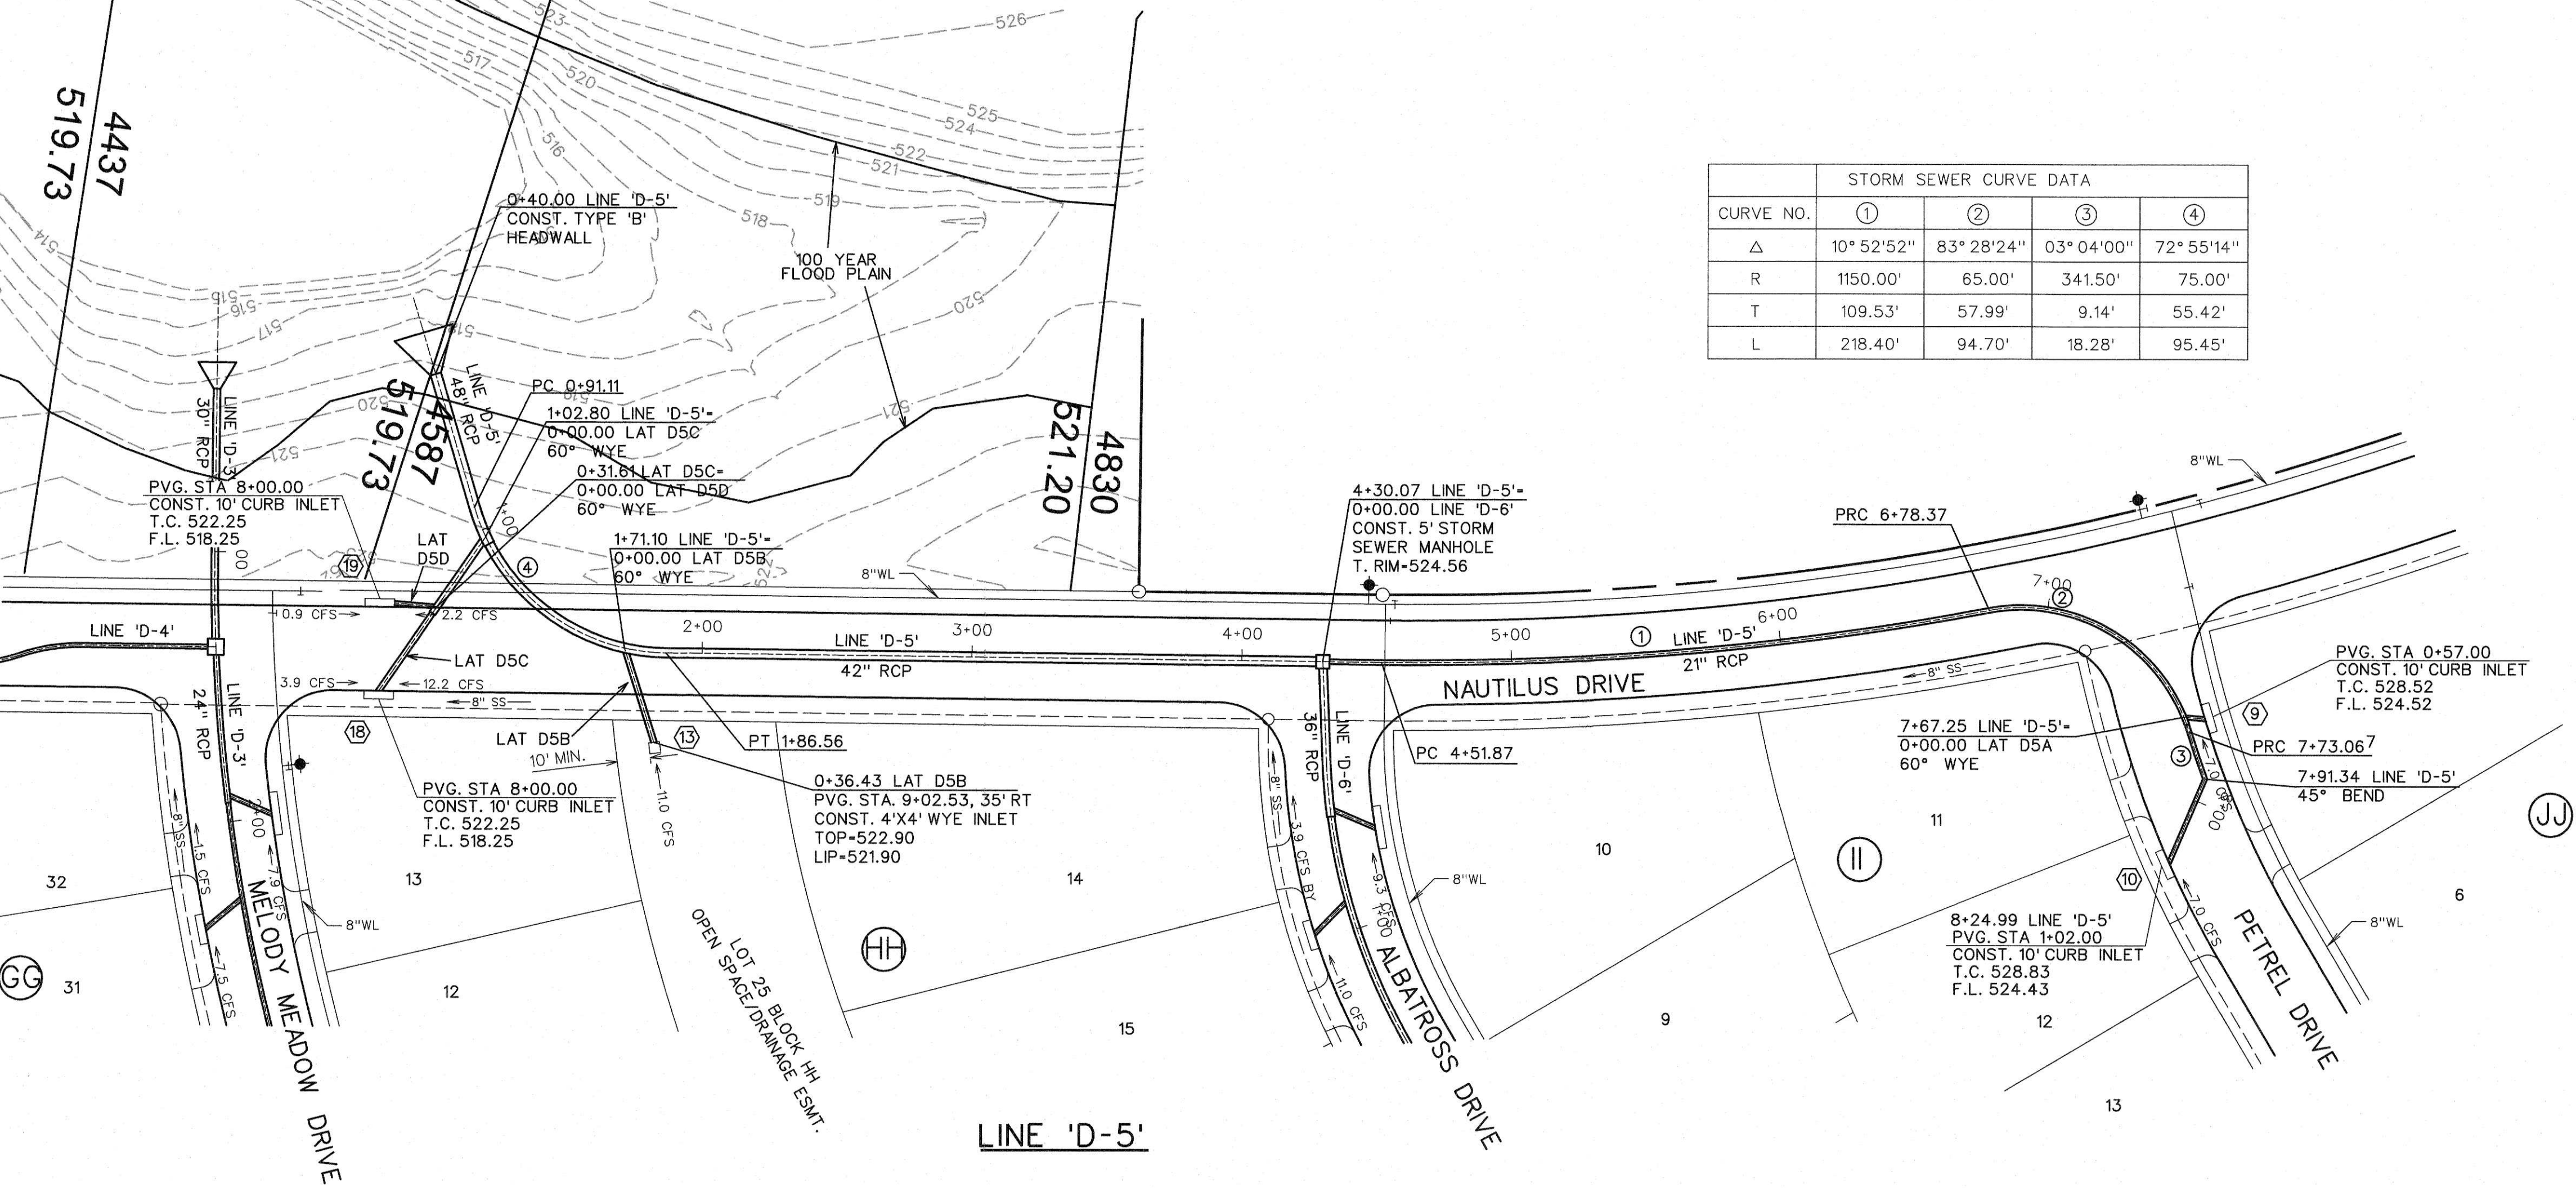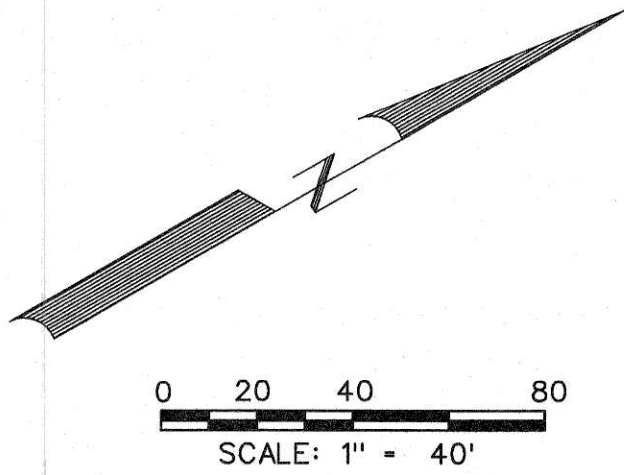

48" RCP Q ₁₀₀ = 81.8 cfs V ₁₀₀ = 6.5 fps S = 0.0032 CAP = 14.4 cfs	42" RCP Q ₁₀₀ = 63.2 cfs V ₁₀₀ = 6.6 fps S = 0.0039 CAP = 100 cfs	42" RCP Q ₁₀₀ = 52.9 cfs V ₁₀₀ = 9.0 fps S = 0.0028 CAP = 84.2 cfs	21" RCP Q ₁₀₀ = 14.0 cfs V ₁₀₀ = 5.8 fps S = 0.0078 CAP = 13.3 cfs	18" RCP Q ₁₀₀ = 7.0 cfs V ₁₀₀ = 9.0 fps S = 0.0044 CAP = 16.6 cfs
--	---	--	--	---

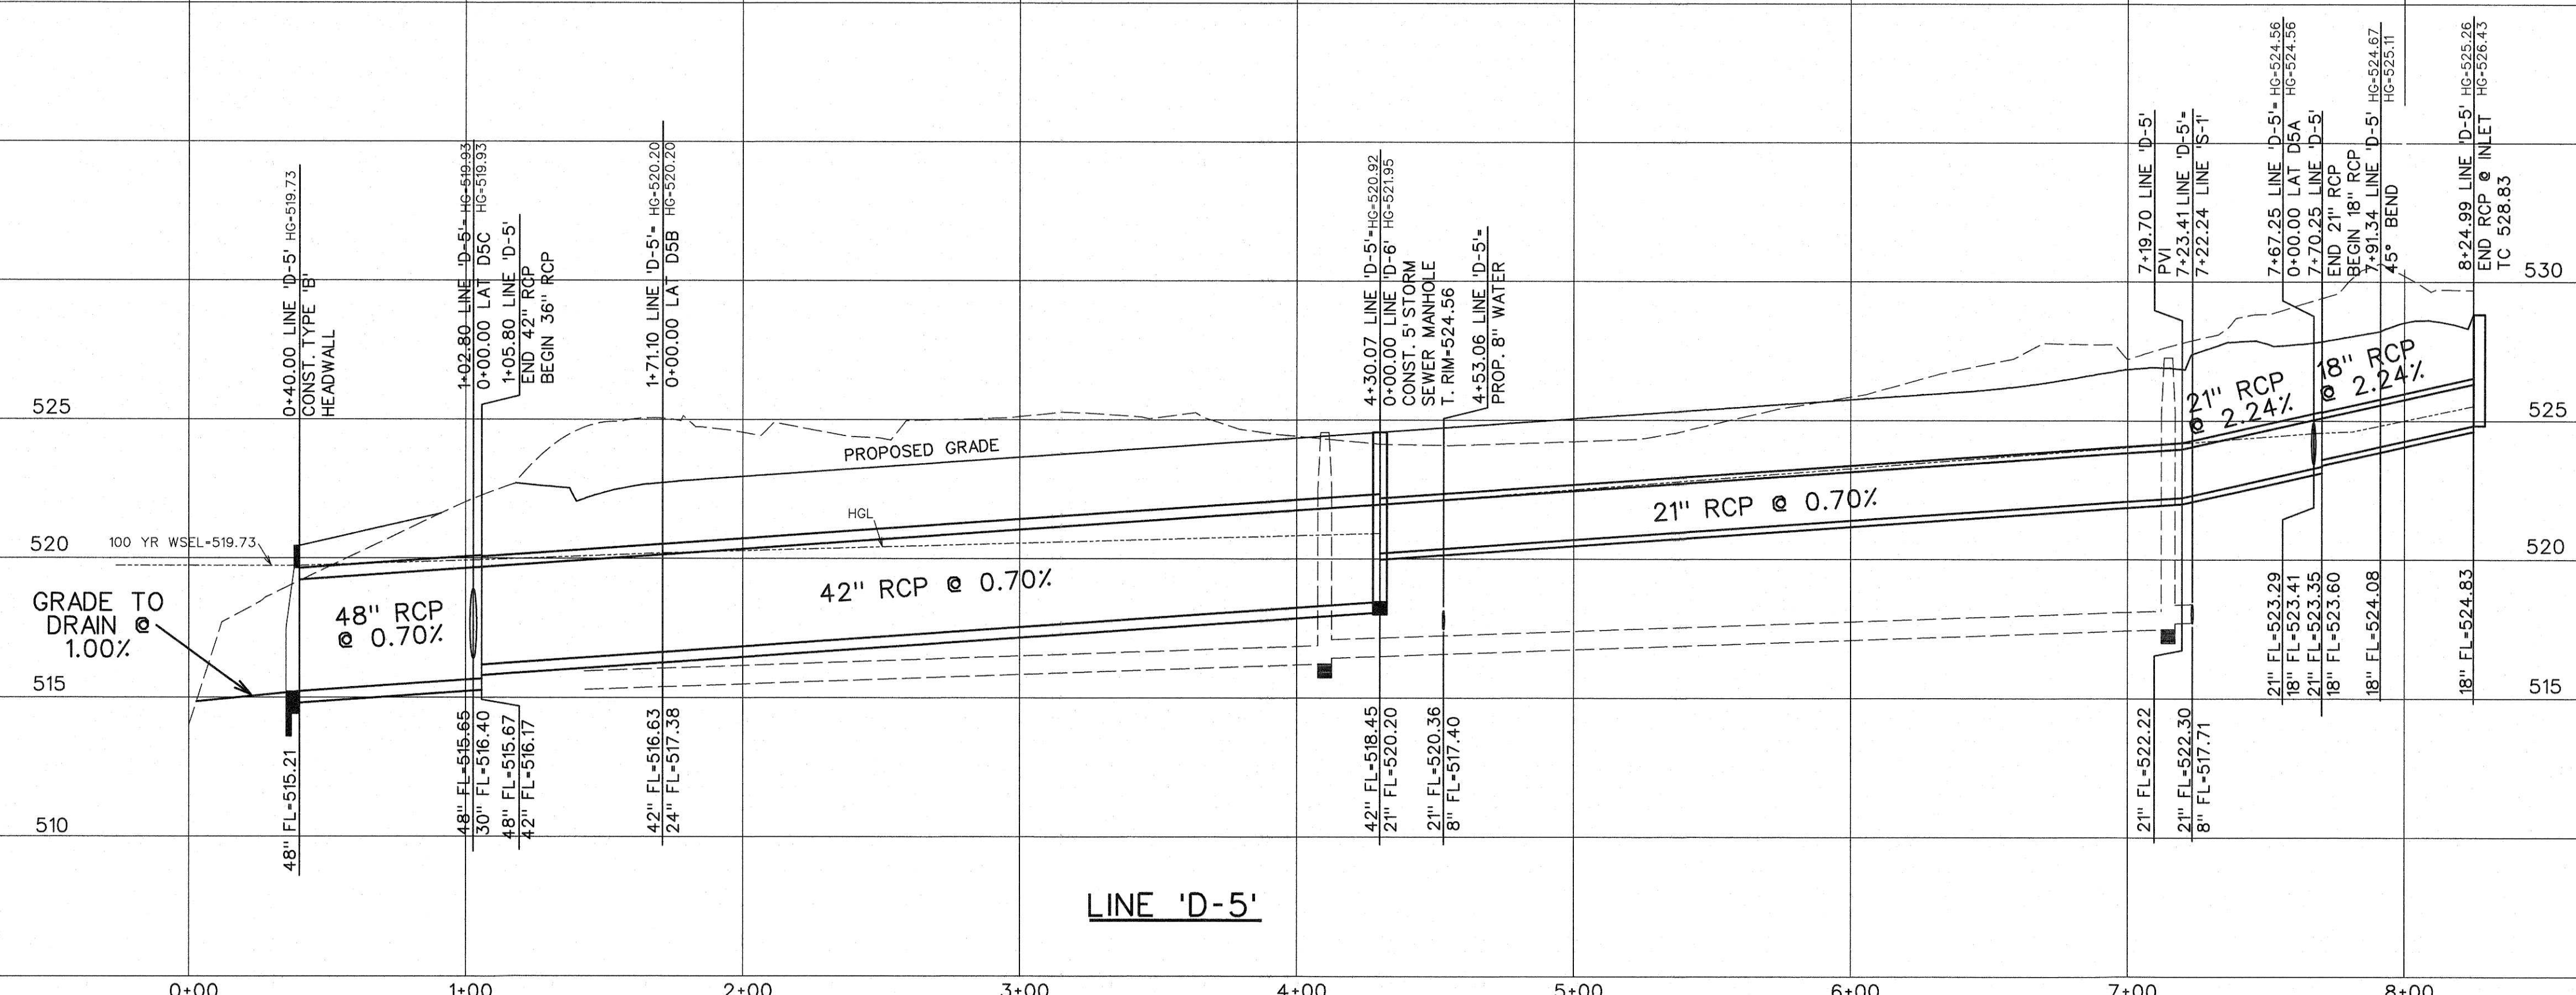

AS-BUILT DECEMBER 2020
INFORMATION PROVIDED
BY CONTRACTORS
(NOT FIELD VERIFIED)





CORWIN ENGINEERING, INC.
200 W. BELMONT, SUITE E
ALLEN, TEXAS 75013 (972)396-1200
TBP# FIRM #5951

DEVELOPMENT PLANS FOR
**STONE CREEK
PHASE X**
ROCKWALL, TEXAS

STORM SEWER PLAN AND PROFILE
LINE 'D-5'

DRAWN BY	DESIGNED BY	CHECKED BY	SHEET NO.
JOB NUMBER	DATE	SCALE: HOR: 1"=40' VER: 1"=4'	22
19012	MAY 2019		

STORM SEWER CURVE DATA			
CURVE NO.	①	②	③
Δ	28° 27'16"	60° 00'00"	49° 18'38"
R	225.00'	65.00'	65.00'
T	57.05'	37.53'	29.84'
L	111.74'	68.07'	55.94'

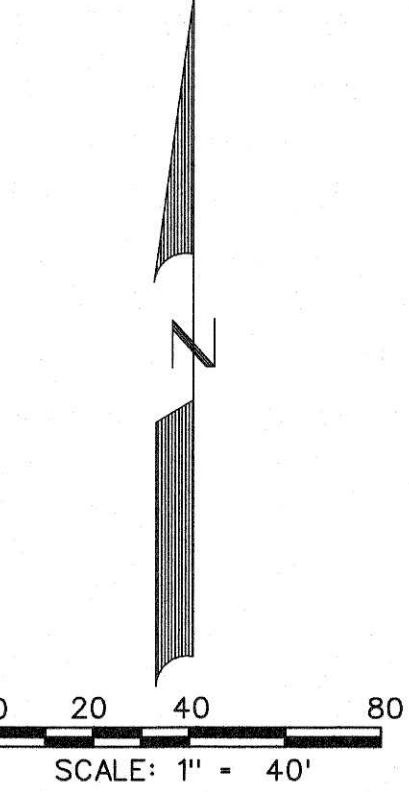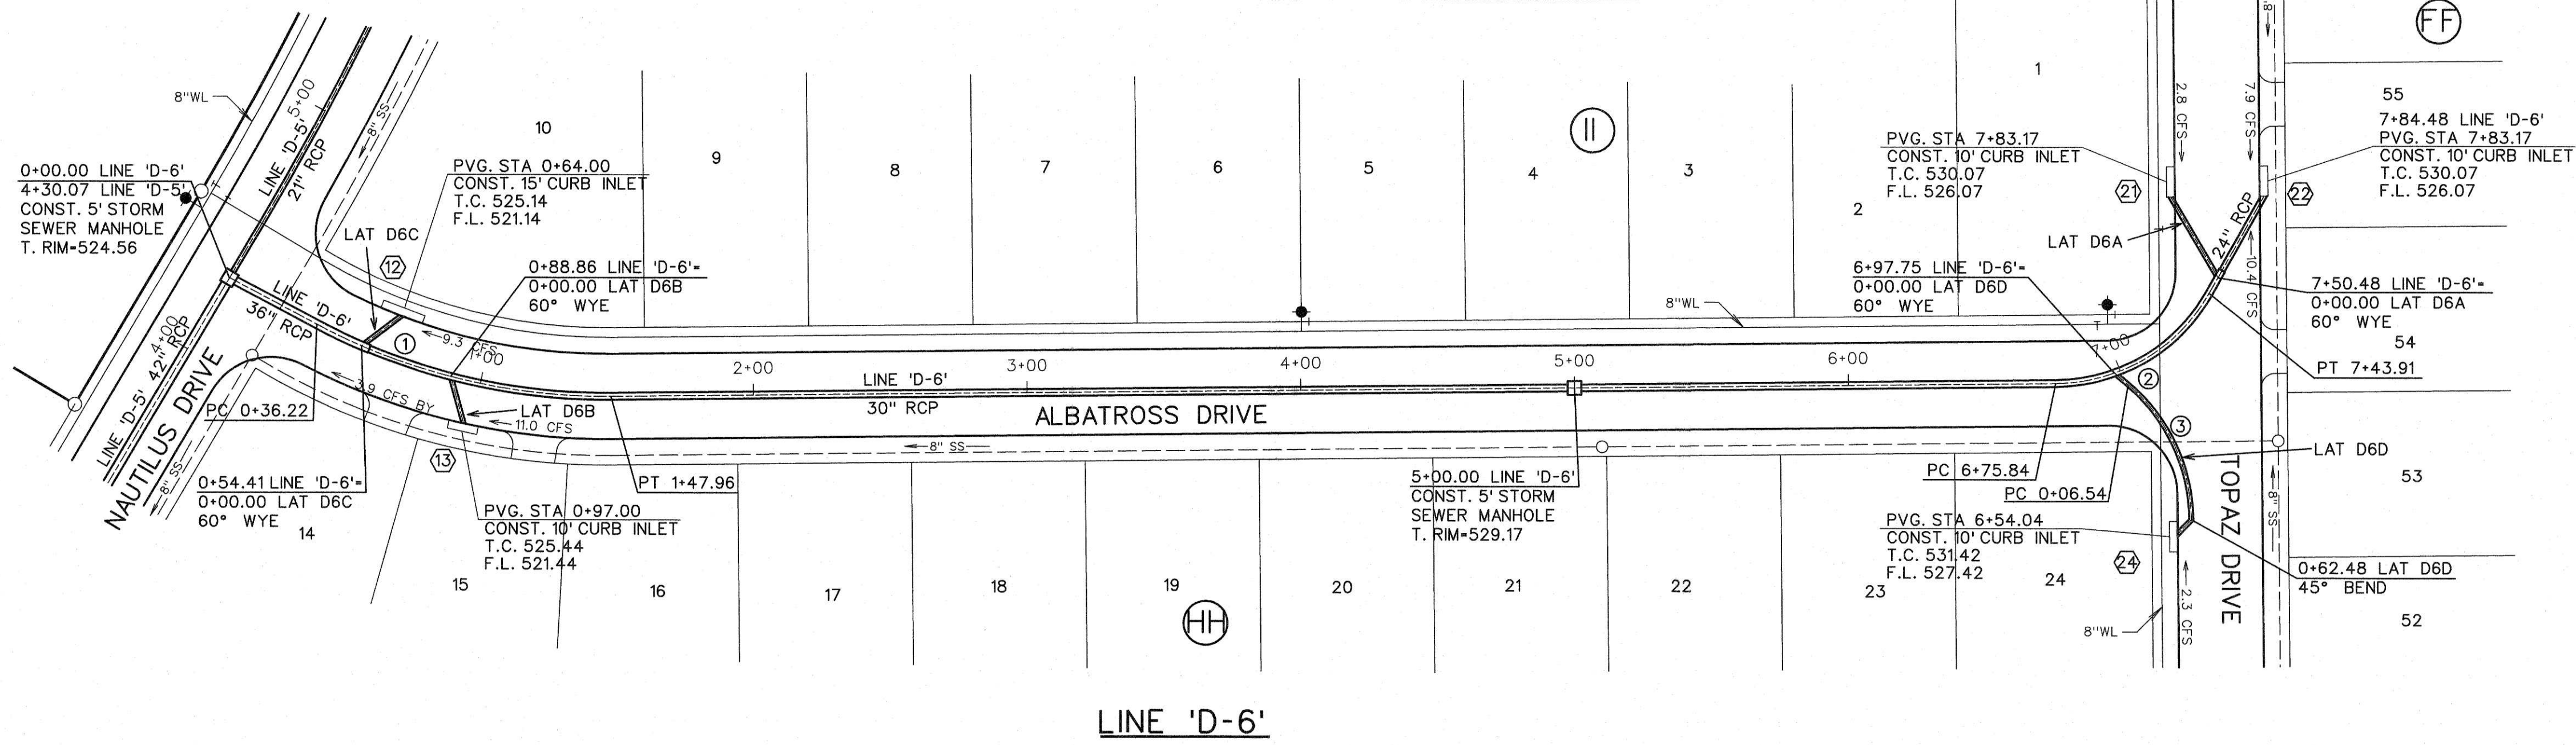


- LEGEND**
- (B) - BLOCK LABEL
 - (19) - INLET NUMBER
 - ① - CURVE NUMBER
 - - SANITARY SEWER
 - ⬮ - WATER
 - == - PROPOSED STORM SEWER
 - - EXISTING STORM SEWER

36" RCP 30" RCP
 $Q_{100} = 38.2 \text{ cfs}$ $Q_{100} = 29.4 \text{ cfs}$
 $V_{100} = 5.4 \text{ fps}$ $V_{100} = 6.0 \text{ fps}$
 $S = 0.0033$ $S = 0.0051$
 $CAP = 55.8 \text{ cfs}$ $CAP = 34.3 \text{ cfs}$

30" RCP
 $Q_{100} = 23.4 \text{ cfs}$
 $V_{100} = 4.8 \text{ fps}$
 $S = 0.0032$
 $CAP = 34.3 \text{ cfs}$

24" RCP
 $Q_{100} = 18.3 \text{ cfs}$
 $V_{100} = 5.8 \text{ fps}$
 $S = 0.0065$
 $CAP = 18.9 \text{ cfs}$

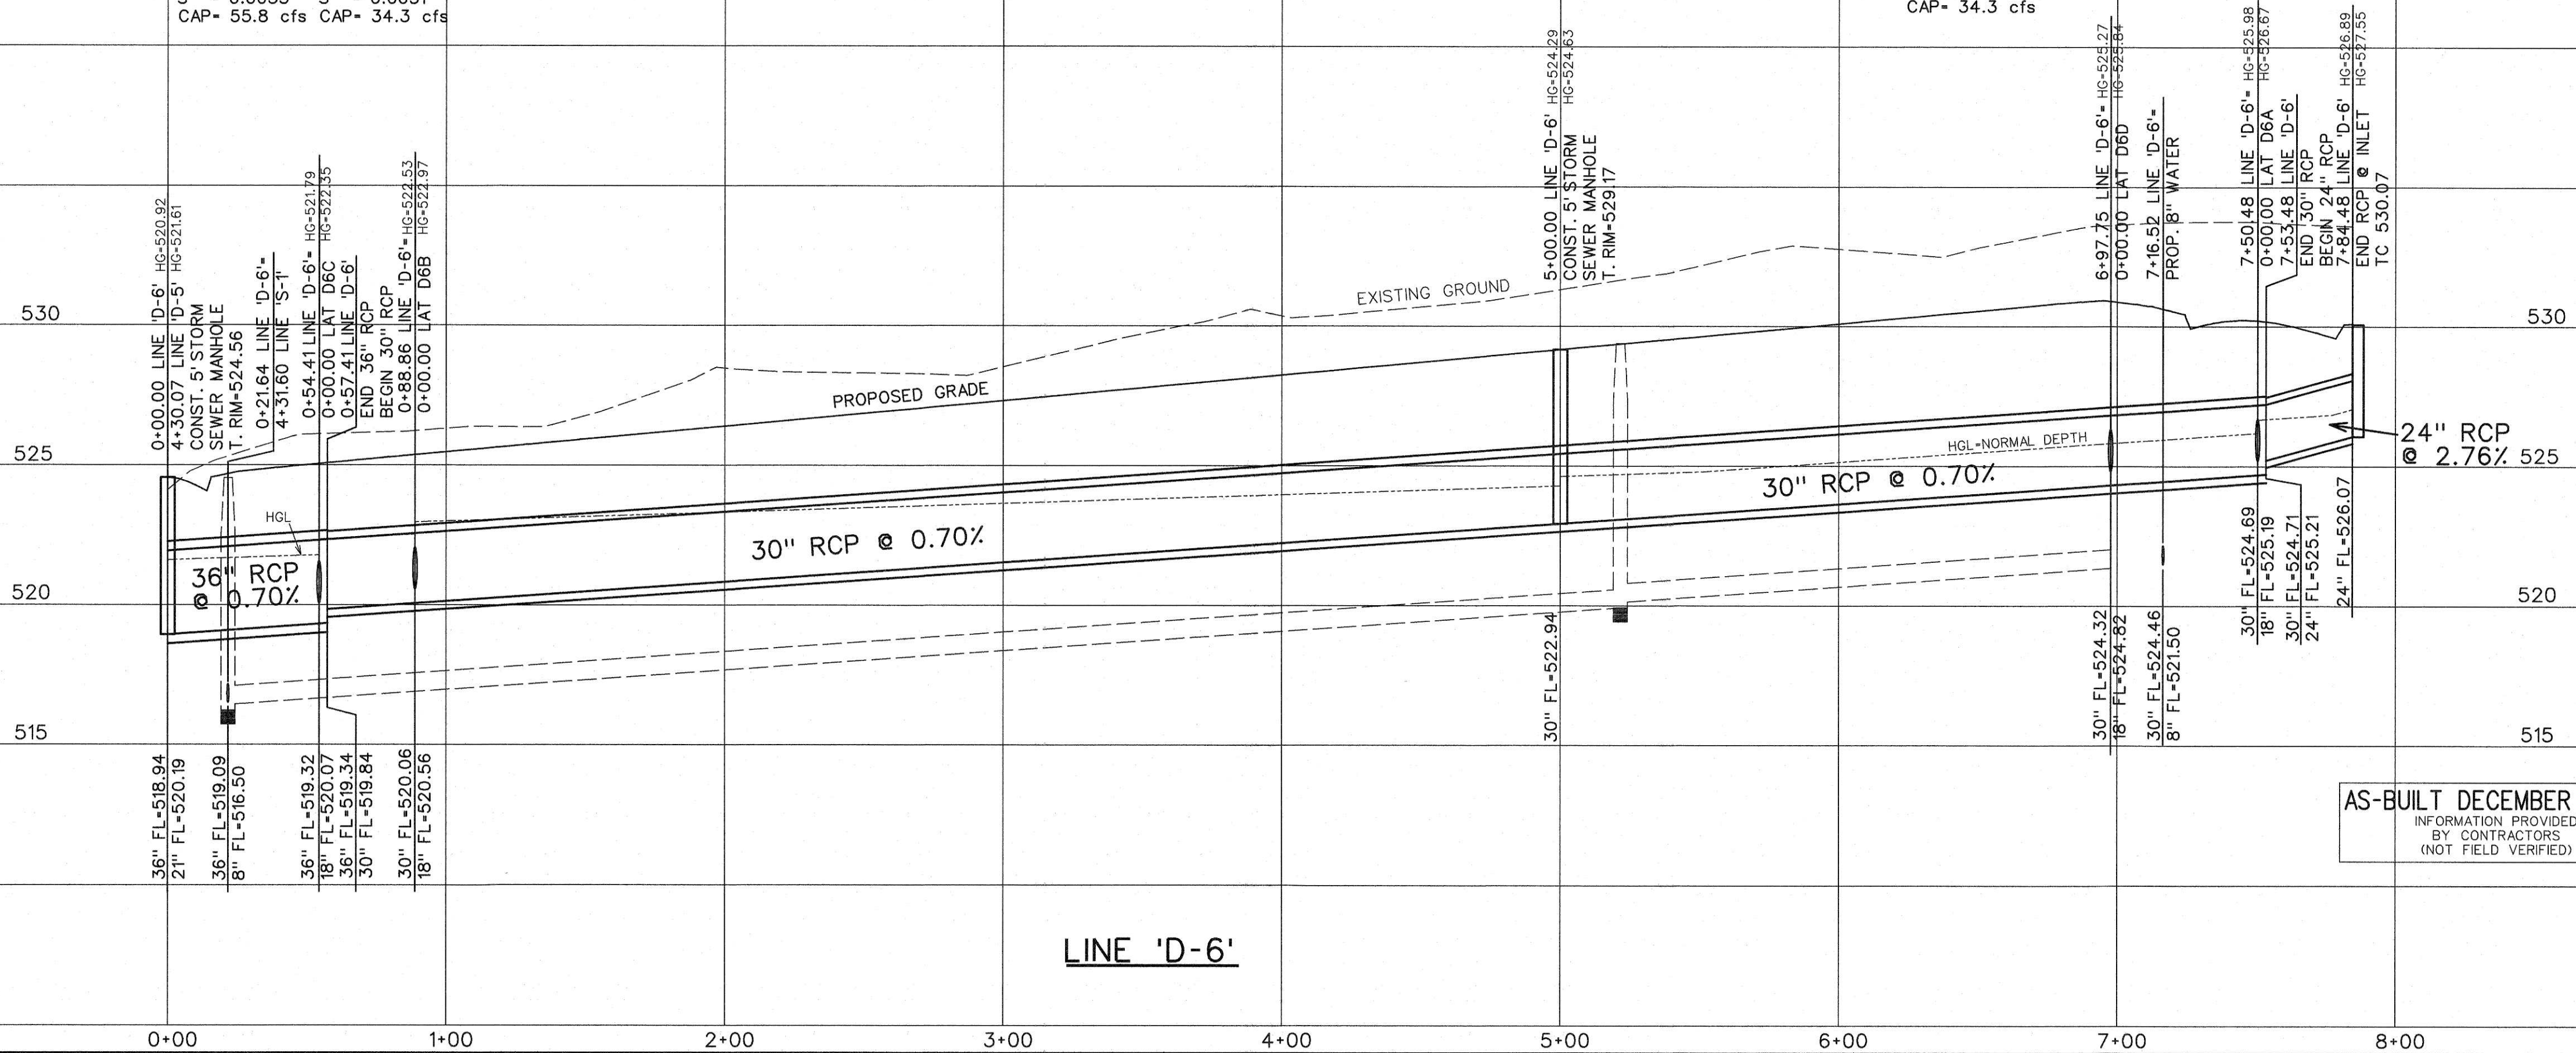

AS-BUILT DECEMBER 2020
 INFORMATION PROVIDED
 BY CONTRACTORS
 (NOT FIELD VERIFIED)




CORWIN ENGINEERING, INC.
 200 W. BELMONT, SUITE E
 ALLEN, TEXAS 75013 (972)396-1200
 TBPE FIRM #5951

DEVELOPMENT PLANS FOR
STONE CREEK
 PHASE X
 ROCKWALL, TEXAS

STORM SEWER PLAN AND PROFILE
 LINE 'D-6'

DRAWN BY	DESIGNED BY	CHECKED BY	SHEET NO.
JOB NUMBER	DATE	SCALE: HOR: 1"=40'	23
19012	MAY 2019	VER: 1"=4'	

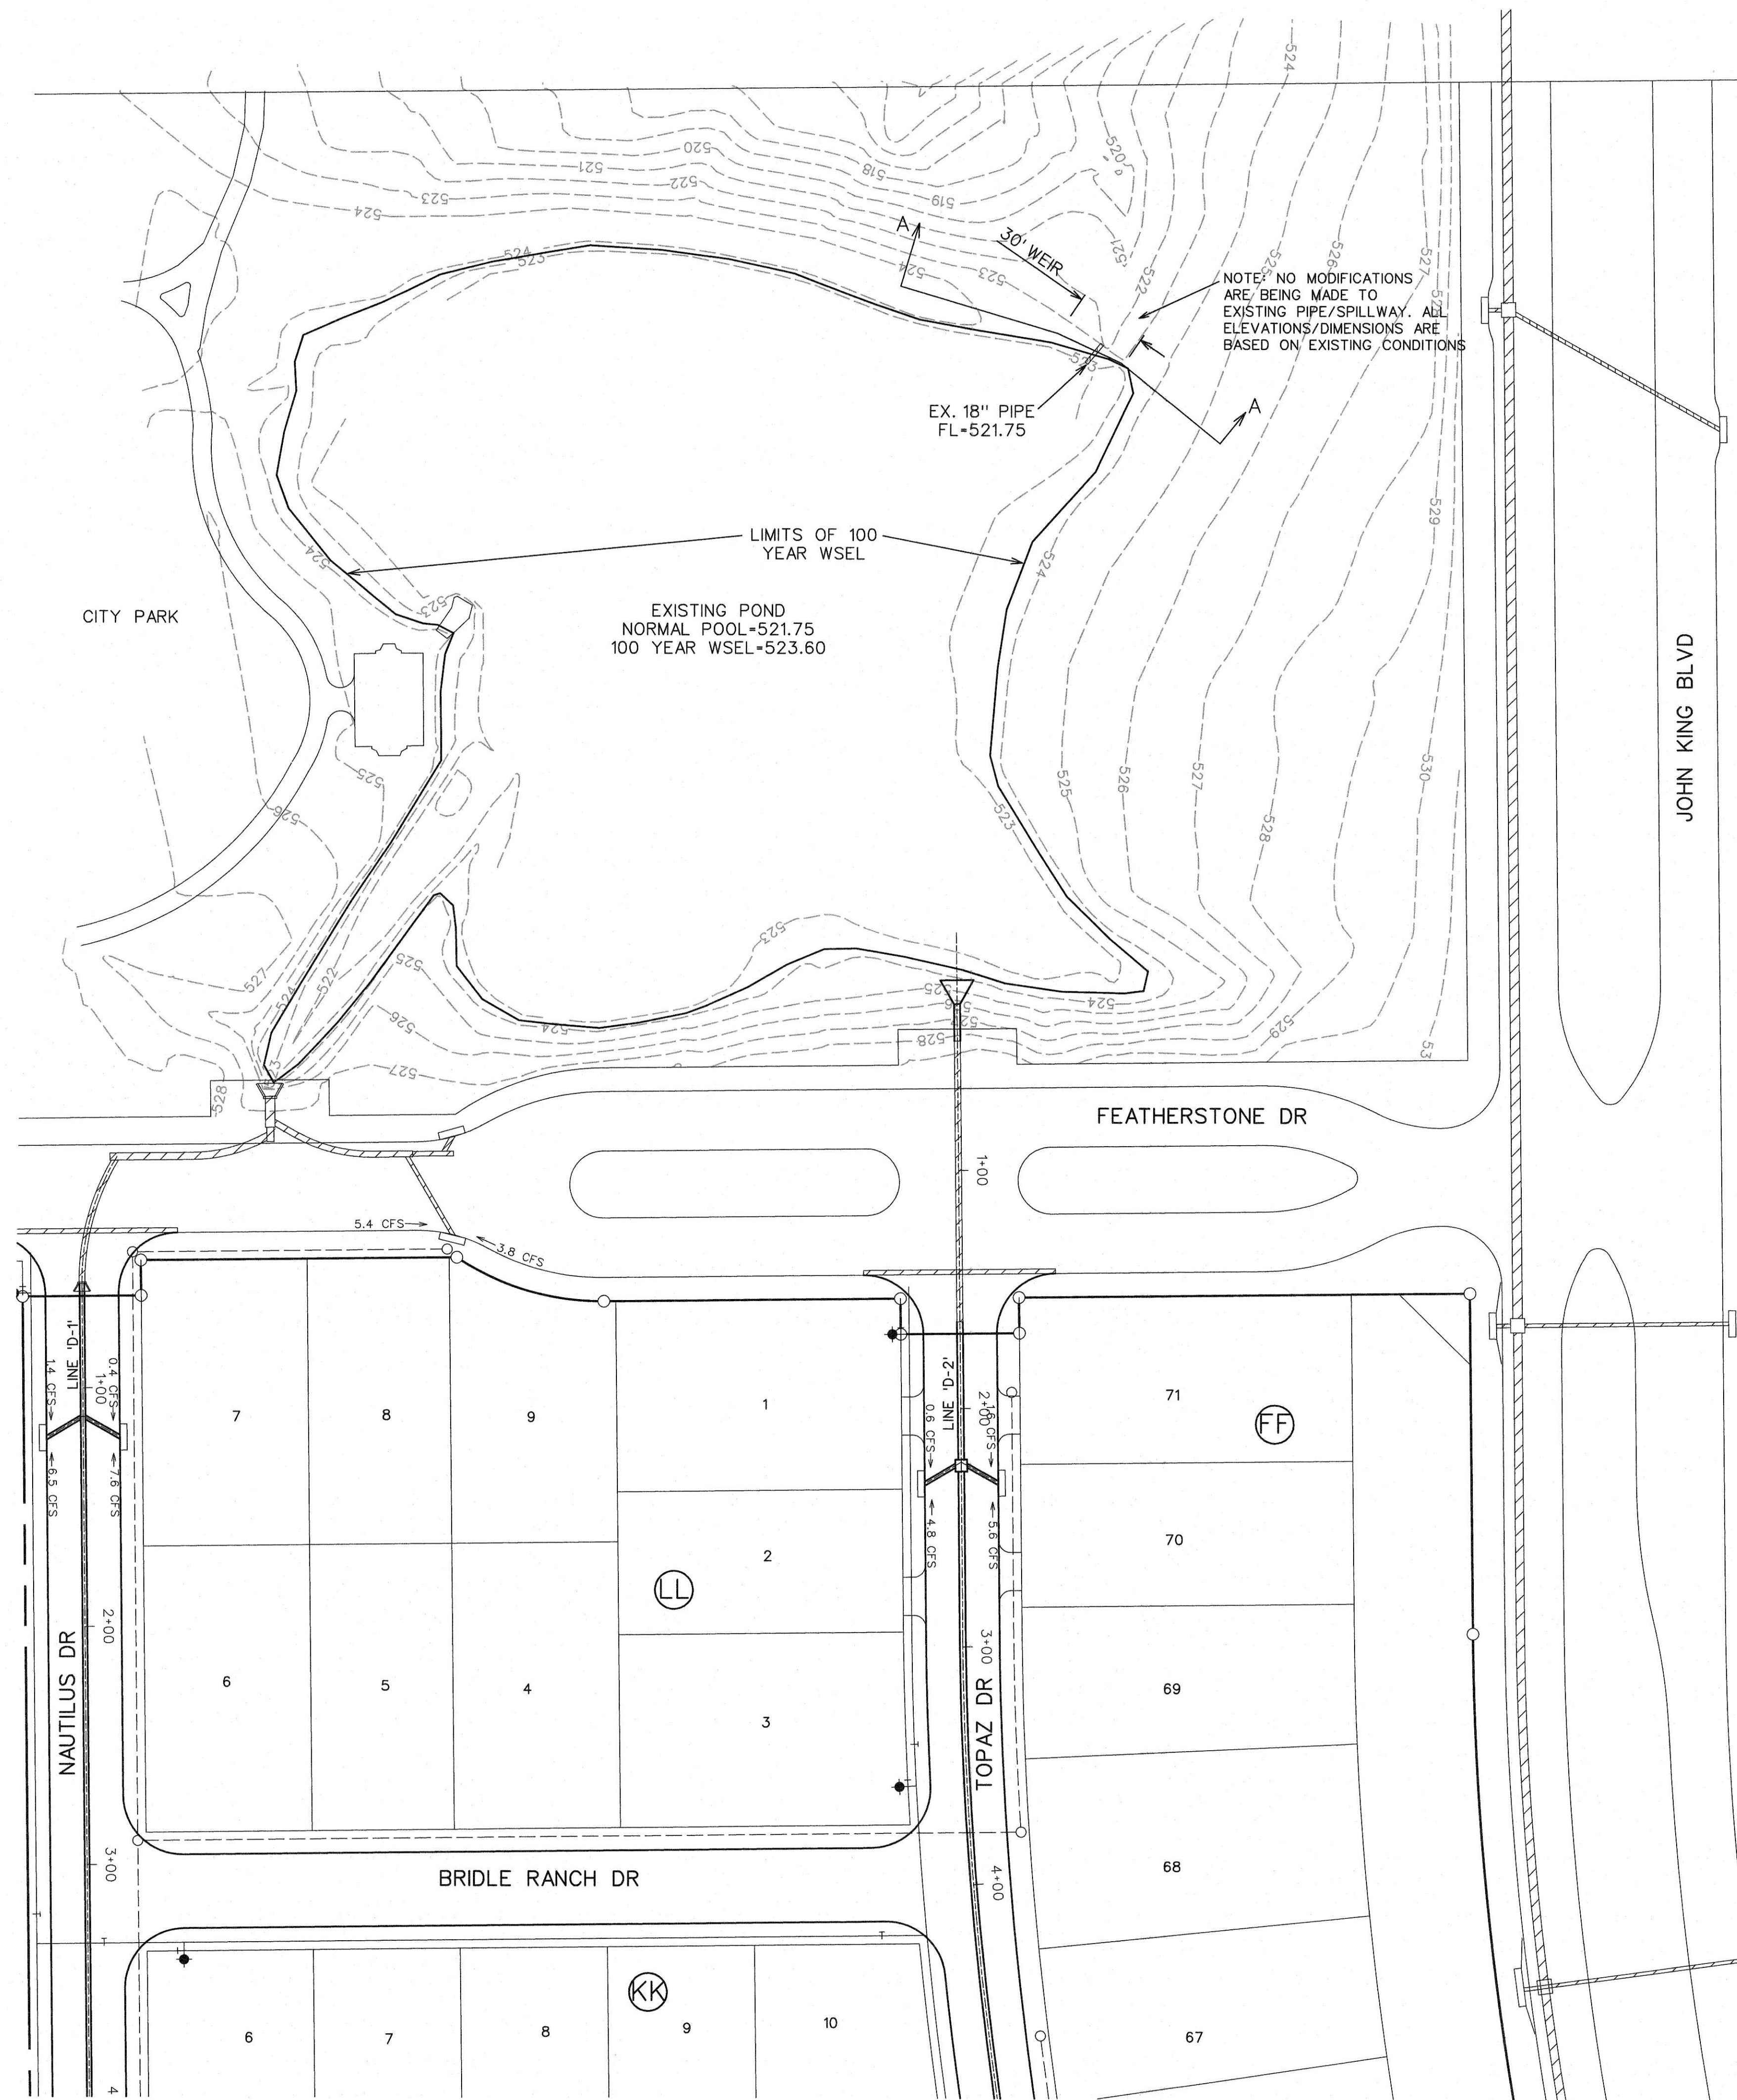

Stone Creek Phase 10 Existing Pond on City Park

5-Year storm
Pre-Project Runoff Calculations

Area #	Area (sf)	Area (acres)	Existing Runoff Coefficient	Tc - Existing (min)	Rainfall Intensity (in/hr)	Q - Undeveloped (cfs)
EXT-EX4	920591	21.13	0.37	20	4.9	38.7

Allowed Release = 38.7

Post-Project Runoff Calculations

Area #	Area (sf)	Area (acres)	Proposed Runoff Coefficient	Tc - Existing (min)	Rainfall Intensity (in/hr)	Q - Post Development (cfs)
1-8.22 EX1-2.3A	1020858	23.44	0.44	10	6.1	82.4

10-Year storm
Pre-Project Runoff Calculations

Area #	Area (sf)	Area (acres)	Existing Runoff Coefficient	Tc - Existing (min)	Rainfall Intensity (in/hr)	Q - Undeveloped (cfs)
EXT-EX4	920591	21.13	0.37	20	5.9	46.6

Allowed Release = 46.6

Post-Project Runoff Calculations

Area #	Area (sf)	Area (acres)	Proposed Runoff Coefficient	Tc - Existing (min)	Rainfall Intensity (in/hr)	Q - Post Development (cfs)
1-8.22 EX1-2.3A	1020858	23.44	0.44	10	7.1	72.6

25-Year storm
Pre-Project Runoff Calculations

Area #	Area (sf)	Area (acres)	Existing Runoff Coefficient	Tc - Existing (min)	Rainfall Intensity (in/hr)	Q - Undeveloped (cfs)
EXT-EX4	920591	21.13	0.37	20	6.6	52.2

Allowed Release = 52.2

Post-Project Runoff Calculations

Area #	Area (sf)	Area (acres)	Proposed Runoff Coefficient	Tc - Existing (min)	Rainfall Intensity (in/hr)	Q - Post Development (cfs)
1-8.22 EX1-2.3A	1020858	23.44	0.44	10	8.3	84.9

50-Year storm
Pre-Project Runoff Calculations

Area #	Area (sf)	Area (acres)	Existing Runoff Coefficient	Tc - Existing (min)	Rainfall Intensity (in/hr)	Q - Undeveloped (cfs)
EXT-EX4	920591	21.13	0.37	20	7.5	59.3

Allowed Release = 59.3

Post-Project Runoff Calculations

Area #	Area (sf)	Area (acres)	Proposed Runoff Coefficient	Tc - Existing (min)	Rainfall Intensity (in/hr)	Q - Post Development (cfs)
1-8.22 EX1-2.3A	1020858	23.44	0.44	10	9	92.1

100-Year storm
Pre-Project Runoff Calculations

Area #	Area (sf)	Area (acres)	Existing Runoff Coefficient	Tc - Existing (min)	Rainfall Intensity (in/hr)	Q - Undeveloped (cfs)
EXT-EX4	920591	21.13	0.37	20	8.3	65.6

Allowed Release = 65.6

Post-Project Runoff Calculations

Area #	Area (sf)	Area (acres)	Proposed Runoff Coefficient	Tc - Existing (min)	Rainfall Intensity (in/hr)	Q - Post Development (cfs)
1-8.22 EX1-2.3A	1020858	23.44	0.44	10	9.8	100.2

Stage-Discharge Table

Stage	H	Office 1	Discharge	Weir	Depth of Flow	Weir	Actual	Allowable	Storm
Stage	H	Office 1	Discharge	Weir	Depth of Flow	Weir	Actual	Allowable	Storm
S21.75	0	0	0	0	0	0	0	0	0
S22.00	0.13	0.19	0.3	0	0	0	0.3	0	0
S23.35	0.80	0.83	2.7	30.0	0.1	2.8	5.4	38.7	5-year
S23.49	0.87	0.72	3.2	30.0	0.2	9.5	12.7	46.6	10-year
S23.50	0.88	0.85	3.8	30.0	0.3	10.0	15.8	52.2	25-year
S23.56	0.90	1.05	4.8	30.0	0.3	13.6	18.4	59.3	50-year
S23.61	0.93	1.18	5.5	30.0	0.4	17.0	22.5	65.6	100-year
S24.00	1.13	1.57	9.0	30.0	0.8	51.2	59.3		
S24.30	1.27	1.77	9.8	30.0	1.0	84.9	65.6		
S24.60	1.43	1.77	10.2	30.0	1.4	123.8	133.9		

THE STAGE-DISCHARGE TABLE IS BASED ON THE EXISTING PIPE OUTFALL AND POND SPILLWAY


Elevation Calculations

Event	Maximum Release Rate	Storage Requirement	Occurs at Elevation
5-year	5.4	103499	523.35
10-year	12.7	114889	523.49
25-year	13.8	115915	523.50
50-year	18.4	129123	523.56
100-year	22.5	132462	523.61

Elevation-Storage Table

Elevation (sf)	Volume
521.75	0
522.00	7950
523.00	74584
524.00	156090
524.60	216915

ELEVATION-STORAGE TABLE IS BASED ON EXISTING POND

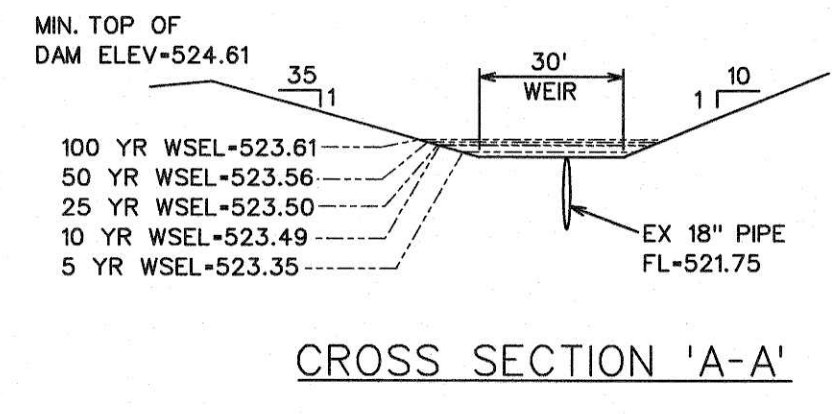

CROSS SECTION 'A-A'

DETENTION STORAGE CALCULATIONS - 5 Year												
Storm Duration	Outflow Duration	Area (Ac.)	Future "C"	Future "R"	Future "D"	Rainfall Intensity	Inflow (cfs)	Inflow Volume (cubic ft.)	Outflow Volume (cubic ft.)	Volume (acre-ft.)	Outflow (cfs)	
10	30	23.44	0.44	1.00	10.23	6.10	82.4	37435	4830	52605	6.75	5.4
20	40	23.44	0.44	1.00	10.23	4.90	53.1	40741	8041	53792	1.23	5.4
30	50	23.44	0.44	1.00	10.23	4.10	41.9	75284	8049	67434	1.55	5.4
40	60	23.44	0.44	1.00	10.23	3.40	34.8	8381	9559	73862	1.65	5.4
50	70	23.44	0.44	1.00	10.23	2.80	28.8	85916	11269	74447	1.71	5.4
60	80	23.44	0.44	1.00	10.23	2.60	26.8	85735	10879	75286	1.90	5.4
70	90	23.44	0.44	1.00	10.23	2.40	24.5	100999	14489	88511	2.60	5.4
80	100	23.44	0.44	1.00	10.23	2.30	23.5	112918	16099	96880	2.22	5.4
90	110	23.44	0.44	1.00	10.23	2.10	21.5	115807	17709	98278	2.26	5.4
100	120	23.44	0.44	1.00	10.23	1.90	19.4	116901	19319	97282	2.23	5.4
110	130	23.44	0.44	1.00	10.23	1.80	18.4	121510	20928	100582	2.31	5.4
120	140	23.44	0.44	1.00	10.23	1.74	17.4	125192	22538	103554	2.36	5.4
130	150	23.44	0.44	1.00	10.23	1.60	16.4	127847	24148	104493	2.38	5.4
140	160	23.44	0.44	1.00	10.23	1.50	15.3	128974	25758	103116	2.37	5.4
150	170	23.44	0.44	1.00	10.23	1.40	14.3	128974	27368	101506	2.33	5.4

DETENTION STORAGE CALCULATIONS - 10 Year												
Storm Duration	Outflow Duration	Area (Ac.)	Future "C"	Future "R"	Future "CA"	Rainfall Intensity	Inflow Volume (cubic ft.)	Outflow Volume (cubic ft.)	Volume (cubic ft.)	Volume (acre-ft.)	Outflow (cfs)	
10	20	23.44	0.44	1.00	10.23	7.10	728	43572	7688	35526	6.82	12.7
20	30	23.44	0.44	1.00	10.23	5.90	603	72415	11469	60946	1.40	12.7
30	40	23.44	0.44	1.00	10.23	4.80	491	80371	12592	72073	1.69	12.7
40	50	23.44	0.44	1.00	10.23	4.00	400	88190	15115	72075	1.87	12.7
50	60	23.44	0.44	1.00	10.23	3.50	358	107395	22938	84457	1.94	12.7
60	70	23.44	0.44	1.00	10.23	3.00	307	110484	26781	82703	1.92	12.7
70	80	23.44	0.44	1.00	10.23	2.80	288	122283	30584	85529	2.06	12.7
80	90	23.44	0.44	1.00	10.23	2.60	268	127847	34507	83240	2.14	12.7
90	100	23.44	0.44	1.00	10.23	2.50	258	130600	38230	89889	2.29	12.7
100	110	23.44	0.44	1.00	10.23	2.40	245	142785	42053	105232	2.42	12.7
110	120	23.44	0.44	1.00	10.23	2.30	235	155983	45876	108387	2.51	12.7
120	130	23.44	0.44	1.00	10.23	2.20	225	162013	49699	112315	2.58	12.7
130	140	23.44	0.44	1.00	10.23	2.10	215	167537	53522	114615	2.62	12.7
140	150	23.44	0.44	1.00	10.23	2.00	205	171832	57345	114448	2.63	12.7
150	160	23.44	0.44	1.00	10.23	1.90	194	174901	61168	113733	2.61	12.7
114.682												

Duration	Duration	(Ac.)	"C"	"R"	"CA"	Intensity	(cfs)	(cubic ft.)	(cubic ft.)	(acre-ft.)	(cfs)	
10	30	23.44	0.44	1.00	10.23	8.30	849	50938	12445	36491	6.88	13.8
20	40	23.44	0.44	1.00	10.23	6.90	675	81097	18593	64413	1.48	13.8
30	50	23.44	0.44	1.00	10.23	5.50	563	101258	20742	86817	1.85	13.8
40	60	23.44	0.44	1.00	10.23	4.80	470	112918	24890	88028	2.02	13.8
50	70	23.44	0.44	1.00	10.23	4.00	409	122737	29039	93659	2.19	13.8
60	80	23.44	0.44	1.00	10.23	3.50	358	128974	33167	95667	2.28	13.8
70	90	23.44	0.44	1.00	10.23	3.00	308	134182	37335	100426	2.40	13.8
80	100	23.44	0.44	1.00	10.23	3.10	317	132194	41484	110711	2.54	13.8
90	110	23.44	0.44	1.00	10.23	2.90	297	130172	45632	114540	2.63	13.8
100	120	23.44	0.44	1.00	10.23	2.70	278	128996	49780	115515	2.66	13.8
110	130	23.44	0.44	1.00	10.23	2.50	258	136094	53929	114855	2.63	13.8
120	140	23.44	0.44	1.00	10.23	2.30	238	139576	58077	111381	2.56	13.8
130	150	23.44	0.44	1.00	10.23	2.15	220	141528	62226	109309	2.51	13.8
140	160	23.44	0.44	1.00	10.23	2.00	205	143532	66374	104459	2.42	13.8
150	170	23.44	0.44	1.00	10.23	1.85	189	145536	70522	99776	2.29	13.8

1151915


DETENTION STORAGE CALCULATIONS - 50 Year											
Storm	Duration	Area	Future "C"	Future "R"	Future "CA"	Rainfall Intensity	Inflow Volume	Outflow Volume	Volume	Volume	Outflow


20	40	23.44	0.44	1.00	10.23	9.00	921	52232	18518	38716	6.89	18.4
30	50	23.44	0.44	1.00	10.23	7.50	767	62053	22022	70051	1.61	18.4
40	60	23.44	0.44	1.00	10.23	6.10	624	71205	27527	84778	1.95	18.4
50	70	23.44	0.44	1.00	10.23	5.20	532	72847	32033	84814	2.17	18.4
60	80	23.44	0.44	1.00	10.23	4.50	460	130060	36338	95542	2.29	18.4
70	90	23.44	0.44	1.00	10.23	3.90	399	135303	40463	95555	2.29	18.4
80	100	23.44	0.44	1.00	10.23	3.70	378	139945	44595	103246	2.51	18.4
90	110	23.44	0.44	1.00	10.23	3.50	358	171532	55554	116778	2.69	18.4
100	120	23.44	0.44	1.00	10.23	3.30	338	182265	60590	121705	2.79	18.4
110	130	23.44	0.44	1.00	10.23	3.00	307	184108	66065	118841	2.71	18.4
120	140	23.44	0.44	1.00	10.23	2.90	297	187098	71571	124195	2.85	18.4
130	150	23.44	0.44	1.00	10.23	2.80	288	206199	77078	129123	2.96	18.4
140	160	23.44	0.44	1.00	10.23	2.65	271	211415	82592	128534	2.96	18.4
150	170	23.44	0.44	1.00	10.23	2.50	258	214794	88097	126734	2.91	18.4
150	170	23.44	0.44	1.00	10.23	2.35	240	218325	93592	122732	2.82	18.4

129 123

DETENTION STORAGE CALCULATIONS - 100 Year												
Storm Duration	Outflow Duration	Area (Ac.)	Future "C"	Future "R"	Future "CA"	Rainfall Intensity	Inflow (cfs)	Inflow Volume (cubic ft.)	Outflow Volume (cubic ft.)	Volume (cubic ft.)	Volume (acre-ft.)	Outflow (cfs)
10	30	23.44	0.44	1.00	10.23	9.80	100.2	80141	2089	3987.2	0.92	22.5


40	60	23.44	0.44	1.00	10.23	5.80	59.3	142375	6039	161837	2.34	22.5
50	70	23.44	0.44	1.00	10.23	5.00	51.1	153422	47295	106126	2.44	22.5
60	80	23.44	0.44	1.00	10.23	4.50	46.0	165996	54052	111044	2.56	22.5
70	90	23.44	0.44	1.00	10.23	4.00	40.9	171632	60309	111624	2.66	22.5
80	100	23.44	0.44	1.00	10.23	3.70	37.8	181861	67585	114687	2.62	22.5
90	110	23.44	0.44	1.00	10.23	3.50	35.8	193311	74321	119590	2.75	22.5
100	120	23.44	0.44	1.00	10.23	3.40	34.6	208654	81076	127476	2.83	22.5
110	130	23.44	0.44	1.00	10.23	3.30	32.7	216018	87634	126104	2.84	22.5
120	140	23.44	0.44	1.00	10.23	3.00	30.7	220627	94581	126337	2.96	22.5
130	150	23.44	0.44	1.00	10.23	2.90	29.7	231360	101347	130615	2.96	22.5
140	160	23.44	0.44	1.00	10.23	2.80	28.6	243938	108104	135482	3.04	22.5
150	170	23.44	0.44	1.00	10.23	2.80	28.6	299338	114860	134478	3.08	22.5
132,662												
3.04												

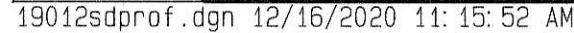


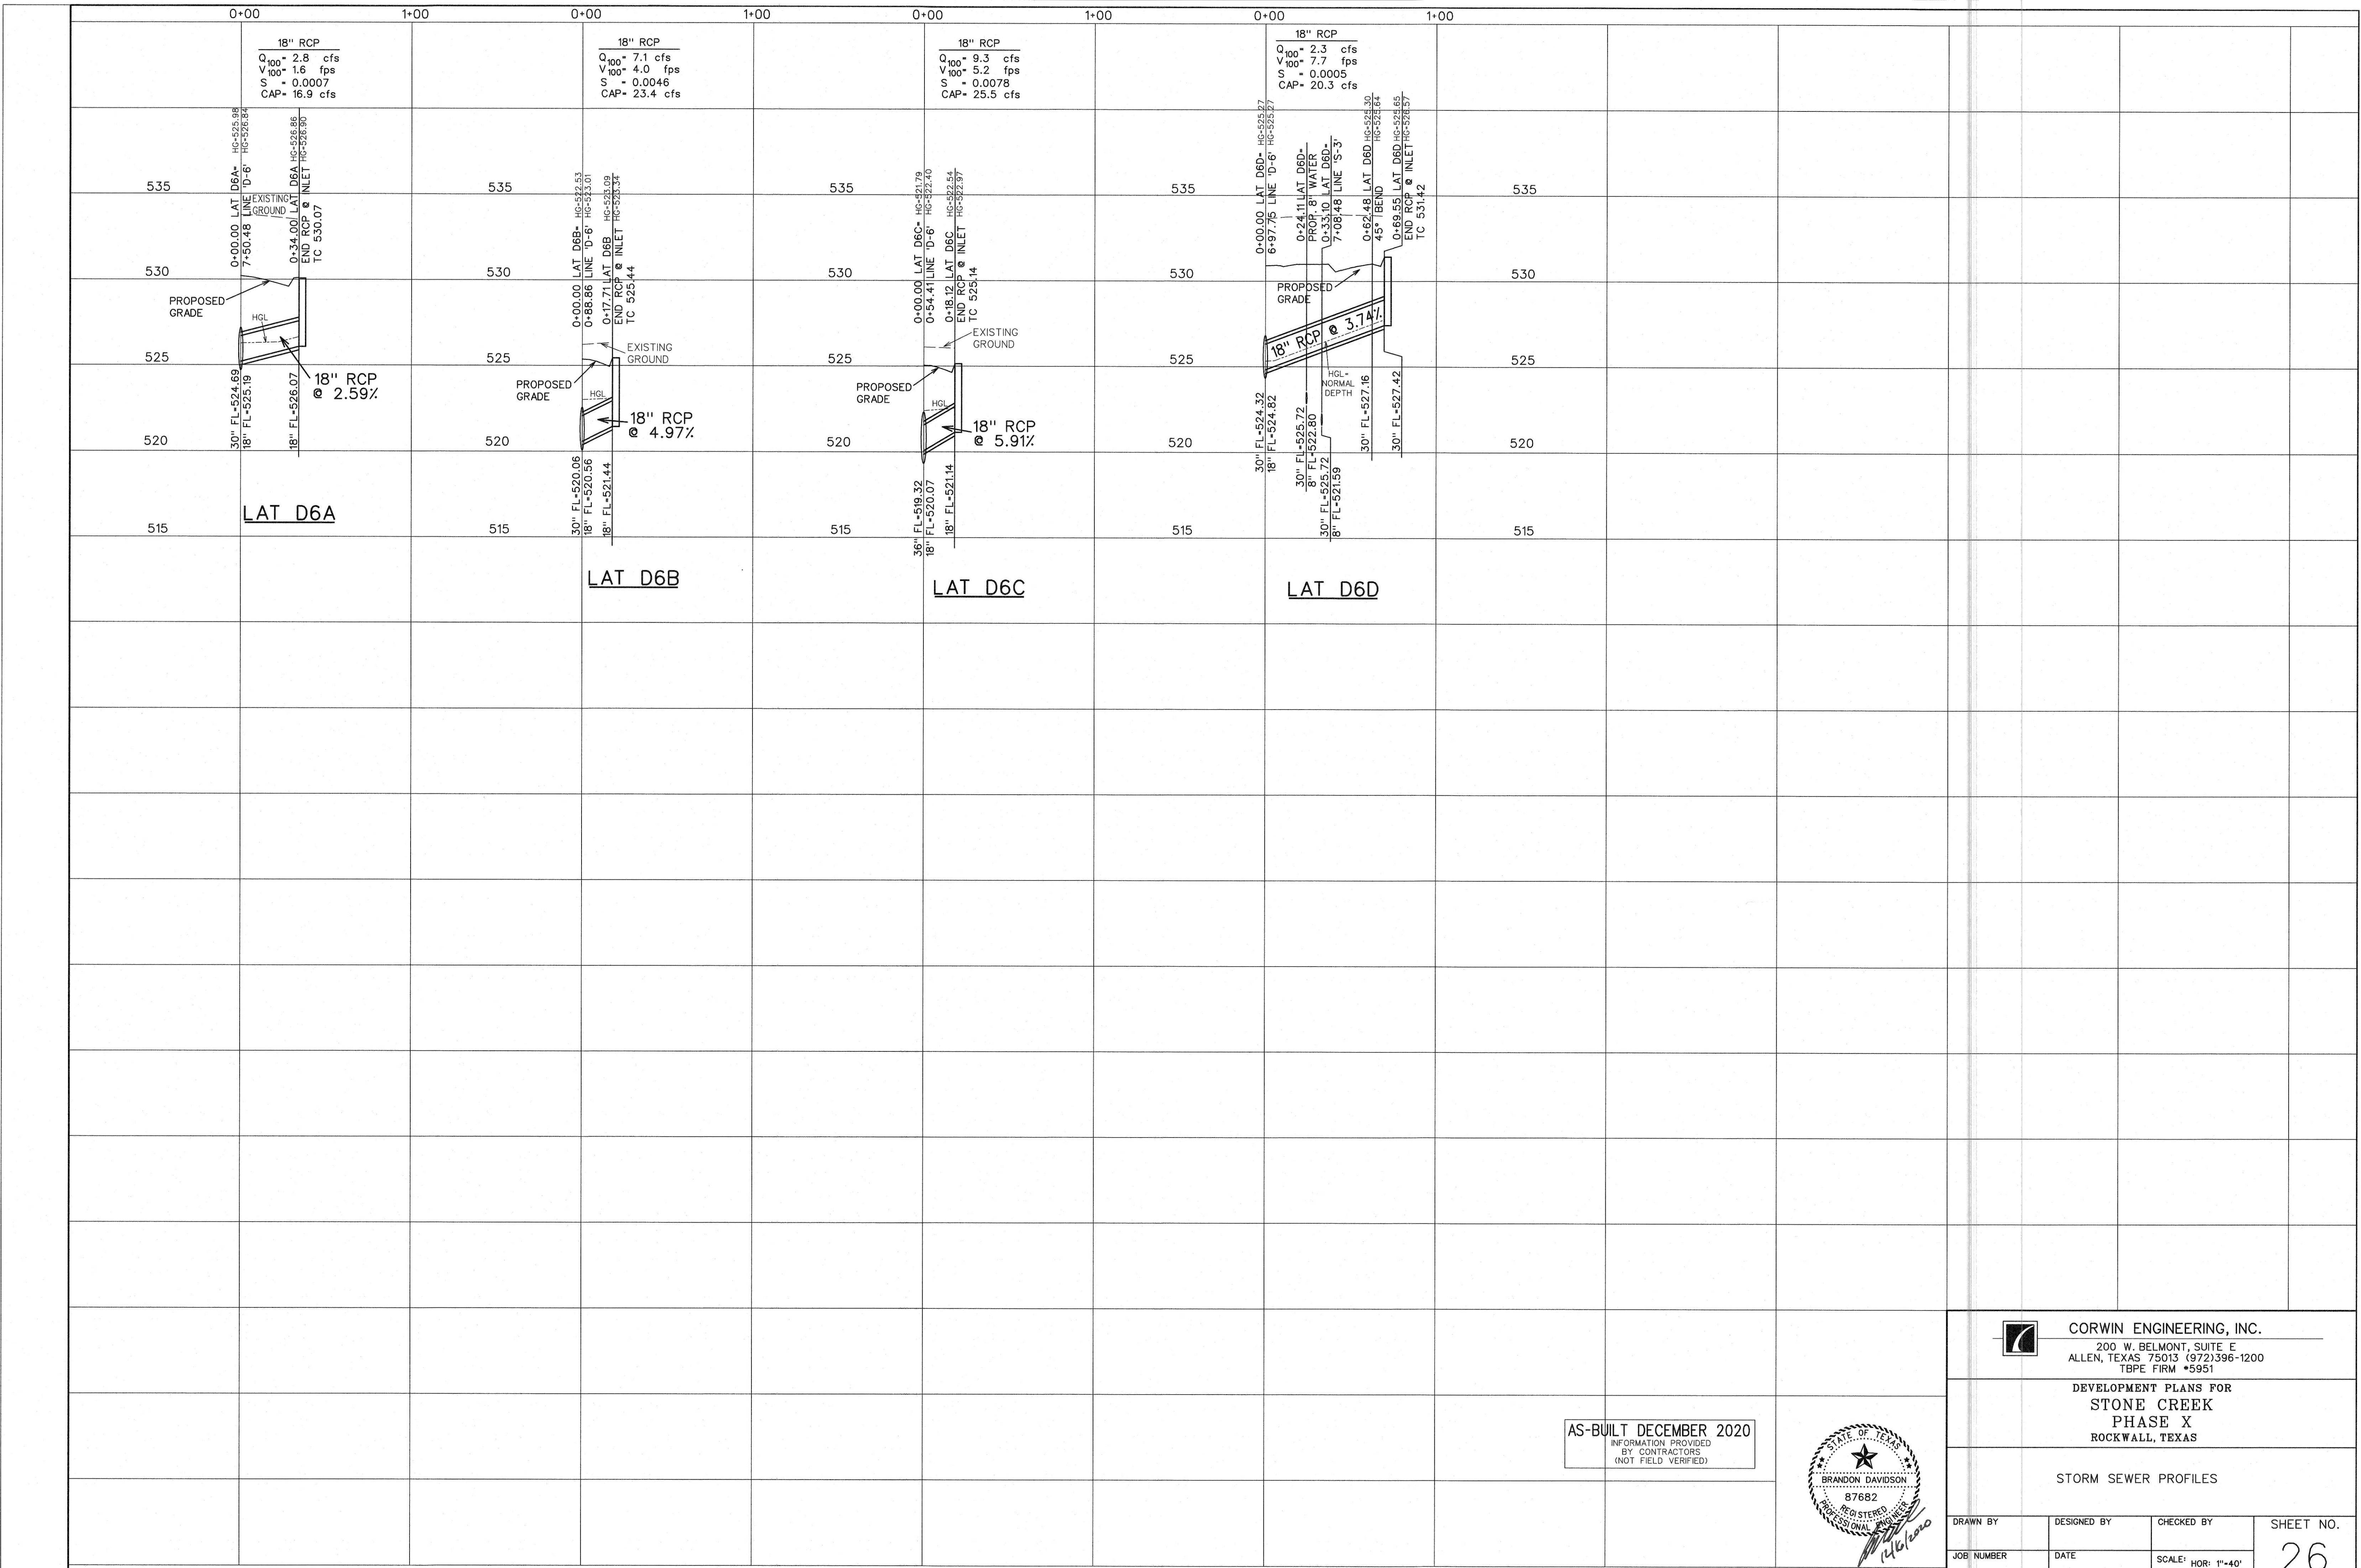

AS-BUILT DECEMBER 2020
INFORMATION PROVIDED
BY CONTRACTORS
(NOT FIELD VERIFIED)

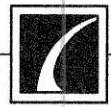


 CORWIN ENGINEERING, INC. 200 W. BELMONT, SUITE E ALLEN, TEXAS 75013 (972)396-1200 TBPE FIRM #5951			
DEVELOPMENT PLANS FOR STONE CREEK PHASE X ROCKWALL, TEXAS			
STORM SEWER PROFILES			
DRAWN BY	DESIGNED BY	CHECKED BY	SHEET NO.
JOB NUMBER 19012	DATE MAY 2019	SCALE: HOR: 1"=40' VER: 1"=4'	26

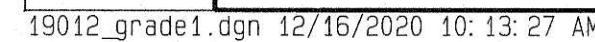




SCALE: 1" = 50'

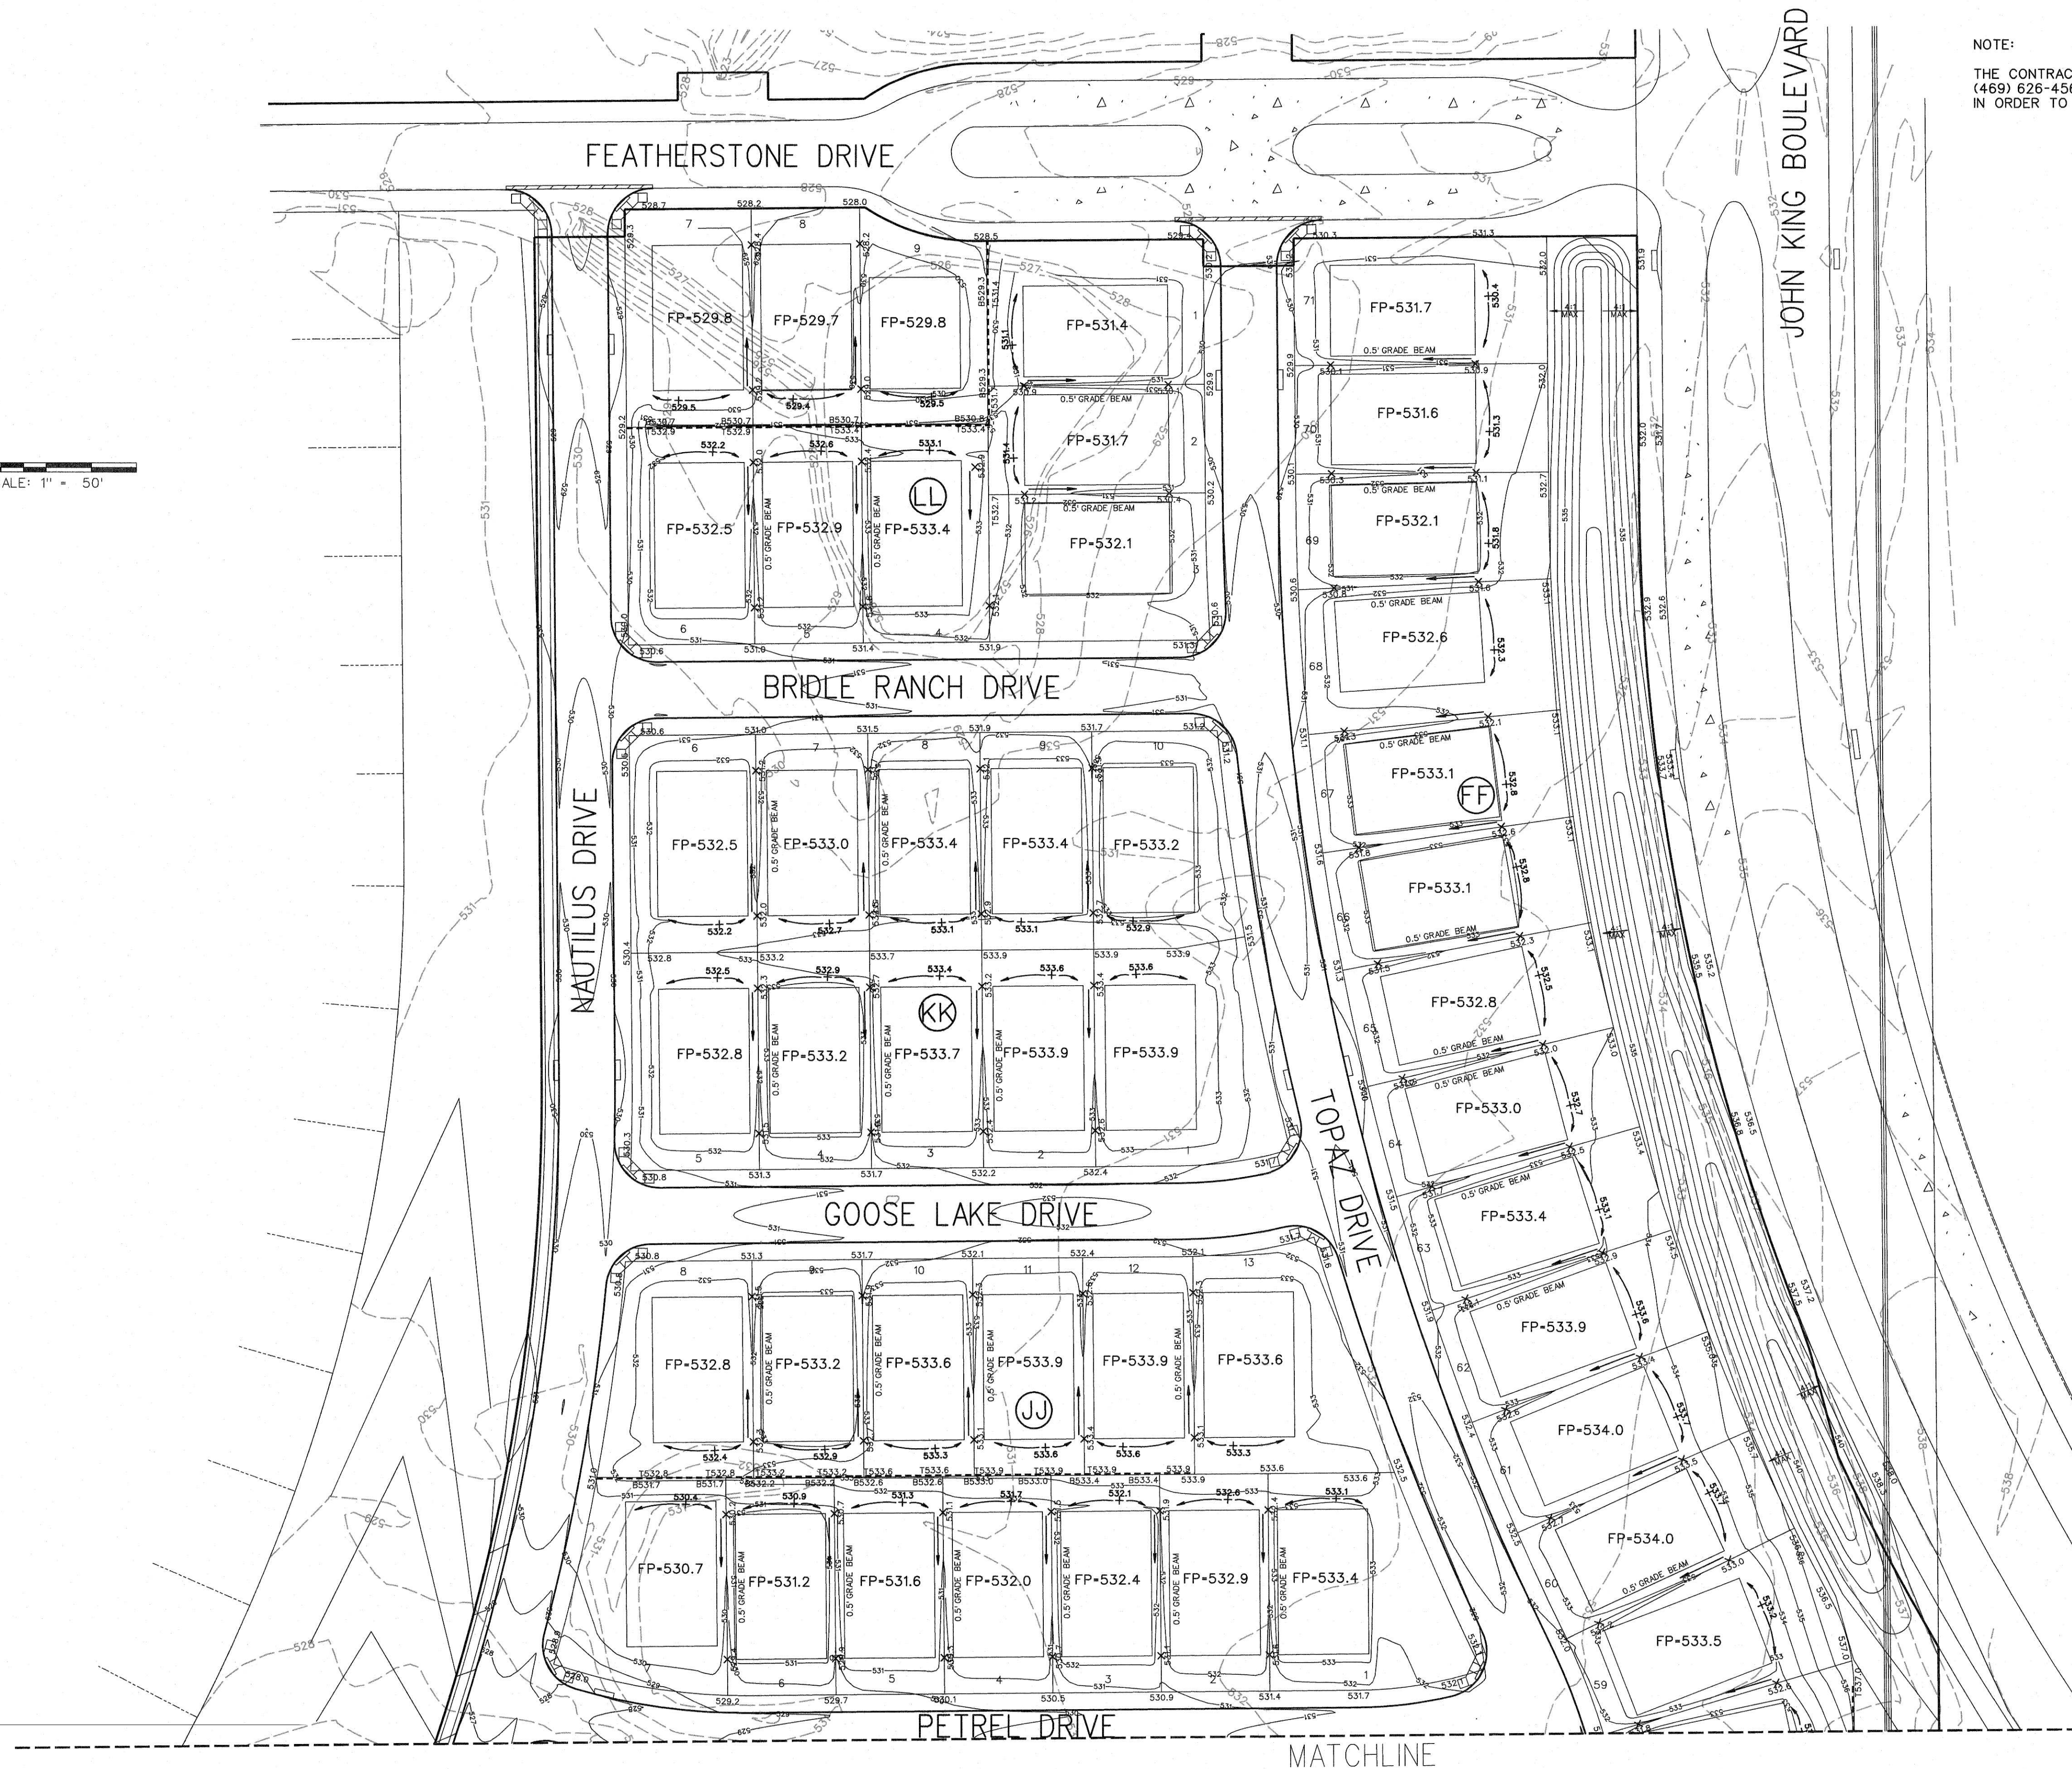

NOTE:

THE CONTRACTOR SHALL CONTACT NTMWD LINE LOCATES AT (469) 626-4569 AT LEAST 72 HOURS PRIOR TO WORKING IN EASEMENT IN ORDER TO SCHEDULE A REPRESENTATIVE TO BE ON SITE.

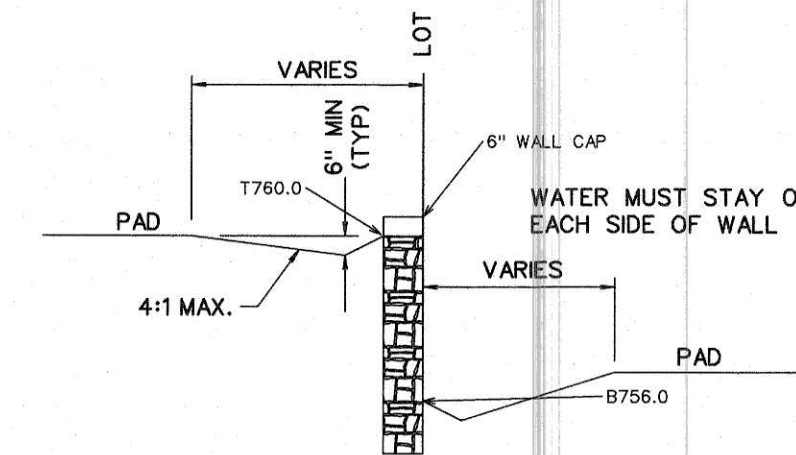

TYPICAL SIDEYARD RETAINING WALL
N.T.S.

NOTE:

RETAINING WALLS 3' IN HEIGHT AND OVER NEED AN ENGINEER SEALED PLAN. (PLANS TO BE SUBMITTED PRIOR TO ENGINEERING APPROVAL)

NOTE:

T760.0 - GRADE SHOWN AT WALL TOP
B756.0 - GRADE SHOWN AT WALL BOTTOM
WALL CAP SHALL BE 6" ABOVE SHOWN WALL TOP.

LEGEND

SPOT ELEVATION	706.2
EXIST. CONTOUR	700
PROP. CONTOUR	704
RETAINING WALL	---
HIGH POINT	HP
TOP OF WALL GRADE	T706.2
BOTTOM OF WALL GRADE	B706.2

NOTES:

1. Finish Floor Elevation to be 0.70 Feet above Finished Pad.(FP)
2. Additional Erosion Control to be installed in Parkways as determined by the City Inspector.
3. Finished Pad Elevations are within ± 0.3 Feet.
4. All fill compacted to min 95% std. density using sheeps foot roller.
5. All portions of the wall to be on one lot. Do not install on property line or in easements or right of way.
6. All R.O.W. to be $\frac{1}{4}$ " per foot.

NO SLOPES GREATER THAN 4:1 ALLOWED WITHOUT A RETAINING WALL




CORWIN ENGINEERING, INC.
200 W. BELMONT, SUITE E
ALLEN, TEXAS 75013 (972)396-1200
TBPE FIRM #5951


DEVELOPMENT PLANS FOR
STONE CREEK
PHASE X
ROCKWALL, TEXAS

GRADING PLAN




DRAWN BY	DESIGNED BY	CHECKED BY	SHEET NO.
JOB NUMBER	DATE	SCALE:	28
19012	MAY 2019	1"=50'	

AS-BUILT DECEMBER 2020
INFORMATION PROVIDED
BY CONTRACTORS
(NOT FIELD VERIFIED)


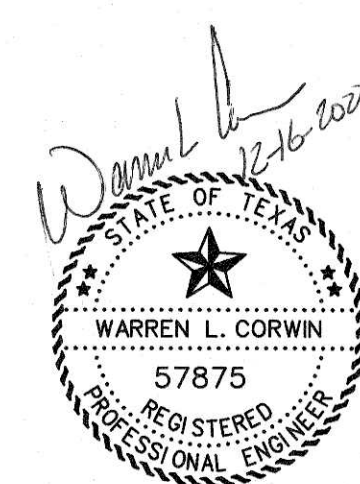


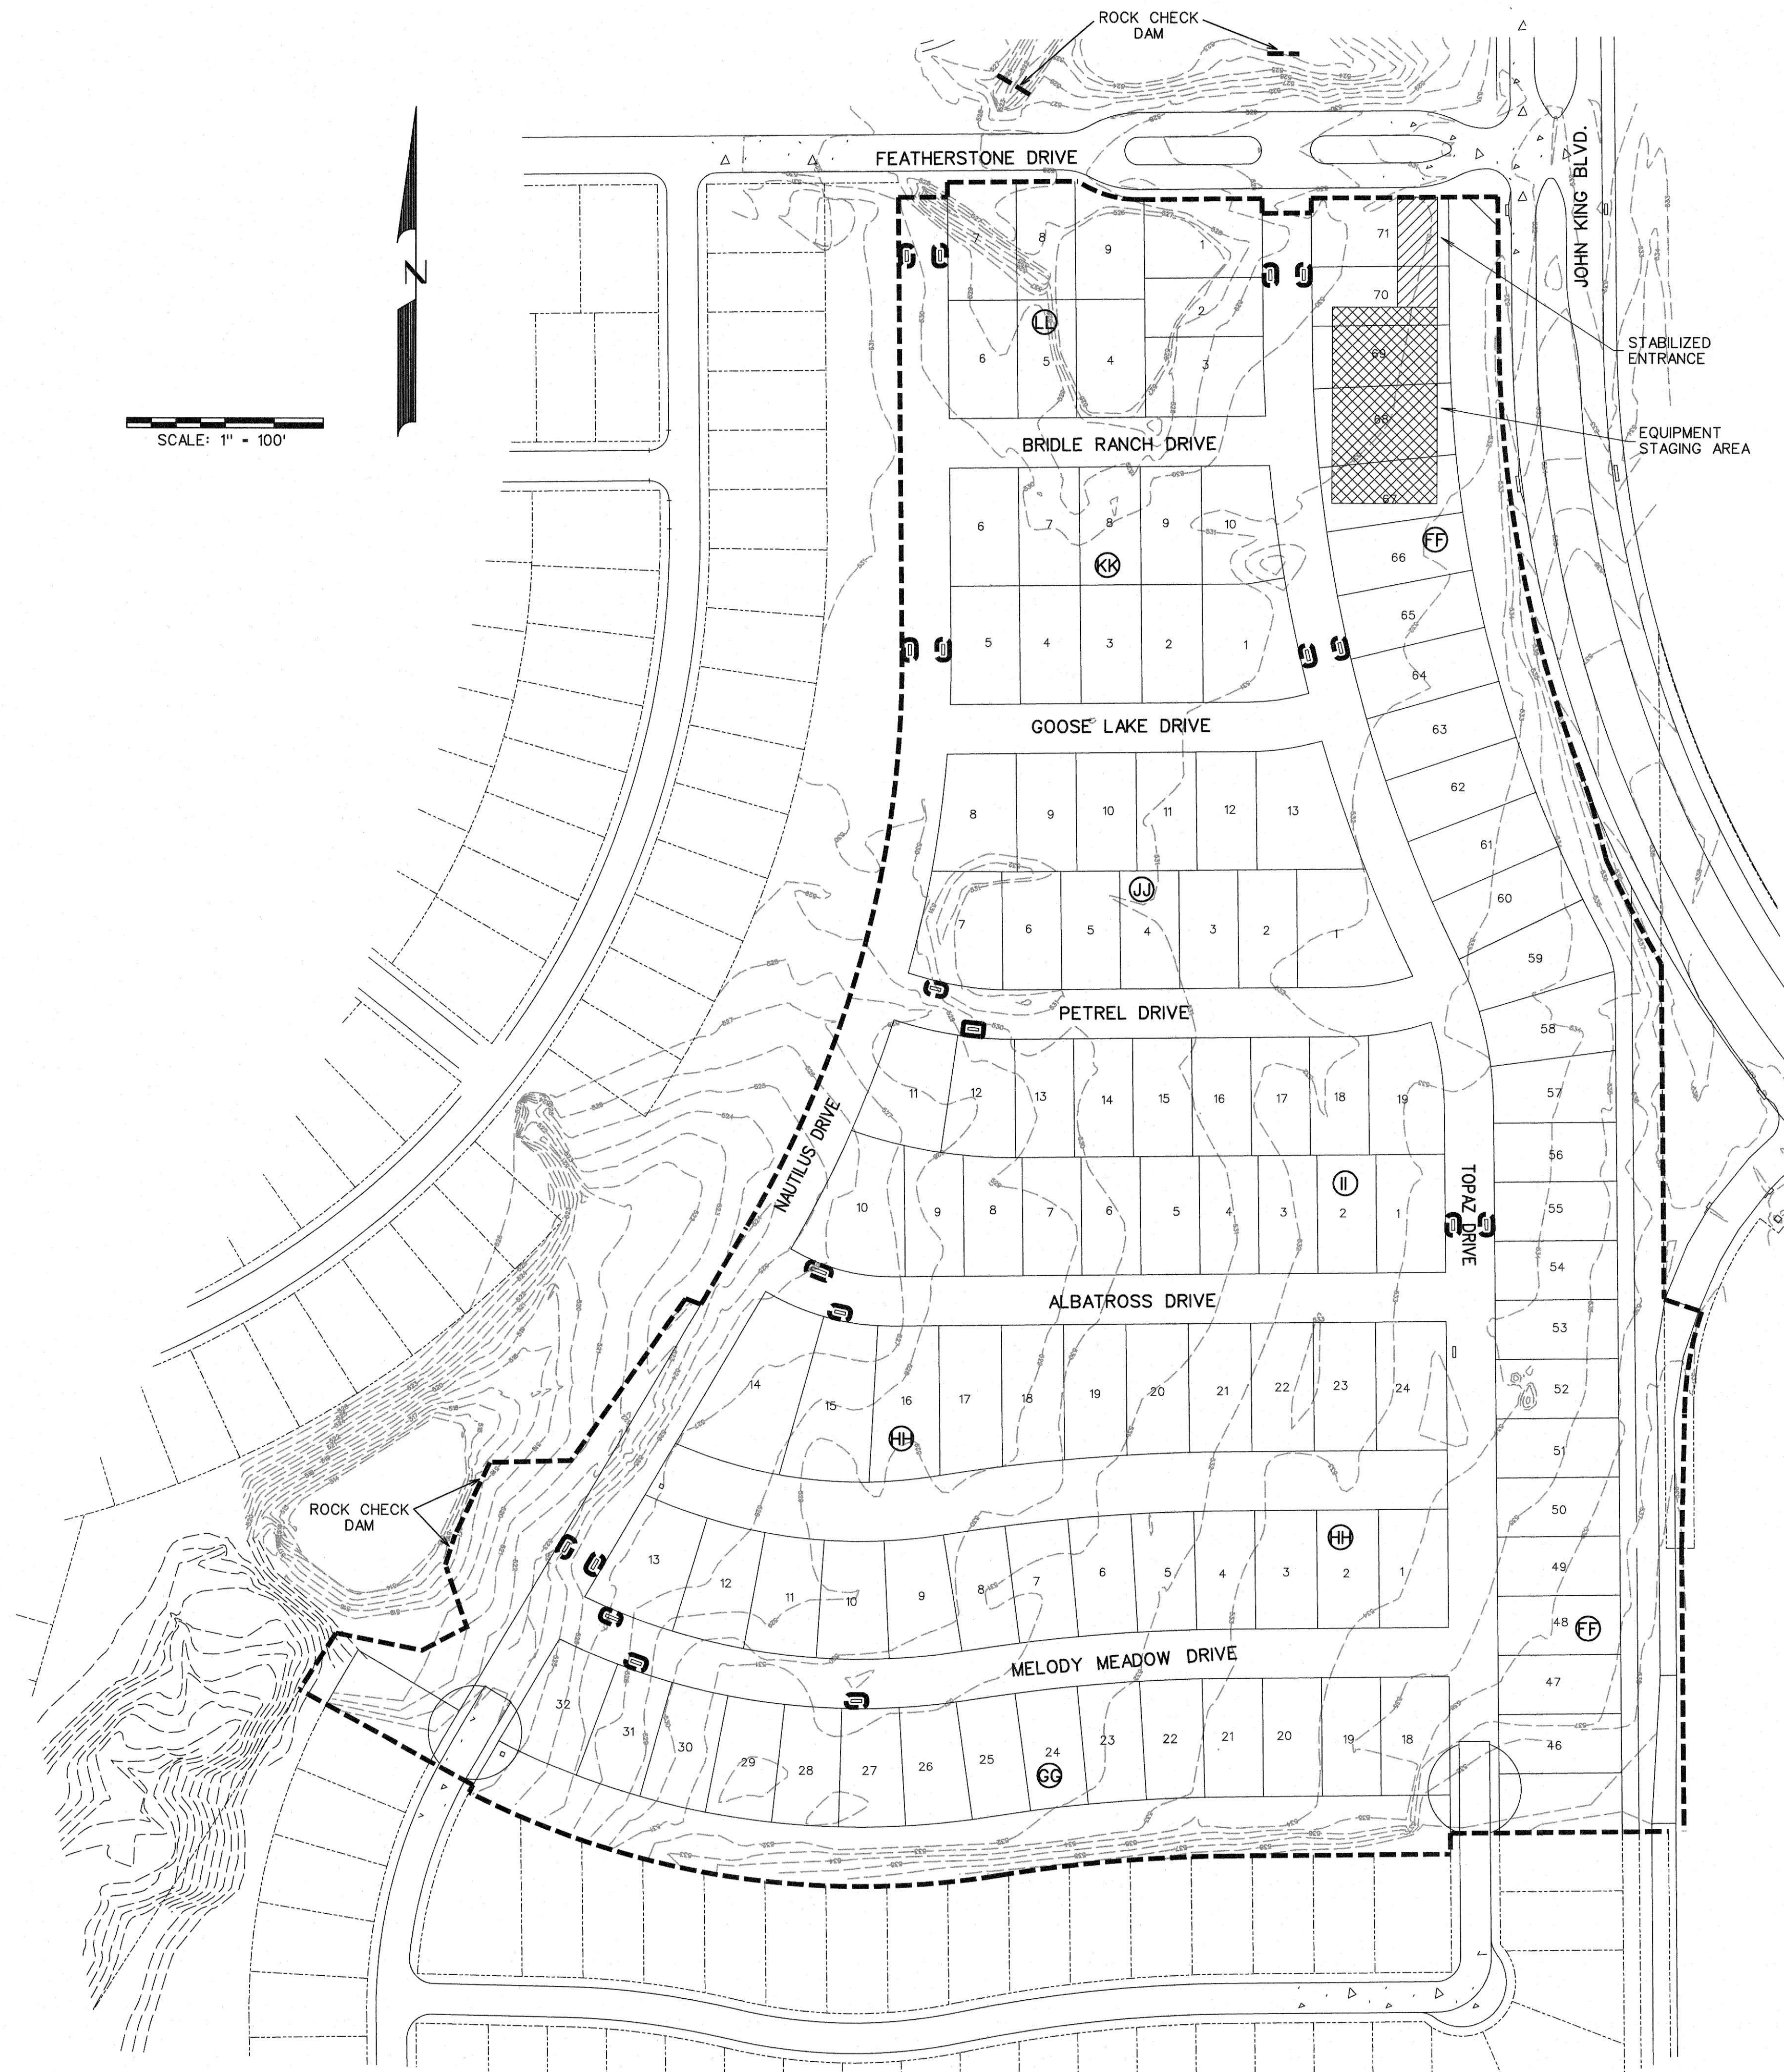


SCALE: 1" = 100'

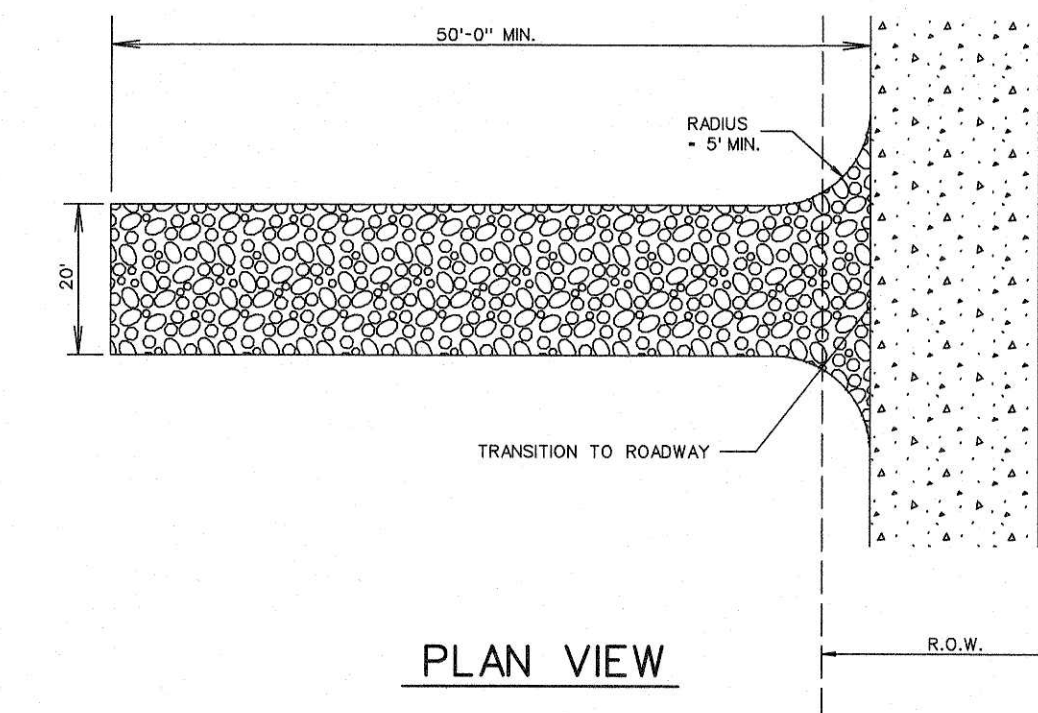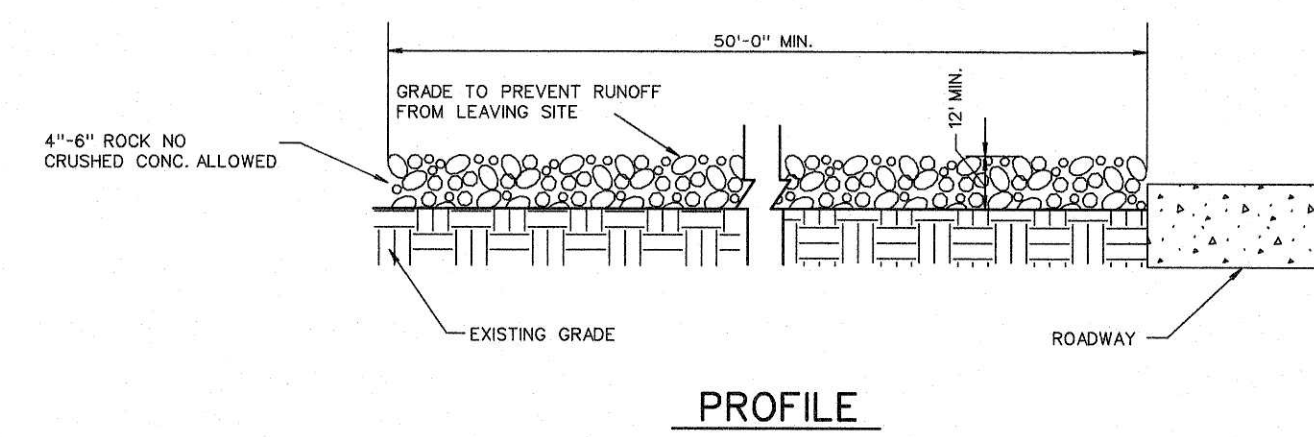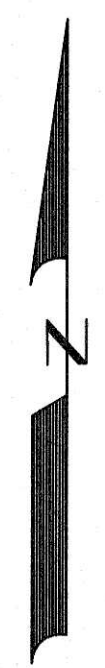


STABILIZED ENTRANCE DETAIL

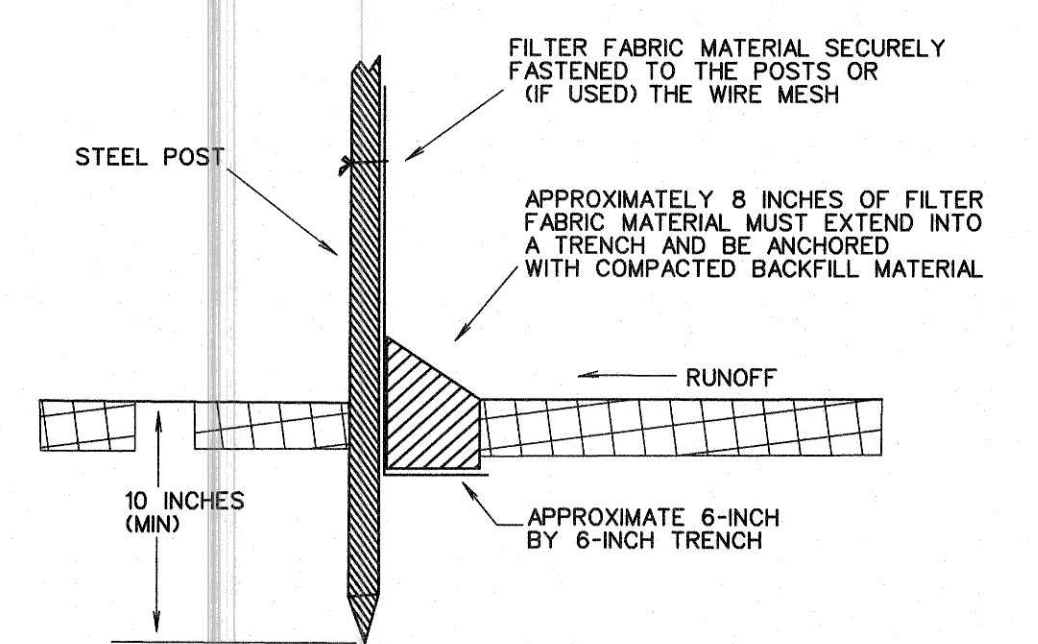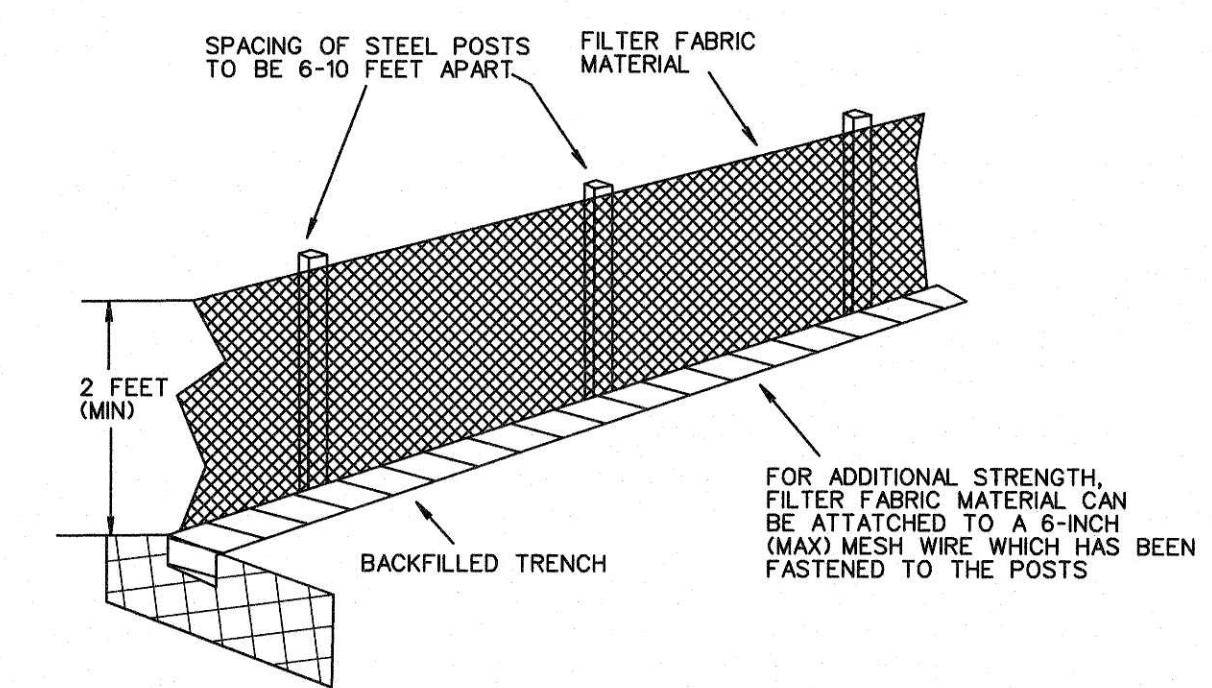

FILTER FABRIC FENCE DETAIL

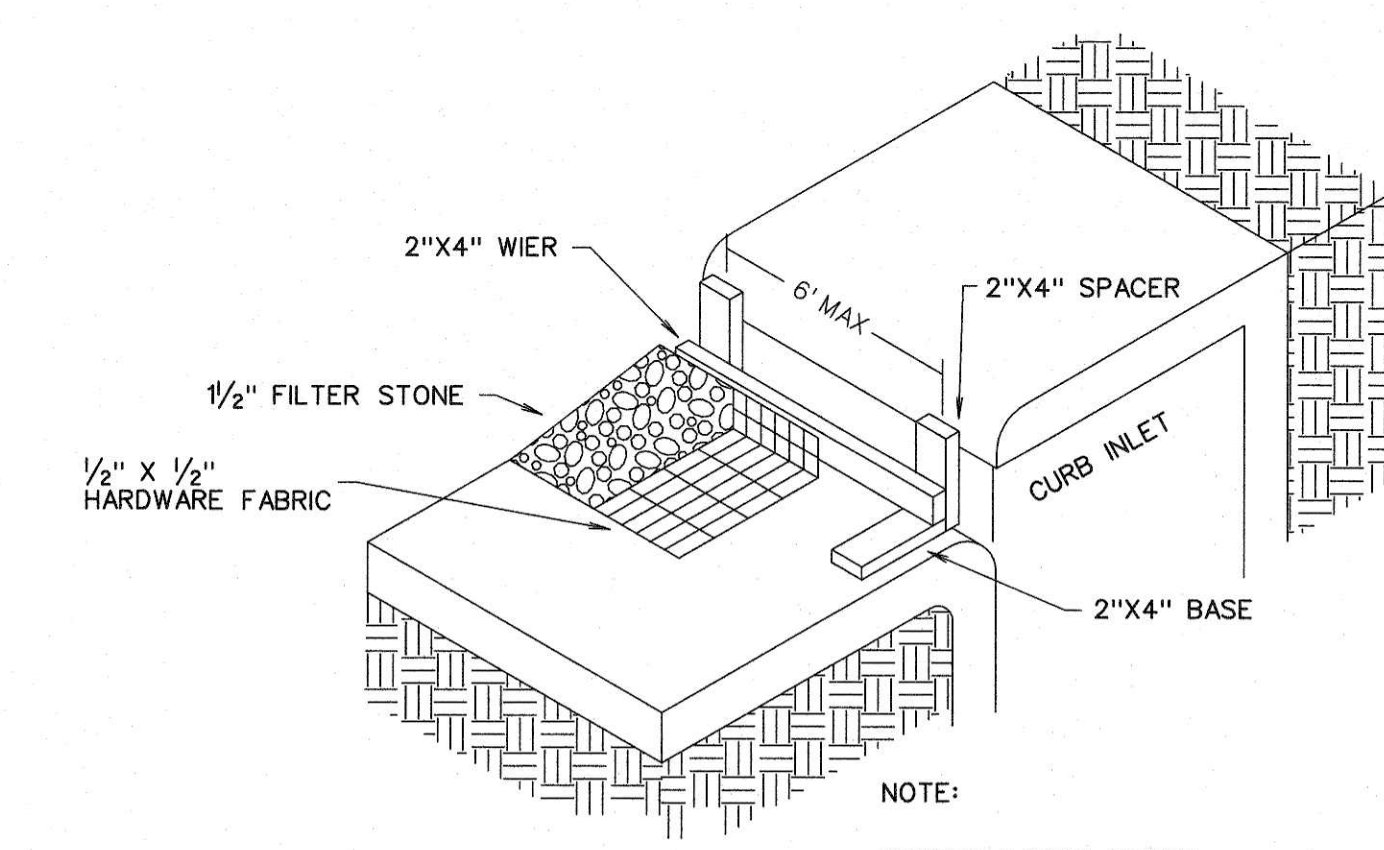

TYPE B CURB INLET PROTECTION

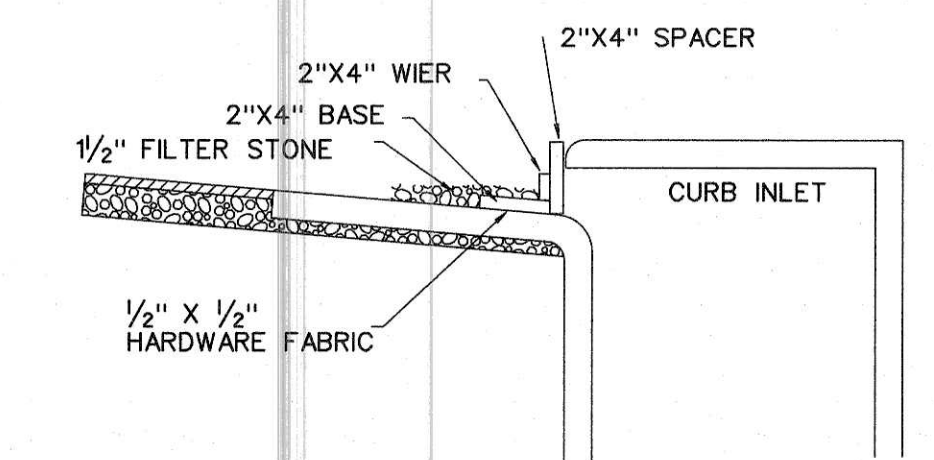

INLET SECTION

AS-BUILT DECEMBER 2020
INFORMATION PROVIDED
BY CONTRACTORS
(NOT FIELD VERIFIED)

LEGEND

SILT FENCE (BEFORE CONSTRUCTION) -----

INLET PROTECTION



CONSTRUCTION SEQUENCE


1. GRADING CONTRACTOR TO INSTALL TEMPORARY STABILIZED ENTRANCE.
2. INSTALL SILT FENCE AS SHOWN, (TS-600 POLY FELT) PER C.O.G. SPECIFICATIONS.
3. PERFORM GRADING AND UTILITY CONSTRUCTION.
4. AFTER THE INLET BOTTOMS ARE CONSTRUCTED, THE INLETS SHALL BE FILLED WITH STONE AND COVERED WITH A FILTER FABRIC (TS-600 POLY FELT OR EQUIVALENT) BY UTILITY CONTRACTOR.
5. PRIOR TO CITY RELEASING PAVING, SOD OR SEED, CURLEX SHALL BE INSTALLED ON SIDES AND BOTTOM OF ALL DETENTION PONDS.
6. AFTER PAVING AND COMPLETION OF INLETS, INLET FILTERS SHALL BE INSTALLED IN ALL INLETS AND MAINTAINED UNTIL RE-VEGETATION HAS BEEN COMPLETED BY PAVING CONTRACTOR.
7. SILT FENCE SHALL REMAIN IN PLACE UNTIL RE-VEGETATION HAS BEEN COMPLETED.
8. PAVING CONTRACTOR SHALL REMOVE TEMPORARY STABILIZED ENTRANCE.
9. PRIOR TO CITY ACCEPTANCE THE PAVING CONTRACTOR SHALL BE RESPONSIBLE FOR REMOVING ANY MUD OR SILT WHICH COLLECTS ON THE EXISTING AND NEW PAVEMENT.
10. PRIOR TO CITY ACCEPTANCE 75-80% OF ALL DISTURBED AREA SHALL HAVE A MIN. 1" TALL GRASS ESTABLISHED.
11. 75-80% OF ALL DISTURBED AREA TO HAVE 1" HIGH GRASS ESTABLISHED PRIOR TO ENGINEERING ACCEPTANCE.
12. ALL BAR DITCHES TO BE ANCHORED, SEEDING & CURLEXED PRIOR TO ACCEPTANCE OF GRASS ISN'T ESTABLISHED.

CORWIN ENGINEERING, INC.
200 W. BELMONT, SUITE E
ALLEN, TEXAS 75013 (972)396-1200
TBPE FIRM #5951

DEVELOPMENT PLANS FOR
STONE CREEK
PHASE X
ROCKWALL, TEXAS

EROSION CONTROL PLAN

DRAWN BY	DESIGNED BY	CHECKED BY	SHEET NO.
JOB NUMBER	DATE	SCALE:	29
19012	MAY 2019	1"=100'	

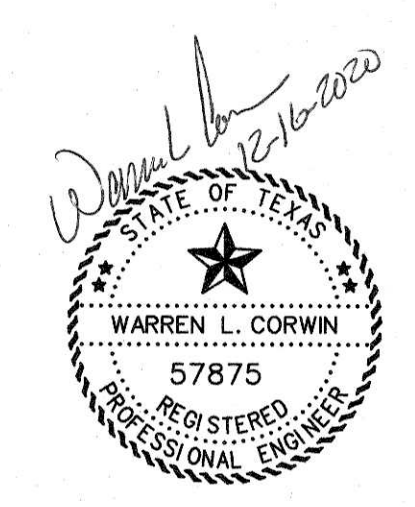



-Any decorative sign poles and fixtures installed shall be maintained by the HOA.

All developments shall be provided with streetlights. In general, lights should be located at street intersections and at intervals no greater than four hundred (400) feet apart. Streetlights should be the equivalent of 175-watt mercury vapor fixtures on minor residential streets. All collector and arterial, or commercial streets shall have sodium vapor fixtures with a minimum wattage of 250 or 400 watts as directed by the City. In some instances, the City may require greater wattage.

LEGEND

 - STREET LIGHT

 - STOP SIGN

 - STREET NAME BLADE

DRAWN BY	DESIGNED BY	CHECKED BY	SHEET NO. 30
JOB NUMBER 19012	DATE MAY 2019	SCALE: 1"=100'	

9" Min.

9" Min.

42"

7" Dia.

1" Dia.

1" Dia.

1" Dia.

1 1/2" R Typ.

Rockwall Logo Detail

NOT TO SCALE

Notes:

1. Street name blades shall consist of white SCOTCHLITE 3550 High Intensity Prismatic Material, digitally printed using HP Latex 350 or higher.
 a. Graeco: Plankton 355C with overlay CMYK 100-0-20-0 set to darken.
2. Blue: Pantone 287C.
3. Lettering to be composed of a combination of upper and lowercase letters, with initial uppercase letters. Font to be Clearview TCO2-1w with uppercase to be 9" Min. height and lowercase to be 4.5" Min. height. The N, S, E, and W designations, if required, shall be uppercase 4.5" Min. height preceding the street name. No more than 65% compression on font width.
4. Lettering for street designations and block numbers to be composed of initial uppercase letters at least 3" Min. height and lower-case letters at least 2.25" Min. height. Street designations shall consist of St, Ln, Dr, Blvd, Way, Ct, Cir, Trace, Trk, Ave, Rd, Pkwy, and Pl.
5. Sign post to be 2 3/8" O.D., galvanized steel tube sign pole.
6. All street signs shall be approved by Rockwall Streets Division prior to manufacture.
7. Any variation from this Sheet Sign detail must be approved by Rockwall Streets Division prior to manufacture.

STREET SIGN DETAIL

NOT TO SCALE

STREET REGULATORY SIGNAGE	CITY OF ROCKWALL
TYPICAL STREET SIGN DETAIL	
	DATE: May 2018 DRAWING NO: R-2300

Decorative Sign Poles and Fixtures – The City of Rockwall maintains Standard Street and regulatory sign post installed on public streets within its designated right-of-ways. These standard poles are 2 1/2" O.D. galvanized steel tube sign post with a galvanized finish. In such cases, where the developer elects to install non standard decorative sign poles, the ownership and maintenance of all such poles, fixtures and associated hardware become the maintenance responsibility of the Homeowners Association and shall be so stated on the subdivision plat. The decorative pole, assemblies, base and anchoring details are to be submitted to and approved by the City of Rockwall prior to installation.

- The street blade sign shall consist of green 3M Scotchlite Series 3930 high intensity prismatic material background – (product code 3937). The lettering shall consist of white 3M Scotchlite Series 3930 high intensity prismatic material (product code – 3930). The background sheeting shall be white 3M 3990 high intensity prismatic material. The background material shall be applied to the full width and height of the sign blank leaving no metal exposed. The background material shall be one continuous piece of material. Patching of background material is not allowed and any sign with patching material of any type will be rejected by the City.

Technical drawing of a street light pole assembly, showing side and cross-sectional views with dimensions and labels.

Side View Labels:

- 1: Light fixture
- 2: Pole section
- 3: Base section
- 4: Abrasion resistant collar
- Final grade: Indicated by a horizontal line at the base of the pole.

Dimensions (Side View):

- 12' 4"
- 6'

Cross-sectional View Labels:

- 4: Abrasion resistant collar
- Tamped soil: Indicated by a horizontal line at the top of the backfill.
- Stabilizing backfill: Indicated by a horizontal line at the base of the backfill.
- #6 Cu around coil: Indicated by a horizontal line at the base of the backfill.
- 18": Dimension for the width of the backfill.
- 24" Min.: Dimension for the height of the backfill.
- 6": Dimension for the width of the backfill at the top.
- As req: As required.

Dimensions (Cross-sectional View):

- 6"
- 18"
- 24" Min.
- 6"









Item	Qty	Description	T&M/Ref	CU
1		LED, Luminaire, Post Top, 0-55 W, Type III, 120-277 V	802694	LEDPT55
1		LED, Luminaire, Post Top, 66-100 W, Type III, 120-277 V	802695	LEDPT100
1		High Pressure Sodium Luminaire, Post Top, 100 W, Type III, 120 V	303146	LL100H31
2		Round Pole, 20 ft., Black, Fiberglass, Embedded Base	313835	
3		Stabilizing Backfill Foam, 2 1/2 cubic ft.	306116	SUPP20
4		Abrasion Resistant Collar	321382	
5		Grounding		
6		Fusing		

Copyright 2018 Oneair Electric Delivery Company. All rights reserved.

The City of Rockwall reserves the right to approve or disapprove any sign/pole design and/or location. The City of Rockwall must approve the color of signposts and any requested sign mounting/trim.

DRAWN BY	DESIGNED BY	CHECKED BY	SHEET NO. 31
JOB NUMBER 19012	DATE MAY 2019	SCALE: 1"=100'	

AS-BUILT DECEMBER 2020
INFORMATION PROVIDED
BY CONTRACTORS
(NOT FIELD VERIFIED)

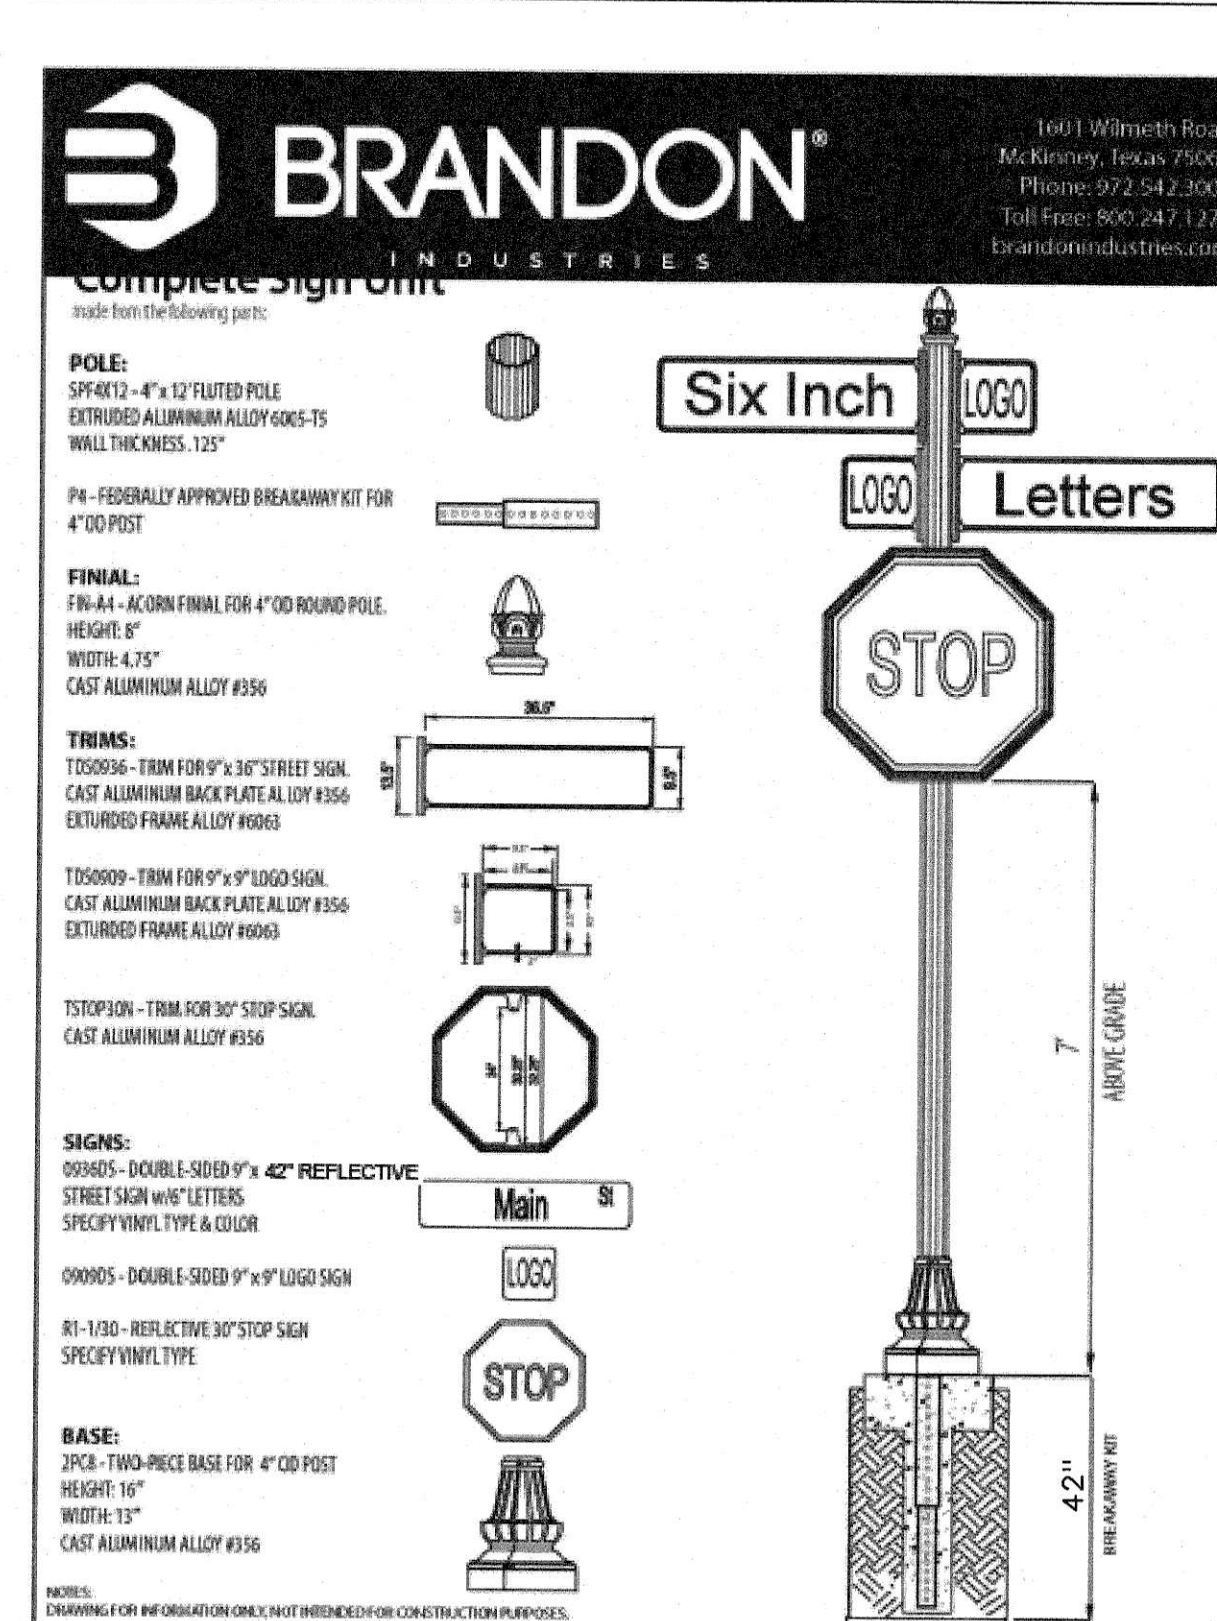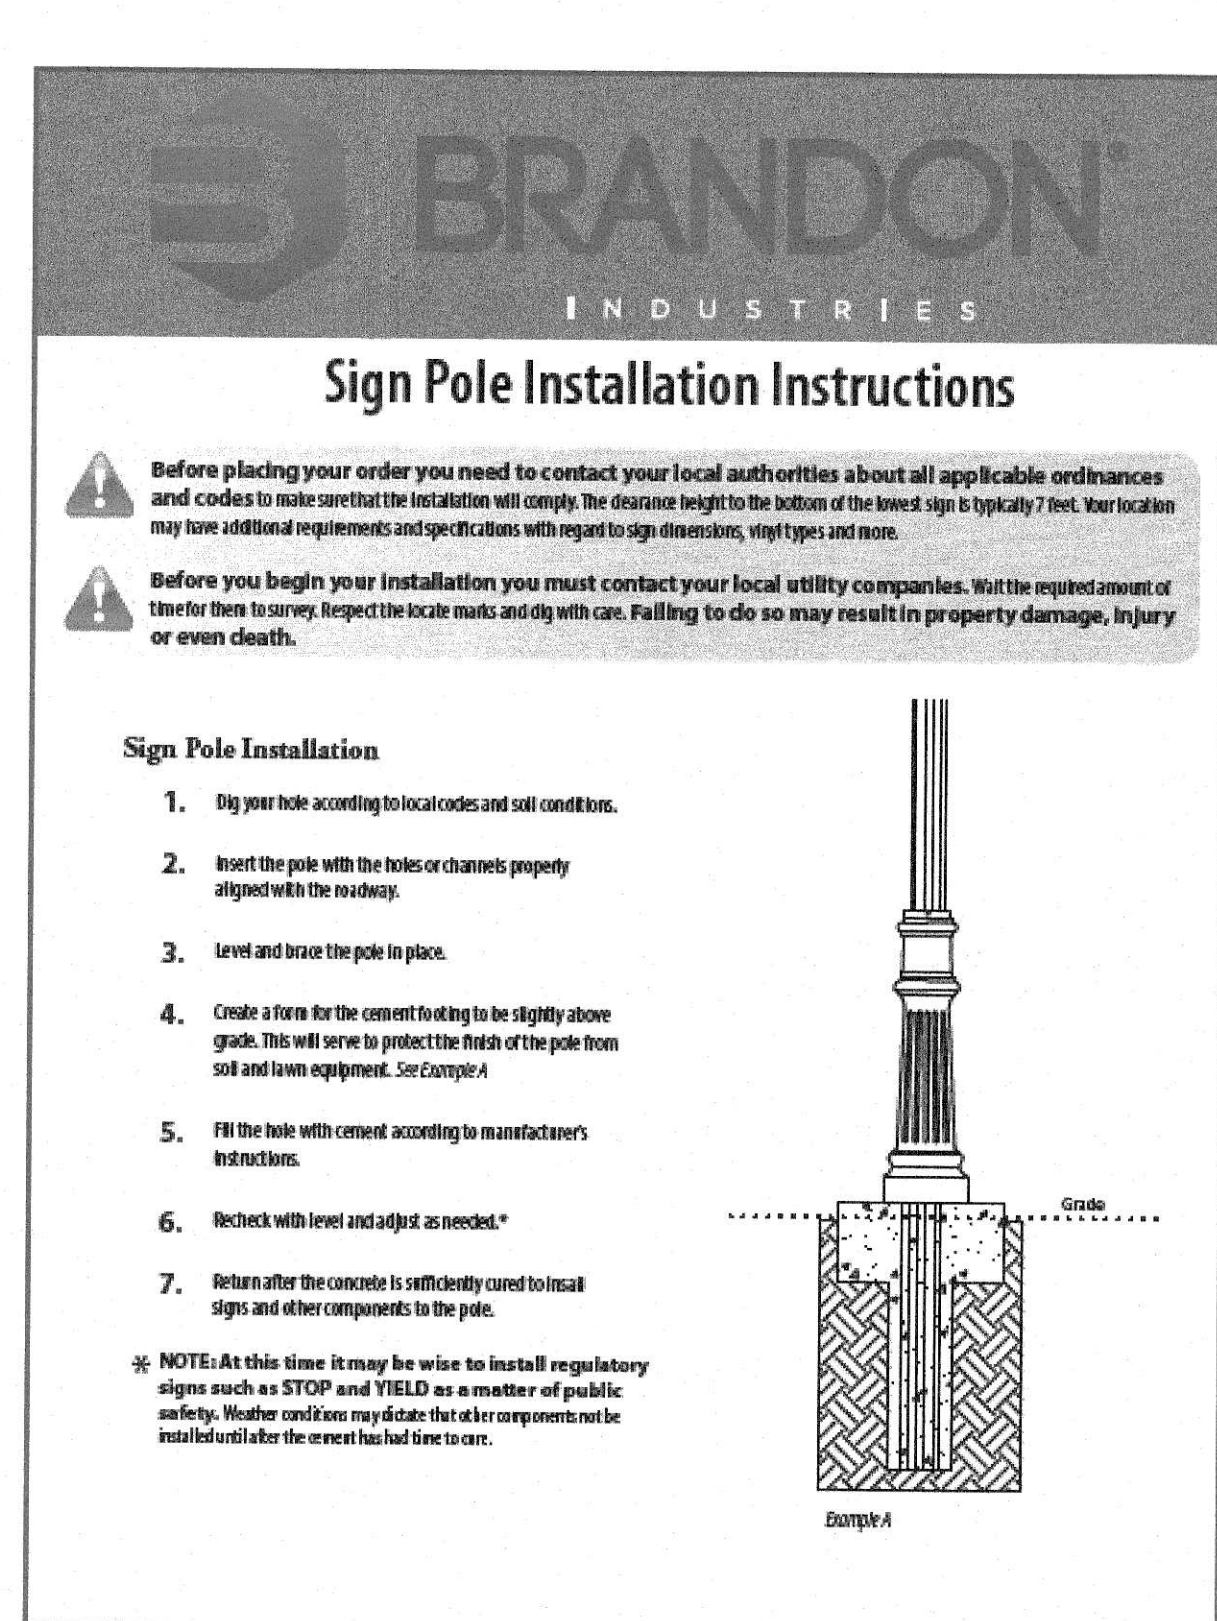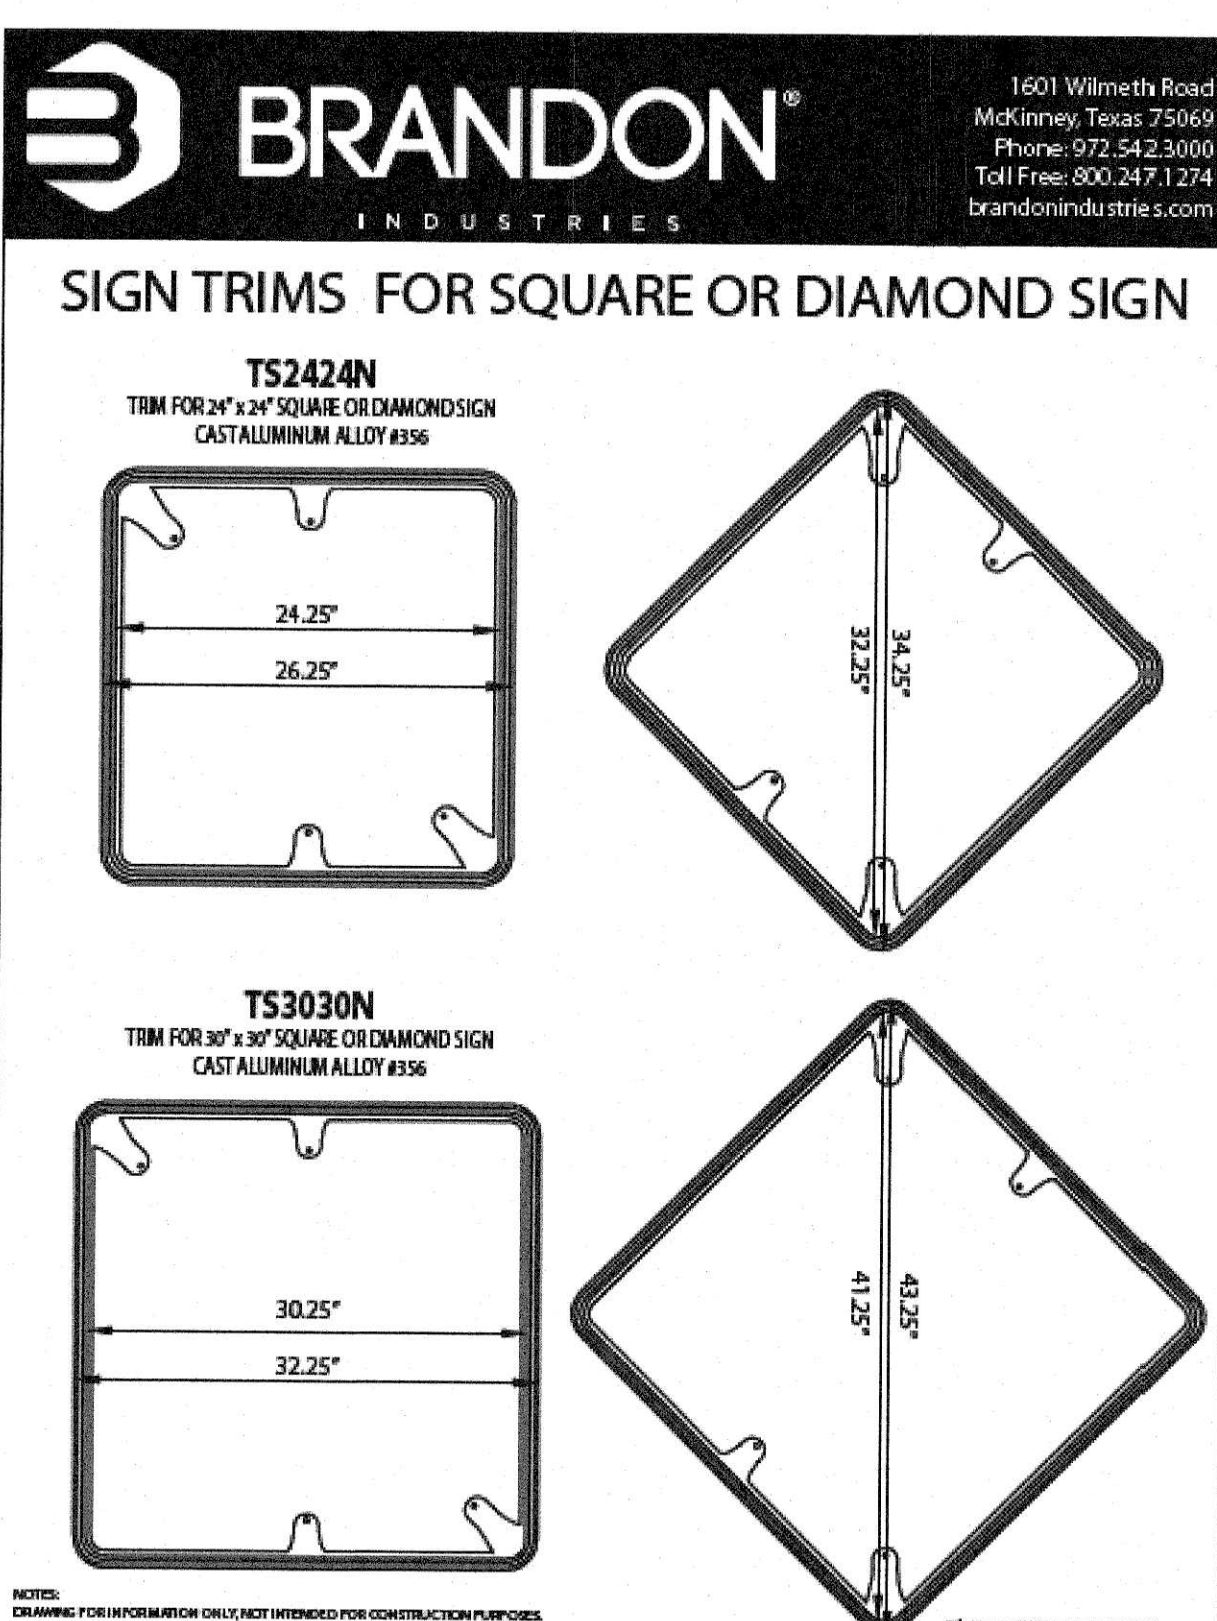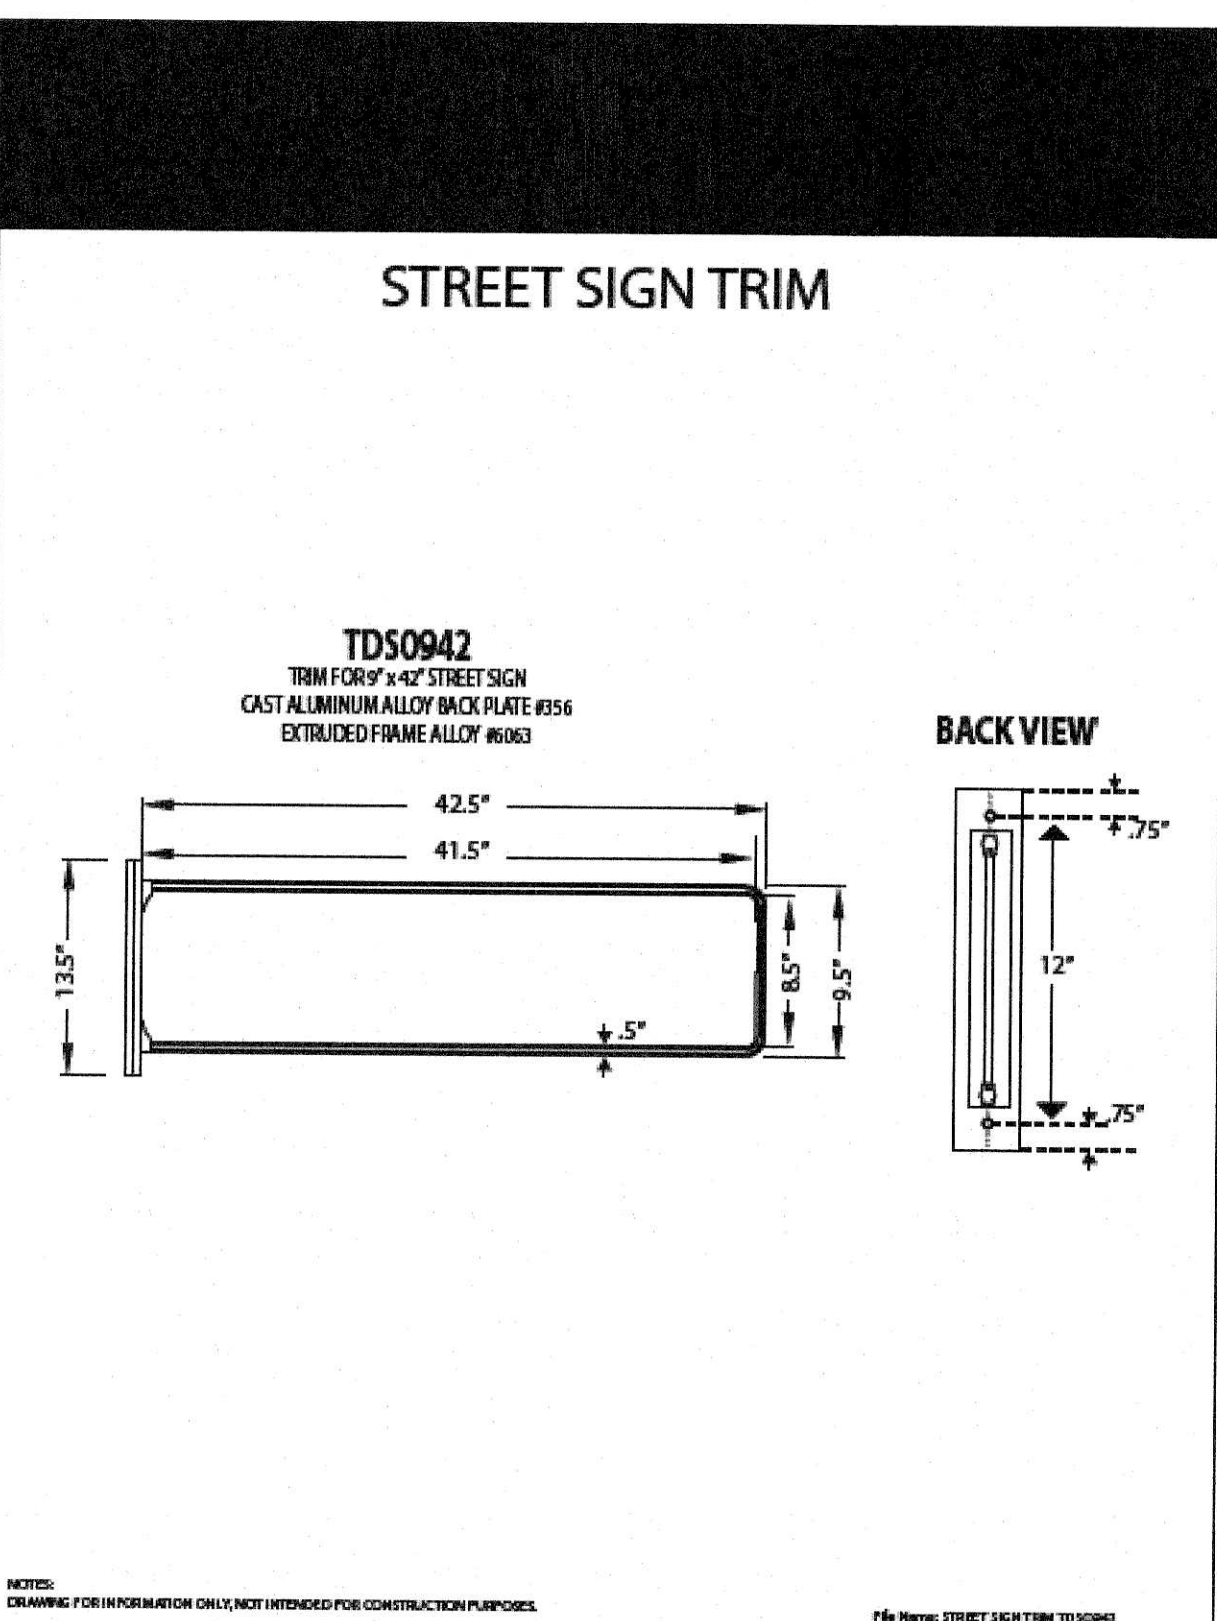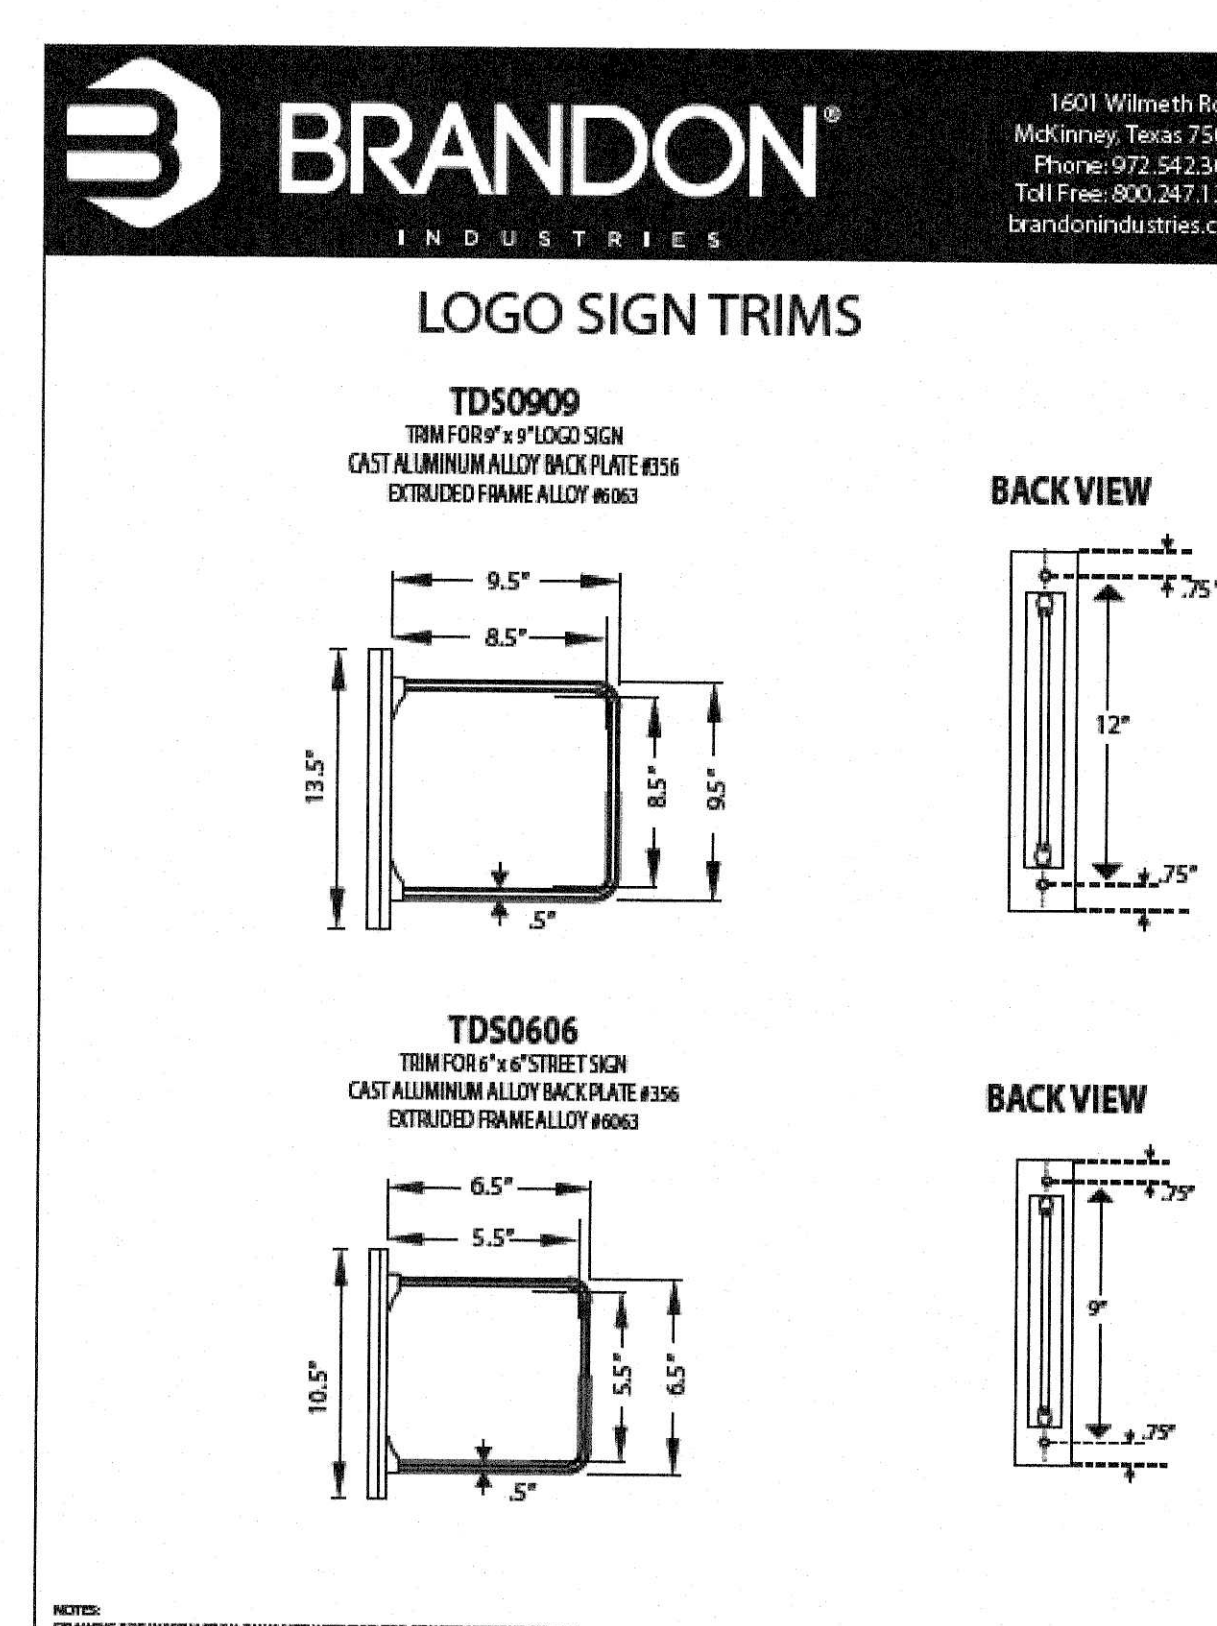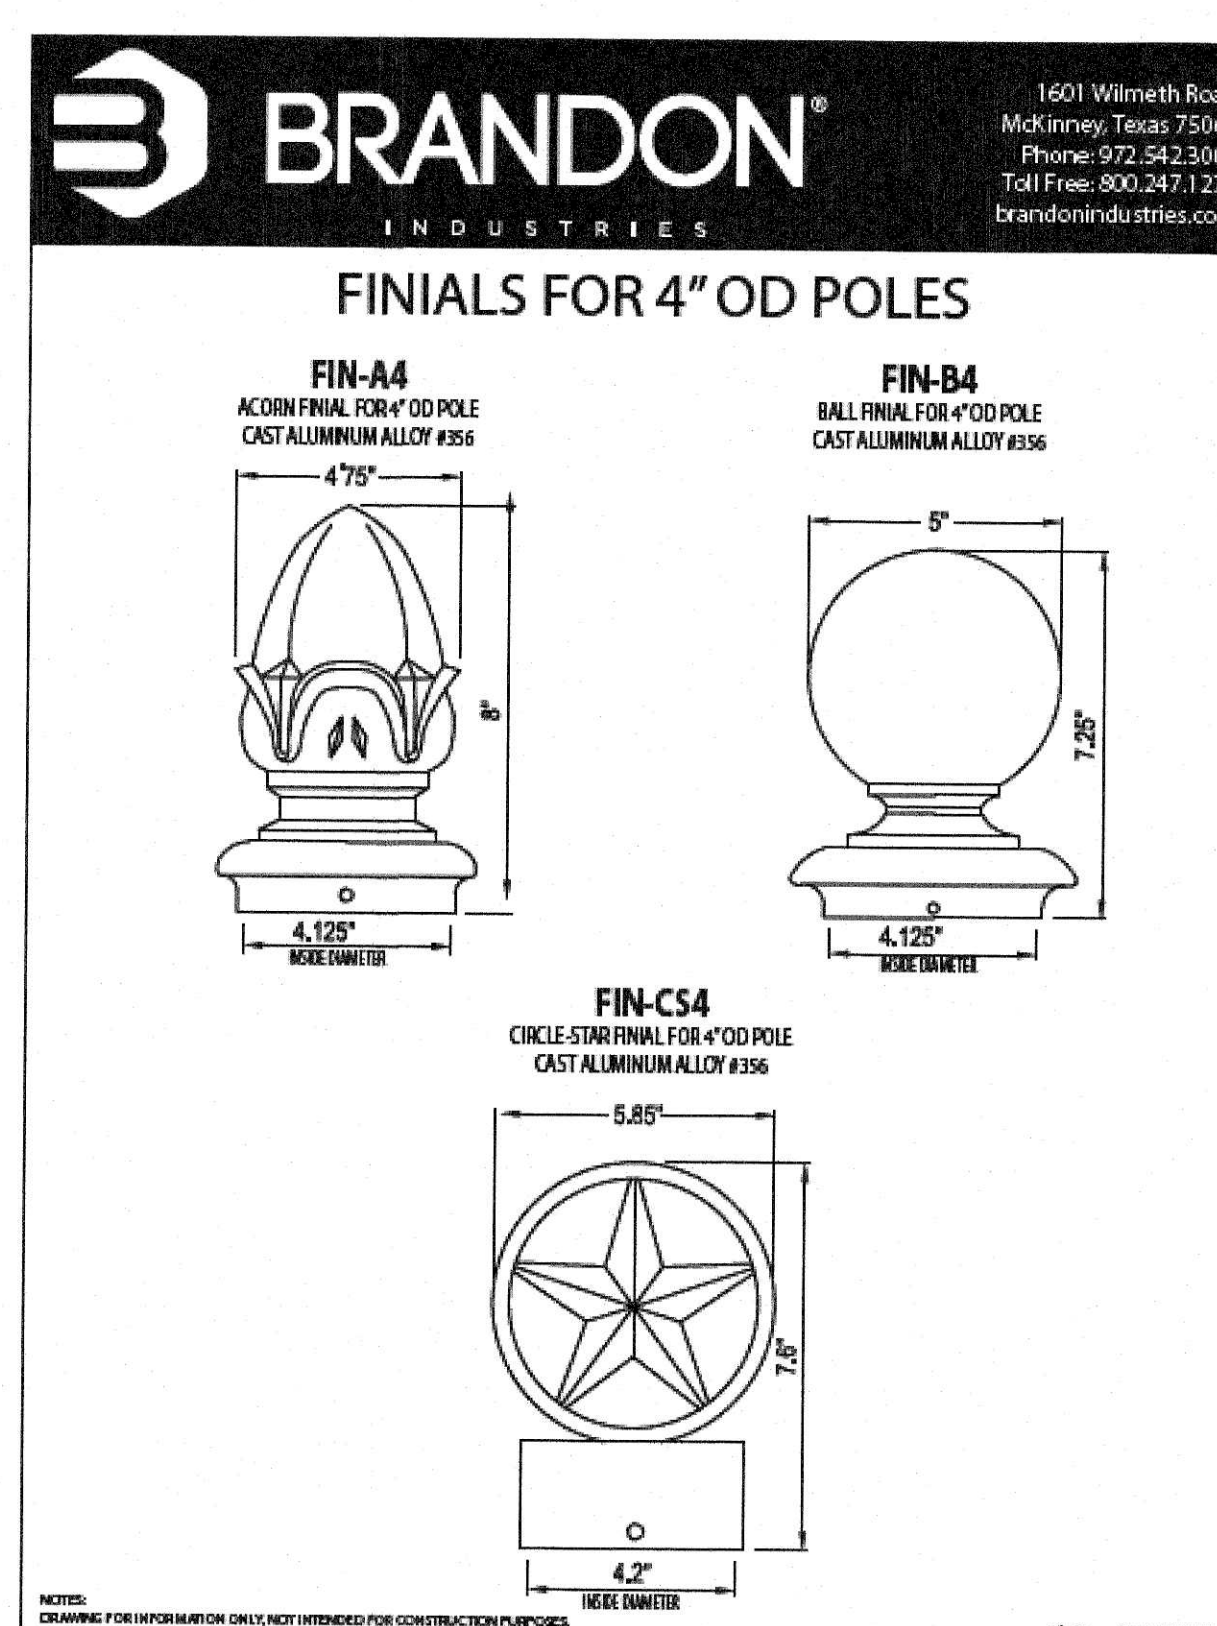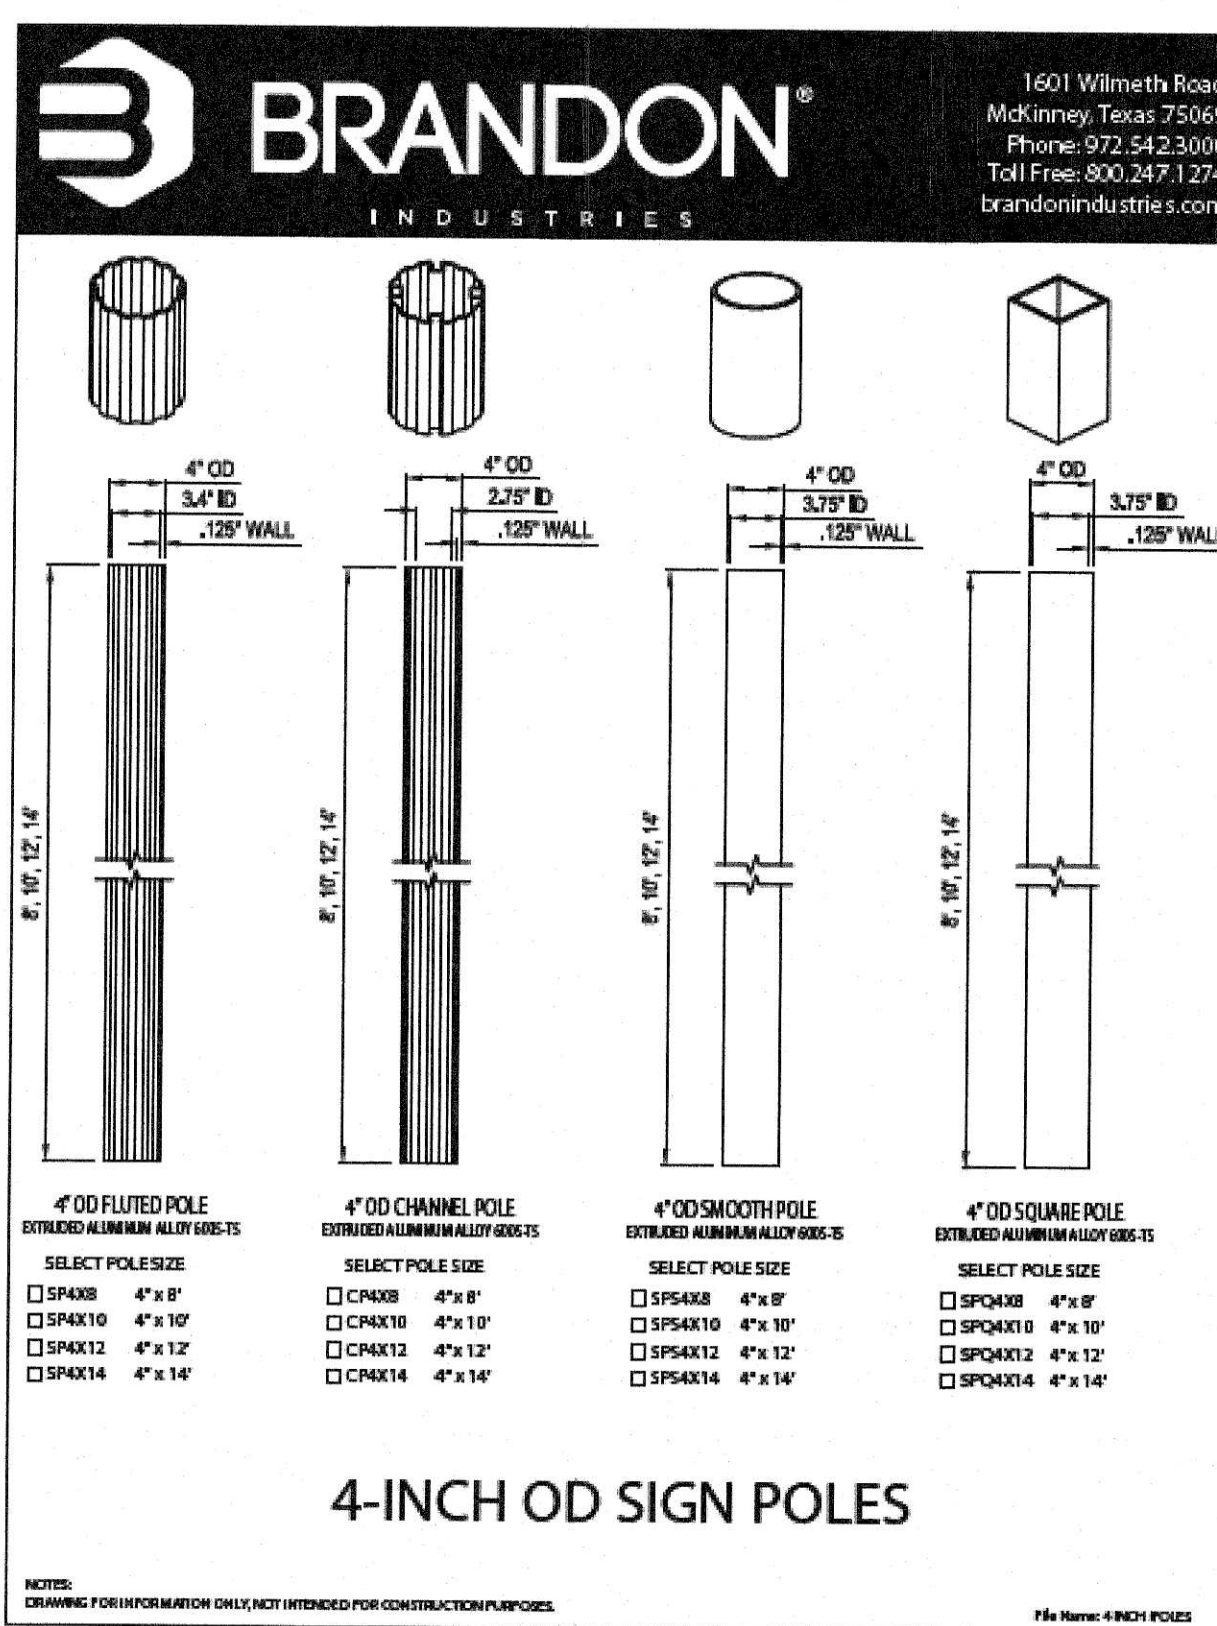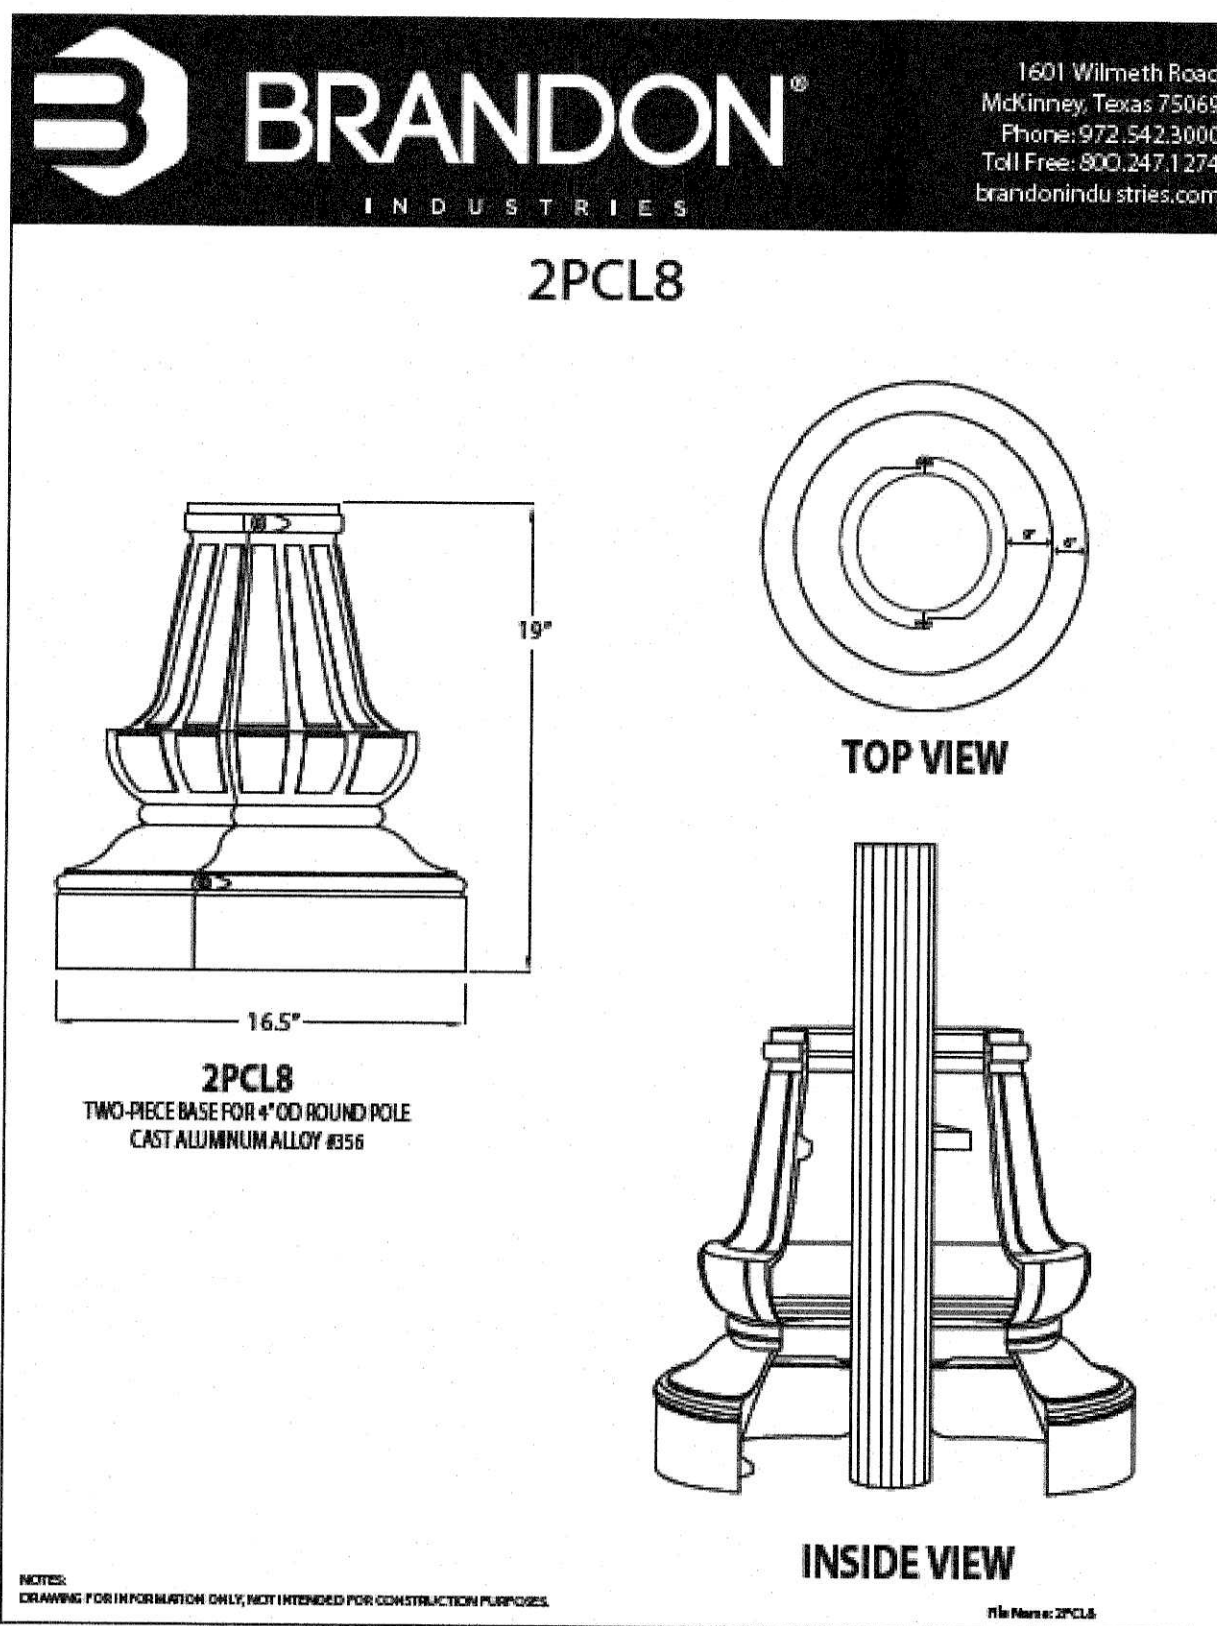

CORWIN ENGINEERING, INC. 200 W. BELMONT, SUITE E ALLEN, TEXAS 75013 (972) 396-1200 TBPE FIRM #5951			
DEVELOPMENT PLANS FOR STONE CREEK PHASE X ROCKWALL, TEXAS			
DECORATIVE SIGN POLE DETAILS			
DRAWN BY	DESIGNED BY	CHECKED BY	SHEET NO. 32
JOB NUMBER 19012	DATE MAY 2019	SCALE: 1"=100'	

AS-BUILT DECEMBER 2020
INFORMATION PROVIDED
BY CONTRACTORS
(NOT FIELD VERIFIED)