


DEVELOPMENT PLANS
FOR
STONE CREEK
PHASE VIII
CITY OF ROCKWALL, TEXAS

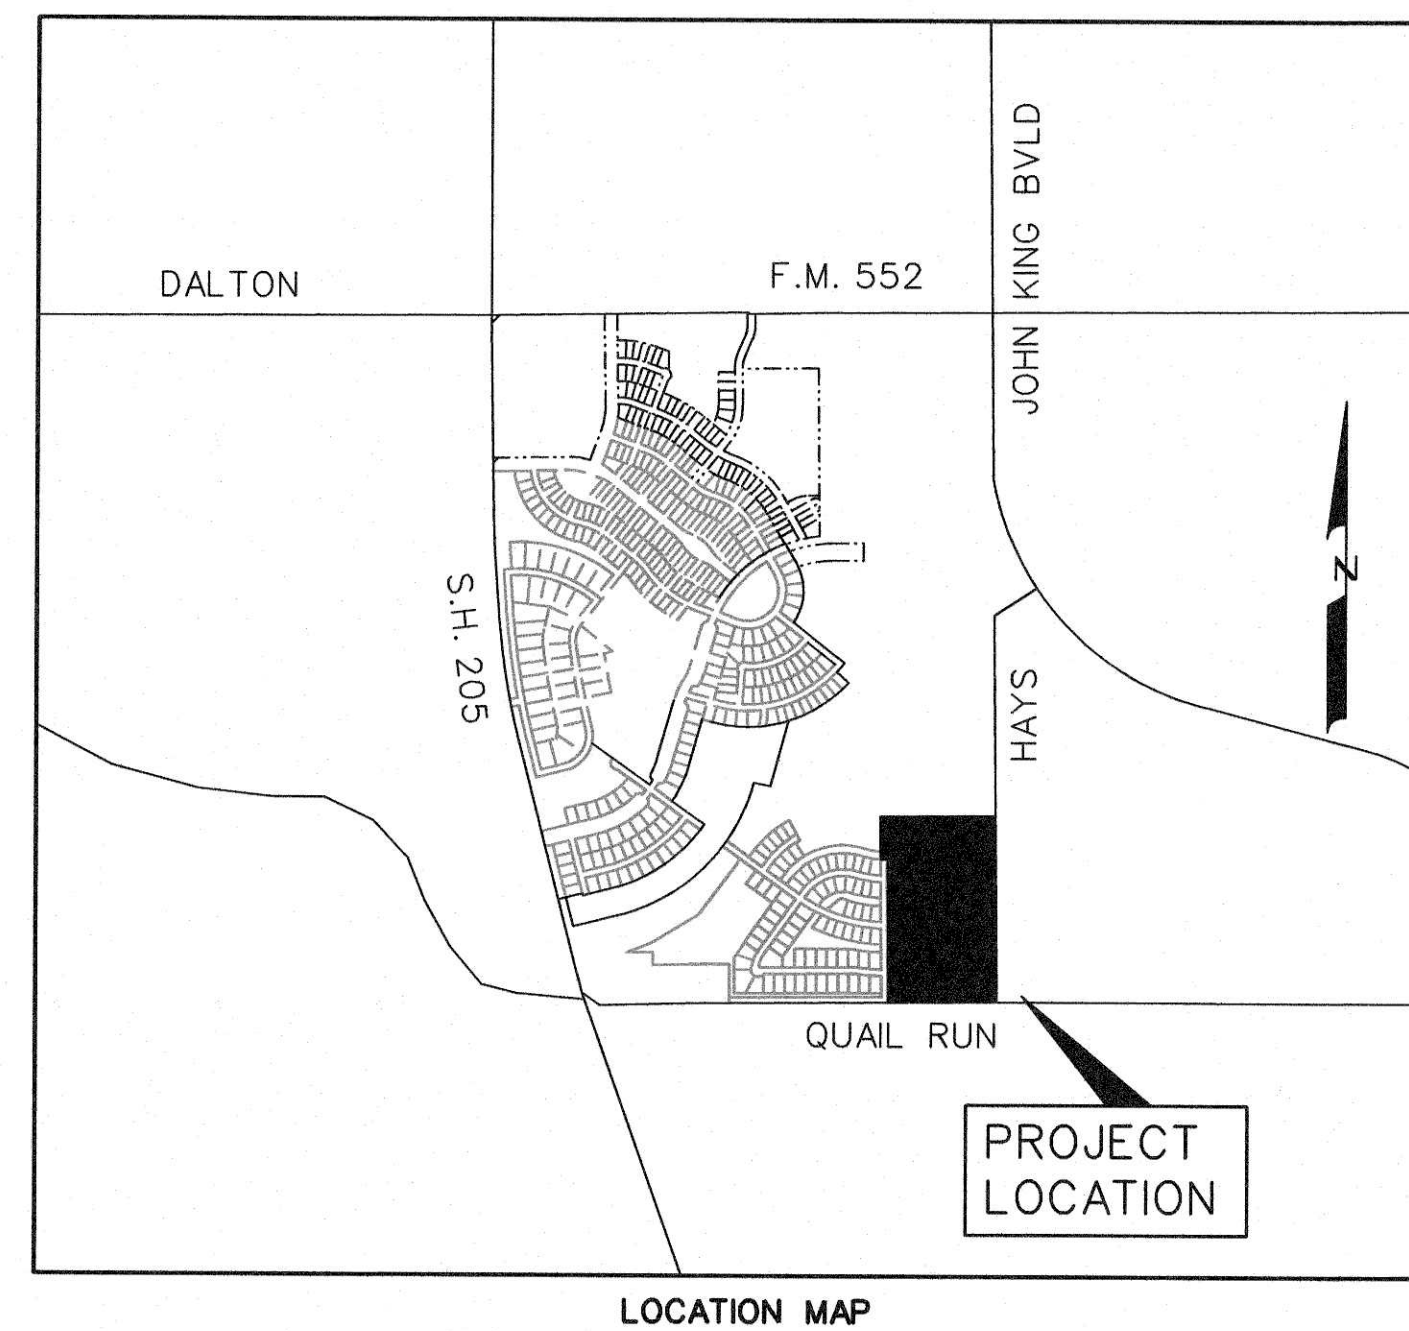


PREPARED FOR
STONE CREEK PHASE 8, LTD.
8214 WESTCHESTER DRIVE, SUITE 710, DALLAS, TEXAS 75225

CORWIN ENGINEERING, INC. — CONSULTING ENGINEERS
200 W. BELMONT, SUITE E TBPE FIRM #5951 ALLEN, TEXAS 75013

INDEX

- 1 TITLE
- 2 PLAT
- 3 EMERSON DRIVE
- 4 HARVARD DRIVE
- 5 NAKOMA DRIVE
- 6 MONTROSE DRIVE, MEMORIAL DRIVE
- 7 WANETA DRIVE
- 8 QUAIL RUN ROAD
- 9 QUAIL RUN ROAD CROSS SECTIONS
- 10 HAYS ROAD
- 11 HAYS ROAD
- 12 HAYS ROAD CROSS SECTIONS
- 12A SIDEWALK RAMP DETAILS
- 13 WATER AND SANITARY SEWER PLAN
- 14 SANITARY SEWER PROFILES
- 15 SANITARY SEWER PROFILES
- 16 EXISTING CONDITIONS DRAINAGE AREA MAP
- 17 DRAINAGE AREA MAP
- 17A INTERIM CONDITIONS DRAINAGE AREA MAP
- 18 DRAINAGE CALCULATIONS
- 19 STORM SEWER PLAN AND PROFILE LINES 'D-1' & 'D-2'
- 20 STORM SEWER PLAN AND PROFILE LINE 'D-3'
- 21 STORM SEWER PLAN AND PROFILE LINE 'D-4'
- 22 STORM SEWER PLAN AND PROFILE LINE 'D-7'
- 23 STORM SEWER PLAN AND PROFILE LINE 'D-5'
- 24 STORM SEWER PROFILES
- 25 GRADING PLAN
- 26 EROSION CONTROL PLAN
- 27 SIGN AND LIGHT PLAN
- 28 QUAIL RUN ROAD TRAFFIC SIGNAGE PLAN
- 29 HAYS ROAD TRAFFIC SIGNAGE PLAN
- 30 PHASE 1 DETOUR PLAN - HAYS ROAD CLOSURE
- 31 PHASE 2 DETOUR PLAN - QUAIL RUN CLOSURE
- 32 PHASE 3 DETOUR PLAN - QUAIL RUN CLOSURE

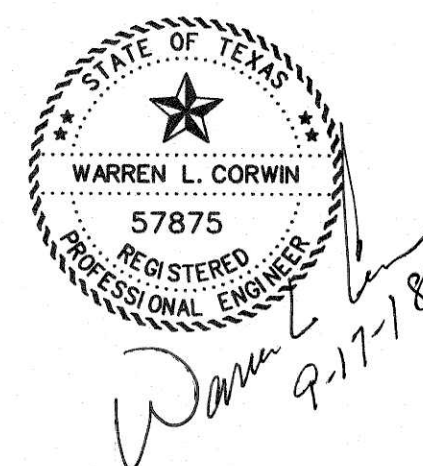

BENCHMARK:

CITY OF ROCKWALL SURVEY MONUMENT ON AN INLET
AT THE NORTHWEST CORNER OF FEATHERSTONE DR. AND
HARVARD DR.
ELEV. = 525.31



AS-BUILT SEPTEMBER 2018
INFORMATION PROVIDED
BY CONTRACTORS
(NOT FIELD VERIFIED)

NOTE:

CITY OF ROCKWALL STANDARDS
AND NCTCOG 3rd ADDITION STANDARDS
SHALL BE USED FOR REFERENCE.

| NO. | REVISIONS | DATE |
|-----|-----------|------|
| | | |
| | | |

OCTOBER 2016

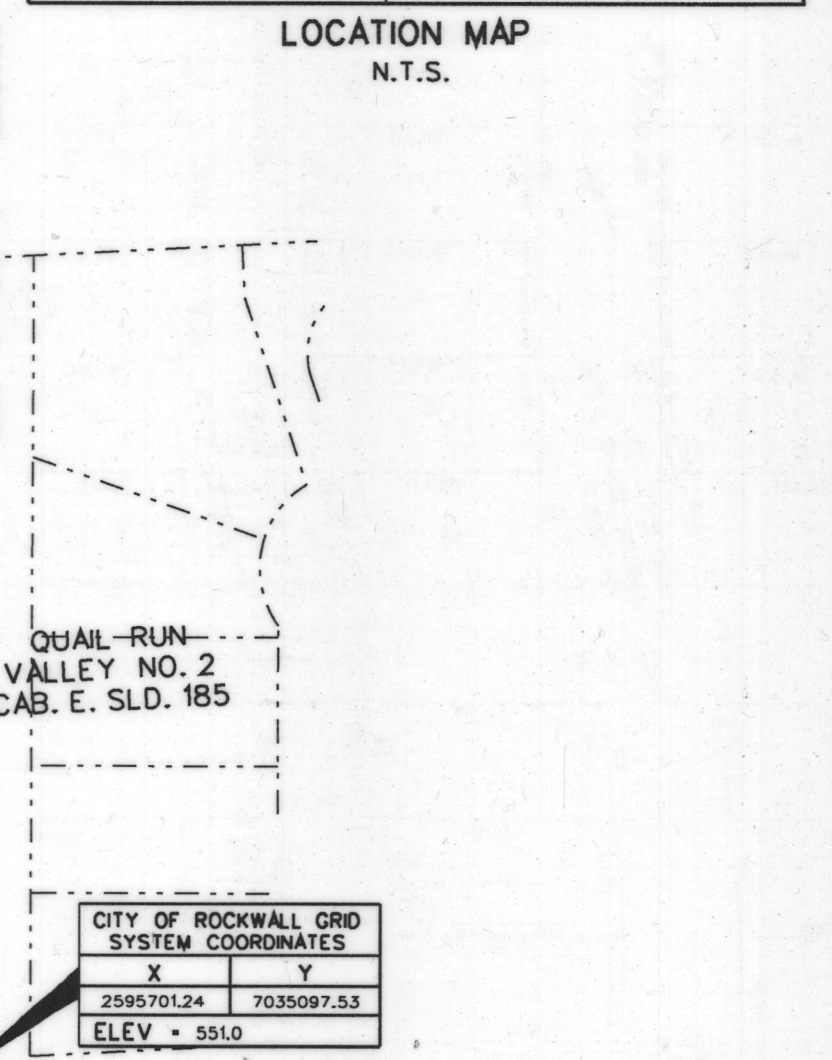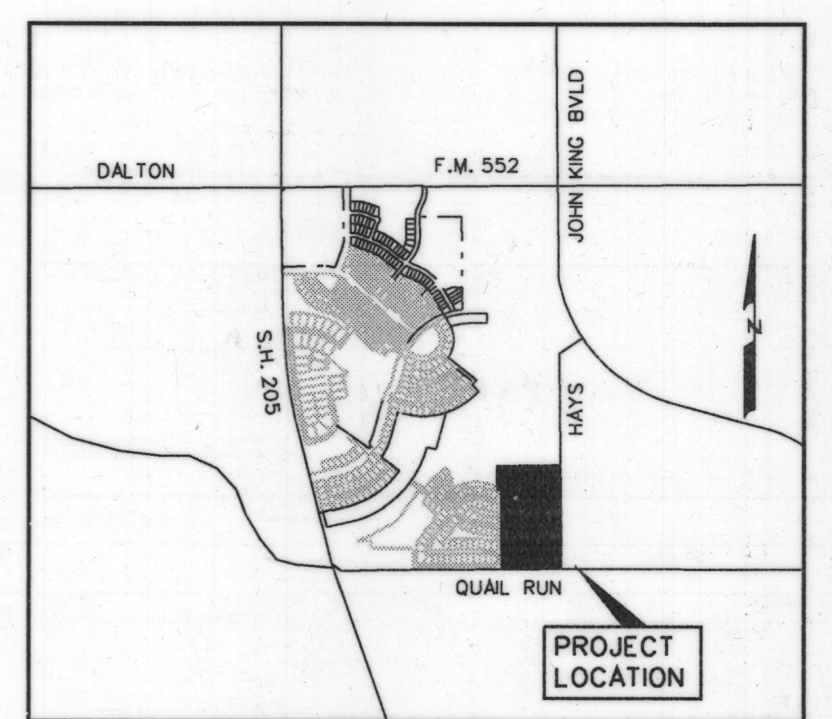

5289

FINAL PLAT

OF

STONE CREEK

PHASE VIII

TOTAL RESIDENTIAL LOTS 102

TOTAL ACRES 28.655

OUT OF THE

S. KING SURVEY, ABSTRACT NO. 131

IN THE

CITY OF ROCKWALL

ROCKWALL COUNTY, TEXAS

OWNER

STONE CREEK PHASE 8, LTD.

8214 WESTCHESTER DRIVE, SUITE 710

DALLAS, TEXAS 75225

214-522-4945

PREPARED BY

CORWIN ENGINEERING, INC.

200 W. BELMONT, SUITE E

ALLEN, TEXAS 75013

972-396-1200

OCTOBER 2017 SCALE 1" = 100'

CASE NO. P2017-023

SHEET 1 OF 2

OWNER'S CERTIFICATE

NOW, THEREFORE, KNOW ALL MEN BY THESE PRESENTS:

STATE OF TEXAS
COUNTY OF ROCKWALL

We the undersigned owners of the land shown on this plat, and designated herein as the STONE CREEK PHASE VIII, subdivision to the City of Rockwall, Texas, and whose name is subscribed hereto, hereby dedicate to the use of the public forever all streets, alleys, parks, water courses, drains, easements and public places thereon shown on the purpose and consideration therein expressed. We further certify that all other parties who have a mortgage or lien interest in the STONE CREEK PHASE VIII, subdivision have been notified and signed this plat.

We understand and do hereby reserve the easement strips shown on this plat for the purposes stated and for the mutual use and accommodation of all utilities desiring to use or using same. We also understand the following:

1. No buildings shall be constructed or placed upon, over, or across the utility easements as described herein.
2. Any public utility shall have the right to remove and keep removed all or part of any buildings, fences, trees, shrubs, or other growths or improvements which in any way endanger or interfere with construction, maintenance or efficiency of their respective system on any of these easement strips; and any public utility shall at all times have the right of ingress or egress to, from and upon the said easement strips for purpose of construction, reconstruction, inspecting, patrolling, maintaining, and either adding to or removing all or part of their respective system without the necessity of, at any time, procuring the permission of anyone.
3. The City of Rockwall will not be responsible for any claims of any nature resulting from or occasioned by the establishment of grade of streets in the subdivision.
4. The developer and subdivision engineer shall bear total responsibility for storm drain improvements.
5. The developer shall be responsible for the necessary facilities to provide drainage patterns and drainage controls such that properties within the drainage area are not adversely affected by storm drainage from the development.
6. The detention drainage system is to be maintained, repaired and owned by the subdivision.
7. No house dwelling unit, or other structure shall be constructed on any lot in this addition by the owner or any other person until the developer and/or owner has complied with all requirements of the Subdivision Regulations of the City of Rockwall regarding improvements with respect to the entire block on the street or streets on which property abuts, including the actual installation of streets with the required base and paving, curb and gutter, water and sewer, drainage structures, storm structures, storm sewers, and alleys, all according to the specifications of the City of Rockwall; or

Until an escrow deposit, sufficient to pay for the cost of such improvements, as determined by the city's engineer and/or city administrator, computed on a private commercial rate basis, has been made with the city secretary, accompanied by an agreement signed by the developer and/or owner, authorizing the city to make such improvements at prevailing private commercial rates, or have the same made by a contractor and pay for the same out of the escrow deposit, should the developer and/or owner fail or refuse to install the required improvements within the time stated in such written agreement, but in no case shall the City be obligated to make such improvements itself. Such deposit may be used by the owner and/or developer as progress payments as the work progresses in making such improvements by making certified requisitions to the city secretary, supported by evidence of work done; or

Until the developer and/or owner files a corporate surety bond with the city secretary in a sum equal to the cost of such improvements for the designated area, guaranteeing the installation thereof within the time stated in the bond, which time shall be fixed by the city council of the City of Rockwall.

We further acknowledge that the dedications and/or exactions made herein are proportional to the impact of the Subdivision upon the public services required in order that the development will comport with the present and future growth needs of the City; we, our successors and assigns hereby waive any claim, damage, or cause of action that we may have as a result of the dedication of exactions made herein.

Stone Creek Phase 8, Ltd.
an Texas limited partnership
By: Stone Creek Phase 8 GP Corporation,
a Texas corporation, its General Partner

Richard Skorburg
President

STATE OF TEXAS
COUNTY OF DALLAS

Before me, the undersigned authority, on this day personally appeared RICHARD SKORBURG, known to me to be the person whose name is subscribed to the foregoing instrument, and acknowledged to me that he executed the same for the purpose and consideration therein stated. Given upon my hand and seal of office this 31 day of October, 2017.

Notary Public in and for the State of Texas My Commission Expires: 6-30-2019

NOTE: It shall be the policy of the City of Rockwall to withhold issuing building permits until all streets, water, sewer and storm drainage systems have been accepted by the City. The approval of a plat by the City does not constitute any representation, assurance or guarantee that any building within such plat shall be approved, authorized or permit therefore issued, nor shall such approval constitute any representation, assurance or guarantee by the City of the adequacy and availability for water for personal use and fire protection within such plat, as required under Ordinance 83-54.

Planning & Zoning Commission

Date

APPROVED

I hereby certify that the above and foregoing plat of an addition to the City of Rockwall, Texas, was approved by the City Council of the City of Rockwall on the 15 day of May, 2017.

This approval shall be invalid unless the approved plat for such addition is recorded in the office of the County Clerk of Rockwall, County, Texas, within one hundred eighty (180) days from said date of final approval.

WITNESS OUR HANDS, this 29th day of January, 2018

Mayor, City of Rockwall

City Secretary

City Engineer

LEGAL DESCRIPTION

WHEREAS, STONE CREEK PHASE 8, LTD., is the owner of a tract of land situated in the S. King Survey, Abstract No. 131 in the City of Rockwall, Rockwall County, Texas, being part of a tract of land as described in Stone Creek Balance LTD., Clerks File No. 2007-00375394 in the Deed Records of Rockwall County, Texas, and being more particularly described as follows:

BEGINNING, at a "X" cut found at the most southeast corner of Stone Creek Phase VII, an addition to the City of Rockwall, as described in Cabinet I, Pages 392-394, in the Plat Records of Rockwall County, Texas;

THENCE, North 00° 35' 35" West, along the east line of said Stone Creek Phase VII, for a distance of 1080.02 feet, to a 1/2 inch iron rod found, on a non-tangent curve to the right, having a radius of 655.00 feet, a central angle of 04° 22' 44", and a tangent of 25.04 feet;

THENCE, continuing along said east line and with said curve to the right for an arc distance of 50.06 feet (Chord Bearing North 88° 06' 43" West - 50.05 feet), to a 1/2 inch iron rod found;

THENCE, North 00° 35' 35" West, continuing along said east line at 60.22 feet, passing a 1/2 inch iron rod found at the northeast corner of said Stone Creek Phase VII, and continuing for a total distance of 191.20 feet, to a 1/2 inch iron rod set with a yellow cap stamped with "Corwin Eng. Inc.";

THENCE, North 03° 34' 06" East, for a distance of 50.00 feet, to a 1/2 inch iron rod set with a yellow cap stamped with "Corwin Eng. Inc.", on a non-tangent curve to the left, having a radius of 800.00 feet, a central angle of 01° 08' 34", and a tangent of 7.98 feet;

THENCE, along said curve to the left for an arc distance of 15.96 feet (Chord Bearing South 87° 00' 11" East - 15.96 feet), to a 1/2 inch iron rod set with a yellow cap stamped with "Corwin Eng. Inc.";

THENCE, North 02° 25' 32" East, for a distance of 120.00 feet, to a 1/2 inch iron rod set with a yellow cap stamped with "Corwin Eng. Inc.", on a curve to the left, having a radius of 680.00 feet, a central angle of 14° 11' 44", and a tangent of 84.67 feet;

THENCE, along said curve to the left for an arc distance of 168.48 feet (Chord Bearing North 85° 19' 40" East - 168.05 feet), to a 1/2 inch iron rod set with a yellow cap stamped with "Corwin Eng. Inc.", at the point of reverse curvature of a curve to the right, having a radius of 1270.00 feet, a central angle of 11° 10' 37", and a tangent of 124.27 feet;

THENCE, along said curve to the right for an arc distance of 247.74 feet (Chord Bearing North 83° 49' 06" East - 247.35 feet), to a 1/2 inch iron rod set with a yellow cap stamped with "Corwin Eng. Inc.", at the point of tangency;

THENCE, North 89° 24' 25" East, for a distance of 448.33 feet, to a 1/2 inch iron rod set with a yellow cap stamped with "Corwin Eng. Inc.", in the east line of said Stone Creek Balance tract being in Hayes Road (Variable R.O.W.);

THENCE, South 00° 35' 35" East, along the east line of said Stone Creek Balance tract and with said Hayes Road, for a distance of 1480.61 feet, to a 1/2 inch iron rod set with a yellow cap stamped with "Corwin Eng. Inc.", being the southeast corner of said Stone Creek Balance tract and being the approximate centerline of said Hayes Road and Quail Run Road (Variable R.O.W.);

THENCE, South 89° 34' 36" West, along the south line of said Stone Creek Balance tract and with said Quail Run Road, at 417.06, passing the northeast corner of Quail Run Valley No. 2, an addition to the City of Rockwall, as described in Cob. E, Pg. 185, in said Plat Records, and continuing along the north line of said Quail Run Valley No. 2, for a total distance of 838.00 feet, to the POINT OF BEGINNING and containing 28.655 acres of land.

SURVEYOR CERTIFICATE

I, WARREN L. CORWIN, do hereby certify that the plat shown hereon accurately represents the results of an on-the-ground survey made under my direction and supervision and all corners are as shown thereon and there are no encroachments, conflicts, protrusions or visible utilities on the ground except as shown and said plat has been prepared in accordance with the plotting rules and regulations of the City Plan Commission of the City of Rockwall, Texas.

DATED the this 24 day of Oct, 2017.

WARREN L. CORWIN
R.P.L.S. No. 4621

THE STATE OF TEXAS
COUNTY OF COLLIN

BEFORE ME, the undersigned, a Notary Public in and for the State of Texas, on this day personally appeared WARREN L. CORWIN, known to me to be the person whose name is subscribed to the foregoing instrument and acknowledged to me that he executed the same in the capacity therein stated and for the purposes and considerations therein expressed.

WITNESS MY HAND AND SEAL OF OFFICE, this the 24 day of Oct, 2017.

Notary Public in and for the State of Texas



Filed and Recorded
Official Public Records
Shelli Miller, County Clerk
Rockwall County, Texas
03/06/2018 11:29:24 AM
\$100.00
20180000003835



Shelli Miller
County Clerk

COPY

FINAL PLAT
OFSTONE CREEK
PHASE VIIITOTAL RESIDENTIAL LOTS 102
TOTAL ACRES 28.655

OUT OF THE

S. KING SURVEY, ABSTRACT NO. 131

IN THE

CITY OF ROCKWALL
ROCKWALL COUNTY, TEXAS

OWNER

STONE CREEK PHASE 8, LTD.

8214 WESTCHESTER DRIVE, SUITE 710
DALLAS, TEXAS 75225
214-522-4945

PREPARED BY

CORWIN ENGINEERING, INC.


200 W. BELMONT, SUITE E
ALLEN, TEXAS 75013
972-396-1200

OCTOBER 2017

CASE NO. P2017-023

SHEET 2 OF 2

0 20 40 80
SCALE: 1" = 40'

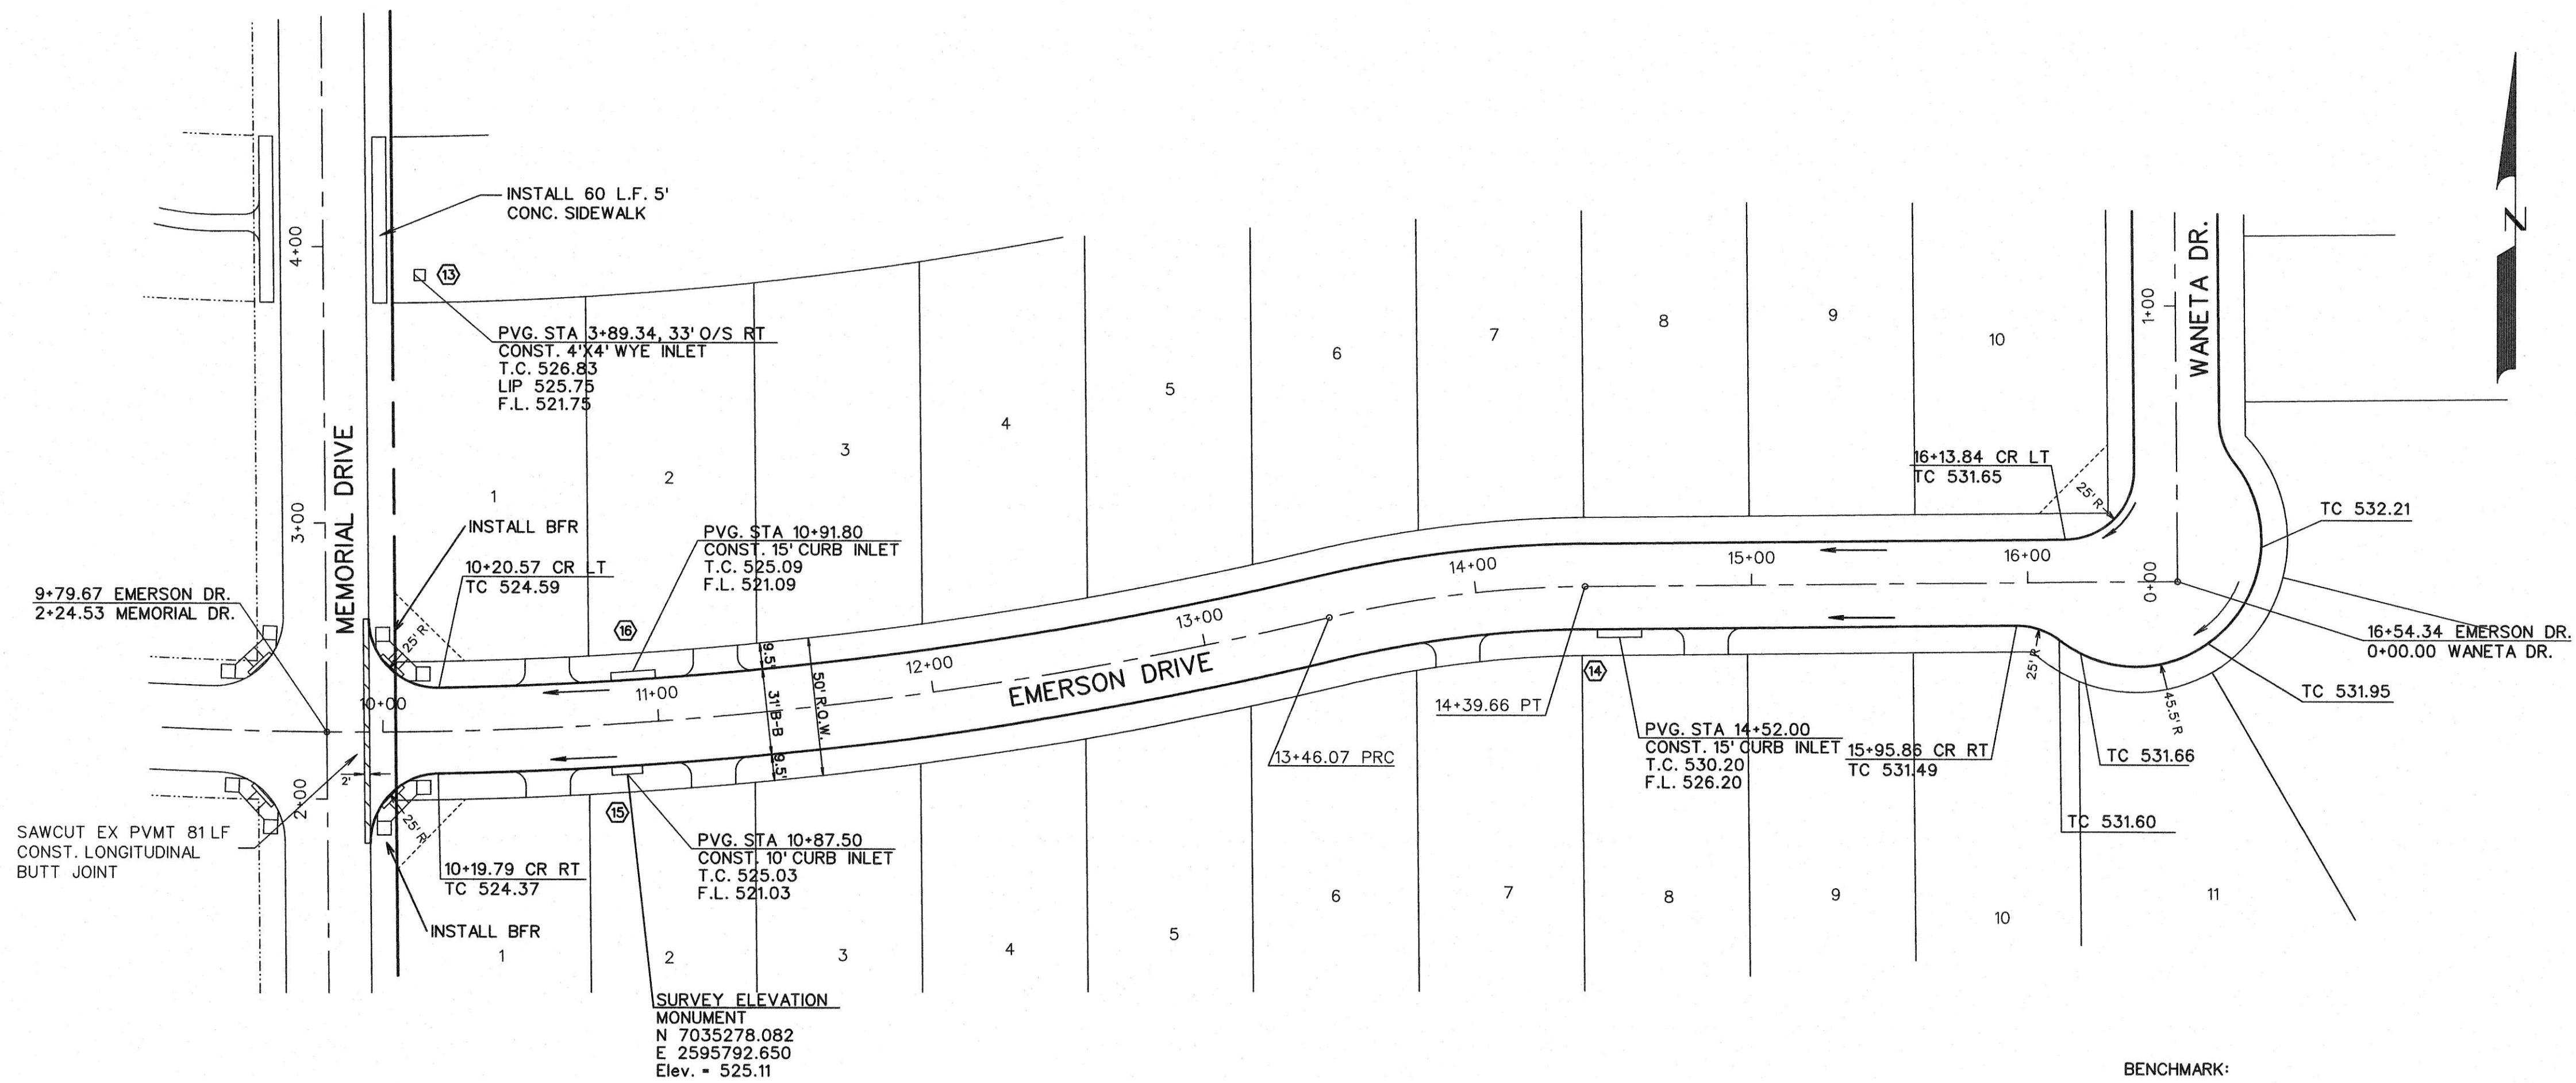


SURVEY ELEVATION
MONUMENT
N 7035278.082
E 2595792.650
Elev. = 525.11

BENCHMARK:

CITY OF ROCKWALL SURVEY MONUMENT ON AN INLET
AT THE NORTHWEST CORNER OF FEATHERSTONE DR. AND
HARVARD DR.

ELEV. = 525.31

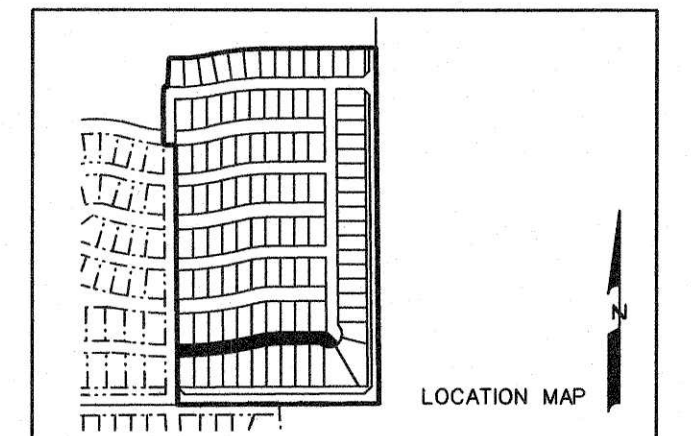

PROPOSED TC LT


535

530


525

520

PROPOSED TC RT

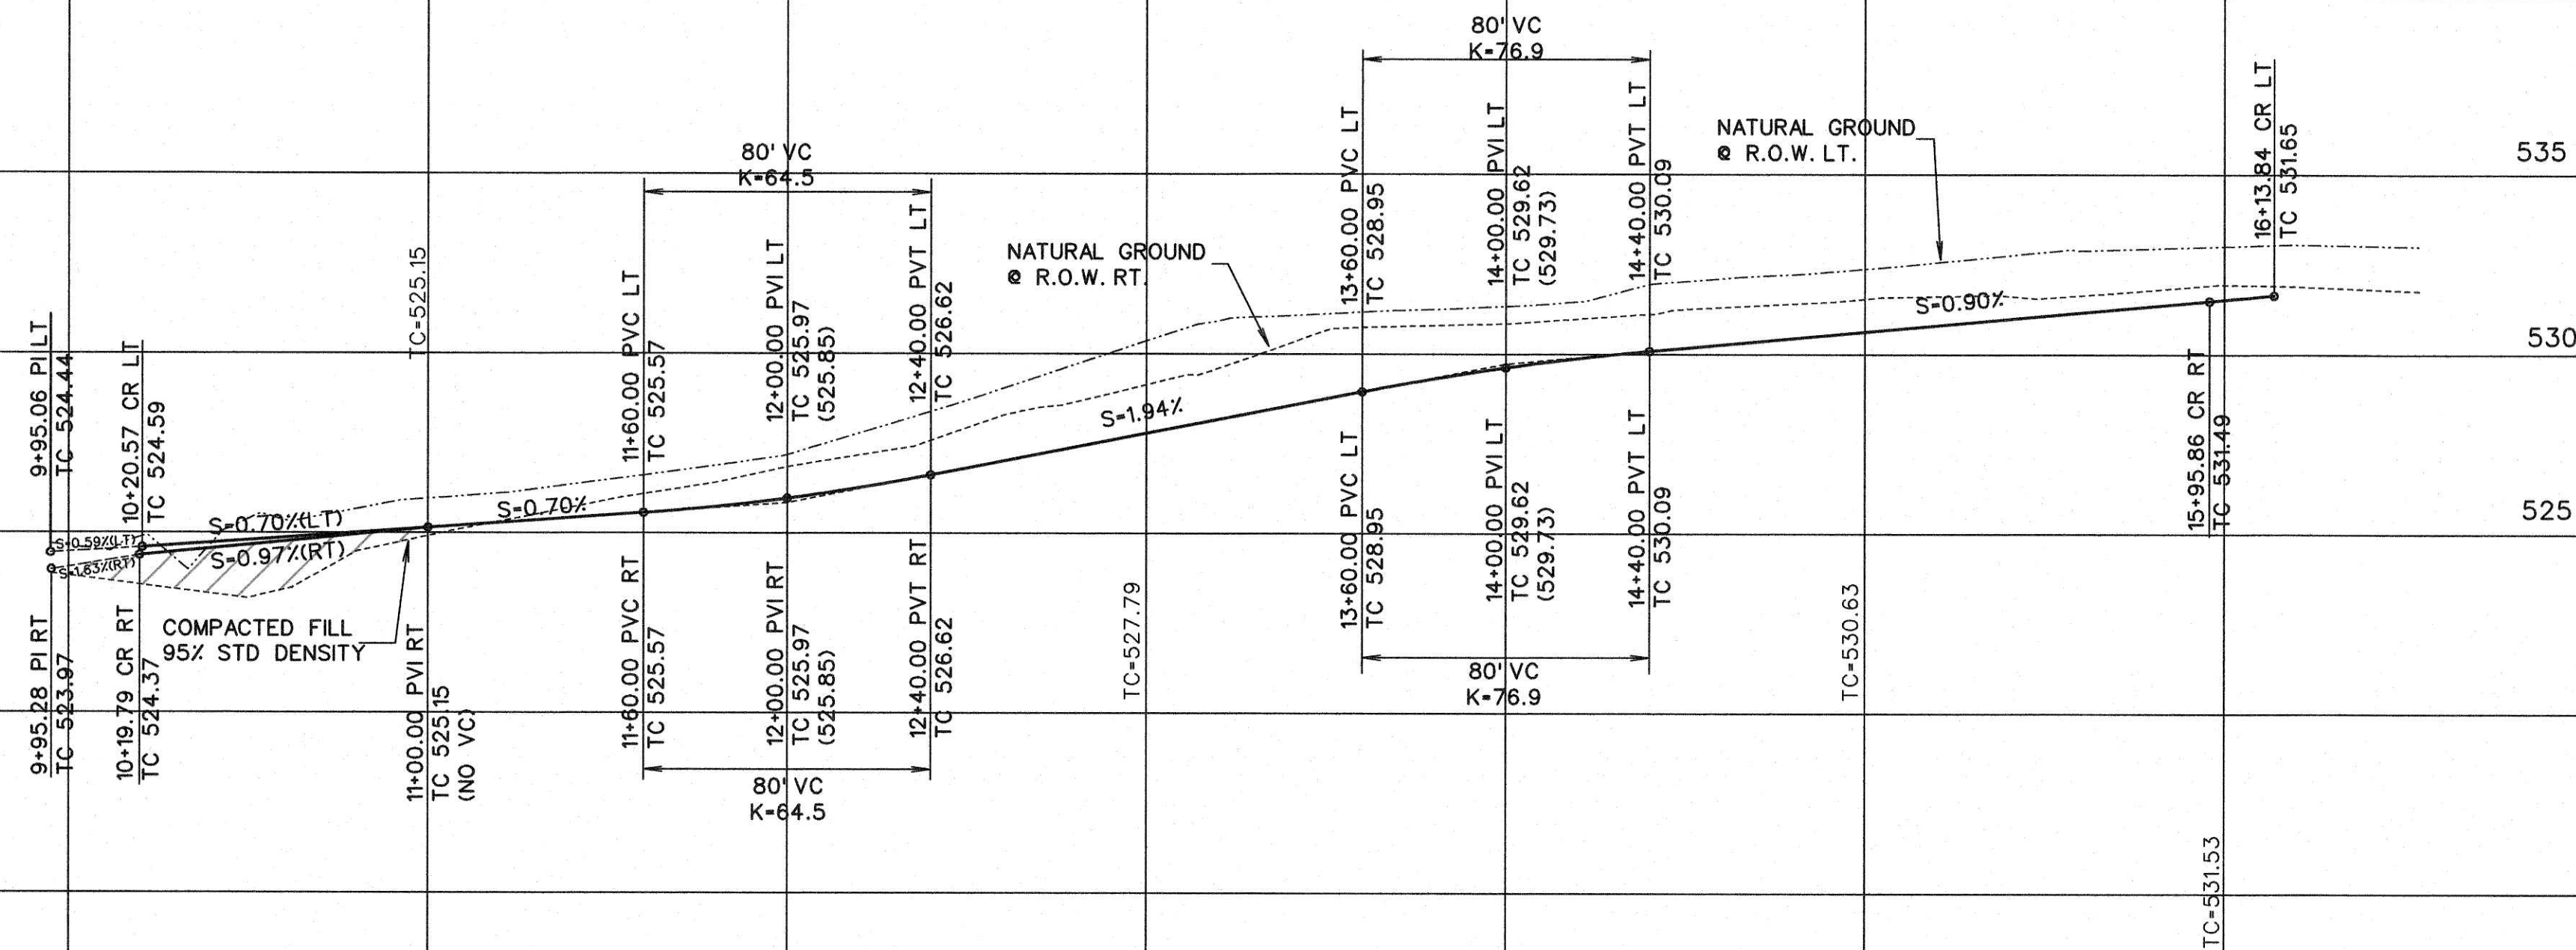

AS-BUILT SEPTEMBER 2018
INFORMATION PROVIDED
BY CONTRACTORS
(NOT FIELD VERIFIED)


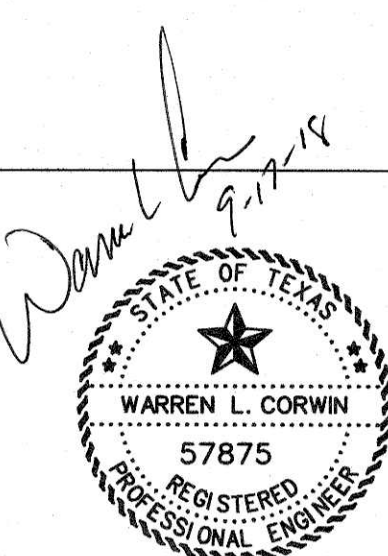




CORWIN ENGINEERING, INC.
200 W. BELMONT, SUITE E
ALLEN, TEXAS 75013 (972)396-1200
TBPE FIRM #5951


DEVELOPMENT PLANS FOR
STONE CREEK
PHASE VIII
ROCKWALL, TEXAS



EMERSON DRIVE

| | | | |
|------------|--------------|----------------------------------|-----------|
| DRAWN BY | DESIGNED BY | CHECKED BY | SHEET NO. |
| JOB NUMBER | DATE | SCALE: HOR: 1"=40' VER: 1"=4' | 3 OF 32 |
| 16044 | OCTOBER 2016 | | |

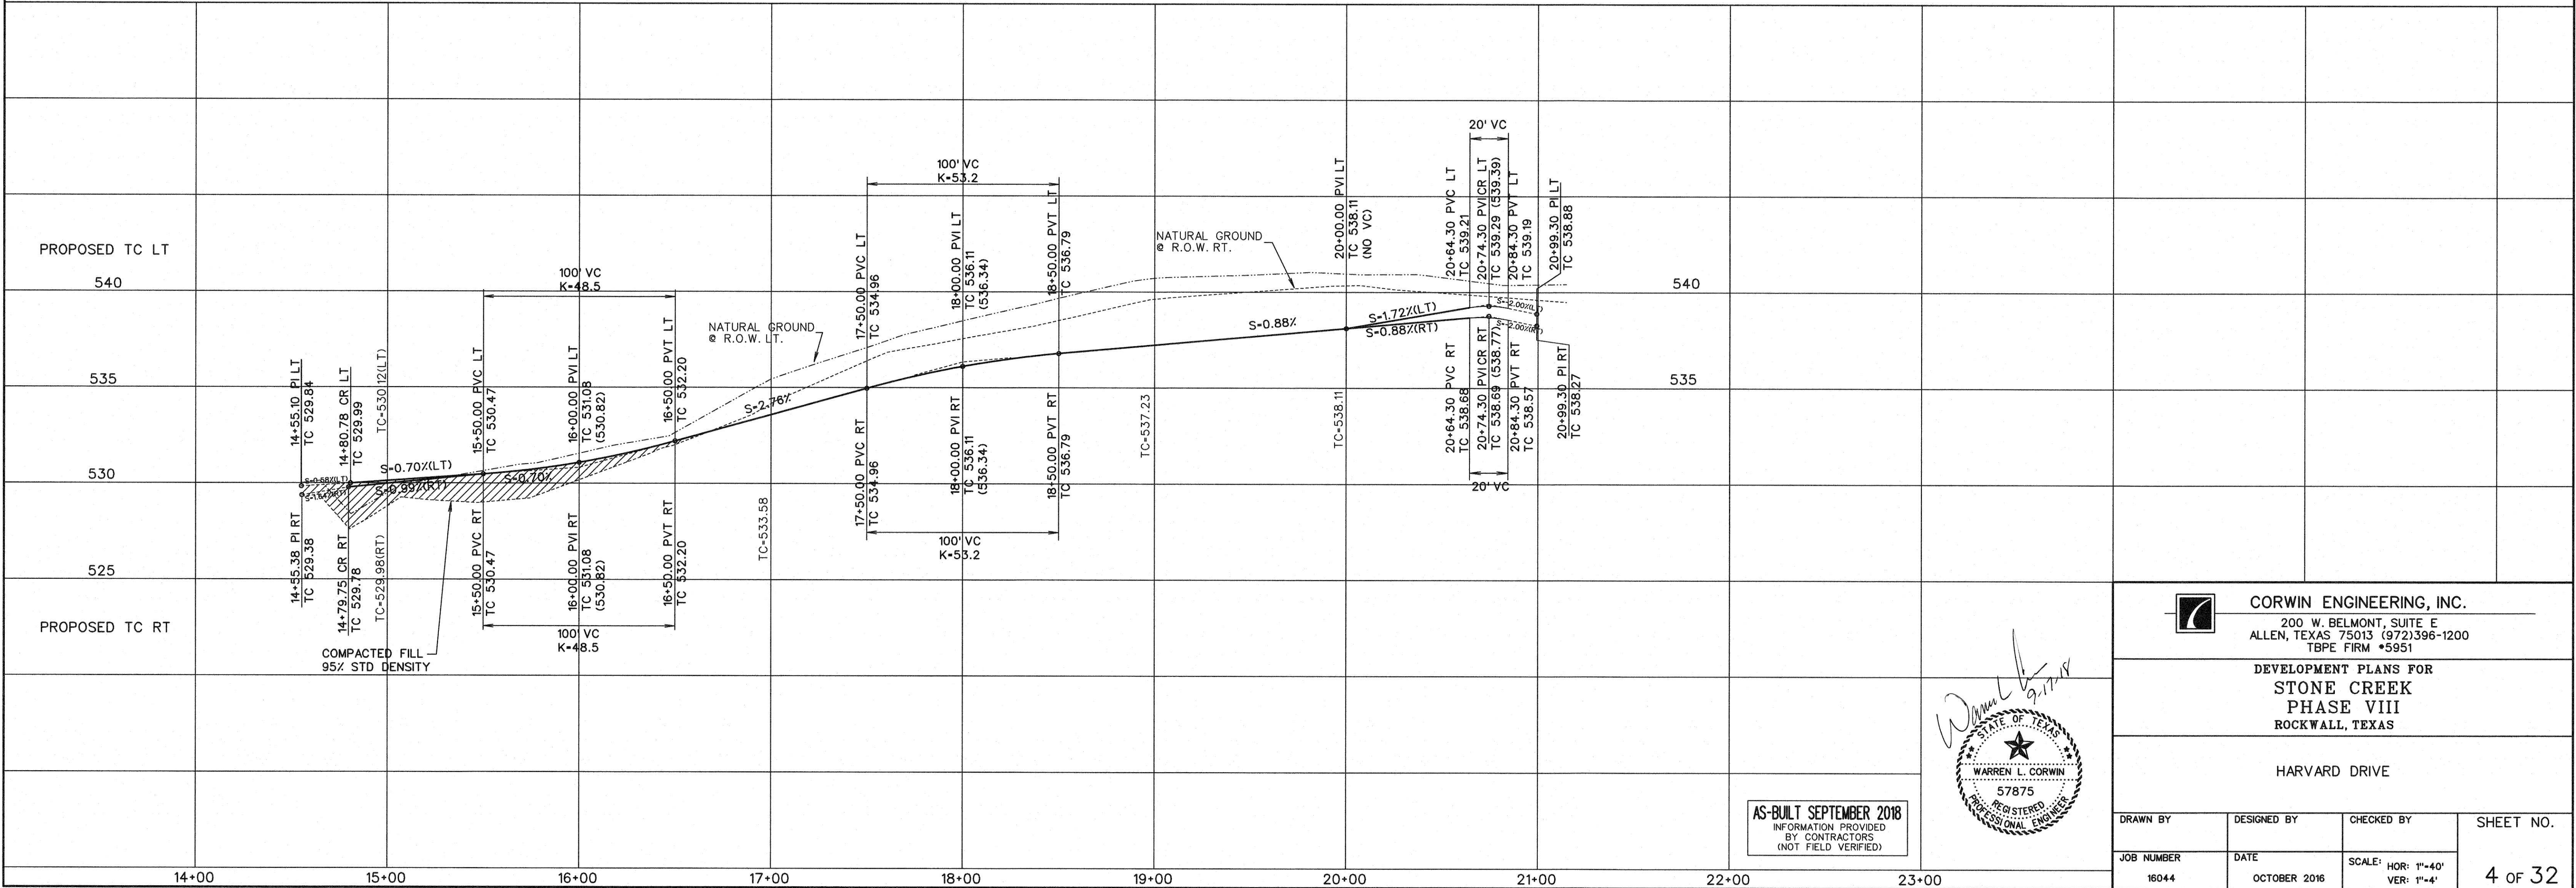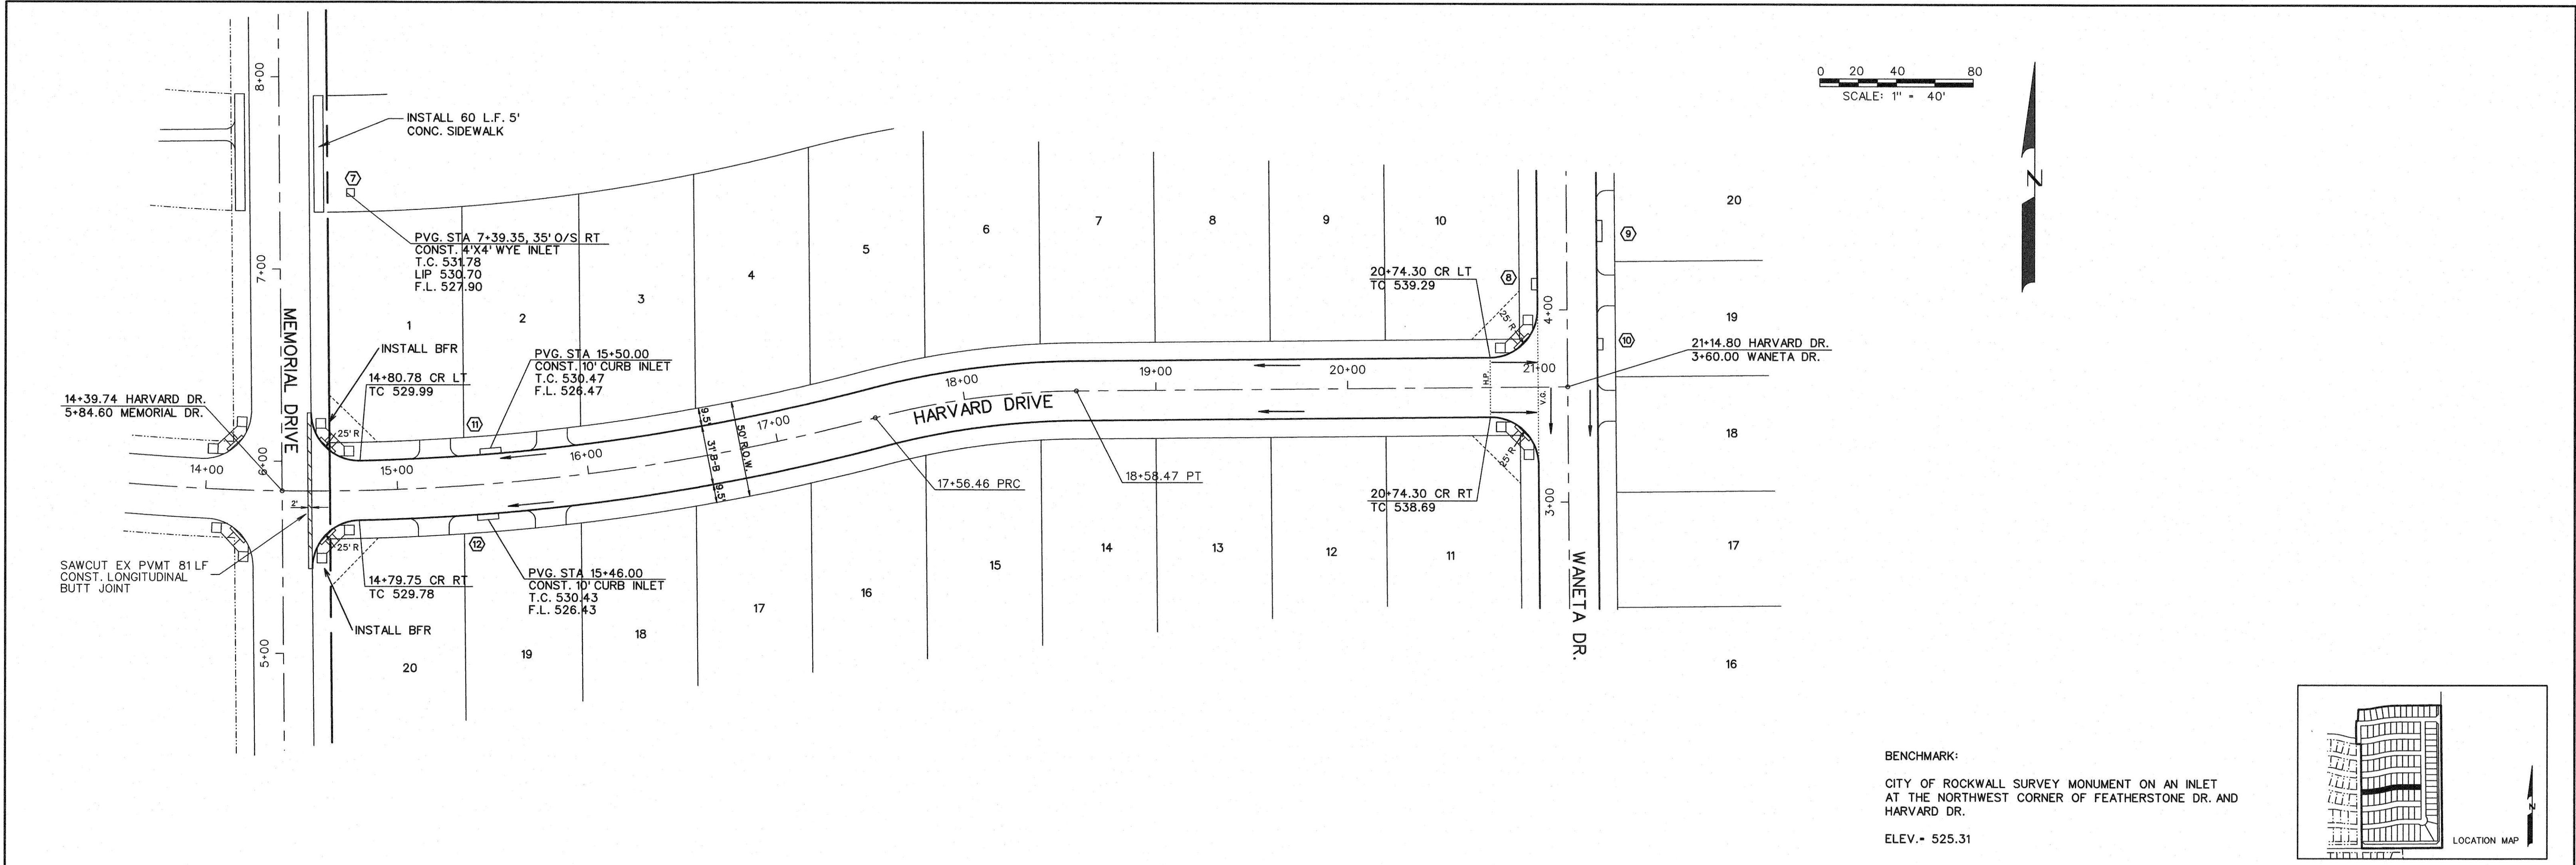


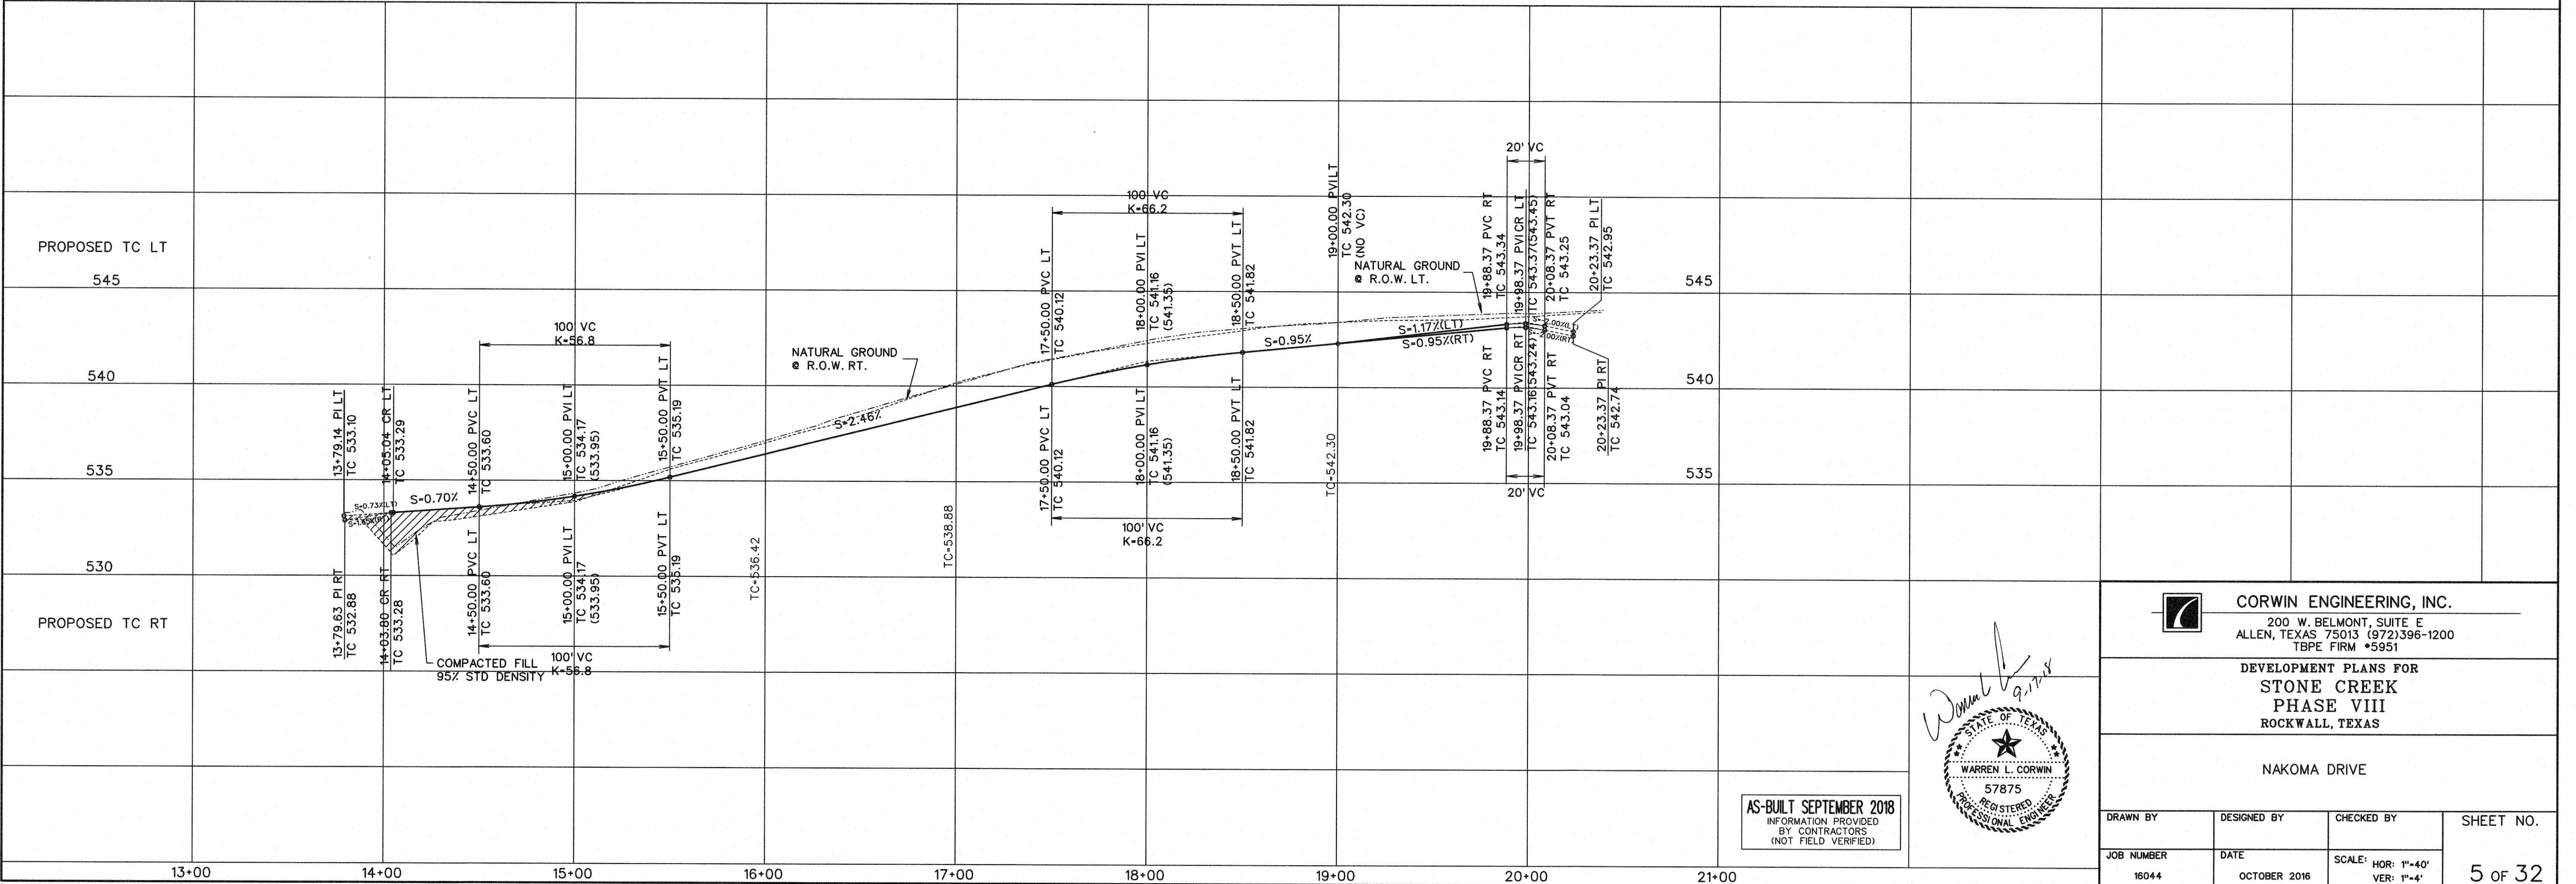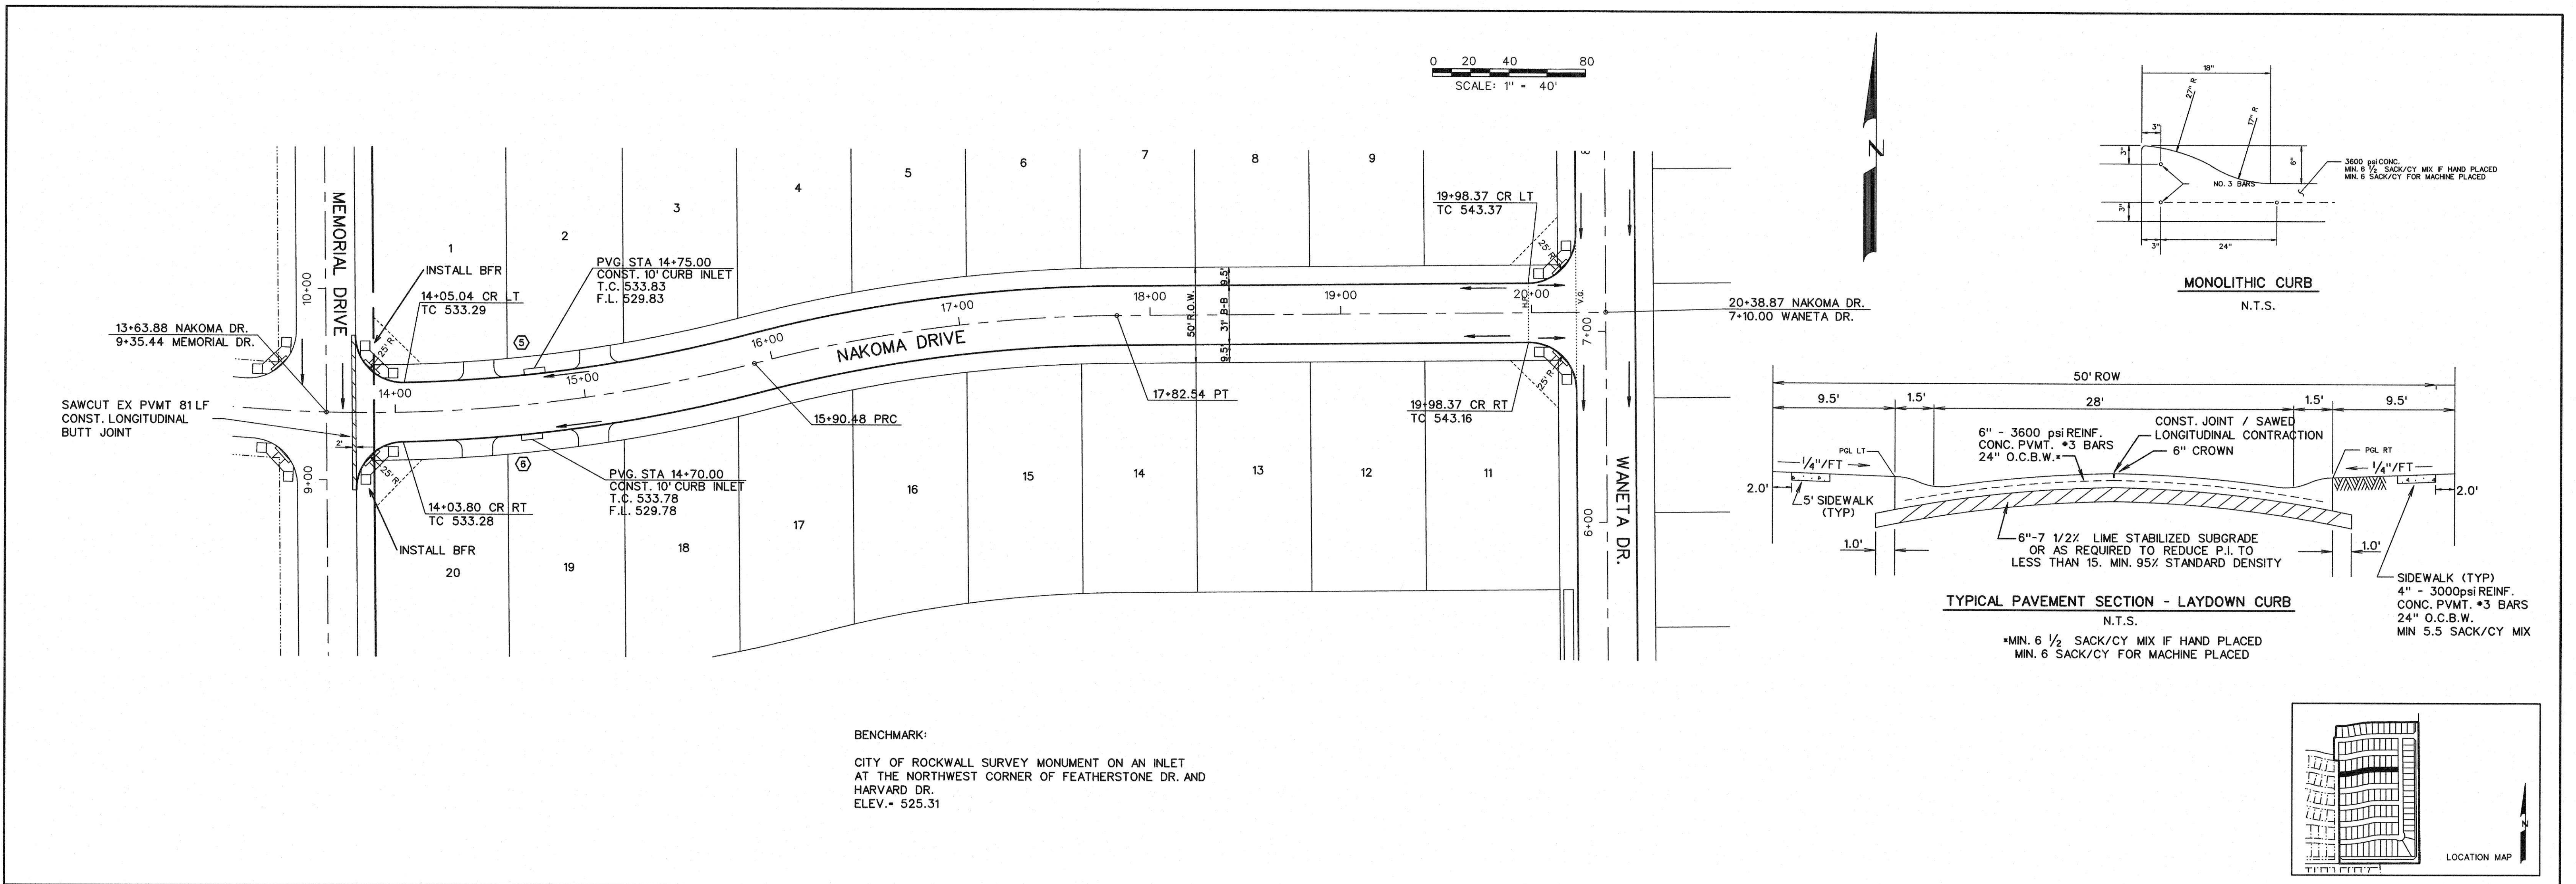

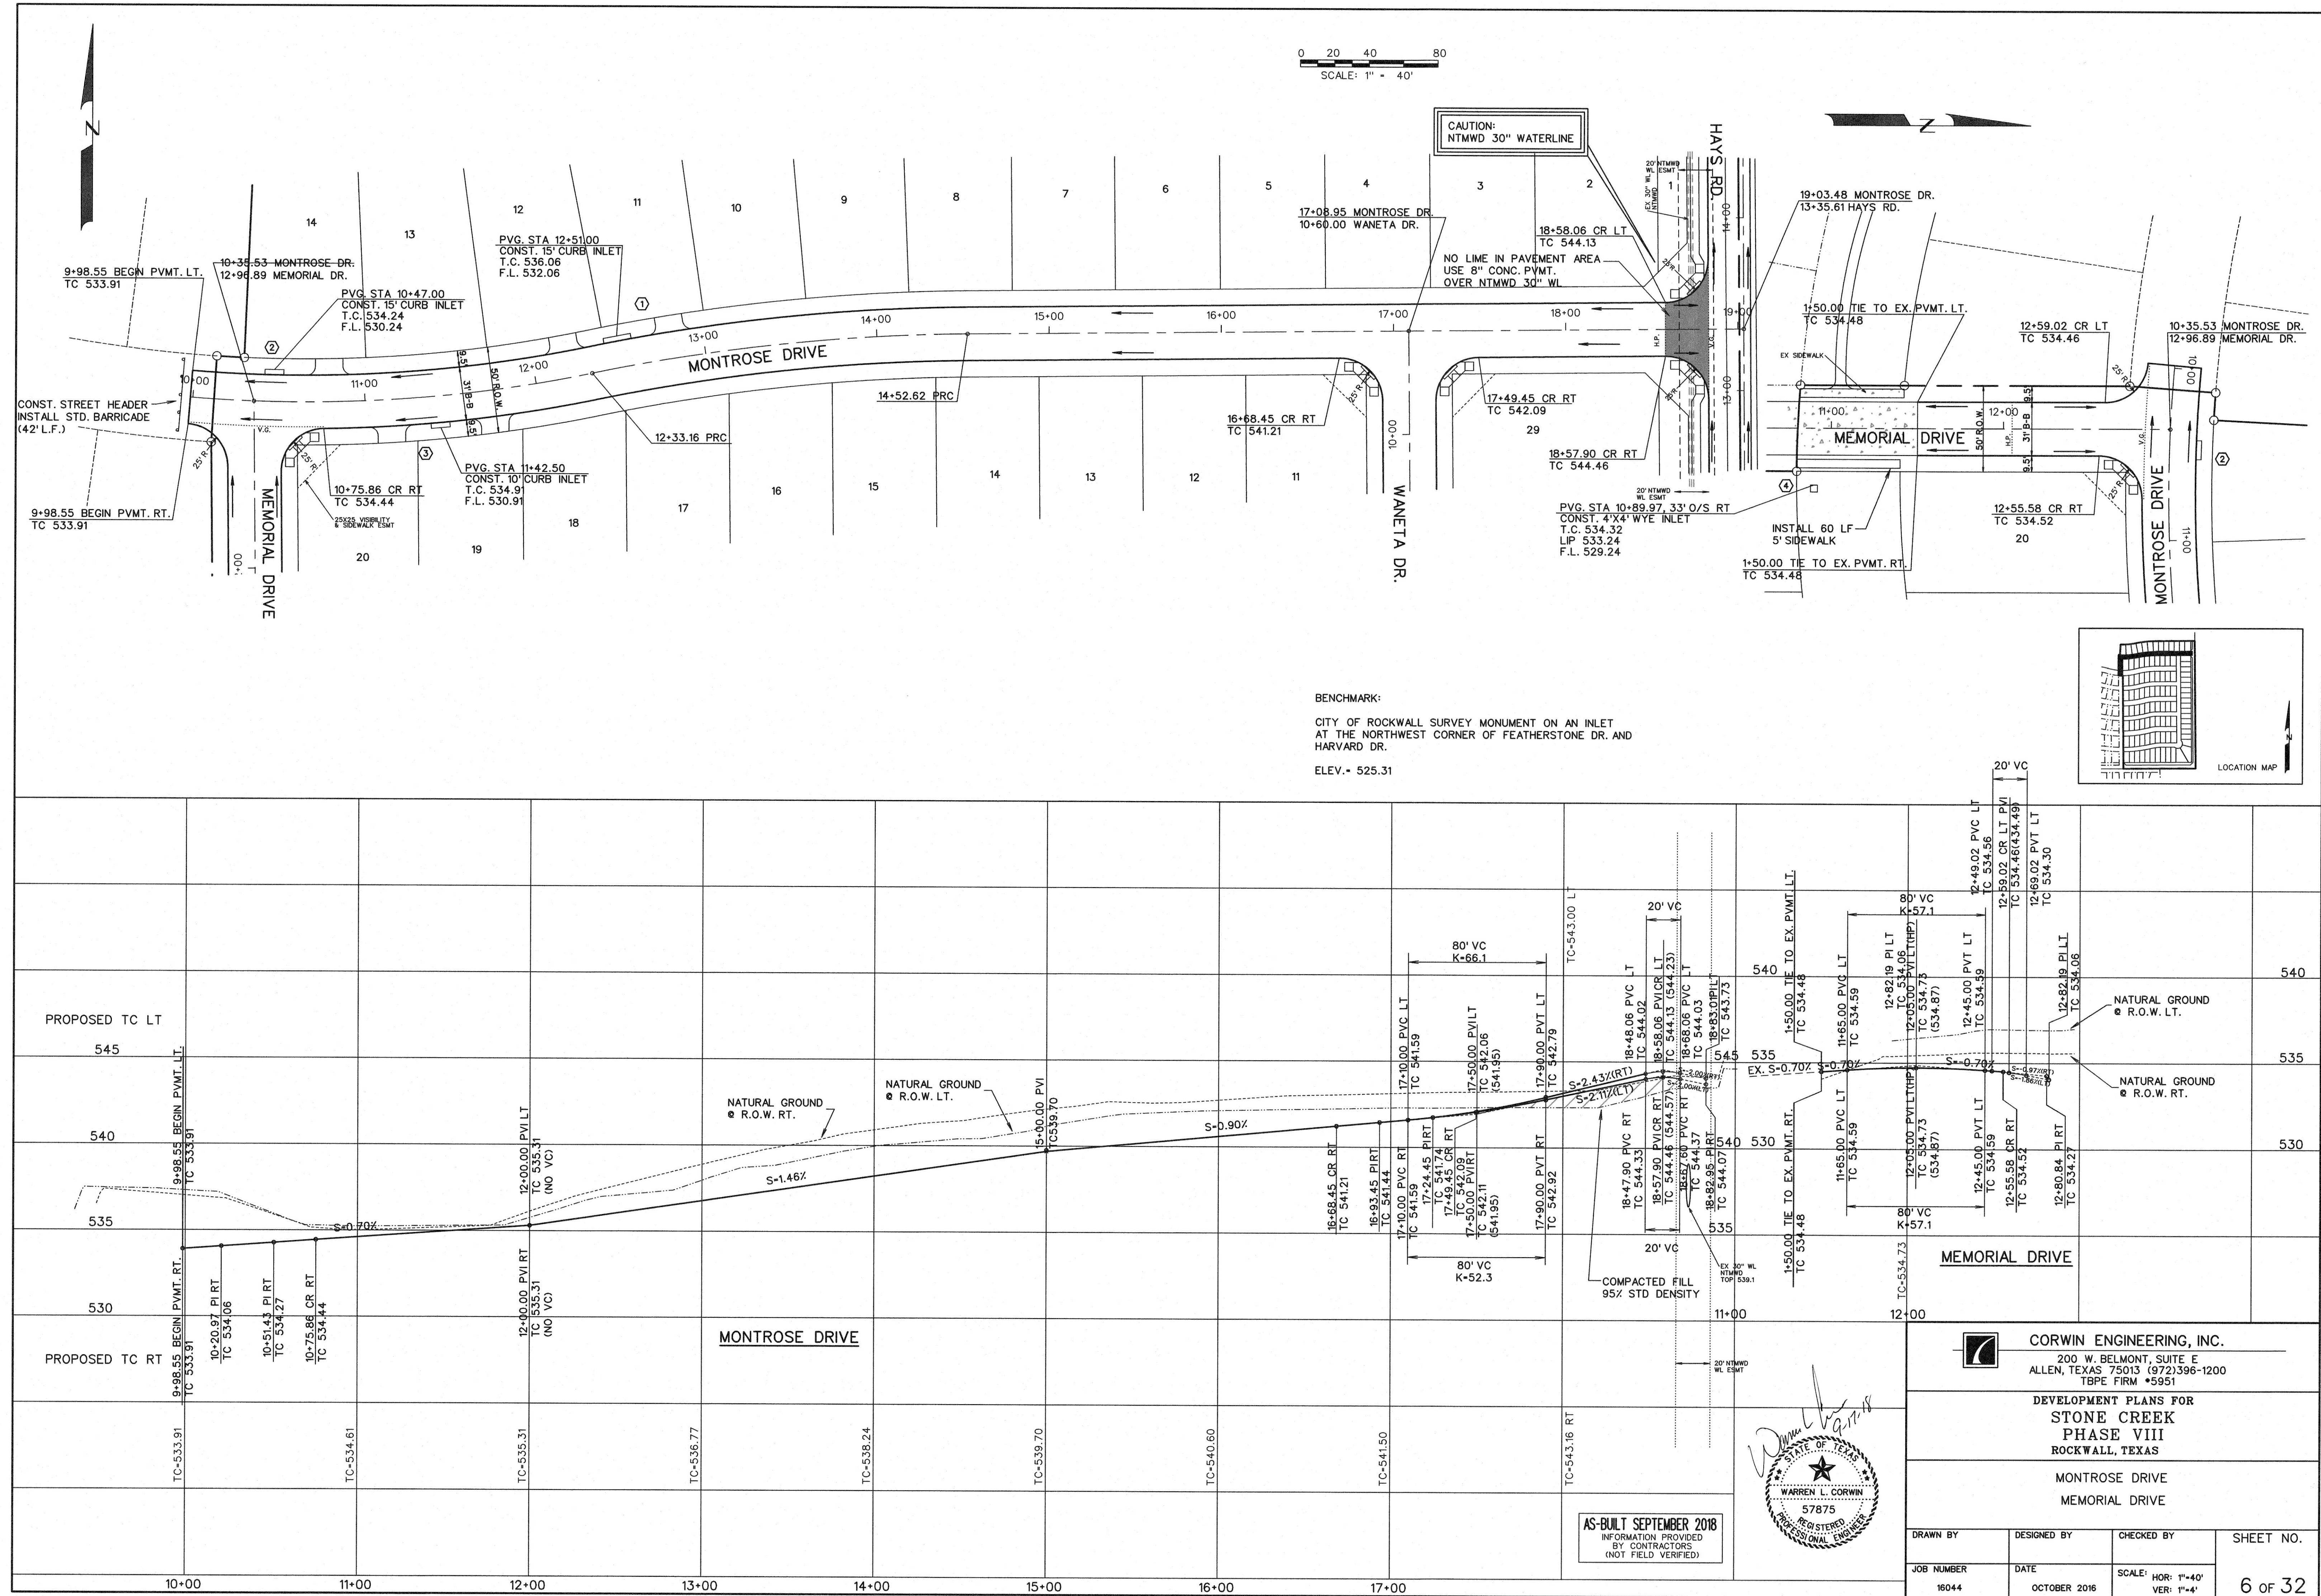

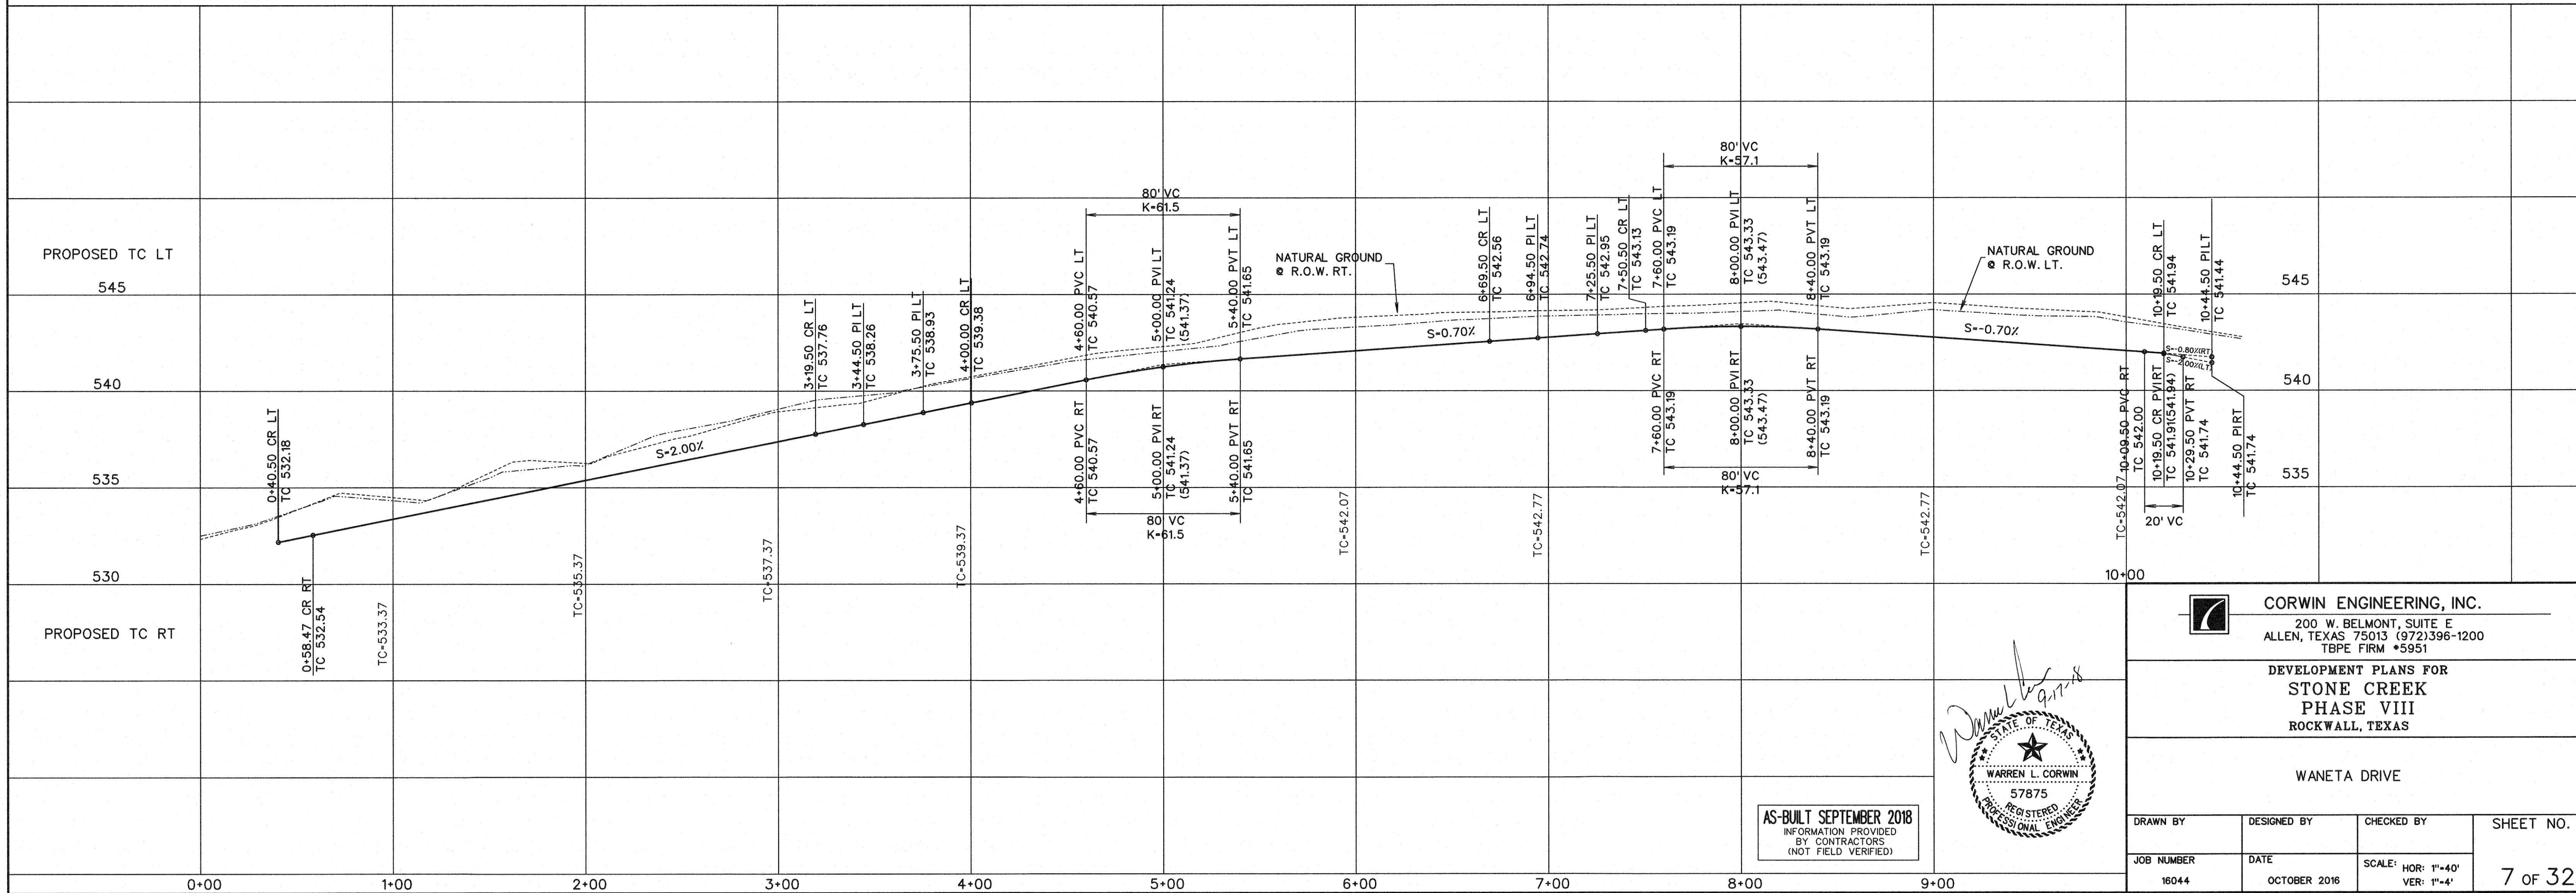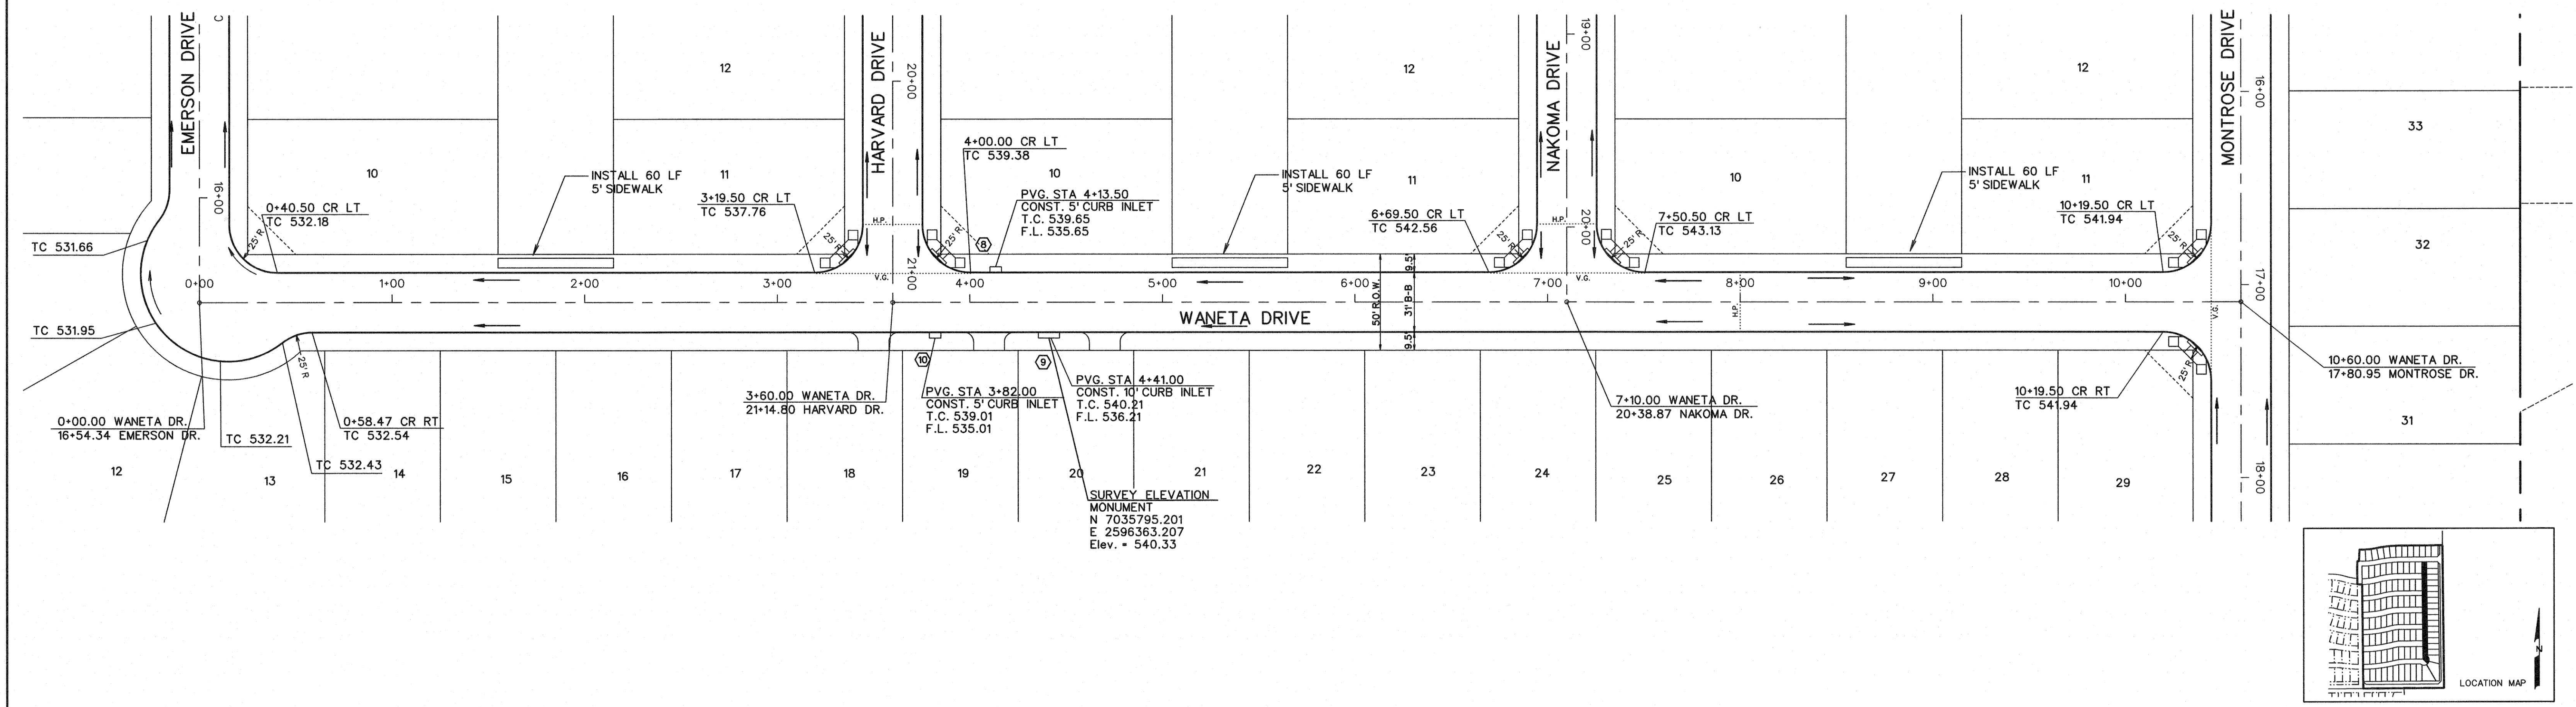


AS-BUILT SEPTEMBER 2018
INFORMATION PROVIDED
BY CONTRACTORS
(NOT FIELD VERIFIED)

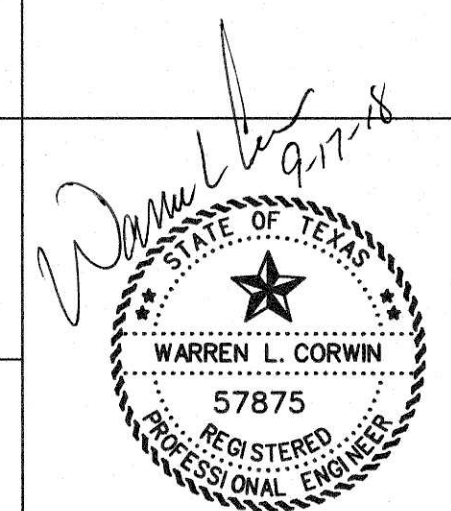





















CORWIN ENGINEERING, INC.
200 W. BELMONT, SUITE E
ALLEN, TEXAS 75013 (972)396-1200
TBP# FIRM #5951

DEVELOPMENT PLANS FOR
STONE CREEK
PHASE VIII
ROCKWALL, TEXAS


WANETA DRIVE


| | | | |
|------------|--------------|----------------------------------|-----------|
| DRAWN BY | DESIGNED BY | CHECKED BY | SHEET NO. |
| JOB NUMBER | DATE | SCALE: HOR: 1"=40' VER: 1"=4' | 7 of 32 |
| 16044 | OCTOBER 2016 | | |


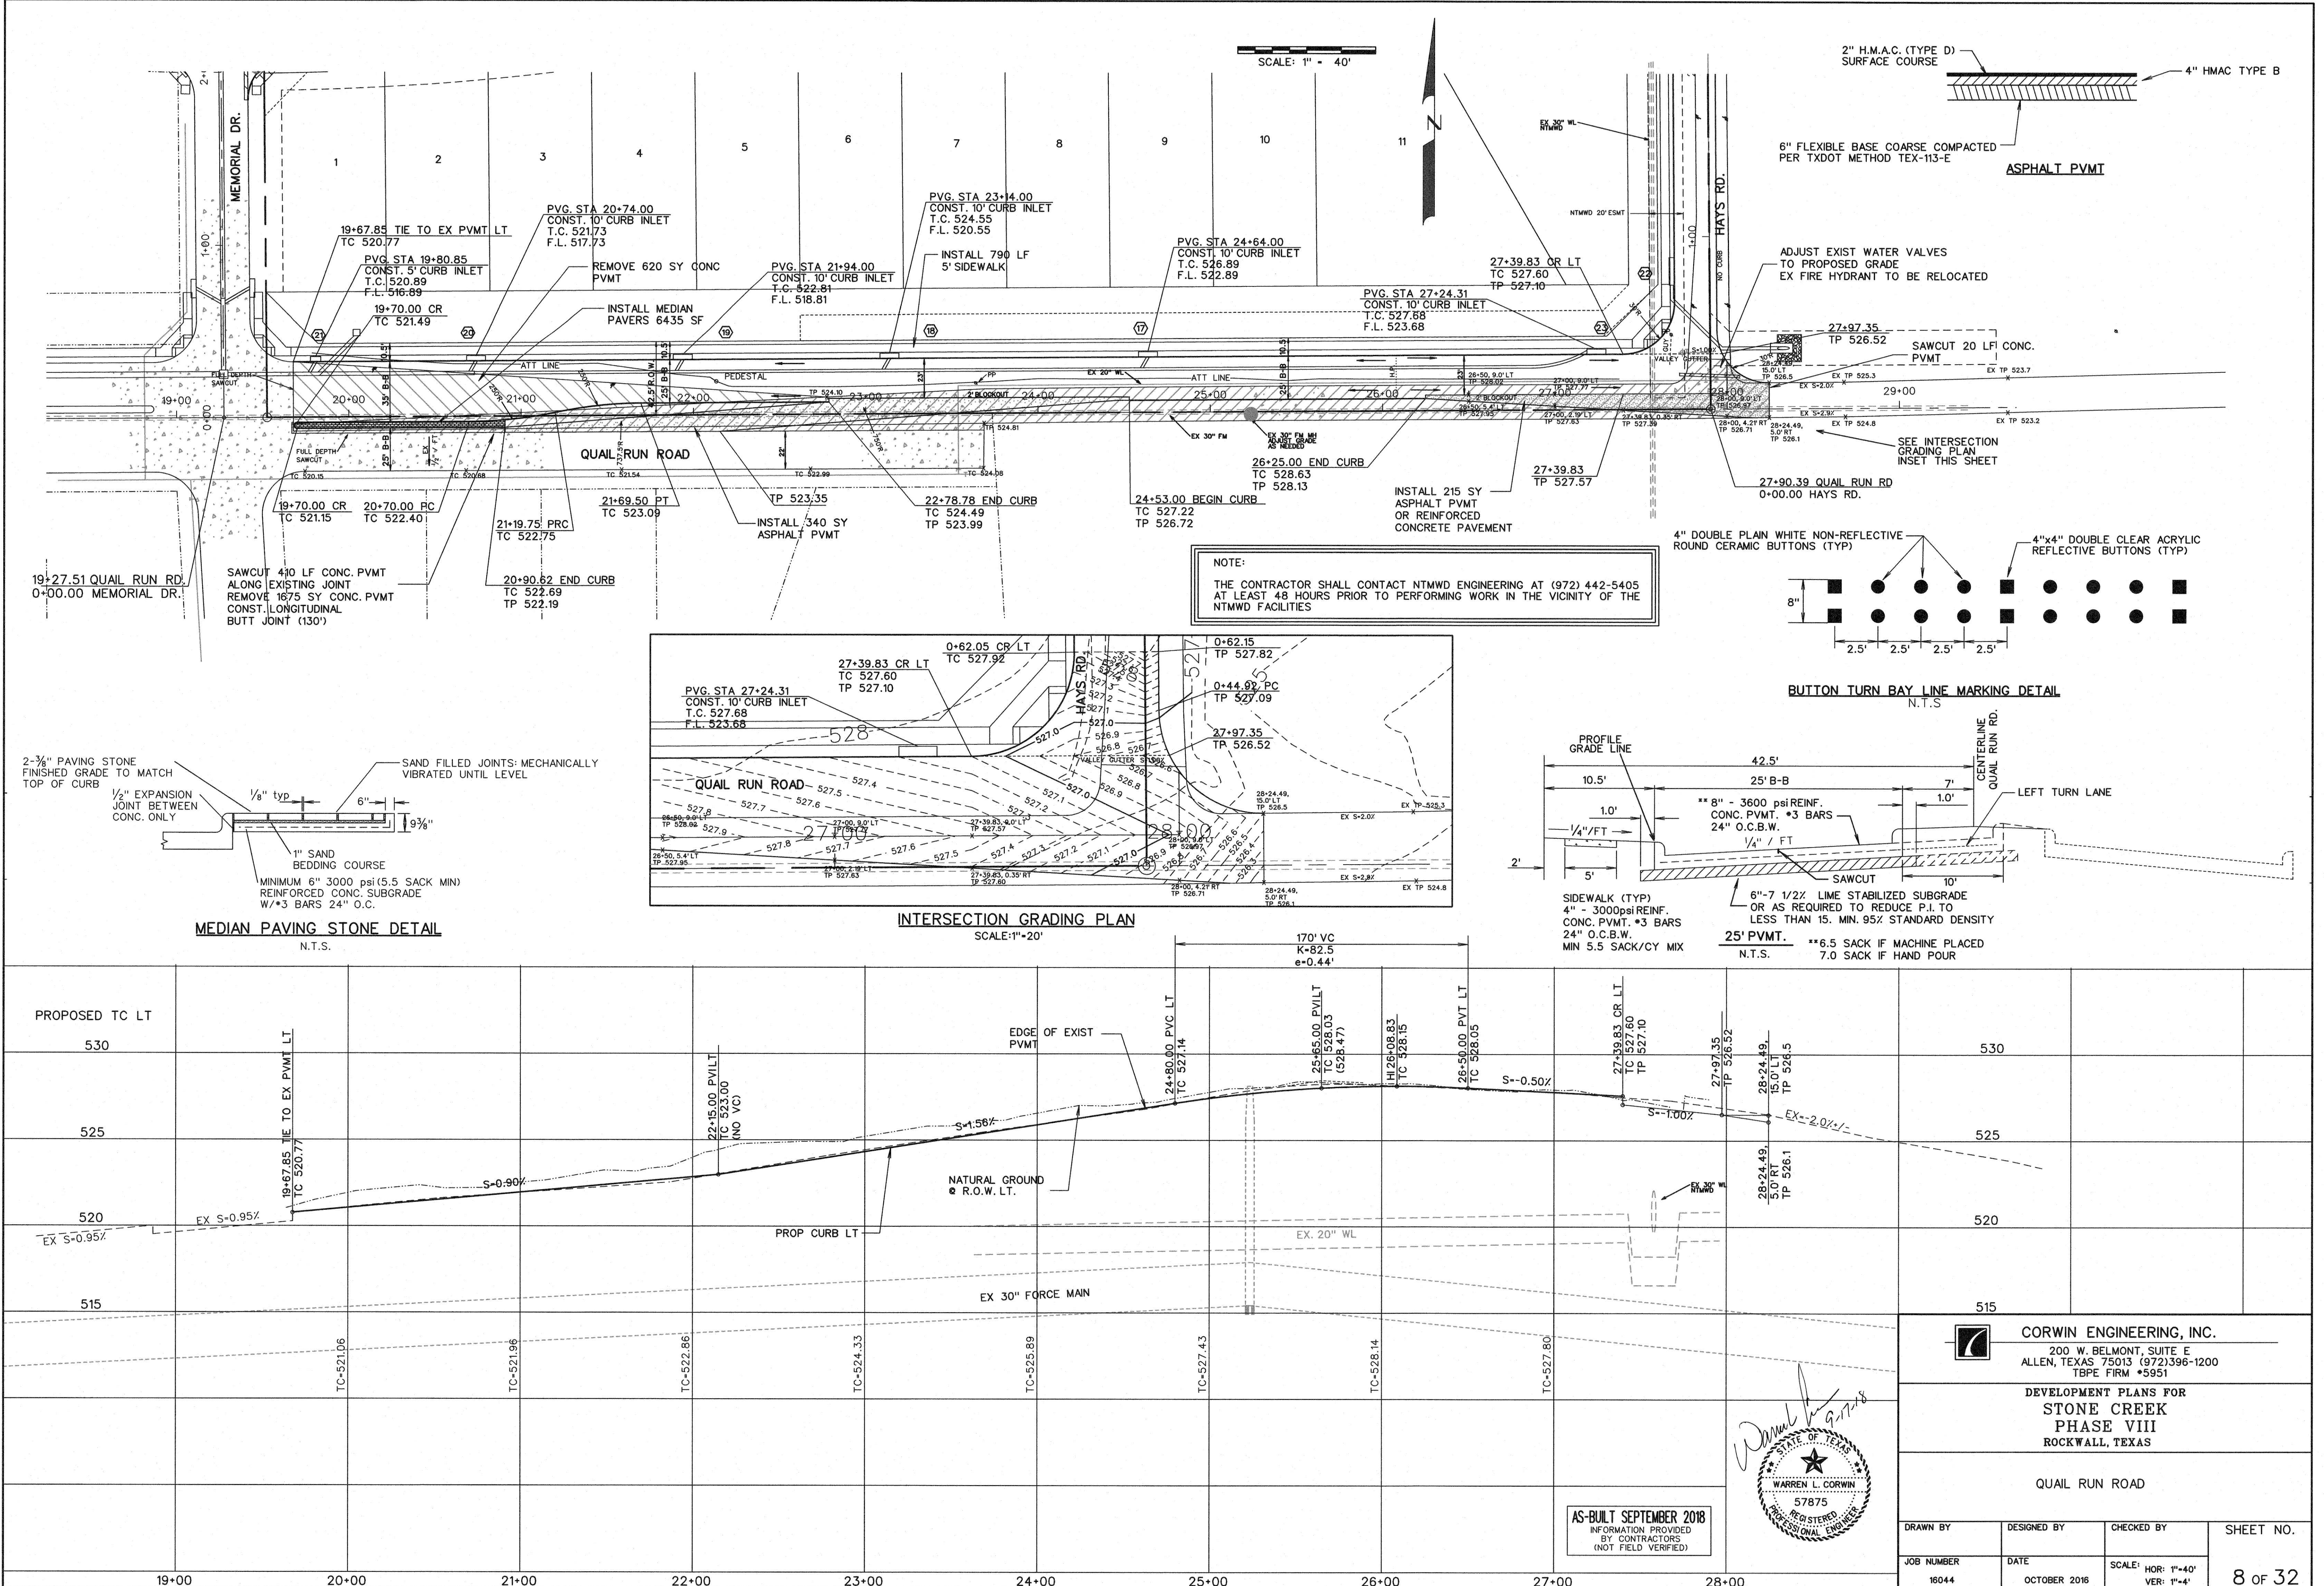


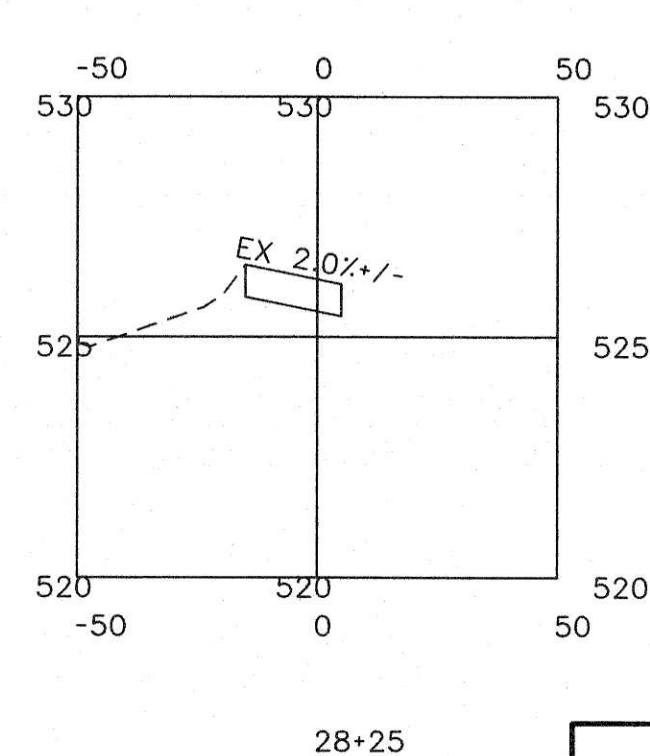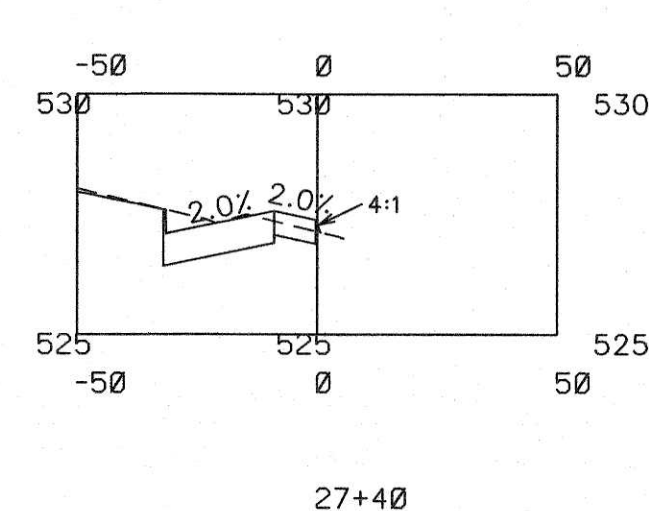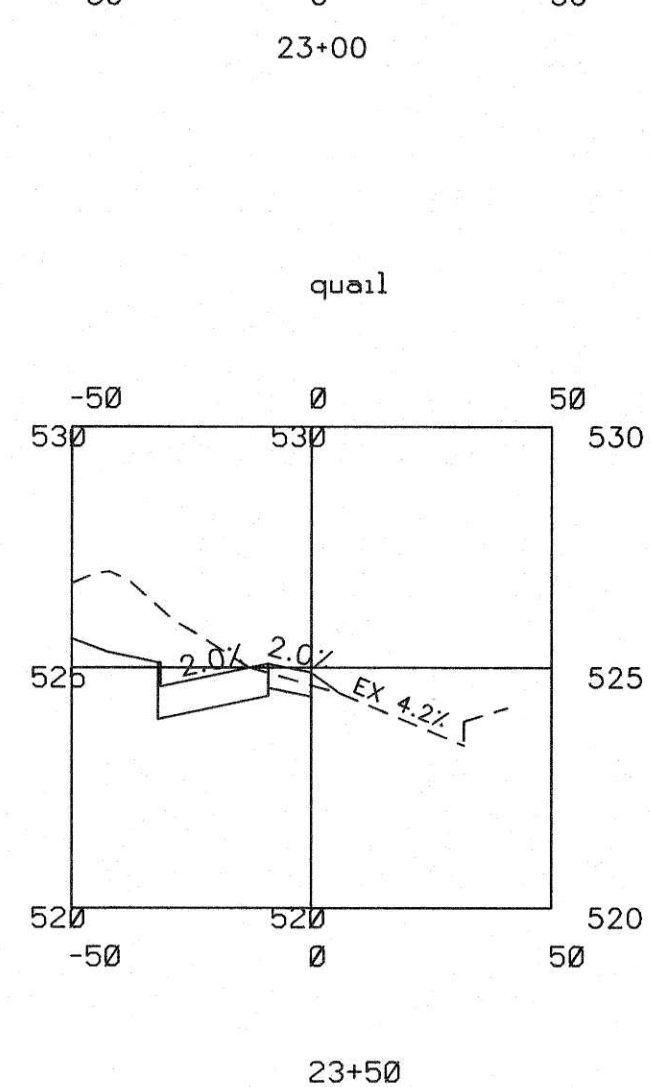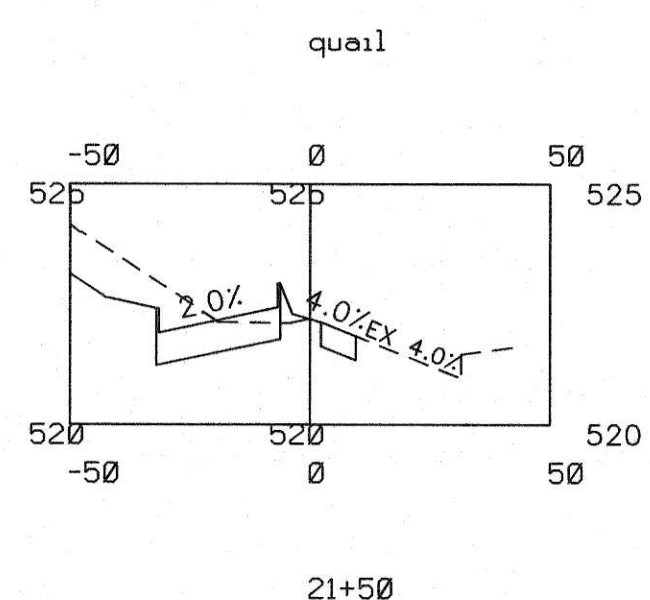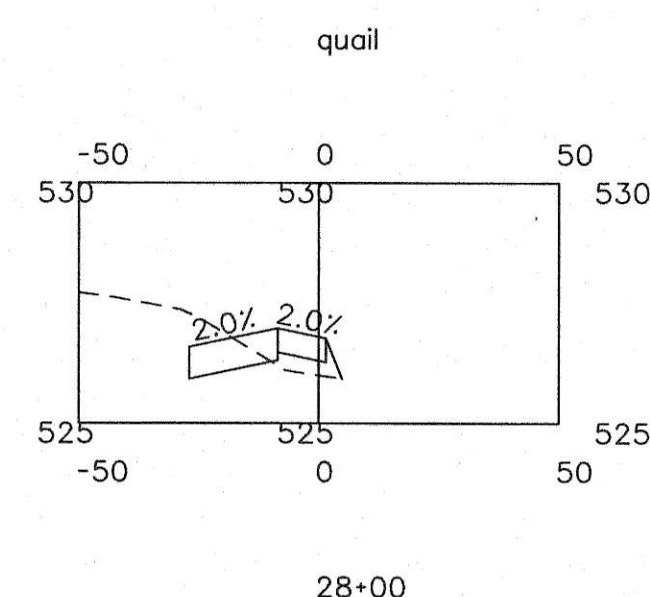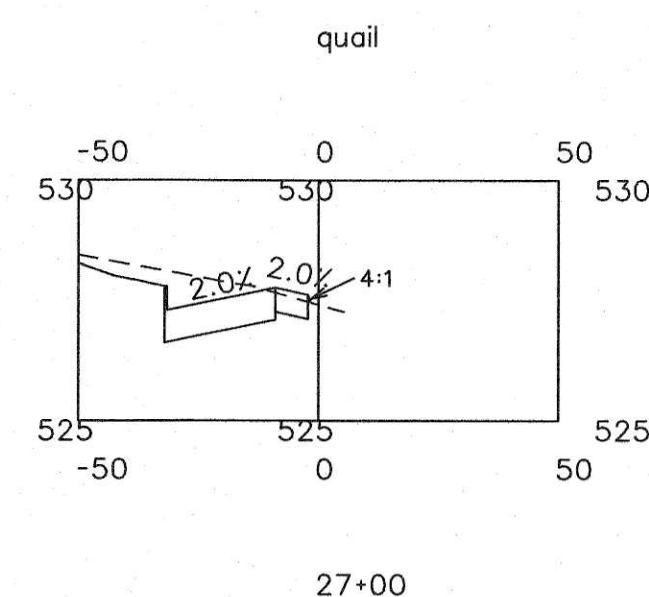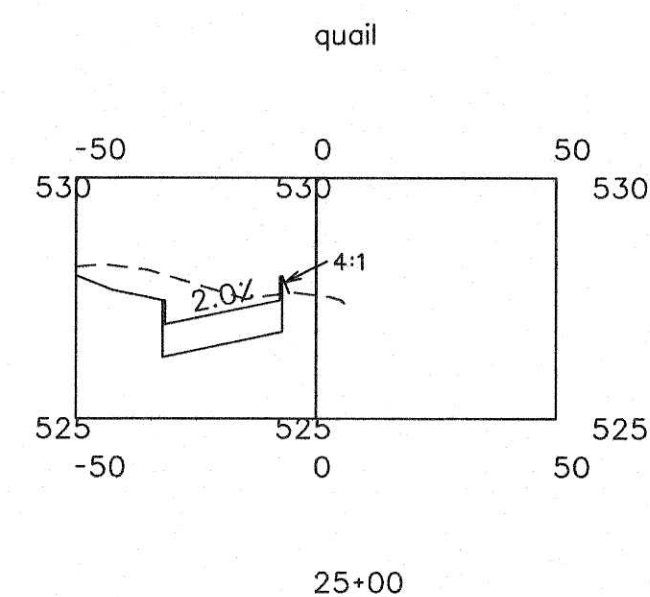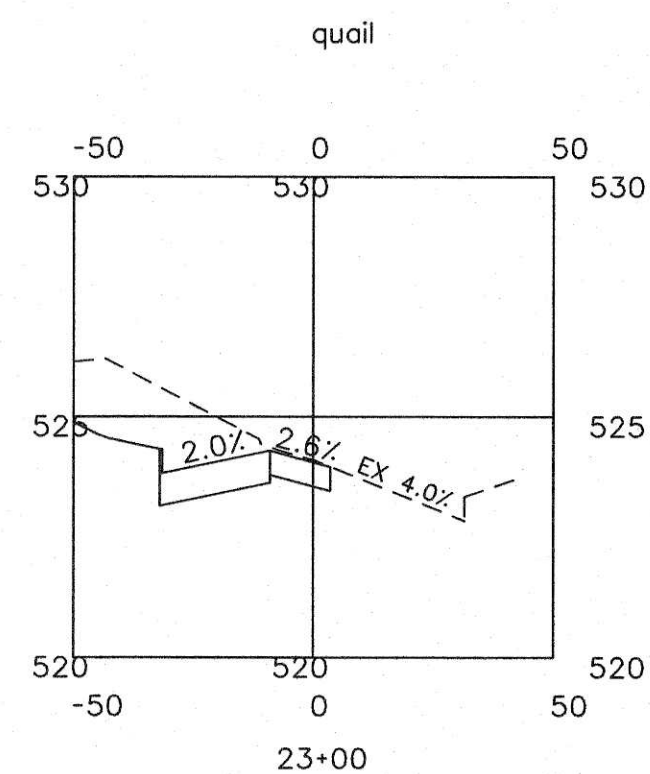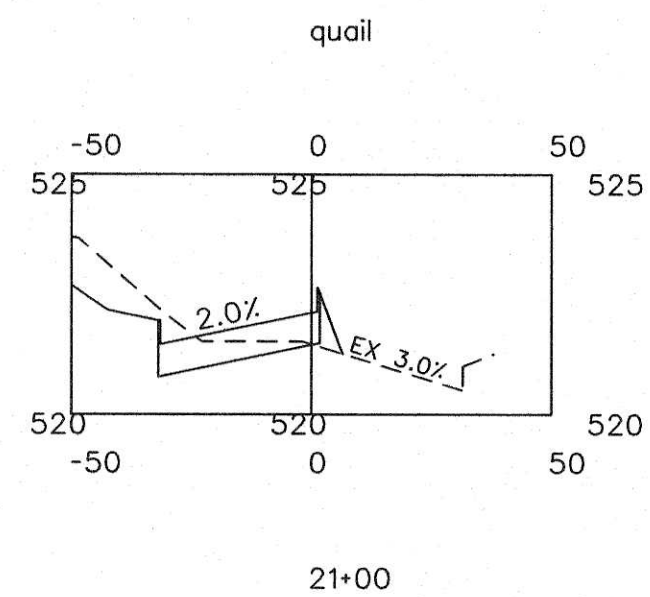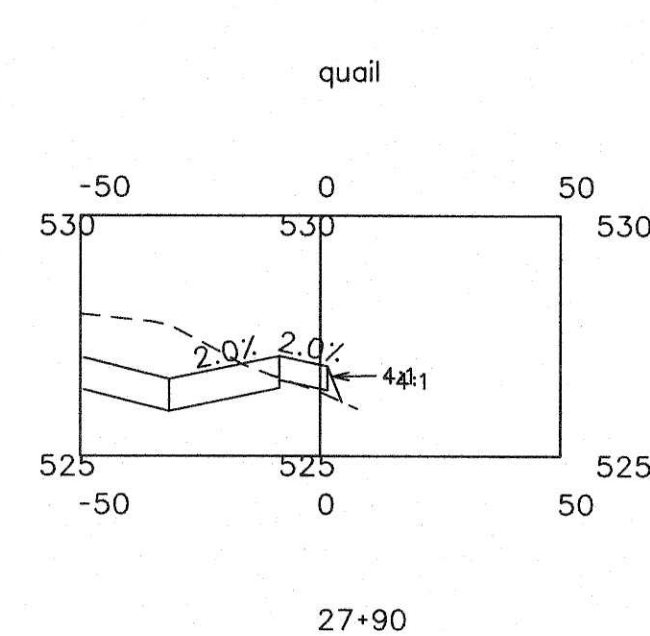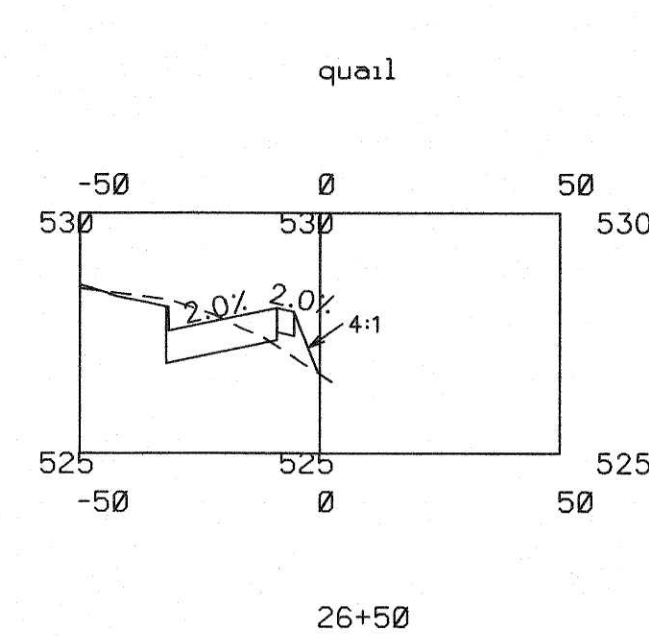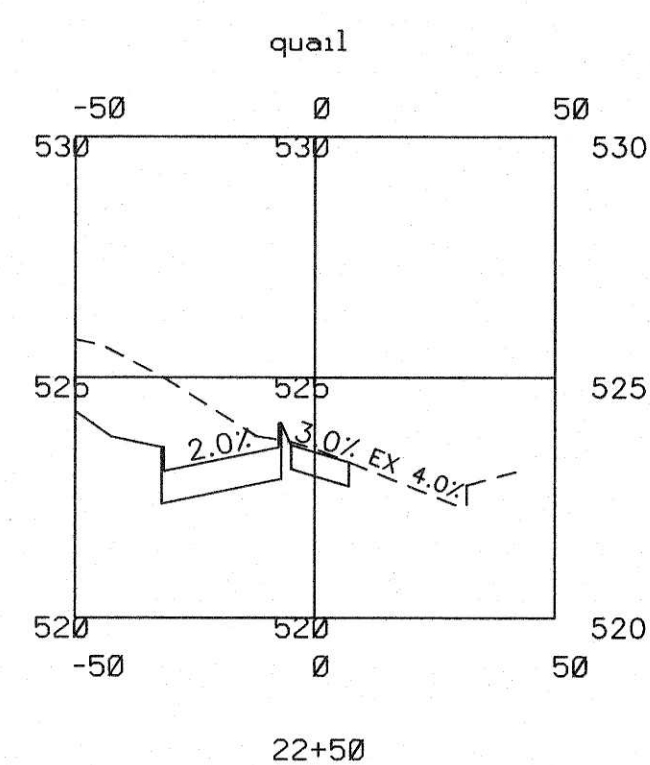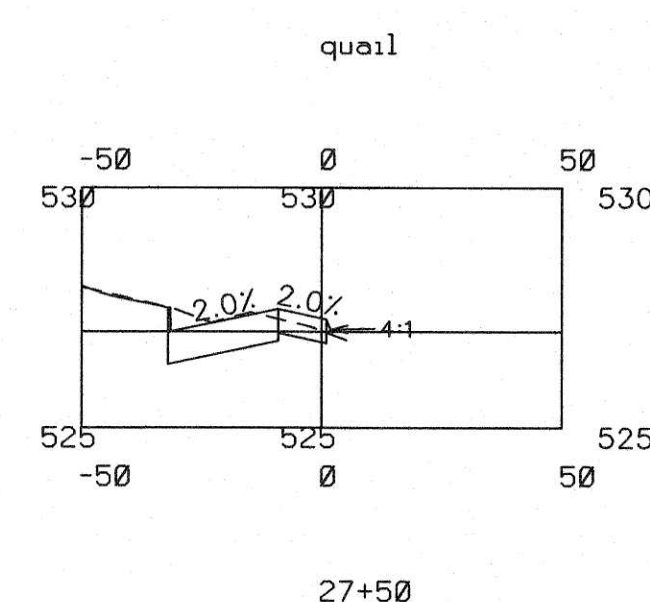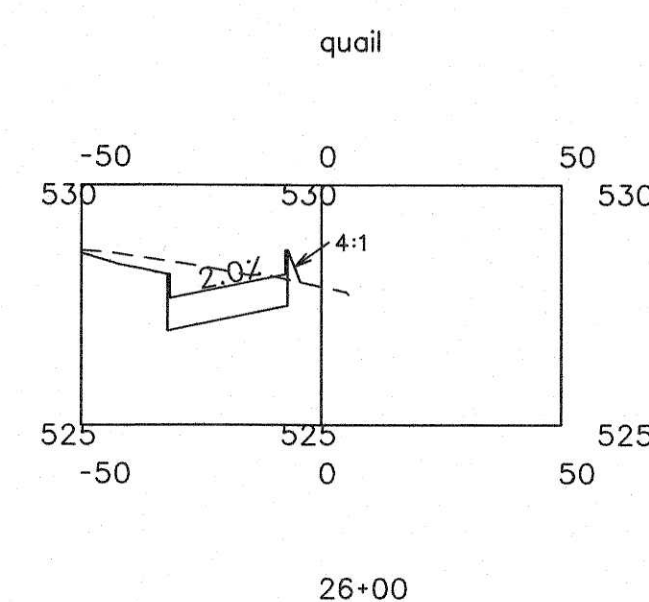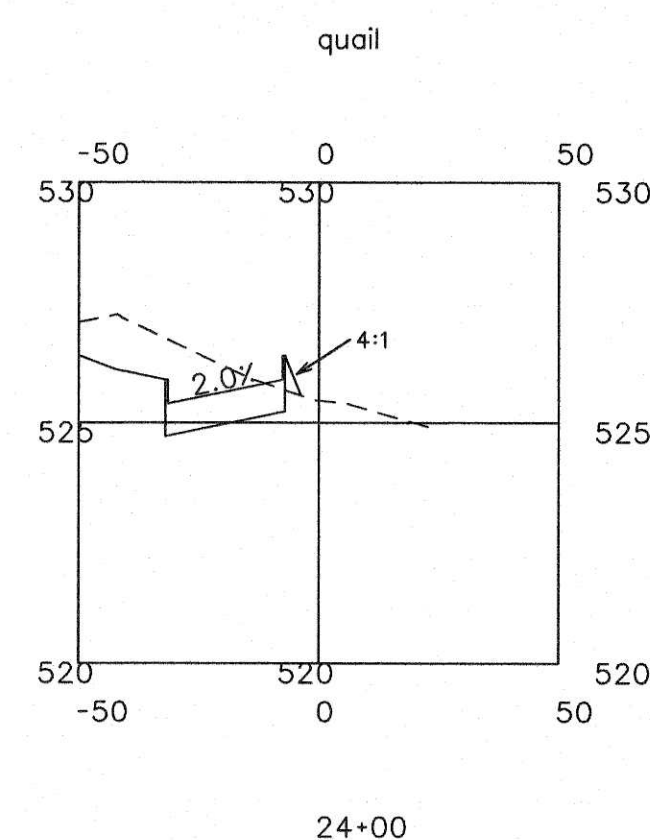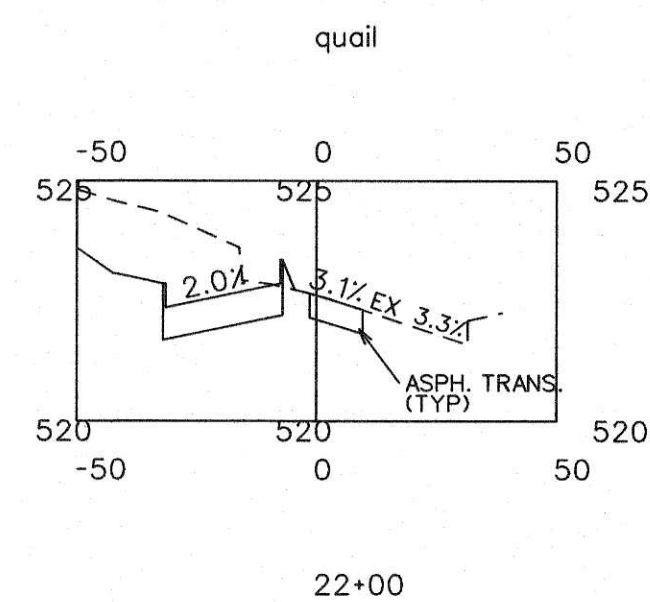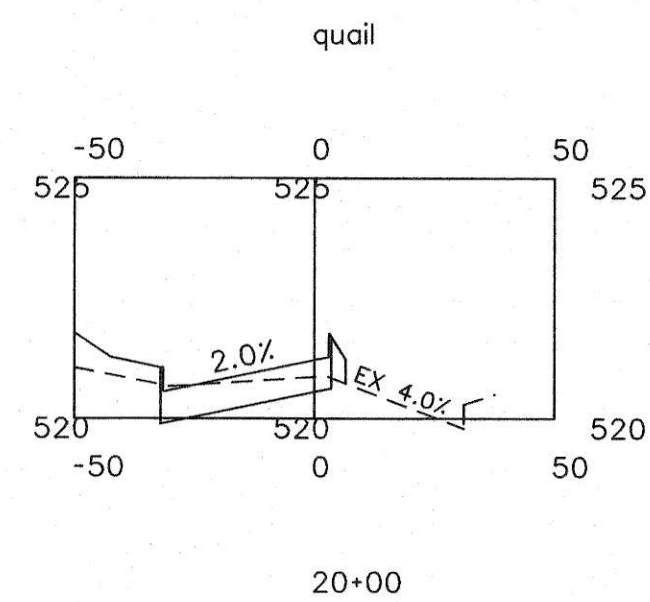


















AS-BUILT SEPTEMBER 2018
INFORMATION PROVIDED
BY CONTRACTORS
(NOT FIELD VERIFIED)

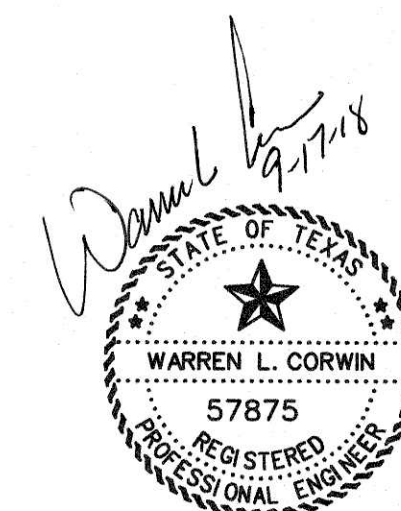


| | | | |
|--|--------------|----------------------------------|-----------|
| <div><div></div><div><div>CORWIN ENGINEERING, INC.</div><div>200 W. BELMONT, SUITE E</div><div>ALLEN, TEXAS 75013 (972)396-1200</div><div>TBPE FIRM #5951</div></div></div> | | | |
| DEVELOPMENT PLANS FOR STONE CREEK PHASE VIII ROCKWALL, TEXAS | | | |
| QUAIL RUN ROAD CROSS SECTIONS | | | |
| DRAWN BY | DESIGNED BY | CHECKED BY | SHEET NO. |
| JOB NUMBER | DATE | SCALE: HOR: 1"=40' VER: 1"=4' | 9 of 32 |
| 16044 | OCTOBER 2016 | | |

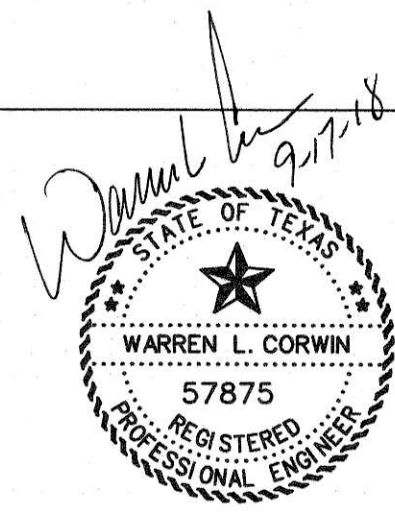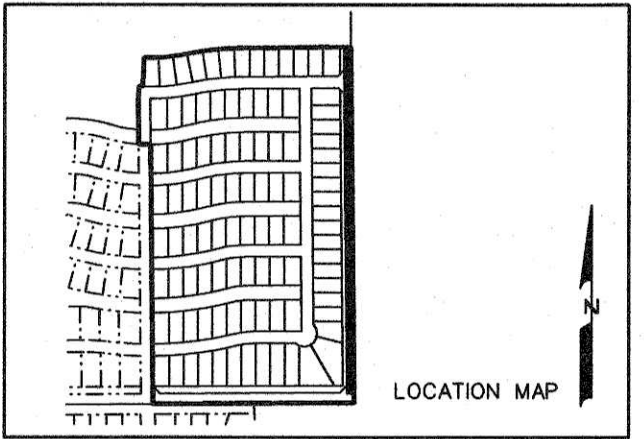


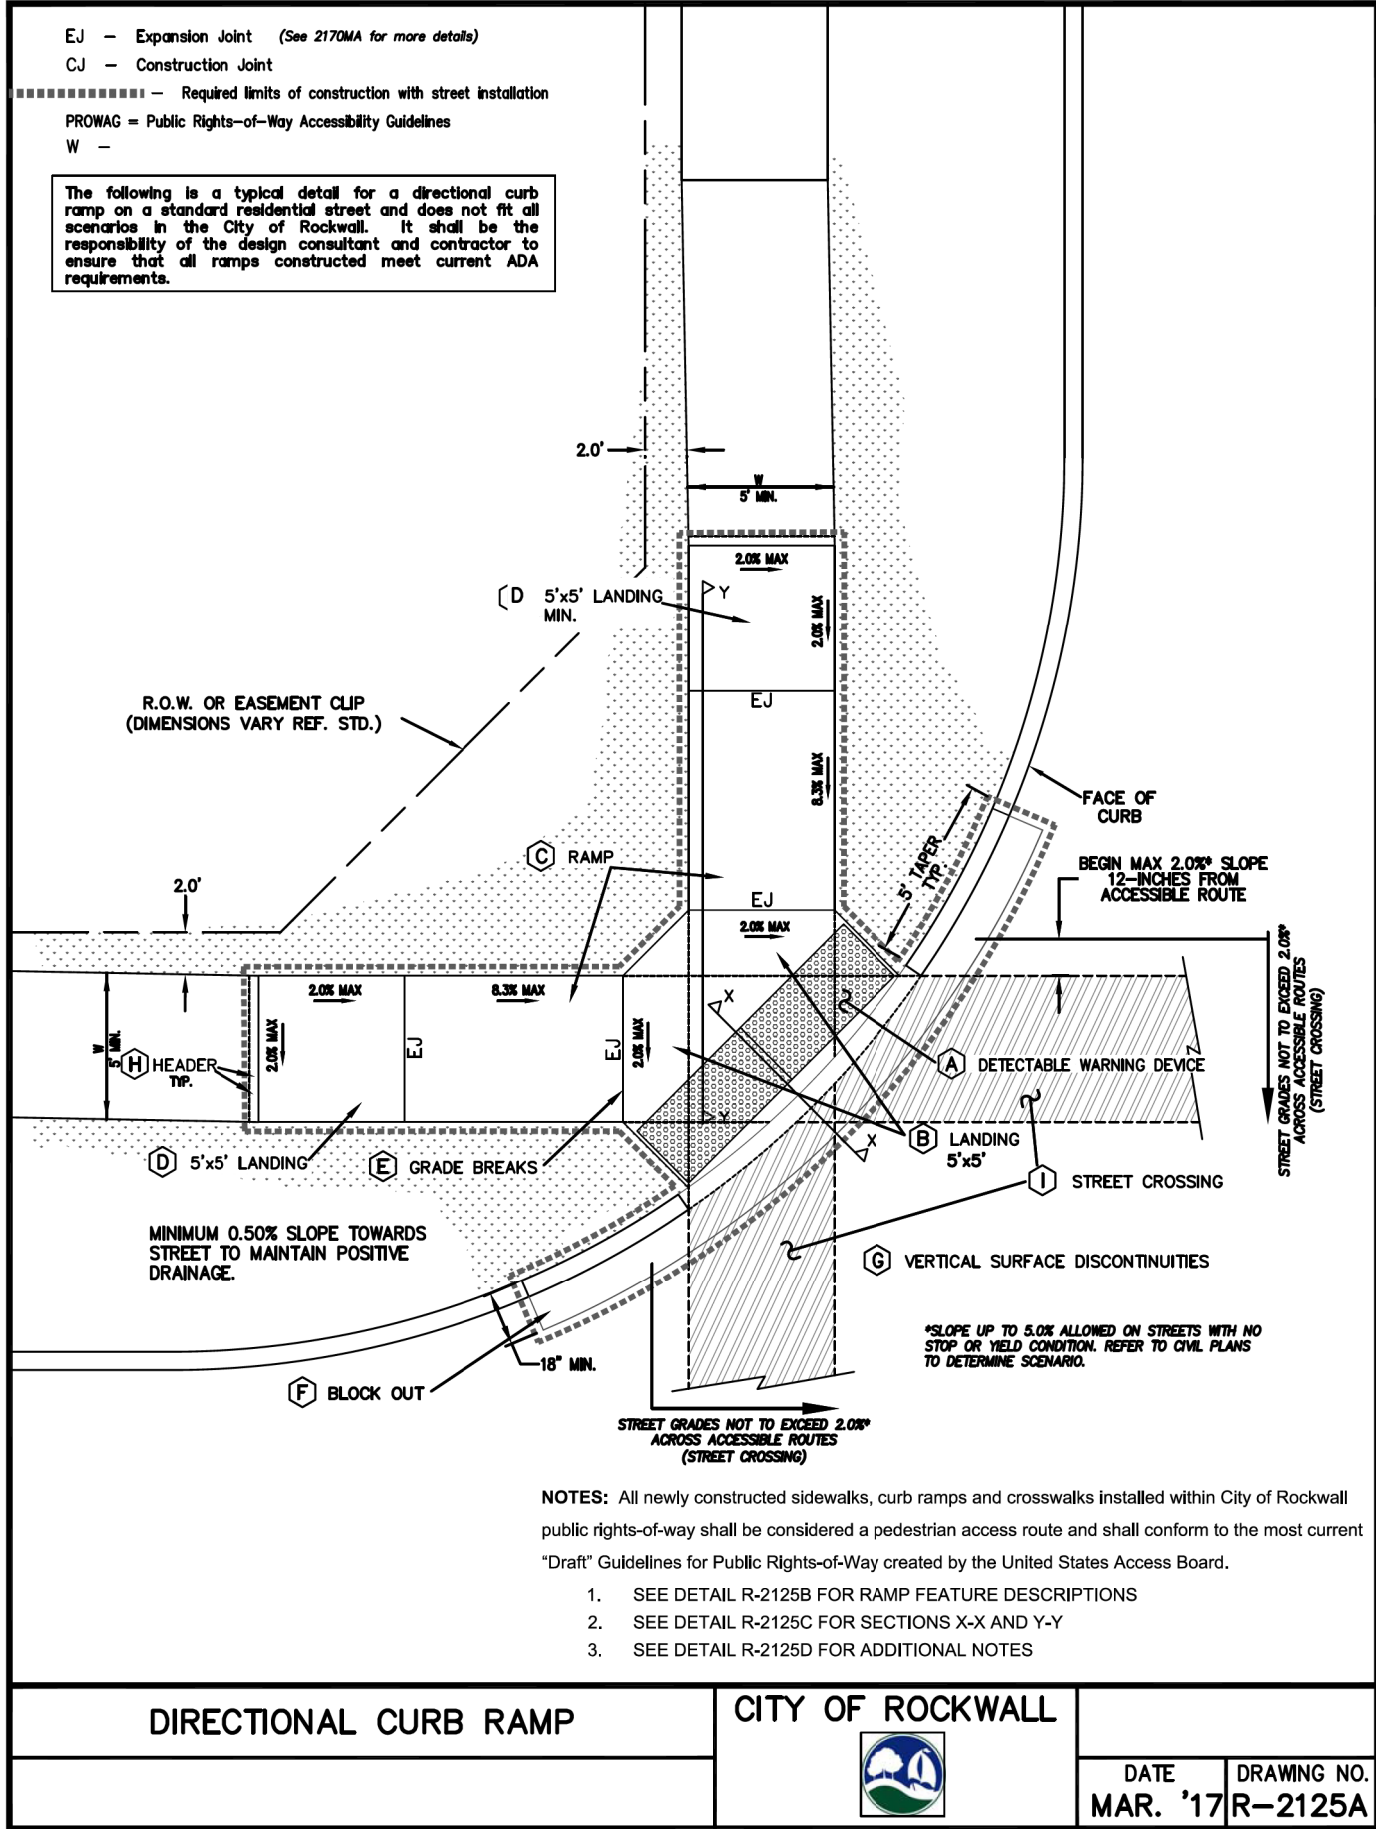
| | | | |
|---------------------|----------------------|----------------------------------|---------------------------|
| DRAWN BY | DESIGNED BY | CHECKED BY | SHEET NO. 10 OF 32 |
| JOB NUMBER 16044 | DATE OCTOBER 2016 | SCALE: HOR: 1"=40' VER: 1"=4' | |

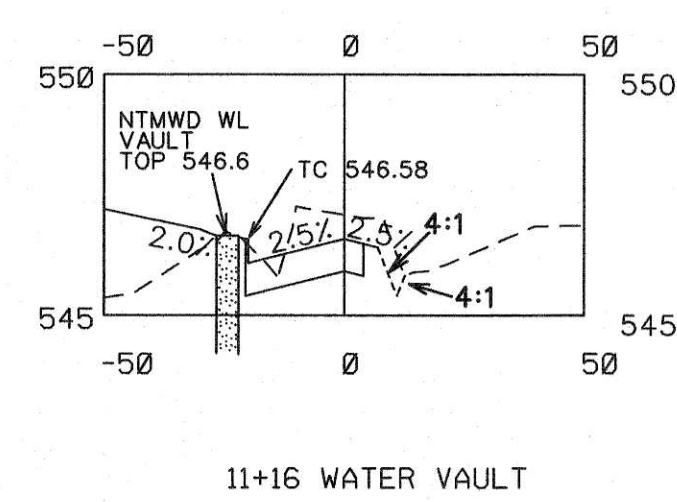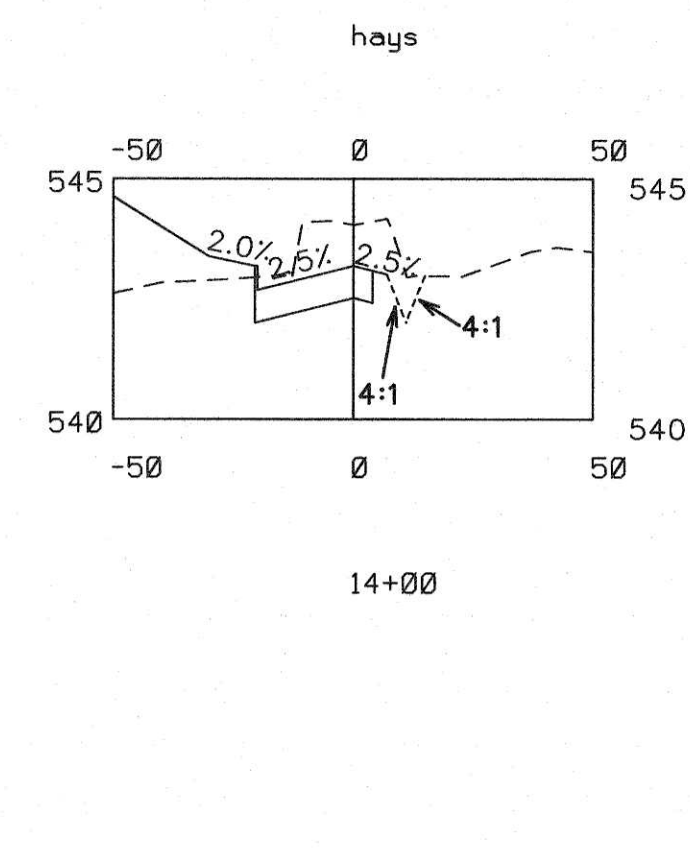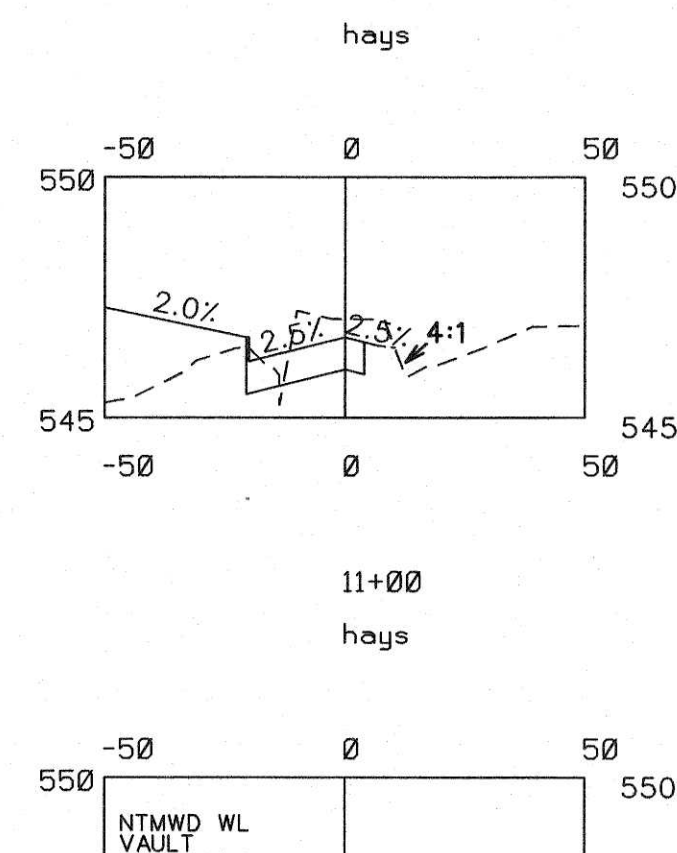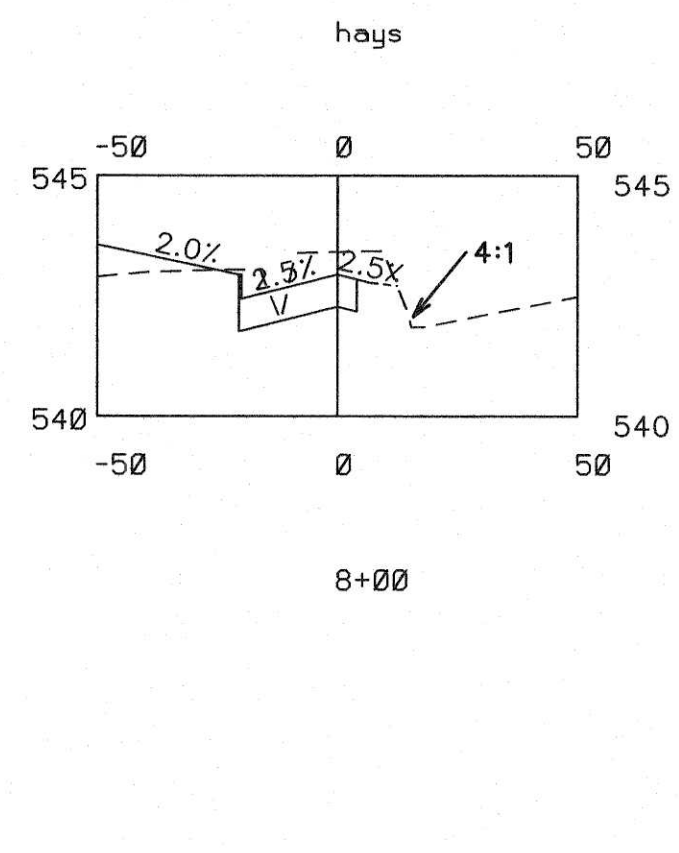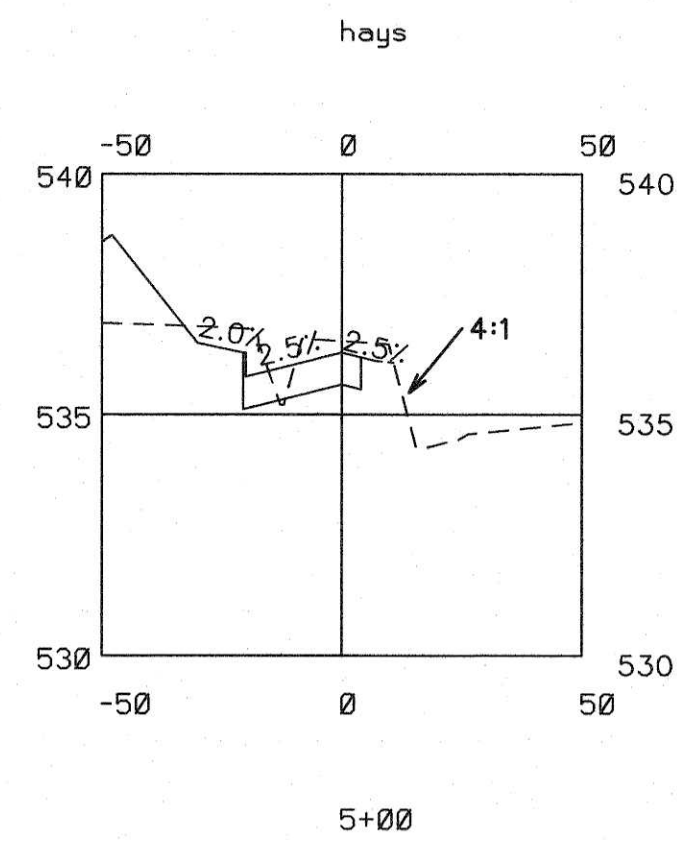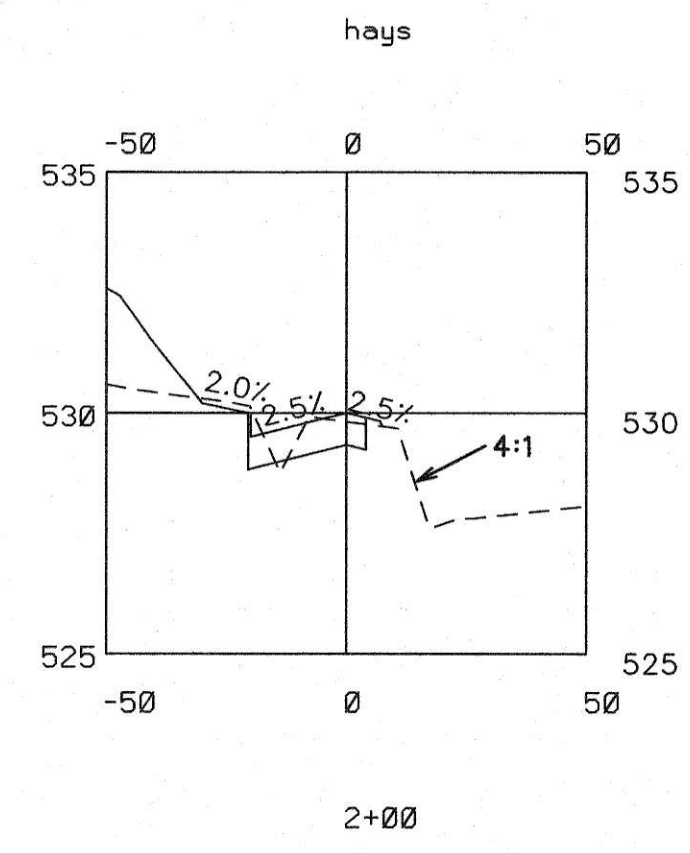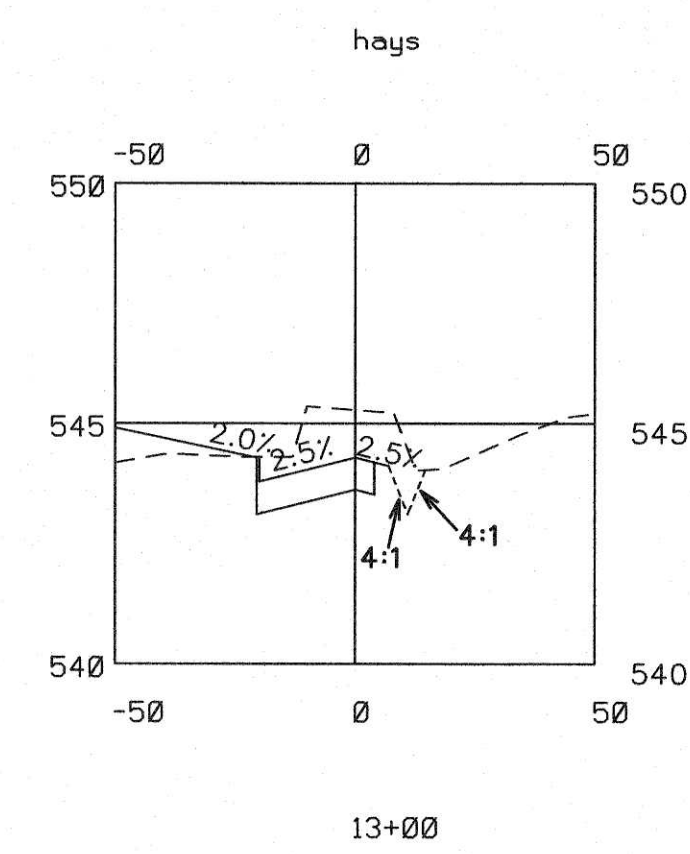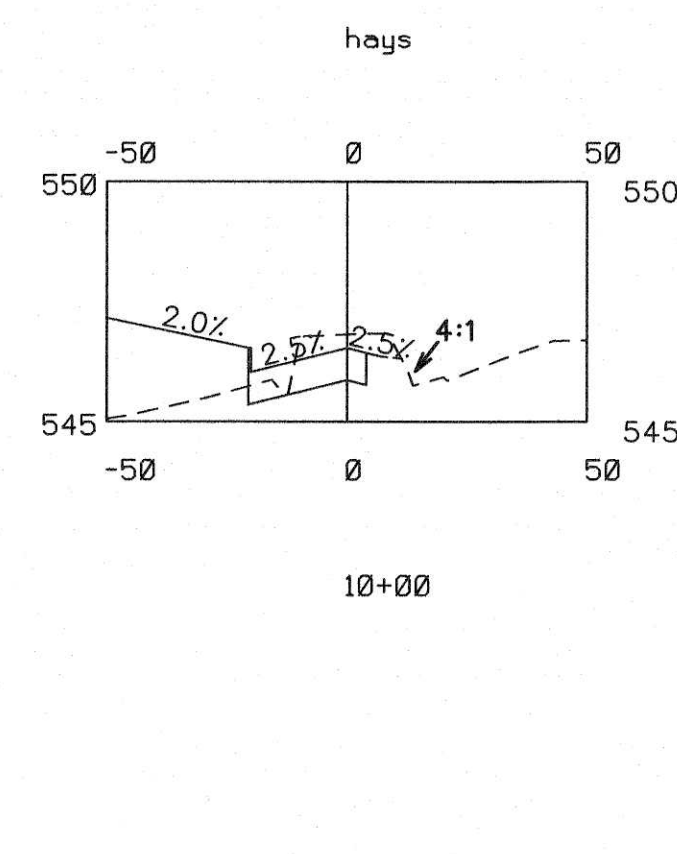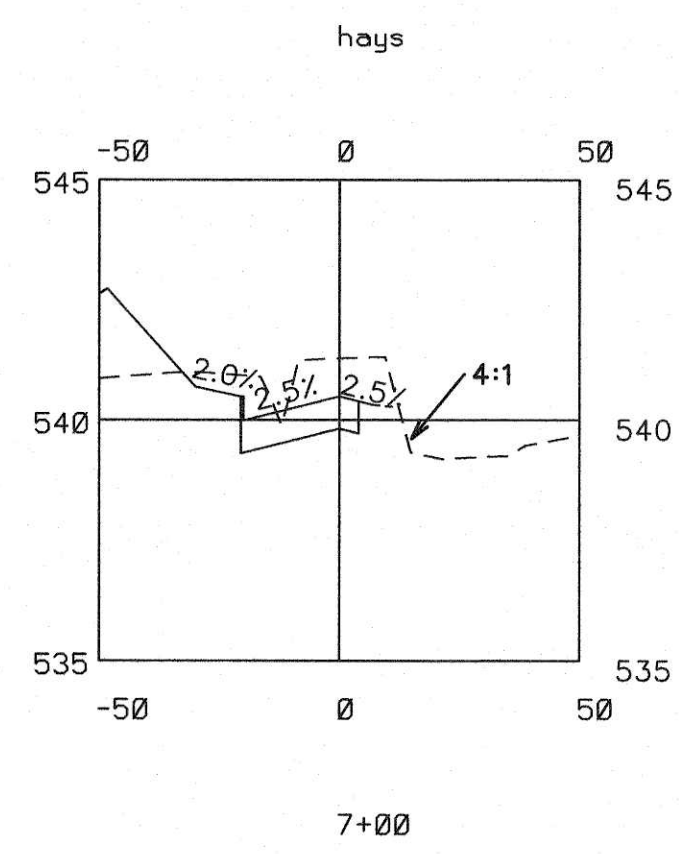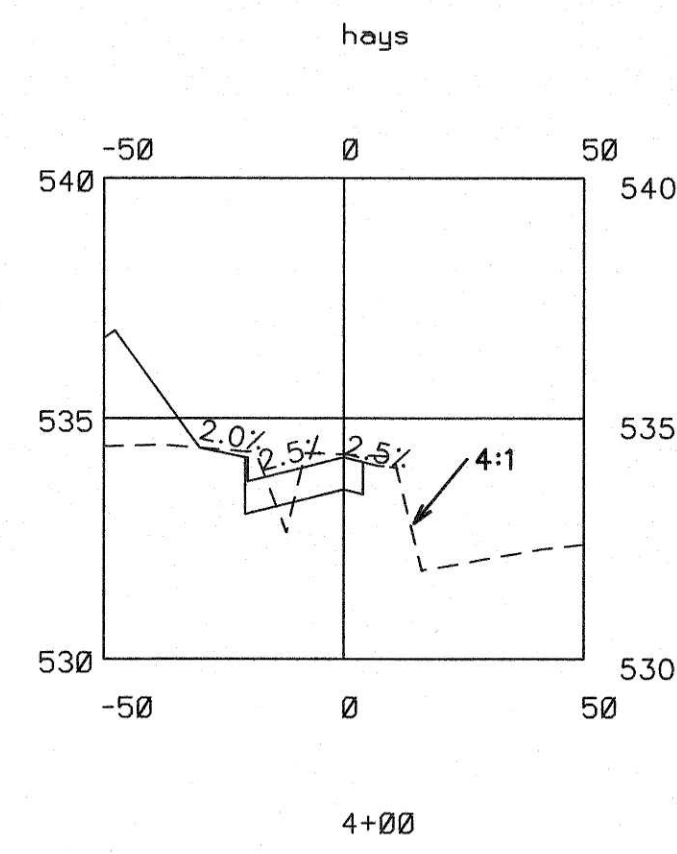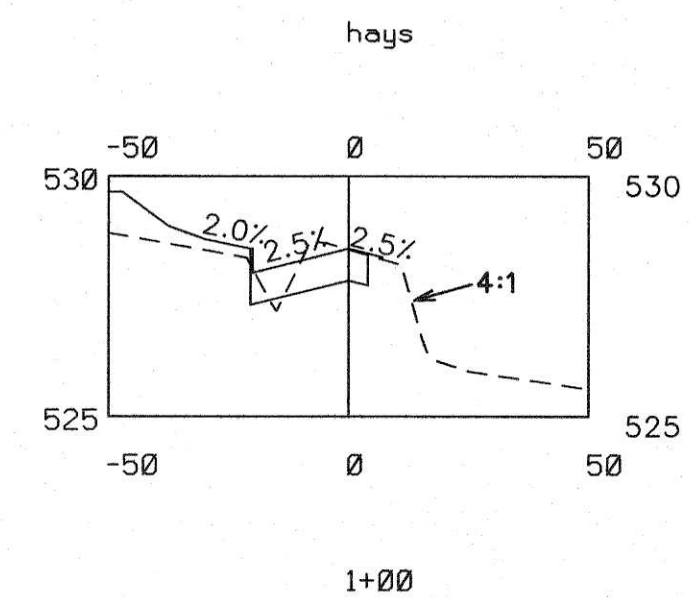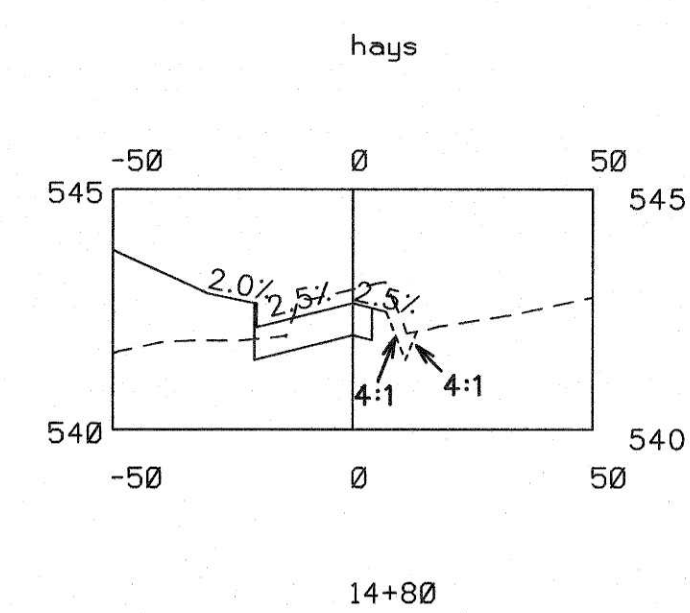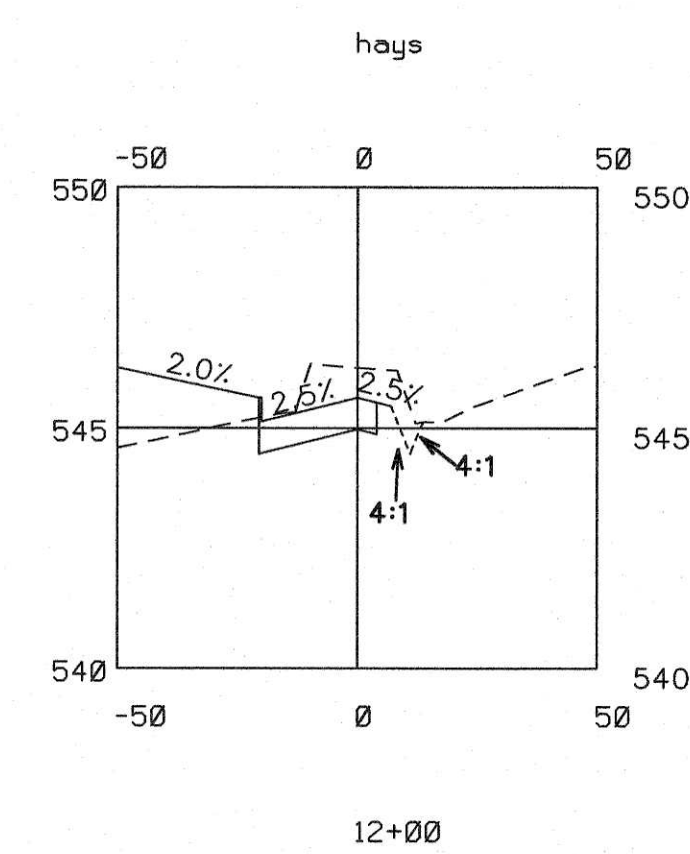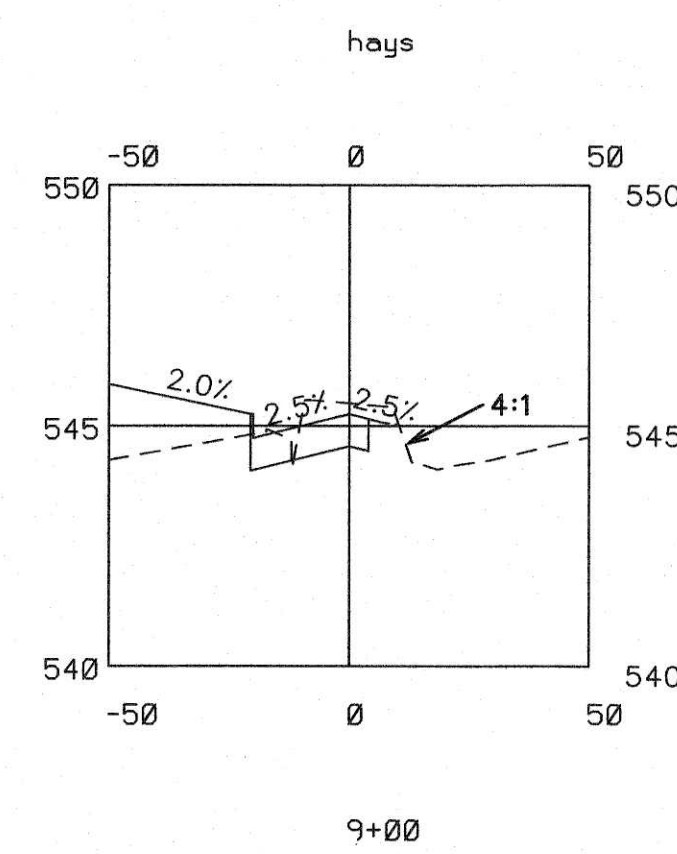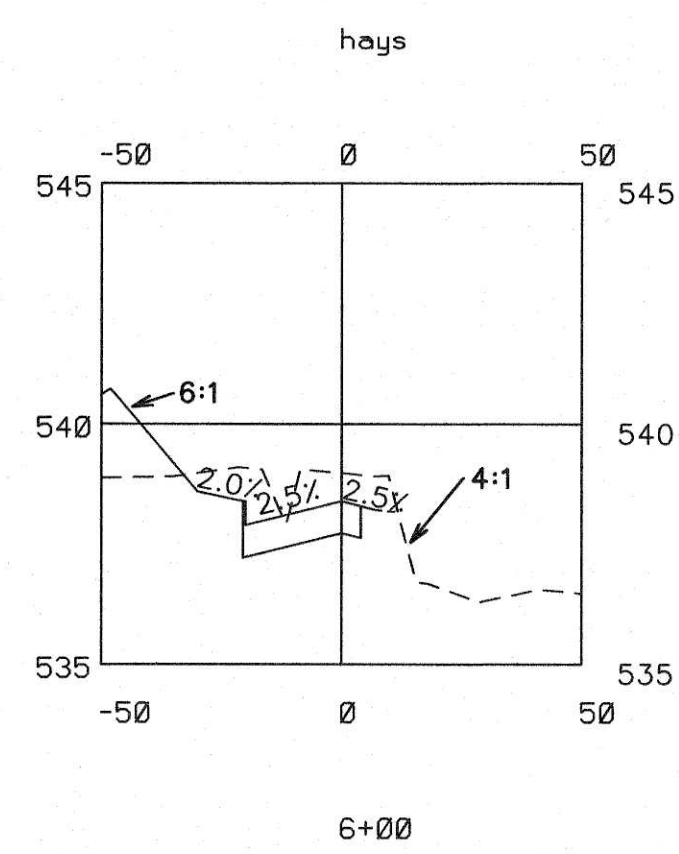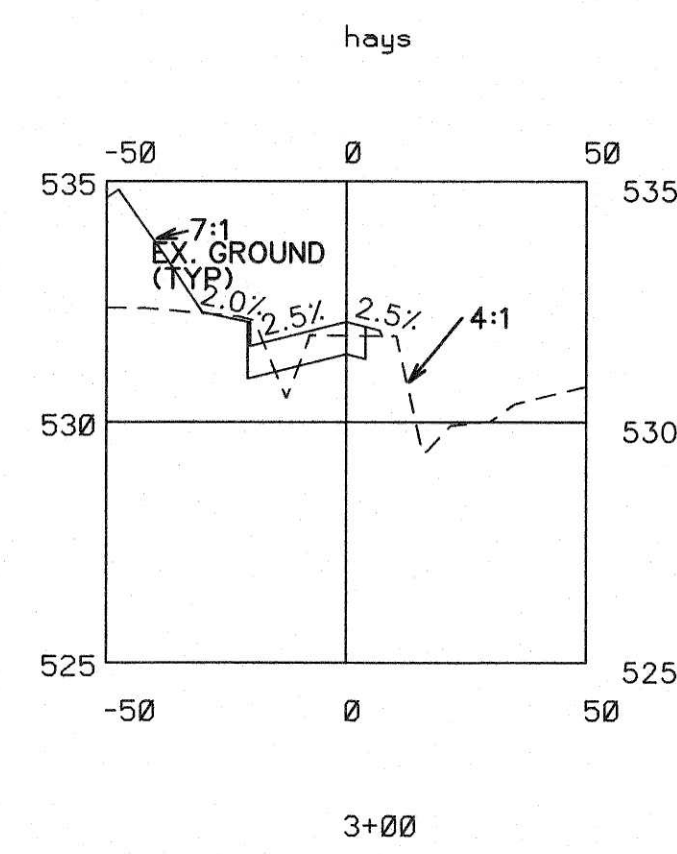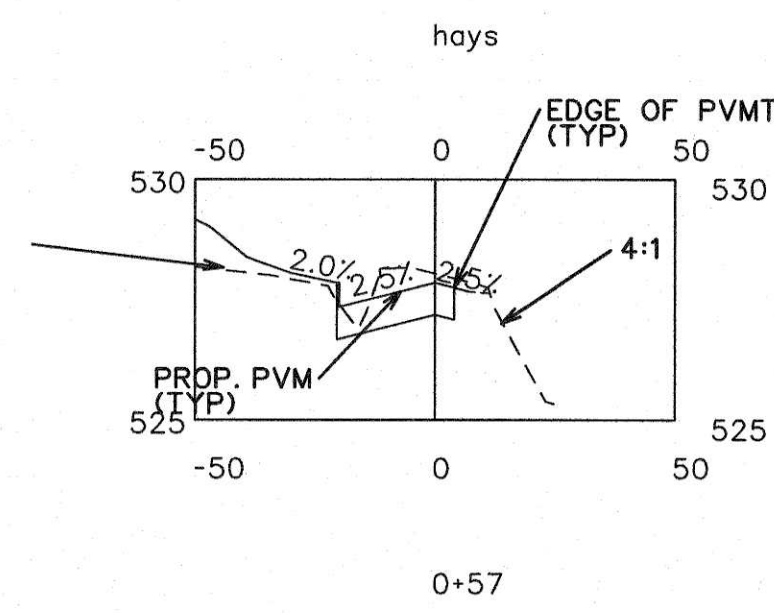



AS-BUILT SEPTEMBER 2018
INFORMATION PROVIDED
BY CONTRACTORS
(NOT FIELD VERIFIED)

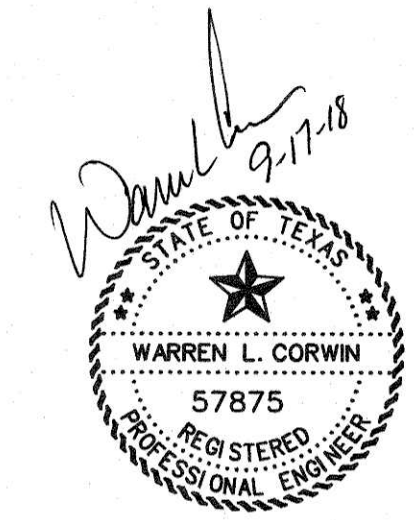

| | | | |
|--|----------------------|----------------------------------|-----------|
| <div>  CORWIN ENGINEERING, INC. 200 W. BELMONT, SUITE E ALLEN, TEXAS 75013 (972)396-1200 TBPE FIRM #5951 </div> | | | |
| DEVELOPMENT PLANS FOR STONE CREEK PHASE VIII ROCKWALL, TEXAS | | | |
| HAYS ROAD CROSS SECTIONS | | | |
| DRAWN BY | DESIGNED BY | CHECKED BY | SHEET NO. |
| JOB NUMBER 16044 | DATE OCTOBER 2016 | SCALE: HOR: 1"=40' VER: 1"=4' | 12 OF 32 |



- A** Detectable Warning Devices (DWD) shall be pre-manufactured cast-in-place truncated dome plates installed to the manufacturer's specifications, and shall meet all ADA requirements. No Brick Pavers allowed. Color to be approved by the City. DWD shall be 24 inches in length for the full width of the street connection starting at the back of curb. A maximum 2-inch border shall be allowed on the sides of the DWD for proper installation.
- B** Also known as "Clear Space" per ADA PROWAG, the City requires a minimum landing space of 5-foot by 5-foot at the bottom of every ramp. This landing space shall have a cross slope in both directions that does not exceed 2.0% and shall be wholly outside the parallel vehicular travel path.
- C** The ramp component of the directional curb ramp shall have a continuous longitudinal slope more than 5% and less than 8.3%. The ramp shall also have a cross slope of no more than 2.0%. Length of ramp can vary, but shall not exceed 15 feet to achieve desired elevation change.
- D** Also known as "Turning Space" per ADA PROWAG, a minimum landing space of 5-foot by 5-foot shall be at the top of every ramp. This landing (turning) space shall have a cross slope in both directions that does not exceed 2.0%. Landing must match width of sidewalk and length shall be the same distance ("Squared" Landing).
- E** All curb ramps shall have grade breaks at the top and bottom that are perpendicular to the direction of the ramp run. Where the ends of the bottom grade break are less than or equal to 5 feet, the DWD shall be placed within the ramp at the bottom grade break. Where either end of the bottom grade break is greater than 5 feet, the DWD shall be placed behind the back of the curb.
- F** Paving contractor shall leave block out with a keyway joint installed, minimum of 18 inches measured from back of curb. Block out shall be poured monolithically with Curb Ramp. Concrete shall tie to street paving with a keyway joint per NCTCOG detail 2050. No curb shall be constructed where a DWD is provided. The curb on either side shall have a typical 5 foot taper to transition from the standard 6-inch curb height to be flush with ramp.
- G** All work associated with accessible routes shall be installed flush with all features to minimize vertical surface discontinuities. Each segment along accessible route shall be flush with no more (zero tolerance) than a 1/4-inch grade separation (elevation difference), or 1/2-inch grade separation if beveled (bevel slope shall not be steeper than 50%).
- H** A sidewalk header shall be constructed at ends of all work performed.
- I** Street crossings shall adhere to same guidelines as other accessible routes within public right-of-way, and shall be for the full width of the in-line accessible route. Cross slope shall not exceed 2%. New street construction shall incorporate all ADA design requirements. It shall be the responsibility of the Design Professional and Contractor to ensure all street crossings meet the requirements of PROWAG. Street alterations on existing streets to bring to compliance shall be at the City Engineer's discretion.
- J** All curbs constructed as part of an ADA Ramp shall match City curb standards.
- * See PROWAG special design considerations when street crossing has no stop or yield condition.

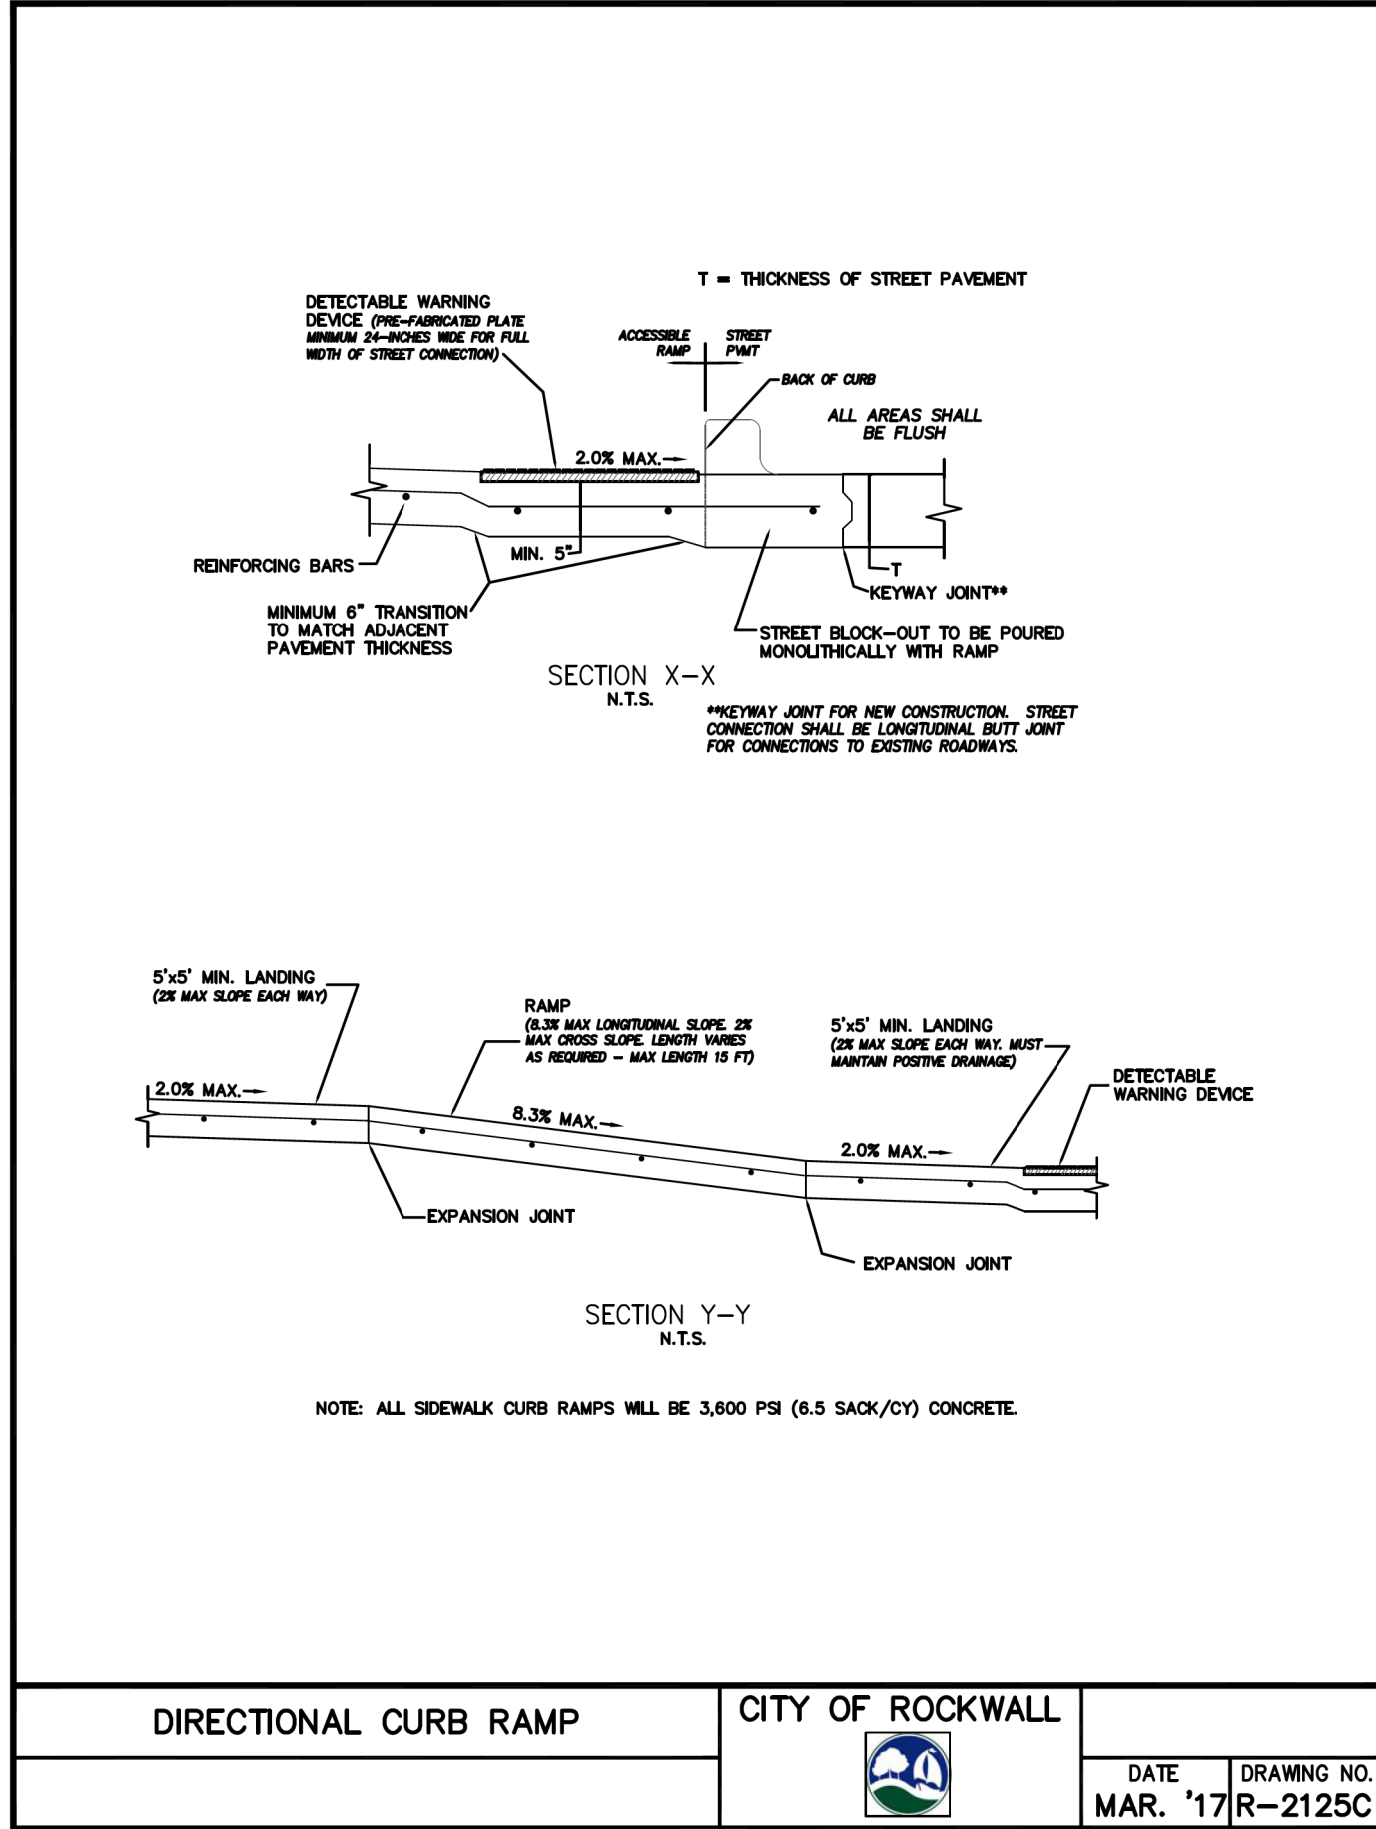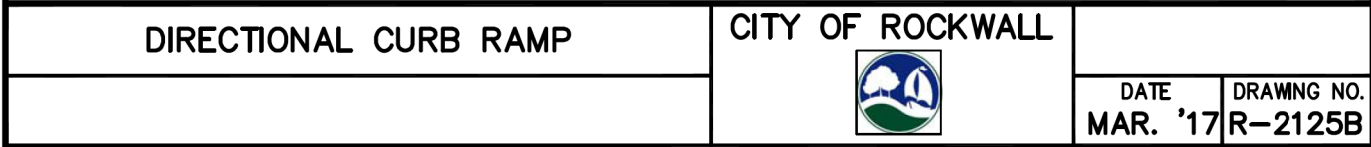

PEDESTRIAN ACCESSIBILITY (WITHIN PUBLIC R.O.W.)

All newly constructed sidewalks, curb ramps and crosswalks installed within City of Rockwall public rights-of-way shall be considered a pedestrian access route and shall conform to the most current Guidelines for Public Rights-of-Way created by the United States Access Board.

CURB RAMPS


- All slopes shown are **MAXIMUM ALLOWABLE**. Lesser slopes that will still drain properly should be used. Adjust curb ramp length or grade of approach sidewalks as directed.
- Landings shall be 5'x 5' minimum with a maximum 2% slope in the transverse and longitudinal directions.
- Clear space at the bottom of curb ramps shall be a minimum of 5'x 5' wholly contained within the crosswalk and wholly outside the parallel vehicular travel path.
- Maximum allowable cross slope on sidewalk and curb ramp surfaces is 2%.
- Additional information on curb ramp location, design, light reflective value and texture may be found in the most current edition of the Texas Accessibility Standards (TAS) and 16 TAC 68.102. Federal guidelines shall supersede any conflicts.
- Crosswalk dimensions, crosswalk markings and stop bar locations shall be as shown elsewhere in the plans. At intersections where crosswalk markings are not required, curb ramps and accessible routes shall align with theoretical crosswalks unless otherwise directed.
- Handrails are not required on curb ramps.
- Provide a flush transition where the curb ramps connect to the street.
- Accessible routes are considered "ramps" when longitudinal slopes are between 5% and 8.3% (maximum allowable). Sidewalks under 5% longitudinal slope are deemed accessible routes and must follow all applicable guidelines.

DETECTABLE WARNING DEVICE

- Curb ramps must contain a detectable warning surface that consists of raised truncated domes complying with Section 705 of the TAS. The surface must contrast visually with adjoining surfaces. Furnish and install an approved cast-in-place dark red detectable warning surface material adjacent to uncolored concrete, unless specified elsewhere in the plans.
- Detectable Warning Materials shall be truncated dome plates in the color approved by the City. Install products in accordance with manufacturer's specifications.
- Detectable warning surfaces must be slip resistant and not allow water to accumulate.
- Detectable warning surfaces shall be a minimum of 24" in depth in the direction of pedestrian travel, and extend the full width of the curb ramp or landing where the pedestrian access route enters the street.
- Detectable warning surfaces shall be located so that the edge nearest the curb line is at the back of curb. When placed on the ramp, align the rows of domes to be perpendicular to the grade break between the ramp run and the street. Where detectable warning surfaces are provided on a surface with a slope that is less than 5 percent, dome orientation is less critical. Detectable warning surfaces may be curved along the corner radius.

SIDEWALKS

- Provide clear ground space at operable parts, including pedestrian push buttons. Operable parts shall be placed within one or more reach ranges specified in TAS 308.
- Place traffic signal or illumination poles, ground boxes, controller boxes, signs, drainage facilities and other items so as not to obstruct the pedestrian access route or clear ground space.
- Street grades and cross slopes shall be as shown elsewhere in the plans.
- Changes in level greater than 1/4 inch are not permitted (1/2 inch with bevel).
- The least possible grade should be used to maximize accessibility. The running slope of sidewalks and crosswalks within the public right of way may follow the grade of the parallel roadway. Where a continuous grade greater than 5% must be provided, handrails may be desirable to improve accessibility. Handrails may also be needed to protect pedestrians from potentially hazardous conditions. If provided, handrails shall comply with TAS 505.
- Handrail extensions shall not protrude into the usable landing area or into intersecting pedestrian routes.

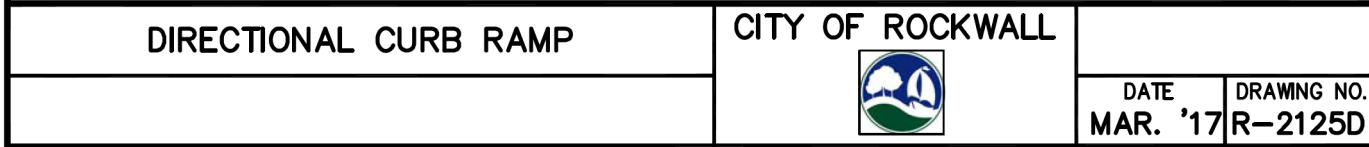

CORWIN ENGINEERING, INC.
200 W. BELMONT, SUITE E
ALLEN, TEXAS 75013 (972)396-1200
TBPE FIRM #5951

DEVELOPMENT PLANS FOR
STONE CREEK
PHASE VIII
ROCKWALL, TEXAS


SIDEWALK RAMP DETAILS

| | | | |
|------------|--------------|----------------------------------|-----------|
| DRAWN BY | DESIGNED BY | CHECKED BY | SHEET NO. |
| JOB NUMBER | DATE | SCALE: HOR: 1"=40' VER: 1"=4' | 12A OF 32 |
| 16044 | OCTOBER 2016 | | |


AS-BUILT SEPTEMBER 2018
INFORMATION PROVIDED
BY CONTRACTORS
(NOT FIELD VERIFIED)

LEGEND

- PROP. WATER LINE
- PROP. FIRE HYDRANT AND VALVE
- PROP. GATE VALVE
- PROP. FLUSH VALVE
- EXIST. WATER LINE
- EXIST. FIRE HYDRANT AND VALVE
- PROP. SANITARY SEWER
- PROP. MANHOLE
- PROP. CLEANOUT
- EXIST. SANITARY SEWER
- EXIST. MANHOLE
- PROP. STORM SEWER
- PROP. CURB INLETS
- PROP. CONC. HEADWALL

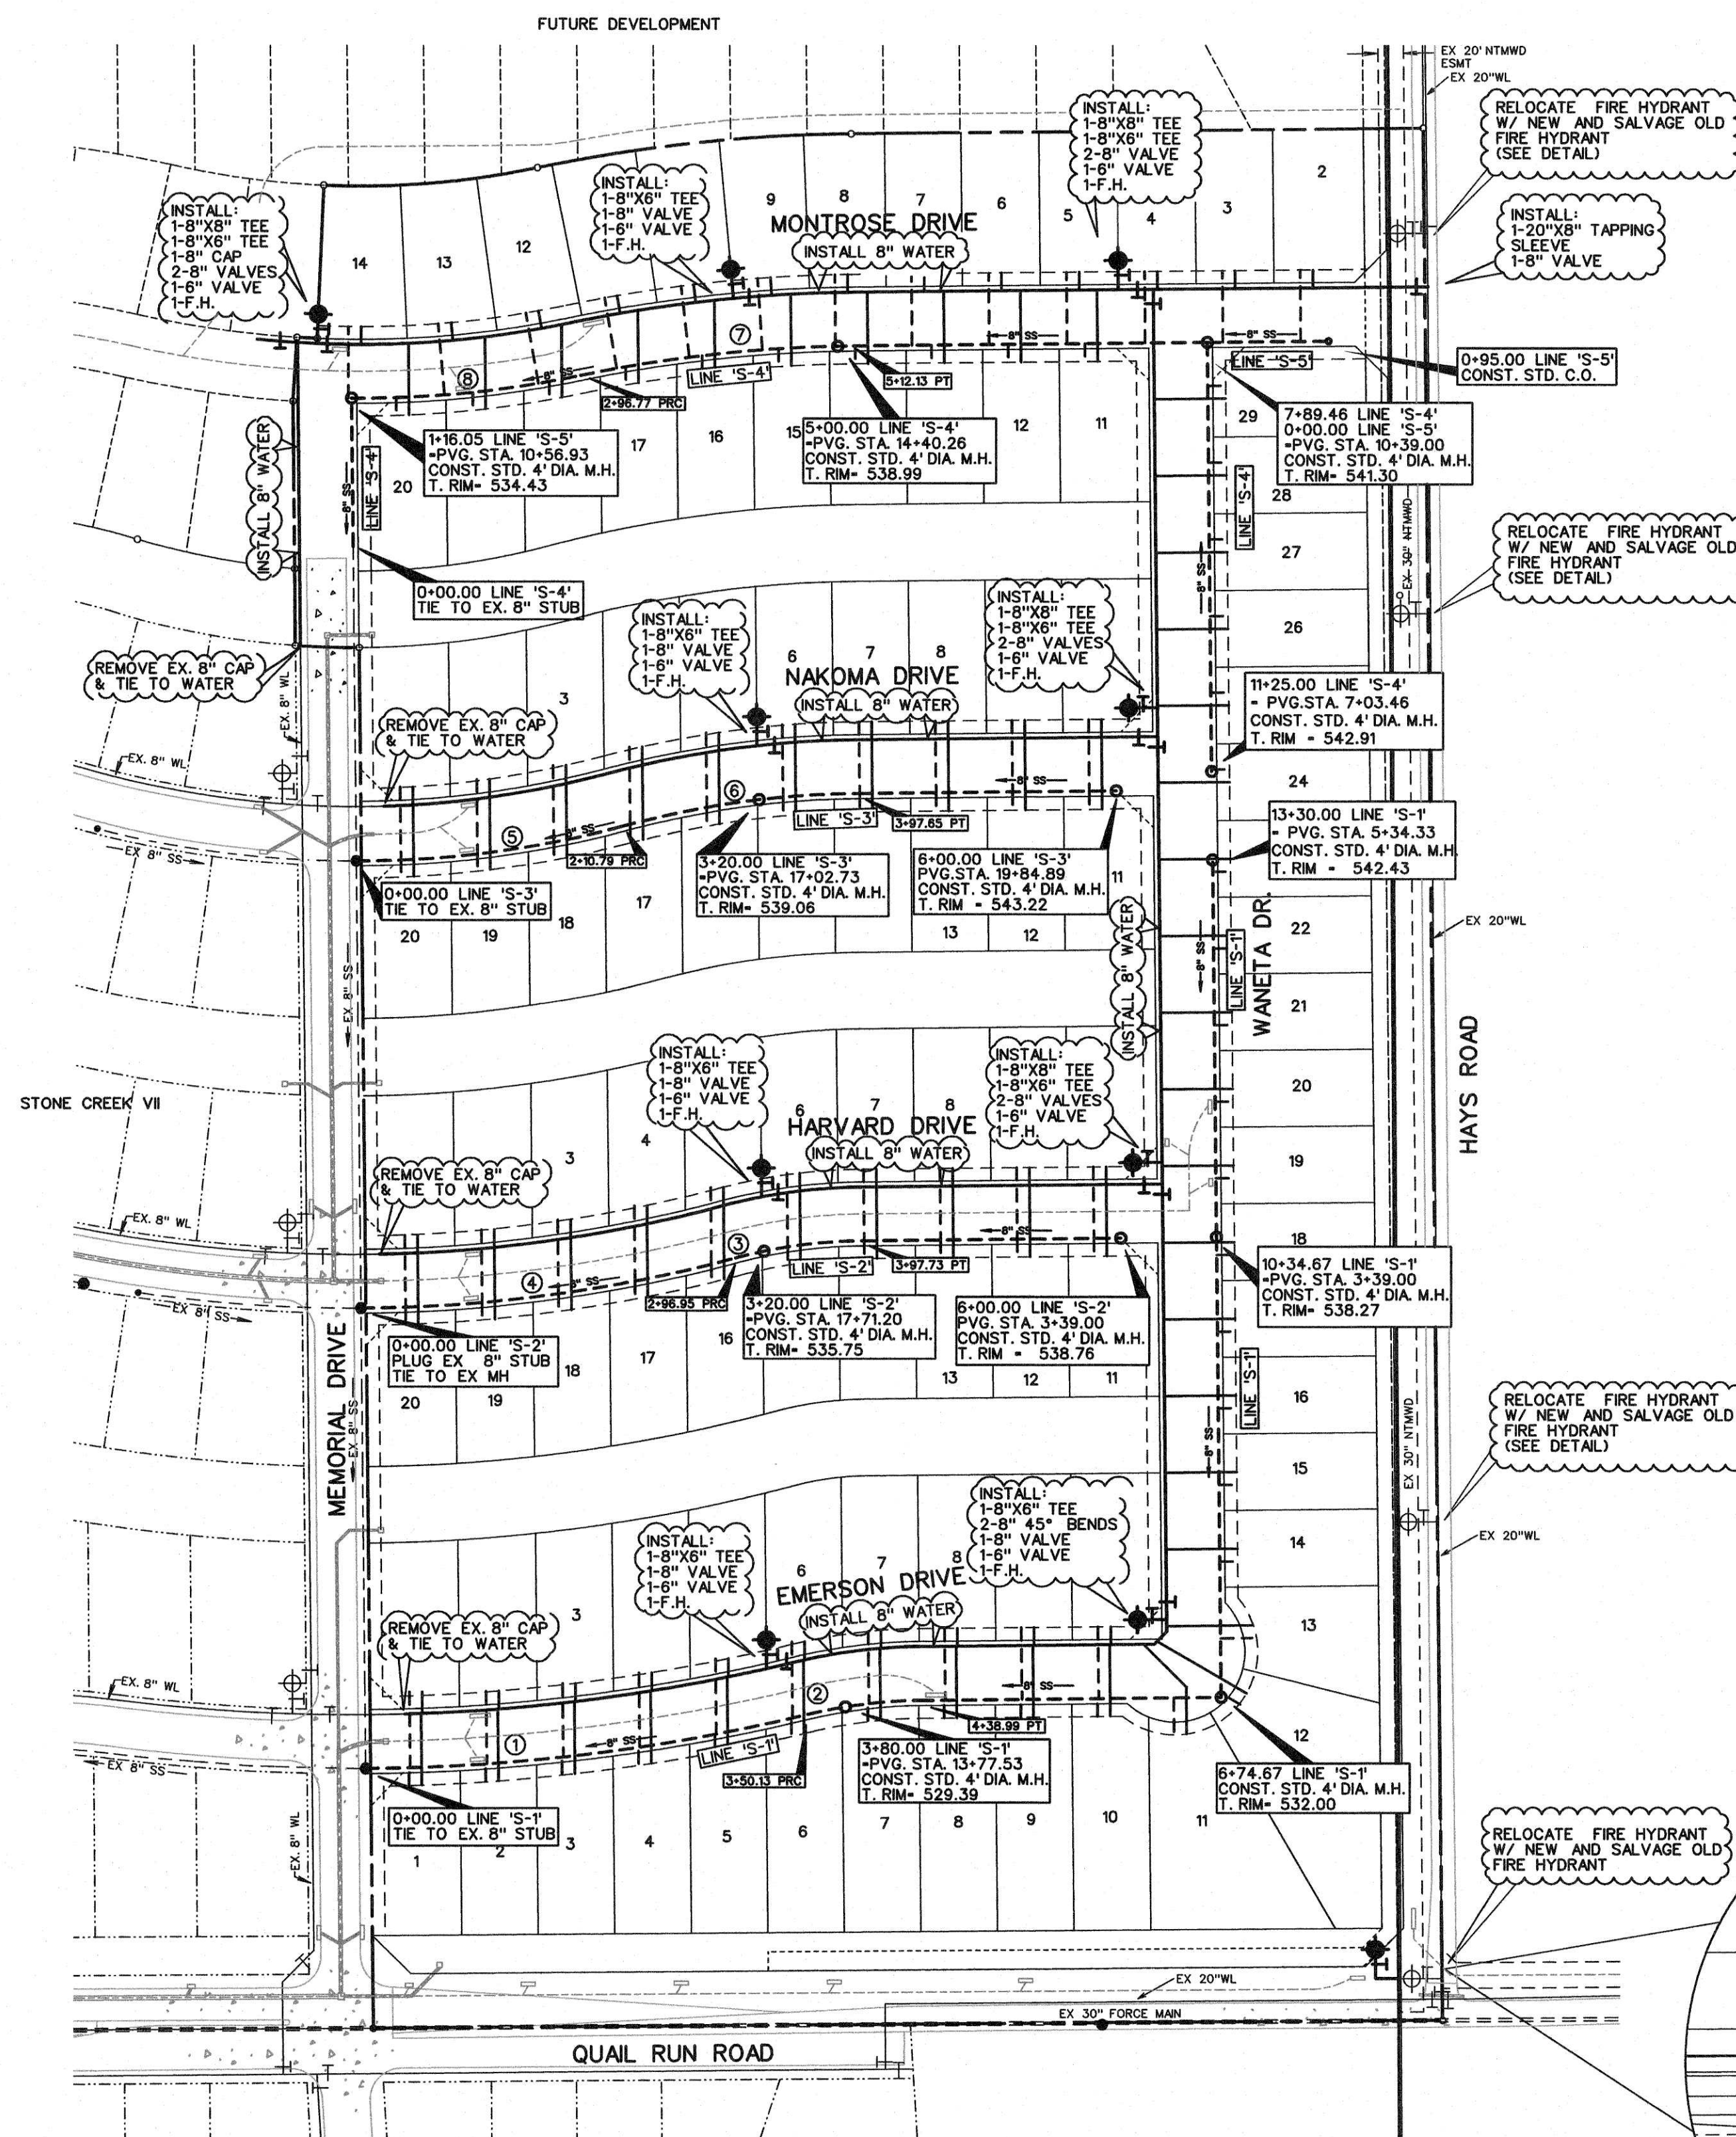

FIRE HYDRANT RELOCATION

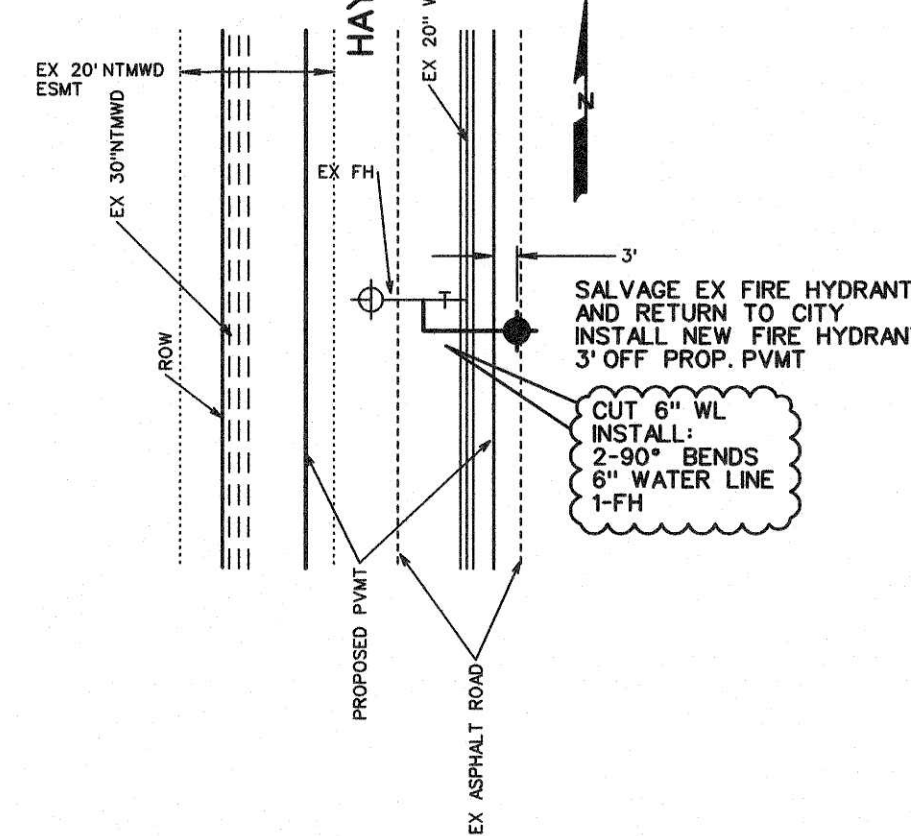



NOTE:

THE CONTRACTOR SHALL CONTACT NTMWD ENGINEERING AT (972) 442-5405 AT LEAST 48 HOURS PRIOR TO PERFORMING WORK IN THE VICINITY OF THE NTMWD FACILITIES

BENCHMARK:

CITY OF ROCKWALL SURVEY MONUMENT ON AN INLET AT THE NORTHWEST CORNER OF FEATHERSTONE DR. AND HARVARD DR. ELEV. = 525.31

AS-BUILT SEPTEMBER 2018
INFORMATION PROVIDED
BY CONTRACTORS
(NOT FIELD VERIFIED)

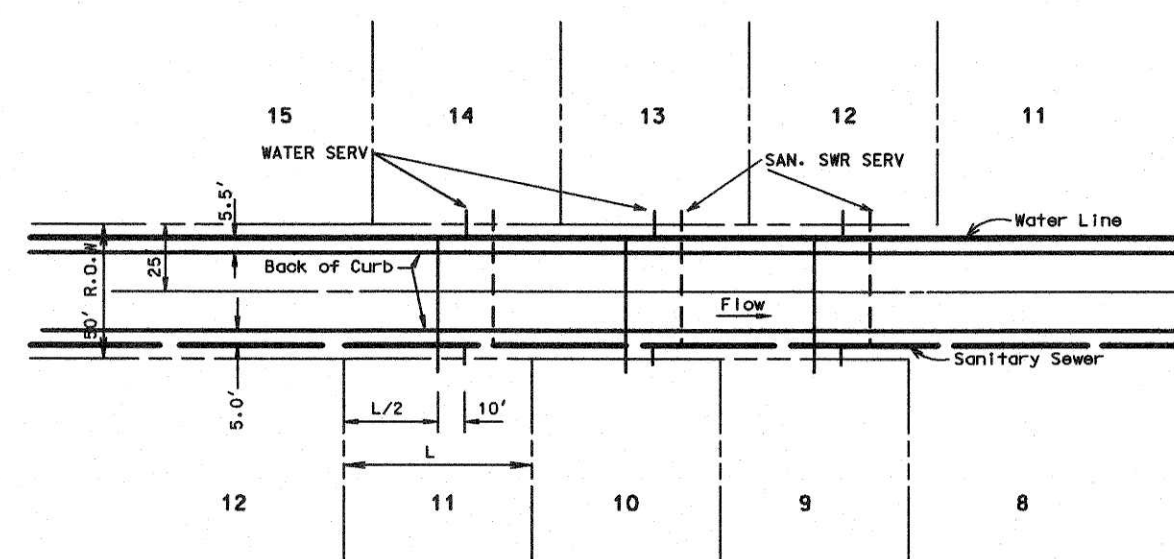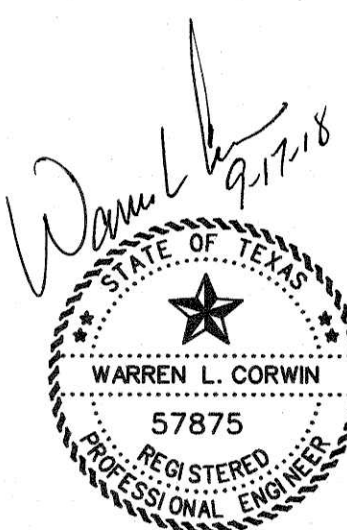

TYPICAL WATER & SEWER
SERVICE LAYOUT
N.T.S.

CURVE TABLE

| CURVE NO. | DELTA | RADIUS | LENGTH | TANGENT |
|-----------|-----------|----------|---------|---------|
| 1. | 13°06'12" | 1531.00' | 350.13' | 175.83' |
| 2. | 12°55'19" | 394.00' | 88.86' | 44.62' |
| 3. | 14°17'33" | 404.00' | 100.78' | 50.65' |
| 4. | 14°31'46" | 1171.00' | 296.95' | 149.28' |
| 5. | 14°42'39" | 821.00' | 210.79' | 105.98' |
| 6. | 14°11'56" | 754.00' | 186.86' | 93.91' |
| 7. | 11°10'37" | 1104.00' | 215.36' | 108.02' |
| 8. | 12°14'21" | 846.00' | 180.72' | 90.70' |

NOTE:

ALL WATER LINES TO BE CLASS 200 PIPE DR-14 C-900.

ALL SANITARY SEWER PIPE TO BE SDR 35 FOR 5'-10' DEEP AND SDR 26 FOR 10' AND GREATER.

INSTALL BLUE "EMS" DISK ON WATER LINE AT EVERY 250' AND CHANGE IN DIRECTION, VALVE, AND SERVICE.

INSTALL GREEN "EMS" DISK ON SANITARY SEWER LINE EVERY 250' AND AT EVERY CHANGE IN DIRECTION, MANHOLE, CLEANOUT, AND SERVICE.

ALL MANHOLES TO BE RAVEN EPOXY LINED AND SEALED OR APPROVED EQUAL TO BE SPARK AND PRESSURE TESTED.

| SERVICE SCHEDULE | | |
|------------------|--------|-----|
| TYPE | SIZE | NO. |
| SANITARY | 4" | 102 |
| WATER | 1" | 102 |
| IRRIGATION | 1 1/2" | xx |




CORWIN ENGINEERING, INC.
200 W. BELMONT, SUITE E
ALLEN, TEXAS 75013 (972) 396-1200
TBE FIRM #5951



DEVELOPMENT PLANS FOR
STONE CREEK
PHASE VIII
ROCKWALL, TEXAS

WATER AND SANITARY SEWER PLAN

| DRAWN BY | DESIGNED BY | CHECKED BY | SHEET NO. |
|---------------------|----------------------|-------------------|-----------|
| JOB NUMBER 16044 | DATE OCTOBER 2016 | SCALE: 1"=100' | 13 OF 32 |

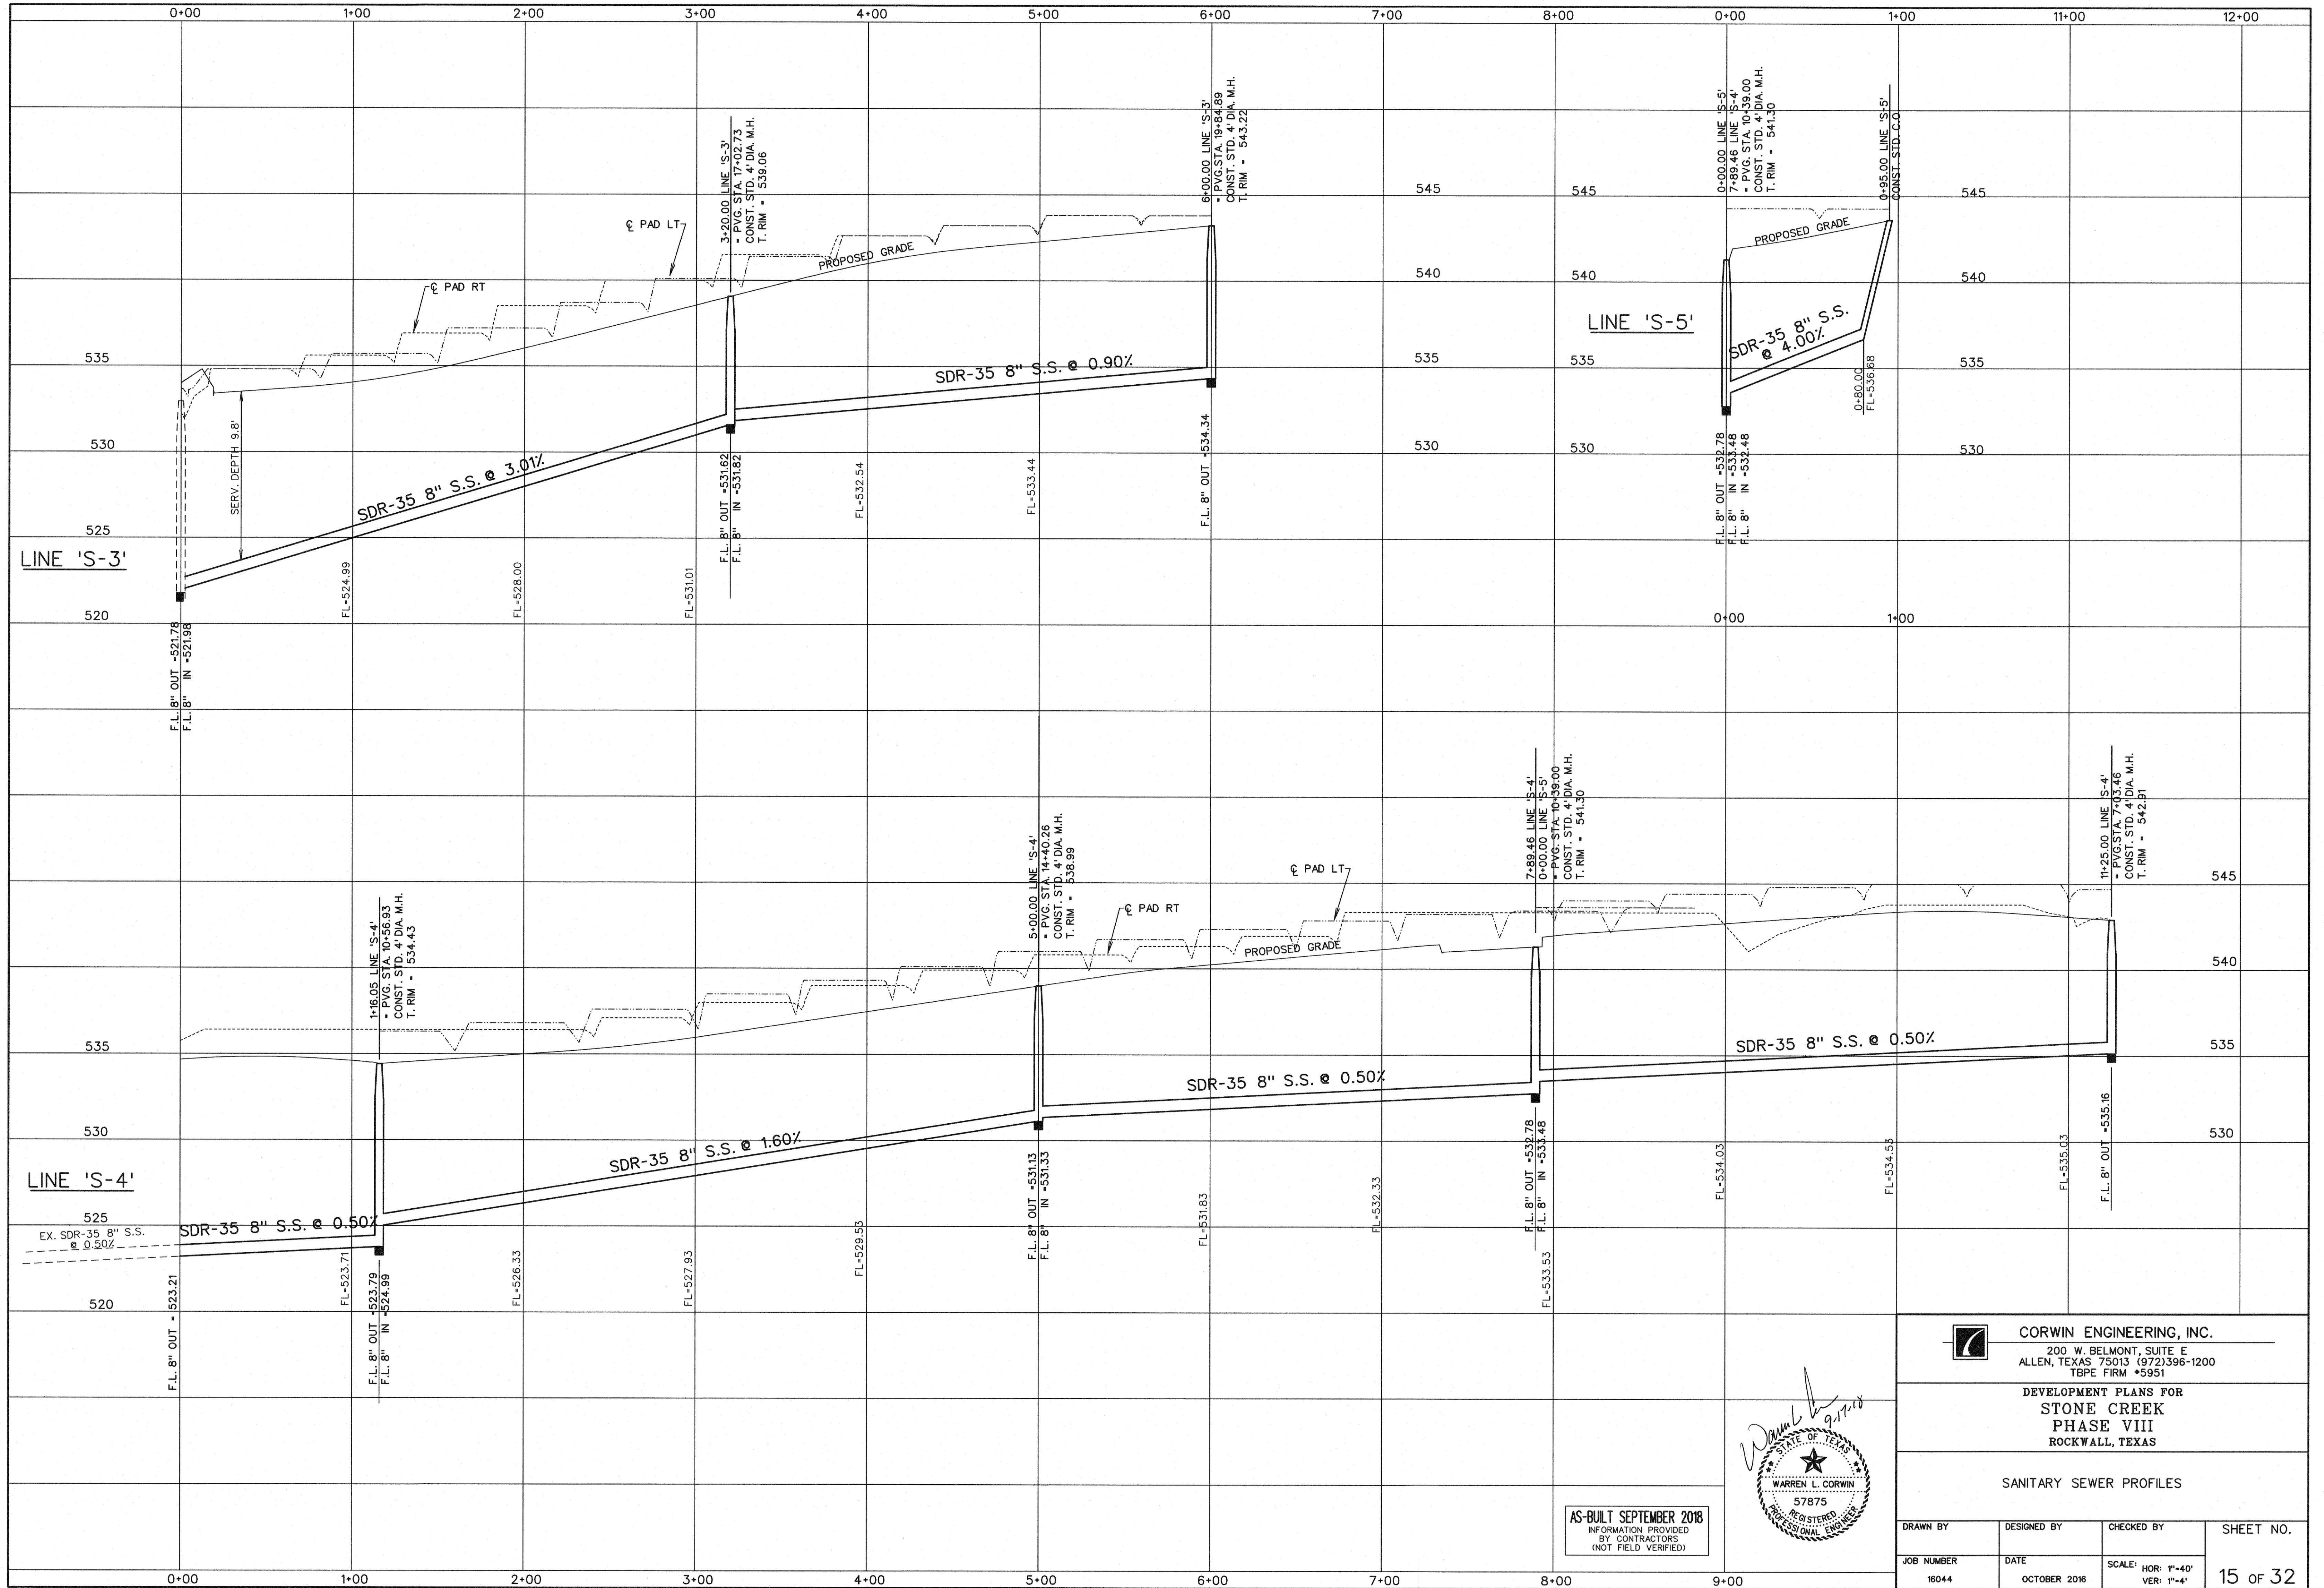

AS-BUILT SEPTEMBER 2018
INFORMATION PROVIDED
BY CONTRACTORS
(NOT FIELD VERIFIED)

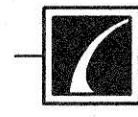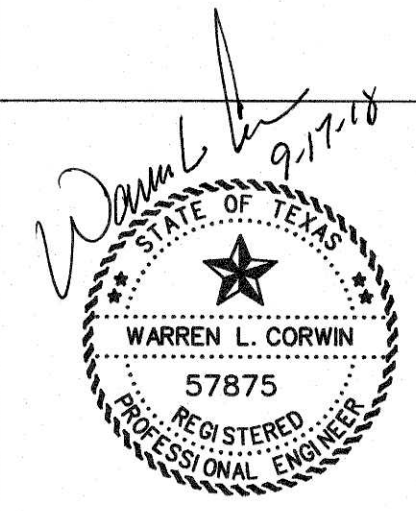


CORWIN ENGINEERING, INC.
200 W. BELMONT, SUITE E
ALLEN, TEXAS 75013 (972)396-1200
TBP# FIRM #5951

DEVELOPMENT PLANS FOR
STONE CREEK
PHASE VIII
ROCKWALL, TEXAS


SANITARY SEWER PROFILES

| | | | |
|------------|--------------|----------------------------------|-----------|
| DRAWN BY | DESIGNED BY | CHECKED BY | SHEET NO. |
| JOB NUMBER | DATE | SCALE: HOR: 1"=40' VER: 1"=4' | 15 OF 32 |
| 16044 | OCTOBER 2016 | | |

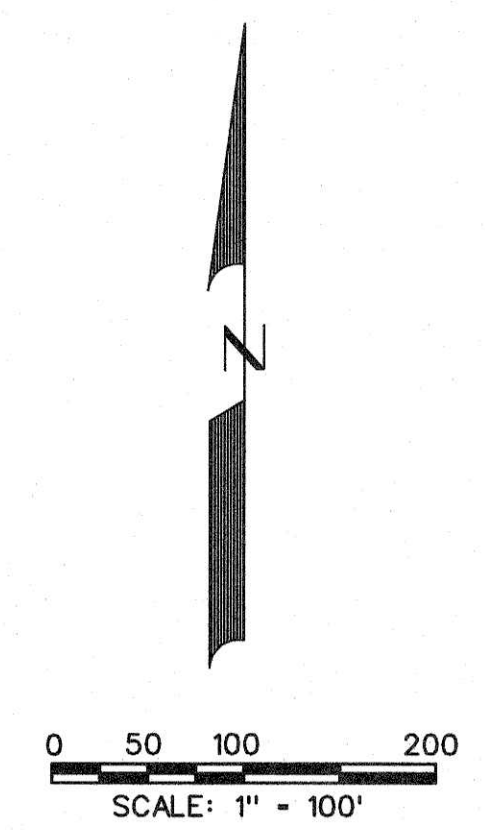

| EXISTING CONDITIONS RUNOFF COMPUTATIONS | | | | | | | | | |
|---|-----------|--------------|--------------------|------|----------|----------------|--------------|----------------|--|
| Area # | Area (sf) | Area (acres) | Runoff Coefficient | CA | Tc (min) | I(100) (in/hr) | Q(100) (cfs) | Drains To: | |
| EX1 | 217491 | 4.99 | 0.35 | 1.75 | 20 | 8.30 | 14.5 | North | |
| EX2 | 305933 | 7.02 | 0.35 | 2.46 | 20 | 8.30 | 20.4 | Harvard Drive | |
| EX3 | 360930 | 8.29 | 0.35 | 2.90 | 20 | 8.30 | 24.1 | Memorial Drive | |
| EX4 | 246648 | 5.66 | 0.35 | 1.98 | 20 | 8.30 | 16.4 | Memorial Drive | |
| EX5 | 140357 | 3.22 | 0.35 | 1.13 | 20 | 8.30 | 9.4 | Hays Road | |

- LEGEND
- PROP. STORM SEWER
 - PROP. CURB INLETS
 - PROP. CONC. HEADWALL
 - EXIST. STORM SEWER
 - DRAINAGE AREA DIVIDE
 - FLOW ARROW
 - DRAINAGE AREA NO.



CORWIN ENGINEERING, INC.
200 W. BELMONT, SUITE E
ALLEN, TEXAS 75013 (972)396-1200
TBPE FIRM #5951


DEVELOPMENT PLANS FOR
STONE CREEK
PHASE VIII
ROCKWALL, TEXAS

EXISTING CONDITIONS DRAINAGE AREA MAP






| | | | |
|---------------------|----------------------|-------------------|---------------------------|
| DRAWN BY | DESIGNED BY | CHECKED BY | SHEET NO. 16 OF 32 |
| JOB NUMBER 16044 | DATE OCTOBER 2016 | SCALE: 1"=100' | |

AS-BUILT SEPTEMBER 2018
INFORMATION PROVIDED
BY CONTRACTORS
(NOT FIELD VERIFIED)



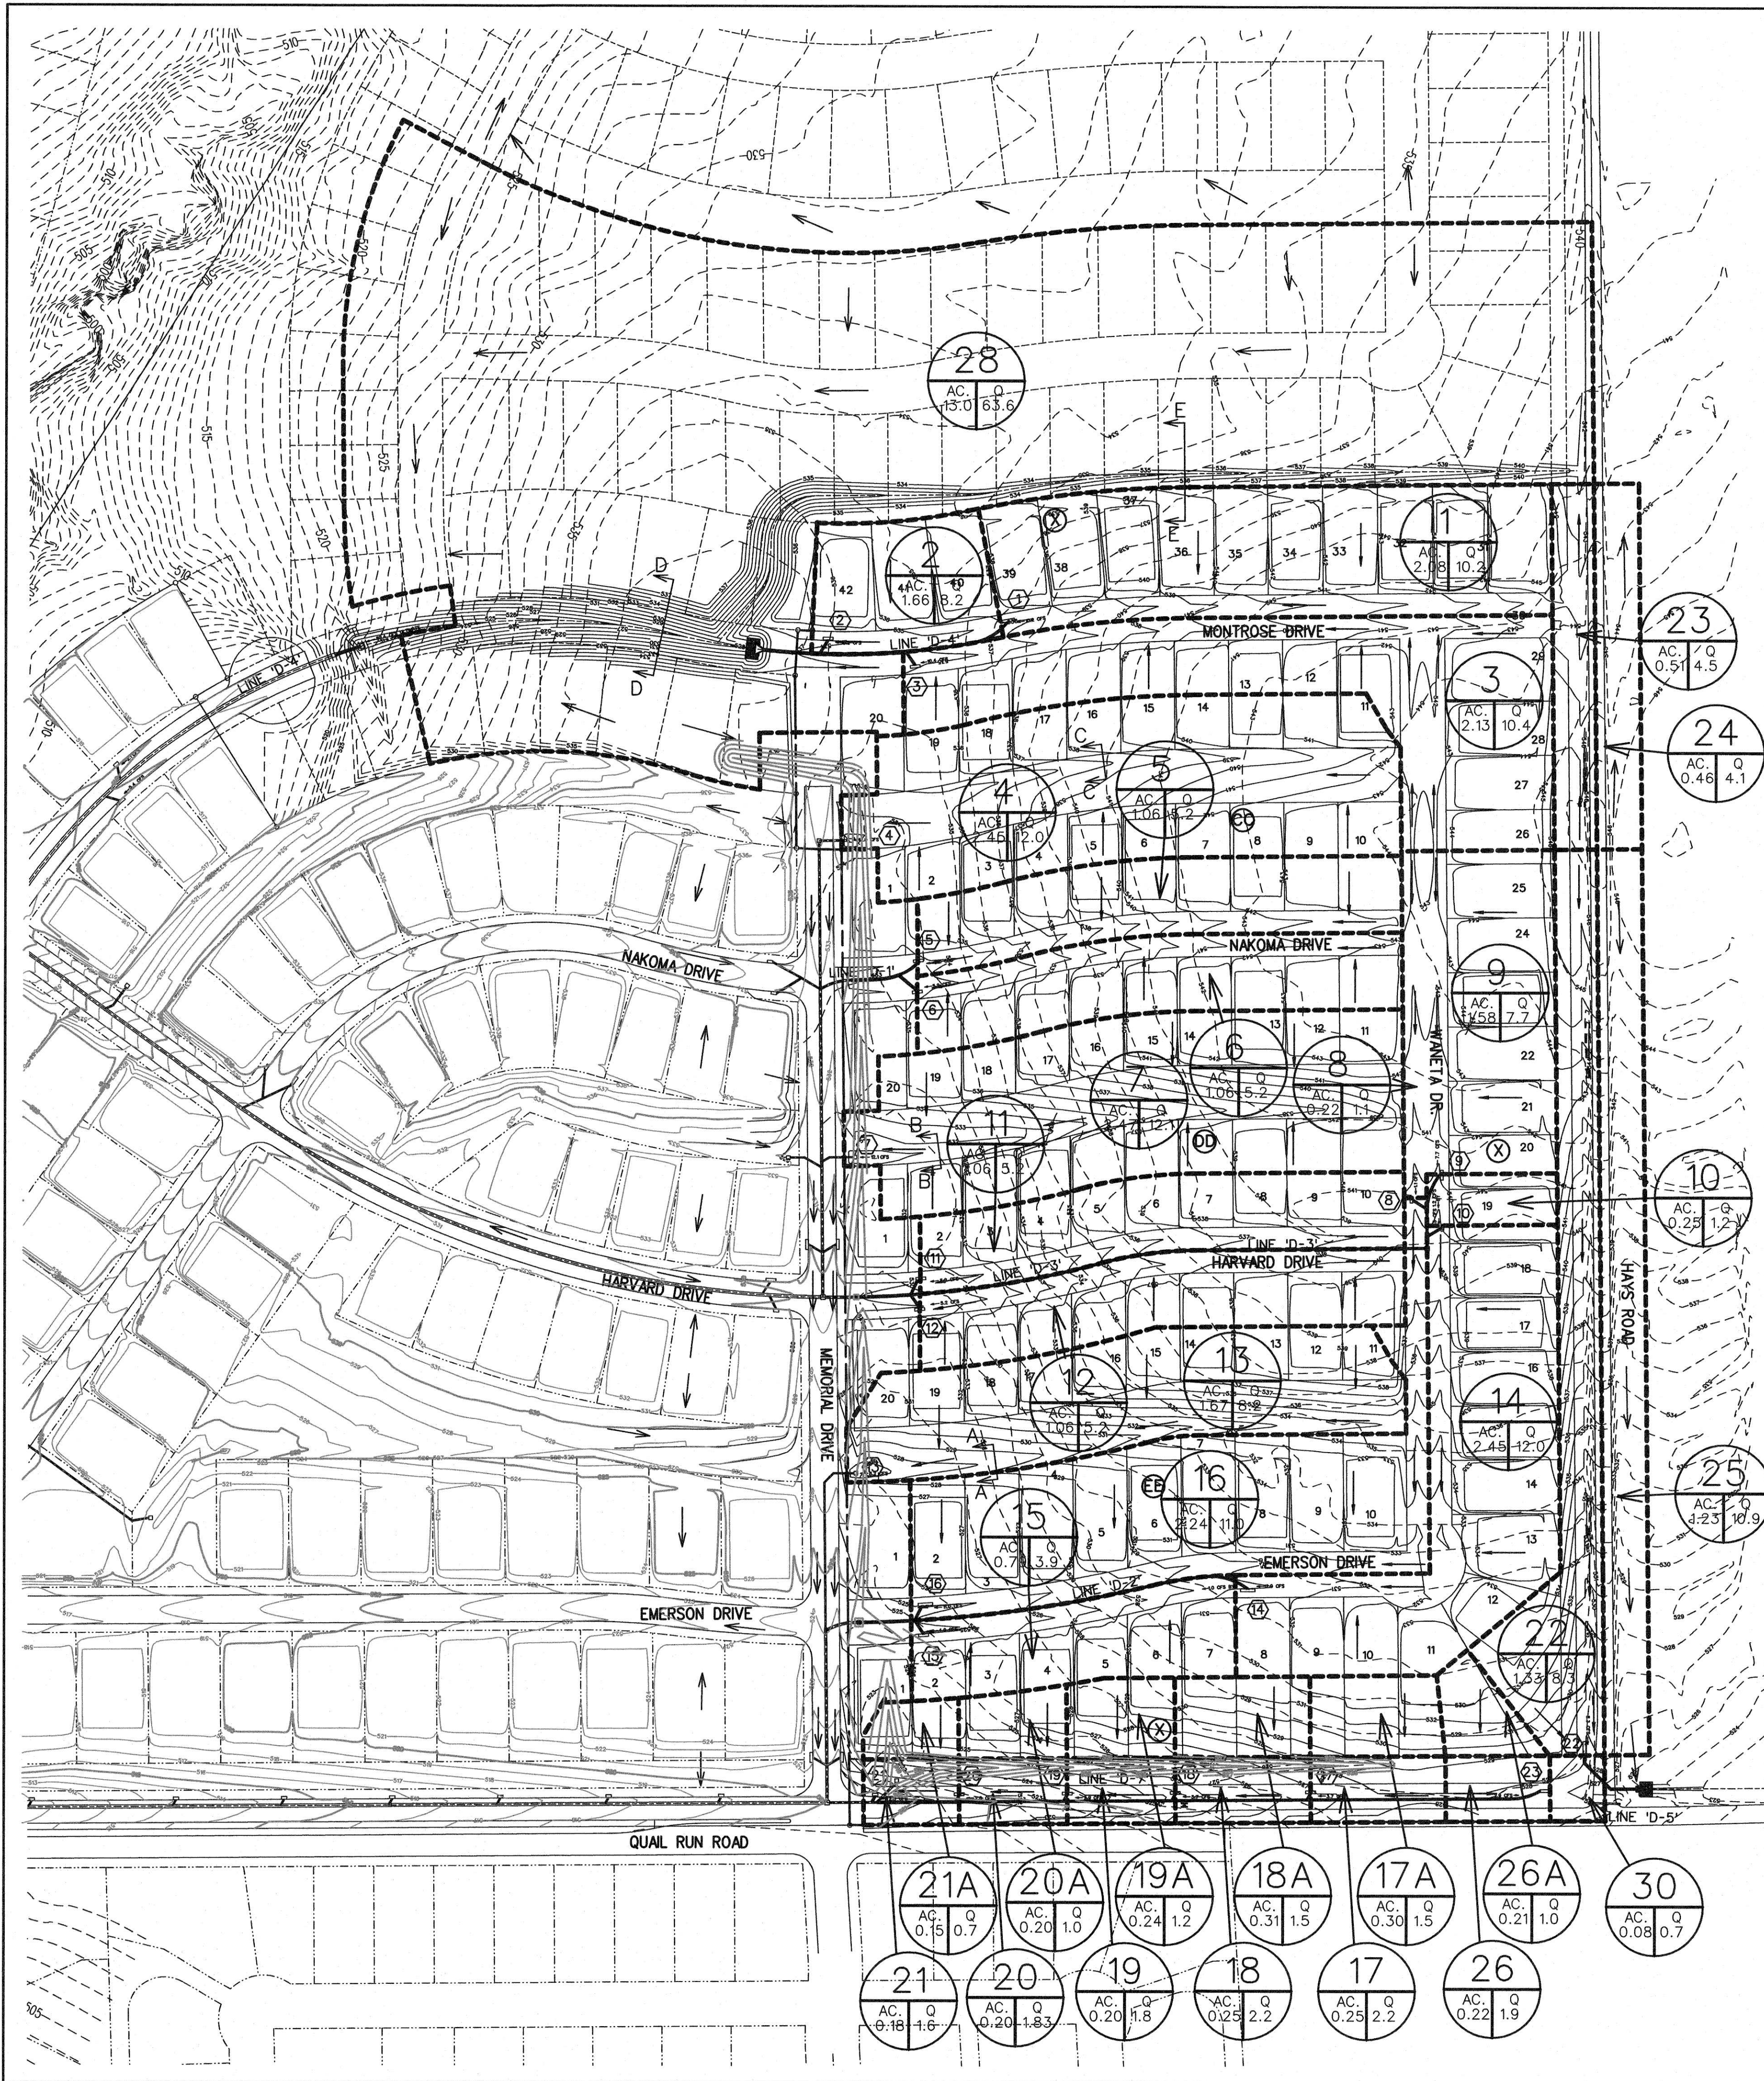

| RUNOFF COMPUTATIONS | | | | | | | | | |
|---------------------|-----------|--------------|--------------------|------|----------|----------------|--------------|---------------------|--|
| # | Area (sf) | Area (acres) | Runoff Coefficient | CA | Tc (min) | I(100) (in/hr) | Q(100) (cfs) | Drains To | |
| 1 | 93488 | 2.08 | 0.50 | 1.04 | 10 | 9.80 | 10.2 | Inlet 1 | |
| 2 | 28509 | 0.66 | 0.50 | 0.33 | 10 | 9.80 | 3.2 | Inlet 2 | |
| 3 | 92832 | 2.13 | 0.50 | 1.07 | 10 | 9.80 | 10.4 | Inlet 3 | |
| 4 | 106840 | 2.45 | 0.50 | 1.22 | 10 | 9.80 | 12.0 | Inlet 4 | |
| 5 | 40032 | 0.92 | 0.50 | 0.53 | 10 | 9.80 | 5.2 | Inlet 5 | |
| 6 | 46088 | 1.06 | 0.50 | 0.53 | 10 | 9.80 | 5.2 | Inlet 6 | |
| 7 | 107750 | 2.47 | 0.50 | 1.24 | 10 | 9.80 | 12.1 | Inlet 7 | |
| 8 | 9600 | 0.22 | 0.50 | 0.11 | 10 | 9.80 | 1.1 | Inlet 8 | |
| 9 | 68736 | 1.58 | 0.50 | 0.79 | 10 | 9.80 | 7.7 | Inlet 9 | |
| 10 | 10944 | 0.25 | 0.50 | 0.13 | 10 | 9.80 | 1.2 | Inlet 10 | |
| 11 | 46114 | 1.06 | 0.50 | 0.53 | 10 | 9.80 | 5.2 | Inlet 11 | |
| 12 | 45660 | 1.06 | 0.50 | 0.53 | 10 | 9.80 | 5.2 | Inlet 12 | |
| 13 | 72824 | 1.67 | 0.50 | 0.84 | 10 | 9.80 | 8.2 | Inlet 13 | |
| 14 | 106847 | 2.45 | 0.50 | 1.23 | 10 | 9.80 | 12.0 | Inlet 14 | |
| 15 | 34510 | 0.79 | 0.50 | 0.40 | 10 | 9.80 | 3.9 | Inlet 15 | |
| 16 | 97714 | 2.24 | 0.50 | 1.12 | 10 | 9.80 | 11.0 | Inlet 16 | |
| 17 | 10875 | 0.25 | 0.90 | 0.22 | 10 | 9.80 | 2.2 | Inlet 17 | |
| 17A | 13005 | 0.30 | 0.50 | 0.15 | 10 | 9.80 | 1.5 | Inlet 17 | |
| 18 | 10875 | 0.25 | 0.90 | 0.22 | 10 | 9.80 | 2.2 | Inlet 18 | |
| 18A | 13350 | 0.31 | 0.50 | 0.15 | 10 | 9.80 | 1.5 | Inlet 18 | |
| 19 | 8700 | 0.20 | 0.90 | 0.18 | 10 | 9.80 | 1.8 | Inlet 19 | |
| 19A | 10488 | 0.24 | 0.50 | 0.12 | 10 | 9.80 | 1.2 | Inlet 19 | |
| 20 | 8700 | 0.20 | 0.90 | 0.18 | 10 | 9.80 | 1.8 | Inlet 20 | |
| 20A | 8658 | 0.20 | 0.50 | 0.10 | 10 | 9.80 | 1.0 | Inlet 20 | |
| 21 | 7891 | 0.18 | 0.90 | 0.16 | 10 | 9.80 | 1.6 | Inlet 21 | |
| 21A | 6449 | 0.15 | 0.50 | 0.07 | 10 | 9.80 | 0.7 | Inlet 21 | |
| 22 | 57721 | 1.33 | 0.64 | 0.84 | 10 | 9.80 | 8.3 | Inlet 22 | |
| 23 | 22285 | 0.51 | 0.90 | 0.46 | 10 | 9.80 | 4.5 | Hays Road | |
| 24 | 20250 | 0.46 | 0.90 | 0.42 | 10 | 9.80 | 4.1 | Hays Road | |
| 25 | 53781 | 1.23 | 0.90 | 1.11 | 10 | 9.80 | 10.9 | Inlet 22 | |
| 26 | 9378 | 0.22 | 0.90 | 0.19 | 10 | 9.80 | 1.9 | Inlet 23 | |
| 26A | 9267 | 0.21 | 0.50 | 0.11 | 10 | 9.80 | 1.0 | Inlet 23 | |
| 28 | 56523 | 1.30 | 0.50 | 0.48 | 10 | 9.80 | 6.6 | Ultimate to Line D4 | |
| 30 | 3418 | 0.08 | 0.90 | 0.07 | 10 | 9.80 | 0.7 | Hays Road | |

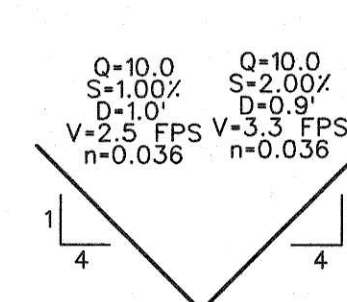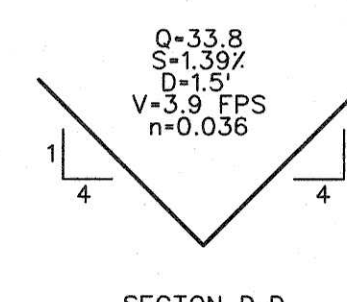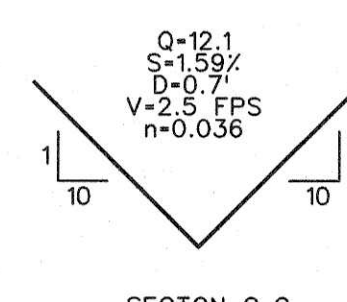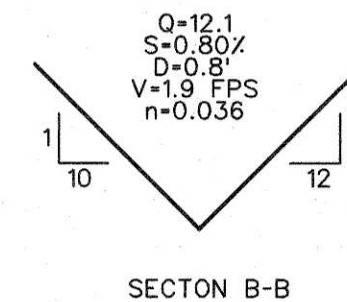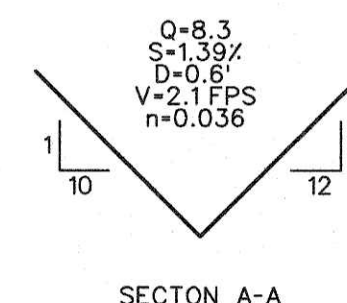

TYPICAL GRADE TO DRAIN SECTIONS
N.T.S.

- LEGEND
- PROP. STORM SEWER
 - PROP. CURB INLETS
 - PROP. CONC. HEADWALL
 - EXIST. STORM SEWER
 - DRAINAGE AREA DIVIDE
 - FLOW ARROW
 - DRAINAGE AREA NO.

AS-BUILT SEPTEMBER 2018
INFORMATION PROVIDED
BY CONTRACTORS
(NOT FIELD VERIFIED)





CORWIN ENGINEERING, INC.
200 W. BELMONT, SUITE E
ALLEN, TEXAS 75013 (972)396-1200
TBP FIRM #5951

DEVELOPMENT PLANS FOR
STONE CREEK
PHASE VIII
ROCKWALL, TEXAS


DRAINAGE AREA MAP

| DRAWN BY | DESIGNED BY | CHECKED BY | SHEET NO. |
|---------------------|----------------------|-------------------|-----------|
| JOB NUMBER 16044 | DATE OCTOBER 2016 | SCALE: 1"=100' | 17 OF 32 |

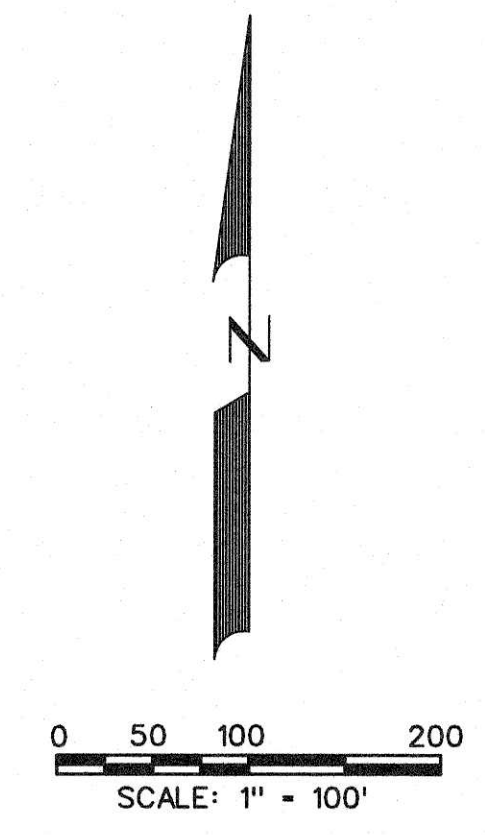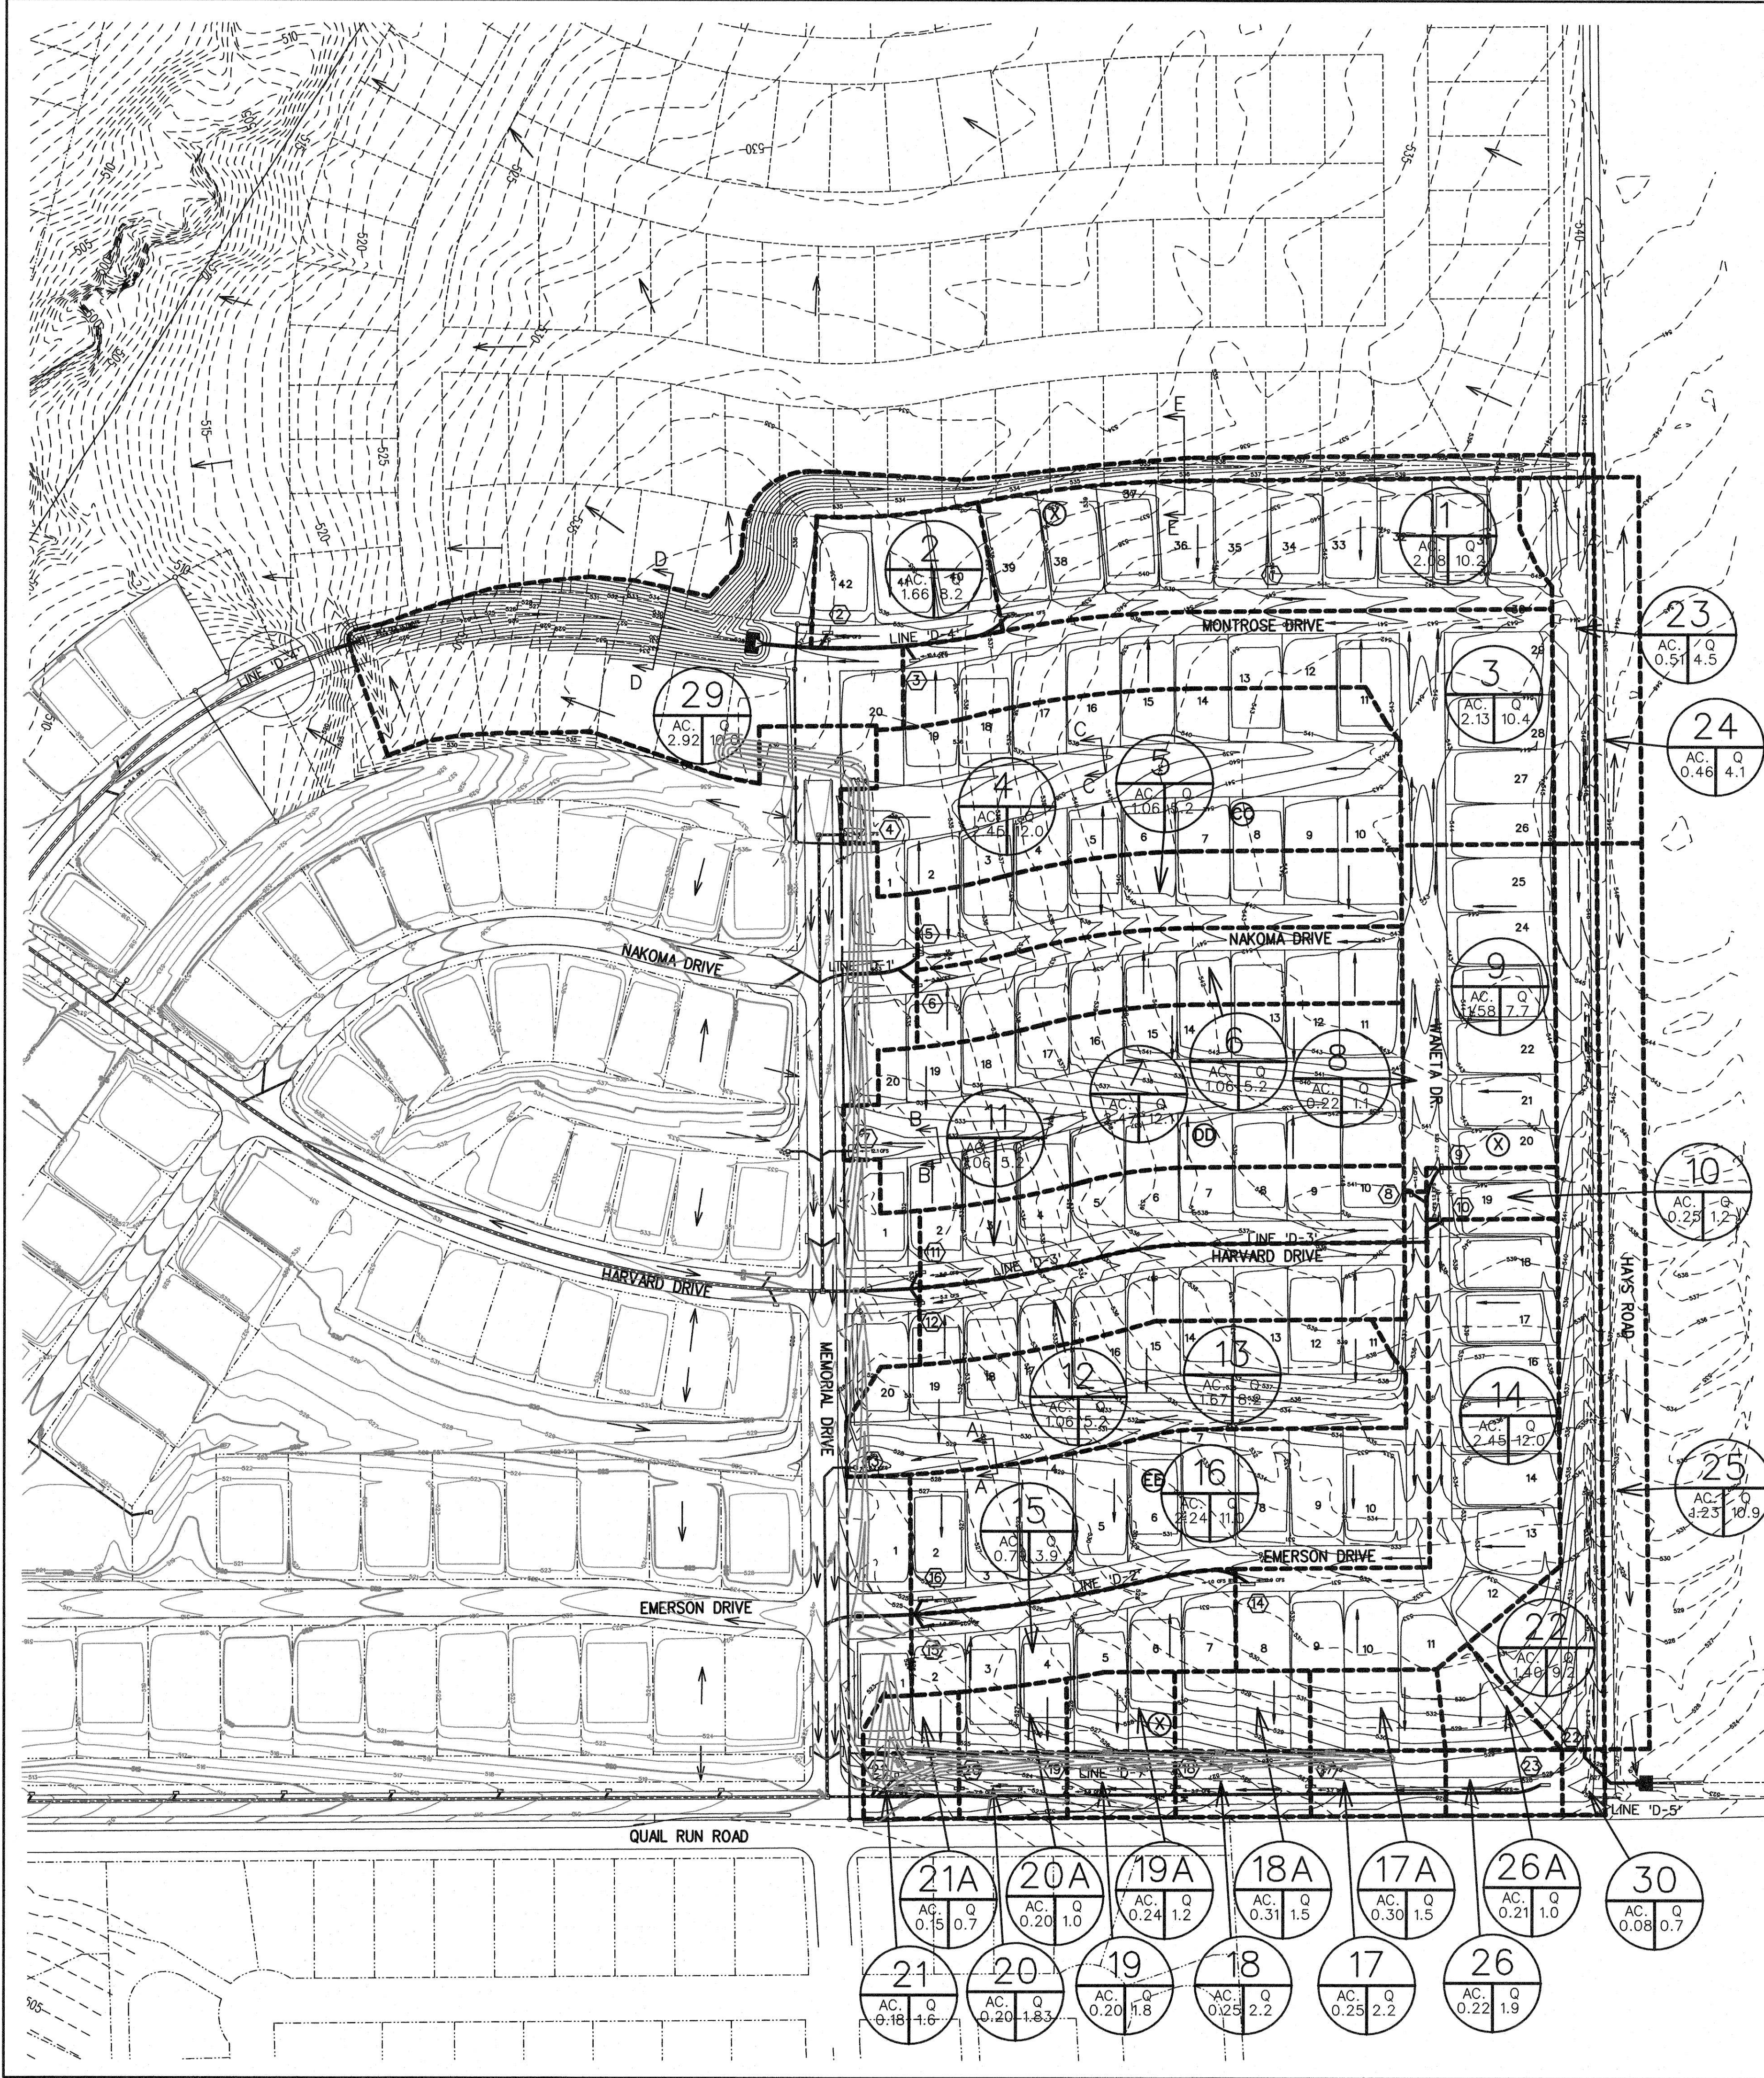


RUNOFF COMPUTATIONS


| # | Area (sf) | Area (acres) | Runoff Coefficient | CA | Tc (min) | I(100) (in/hr) | Q(100) (cfs) | Drains To: |
|-----|-----------|--------------|--------------------|------|----------|----------------|--------------|--------------------|
| 1 | 90489 | 2.06 | 0.50 | 1.04 | 10 | 9.80 | 10.2 | Inlet 1 |
| 2 | 28809 | 0.66 | 0.50 | 0.33 | 10 | 9.80 | 3.2 | Inlet 2 |
| 3 | 92832 | 2.13 | 0.50 | 1.07 | 10 | 9.80 | 10.4 | Inlet 3 |
| 4 | 106840 | 2.45 | 0.50 | 1.22 | 10 | 9.80 | 12.0 | Inlet 4 |
| 5 | 46032 | 1.06 | 0.50 | 0.53 | 10 | 9.80 | 5.2 | Inlet 5 |
| 6 | 46098 | 1.06 | 0.50 | 0.53 | 10 | 9.80 | 5.2 | Inlet 6 |
| 7 | 107750 | 2.47 | 0.50 | 1.24 | 10 | 9.80 | 12.1 | Inlet 7 |
| 8 | 9600 | 0.22 | 0.50 | 0.11 | 10 | 9.80 | 1.1 | Inlet 8 |
| 9 | 86736 | 1.98 | 0.50 | 0.79 | 10 | 9.80 | 7.7 | Inlet 9 |
| 10 | 10944 | 0.25 | 0.50 | 0.13 | 10 | 9.80 | 1.2 | Inlet 10 |
| 11 | 46114 | 1.06 | 0.50 | 0.53 | 10 | 9.80 | 5.2 | Inlet 11 |
| 12 | 45960 | 1.06 | 0.50 | 0.53 | 10 | 9.80 | 5.2 | Inlet 12 |
| 13 | 72824 | 1.67 | 0.50 | 0.84 | 10 | 9.80 | 8.2 | Inlet 13 |
| 14 | 106847 | 2.45 | 0.50 | 1.23 | 10 | 9.80 | 12.0 | Inlet 14 |
| 15 | 34510 | 0.79 | 0.50 | 0.40 | 10 | 9.80 | 3.9 | Inlet 15 |
| 16 | 97714 | 2.24 | 0.50 | 1.12 | 10 | 9.80 | 11.0 | Inlet 16 |
| 17 | 10875 | 0.25 | 0.90 | 0.22 | 10 | 9.80 | 2.2 | Inlet 17 |
| 17A | 13005 | 0.30 | 0.50 | 0.15 | 10 | 9.80 | 1.5 | Inlet 17 |
| 18 | 10875 | 0.25 | 0.90 | 0.22 | 10 | 9.80 | 2.2 | Inlet 18 |
| 18A | 13350 | 0.31 | 0.50 | 0.15 | 10 | 9.80 | 1.5 | Inlet 18 |
| 19 | 8700 | 0.20 | 0.90 | 0.18 | 10 | 9.80 | 1.8 | Inlet 19 |
| 19A | 10488 | 0.24 | 0.50 | 0.12 | 10 | 9.80 | 1.2 | Inlet 19 |
| 20 | 8700 | 0.20 | 0.90 | 0.18 | 10 | 9.80 | 1.8 | Inlet 20 |
| 20A | 8858 | 0.20 | 0.50 | 0.10 | 10 | 9.80 | 1.0 | Inlet 20 |
| 21 | 7691 | 0.18 | 0.90 | 0.16 | 10 | 9.80 | 1.6 | Inlet 21 |
| 21A | 6449 | 0.15 | 0.50 | 0.07 | 10 | 9.80 | 0.7 | Inlet 21 |
| 22 | 57721 | 1.33 | 0.84 | 0.84 | 10 | 9.80 | 8.3 | Inlet 22 |
| 23 | 22285 | 0.51 | 0.90 | 0.46 | 10 | 9.80 | 4.5 | Hays Road |
| 24 | 20250 | 0.46 | 0.90 | 0.42 | 10 | 9.80 | 4.1 | Hays Road |
| 25 | 53781 | 1.23 | 0.90 | 1.11 | 10 | 9.80 | 10.9 | Inlet 22 |
| 26 | 9378 | 0.22 | 0.90 | 0.19 | 10 | 9.80 | 1.9 | Inlet 23 |
| 26A | 9267 | 0.21 | 0.50 | 0.11 | 10 | 9.80 | 1.0 | Inlet 23 |
| 29 | 127324 | 2.92 | 0.35 | 1.02 | 10 | 9.80 | 10.0 | Interim to Line D4 |
| 30 | 3418 | 0.08 | 0.90 | 0.07 | 10 | 9.80 | 0.7 | Hays Road |

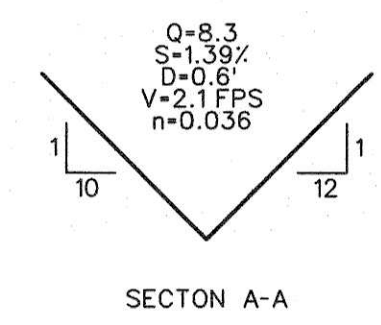


SECTION A-A

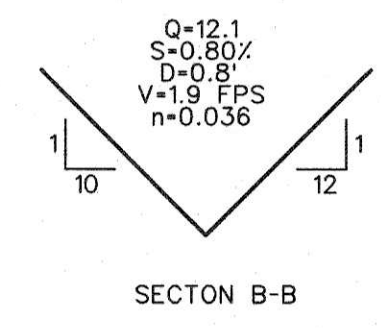


SECTION B-B

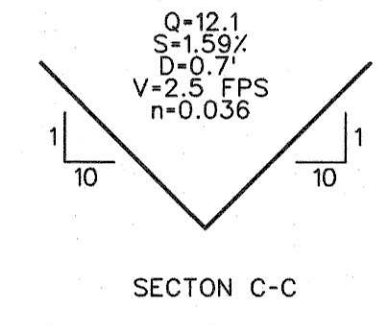

SECTION C-C

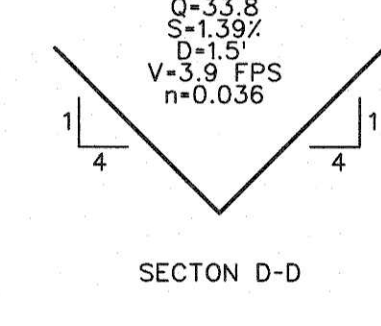

SECTION D-D

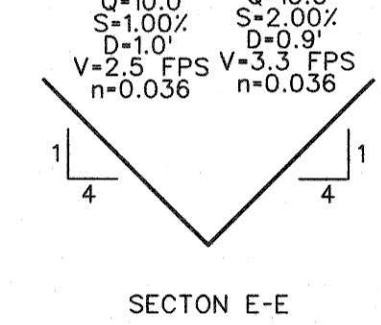

SECTION E-E

TYPICAL GRADE TO DRAIN SECTIONS
N.T.S.

LEGEND

- PROP. STORM SEWER
- PROP. CURB INLETS
- PROP. CONC. HEADWALL
- EXIST. STORM SEWER
- DRAINAGE AREA DIVIDE
- FLOW ARROW
- AC Q DRAINAGE AREA NO.

AS-BUILT SEPTEMBER 2018
INFORMATION PROVIDED
BY CONTRACTORS
(NOT FIELD VERIFIED)



CORWIN ENGINEERING, INC.
200 W. BELMONT, SUITE E
ALLEN, TEXAS 75013 (972)396-1200
TBP FIRM #5951


**DEVELOPMENT PLANS FOR
STONE CREEK
PHASE VIII
ROCKWALL, TEXAS**


INTERIM CONDITIONS DRAINAGE AREA MAP

| | | | |
|------------|--------------|------------|-----------|
| DRAWN BY | DESIGNED BY | CHECKED BY | SHEET NO. |
| JOB NUMBER | DATE | SCALE: | |
| 16044 | OCTOBER 2016 | 1"=100' | 17A of 32 |

STORM SEWER CALCULATIONS


| Upstream Station | Downstream Station | Distance (ft) | AREA NO. | Total Area (Acres) | Picked Up (Acres) | C | CA | Accumulated CA | Tc (Mn) | Design Storm (Years) | I (in/hr) | Q (CFS) | S (ft/ft) | Pipe Size (in) | Partial Flow? | Velocity (fps) | Flow Time (Mn) | Velocity Head (ft) | Junction Type | K | Time at D/S (Mn) | Minor Losses (ft) | Hydraulic Grade Upstream | Hydraulic Grade Downstream | |
|------------------|--------------------|---------------|----------|--------------------|-------------------|------|------|----------------|---------|----------------------|-----------|---------|-----------|----------------|---------------|----------------|----------------|--------------------|---------------|------|------------------|-------------------|--------------------------|----------------------------|--------|
| Line D1 | | | | | | | | | | | | | | | | | | | | | | | | | |
| 1+16.05 | 0+89.01 | 27.04 | 5 | 1.06 | 1.06 | 0.50 | 0.53 | 0.53 | 10.00 | 100 | 9.80 | 5.2 | 0.0024 | 18 | No | 2.9 | 0.15 | 0.13 | Inlet | 1.25 | 10.15 | 0.17 | | 532.36 | 532.19 |
| 0+89.01 | 0+36.65 | 52.36 | D1A | 1.06 | 1.06 | 0.50 | 0.53 | 1.06 | 10.15 | 100 | 9.78 | 10.3 | 0.0021 | 24 | No | 3.3 | 0.27 | 0.17 | 60" Vye | 0.35 | 10.42 | 0.12 | | 532.13 | 532.01 |
| 0+36.65 | 0+00.00 | 36.65 | | 0.00 | 0.00 | 0.50 | 0.00 | 1.06 | 10.42 | 100 | 9.74 | 10.3 | 0.0006 | 30 | No | 2.1 | 0.29 | 0.07 | 60" Vye | 0.35 | 10.71 | 0.01 | | 531.90 | 531.89 |
| 0+00.00 | | | | | | | | | | | | | | | | 5.8 | 0.00 | 0.52 | 60" Vye | 0.35 | 0.00 | 0.46 | | 531.86 | 531.40 |
| Lat D1A | | | | | | | | | | | | | | | | | | | | | | | | | |
| 0+26.63 | 0+00.00 | 26.63 | 6 | 1.06 | 1.06 | 0.50 | 0.53 | 0.53 | 10.00 | 100 | 9.80 | 5.2 | 0.0024 | 18 | No | 2.9 | 0.15 | 0.13 | Inlet | 1.25 | 10.15 | 0.17 | | 532.36 | 532.19 |
| 0+00.00 | | | | | | | | | | | | | | | | 3.3 | 0.00 | 0.17 | 60" Vye | 0.35 | 0.00 | 0.12 | | 532.13 | 532.01 |
| Line D2 | | | | | | | | | | | | | | | | | | | | | | | | | |
| 4+77.10 | 1+00.50 | 376.60 | 14 | 2.45 | 2.24 | 0.50 | 1.12 | 1.12 | 10.00 | 100 | 9.80 | 11.0 | 0.0110 | 18 | Yes | 8.4 | 0.75 | 1.10 | Inlet | 1.25 | 10.75 | 1.37 | | 528.70 | 527.33 |
| 1+00.50 | 0+36.52 | 63.98 | D2A, D2B | 3.04 | 3.24 | 0.50 | 1.62 | 2.74 | 10.75 | 100 | 9.69 | 26.6 | 0.0138 | 24 | No | 8.5 | 0.13 | 1.11 | 60" Vye | 0.35 | 10.87 | 0.73 | | 523.20 | 522.47 |
| 0+36.52 | 0+00.00 | 36.52 | | 0.00 | 0.00 | 0.50 | 0.00 | 2.74 | 10.87 | 100 | 9.67 | 26.5 | 0.0042 | 30 | No | 5.4 | 0.11 | 0.45 | 60" Vye | 0.35 | 10.99 | 0.06 | | 521.58 | 521.52 |
| 0+00.00 | | | | | | | | | | | | | | | | 7.2 | 0.00 | 0.80 | 60" Vye | 0.35 | 0.00 | 0.65 | | 521.37 | 520.72 |
| Lat D2A | | | | | | | | | | | | | | | | | | | | | | | | | |
| 0+17.93 | 0+00.00 | 17.93 | 16 | 2.24 | 2.24 | 0.50 | 1.12 | 1.12 | 10.00 | 100 | 9.80 | 11.0 | 0.0110 | 18 | No | 6.2 | 0.05 | 0.60 | Inlet | 1.25 | 10.05 | 0.75 | | 524.32 | 523.57 |
| 0+00.00 | | | | | | | | | | | | | | | | 8.5 | 0.00 | 1.11 | 60" Vye | 0.35 | 0.00 | 0.90 | | 523.37 | 522.47 |
| Lat D2B | | | | | | | | | | | | | | | | | | | | | | | | | |
| 0+17.97 | 0+00.00 | 17.97 | 15 | 0.79 | 1.00 | 0.50 | 0.50 | 0.50 | 10.00 | 100 | 9.80 | 4.9 | 0.0022 | 18 | No | 2.8 | 0.11 | 0.12 | Inlet | 1.25 | 10.11 | 0.15 | | 523.73 | 523.58 |
| 0+00.00 | | | | | | | | | | | | | | | | 8.5 | 0.00 | 1.11 | 60" Vye | 0.35 | 0.00 | 1.07 | | 523.54 | 522.47 |
| Line D3 | | | | | | | | | | | | | | | | | | | | | | | | | |
| 18+48.33 | 18+08.98 | 39.35 | 9 | 1.58 | 1.33 | 0.50 | 0.66 | 0.66 | 10.00 | 100 | 9.80 | 6.5 | 0.0038 | 18 | Yes | 10.5 | 0.06 | 1.71 | Inlet | 1.25 | 10.06 | 2.14 | | 534.87 | 532.73 |
| 18+08.98 | 18+05.98 | 3.00 | PVI | 0.00 | 0.00 | 0.50 | 0.00 | 0.66 | 10.06 | 100 | 9.79 | 6.5 | 0.0038 | 18 | Yes | 6.3 | 0.01 | 0.62 | PVI | 1.00 | 10.07 | 0.00 | | 532.59 | 532.59 |
| 18+05.98 | 17+75.68 | 30.30 | D3I | 0.22 | 0.22 | 0.50 | 0.11 | 0.77 | 10.07 | 100 | 9.79 | 7.6 | 0.0052 | 18 | Yes | 6.5 | 0.08 | 0.66 | 60" Vye | 0.35 | 10.15 | 0.44 | | 532.58 | 532.14 |
| 17+75.68 | 17+62.63 | 13.05 | D3H | 0.25 | 0.50 | 0.50 | 0.25 | 1.02 | 10.15 | 100 | 9.78 | 10.0 | 0.0091 | 18 | Yes | 6.8 | 0.03 | 0.72 | 60" Vye | 0.35 | 10.18 | 0.49 | | 531.98 | 531.50 |
| 17+62.63 | 14+00.00 | 362.63 | NH | 0.00 | 0.00 | 0.50 | 0.00 | 1.02 | 10.18 | 100 | 9.77 | 10.0 | 0.0091 | 18 | Yes | 6.8 | 0.89 | 0.72 | NH | 0.55 | 11.07 | 0.39 | | 531.38 | 530.98 |
| 14+00.00 | 11+85.01 | 214.99 | PVI | 0.00 | 0.00 | 0.50 | 0.00 | 1.02 | 11.07 | 100 | 9.64 | 9.9 | 0.0088 | 18 | Yes | 10.3 | 0.35 | 1.65 | PVI | 1.00 | 11.42 | 0.93 | | 529.98 | 529.05 |
| 11+85.01 | 11+22.57 | 62.44 | D3F, D3G | 2.11 | 2.11 | 0.50 | 1.06 | 2.08 | 11.42 | 100 | 9.59 | 20.0 | 0.0078 | 24 | No | 6.4 | 0.16 | 0.63 | 60" Vye | 0.35 | 11.58 | 0.05 | | 527.69 | 527.64 |
| 11+22.57 | | | | | | | | | | | | | | | | 4.1 | | 0.26 | | 1.00 | | 0.00 | | 527.15 | 527.15 |
| Lat D3F | | | | | | | | | | | | | | | | | | | | | | | | | |
| 0+17.94 | 0+00.00 | 17.94 | 11 | 1.06 | 1.06 | 0.50 | 0.53 | 0.53 | 10.00 | 100 | 9.80 | 5.2 | 0.0024 | 18 | | 2.9 | 0.10 | 0.13 | Inlet | 1.25 | 10.10 | 0.17 | | 528.43 | 528.26 |
| 0+00.00 | | | | | | | | | | | | | | | | 6.4 | 0.00 | 0.63 | 60" Vye | 0.35 | 0.00 | 0.58 | | 528.22 | 527.64 |
| Lat D3G | | | | | | | | | | | | | | | | | | | | | | | | | |
| 0+17.86 | 0+00.00 | 17.86 | 12 | 1.06 | 1.06 | 0.50 | 0.53 | 0.53 | 10.00 | 100 | 9.80 | 5.2 | 0.0024 | 18 | | 2.9 | 0.10 | 0.13 | Inlet | 1.25 | 10.10 | 0.17 | | 528.43 | 528.26 |
| 0+00.00 | | | | | | | | | | | | | | | | 6.4 | 0.00 | 0.63 | 60" Vye | 0.35 | 0.00 | 0.58 | | 528.22 | 527.64 |
| Lat D3H | | | | | | | | | | | | | | | | | | | | | | | | | |
| 0+17.90 | 0+00.00 | 17.90 | 10 | 0.25 | 0.50 | 0.50 | 0.25 | 0.25 | 10.00 | 100 | 9.80 | 2.5 | 0.0005 | 18 | | 1.4 | 0.21 | 0.03 | Inlet | 1.25 | 10.21 | 0.04 | | 532.25 | 532.21 |
| 0+00.00 | | | | | | | | | | | | | | | | 6.8 | 0.00 | 0.72 | 60" Vye | 0.35 | 0.00 | 0.71 | | 532.20 | 531.50 |
| Lat D3I | | | | | | | | | | | | | | | | | | | | | | | | | |
| 0+18.11 | 0+00.00 | 18.11 | 8 | 0.22 | 0.22 | 0.50 | 0.11 | 0.11 | 10.00 | 100 | 9.80 | 1.1 | 0.0001 | 18 | | 0.6 | 0.51 | 0.01 | Inlet | 1.25 | 10.51 | 0.01 | | 532.81 | 532.80 |
| 0+00.00 | | | | | | | | | | | | | | | | 6.5 | 0.00 | 0.66 | 60" Vye | 0.35 | 0.00 | 0.65 | | 532.80 | 532.14 |
| Line D4 | | | | | | | | | | | | | | | | | | | | | | | | | |
| 12+54.72 | 11+33.74 | 120.98 | 1 | 2.08 | 2.08 | 0.50 | 1.04 | 1.04 | 10.00 | 100 | 9.80 | 10.2 | 0.0094 | 18 | Yes | 8.0 | 0.25 | 0.99 | Inlet | 1.25 | 10.25 | 1.24 | | 534.38 | 533.14 |
| 11+33.74 | 10+37.85 | 95.89 | D4F | 2.13 | 2.13 | 0.50 | 1.07 | 2.10 | 10.25 | 100 | 9.76 | 20.5 | 0.0044 | 27 | No | 5.2 | 0.31 | 0.41 | 60" Vye | 0.35 | 10.56 | 0.07 | | 532.00 | 531.93 |
| 10+37.85 | 9+75.00 | 62.85 | D4E | 0.66 | 0.66 | 0.50 | 0.33 | 2.43 | 10.56 | 100 | 9.72 | 23.6 | 0.0058 | 27 | Yes | 7.4 | 0.14 | 0.85 | 60" Vye | 0.35 | 10.70 | 0.71 | | 531.51 | 530.81 |
| 9+75.00 | | | | | | | | | | | | | | | | | | | | | | | | 530.44 | |
| Line D5 | | | | | | | | | | | | | | | | | | | | | | | | | |
| 5+25.00 | 4+95.00 | 30.00 | D4, D5 | 7.79 | 7.79 | 0.50 | 3.89 | 3.89 | 10.56 | 100 | 9.72 | 37.8 | 0.0280 | 24 | Yes | 12.4 | 0.04 | 2.39 | | 1.25 | 10.60 | 2.98 | | 517.79 | 514.81 |
| 4+95.00 | | | | | | | | | | | | | | | | | | | | | | | | 513.97 | |
| Lat D4E | | | | | | | | | | | | | | | | | | | | | | | | | |
| 0+17.96 | 0+00.00 | 17.96 | 2 | 0.66 | 0.66 | 0.50 | 0.33 | 0.33 | 10.00 | 100 | 9.80 | 3.2 | 0.0009 | 18 | | 1.8 | 0.16 | 0.05 | Inlet | 1.25 | 10.16 | 0.06 | | 531.72 | 531.66 |
| 0+00.00 | | | | | | | | | | | | | | | | 7.4 | 0.00 | 0.85 | 60" Vye | 0.35 | 0.00 | 0.83 | | 531.64 | 530.81 |
| Lat D4F | | | | | | | | | | | | | | | | | | | | | | | | | |
| 0+17.84 | 0+00.00 | 17.84 | 3 | 2.13 | 2.13 | 0.50 | 1.07 | 1.07 | 10.00 | 100 | 9.80 | 10.4 | 0.0099 | 18 | | 5.9 | 0.05 | 0.54 | Inlet | 1.25 | 10.05 | 0.68 | | 533.01 | 532.33 |
| 0+00.00 | | | | | | | | | | | | | | | | 5.2 | 0.00 | 0.41 | 60" Vye | 0.35 | 0.00 | 0.22 | | 532.16 | 531.93 |
| Line D7 | | | | | | | | | | | | | | | | | | | | | | | | | |
| 20+19.32 | 17+59.00 | 260.32 | 26, 26A | 0.43 | 0.43 | 0.70 | 0.30 | 0.30 | 10.00 | 100 | 9.80 | 2.9 | 0.0008 | 18 | Yes | 4.7 | 0.92 | 0.34 | Inlet | 1.25 | 10.92 | 0.43 | | 523.92 | 523.49 |
| 17+59.00 | 17+00.00 | 59.00 | D7N | 0.55 | 0.55 | 0.68 | 0.37 | 0.67 | 10.92 | 100 | 9.66 | 6.5 | 0.0038 | 18 | Yes | 5.7 | 0.17 | 0.50 | 60" Vye | 0.35 | 11.10 | 0.38 | | 523.29 | 522.91 |
| 17+00.00 | 16+09.00 | 91.00 | PVI | 0.00 | 0.00 | 0.50 | 0.00 | 0.67 | 11.10 | 100 | 9.64 | 6.5 | 0.0038 | 18 | Yes | 7.5 | 0.20 | 0.87 | PVI | 1.00 | 11.30 | 0.37 | | 522.68 | 522.31 |
| 16+09.00 | 14+89.00 | 120.00 | D7M | 0.56 | 0.56 | 0.68 | 0.38 | 1.05 | 11.30 | 100 | 9.61 | 10.1 | 0.0093 | 18 | No | 5.7 | 0.35 | 0.51 | 60" Vye | 0.35 | 11.65 | 0.00 | | 521.96 | 521.96 |
| 14+89.00 | 13+49.00 | 120.00 | D7L | 0.44 | 0.44 | 0.68 | 0.30 | 1.35 | 11.65 | 100 | 9.55 | 12.9 | 0.0151 | 18 | No | 7.3 | 0.27 | 0.83 | 60" Vye | 0.35 | 11.92 | 0.65 | | 520.85 | 520.20 |
| 13+49.00 | 12+75.85 | 93.15 | D7K | 0.40 | 0.40 | 0.70 | 0.38 | 1.63 | 11.92 | 100 | 9.51 | 15.5 | 0.0047 | 24 | No | 4.9 | 0.31 | 0.38 | 60" Vye | 0.35 | 12.24 | 0.09 | | 518.38 | 518.30 |
| 12+75.85 | 12+26.48 | 49.37 | D7J | 0.32 | 0.32 | 0.72 | 0.23 | 1.87 | 12.24 | 100 | 9.46 | 17.7 | 0.0061 | 24 | No | 5.6 | 0.35 | 0.49 | 60" Vye | 0.35 | 12.58 | 0.17 | | 517.86 | 517.50 |
| 12+26.48 | 11+05.00 | 121.48 | D9 | 9.51 | 9.51 | 5.00 | 4.76 | 6.62 | 12.38 | 100 | 9.44 | 52.5 | 0.0057 | 39 | No | 7.5 | 0.27 | 0.80 | NH | 1.00 | 12.65 | 0.88 | | 517.20 | 516.31 |
| 11+05.00 | 9+80.00 | 125.00 | D7A | 0.37 | 0.37 | 0.79 | 0.29 | 6.91 | 12.65 | 100 | 9.40 | 65.0 | 0.0062 | 39 | No | 7.8 | 0.27 | 0.95 | 60" Vye | 0.60 | 12.92 | 0.42 | | 515.62 | 515.19 |
| 9+80.00 | 8+60.00 | 120.00 | D7B | 0.41 | 0.37 | 0.70 | 0.26 | 7.17 | 12.92 | 100 | 9.36 | 67.1 | 0.0066 | 39 | No | 8.1 | 0.25 | 1.02 | 60" Vye | 0.60 | 13.10 | 0.44 | | 514.42 | 514.07 |
| 8+60.00 | 7+40.00 | 120.00 | D7C | 0.40 | 0.40 | 0.70 | 0.38 | 7.45 | 13.16 | 100 | 9.33 | 69.5 | 0.0071 | 39 | No | 8.4 | 0.24 | 1.09 | 60" Vye | 0.60 | 13.40 | 0.48 | | 513.19 | 512.70 |
| 7+40.00 | 6+20.00 | 120.00 | D7D | 0.40 | 0.40 | 0.70 | 0.28 | 7.73 | 13.40 | 100 | 9.29 | 71.8 | 0.0051 | 42 | No | 7.5 | 0.27 | 0.86 | 60" Vye | 0.60 | 13.67 | 0.10 | | 511.95 | 511.75 |
| 6+20.00 | 5+00.00 | 120.00 | D7E | 0.40 | 0.40 | 0.70 | 0.28 | 8.01 | 13.67 | 100 | 9.25 | 74.1 | 0.0054 | 42 | No | 7.7 | 0.26 | 0.92 | 60" Vye | 0.60 | 13.93 | 0.40 | | 511.14 | 510.74 |
| 5+00.00 | 3+40.00 | 160.00 | D7F | 0.40 | 0.40 | 0.70 | 0.28 | 8.29 | 13.93 | 100 | 9.21 | 76.3 | 0.0058 | 42 | No | 7.9 | 0.34 | 0.98 | 60" Vye | 0.60 | 14.27 | 0.43 | | 510.09 | 509.66 |
| 3+40.00 | 2+35.00 | 105.00 | D7G | 0.53 | 0.53 | 0.70 | 0.37 | 8.66 | 14.27 | 100 | 9.16 | 79.3 | 0.0062 | 42 | No | 8.2 | 0.21 | 1.06 | 60" Vye | 0.60 | 1 | | | | |

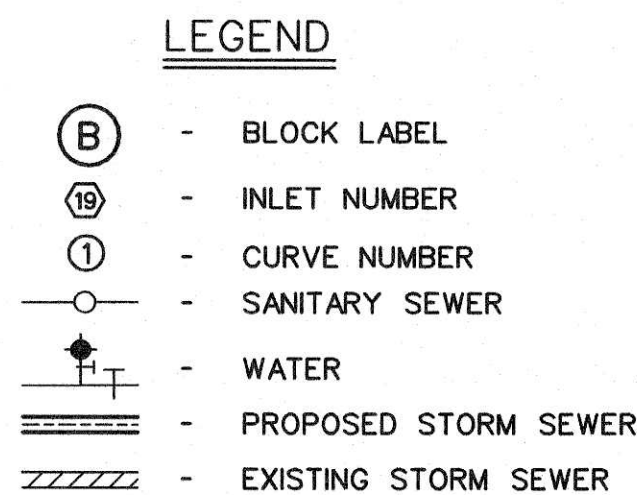

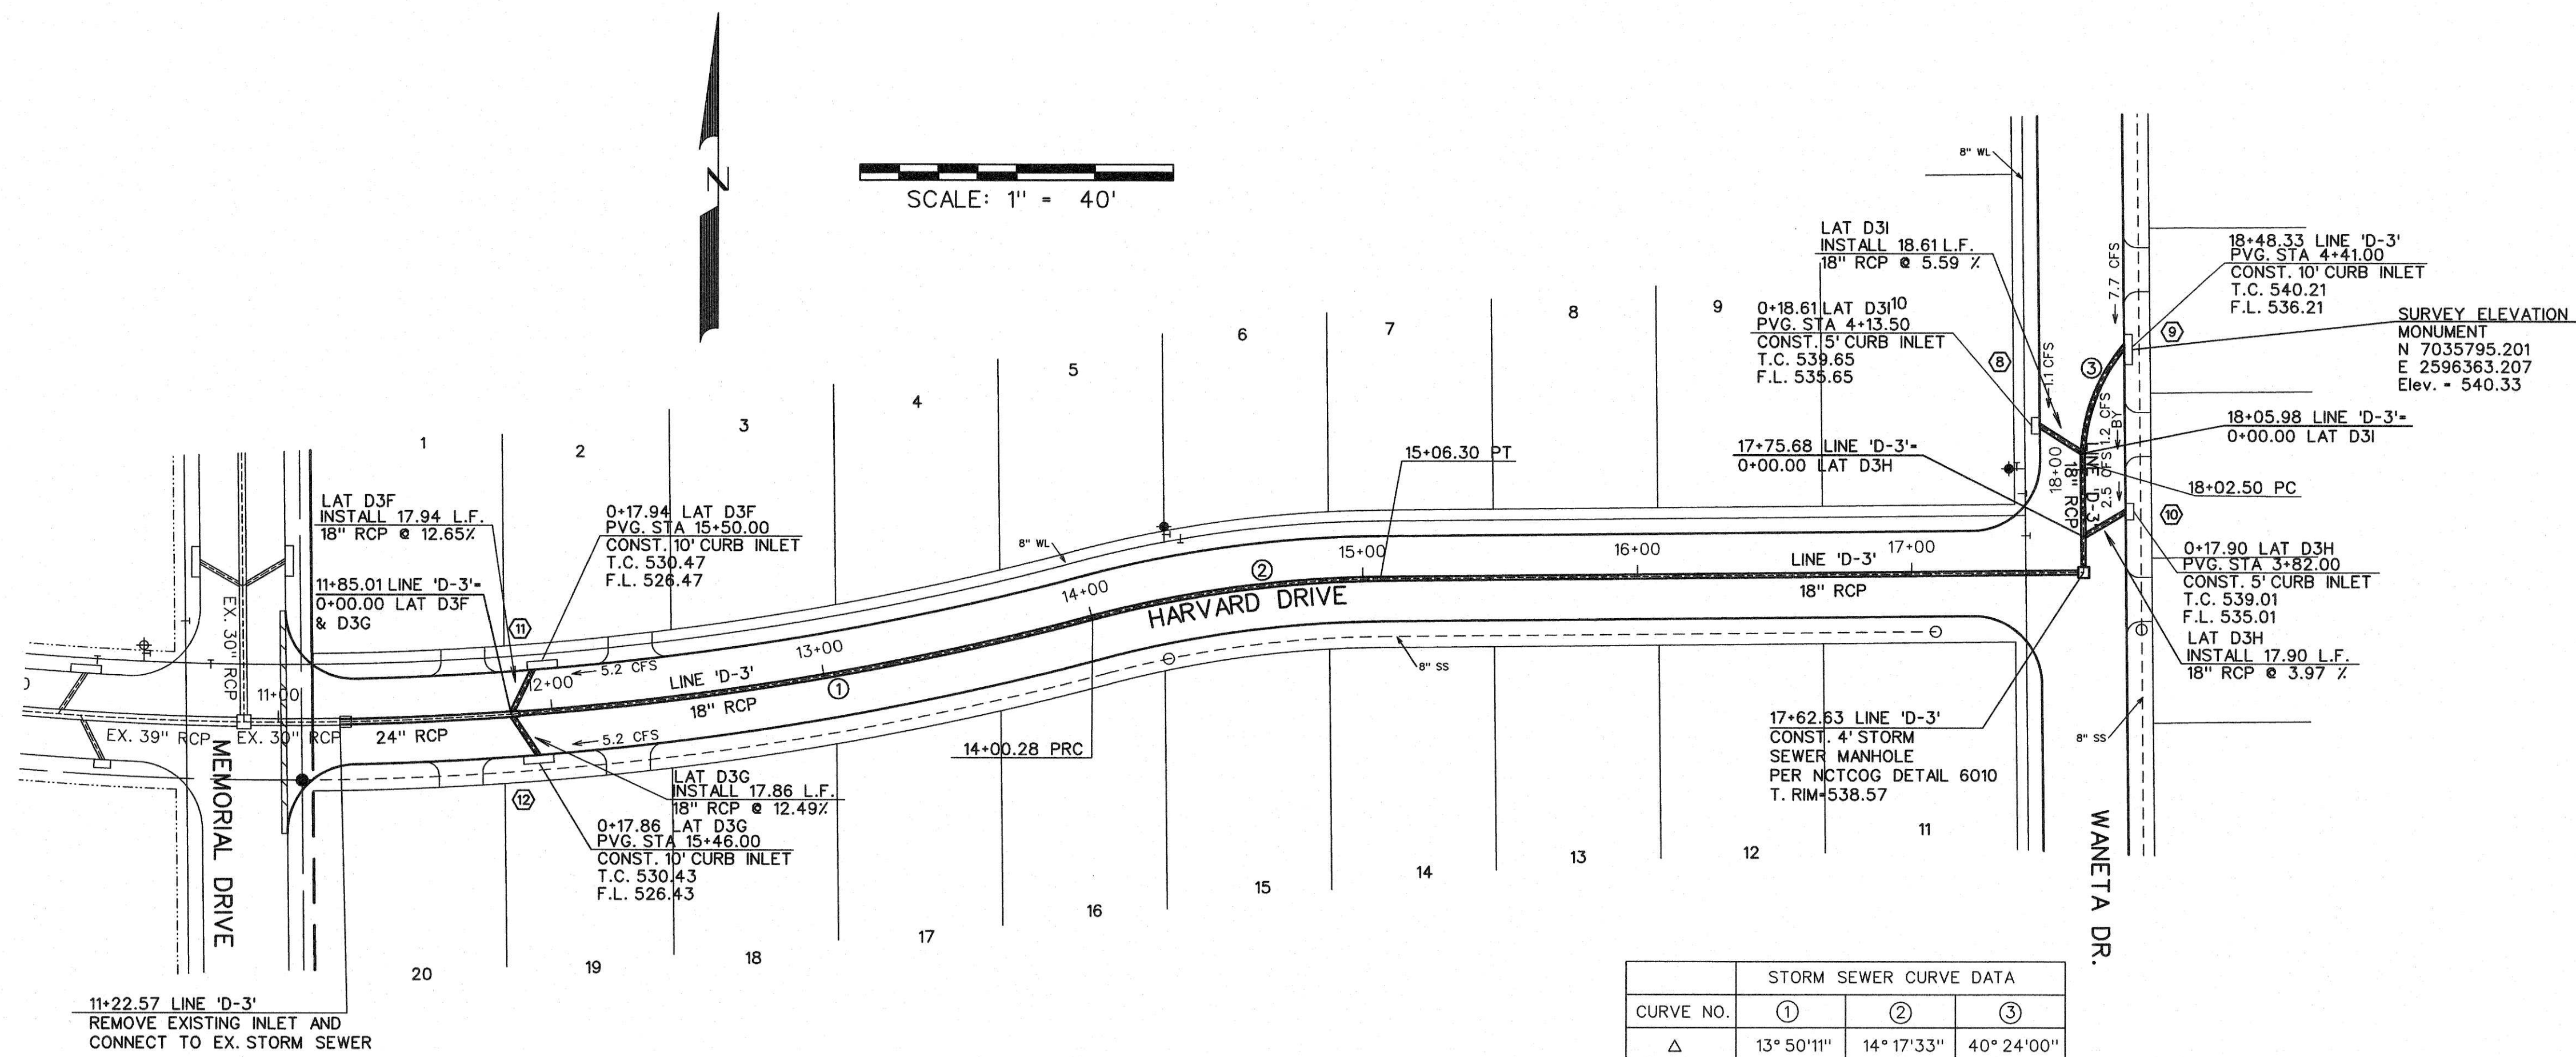

| STORM SEWER CURVE DATA | | | |
|------------------------|-------------|-------------|-------------|
| CURVE NO. | ① | ② | ③ |
| Δ | 13° 50' 11" | 14° 17' 33" | 40° 24' 00" |
| R | 1150.00' | 425.00' | 65.00' |
| T | 139.54' | 53.28' | 23.92' |
| L | 277.71' | 106.02' | 45.83' |

- LEGEND**
- ⓑ - BLOCK LABEL
 - ⑩ - INLET NUMBER
 - ① - CURVE NUMBER
 - - SANITARY SEWER
 - ⦿ - WATER
 - - PROPOSED STORM SEWER
 - - EXISTING STORM SEWER

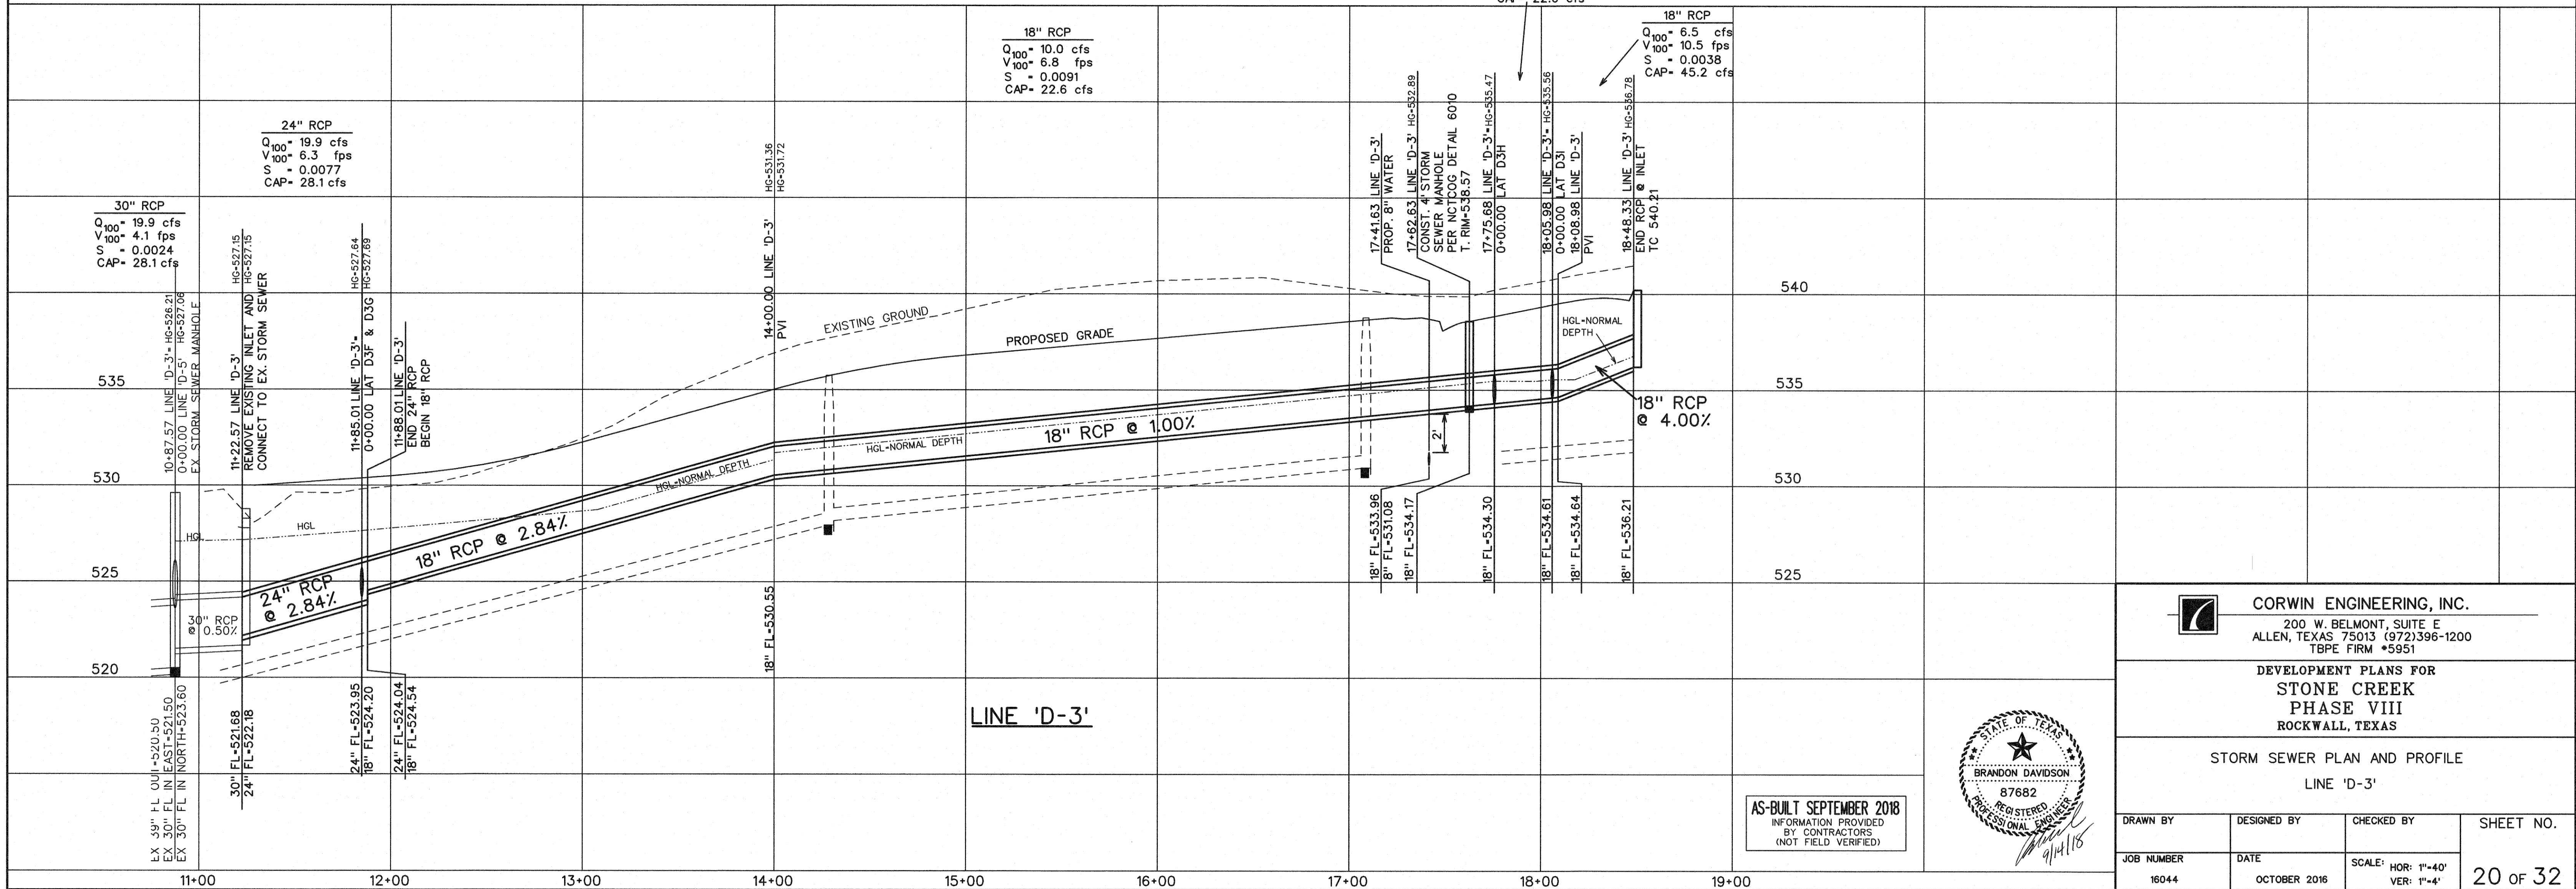

CORWIN ENGINEERING, INC.
 200 W. BELMONT, SUITE E
 ALLEN, TEXAS 75013 (972)396-1200
 TBPE FIRM #5951


DEVELOPMENT PLANS FOR
STONE CREEK
 PHASE VIII
 ROCKWALL, TEXAS

STORM SEWER PLAN AND PROFILE
 LINE 'D-3'




AS-BUILT SEPTEMBER 2018
 INFORMATION PROVIDED
 BY CONTRACTORS
 (NOT FIELD VERIFIED)


| | | | |
|------------|--------------|----------------------------------|-----------|
| DRAWN BY | DESIGNED BY | CHECKED BY | SHEET NO. |
| JOB NUMBER | DATE | SCALE: HOR: 1"=40' VER: 1"=4' | 20 OF 32 |
| 16044 | OCTOBER 2016 | | |

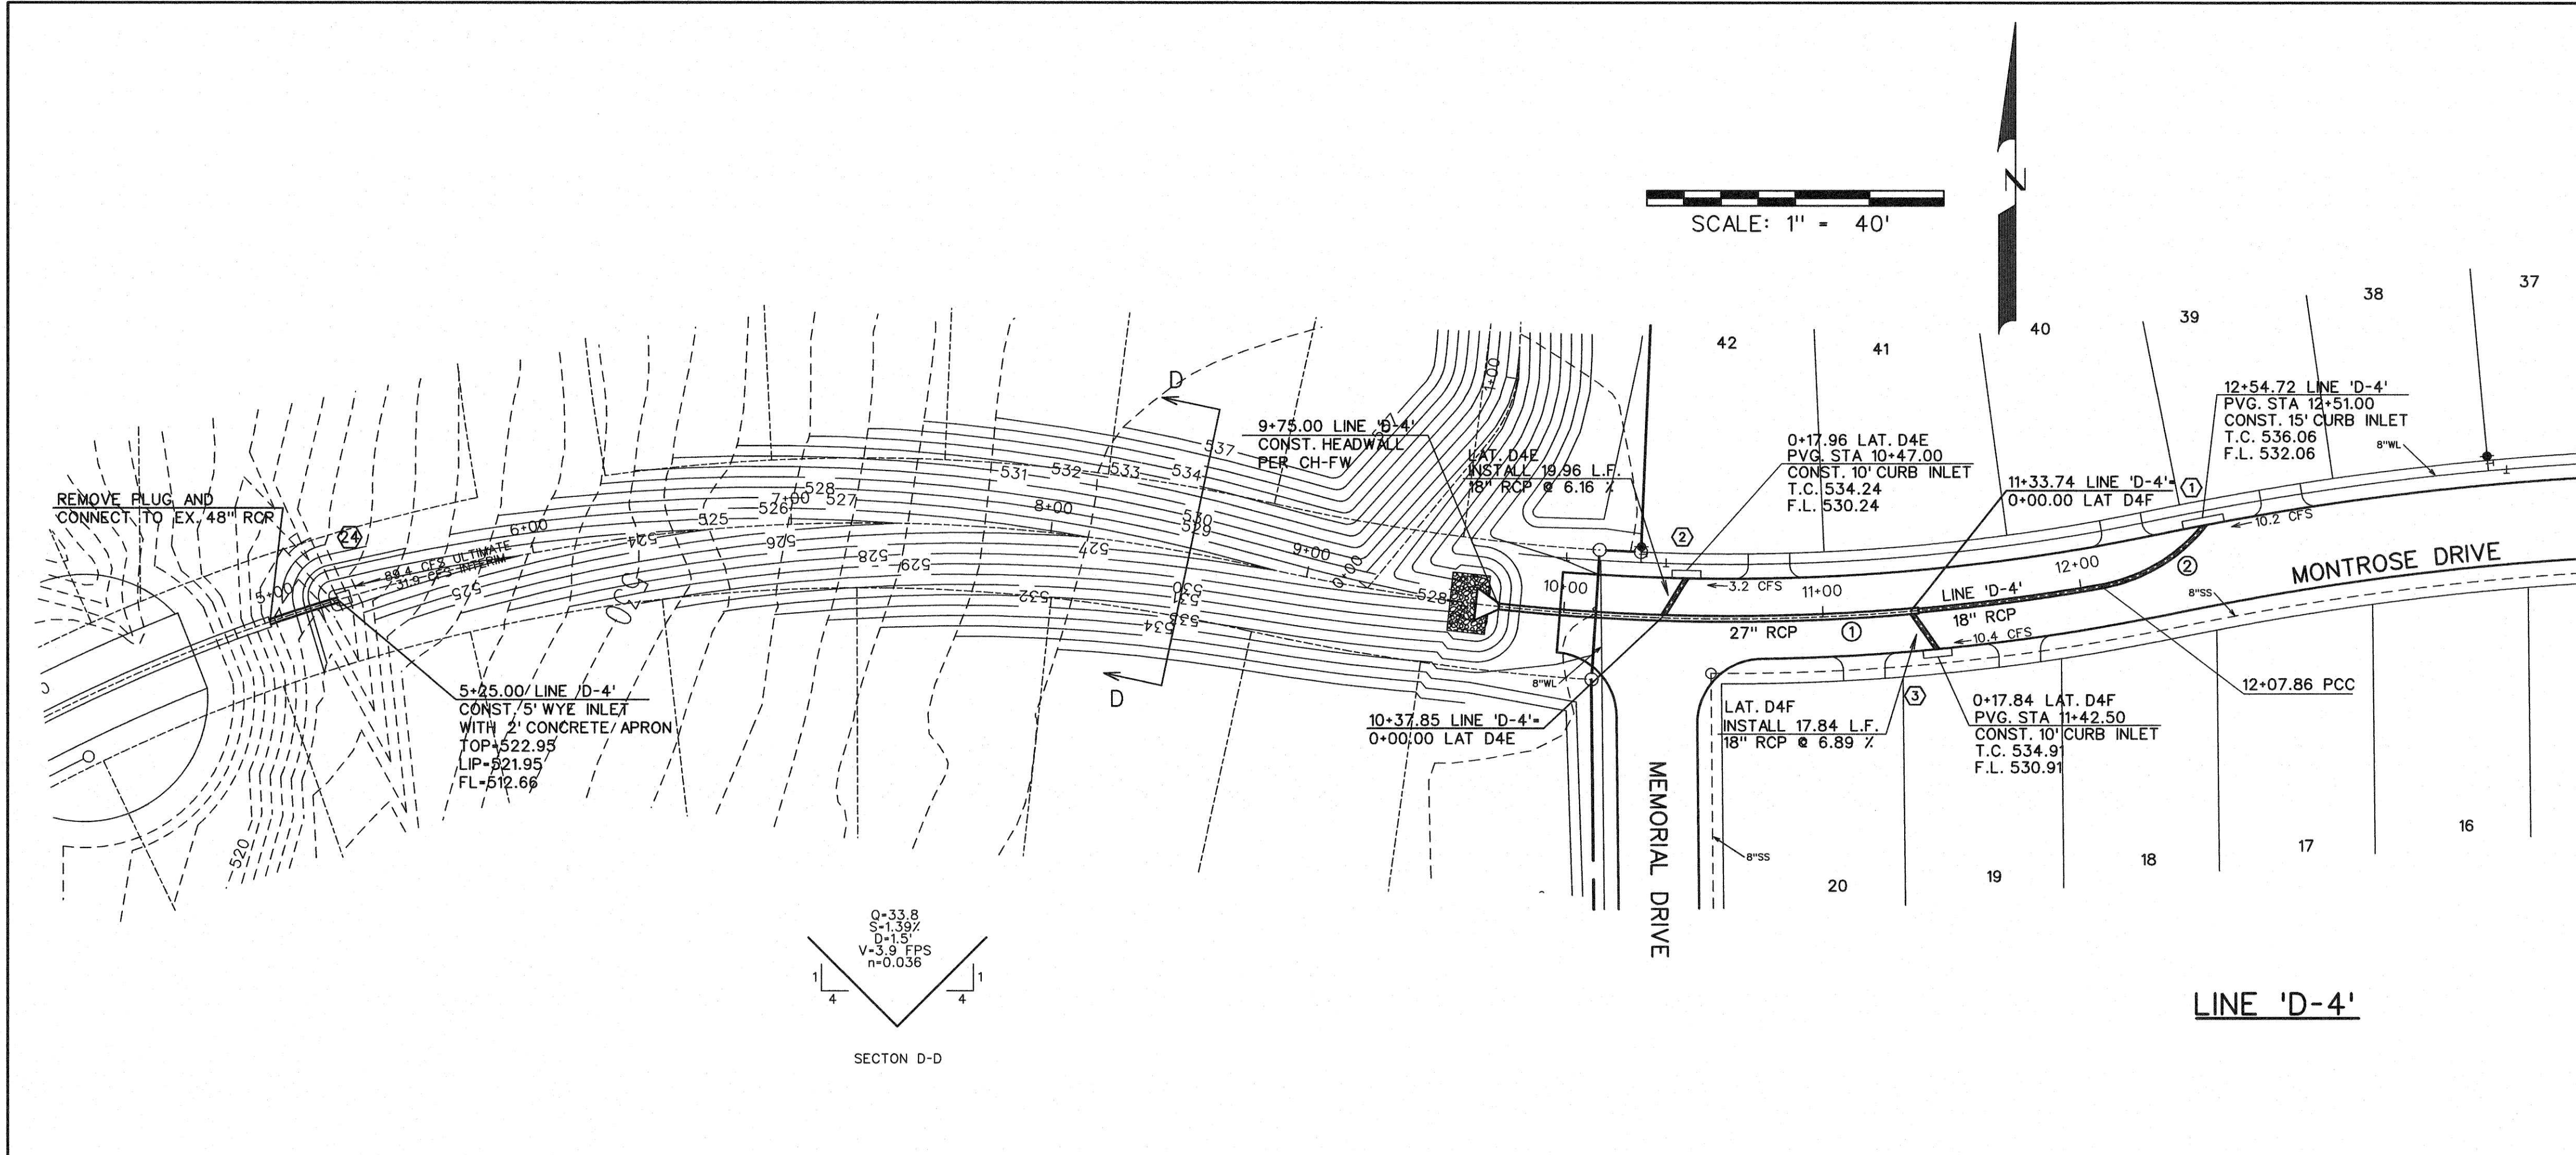

| STORM SEWER CURVE DATA | | |
|------------------------|-------------|-------------|
| CURVE NO. | ① | ② |
| Δ | 16° 10' 20" | 41° 18' 12" |
| R | 825.00' | 65.00' |
| T | 117.21' | 24.50' |
| L | 232.86' | 46.86' |

- LEGEND**
- (B) - BLOCK LABEL
 - (19) - INLET NUMBER
 - ① - CURVE NUMBER
 - - SANITARY SEWER
 - ⊕ - WATER
 - ==== - PROPOSED STORM SEWER
 - - EXISTING STORM SEWER

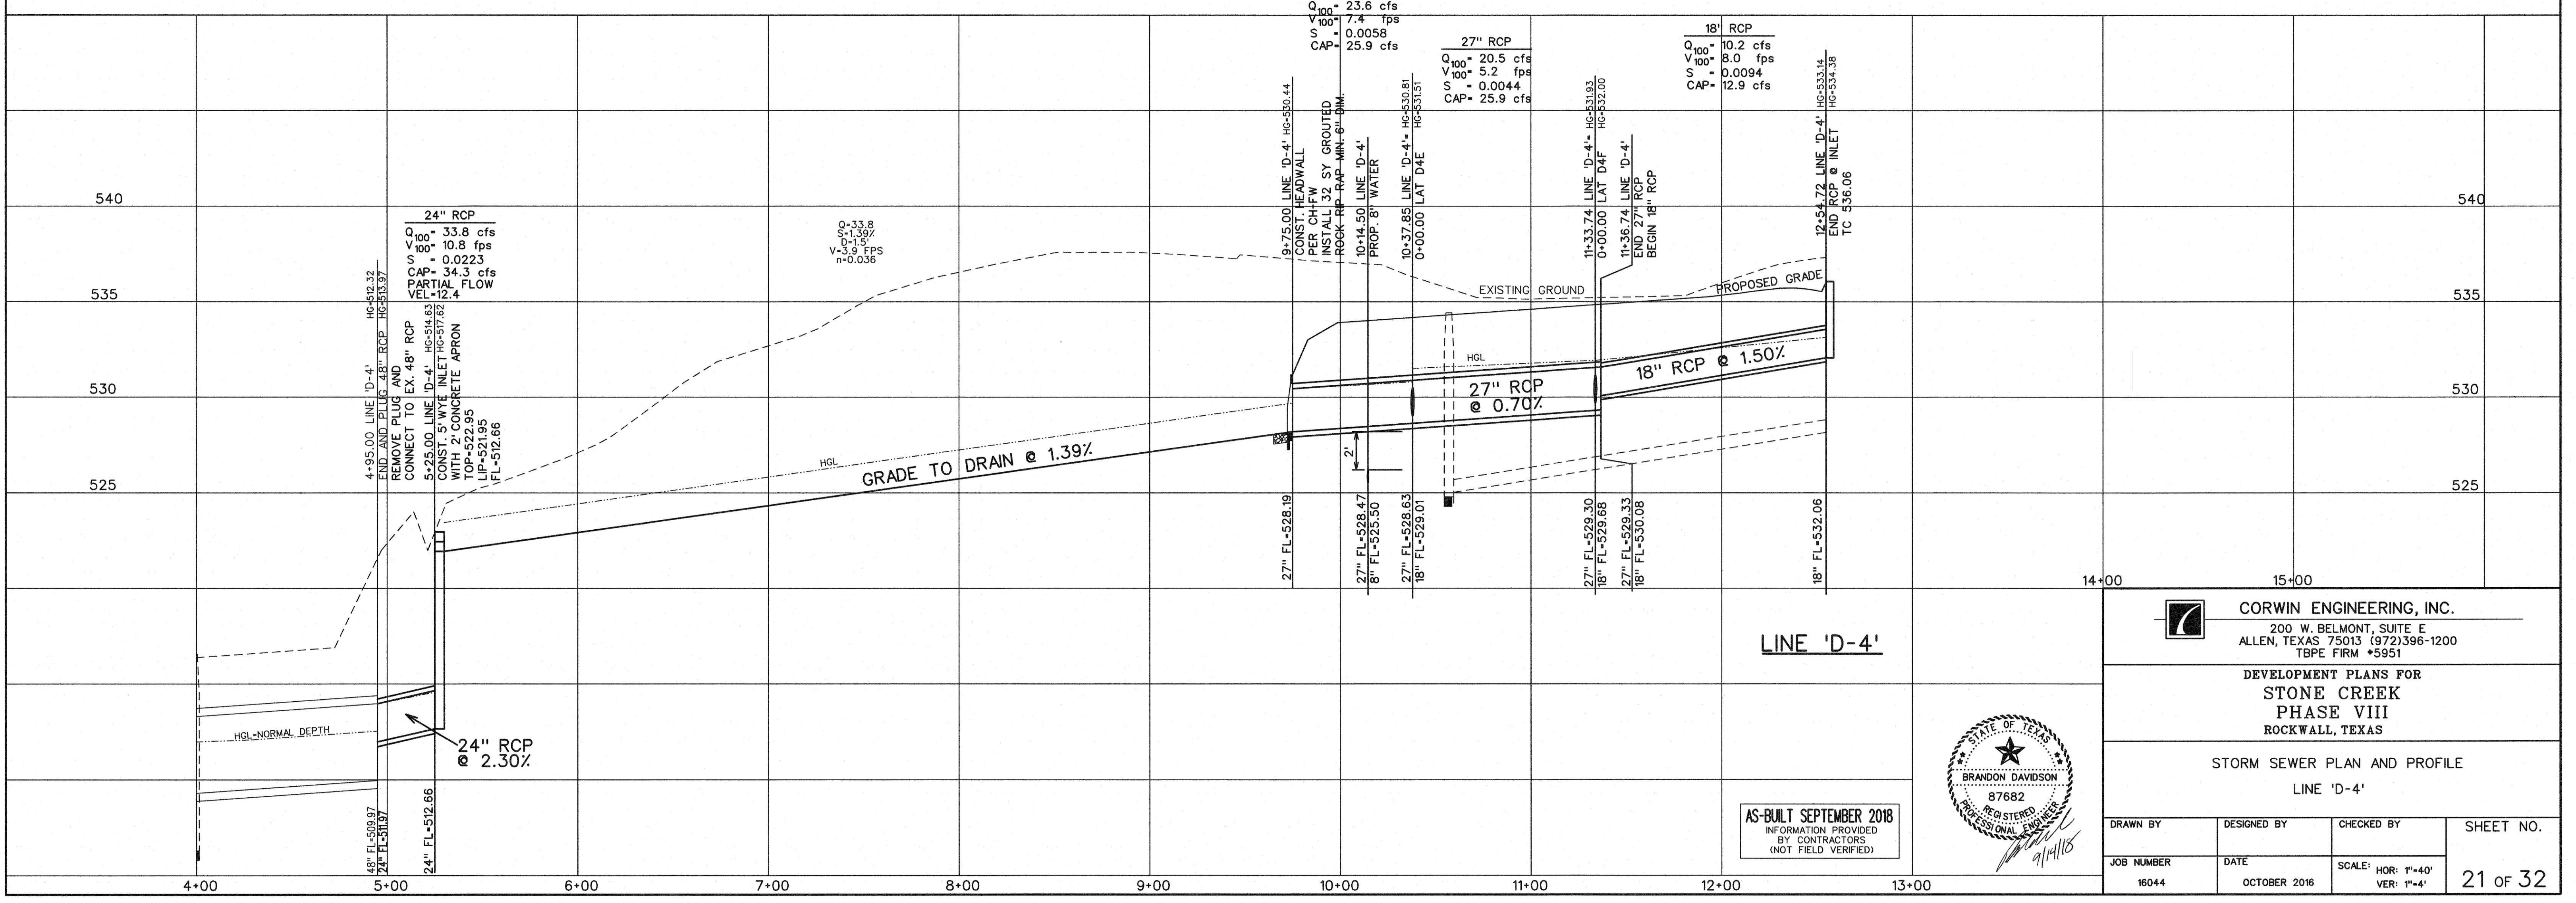

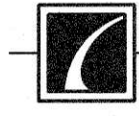**CORWIN ENGINEERING, INC.**
200 W. BELMONT, SUITE E
ALLEN, TEXAS 75013 (972)396-1200
TBPE FIRM #5951



DEVELOPMENT PLANS FOR
**STONE CREEK
PHASE VIII**
ROCKWALL, TEXAS

STORM SEWER PLAN AND PROFILE
LINE 'D-4'

| | | | |
|------------|--------------|----------------------------------|-----------|
| DRAWN BY | DESIGNED BY | CHECKED BY | SHEET NO. |
| JOB NUMBER | DATE | SCALE: HOR: 1"=40' VER: 1"=4' | 21 OF 32 |
| 16044 | OCTOBER 2016 | | |




AS-BUILT SEPTEMBER 2018
INFORMATION PROVIDED
BY CONTRACTORS
(NOT FIELD VERIFIED)

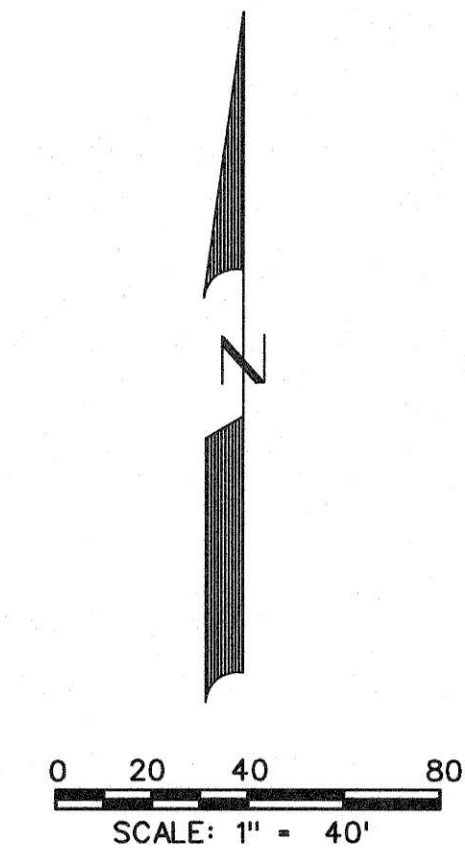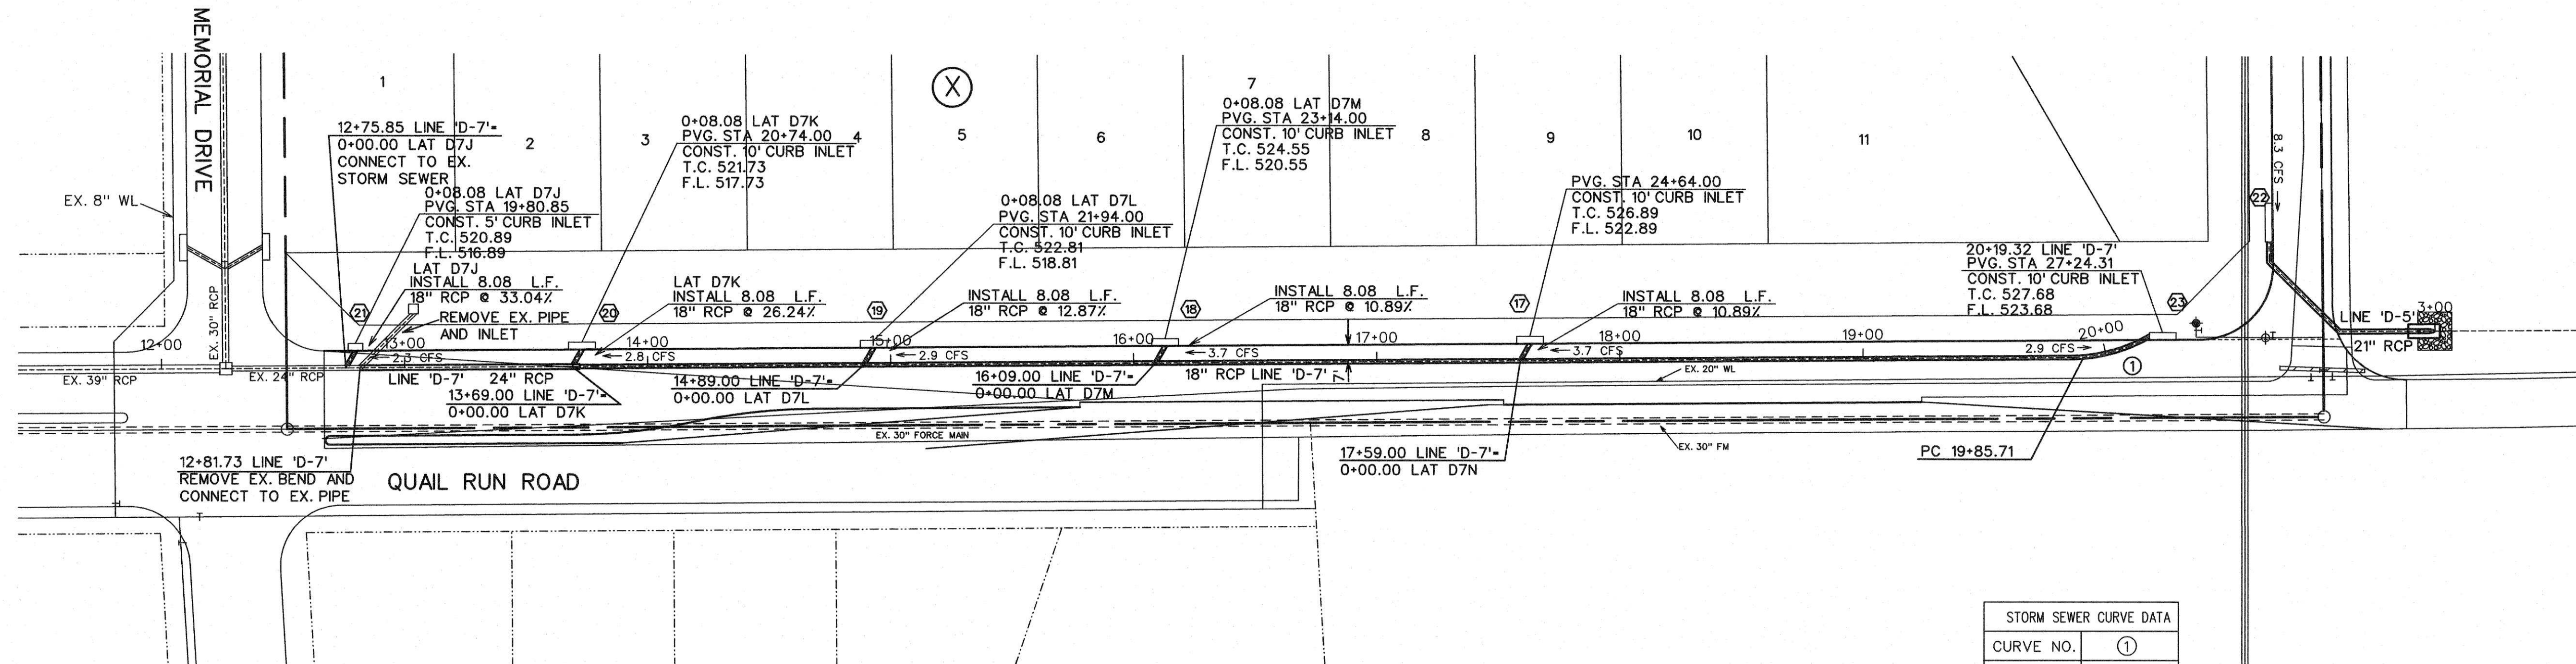

| STORM SEWER CURVE DATA | |
|------------------------|-------------|
| CURVE NO. | ① |
| Δ | 29° 37' 50" |
| R | 65.00' |
| T | 17.19' |
| L | 33.61' |

- LEGEND**
- (B) - BLOCK LABEL
 - (19) - INLET NUMBER
 - ① - CURVE NUMBER
 - - SANITARY SEWER
 - ⊕ - WATER
 - == - PROPOSED STORM SEWER
 - - EXISTING STORM SEWER

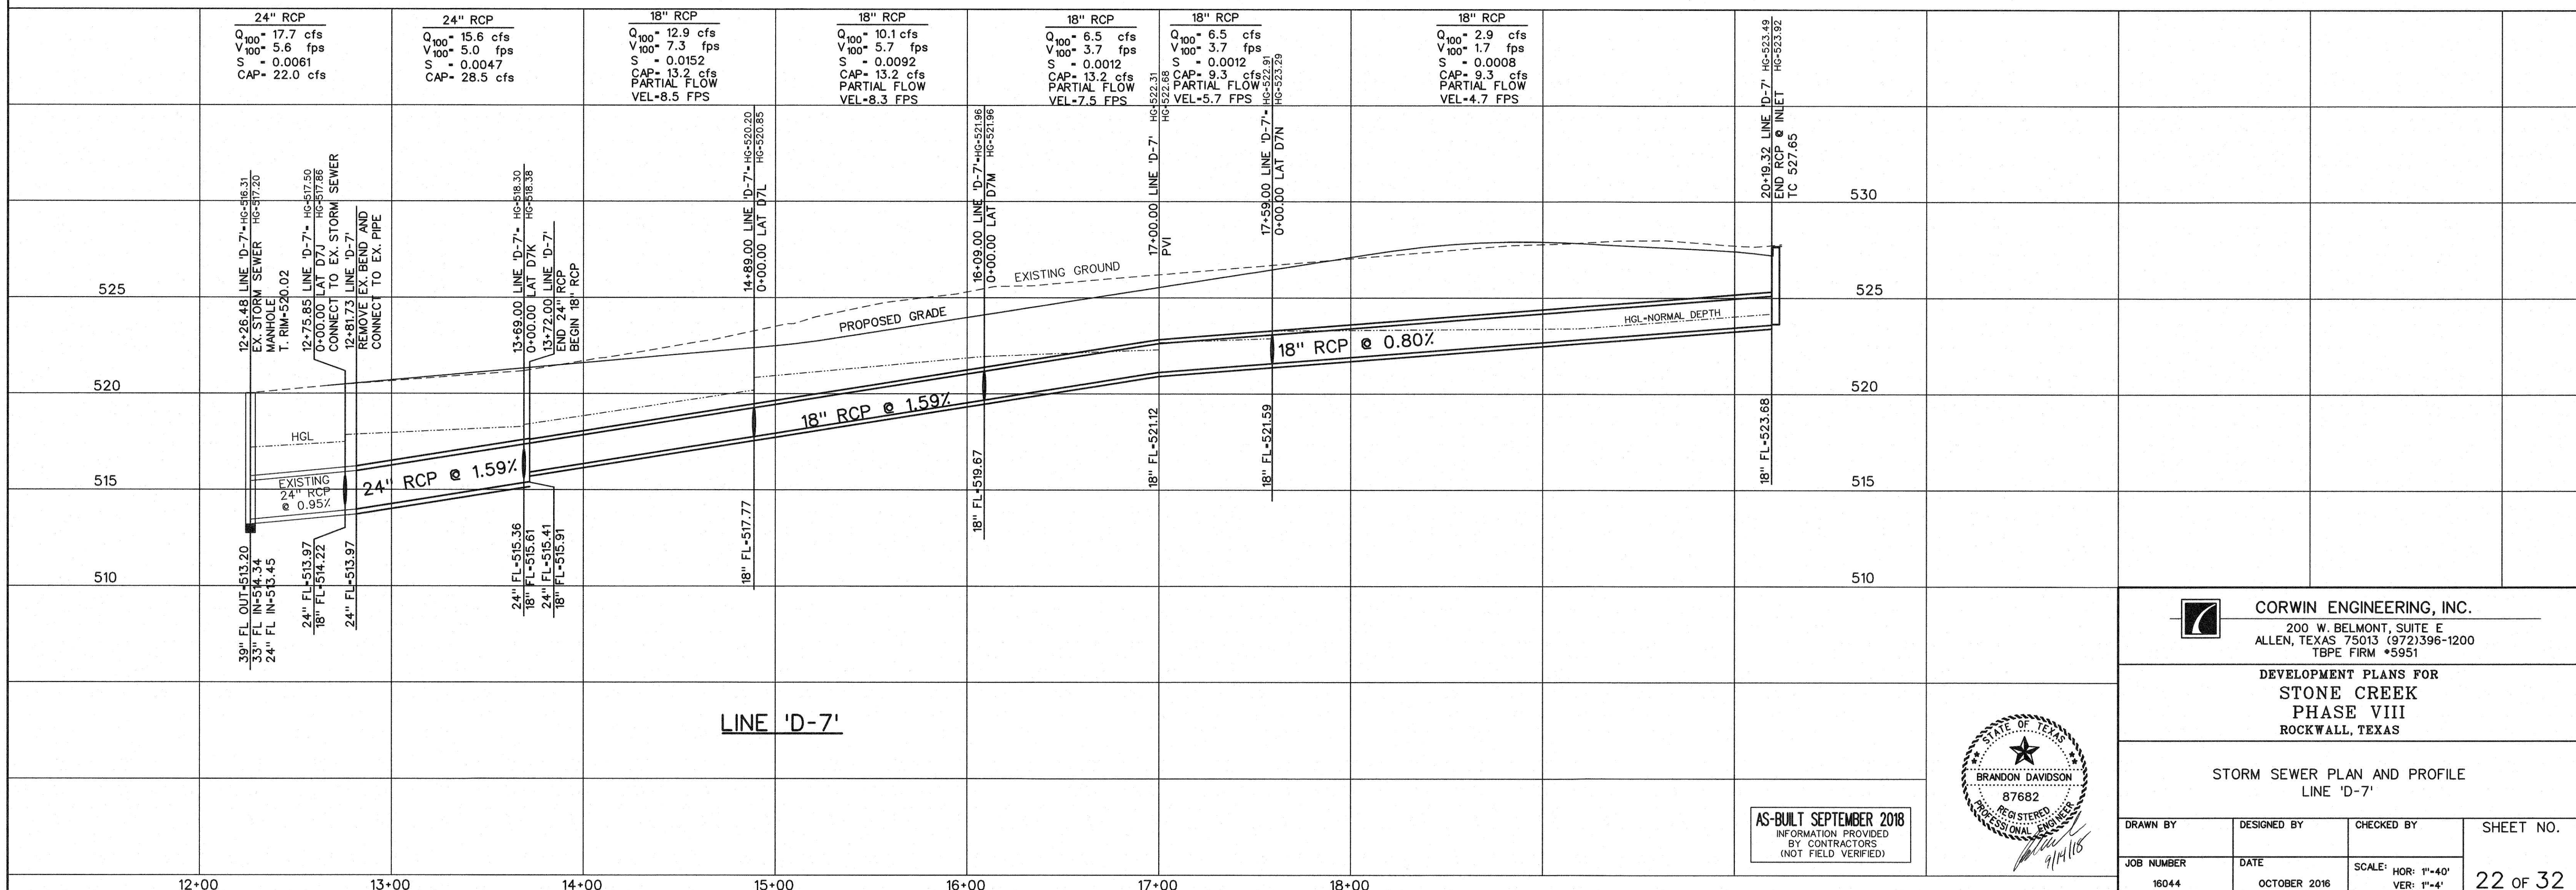

AS-BUILT SEPTEMBER 2018
INFORMATION PROVIDED
BY CONTRACTORS
(NOT FIELD VERIFIED)





CORWIN ENGINEERING, INC.
200 W. BELMONT, SUITE E
ALLEN, TEXAS 75013 (972)396-1200
TBP# FIRM #5951

DEVELOPMENT PLANS FOR
**STONE CREEK
PHASE VIII**
ROCKWALL, TEXAS



STORM SEWER PLAN AND PROFILE
LINE 'D-7'

| | | | |
|---------------------|----------------------|----------------------------------|-----------|
| DRAWN BY | DESIGNED BY | CHECKED BY | SHEET NO. |
| JOB NUMBER 16044 | DATE OCTOBER 2016 | SCALE: HOR: 1"=40' VER: 1"=4' | 22 OF 32 |

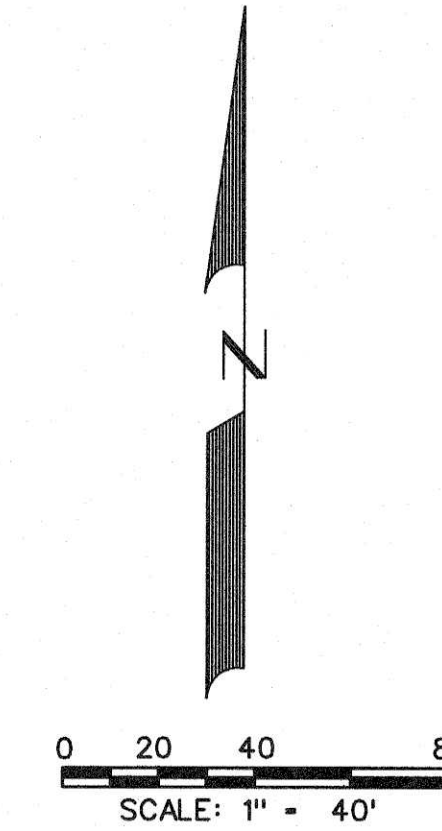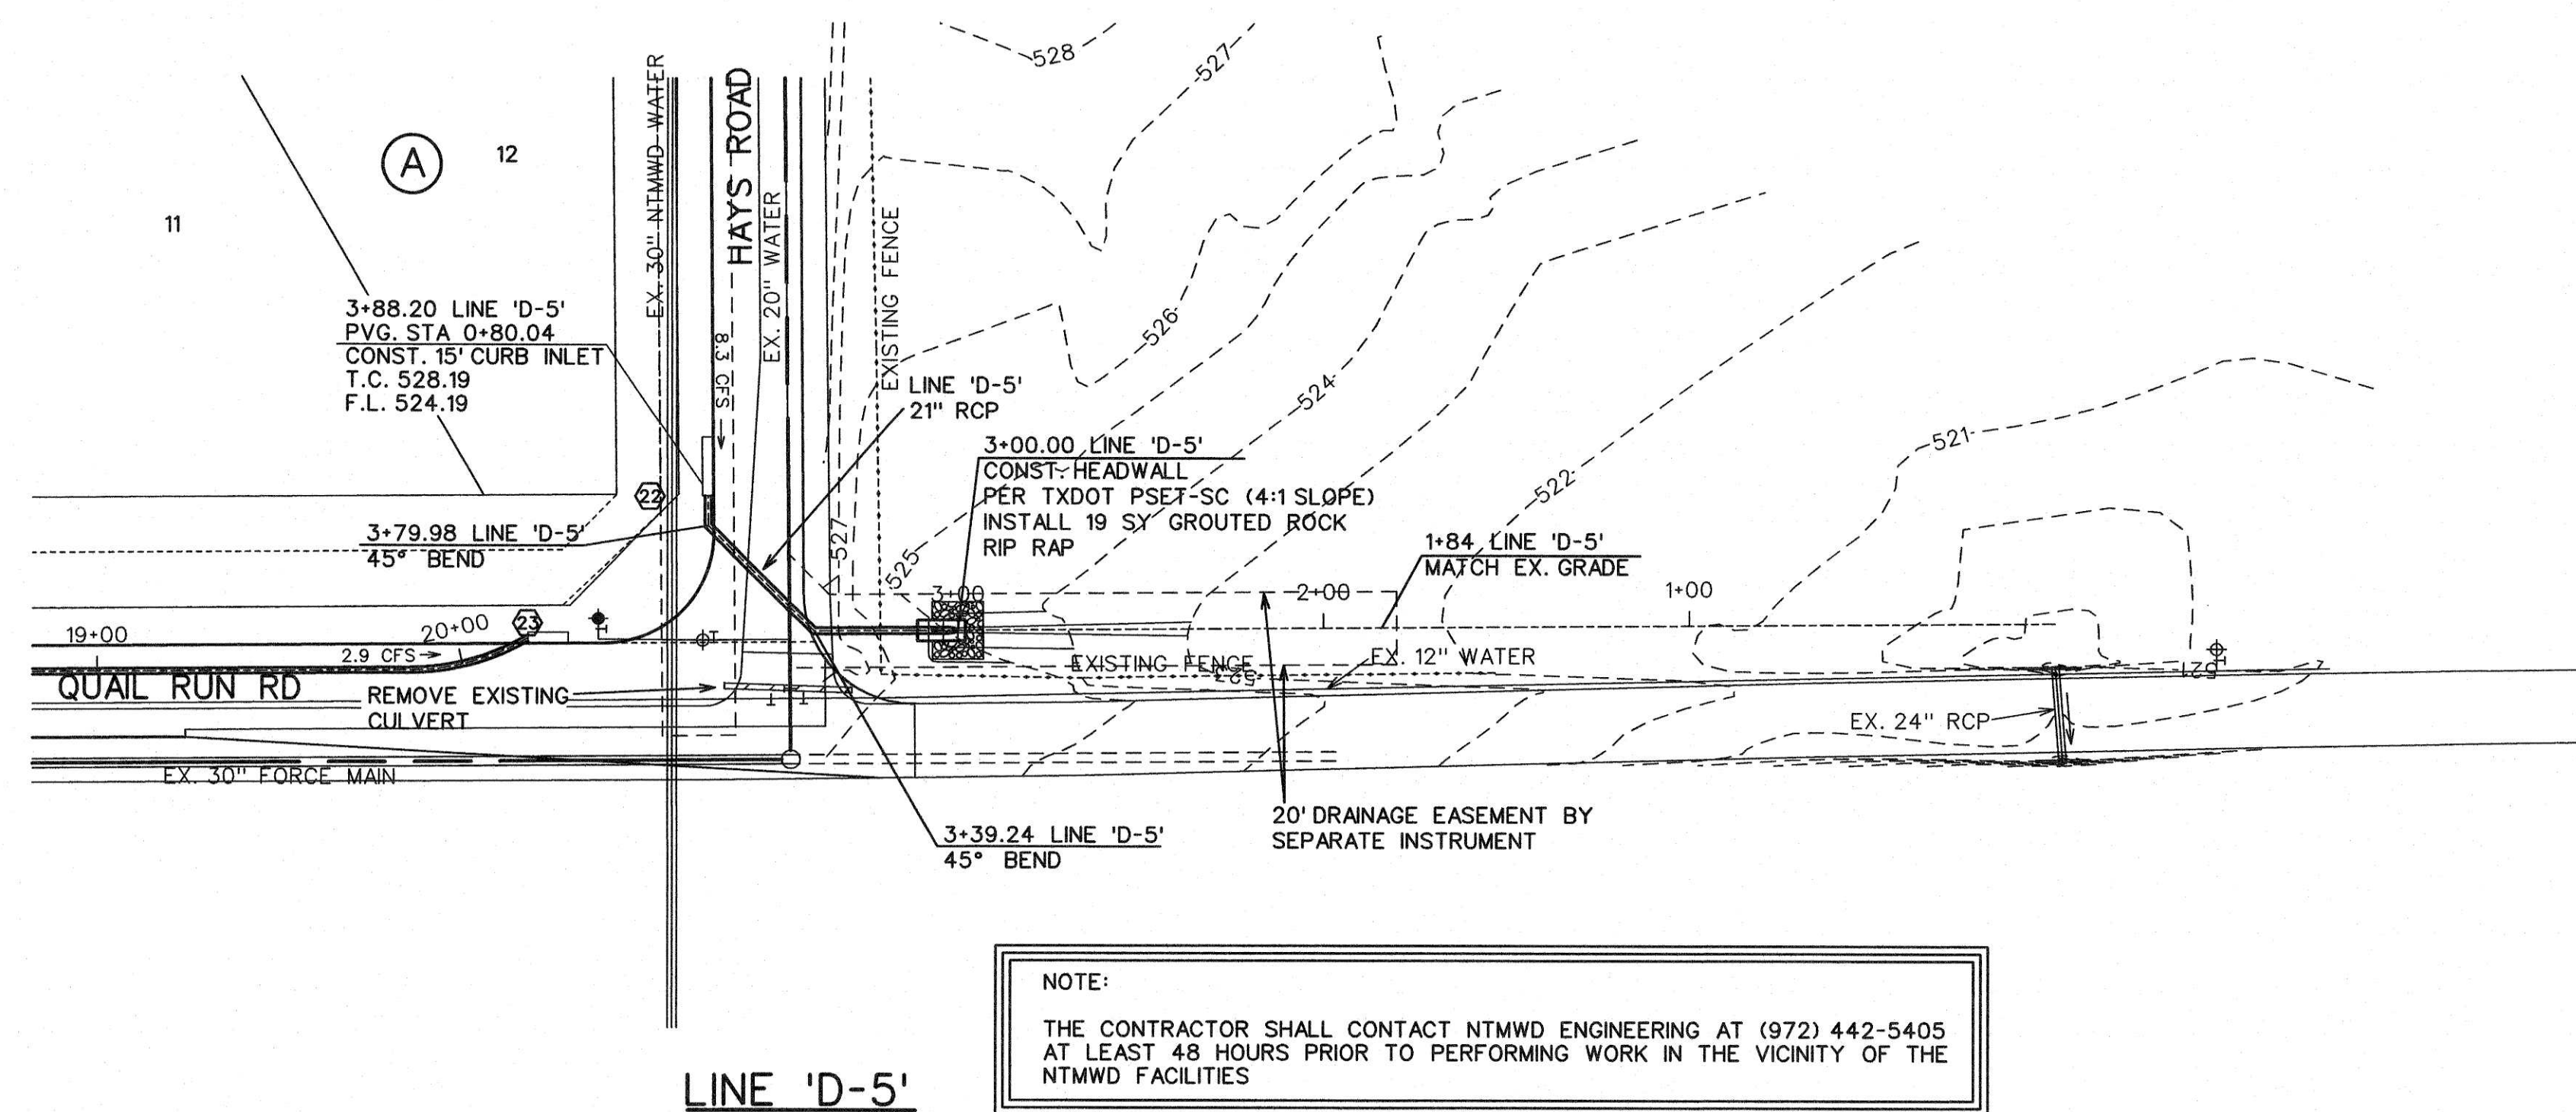

LEGEND

- (B) - BLOCK LABEL
- (19) - INLET NUMBER
- (1) - CURVE NUMBER
- - SANITARY SEWER
- ⊕ - WATER
- == - PROPOSED STORM SEWER
- - EXISTING STORM SEWER

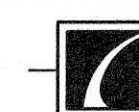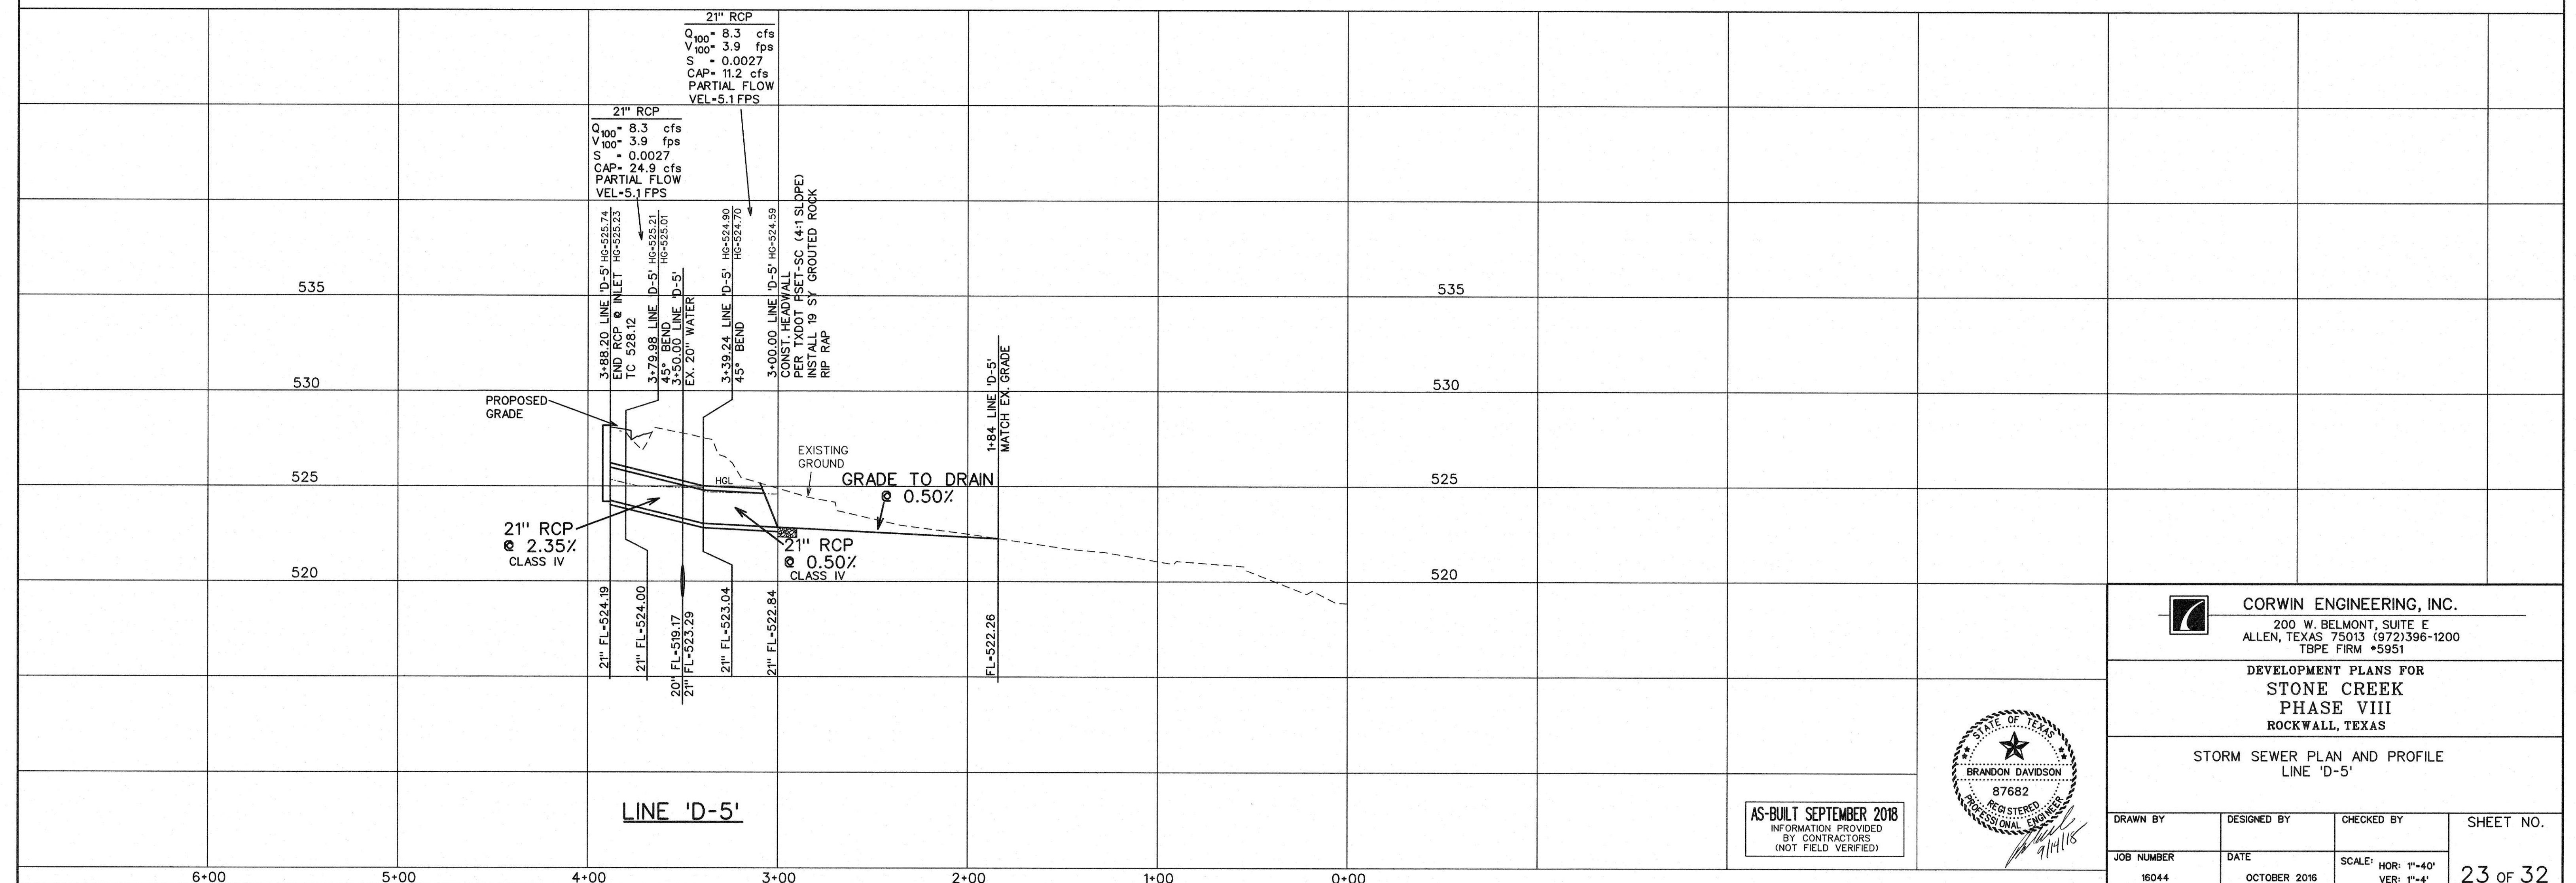

CORWIN ENGINEERING, INC.
200 W. BELMONT, SUITE E
ALLEN, TEXAS 75013 (972)396-1200
TBPE FIRM #5951

DEVELOPMENT PLANS FOR
**STONE CREEK
PHASE VIII**
ROCKWALL, TEXAS

STORM SEWER PLAN AND PROFILE
LINE 'D-5'

| | | | |
|---------------------|----------------------|----------------------------------|-----------|
| DRAWN BY | DESIGNED BY | CHECKED BY | SHEET NO. |
| JOB NUMBER 16044 | DATE OCTOBER 2016 | SCALE: HOR: 1"=40' VER: 1"=4' | 23 of 32 |



AS-BUILT SEPTEMBER 2018
INFORMATION PROVIDED
BY CONTRACTORS
(NOT FIELD VERIFIED)





Regulatory signs should be used only where justified by engineering judgment. All signage plans shall be reviewed and approved by the City of Rockwall Engineering Division and be designed in accordance with the principles described in the current Texas Manual on Uniform Traffic Control Devices (TMUTCD).

All street and regulatory signage shall be installed, inspected and approved, prior to final acceptance of the project. This inspection typically takes place as part of the Engineering Division's final walkthrough. Any sign related issue/issues will be noted on the project's final punch list.

A. A detailed street and regulatory signage plan is to be submitted to the City of Rockwall Engineering Division. All signs shall be shown in the engineering plans for review and approval. The signage plan shall be shown on a separate signage & pavement marking layout sheet or as a part of the plan & profile sheet. The plan shall identify the specific sign designation, size and location for each sign. Sign standards shall also be included in the engineering plans.

B. All signage installed shall comply with the current Texas Manual on Uniform Traffic Control Devices and the Standard Highway Sign Designs for Texas. The sign layout drawings shall show the color and dimensions

of all sign face legend components including background color, legend color, borders, symbols, letter size and style.

C. The developer shall be responsible for furnishing and installing all regulatory signage, warning signage and street name signage along with all necessary sign mounts in accordance with the approved engineering plans. A sample production sign shall be submitted to the Traffic Signs & Pavement Markings Supervisor for review and approval. The sample shall be directed to the City of Rockwall Service Center located at 1600 Airport Road, Rockwall Texas 75087. The sample sign must be submitted at least 10 days prior to the scheduled installation date.

D. For a street with a cul-de-sac end, a standard W 14-2a shall be mounted over the street name blade, if the cul-de-sac is not clearly visible from the adjoining roadway, or is located in excess of 400 linear feet from the adjoining roadway.

E. Sign posts shall be 2 3/8" O.D. galvanized steel tube sign post with a galvanized finish.

F. Sign clamps and brackets shall be high strength aluminum.

A. Street name sign blades shall be double-sided with rounded corners.

B. Street Name Blades shall be nine-inch (9") tall flat aluminum. The blades shall be 0.080 inches thick and be a minimum of 36" long.

C. The lettering for the street signs shall be 3M 3930 high intensity prismatic material sheeting for street, regulatory and warning signs and shall be high intensity diamond grade type III prismatic. The street sign background shall be green and the legend shall be white.

D. The street sign blade must incorporate the current City of Rockwall logo. The logo shall consist of white Scotchlite Series 3930 high intensity prismatic material. (Product Code 3930)

E. Block Numbers are required on all street name blades and shall be located on the top right corner of the street blade.

F. The lettering for the street blades shall be composed of a combination of lower-case letters with initial upper-case letters. The Clearview TCAD-1W font shall be used. The lettering shall be composed of initial upper-case letters of at least 6 inches in height and lower case letters of at least 4.5 inches in height. For supplementary lettering to indicate the type of street

(such as Street, Avenue or Road) shall be composed of initial upper-case letters at least 3-inches in height and lower-case letters at least 2.25 inches in height. Abbreviations may be used (for example St., Ave., or Rd) except the street name itself. The supplementary lettering shall be located at the lower right corner of the street blade, under the block number.


G. The street blade sign shall consist of green Scotchlite 3930 high intensity prismatic material background (product code 3937) and white Scotchlite 3930 high intensity prismatic material for the lettering (product code 3930). The background sheeting shall be white 3M 3990 high intensity prismatic material. The background material shall be applied to the full width and height of the sign blank leaving no metal exposed. The background material shall be one continuous piece of material. Patching of background material is not allowed and any sign with patching material of any type will be rejected by the City.

Alternative Option:

As an alternative, the foreground color may be green transparent Scotchlite ElectroCut 1177 film (E.C. film). Lettering shall be cut out and removed producing a single continuous piece of green transparent film material.

Street address markers shall be installed for each lot in the subdivision. The markers shall be located at the center of the lot on the face of the curbs. The address markers shall have a deep green background with reflective white numbers. The number size shall be four (4) inches in height. The background of the address marker shall be eighteen (18) inches in length and from the top of curb to the gutter flow line. The address marker shall show the full numerical portion of the address of the lot.

All signage for multifamily, commercial, retail and industrial developments are required to have a separate permit from the building department. Signs, including any overhangs, are not allowed in any right-of-ways and/or easements. Location of any signage is not approved on engineering plans.

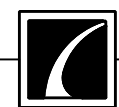




CORWIN ENGINEERING, INC.
200 W. BELMONT, SUITE E
ALLEN, TEXAS 75013 (972)396-1200
TBP E FIRM #5951

DEVELOPMENT PLANS FOR
STONE CREEK
PHASE VIII
ROCKWALL, TEXAS



SIGN AND LIGHT PLAN

| | | | |
|------------|--------------|------------|-----------|
| DRAWN BY | DESIGNED BY | CHECKED BY | SHEET NO. |
| JOB NUMBER | DATE | SCALE: | 27 OF 32 |
| 16044 | OCTOBER 2016 | 1"=100' | |


AS-BUILT SEPTEMBER 2018
INFORMATION PROVIDED
BY CONTRACTORS
(NOT FIELD VERIFIED)

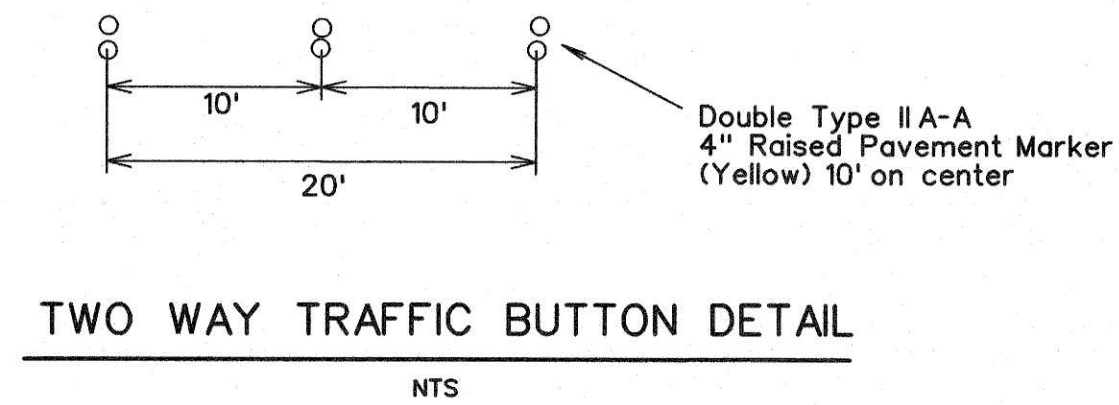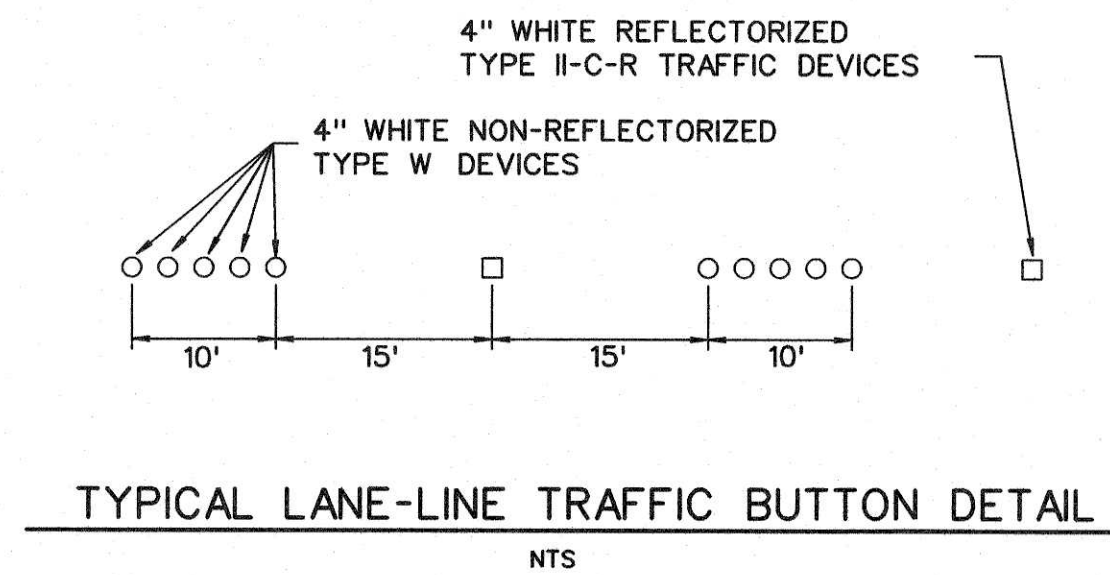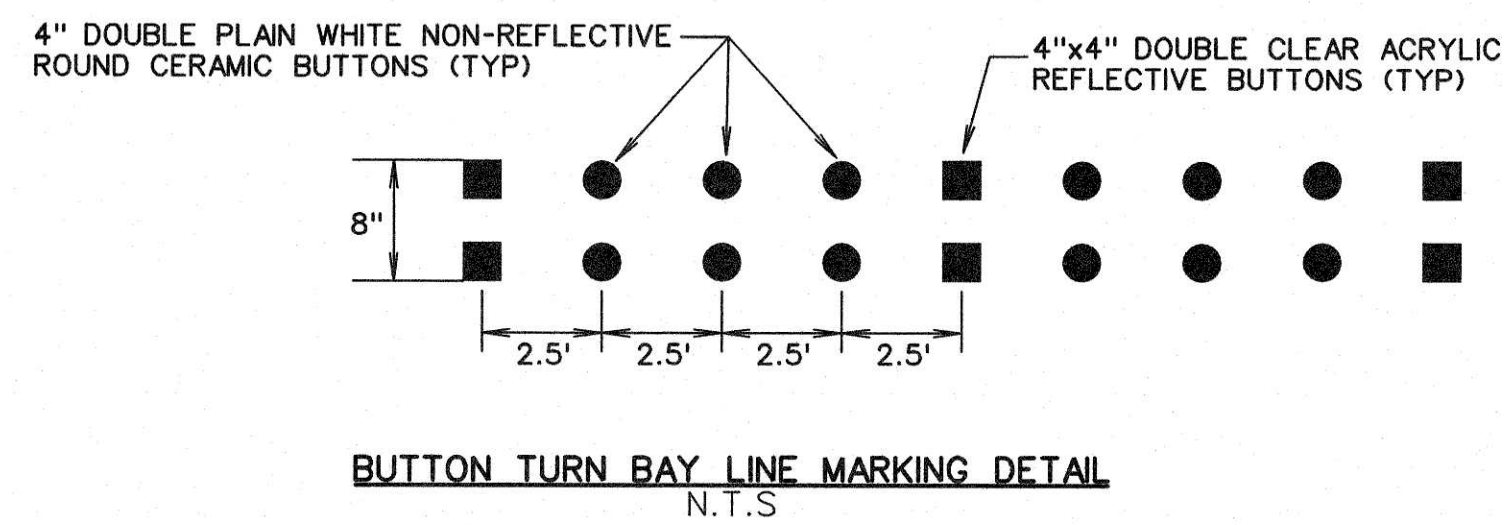



SCALE: 1" = 50'

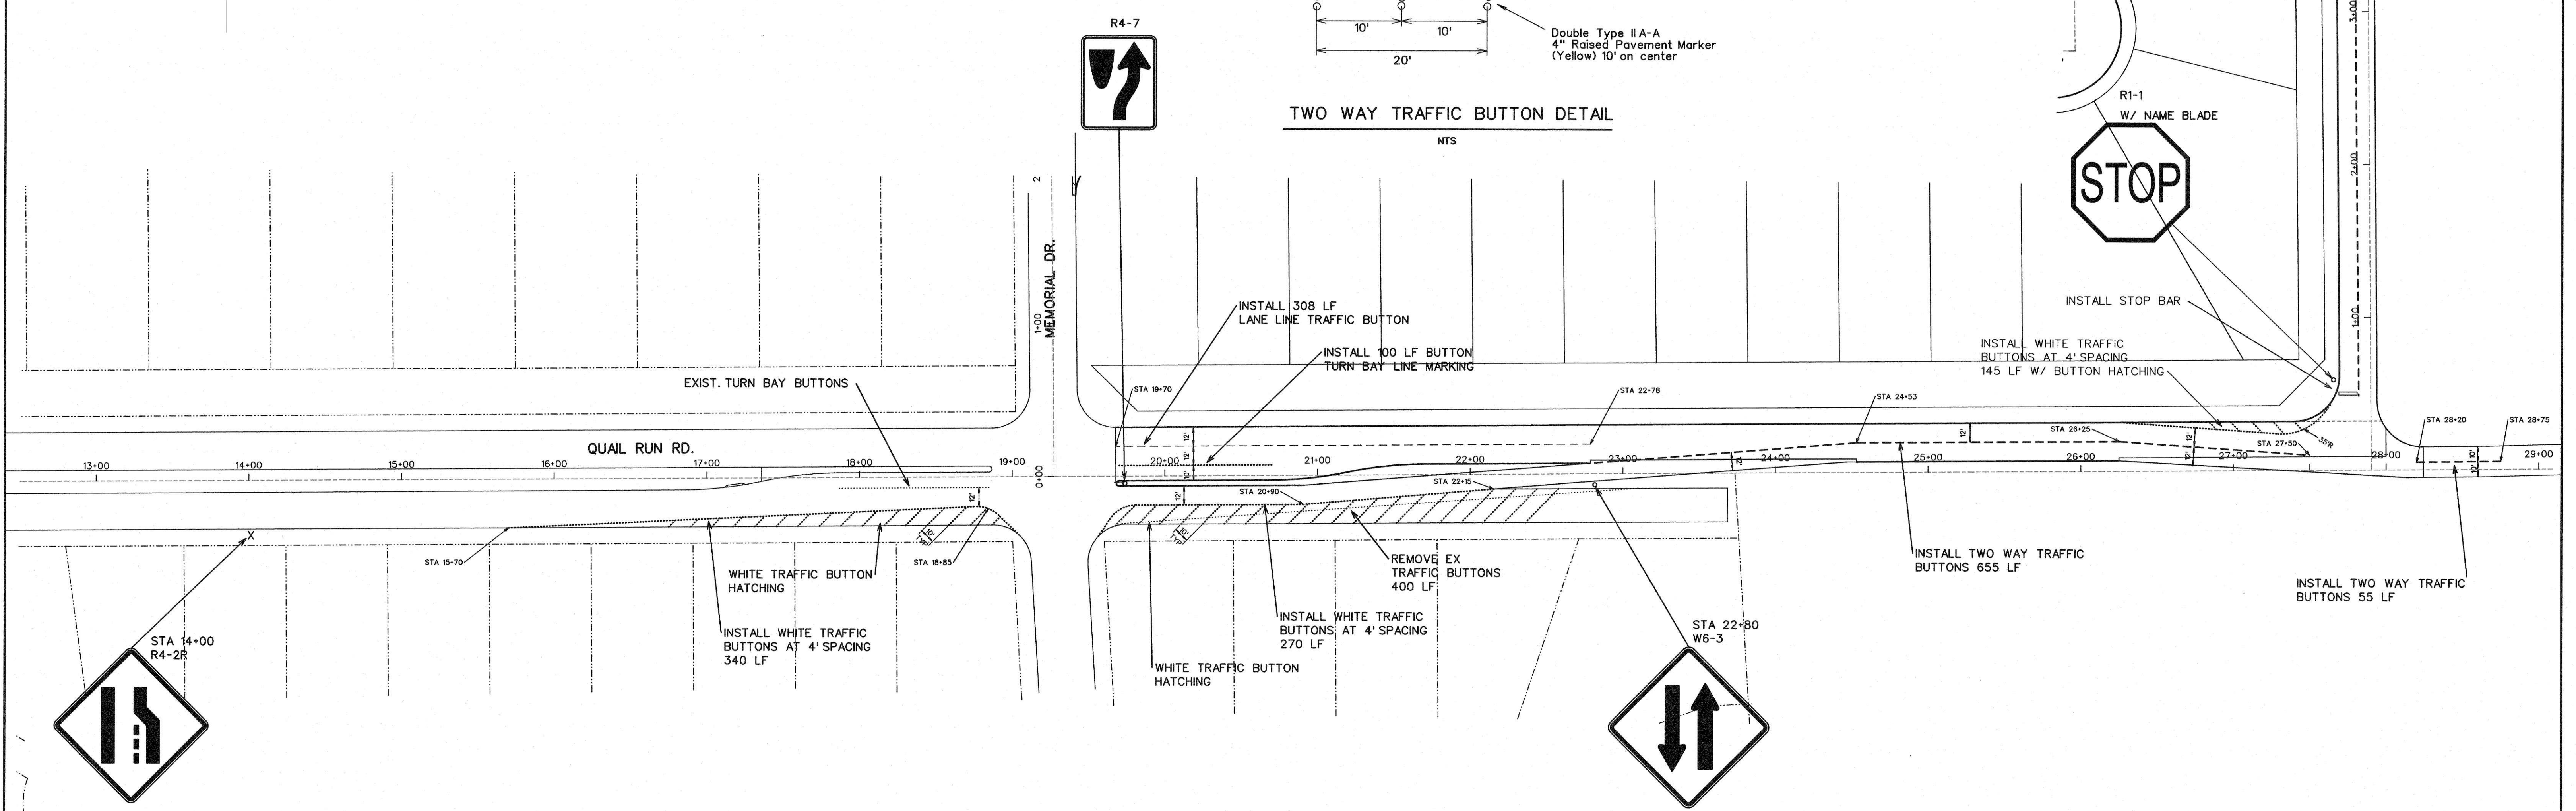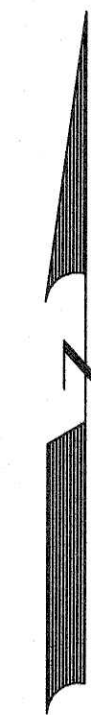

AS-BUILT SEPTEMBER 2018
INFORMATION PROVIDED
BY CONTRACTORS
(NOT FIELD VERIFIED)


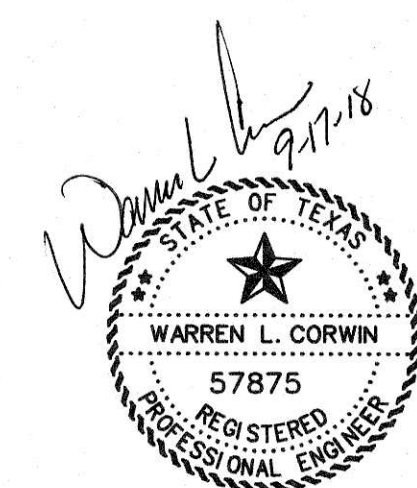

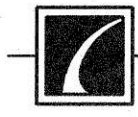
| | | | |
|---|----------------------|------------------|---------------------------|
|  CORWIN ENGINEERING, INC. 200 W. BELMONT, SUITE E ALLEN, TEXAS 75013 (972)396-1200 TBPE FIRM #5951 | | | |
| DEVELOPMENT PLANS FOR STONE CREEK PHASE VIII ROCKWALL, TEXAS | | | |
| QUAIL RUN ROAD TRAFFIC SIGNAGE PLAN | | | |
| DRAWN BY | DESIGNED BY | CHECKED BY | SHEET NO. 28 OF 32 |
| JOB NUMBER 16044 | DATE OCTOBER 2016 | SCALE: 1"=50' | |

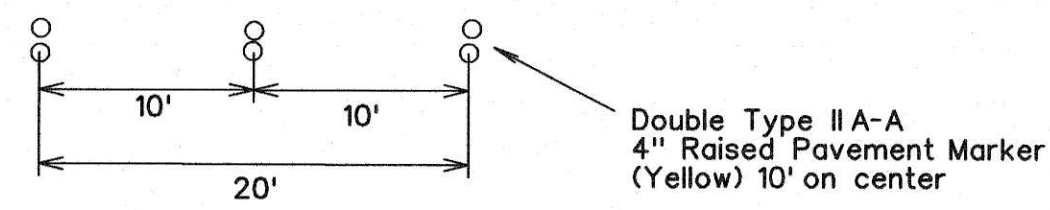



TWO WAY TRAFFIC BUTTON DETAIL



NTS

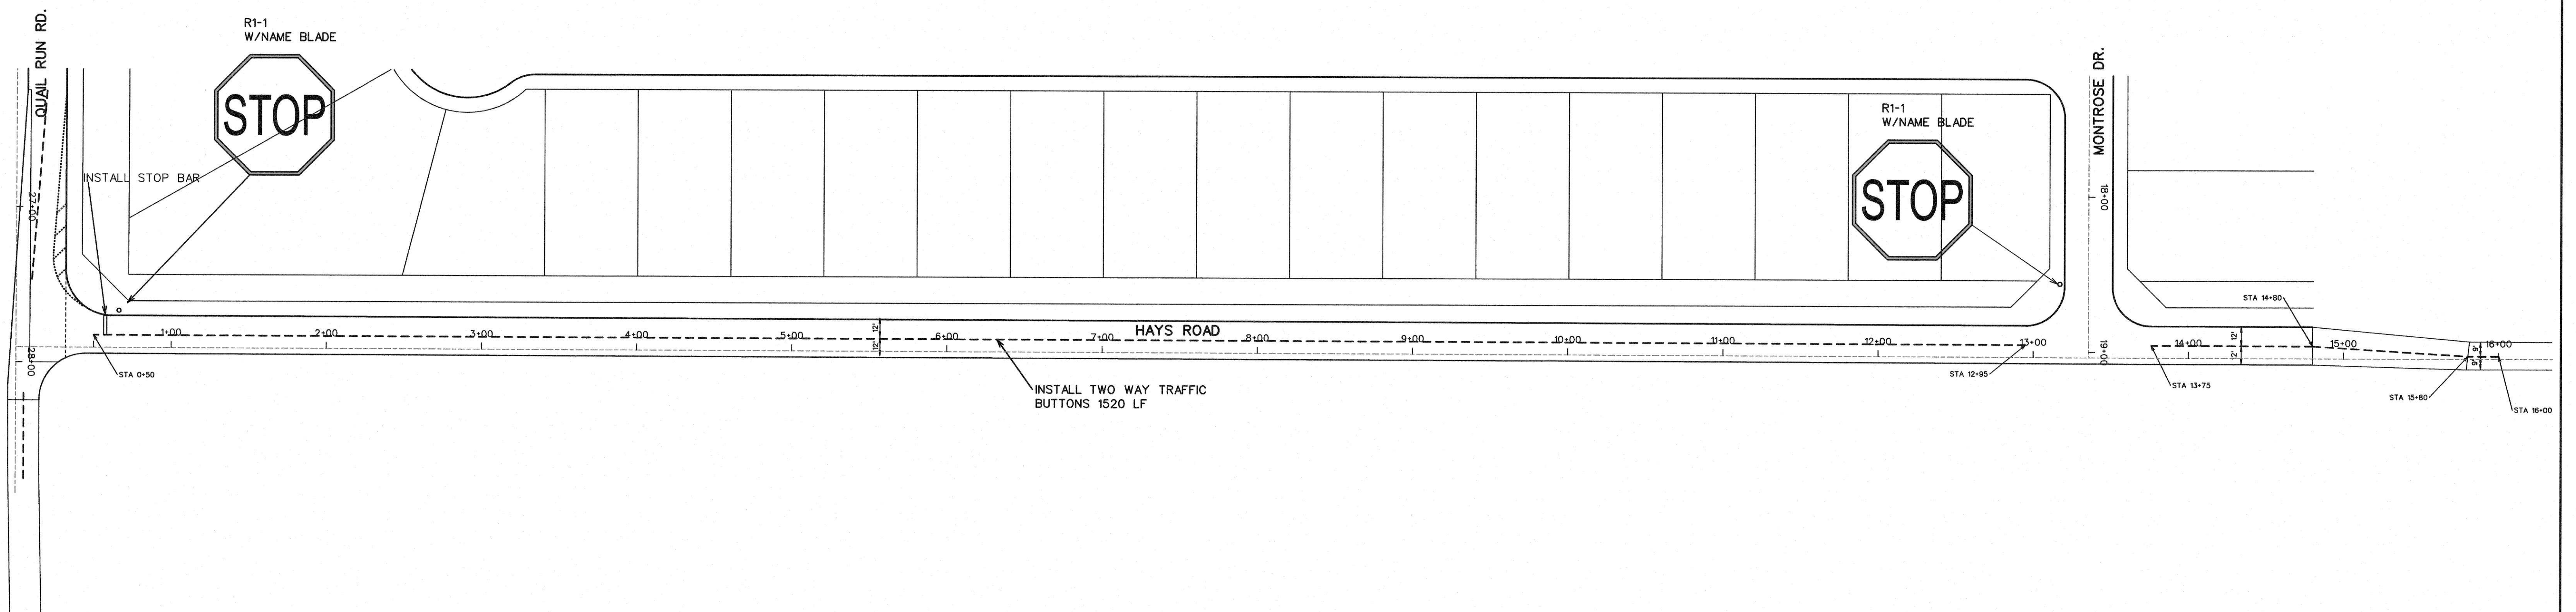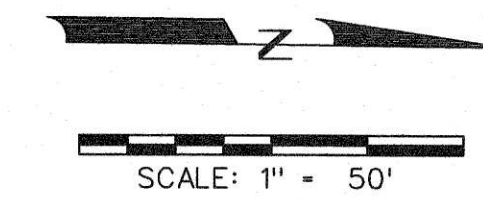

AS-BUILT SEPTEMBER 2018
INFORMATION PROVIDED
BY CONTRACTORS
(NOT FIELD VERIFIED)

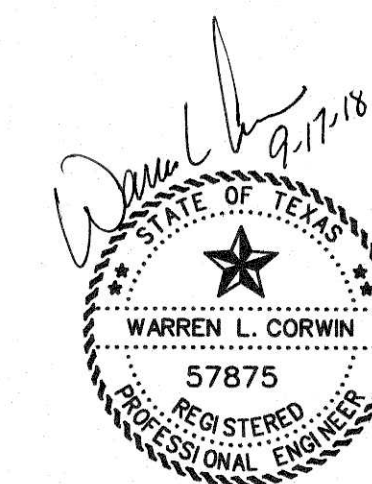



| | | | |
|--|----------------------|------------------|---------------------------|
| <div> CORWIN ENGINEERING, INC. 200 W. BELMONT, SUITE E ALLEN, TEXAS 75013 (972)396-1200 TBPE FIRM #5951</div> | | | |
| DEVELOPMENT PLANS FOR STONE CREEK PHASE VIII ROCKWALL, TEXAS | | | |
| HAYS ROAD TRAFFIC SIGNAGE PLAN | | | |
| DRAWN BY | DESIGNED BY | CHECKED BY | SHEET NO. 29 of 32 |
| JOB NUMBER 16044 | DATE OCTOBER 2016 | SCALE: 1"=50' | |

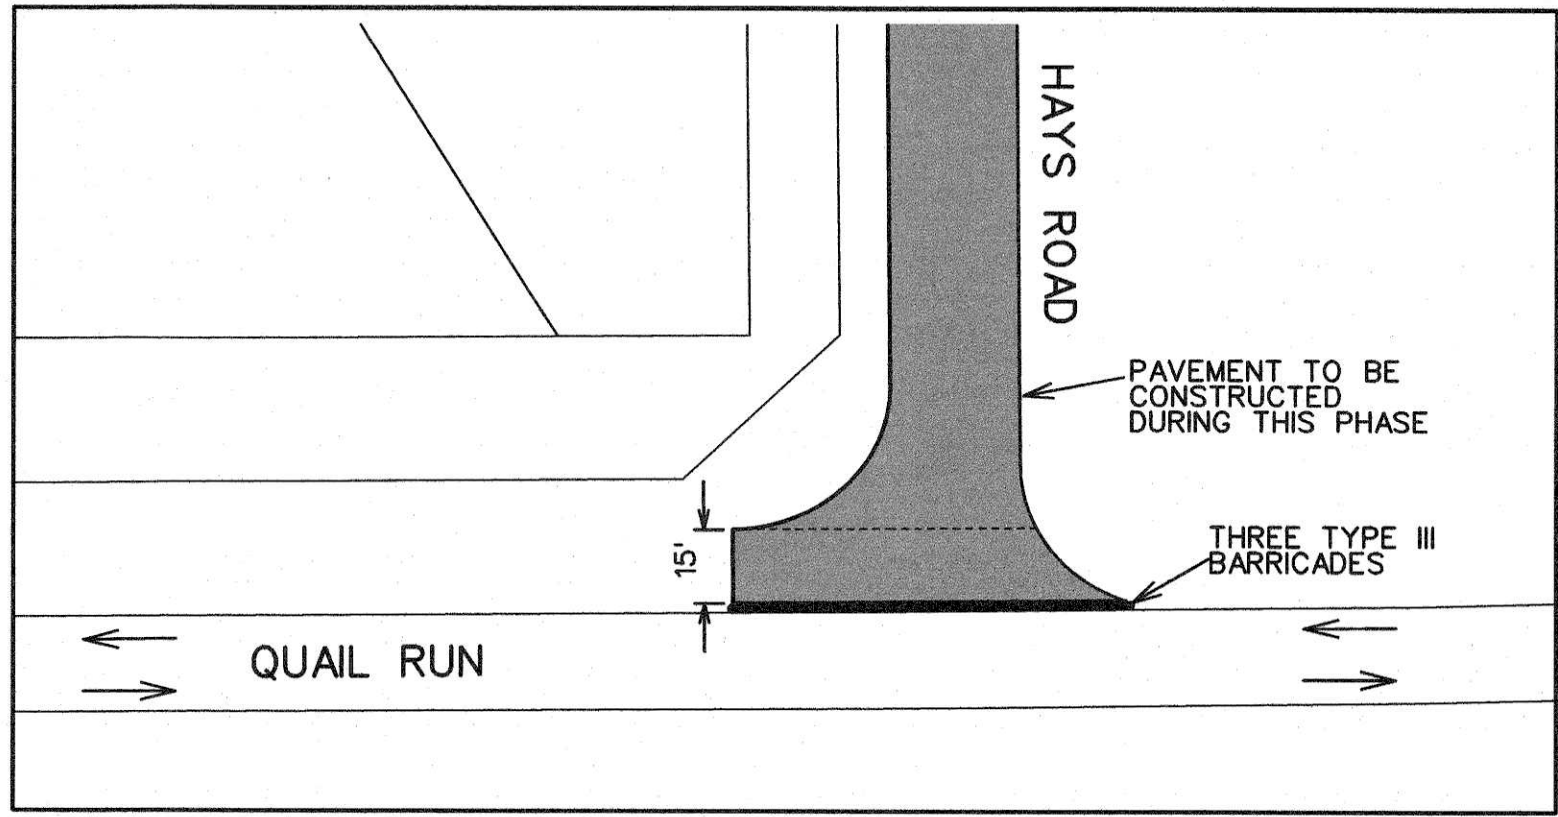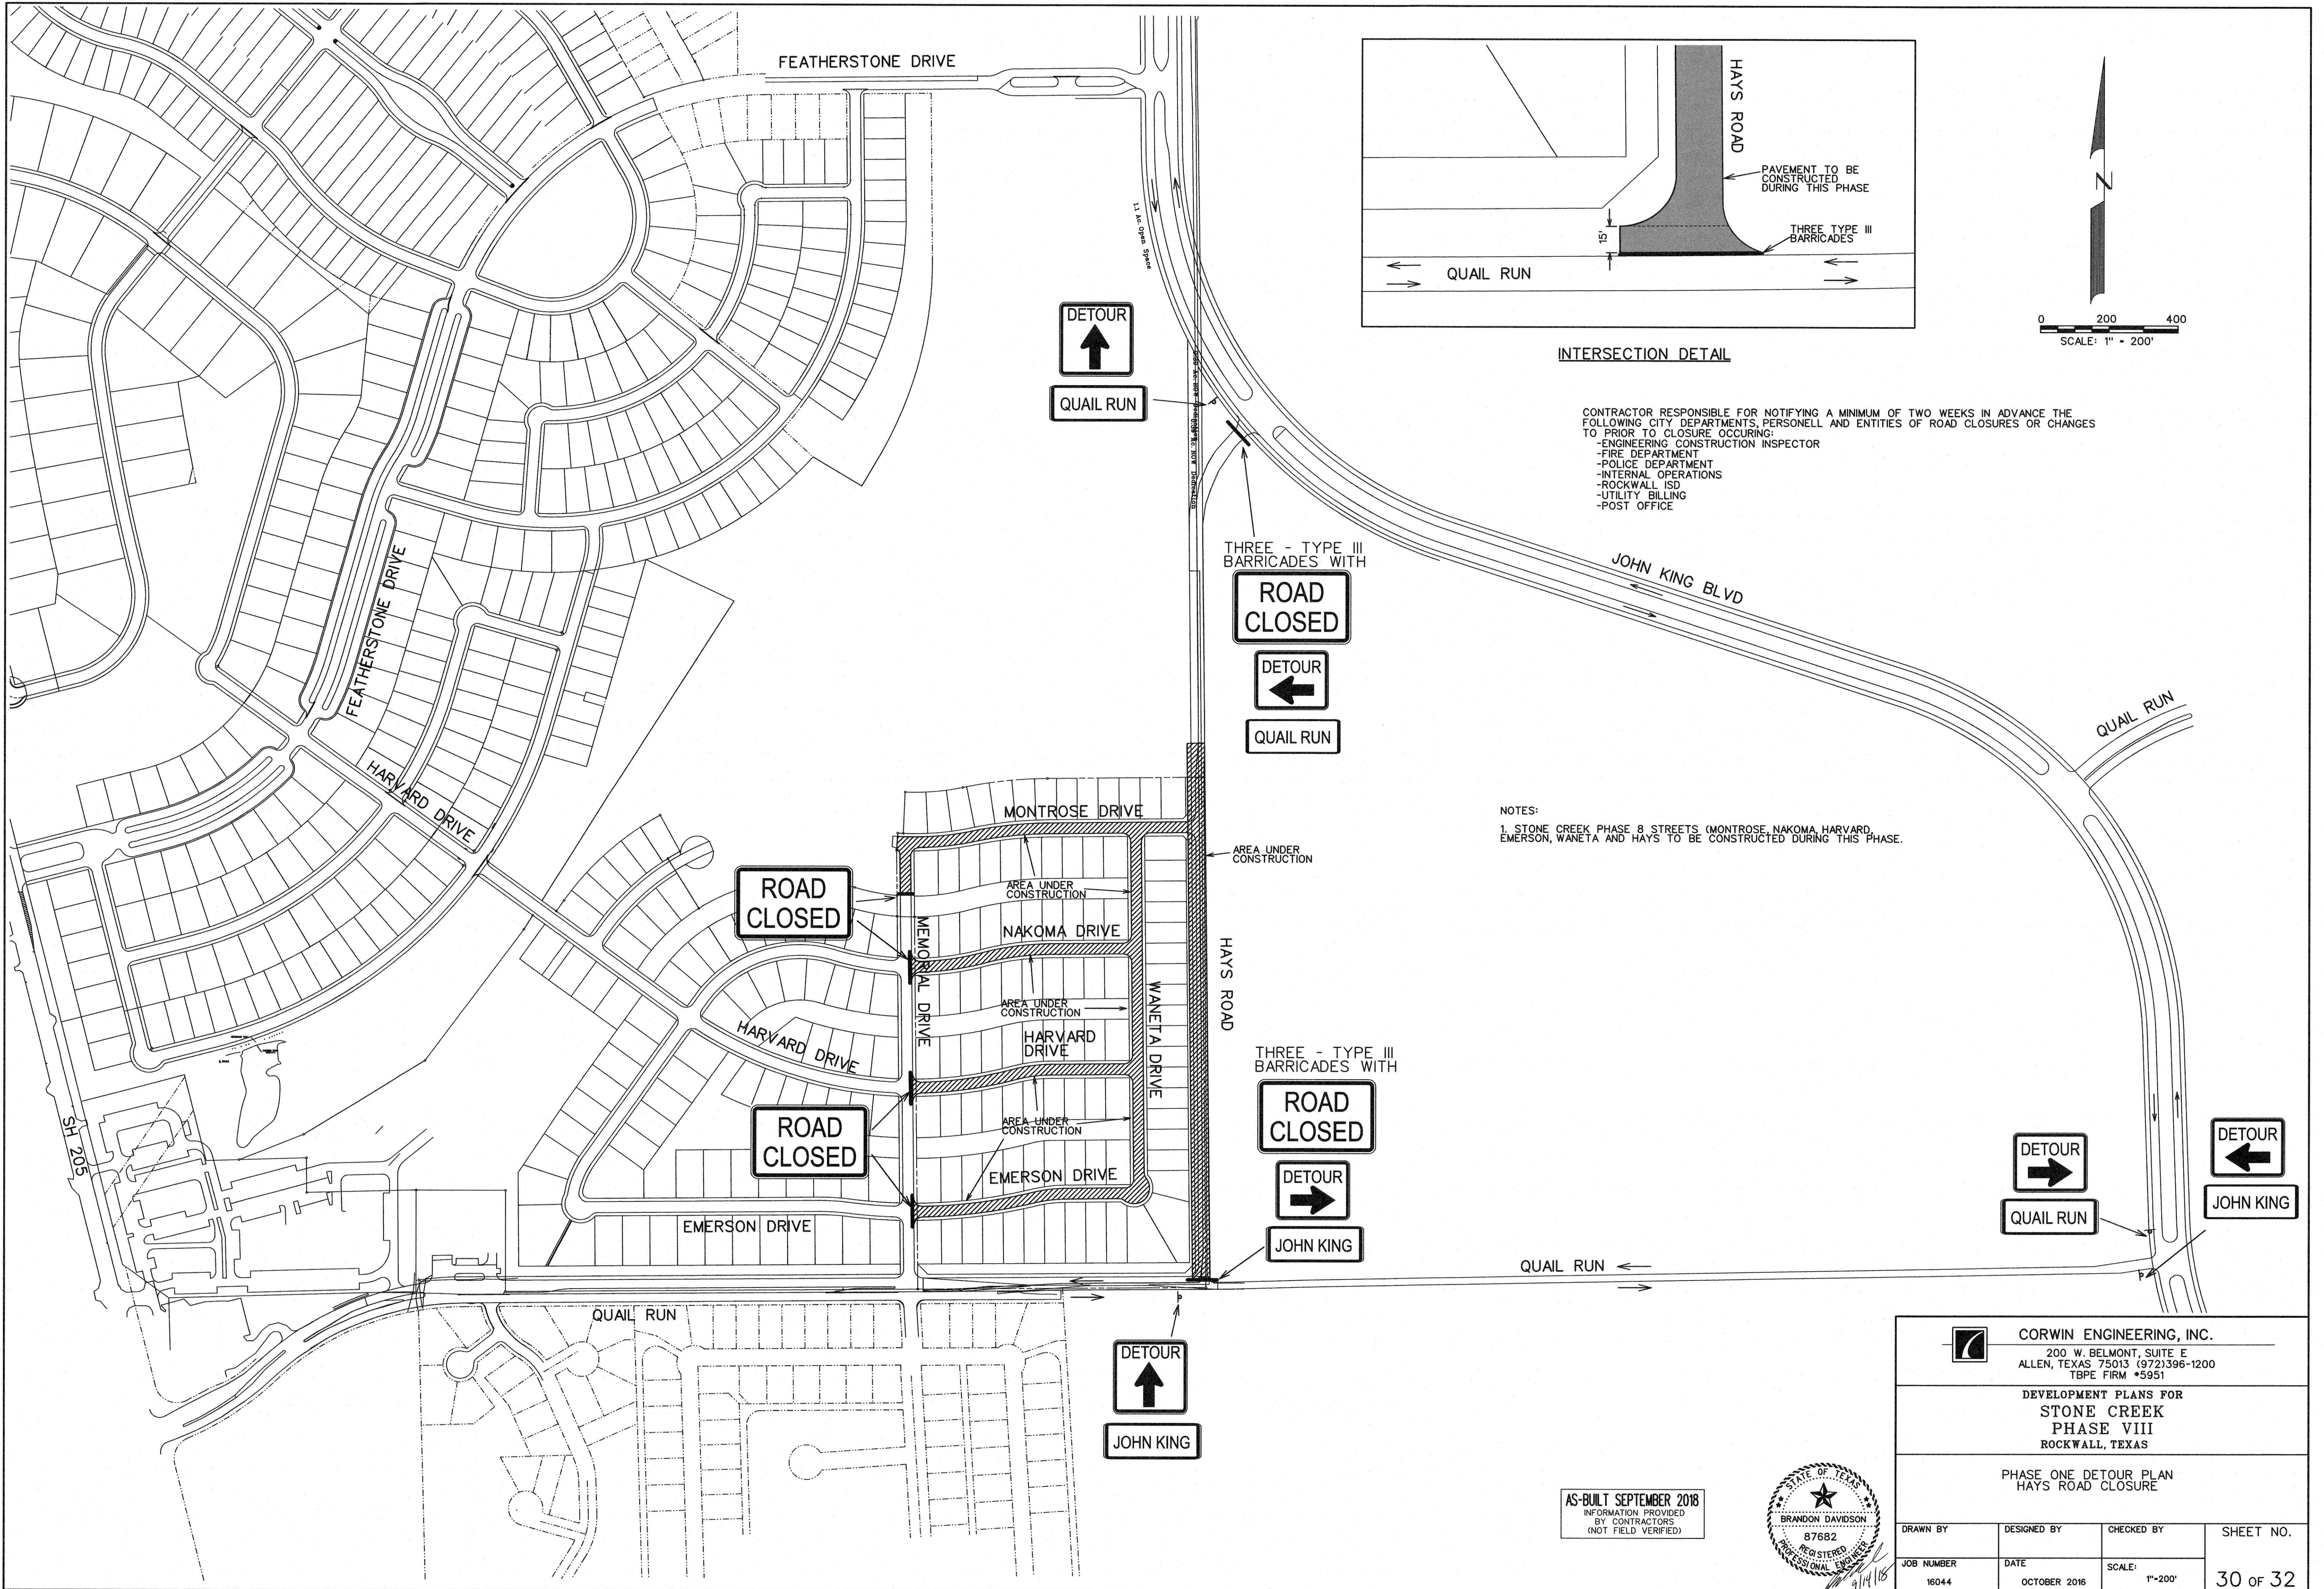

INTERSECTION DETAIL

CONTRACTOR RESPONSIBLE FOR NOTIFYING A MINIMUM OF TWO WEEKS IN ADVANCE THE FOLLOWING CITY DEPARTMENTS, PERSONELL AND ENTITIES OF ROAD CLOSURES OR CHANGES TO PRIOR TO CLOSURE OCCURING:
-ENGINEERING CONSTRUCTION INSPECTOR
-FIRE DEPARTMENT
-POLICE DEPARTMENT
-INTERNAL OPERATIONS
-ROCKWALL ISD
-UTILITY BILLING
-POST OFFICE

NOTES:
1. STONE CREEK PHASE 8 STREETS (MONTROSE, NAKOMA, HARVARD, EMERSON, WANETA AND HAYS) TO BE CONSTRUCTED DURING THIS PHASE.

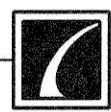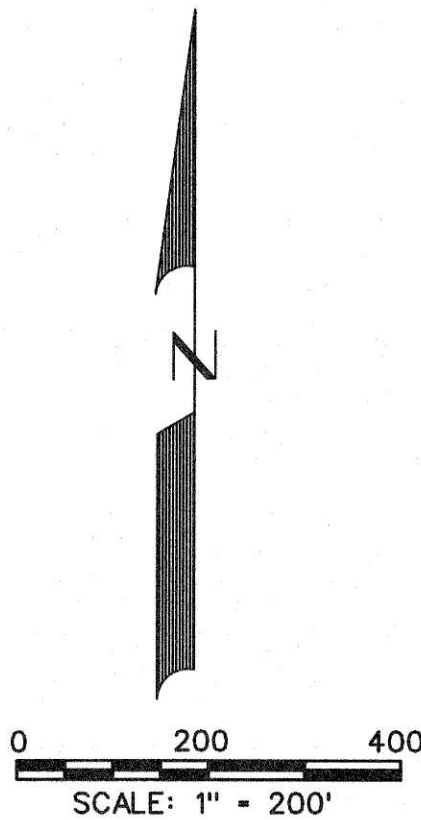

CORWIN ENGINEERING, INC.
200 W. BELMONT, SUITE E
ALLEN, TEXAS 75013 (972)396-1200
TBPE FIRM #5951



DEVELOPMENT PLANS FOR
STONE CREEK
PHASE VIII
ROCKWALL, TEXAS

PHASE ONE DETOUR PLAN
HAYS ROAD CLOSURE



AS-BUILT SEPTEMBER 2018
INFORMATION PROVIDED
BY CONTRACTORS
(NOT FIELD VERIFIED)


| | | | |
|------------|--------------|------------|-----------|
| DRAWN BY | DESIGNED BY | CHECKED BY | SHEET NO. |
| JOB NUMBER | DATE | SCALE: | |
| 16044 | OCTOBER 2016 | 1"=200' | 30 OF 32 |

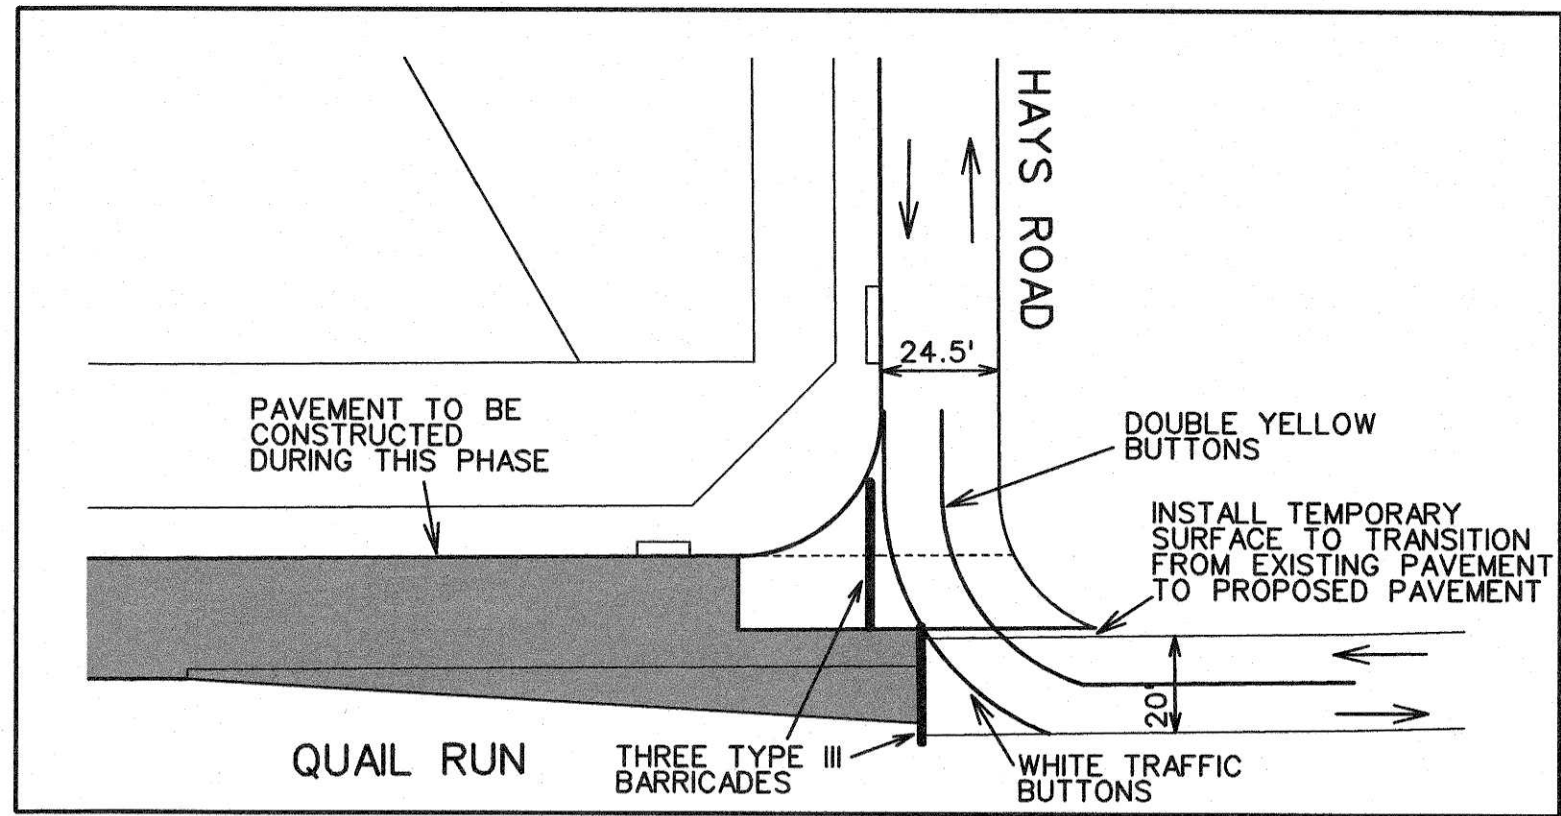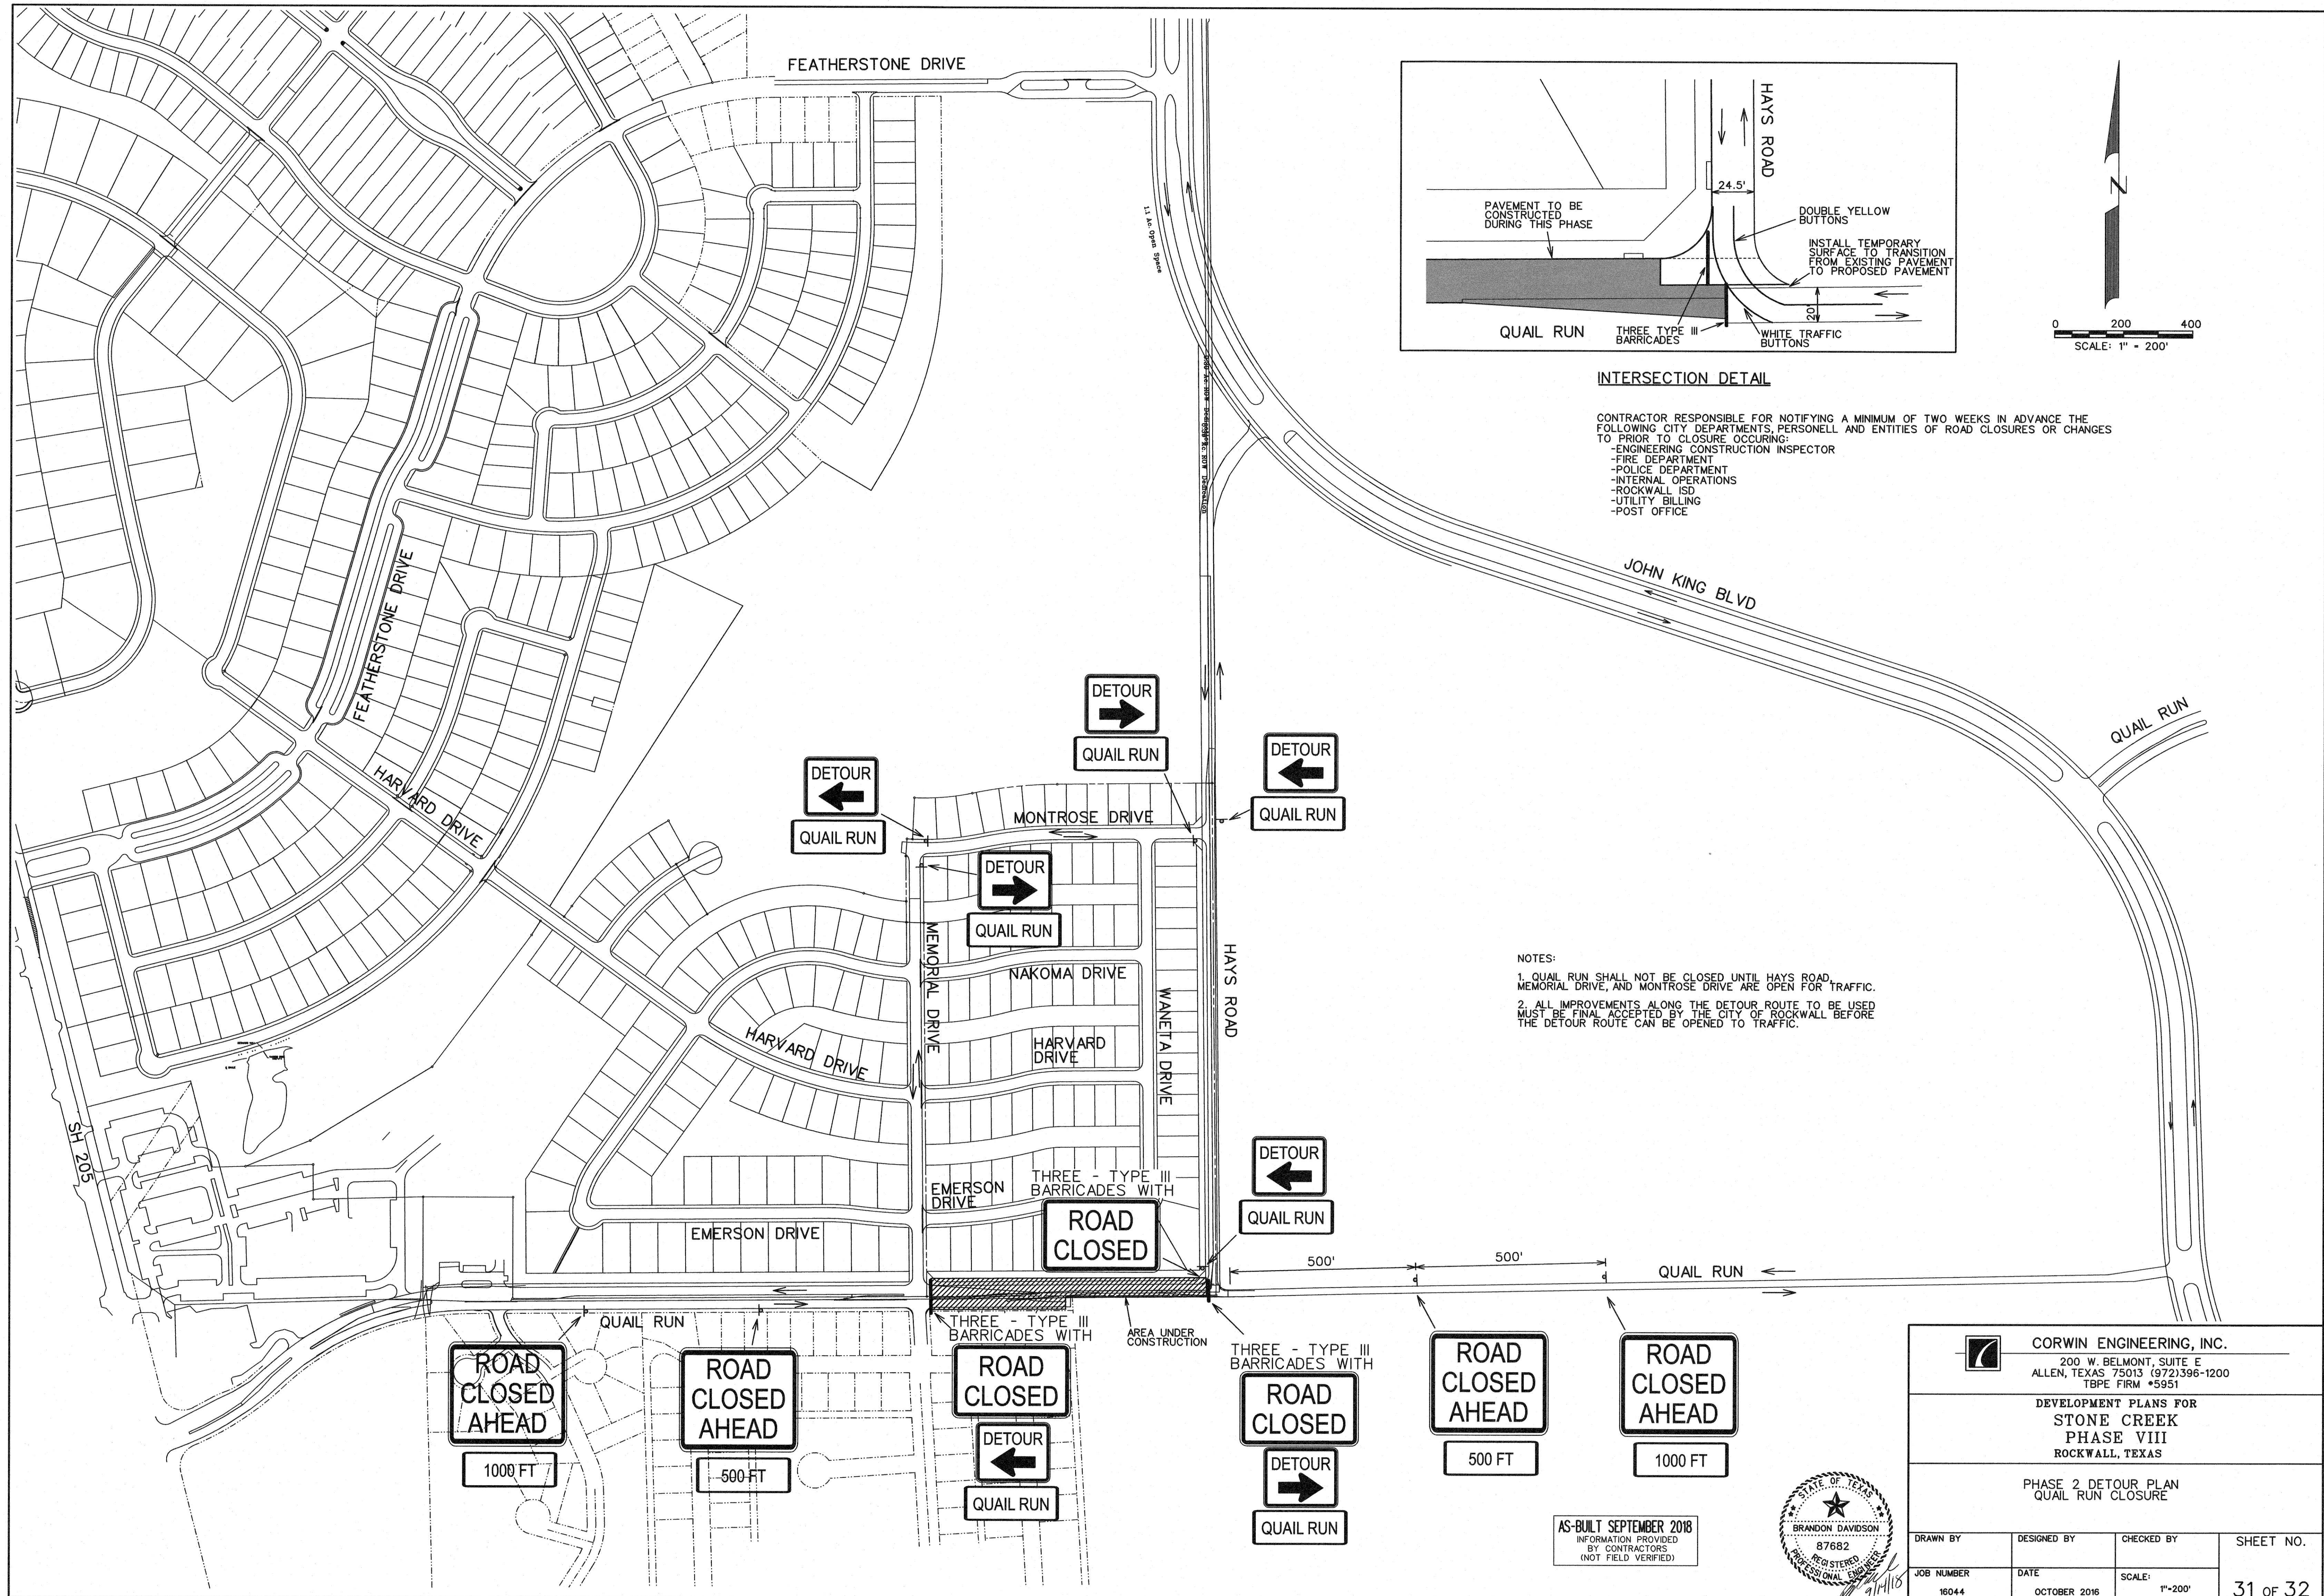


INTERSECTION DETAIL

CONTRACTOR RESPONSIBLE FOR NOTIFYING A MINIMUM OF TWO WEEKS IN ADVANCE THE FOLLOWING CITY DEPARTMENTS, PERSONELL AND ENTITIES OF ROAD CLOSURES OR CHANGES TO PRIOR TO CLOSURE OCCURING:
-ENGINEERING CONSTRUCTION INSPECTOR
-FIRE DEPARTMENT
-POLICE DEPARTMENT
-INTERNAL OPERATIONS
-ROCKWALL ISD
-UTILITY BILLING
-POST OFFICE


NOTES:
1. QUAIL RUN SHALL NOT BE CLOSED UNTIL HAYS ROAD, MEMORIAL DRIVE, AND MONTROSE DRIVE ARE OPEN FOR TRAFFIC.
2. ALL IMPROVEMENTS ALONG THE DETOUR ROUTE TO BE USED MUST BE FINAL ACCEPTED BY THE CITY OF ROCKWALL BEFORE THE DETOUR ROUTE CAN BE OPENED TO TRAFFIC.

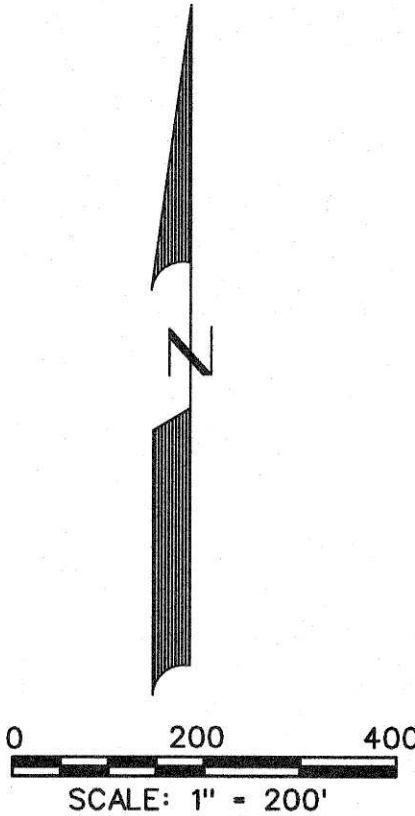

| | | | |
|--|--------------|------------|-----------|
|  CORWIN ENGINEERING, INC. 200 W. BELMONT, SUITE E ALLEN, TEXAS 75013 (972)396-1200 TBPE FIRM #5951 | | | |
| DEVELOPMENT PLANS FOR STONE CREEK PHASE VIII ROCKWALL, TEXAS | | | |
| PHASE 2 DETOUR PLAN QUAIL RUN CLOSURE | | | |
| DRAWN BY | DESIGNED BY | CHECKED BY | SHEET NO. |
| JOB NUMBER | DATE | SCALE: | 31 OF 32 |
| 18044 | OCTOBER 2016 | 1"=200' | |


AS-BUILT SEPTEMBER 2018
INFORMATION PROVIDED
BY CONTRACTORS
(NOT FIELD VERIFIED)



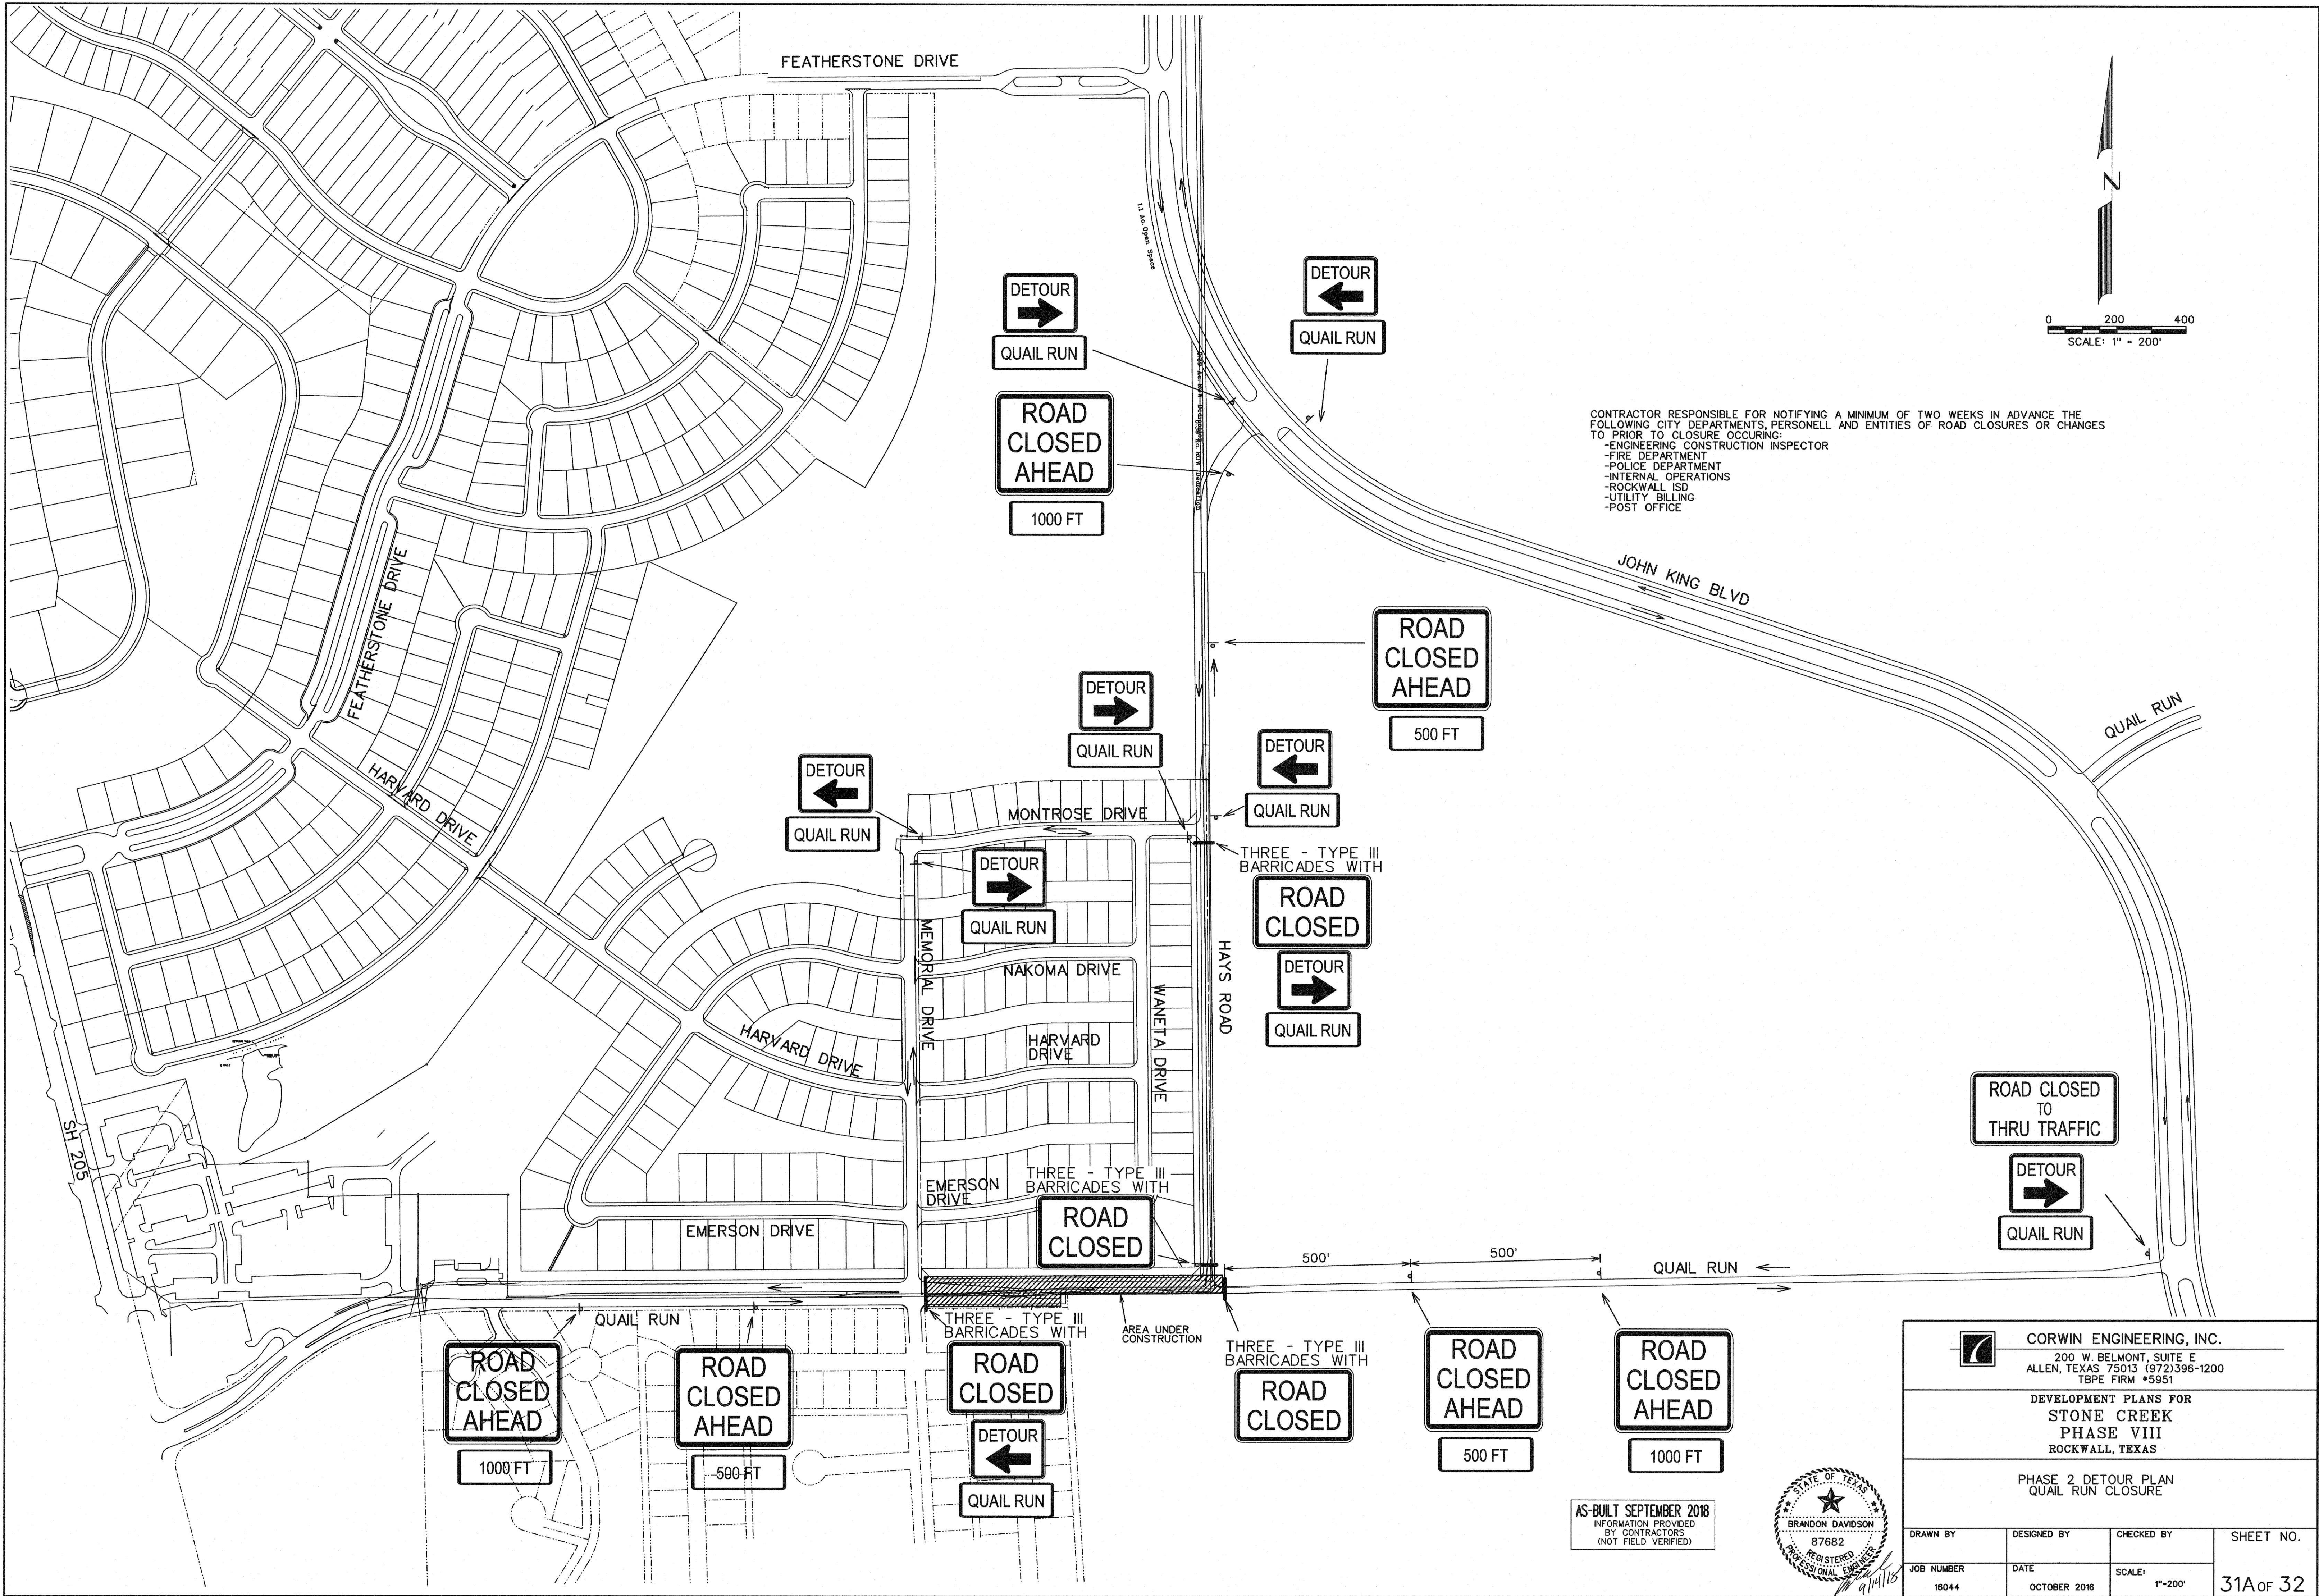

CONTRACTOR RESPONSIBLE FOR NOTIFYING A MINIMUM OF TWO WEEKS IN ADVANCE THE FOLLOWING CITY DEPARTMENTS, PERSONELL AND ENTITIES OF ROAD CLOSURES OR CHANGES TO PRIOR TO CLOSURE OCCURING:
-ENGINEERING CONSTRUCTION INSPECTOR
-FIRE DEPARTMENT
-POLICE DEPARTMENT
-INTERNAL OPERATIONS
-ROCKWALL ISD
-UTILITY BILLING
-POST OFFICE

ROAD CLOSED
TO
THRU TRAFFIC
DETOUR
QUAIL RUN

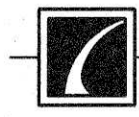

CORWIN ENGINEERING, INC.
200 W. BELMONT, SUITE E
ALLEN, TEXAS 75013 (972)396-1200
TBPE FIRM #5951



**DEVELOPMENT PLANS FOR
STONE CREEK
PHASE VIII
ROCKWALL, TEXAS**

**PHASE 2 DETOUR PLAN
QUAIL RUN CLOSURE**

| | | | |
|------------|--------------|------------|-----------|
| DRAWN BY | DESIGNED BY | CHECKED BY | SHEET NO. |
| JOB NUMBER | DATE | SCALE: | |
| 16044 | OCTOBER 2016 | 1"=200' | 31A of 32 |



AS-BUILT SEPTEMBER 2018
INFORMATION PROVIDED
BY CONTRACTORS
(NOT FIELD VERIFIED)

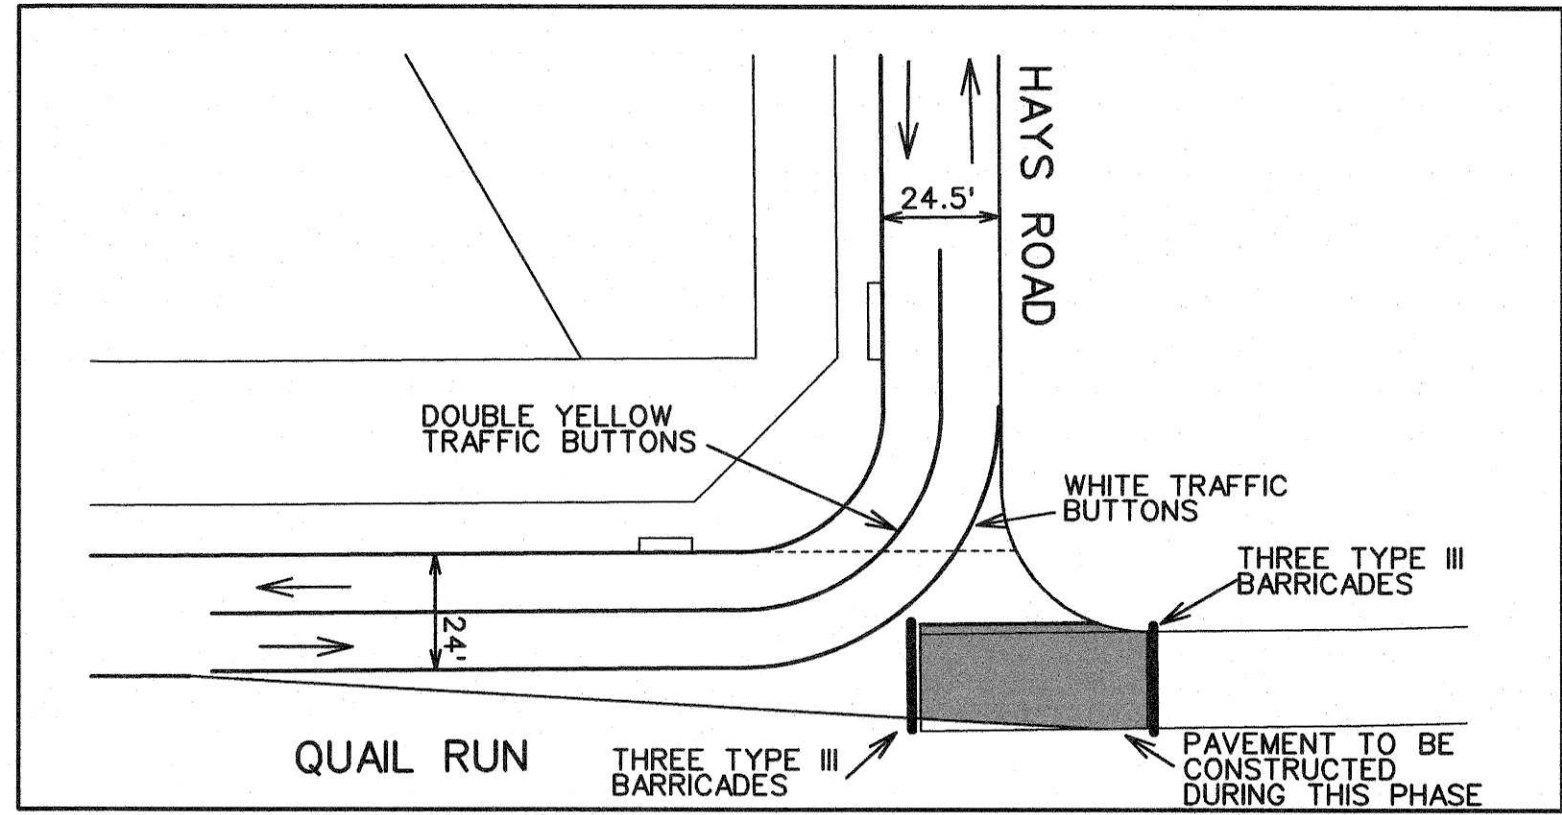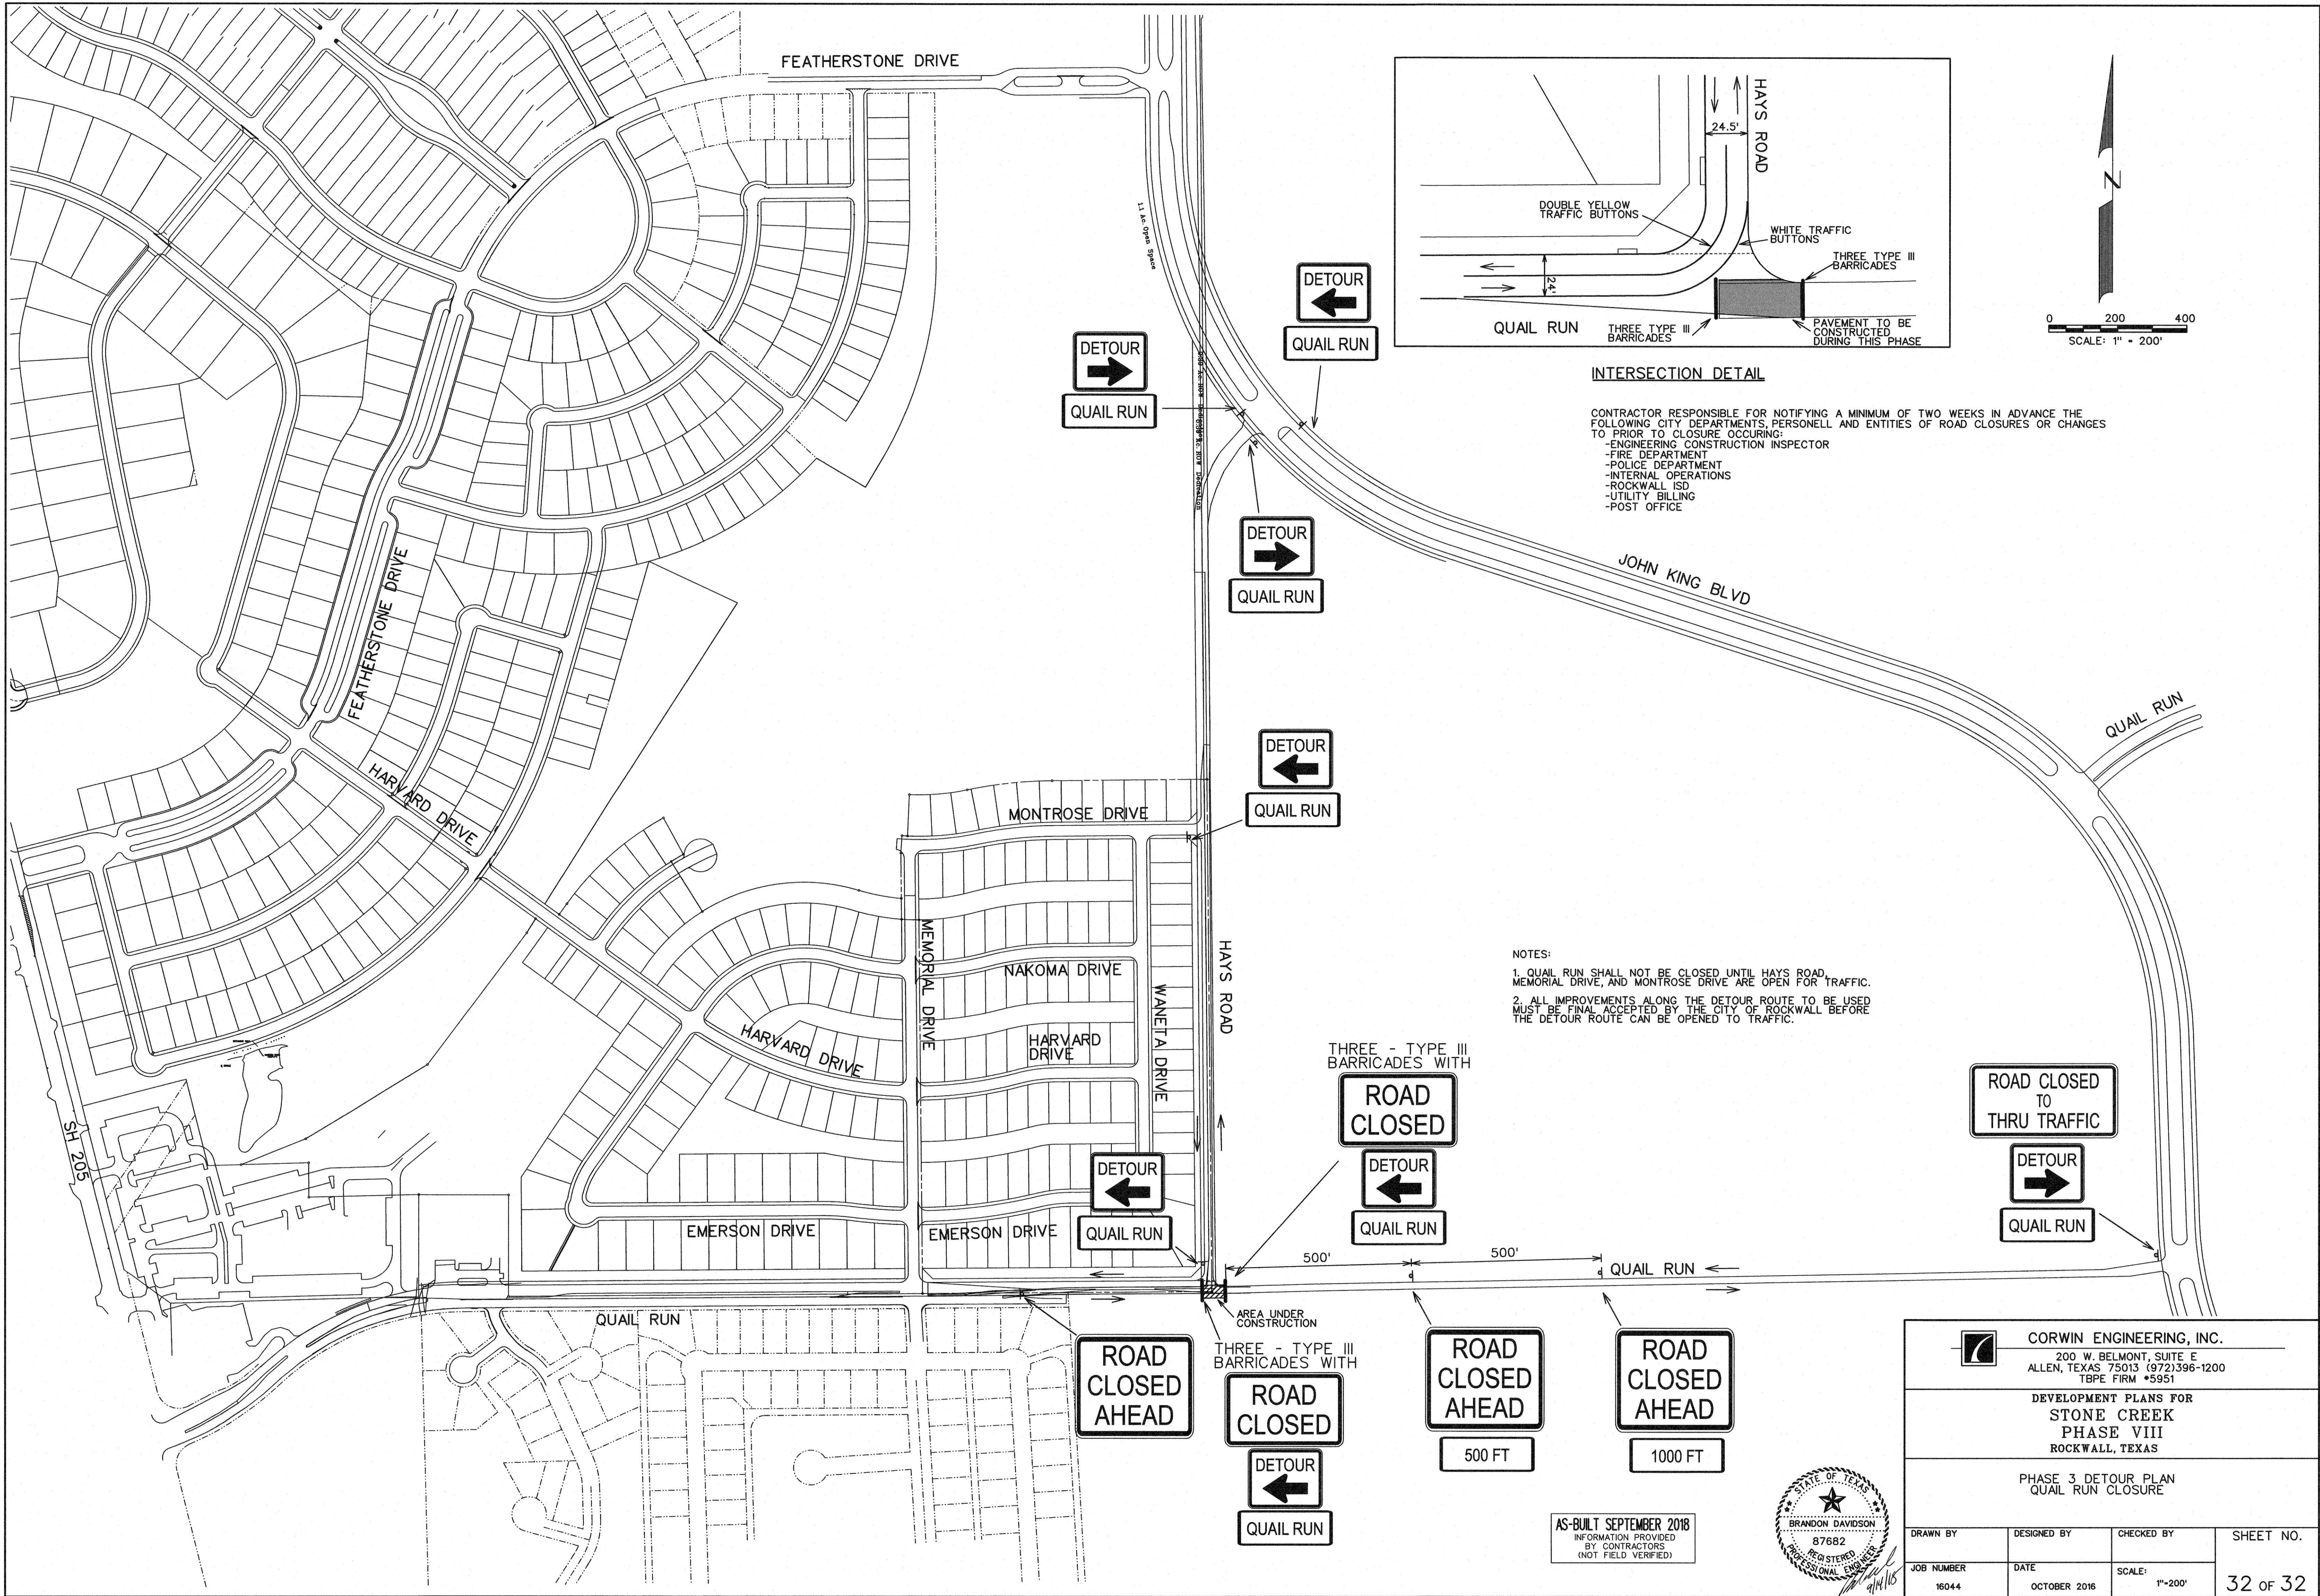

INTERSECTION DETAIL

CONTRACTOR RESPONSIBLE FOR NOTIFYING A MINIMUM OF TWO WEEKS IN ADVANCE THE FOLLOWING CITY DEPARTMENTS, PERSONELL AND ENTITIES OF ROAD CLOSURES OR CHANGES TO PRIOR TO CLOSURE OCCURRING:
-ENGINEERING CONSTRUCTION INSPECTOR
-FIRE DEPARTMENT
-POLICE DEPARTMENT
-INTERNAL OPERATIONS
-ROCKWALL ISD
-UTILITY BILLING
-POST OFFICE

NOTES:
1. QUAIL RUN SHALL NOT BE CLOSED UNTIL HAYS ROAD, MEMORIAL DRIVE, AND MONTROSE DRIVE ARE OPEN FOR TRAFFIC.
2. ALL IMPROVEMENTS ALONG THE DETOUR ROUTE TO BE USED MUST BE FINAL ACCEPTED BY THE CITY OF ROCKWALL BEFORE THE DETOUR ROUTE CAN BE OPENED TO TRAFFIC.

THREE - TYPE III BARRICADES WITH

ROAD CLOSED

DETOUR

QUAIL RUN

500'

500'

QUAIL RUN

AREA UNDER CONSTRUCTION
THREE - TYPE III BARRICADES WITH

ROAD CLOSED

DETOUR

QUAIL RUN


ROAD CLOSED AHEAD

500 FT

ROAD CLOSED AHEAD

1000 FT

AS-BUILT SEPTEMBER 2018
INFORMATION PROVIDED
BY CONTRACTORS
(NOT FIELD VERIFIED)

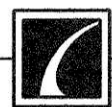

CORWIN ENGINEERING, INC.
200 W. BELMONT, SUITE E
ALLEN, TEXAS 75013 (972)396-1200
TPE FIRM #5951

DEVELOPMENT PLANS FOR
STONE CREEK
PHASE VIII
ROCKWALL, TEXAS

PHASE 3 DETOUR PLAN
QUAIL RUN CLOSURE

| | | | |
|---------------------|----------------------|-------------------|-----------|
| DRAWN BY | DESIGNED BY | CHECKED BY | SHEET NO. |
| JOB NUMBER 16044 | DATE OCTOBER 2016 | SCALE: 1"=200' | 32 OF 32 |