



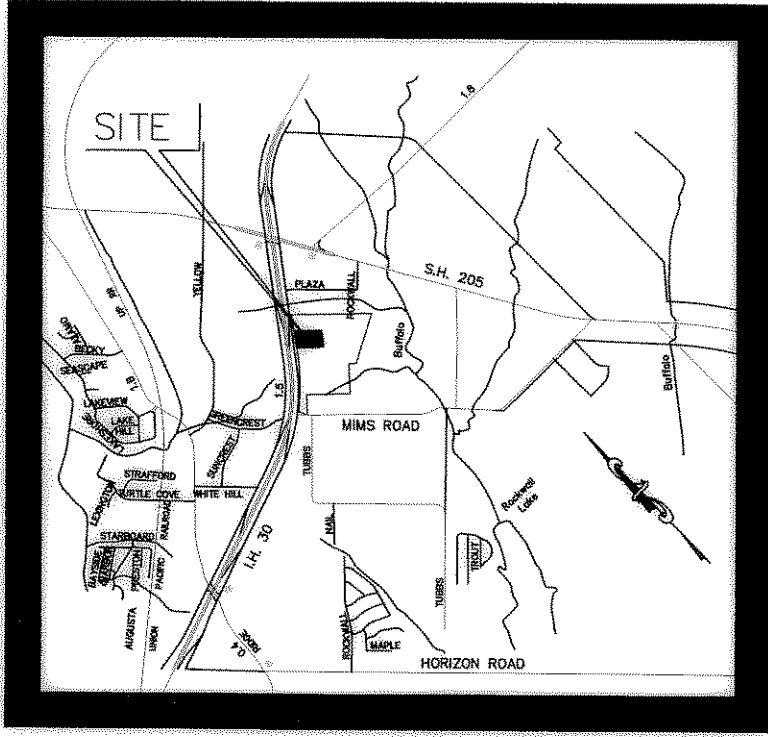


VICINITY MAP

LINE : "A"

$Q_{100}=6.00$ cfs
 $Q_c=10.78$ cfs
 $V=3.26$ fps
 $S=0.301$

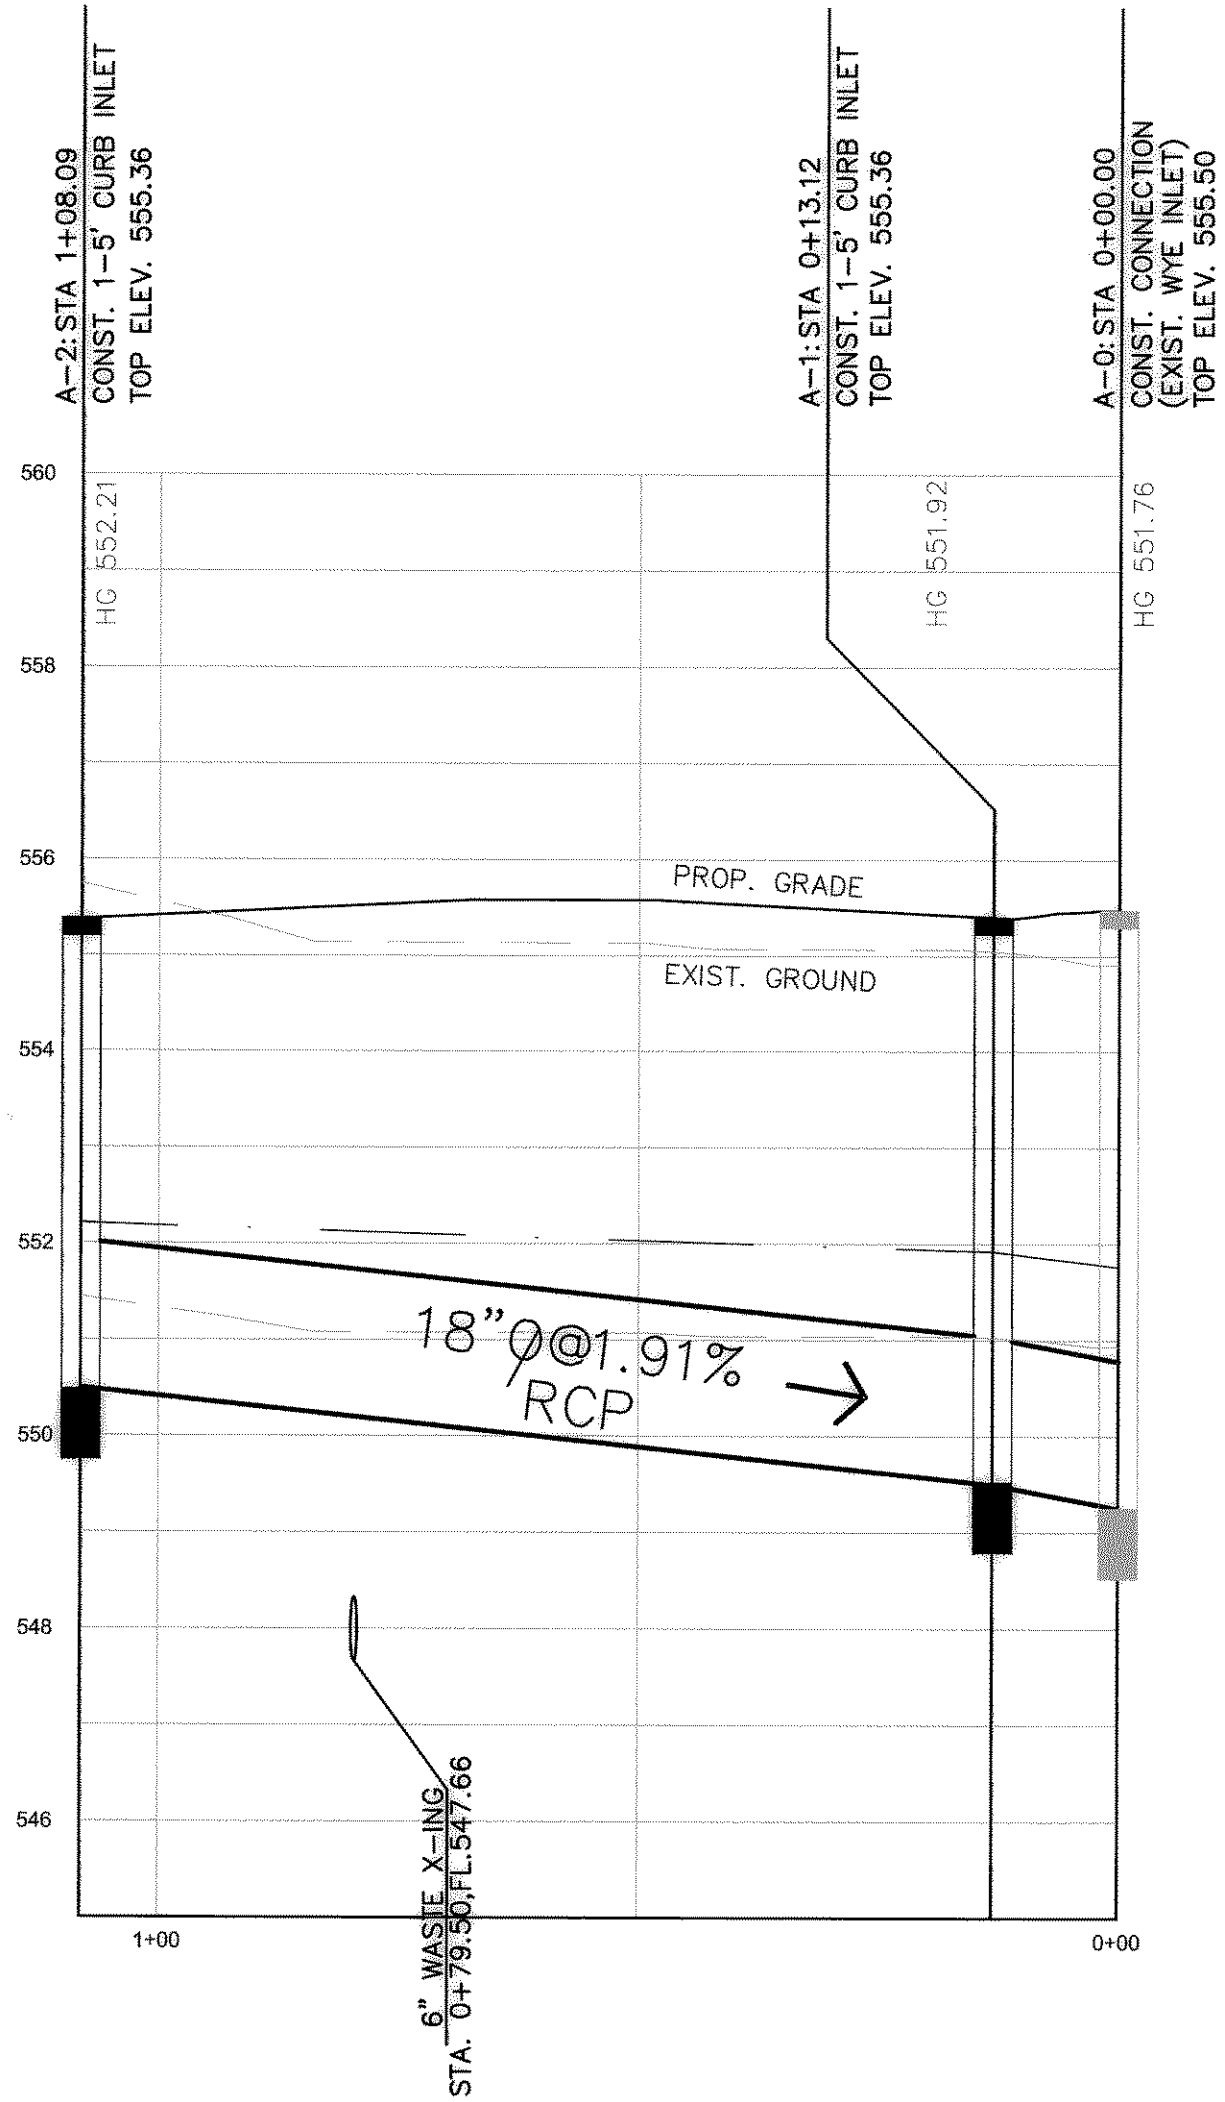

$Q_{100}=11.73$ cfs
 $Q_c=14.50$ cfs
 $V=6.60$ fps
 $S=1.233$

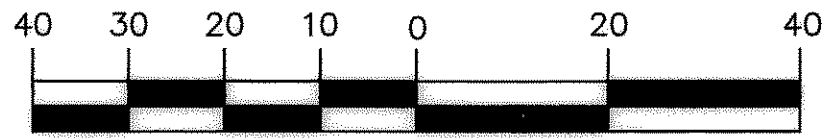

(GRAPHIC SCALE IN FEET)
(1" = 20 FEET H)
(1" = 2 FEET V)

GENERAL NOTES

1. ALL STORM WATER PIPES MUST BE RCP UNLESS NOTED OTHERWISE.

BENCHMARKS

B.M. = SQUARE CUT TOP OF CURB CENTER OF CURB INLET N. SIDE OF RALPH HALL PKWY. & 325'± EAST OF MIMS ROAD (45'± W. OF W. PROPERTY LINE)
ELEV = 549.34


B.M. = SQUARE CUT TOP OF CURB CENTER OF CURB INLET N. SIDE OF RALPH HALL PKWY. & 1530'± EAST OF MIMS ROAD (65'± W. OF E. PROPERTY LINE)
ELEV = 540.41

B.M. = SQUARE CUT ON CONC. BASE OF OVERHEAD SIGN, 161'± N. OF N. EDGE OF I.H. 30 EASTBOUND SERVICE ROAD & 1600'± W. OF MIMS RD. (82'± W. OF E. PROPERTY LINE)
ELEV = 564.23

B.M. = CITY OF ROCKWALL MONUMENT "R07" - BRASS DISK IN CONC., 47'± S. OF CENTERLINE OF I.H. 30 EASTBOUND SERVICE RD. & 105'± E. OF CENTERLINE OF MIMS RD.
ELEV = 566.31

RECORD DRAWING

THIS DRAWING HAS BEEN REVISED TO REFLECT CONSTRUCTION RECORDS MAINTAINED AND PROVIDED BY THE CONTRACTOR FOR THIS PROJECT.
DATE: 11-2-05

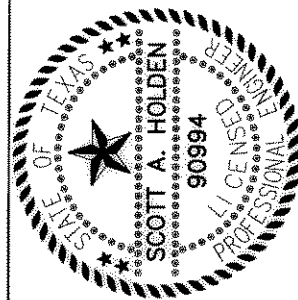

THE SEAL APPEARING ON THIS DOCUMENT WAS AUTHORIZED BY SCOTT A. HOLDEN TEXAS P.E. NO. 90994 ON 11/2/05

DOUPHRADE & ASSOCIATES, INC.
ENGINEERING - PROJECT MANAGEMENT - SURVEYING
2235 RIDGE RD., # 200 ROCKWALL, TEXAS 75087
PHONE: (972)771-9004 FAX: (972)771-9005

STORM PROFILE
T.G.I. FRIDAY'S
1.41 AC.

CITY OF ROCKWALL, ROCKWALL COUNTY, TEXAS

REVISION

S.A.H.
CHECKED

Y.B.
DRAWN

01/15/05
DATE

0429
PROJECT

7.2
OF
21