



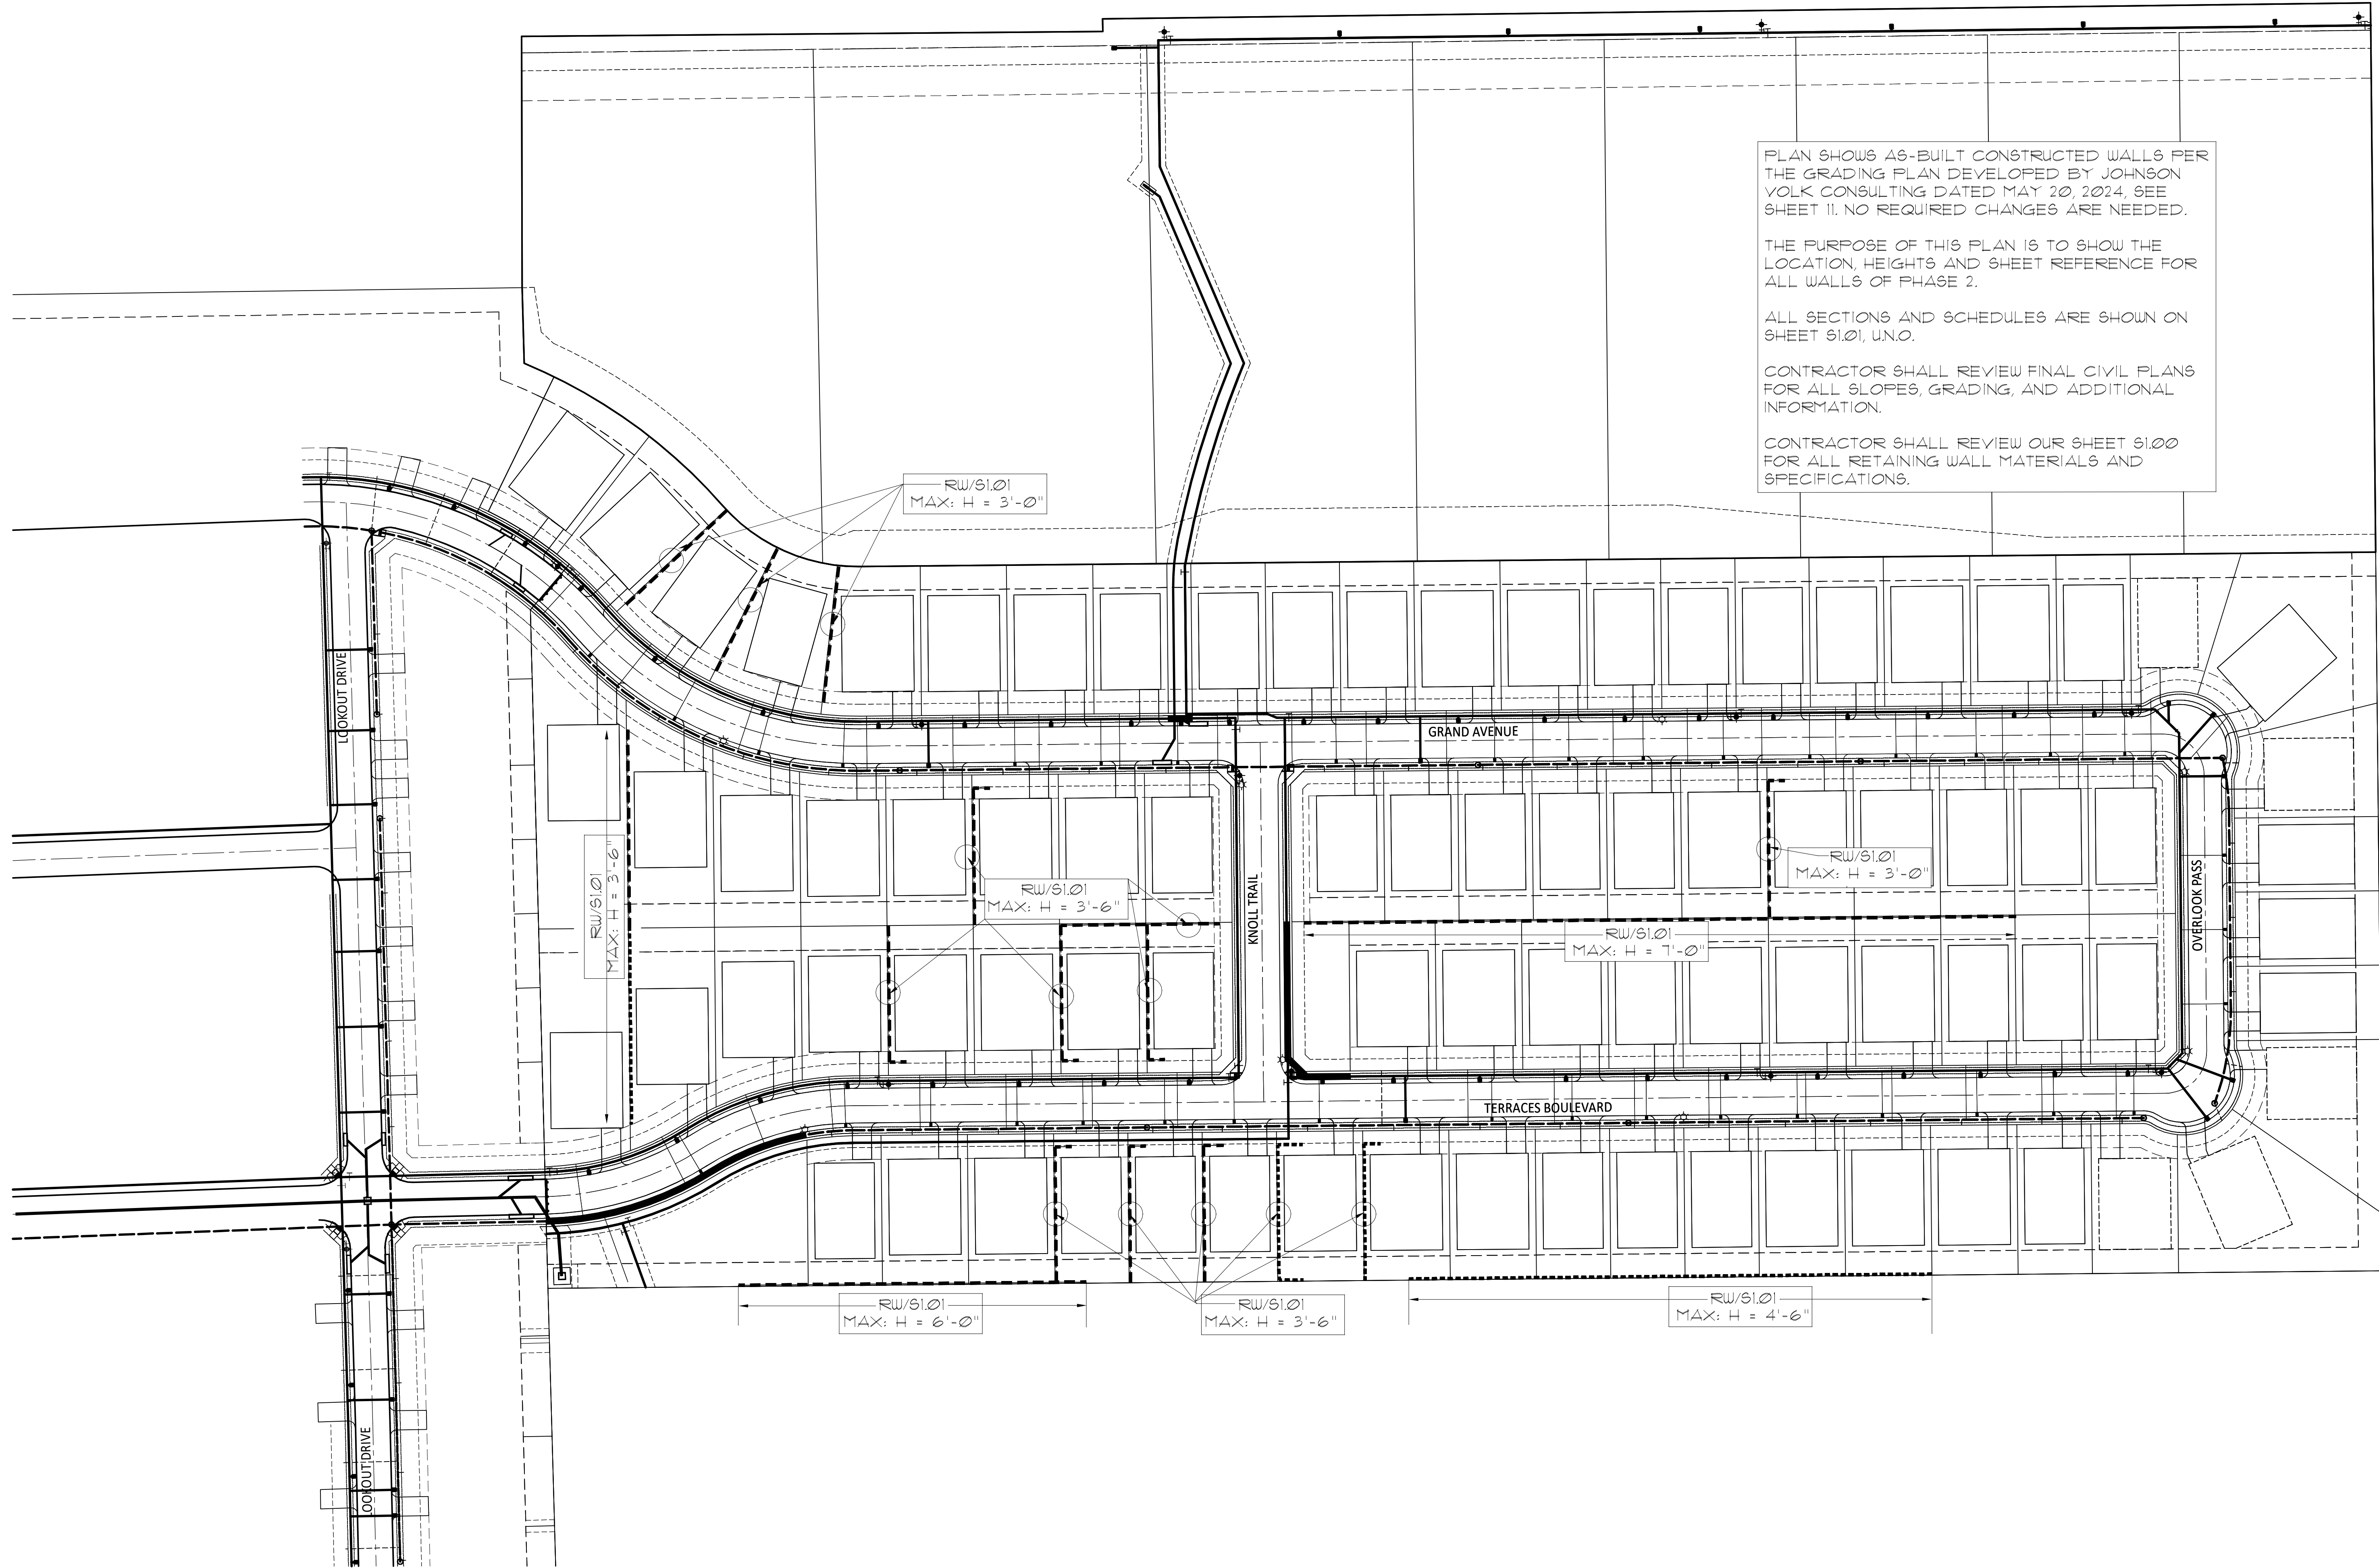

REVISIONS

THE ENGINEERS SEAL ON THIS PLAN WAS ELECTRONICALLY AFFIXED BY LOKI KOTTICAMP REGISTRATION NO. 93691 ON AUGUST 7, 2025.

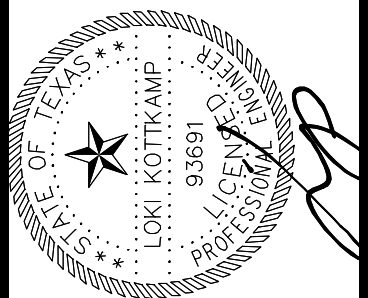

D&E STRUCTURES
CONSULTING ENGINEERS
TX FIRM REG. #F-870

1010 E. ARAPHO ROAD, SUITE 106
RICHARDSON, TX 75081 214-741-3095

WALCO RETAINING WALLS, INC.
TERRACES, PH. 2
ROCKWALL, TEXAS
PLAN: STANDARD RW NOTES AND DETAILS
OFF LOOKOUT DRIVE

JOB #
300569-7
DATE
08/7/25
DRAWN BY

CHECKED BY
LK

SHEET
S1.03