

Development Plans


TOWNEPLACE

SUITES

MARRIOTT

908 E. Interstate 30, Rockwall, TX 75087

City of Rockwall ~ Rockwall County, Texas

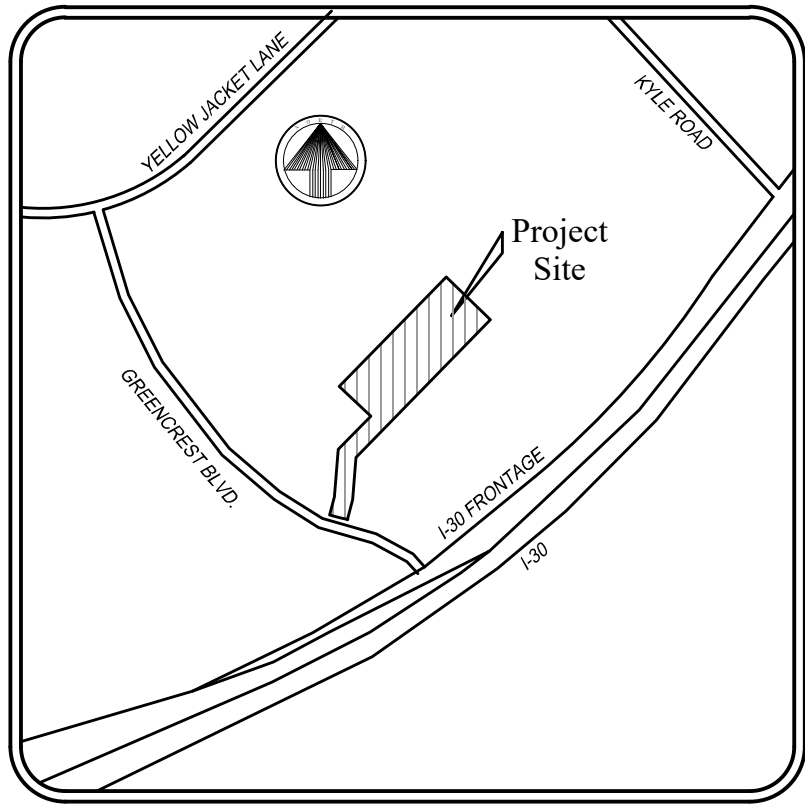

LOCATION MAP

Index of Sheets

Sheet No.	Title
1	Cover Sheet
--	Replat
2	Demolition Plan
3	Erosion Control Plan
4	Site Plan
5	Paving Plan
6	Grading Plan
7	Pre Developed Drainage Area Map
8	Post Developed Drainage Area Map
9-9A	Storm Sewer Plan and Storm Line Calculations
10	Storm Sewer Profiles
11-11a	Detention Pond Plan
--	Underground Detention Pond Details
12a-d	Detention Pond Calculations
13	Utility Plan
14	Sanitary Sewer Line Profile
--	Landscape Plans

Construction Note

All construction to be by City of Rockwall Standards and NCTCOG 4th Edition Standards.

Owner:
Greencrest TPS Hotel, L.P.
3021 Ridge Road, A-120
Rockwall, TX 75032


Engineer:
F.C. Cuny Corp.
#2 Horizon Court
Suite 500
Heath, Texas 75032
469.402.7700
Texas Registered Engineering Firm F-7449



RECORD DRAWINGS

December 2021

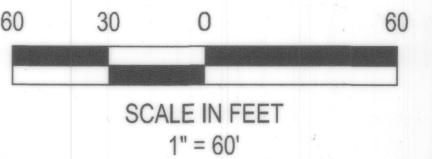

**LEGEND**

(C.M.) - CONTROLLING MONUMENT
 IRF - IRON ROD FOUND
 CIRF - CAPPED IRON ROD FOUND
 INST. - INSTRUMENT
 CAB. - CABINET
 VOL. - VOLUME
 NO. - NUMBER
 PG. - PAGE
 D.R.R.C.T. - DEED RECORDS ROCKWALL COUNTY, TEXAS
 P.R.R.C.T. - PLAT RECORDS ROCKWALL COUNTY TEXAS
 O.P.R.R.C.T. - OFFICIAL PUBLIC RECORDS ROCKWALL COUNTY TEXAS

GENERAL NOTES:

- BEARINGS ARE REFERENCED TO GRID NORTH OF THE TEXAS COORDINATE SYSTEM OF 1983 (NORTH CENTRAL ZONE 4202; NAD83(2011) EPOCH 2010) AS DERIVED LOCALLY FROM WESTERN DATA SYSTEMS CONTINUOUSLY OPERATING REFERENCE STATIONS (CORS) VIA REAL TIME KINEMATIC (RTK) SURVEY METHODS. ALL DISTANCES SHOWN ARE SURFACE DISTANCES USING A COMBINED SCALE FACTOR OF 1.000146135.
- BY GRAPHIC SCALE ONLY AND PER THE NATIONAL FLOOD INSURANCE PROGRAM FLOOD INSURANCE RATE MAP FOR ROCKWALL COUNTY, TEXAS AND INCORPORATED AREAS, MAP NO. 4839/C0040L, EFFECTIVE DATE: SEPTEMBER 26, 2008, THE SUBJECT PROPERTY IS SHOWN TO BE LOCATED IN "ZONE X". THE LOCATION OF THE SAID FLOOD ZONES IS BASED ON SAID MAP AND IS APPROXIMATE AND IS NOT LOCATED ON THE GROUND. THIS STATEMENT SHALL NOT CREATE LIABILITY ON THE PART OF THE SURVEYOR. RELEVANT ZONES ARE DEFINED AS FOLLOWS
- THE SURVEYOR, AS REQUIRED BY STATE LAW, IS RESPONSIBLE FOR SURVEYING INFORMATION ONLY AND BEARS NO RESPONSIBILITY FOR THE ACCURACY OF THE ENGINEERING DATA ON THIS PLAT.
- THE SURVEYOR HAS MADE NO INVESTIGATION OR INDEPENDENT SEARCH FOR EASEMENTS, ENCUMBRANCES, OR ANY OTHER FACTS THAT AN ACCURATE AND CURRENT TITLE SEARCH MAY DISCLOSE.
- ALL CORNERS ARE A 5/8" IRON ROD WITH CAP STAMPED "TNP" UNLESS OTHERWISE SHOWN.
- COORDINATES SHOWN ARE GRID VALUES REFERENCED TO THE CITY OF ROCKWALL GPS MONUMENT NETWORK.
- IT SHALL BE THE POLICY OF THE CITY OF ROCKWALL TO WITHHOLD ISSUING BUILDING PERMITS UNTIL ALL STREETS, WATER, SEWER, AND STORM DRAINAGE SYSTEMS HAVE BEEN ACCEPTED BY THE CITY. THE APPROVAL OF THE PLAT BY THE CITY DOES NOT CONSTITUTE ANY REPRESENTATION, ASSURANCE OR GUARANTEE THAT ANY BUILDING WITHIN SUCH PLAT SHALL BE APPROVED, AUTHORIZE OR PERMIT THEREFORE ISSUED NOR SHALL SUCH APPROVAL CONSTITUTE ANY REPRESENTATION, ASSURANCE OR GUARANTEE BY THE CITY OF THE ADEQUACY AND AVAILABILITY FOR WATER FOR PERSONAL USE AND FIRE PROTECTION WITHIN SUCH PLAT, AS REQUIRED UNDER ORDINANCE 83-54.

FINAL PLAT
TOWN PLACE MARRIOTT ADDITION
LOT 1, LOT 2, AND LOT 3, BLOCK B
3 LOTS

8.715 ACRES OR 379,622 SQUARE FEET
 SITUATED IN THE JD MCFARLAND SURVEY, ABSTRACT NO. 145
 CITY OF ROCKWALL, ROCKWALL COUNTY, TEXAS

BOUNDARY CURVE TABLE				
CURVE #	RADIUS	DELTA	ARC LENGTH	CHORD BEARING
C1	3669.86'	6°24'58"	410.95'	S 48°33'37" W
C2	485.00'	20°36'28"	174.44'	N 73°10'49" W
C3	415.00'	23°57'39"	173.55'	N 71°09'06" W
C4	1493.00'	7°12'39"	187.90'	N 55°47'35" W

LOT LINE TABLE		
LINE #	BEARING	LENGTH
L1	S14°11'02" W	67.86'
L2	N14°11'02" E	63.09'

EASEMENT LINE TABLE		
LINE #	BEARING	LENGTH
L1	N16°15'08" E	18.13'
L2	S44°12'34" W	602.01'
L3	N44°12'34" E	29.10'
L4	S45°47'26" E	24.00'
L5	S44°12'34" W	29.10'
L6	S45°47'26" E	23.00'
L7	S44°12'34" W	24.00'
L8	N45°47'26" W	105.78'
L9	N44°12'20" E	32.01'
L10	N44°12'20" E	69.49'
L11	S45°47'26" E	12.34'
L12	N45°47'26" W	3.23'
L13	N45°47'26" E	3.23'
L14	N45°47'26" W	20.48'
L15	N44°12'34" E	181.04'
L16	N44°12'34" E	330.57'
L17	N04°14'54" E	120.92'
L18	N85°45'06" W	16.97'
L19	N62°07'53" E	40.06'
L20	N85°45'06" W	16.76'
L21	N13°35'46" E	41.58'
L22	N33°49'29" W	40.04'
L23	N64°53'31" W	156.13'
L24	N77°40'28" W	9.60'
L25	N56°28'57" W	14.65'
L26	N33°31'03" E	20.00'
L27	S66°28'57" E	18.43'
L28	S66°28'57" E	31.67'
L29	N46°50'36" E	115.80'

EASEMENT LINE TABLE		
LINE #	BEARING	LENGTH
L28	S43°09'24" E	20.00'
L29	S46°50'36" W	131.61'
L30	N56°28'57" W	45.31'
L31	N55°46'44" E	70.63'
L32	N51°48'40" E	55.14'
L33	S45°47'26" E	11.26'
L34	S42°22'47" W	124.20'
L35	N48°51'59" W	26.98'
L36	S45°47'26" E	21.02'
L37	S43°21'50" W	20.00'
L38	N45°47'26" W	21.32'
L39	N44°12'34" E	6.00'
L40	N45°47'26" W	20.81'
L41	N45°47'26" W	29.00'
L42	N44°12'34" E	204.26'
L43	S45°47'26" E	15.76'
L44	S44°12'34" W	190.58'
L45	S46°20'06" E	34.00'
L46	S89°13'48" W	20.12'
L47	S45°26'03" E	10.00'
L48	S44°12'34" W	18.23'
L49	N89°12'34" E	34.27'
L50	N44°12'34" E	89.09'
L51	S45°47'26" E	67.95'
L52	S45°47'26" E	20.23'
L53	S45°47'26" E	20.23'
L54	S44°12'34" W	23.13'
L55	S45°47'26" E	20.00'
L56	N44°12'34" E	23.13'
L57	S44°12'34" W	23.13'

EASEMENT LINE TABLE		
LINE #	BEARING	LENGTH
L58	S45°47'26" E	20.00'
L59	N44°12'34" E	21.08'
L60	N45°47'26" W	56.53'
L61	N45°47'26" W	56.20'
L62	N44°12'34" E	6.81'
L63	N04°14'54" E	118.65'
L64	S45°47'26" E	27.15'
L65	S45°47'26" E	20.00'
L66	S45°47'26" E	225.76'
L67	N45°25'18" W	71.61'
L68	S44°39'11" W	24.26'
L69	N45°25'18" W	375.33'
L70	S89°12'34" W	41.50'
L71	S44°12'34" W	55.53'
L72	N45°47'26" W	39.25'
L73	S44°12'34" W	10.00'
L74	N45°47'26" W	20.00'
L75	N44°12'34" E	20.00'
L76	S45°47'26" E	20.00'
L77	S44°12'34" W	80.81'
L78	N89°12'34" E	49.82'
L79	S45°25'18" E	379.65'

EASEMENT CURVE TABLE				
CURVE #	RADIUS	DELTA	ARC LENGTH	CHORD BEARING
C1	490.00'	12°46'57"	109.32'	N 71°17'00" W
C2	18.00'	88°45'14"	27.88'	S 86°45'24" W
C3	226.50'	9°20'53"	36.95'	N 08°55'20" E
C4	190.00'	12°00'14"	39.81'	N 10°15'01" E
C5	27.00'	39°57'40"	18.83'	N 24°13'44" E
C6	25.00'	61°38'33"	26.90'	S 14°58'10" E
C7	25.00'	90°00'00"	39.27'	N 89°12'34" E
C8	25.00'	90°00'00"	39.27'	S 00°47'26" E
C9	45.00'	90°00'00"	70.69'	N 00°47'26" W
C10	20.00'	58°12'42"	20.32'	N 16°41'05" W
C11	20.00'	58°12'42"	20.32'	S 74°53'47" E
C12	30.00'	13°22'38"	7.00'	N 18°56'04" W
C13	60.00'	90°00'00"	94.25'	N 89°12'34" E
C15	18.00'	104°38'44"	32.88'	N 03°27'22" E
C16	13.00'	82°23'54"	18.70'	S 86°59'23" E
C17	13.00'	88°10'13"	20.01'	S 01°42'20" E
C18	80.00'	90°00'00"	125.66'	S 89°12'34" W
C19	90.00'	90°00'00"	141.37'	S 89°12'34" W

OWNER
 GREENCREST TPS HOTEL, LP.
 10000 North Central Expressway
 Suite 400
 Dallas, TX 75231


OWNER
 ROCKWALL RENTAL PROPERTIES L.P.
 P.O. Box B
 Terrell, TX. 75160

PROJECT INFORMATION
 Project No.: FCU 18061
 Date: October 2, 2019
 Drawn By: GS9
 Scale: 1"=60'
 SHEET 1 of 2



SURVEYOR
 TEAGUE NALL AND PERKINS, INC.
 825 Watters Creek Boulevard, Suite M300
 Allen, Texas 75013
 214.461.9867 ph 214.461.9864 fx
 T.B.P.L.S. Registration No. 10194381
 www.tnpinc.com

CASE NO. P2019-021

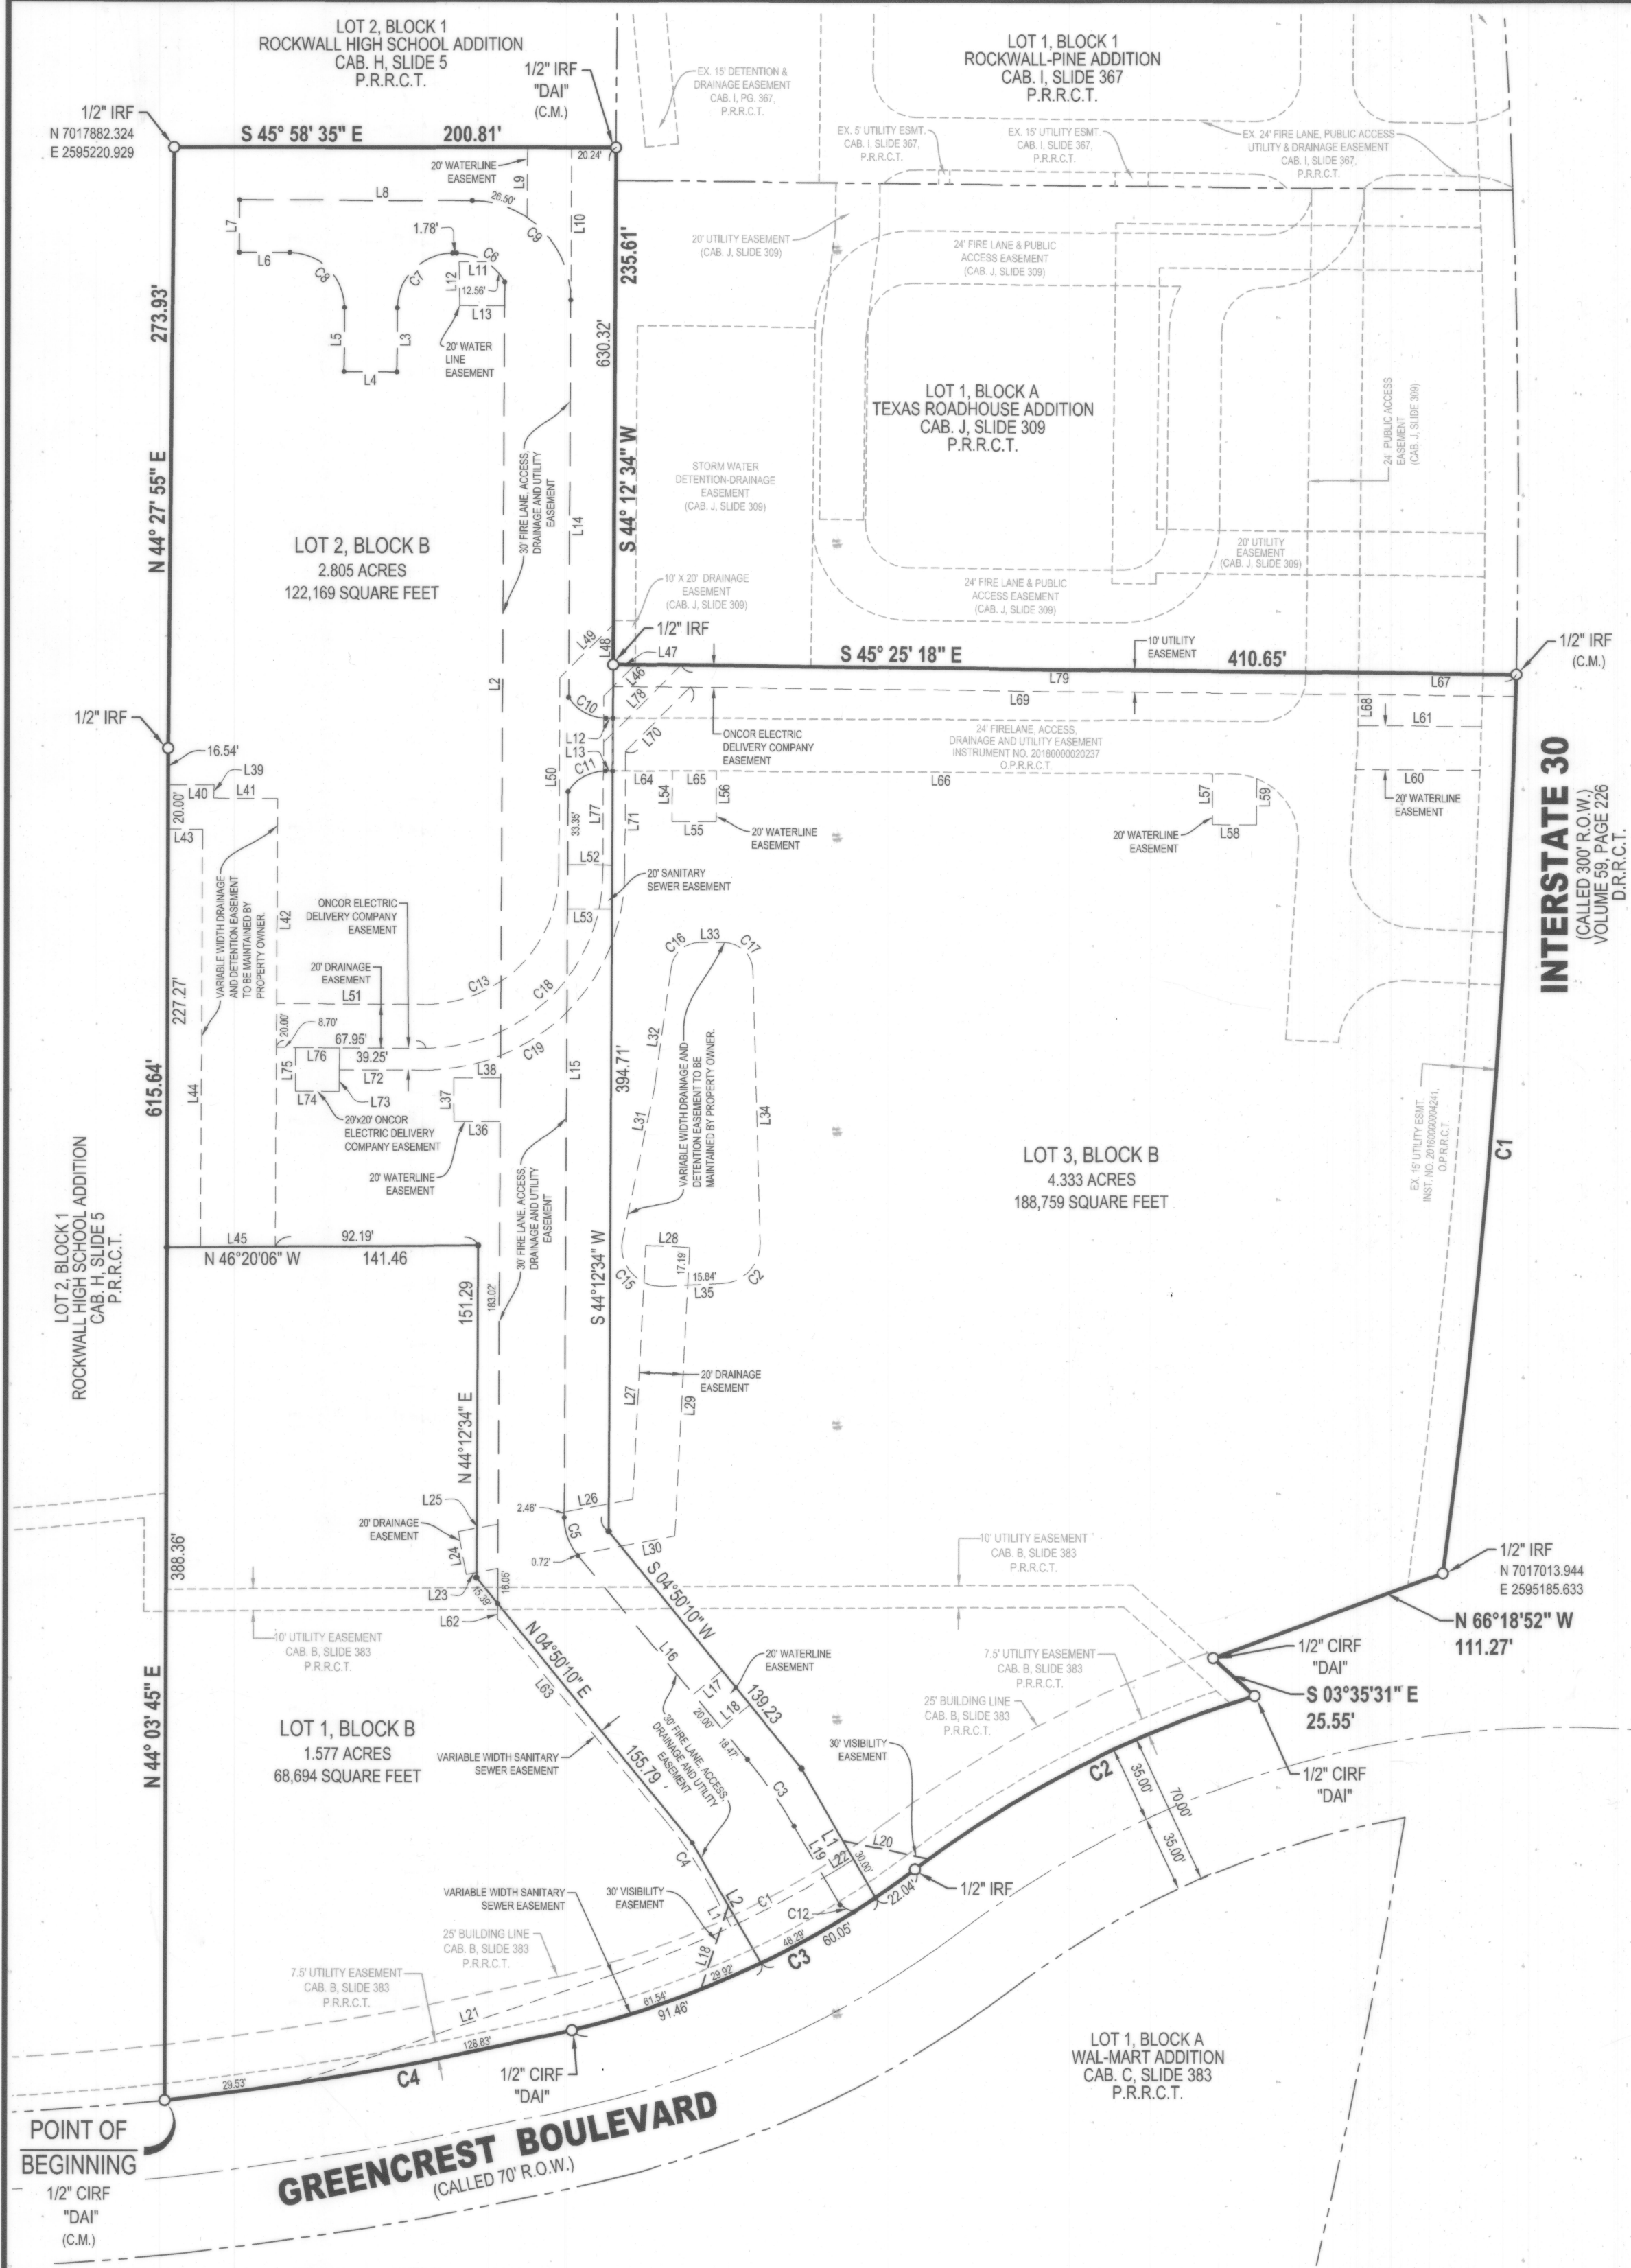

OWNERS CERTIFICATE

STATE OF TEXAS)
COUNTY OF ROCKWALL)

WHEREAS, Greencrest TPS Hotel, LP. and Rockwall Rental Properties, LP. are the owner's of a tract of land out of the J.D. McFarland Survey, Abstract Number 145 being a portion of Lot 1, Block B of Goldencrest Addition, an addition to the city of Rockwall as recorded in Cabinet B, Slide 383 of the Plat Records of Rockwall County, Texas, same being a portion of a called 14.45 acre tract of land described by deed to Rockwall Rental Properties, L.P. as recorded in Volume 4076, Page 48 of the Deed Records of Rockwall County, Texas, and all of a called 2.805 acre tract of land to Greencrest TPS Hotel, LP. as recorded in Instrument Number 20180000020236 of the Official Public Records of Rockwall County, Texas and being more particularly described as follows:

BEGINNING at a 1/2 inch iron rod with cap stamped "DAI" found for the south corner of Lot 2, Block 1 of Rockwall Highschool Addition, an addition to the City of Rockwall as recorded in Cabinet H, Slide 5 of the Plat Records of Rockwall County, Texas, said point also being the west corner of said 14.45 acre tract and lying on the northeast line of Greencrest Boulevard, a called 70.00 feet wide right-of-way;

THENCE North 44 degrees 03 minutes 45 seconds East along the southeast line of said Lot 2, a distance of 615.64 feet to a 1/2 inch iron rod found for corner;

THENCE North 44 degrees 27 minutes 55 seconds East continuing along the southeast line of said Lot 2, a distance of 273.93 feet to a 1/2 inch iron rod found for an inner ell corner of said Lot 2;

THENCE South 45 degrees 58 minutes 35 seconds East continuing along the southeast line of said Lot 2, a distance of 200.81 feet to a 1/2 inch iron rod with cap stamped "DAI" found for a south corner of same lying on the northwest line of Lot 1, Block 1 Rockwall Pine Addition, an addition to the City of Rockwall as recorded in Cabinet I, Slide 367 of the Plat Records of Rockwall County, Texas

THENCE South 44 degrees 12 minutes 34 seconds West along the northwest line of said Rockwall-Pine Addition, passing a 1/2 inch iron rod with cap stamped "ADAMS" found for the west corner of same, also for the north corner of Lot 1, Block A, Texas Roadhouse Addition, an addition to the City of Rockwall as recorded in Cabinet J, Slide 309 of the Plat Records of Rockwall County, Texas, and continuing along the northwest line of said Texas Roadhouse Addition, a total distance of 235.61 feet to a 1/2 inch iron rod found for the west corner of said Lot 1, Block A, Texas Roadhouse Addition;

THENCE South 45 degrees 25 minutes 18 seconds East along the southwest line of said Lot 1, Block A, Texas Roadhouse Addition, a distance of 410.65 feet to a 1/2 inch iron rod found for the south corner of same lying on the northwest right-of-way line of Interstate Highway No. 30 (a variable width right-of-way) at the beginning of a curve to the right;

THENCE with said curve to the right along the northwest right-of-way line of Interstate Highway No. 30 having a radius of 3669.86 feet, a central angle of 06 degrees 24 minutes 58 seconds, an arc length of 410.95 feet, a chord bearing of South 48 degrees 33 minutes 37 seconds West, a distance of 410.74 feet to a 1/2 inch iron rod found for corner on the northeast line of previously mentioned Greencrest Boulevard;

THENCE long the northeast line of said Greencrest Boulevard the following courses and distances;

North 66 degrees 18 minutes 52 seconds West, a distance of 111.27 feet to a 1/2 inch iron rod with cap stamped "DAI" found for corner;

South 03 degrees 35 minutes 31 seconds East, a distance of 25.55 feet to a 1/2 inch iron rod with cap stamped "DAI" found for corner at the beginning of a curve to the left;

With said curve to the left having a radius of 485.00 feet, a central angle of 20 degrees 36 minutes 28 seconds, an arc length of 174.44 feet, a chord bearing of North 73 degrees 10 minutes 49 seconds West, a distance of 173.50 feet to a 1/2 inch iron rod found for corner at the beginning of a reverse curve to the right;

With said reverse curve to the right having a radius of 415.00 feet, a central angle of 23 degrees 57 minutes 39 seconds, an arc length of 173.55 feet, a chord bearing of North 71 degrees 09 minutes 06 seconds West, a distance of 172.29 feet to a 1/2 inch iron rod with cap stamped "DAI" found for corner at the beginning of a compound curve continuing to the right;

With said compound curve continuing to the right having a radius of 1493.00 feet, a central angle of 07 degrees 12 minutes 39 seconds, an arc length of 187.90 feet, a chord bearing of North 55 degrees 47 minutes 35 seconds West, a distance of 187.77 feet to the POINT OF BEGINNING containing 379,622 square Feet, or 8.715 acres of land.

SURVEYOR'S CERTIFICATE


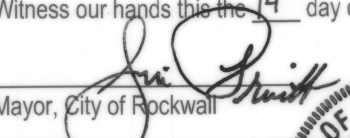

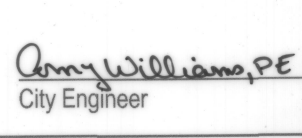
NOW, THEREFORE KNOW ALL MEN BY THESE PRESENTS:

THAT I, Brian J. Maddox, do hereby certify that I prepared this plat from an actual and accurate survey of the land, and that the corner monuments shown thereon were properly placed under my personal supervision.

GIVEN UNDER MY HAND AND SEAL OF OFFICE THIS 4th DAY OF October, 2019

Brian J. Maddox
BRIAN J. MADDOX, R.P.L.S. NO. 5430



 Planning & Zoning Commission, Chairman	<u>5/28/19</u> Date
APPROVED:	
I hereby certify that the above and foregoing plat of an addition to the City of Rockwall, Texas was approved by the City Council of the City of Rockwall on the <u>3</u> day of <u>June</u> , 2019.	
This approval shall be invalid unless the approved Plat for such Addition is recorded in the office of the County Clerk of Rockwall County, Texas, within one hundred eighty (180) days from said date of final approval.	
Witness our hands this <u>14th</u> day of <u>October</u> , 2019.	
 Mayor, City of Rockwall	 City Secretary
 City Engineer	



OWNERS DEDICATION

NOW, THEREFORE, KNOW ALL MEN BY THESE PRESENTS:

STATE OF TEXAS)
COUNTY OF ROCKWALL)

I the undersigned owner of the land shown on this plat, and designated herein as TOWN PLACE MARRIOTT ADDITION to the City of Rockwall, Texas, and whose name is subscribed hereto, hereby dedicate to the use of the public forever all streets, alleys, parks, water courses, drains, easements and public places thereon shown on the purpose and consideration therein expressed. I understand and do hereby reserve the easement strips shown on this plat for the purposes stated and for the mutual use and accommodation of all utilities desiring to use or using same. I also understand the following:

- No buildings shall be constructed or placed upon, over, or across the utility easements as described herein.
- Any public utility shall have the right to remove and keep removed all or part of any buildings, fences, trees, shrubs, or other growths or improvements which in any way endanger or interfere with construction, maintenance or efficiency of their respective system on any of these easement strips; and any public utility shall at all times have the right of ingress or egress to, from and upon the said easement strips for purpose of construction, reconstruction, inspecting, patrolling, maintaining, and either adding to or removing all or part of their respective system without the necessity of, at any time, procuring the permission of anyone.
- The City of Rockwall will not be responsible for any claims of any nature resulting from or occasioned by the establishment of grade of streets in the subdivision.
- The developer and subdivision engineer shall bear total responsibility for storm drain improvements.
- The developer shall be responsible for the necessary facilities to provide drainage patterns and drainage controls such that properties within the drainage area are not adversely affected by storm drainage from the development.
- Drainage/Retention Easements/Facilities shall be owned, operated, maintained and repaired by property owner.
- No house dwelling unit, or other structure shall be constructed on any lot in this addition by the owner or any other person until the developer and/or owner has complied with all requirements of the Subdivision Regulations of the City of Rockwall regarding improvements with respect to the entire block on the street or streets on which property abuts, including the actual installation of streets with the required base and paving, curb and gutter, water and sewer, drainage structures, storm structures, storm sewers, and alleys, all according to the specifications of the City of Rockwall; or until an escrow deposit, sufficient to pay for the cost of such improvements, as determined by the city's engineer and/or city administrator, computed on a private commercial rate basis, has been made with the city secretary, accompanied by an agreement signed by the developer and/or owner, authorizing the city to make such improvements at prevailing private commercial rates, or have the same made by a contractor and pay for the same out of the escrow deposit, should the developer and/or owner fail or refuse to install the required improvements within the time stated in such written agreement, but in no case shall the City be obligated to make such improvements itself. Such deposit may be used by the owner and/or developer as progress payments as the work progresses in making such improvements by making certified requisitions to the city secretary, supported by evidence of work done; or until the developer and/or owner files a corporate surety bond with the city secretary in a sum equal to the cost of such improvements for the designated area, guaranteeing the installation thereof within the time stated in the bond, which time shall be fixed by the city council of the City of Rockwall.

We further acknowledge that the dedications and/or exaction's made herein are proportional to the impact of the Addition upon the public services required in order that the development will comport with the present and future growth needs of the City; we, our successors and assigns hereby waive any claim, damage, or cause of action that we may have as a result of the dedication of exactions made herein.

ROCKWALL RENTAL PROPERTIES, LP


Randall H. Noe
Representative:

STATE OF TEXAS)
COUNTY OF ROCKWALL)

Before me, the undersigned authority, on this day personally appeared Randall H. Noe, known to me to be the person whose name is subscribed to the foregoing instrument, and acknowledged to me that he executed the same for the purpose and consideration therein stated. Given upon my hand and seal of office this 7 day of October, 2019.

Jasmine Galan
Notary Public in and for the State of Texas

11/31/22
My Commission Expires:

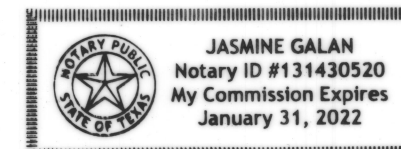

GREENCREST TPS HOTEL, LP.


Thomas E. Kirkland
Representative:

STATE OF TEXAS)
COUNTY OF ROCKWALL)

Before me, the undersigned authority, on this day personally appeared Thomas E. Kirkland, known to me to be the person whose name is subscribed to the foregoing instrument, and acknowledged to me that he executed the same for the purpose and consideration therein stated. Given upon my hand and seal of office this 7 day of October, 2019.

Jasmine Galan
Notary Public in and for the State of Texas

11/31/22
My Commission Expires:

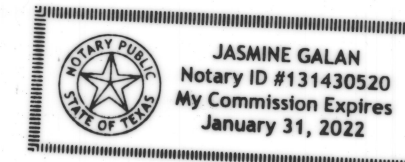

Filed and Recorded
Official Public Records
Shelli Miller, County Clerk
Rockwall County, Texas
10/28/2019 08:41:42 AM
\$100.00
20190000019144



Shelli Miller

OWNER
GREENCREST TPS HOTEL, LP.
10000 North Central Expressway
Suite 400
Dallas, TX 75231

OWNER
ROCKWALL RENTAL PROPERTIES L.P.
P.O. Box. B
Terrell, TX. 75160

CASE NO. P2019-021

FINAL PLAT TOWN PLACE MARRIOTT ADDITION LOT 1, LOT 2, AND LOT 3, BLOCK B 3 LOTS

8.715 ACRES OR 379,622 SQUARE FEET
SITUATED IN THE JD MCFARLAND SURVEY, ABSTRACT NO. 145
CITY OF ROCKWALL, ROCKWALL COUNTY, TEXAS

PROJECT INFORMATION

Project No.: FCU 18061
Date: October 2, 2019
Drawn By: GS9
Scale: 1"=60'
SHEET 2 of 2



SURVEYOR


TEAGUE NALL AND PERKINS, INC.
825 Watters Creek Boulevard, Suite M300
Allen, Texas 75013
214.461.9867 ph 214.461.9864 fx
T.B.P.L.S. Registration No. 10194381
www.tnpinc.com

CAUTION EXISTING UTILITIES !!!
CALL TEXAS 811!! EXISTING UTILITIES AND UNDERGROUND FACILITIES INDICATED ON THESE PLANS HAVE BEEN LOCATED FROM REFERENCE INFORMATION. IT SHALL BE THE RESPONSIBILITY OF THE CONTRACTOR TO VERIFY BOTH HORIZONTALLY AND VERTICALLY THE LOCATION OF ALL EXISTING UTILITIES AND UNDERGROUND FACILITIES PRIOR TO CONSTRUCTION, TO TAKE THE NECESSARY PRECAUTIONS IN ORDER TO PROTECT ALL FACILITIES ENCOUNTERED. THE CONTRACTOR SHALL PRESERVE AND PROTECT ALL EXISTING UTILITIES FROM DAMAGE DURING CONSTRUCTION.


LEGEND

--- PROPERTY LINE


PROPOSED SAWCUT LIMITS

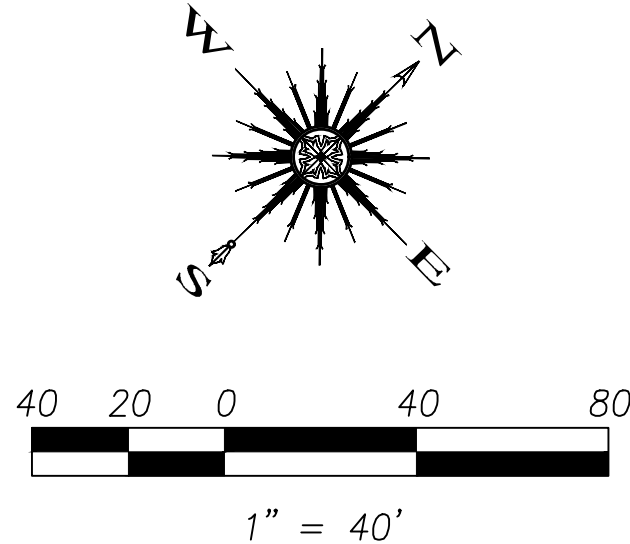

ROCKWALL HIGH SCHOOL BUILDING

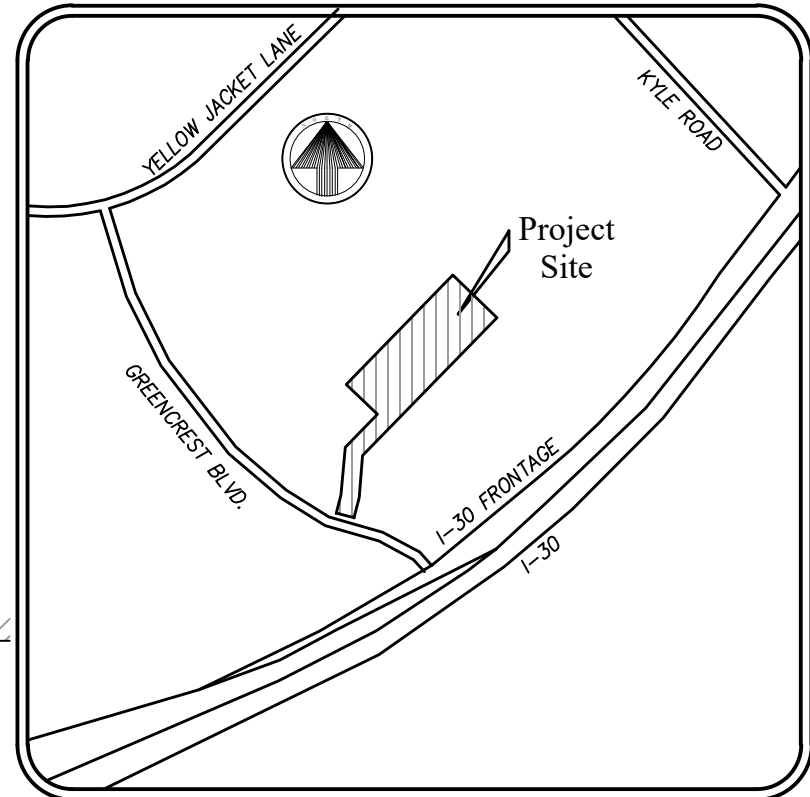

LOCATION MAP

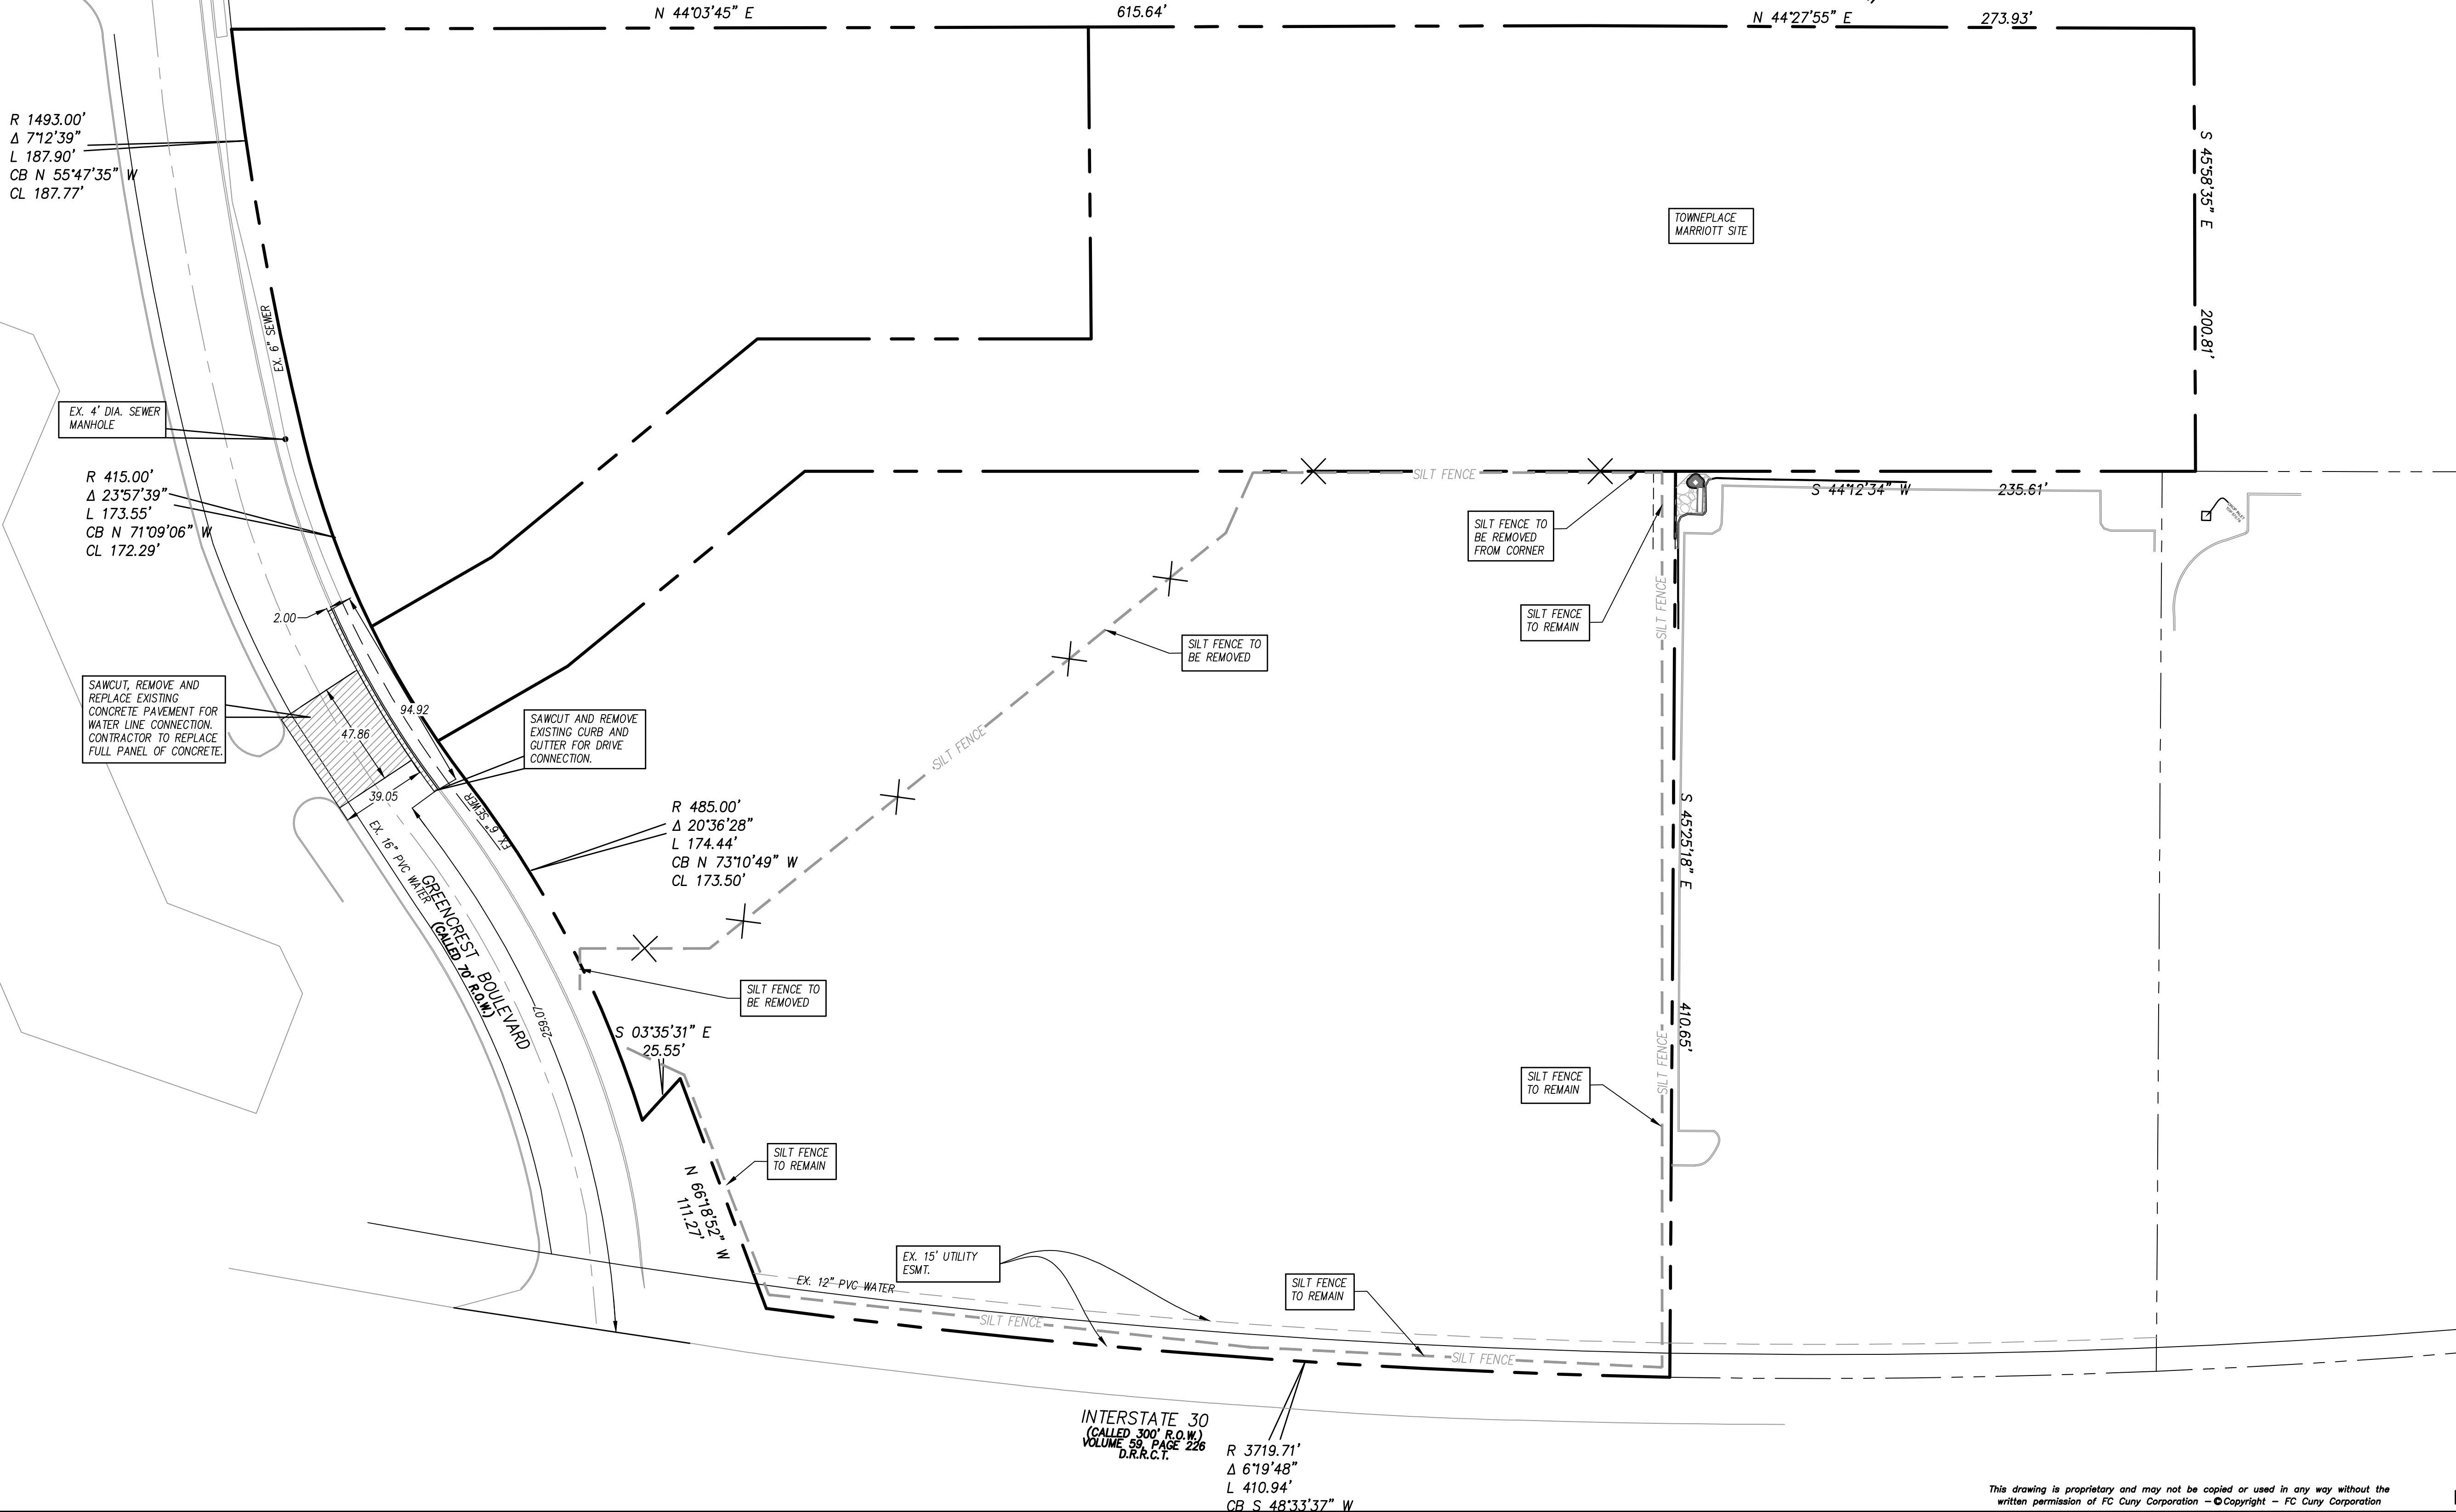

Revision	Date	Description

Owner:
Greencrest TPS Hotel, L.P.

3021 Ridge Road, A-120
Rockwall, TX 75082
Phone: (214) 890-9225


~ Civil Engineer ~
F.C. CUNY CORPORATION
#2 Horizon Court • Heath, Texas 75032 • (469) 402-7700
Texas Registered Engineering Firm F-7449



**TOWNEPLACE
SUITES
MARRIOTT**

908 E. INTERSTATE 30
ROCKWALL, TX 75087

12/23/2021

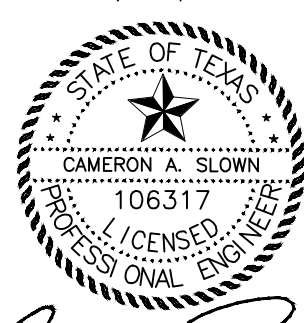

C. Slown

Drawn By:
F.C. CUNY

Checked By:
F.C. CUNY

Date:
11/19/2018

Project No.:
-

Sheet Title:

Demolition Plan

Scale:

Sheet No.:

1"=40'

2 of 14



SP 2018-029

RECORD DRAWING


This drawing is proprietary and may not be copied or used in any way without the written permission of FC Cuny Corporation. © Copyright - FC Cuny Corporation



CALL TEXAS 811!!! EXISTING UTILITIES AND UNDERGROUND FACILITIES INDICATED ON THESE PLANS HAVE BEEN LOCATED FROM REFERENCE INFORMATION. IT SHALL BE THE RESPONSIBILITY OF THE CONTRACTOR TO VERIFY BOTH HORIZONTALLY AND VERTICALLY THE LOCATION OF ALL EXISTING UTILITIES AND UNDERGROUND FACILITIES PRIOR TO CONSTRUCTION, TO TAKE THE NECESSARY PRECAUTIONS IN ORDER TO PROTECT ALL FACILITIES ENCOUNTERED. THE CONTRACTOR SHALL PRESERVE AND PROTECT ALL EXISTING UTILITIES FROM DAMAGE DURING CONSTRUCTION.

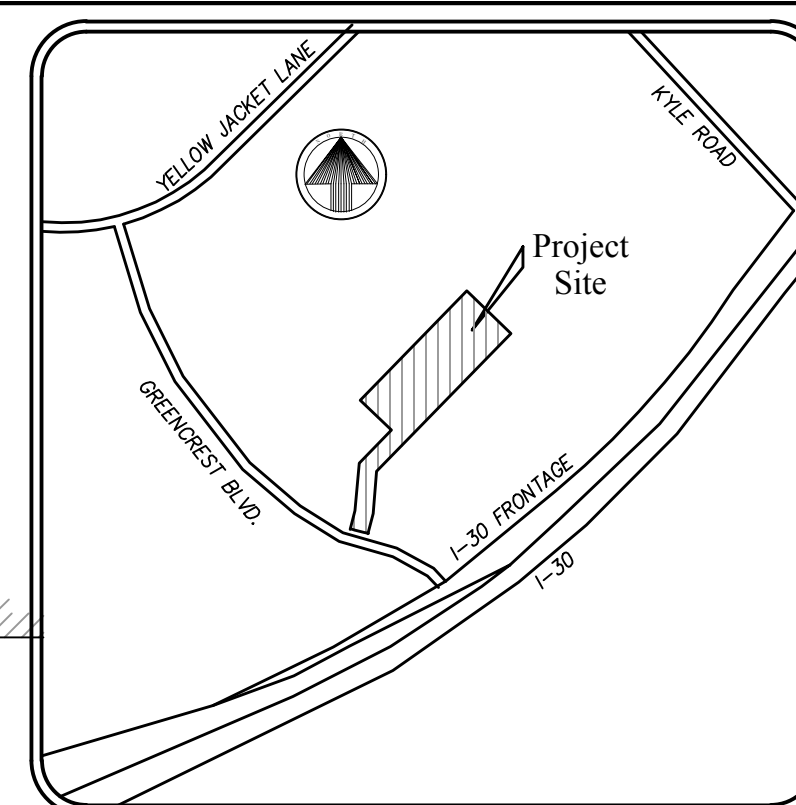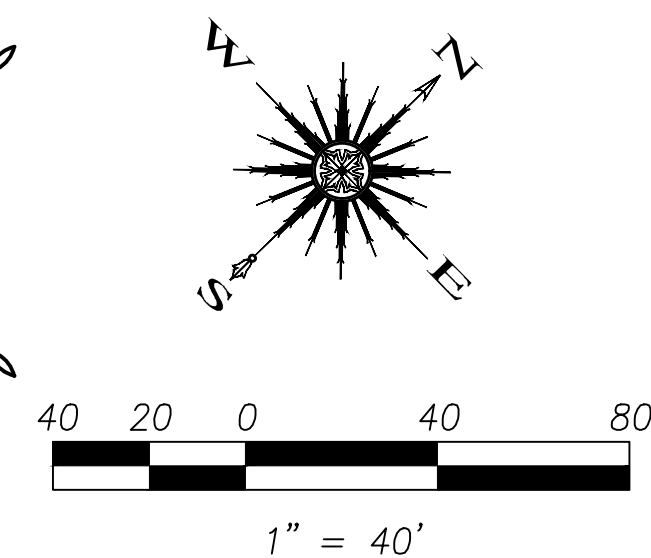

LOCATION MAP

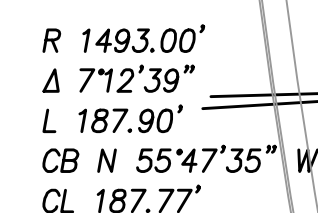

EX. 4' DIA. SEWER
MANHOLE

R 415.00'
 Δ 23°57'39"
 L 173.55'
 CB N 71°09'06" W
 CL 172.29'

R 435.00'
Δ 20°36'28"
L 174.44'
CB N 73°10'49" W
CL 173.50'

35'31" E
5.55'

INTERSTATE 30
(CALLED 300' R.O.W.)
VOLUME 59, PAGE 226
D.R.R.C.T.

R 3719.71'
 Δ 6°19'48"
 L 410.94'
 CB S 48°33'37" W
 CL 410.74'

TEXAS ROADHOUSE
SITE

LEGEND

FLOW DIRECTION

— — — SILT FENCE — — — PROPOSED SILT FENCE

STABILIZED CONSTRUCTION ENTRANCE GENERAL NOTES:

1. STONE SIZE-- 4 TO 10 INCH OPEN GRADED ROCK (NO CRUSHED CONCRETE ALLOWED).
2. LENGTH-- AS EFFECTIVE, BUT NOT LESS THAN 50 FEET.
3. THICKNESS-- NOT LESS THAN 12 INCHES.
4. WIDTH-- NOT LESS THAN FULL WIDTH OF ALL POINTS OF INGRESS OR EGRESS.
5. WASHING-- WHEN NECESSARY, WHEELS SHALL BE CLEANED TO REMOVE SEDIMENT PRIOR TO ENTRANCE ONTO PUBLIC ROADWAY. WHEN WASHING IS REQUIRED, IT SHALL BE DONE ON AN AREA STABILIZED WITH CRUSHED STONE WHICH DRAINS INTO AN APPROVED STRAP OF SEDIMENT BASIN. ALL SEDIMENT SHALL BE PREVENTED FROM ENTERING ANY STORM DRAIN, DITCH, OR WATERCOURSE USING APPROVED METHODS.
6. MAINTENANCE-- THE ENTRANCE SHALL BE MAINTAINED IN A CONDITION WHICH WILL PREVENT TRACKING OR FLOWING OF SEDIMENT ONTO PUBLIC ROADWAYS. THIS MAY REQUIRE PERIODIC TOP DRESSING WITH ADDITIONAL STONE AS CONDITIONS DEMAND, AND REPAIR AND REPAIR OR CLEAN UP ANY MATERIALS THAT ARE WASHED OR CARRIED OFF. SEDIMENT THAT IS DROPPED, WASHED OR TRACKED ONTO PUBLIC ROADWAY MUST BE REMOVED IMMEDIATELY.
7. DRAINAGE-- ENTRANCE MUST BE PROPERLY GRADED OR INCORPORATE A DRAINAGE SWALE TO PREVENT RUNOFF FROM LEAVING THE CONSTRUCTION SITE.

SILT FENCE GENERAL NOTES:

1. STEEL POSTS WHICH SUPPORT THE SILT FENCE SHALL BE INSTALLED ON A SLIGHT ANGLE TOWARD THE ANTIPOATED RUNOFF SOURCE. POST MUST BE EMBEDDED A MINIMUM OF ONE FOOT.
2. THE TOP OF THE SILT FENCE SHALL BE TRENCHED IN WITH A SPADE OR MECHANICAL TRENCHER SO THAT THE DOWNHILL FACE OF THE TRENCH IS FLAT AND PERPENDICULAR TO THE LINE OF FLOW. WHERE FENCE CAN NOT BE TREATED (e.g. pavement) WEIGHT FABRIC FLAP WITH WASHED GRAVEL ON UPHILL SIDE TO PREVENT FLOW UNDER FENCE.
3. THE TRENCH MUST BE A MINIMUM OF 6 INCHES DEEP AND 6 INCHES WIDE TO ALLOW FOR THE SILT FENCE FABRIC TO BE LAID IN THE GROUND AND BACKFILLED WITH COMPACTED MATERIAL.
4. SILT FENCE SHOULD BE SECURELY FASTENED TO EACH STEEL SUPPORT POSTS OR TO WOVEN WIRE, WHICH IS IN TURN ATTACHED TO THE STEEL FENCE POST.
5. INSPECTION SHALL BE MADE WEEKLY OR AFTER EACH RAINFALL EVENT AND REPAIR OR REPLACEMENT SHALL BE MADE PROMPTLY AS NEEDED.
6. SILT FENCE SHALL BE REMOVED WHEN THE SITE IS COMPLETELY STABILIZED SO AS NOT TO BLOCK OR IMPEDE STORM FLOW OR DRAINAGE.
7. ACCUMULATED SILT SHALL BE REMOVED WHEN IT REACHES A DEPTH OF 6 INCHES. THE SILT SHALL BE DISPOSED OF IN AN APPROVED SITE AND IN SUCH A MANNER AS NOT TO CONTRIBUTE TO ADDITIONAL SITUATION.

NOTE:

ALL DISTURBED AREA TO HAVE 80% COVERAGE OF 1" STAND OF GRASS (NOT RYE OR WEEDS) PRIOR TO ACCEPTANCE.

This drawing is proprietary and may not be copied or used in any way without the written permission of FC Cunny Corporation - ©Copyright - FC Cunny Corporation



SP 2018-029

RECORD DRAWING

[illegible]

LEGEND	
	GREENCREST BLVD PAVEMENT
	DUMPSTER PAD AREA PAVEMENT
	HEAVY TRUCK TRAFFIC AREA PAVEMENT
	LIGHT TRUCK/PARKING AREA PAVEMENT
	PROPOSED SIDEWALK

- GENERAL NOTES:**
- ALL DIMENSIONS IN FEET.
 - ALL PAVEMENT DIMENSIONS ARE TO FACE OF CURB UNLESS INDICATED OTHERWISE.
 - SEE ARCHITECTURAL PLANS FOR EXACT BUILDING DIMENSIONS AND LAYOUT.
 - DIMENSIONS ARE TO THE OUTSIDE FACE OF BUILDING WALL AND STRUCTURES.
 - MARK FIRELANE TO CITY SPECIFICATION. "NO PARKING FIRE LANE" EVERY 25' WHITE 4" LETTERS ON A 6" RED STRIPED BACKGROUND.
 - PROPERTY OWNER IS RESPONSIBLE FOR MAINTAINING ALL PAVING INCLUDING FIRE LANE, ACCESS AND UTILITY EASEMENTS.
 - PUBLIC BARRIER FREE RAMP MUST BE TRUNCATED DOME PLATES PER CITY REQUIREMENT. (www.advantogelactile.com)
 - ALL GENERAL FILL MATERIAL SHALL BE COMPACTED WITH A SHEEPS FOOT ROLLER TO 95% STANDARD PROCTOR.
 - PER GEOTECH REPORT BY ALPHA TESTING, ADD 1 INCH TO PAVEMENT THICKNESS AS AN ALTERNATIVE OPTION TO LIME STABILIZATION.

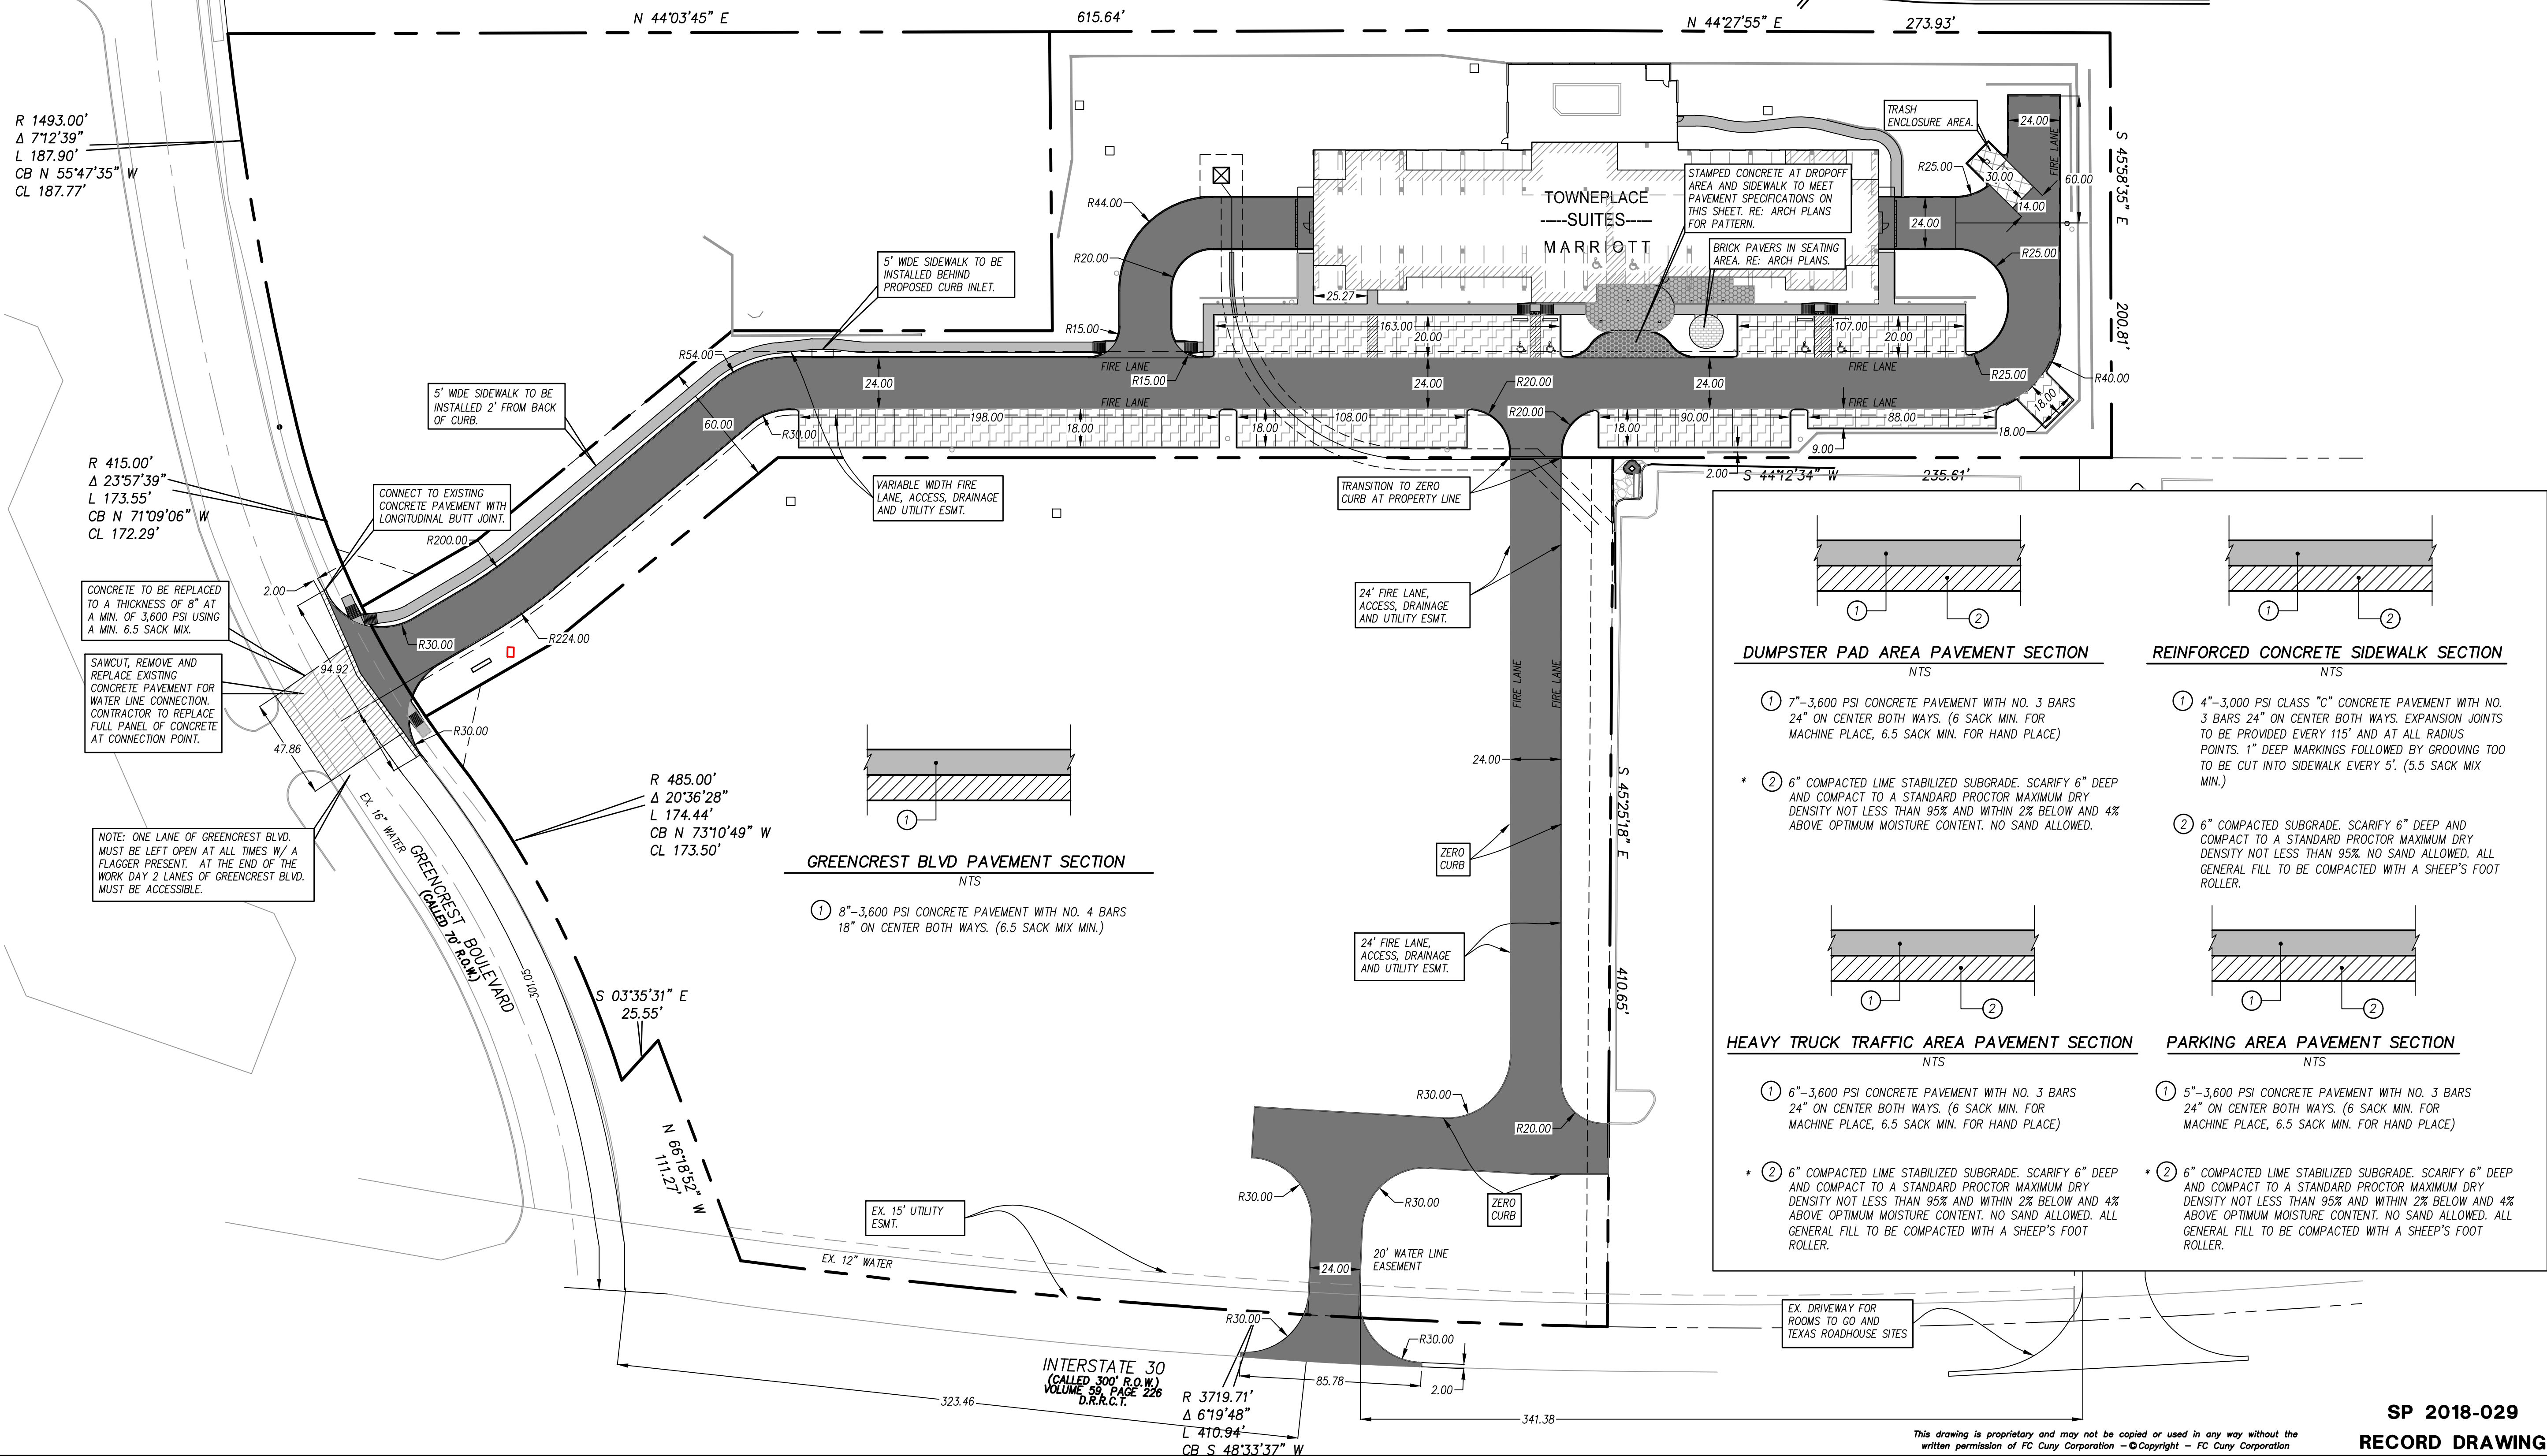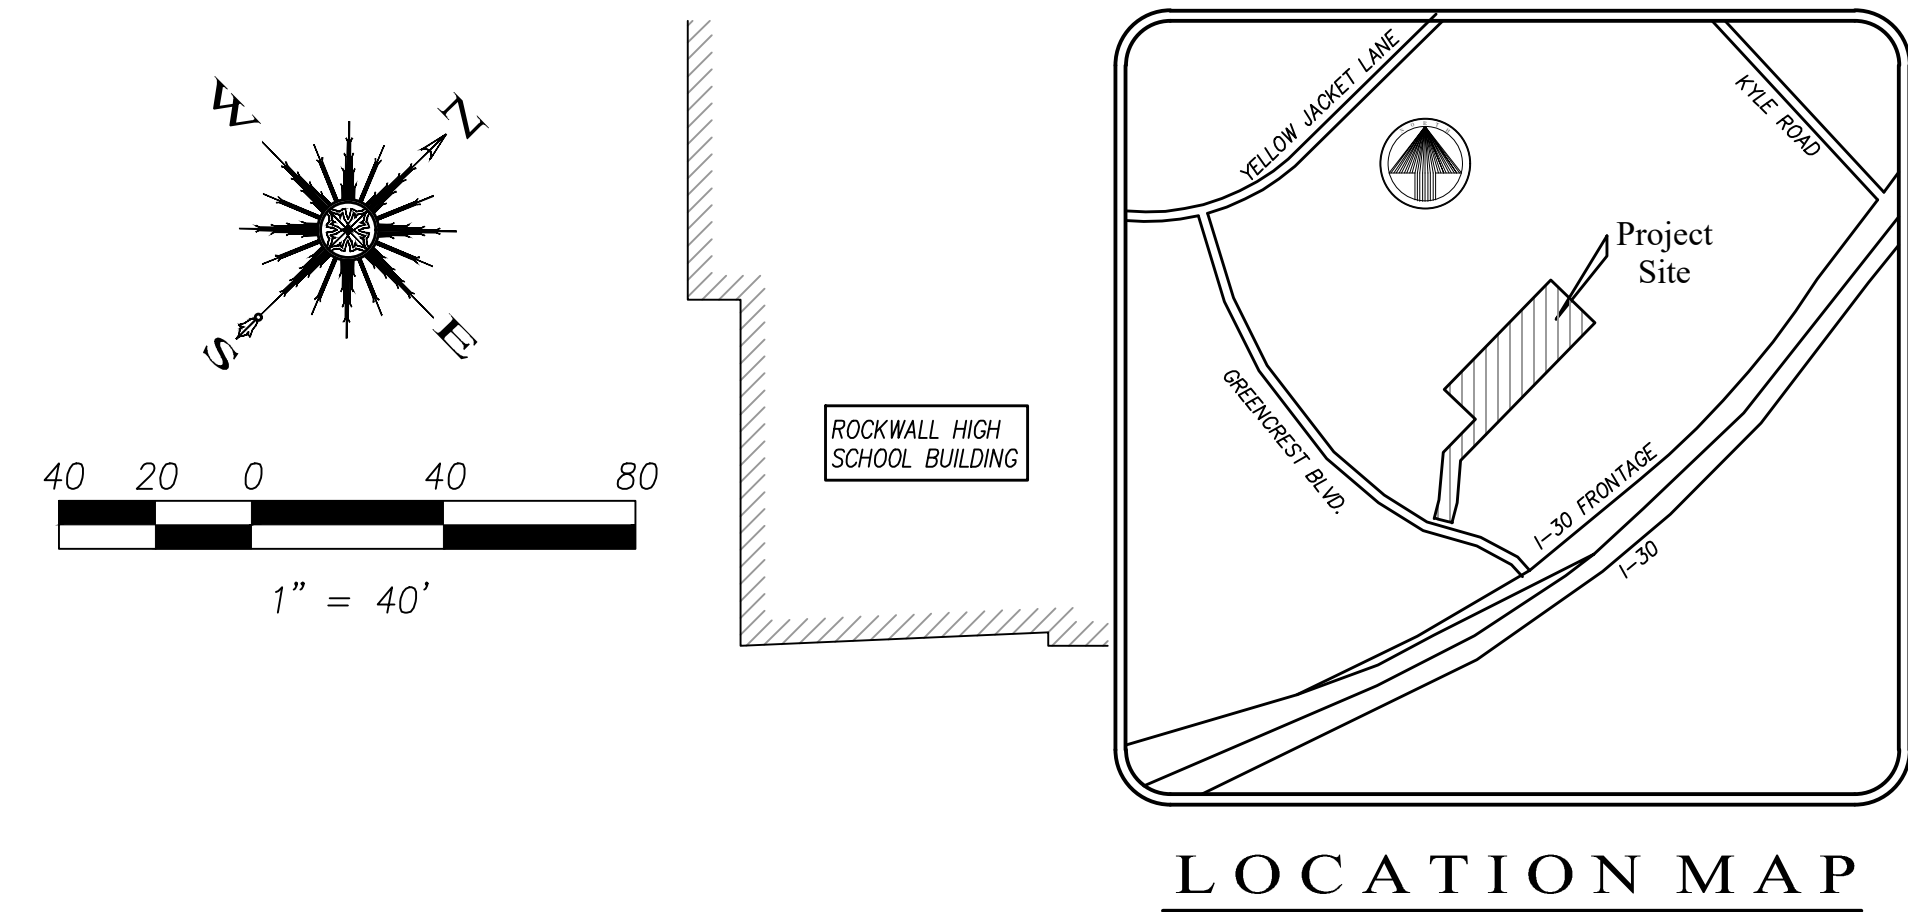

Revision	Date	Description


Owner:	Greencrest TPS Hotel, L.P.
3021 Ridge Road, A-120 Rockwall, TX 75082 Phone: (214) 890-9225	

~ Civil Engineer ~ F.C. CUNY CORPORATION #2 Horizon Court • Heath, Texas 75032 • (409) 402-7700 Texas Registered Engineering Firm F-7449	
---	--

TOWNEPLACE SUITES MARRIOTT	
908 E. INTERSTATE 30 ROCKWALL, TX 75087	
12/23/2021	
Drawn By: F.C. CUNY	Checked By: F.C. CUNY
Date: 11/19/2018	Project No.: -
Sheet Title: Paving Plan	
Scale: 1"=40'	Sheet No.: 5 of 14

This drawing is proprietary and may not be copied or used in any way without the written permission of FC Cuny Corporation. © Copyright - FC Cuny Corporation

SP 2018-029
RECORD DRAWING

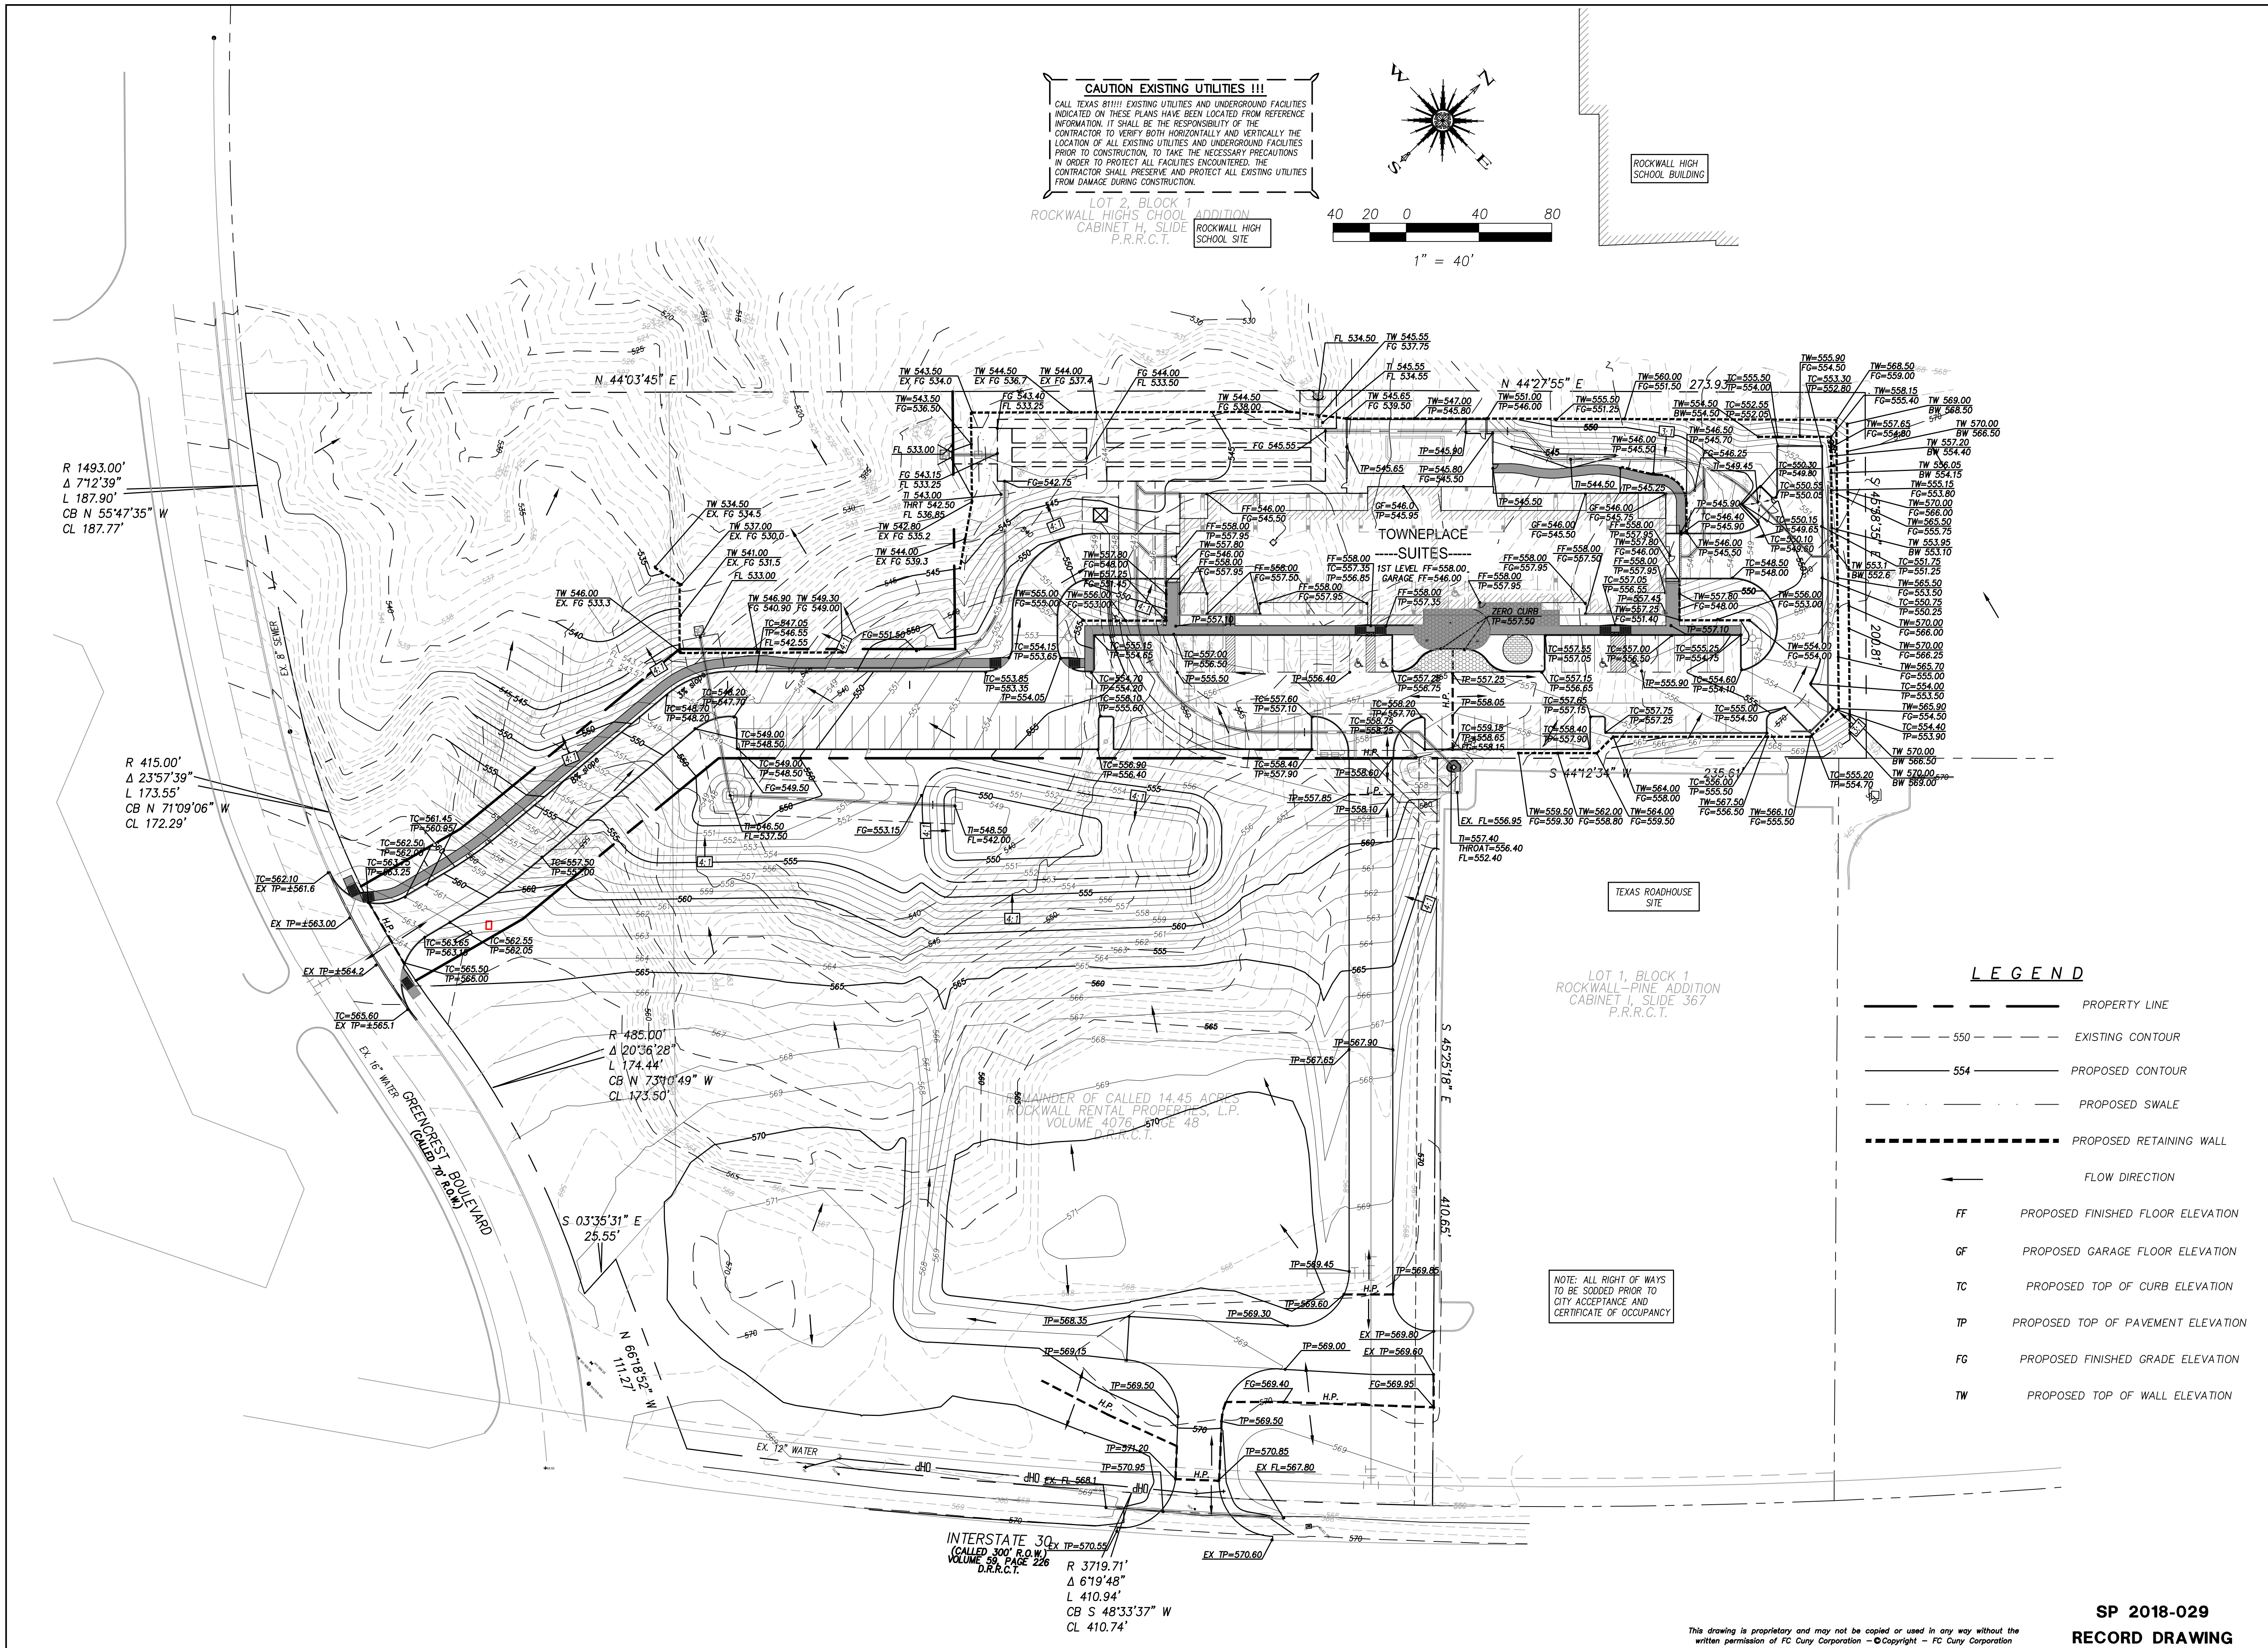

Revision	Date	Description

Owner:
Greentree Hotel, L.P.


3021 Ridge Road, A-120
Rockwall, TX 75082
Phone: (214) 890-9225

~ Civil Engineer ~
F.C. CUNY CORPORATION
#2 Horizon Court • Heath, Texas 75032 • (409) 402-7700
Texas Registered Engineering Firm F-7449

TOWNEPLACE SUITES MARRIOTT

908 E. INTERSTATE 30
ROCKWALL, TX 75087

12/23/2021

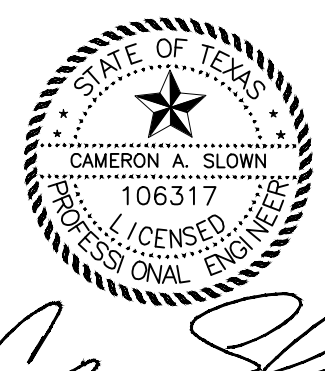


Drawn By: F.C. CUNY
Checked By: F.C. CUNY

Date: 11/19/2018
Project No.: -

Sheet Title:
Grading Plan

Scale: 1"=40'
Sheet No.: 6 of 14

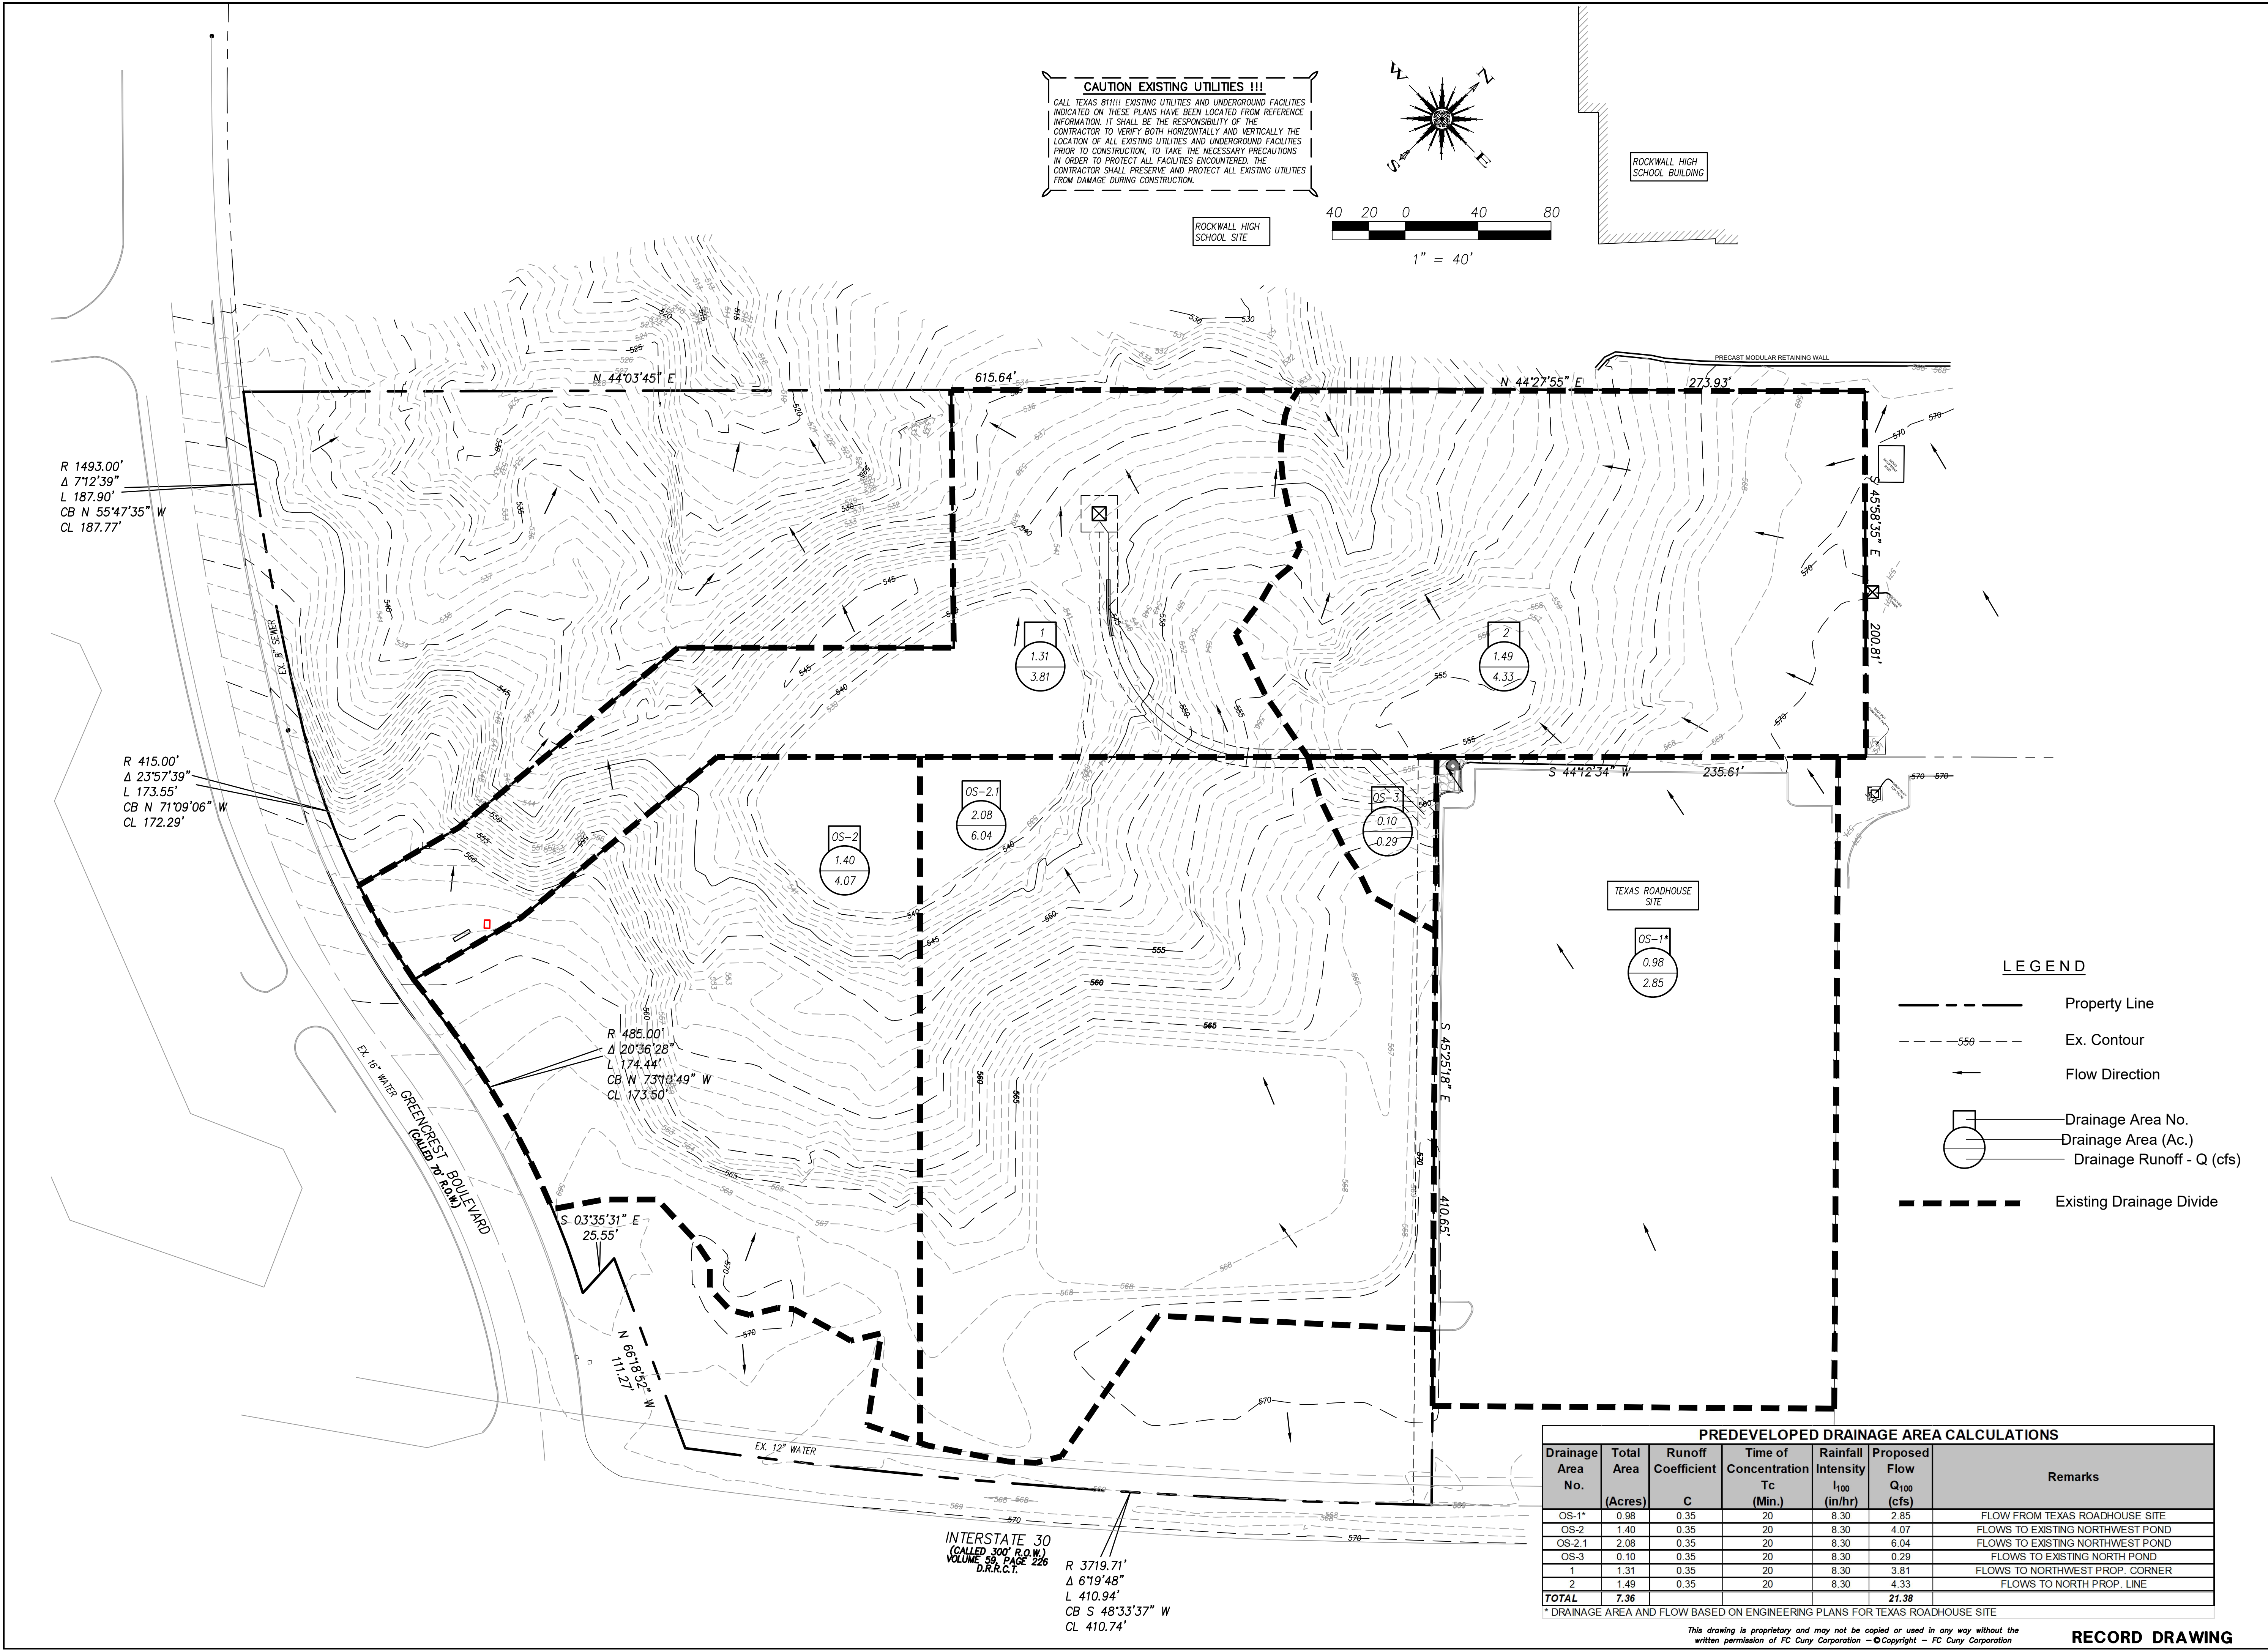

PREDEVELOPED DRAINAGE AREA CALCULATIONS						
Drainage Area No.	Total Area (Acres)	Runoff Coefficient C	Time of Concentration Tc (Min.)	Rainfall Intensity I ₁₀₀ (in/hr)	Proposed Flow Q ₁₀₀ (cfs)	Remarks
OS-1*	0.98	0.35	20	8.30	2.85	FLOW FROM TEXAS ROADHOUSE SITE
OS-2	1.40	0.35	20	8.30	4.07	FLows TO EXISTING NORTHWEST POND
OS-2.1	2.08	0.35	20	8.30	6.04	FLows TO EXISTING NORTHWEST POND
OS-3	0.10	0.35	20	8.30	0.29	FLows TO EXISTING NORTH POND
1	1.31	0.35	20	8.30	3.81	FLows TO NORTHWEST PROP. CORNER
2	1.49	0.35	20	8.30	4.33	FLows TO NORTH PROP. LINE
TOTAL	7.36				21.38	

* DRAINAGE AREA AND FLOW BASED ON ENGINEERING PLANS FOR TEXAS ROADHOUSE SITE

This drawing is proprietary and may not be copied or used in any way without the written permission of FC Cuny Corporation. © Copyright - FC Cuny Corporation

RECORD DRAWING

Revision	Date	Description


Owner:

Greencrest TPS Hotel, L.P.

3021 Ridge Road, A-120
Rockwall, TX 75082
Phone: (214) 890-9225

~ Civil Engineer ~


F.C. CUNY CORPORATION
#2 Horizon Court • Heath, Texas 75032 • (469) 402-7700
Texas Registered Engineering Firm F-7449

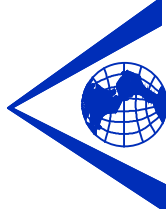

TOWNEPLACE SUITES MARRIOTT

908 E. INTERSTATE 30
ROCKWALL, TX 75087

12/23/2021




Cameron A. Slown

Drawn By: F.C. CUNY
Checked By: F.C. CUNY

Date: 11/19/2018
Project No.: -

Sheet Title:
Pre Developed Drainage Area Map

Scale: 1"=40'
Sheet No.: 7 of 14

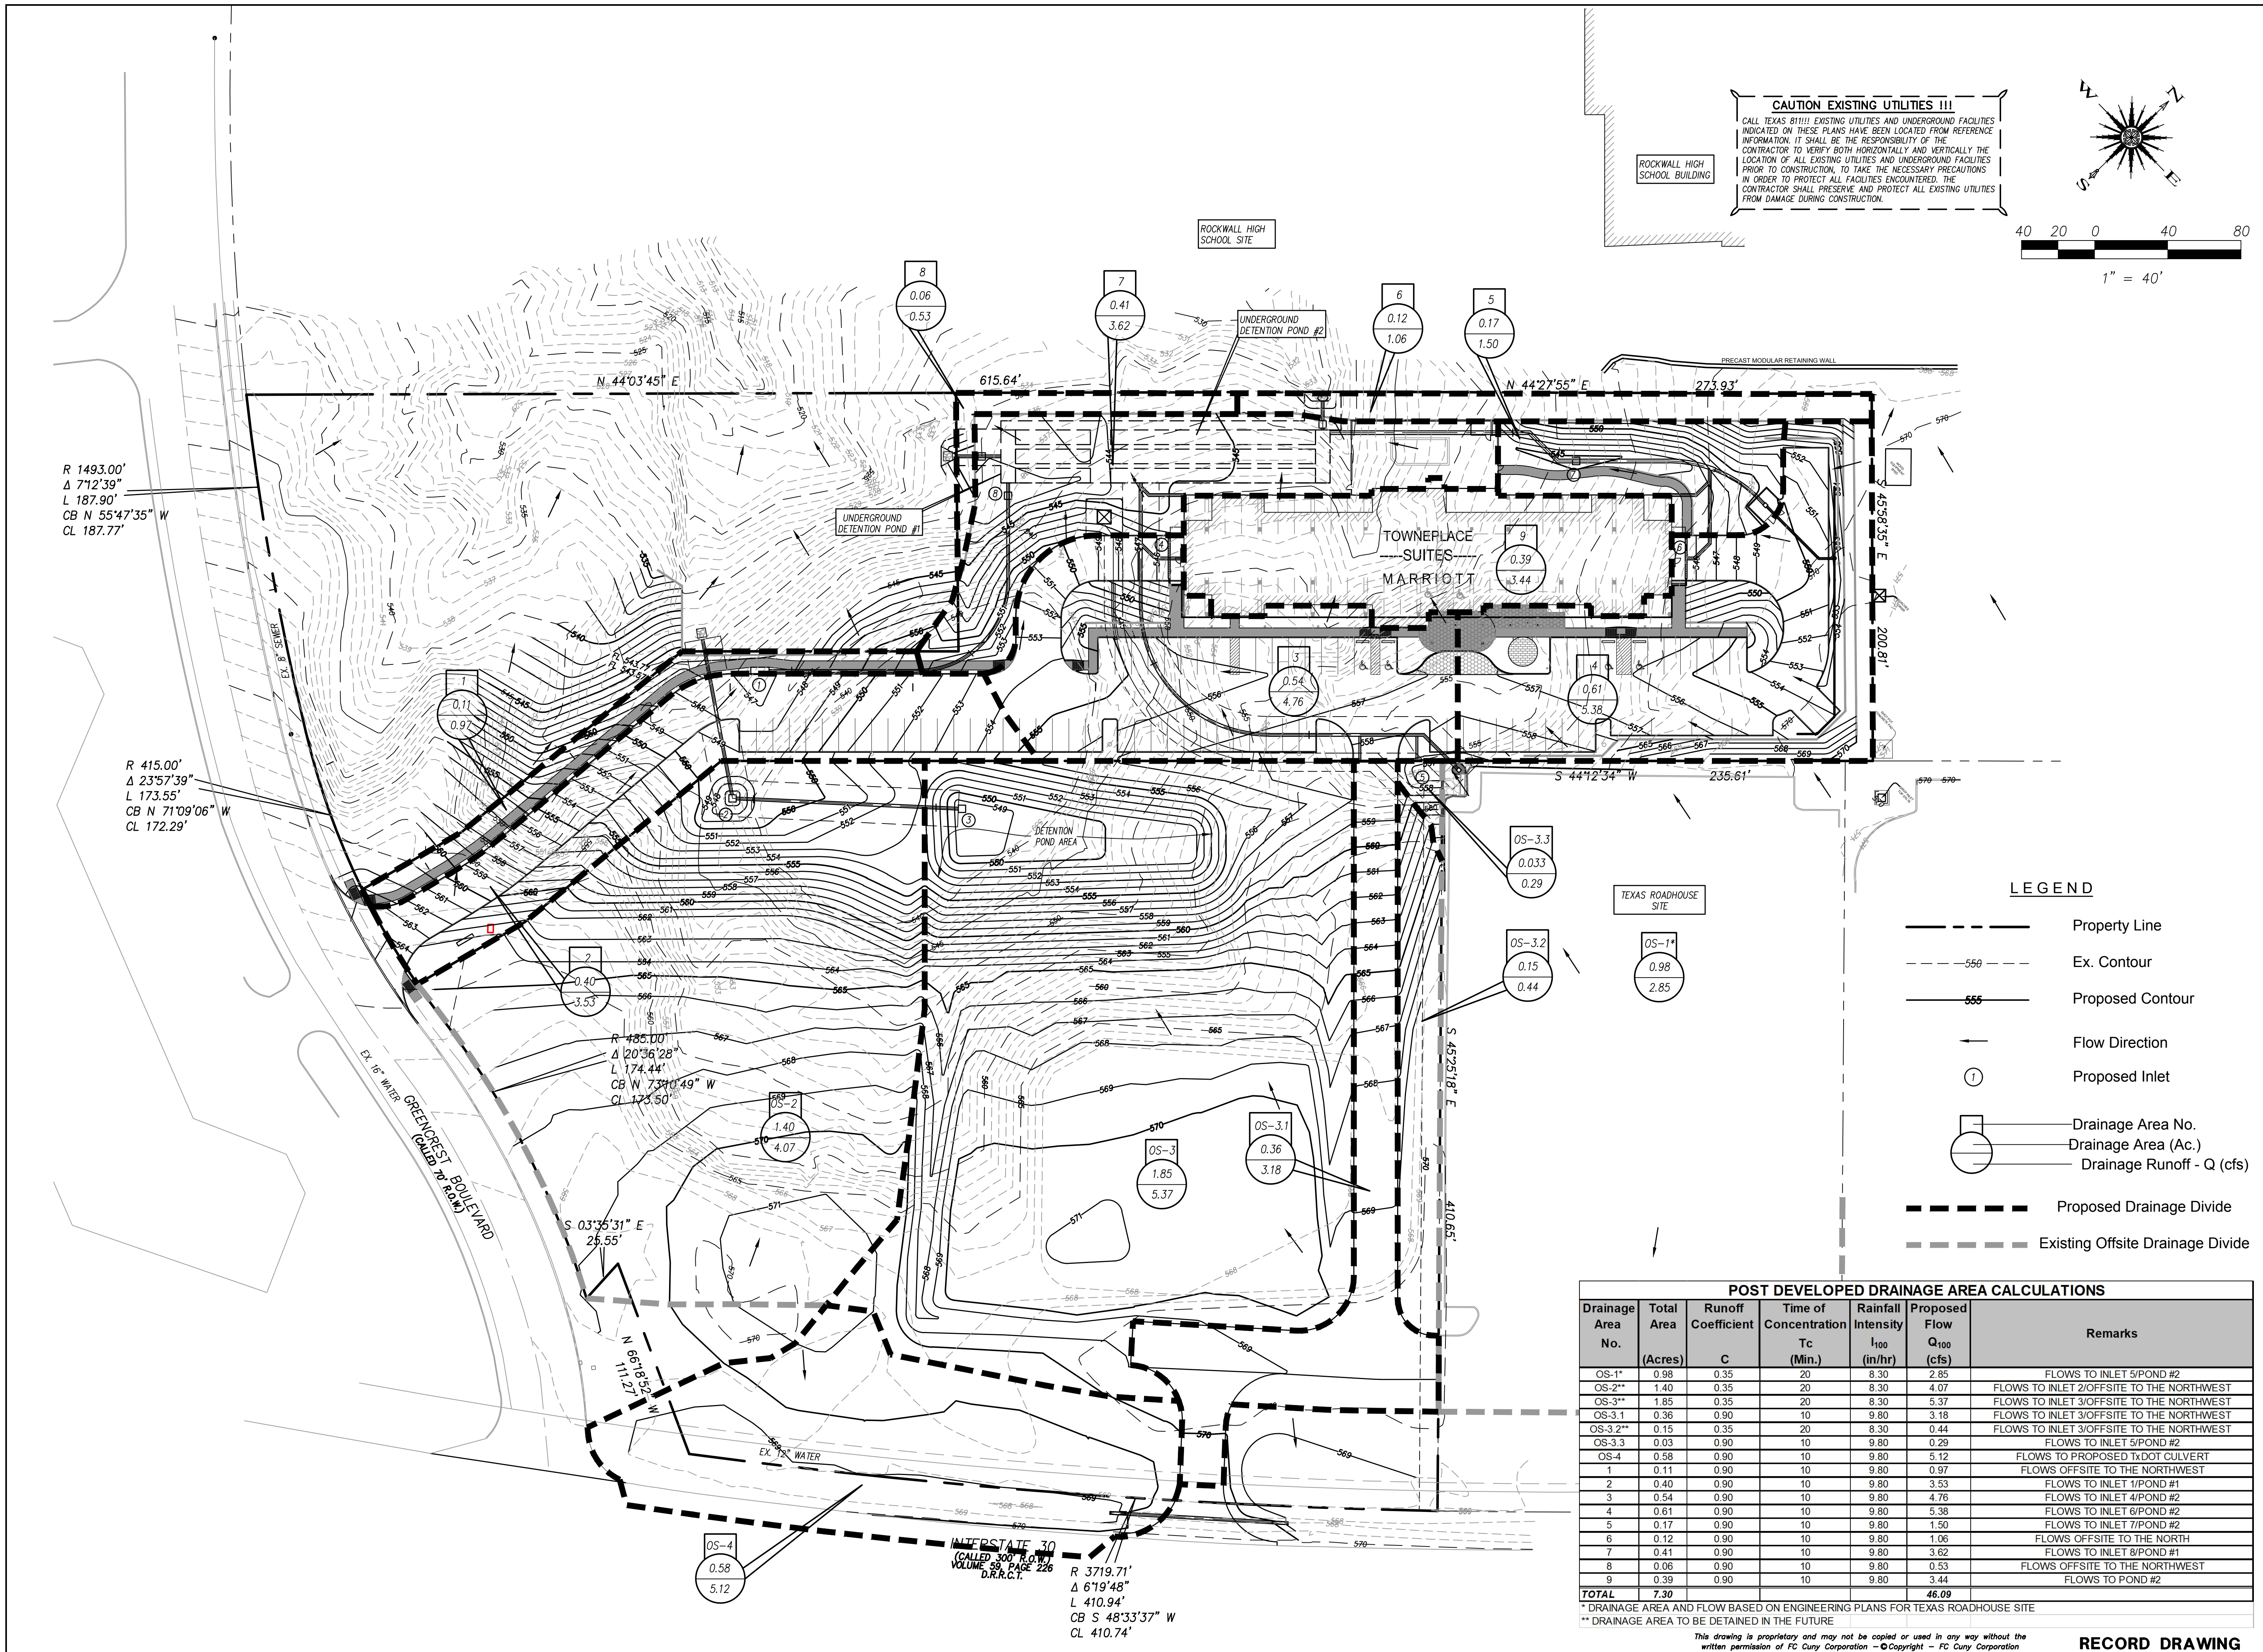

Revision	Date	Description

Owner: **Greencrest TPS Hotel, L.P.**


3021 Ridge Road, A-120
Rockwall, TX 75082
Phone: (214) 890-9225

~ Civil Engineer ~
F.C. CUNY CORPORATION
#2 Horizon Court • Heath, Texas 75032 • (409) 402-7700
Texas Registered Engineering Firm F-7449

TOWNEPLACE SUITES MARRIOTT

908 E. INTERSTATE 30
ROCKWALL, TX 75087

12/23/2021




Drawn By: F.C. CUNY
Checked By: F.C. CUNY


Date: 11/19/2018
Project No.: -

Sheet Title: **Drainage Area Map**

Scale: 1"=40'
Sheet No.: 8 of 14

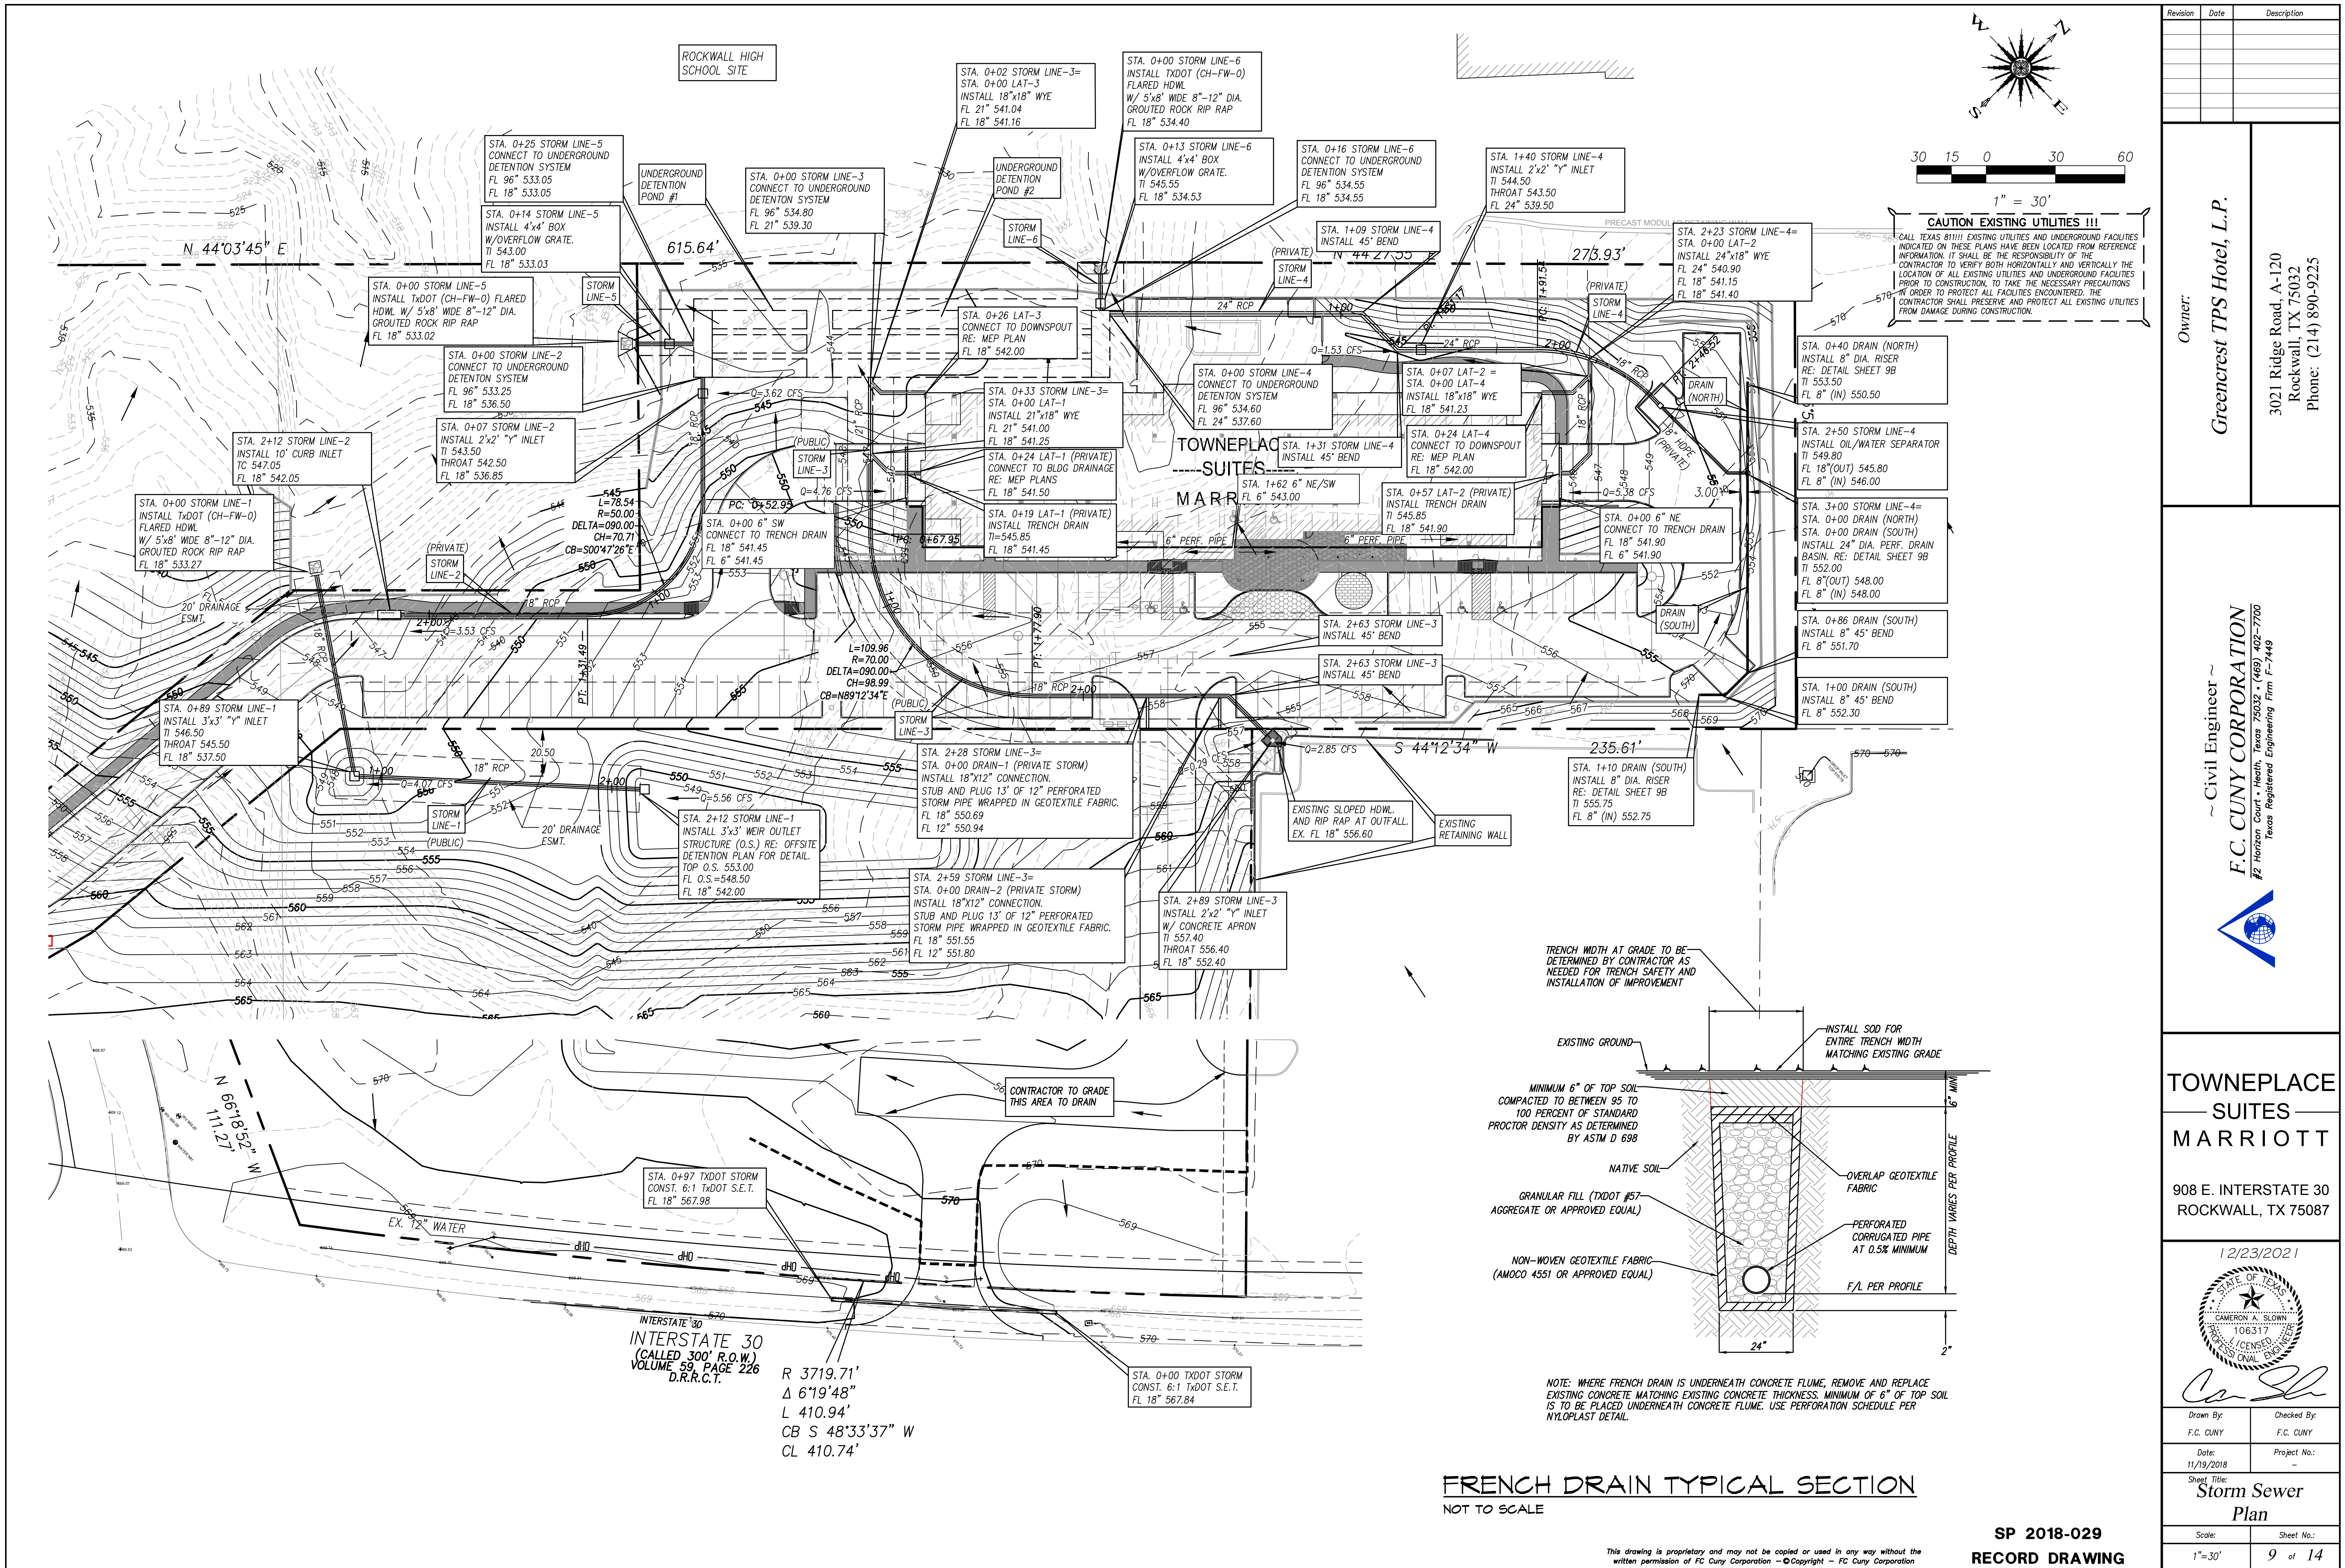

CAUTION EXISTING UTILITIES !!!
CALL TEXAS 811!!! EXISTING UTILITIES AND UNDERGROUND FACILITIES INDICATED ON THESE PLANS HAVE BEEN LOCATED FROM REFERENCE INFORMATION. IT SHALL BE THE RESPONSIBILITY OF THE CONTRACTOR TO VERIFY BOTH HORIZONTALLY AND VERTICALLY THE LOCATION OF ALL EXISTING UTILITIES AND UNDERGROUND FACILITIES PRIOR TO CONSTRUCTION, TO TAKE THE NECESSARY PRECAUTIONS IN ORDER TO PROTECT ALL FACILITIES ENCOUNTERED. THE CONTRACTOR SHALL PRESERVE AND PROTECT ALL EXISTING UTILITIES FROM DAMAGE DURING CONSTRUCTION.

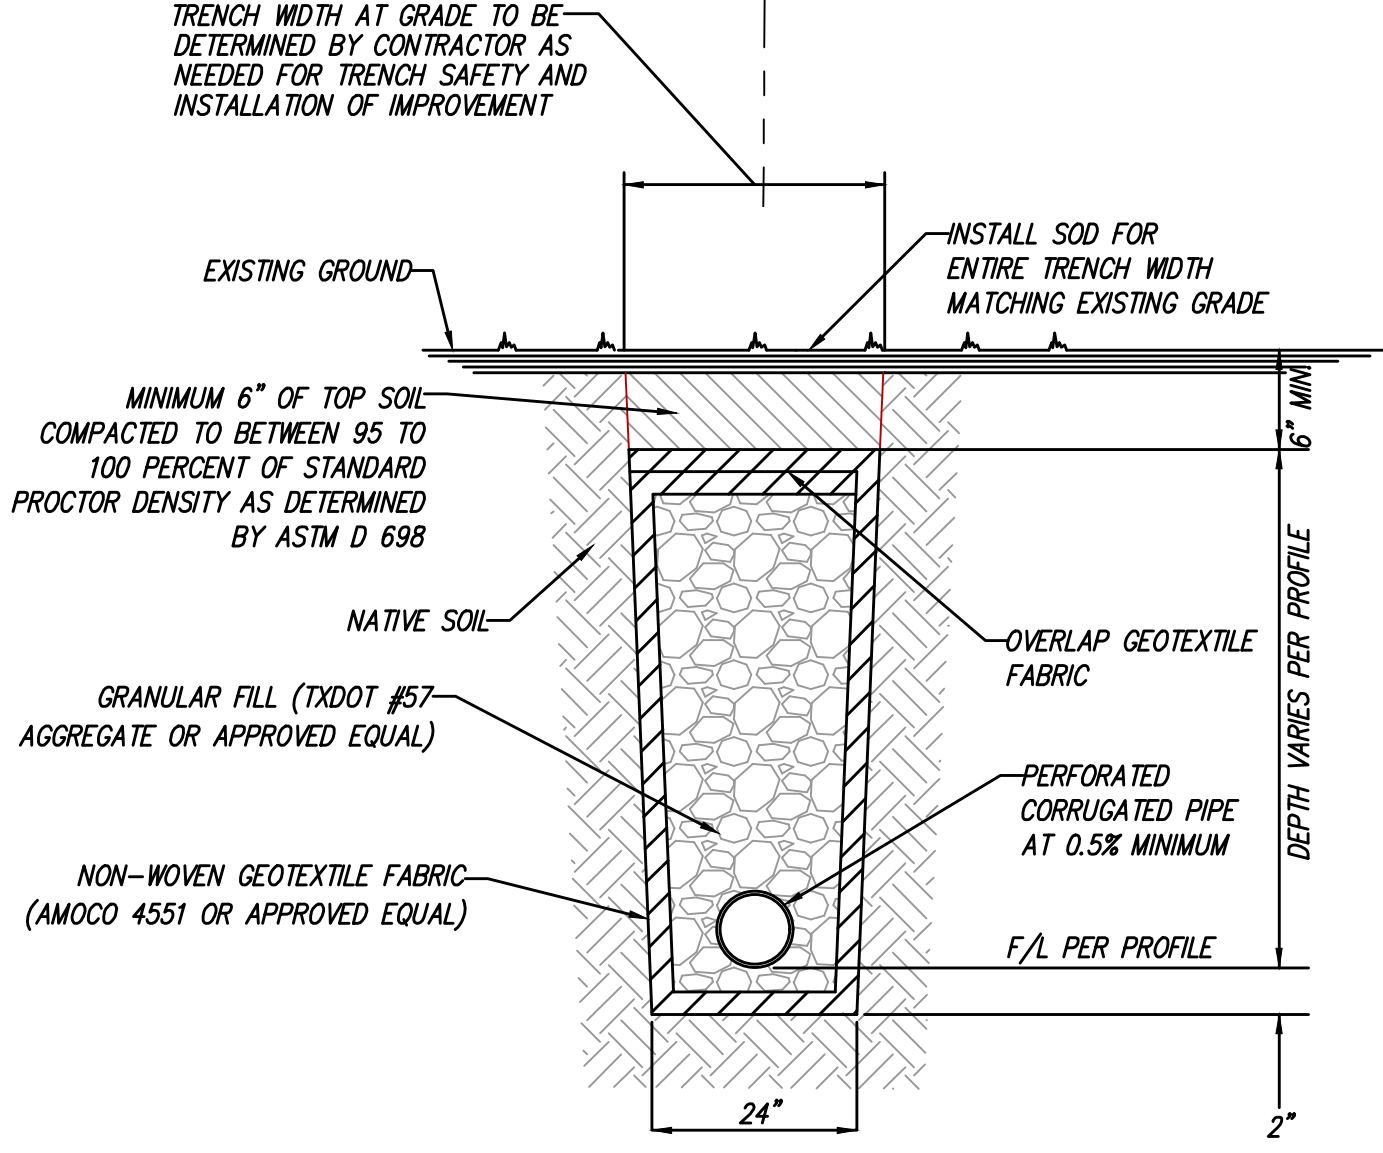

NOTE: WHERE FRENCH DRAIN IS UNDERNEATH CONCRETE FLUME, REMOVE AND REPLACE EXISTING CONCRETE MATCHING EXISTING CONCRETE THICKNESS. MINIMUM OF 6" OF TOP SOIL IS TO BE PLACED UNDERNEATH CONCRETE FLUME. USE PERFORATION SCHEDULE PER NYLOPLAST DETAIL.

FRENCH DRAIN TYPICAL SECTION
NOT TO SCALE

Revision	Date	Description

Owner:

Greentrest TPS Hotel, L.P.

3021 Ridge Road, A-120
Rockwall, TX 75082
Phone: (214) 890-9225

~ Civil Engineer ~

F.C. CUNY CORPORATION
#2 Horizon Court • Heath, Texas 75032 • (409) 402-7700
Texas Registered Engineering Firm F-7449

TOWNEPLACE SUITES MARRIOTT

908 E. INTERSTATE 30
ROCKWALL, TX 75087

12/23/2021

C. Slown

Drawn By:	Checked By:
F.C. CUNY	F.C. CUNY
Date:	Project No.:
11/19/2018	-
Sheet Title:	
Storm Sewer Plan	
Scale:	Sheet No.:
1"=30'	9 of 14

SP 2018-029
RECORD DRAWING

This drawing is proprietary and may not be copied or used in any way without the written permission of FC Cuny Corporation. © Copyright - FC Cuny Corporation

[illegible]

RECORD DRAWING

Scale:	Sheet No.:
1"=30'	9A of 14

Section 2721

Engineered Surface Drainage Products

GENERAL

PVC surface drainage inlets shall include the drain basin type as indicated on the contract drawing and referenced within the contract specifications. The ductile iron grates for each of these fittings are to be considered an integral part of the surface drainage inlet and shall be furnished by the same manufacturer. The surface drainage inlets shall be as manufactured by Nyloplast a division of Advanced Drainage Systems, Inc., or prior approved equal.


MATERIALS

The drain basins required for this contract shall be manufactured from PVC pipe stock, utilizing a thermoforming process to reform the pipe stock to the specified configuration. The drainage pipe connection stubs shall be manufactured from PVC pipe stock and formed to provide a watertight connection with the specified pipe system. This joint tightness shall conform to ASTM D3212 for joints for drain and sewer plastic pipe using flexible elastomeric seals. The flexible elastomeric seals shall conform to ASTM F477. The pipe bell spigot shall be joined to the main body of the drain basin or catch basin. The raw material used to manufacture the pipe stock that is used to manufacture the main body and pipe stubs of the surface drainage inlets shall conform to ASTM D1784 cell class 12454.


The grates and frames furnished for all surface drainage inlets shall be ductile iron for structure sizes 8", 10", 12", 15", 18", 24", 30" and 36" and shall be made specifically for each basin so as to provide a round bottom flange that closely matches the diameter of the surface drainage inlet. Grates for drain basins shall be capable of supporting various wheel loads as specified by Nyloplast. 12" and 15" square grates will be hinged to the frame using pins. Ductile iron used in the manufacture of the castings shall conform to ASTM A536 grade 70-50-05. Grates and covers shall be provided painted black.

INSTALLATION


The specified PVC surface drainage inlet shall be installed using conventional flexible pipe backfill materials and procedures. The backfill material shall be crushed stone or other granular material meeting the requirements of class 1, class 2, or class 3 material as defined in ASTM D2321. Bedding and backfill for surface drainage inlets shall be well placed and compacted uniformly in accordance with ASTM D2321. The drain basin body will be cut at the time of the final grade. No brick, stone or concrete block will be required to set the grate to the final grade height. For load rated installations, a concrete slab shall be poured under and around the grate and frame. The concrete slab must be designed taking into consideration local soil conditions, traffic loading, and other applicable design factors. For other installation considerations such as migration of fines, ground water, and soft foundations refer to ASTM D2321 guidelines.

THIS PRINT DISCLOSES SUBJECT MATTER IN WHICH NYLOPLAST HAS PROPRIETARY RIGHTS. THE RECEIPT OR POSSESSION OF THIS PRINT DOES NOT CONFER, TRANSFER, OR LICENSE THE USE OF THE DESIGN OR TECHNICAL INFORMATION SHOWN HEREIN. REPRODUCTION OF THIS PRINT OR ANY INFORMATION CONTAINED HEREIN, OR MANUFACTURE OF ANY ARTICLE HEREFROM, FOR THE DISCLOSURE TO OTHERS IS FORBIDDEN, EXCEPT BY SPECIFIC WRITTEN PERMISSION FROM NYLOPLAST.	DRAWN BY: CJA DATE: 3-10-00 REVISY BY: NNH DATE: 02-21-18	MATERIAL: PROJECT NO. NAME: DATE: 02-21-18	 3130 VERONA AVE BURLINGTON, GA 30518 PHN (770) 932-2443 FAX (770) 932-2489 www.nyloplast-usa.com	8 IN - 36 IN DRAIN BASIN SPECIFICATIONS DWG NO. 7001-110-011 REV J
--	--	--	---	--


NYLOPLAST DRAIN BASIN WITH SOLID COVER

THIS PRINT DISCLOSES SUBJECT MATTER IN WHICH NYLOPLAST HAS PROPRIETARY RIGHTS. THE RECEIPT OR POSSESSION OF THIS PRINT DOES NOT CONFER, TRANSFER, OR LICENSE THE USE OF THE DESIGN OR TECHNICAL INFORMATION SHOWN HEREIN. REPRODUCTION OF THIS PRINT OR ANY INFORMATION CONTAINED HEREIN, OR MANUFACTURE OF ANY ARTICLE HEREFROM, FOR THE DISCLOSURE TO OTHERS IS FORBIDDEN, EXCEPT BY SPECIFIC WRITTEN PERMISSION FROM NYLOPLAST.	DRAWN BY: EBC DATE: 09-14-07 REVISY BY: NNH DATE: 06-13-18	MATERIAL: PROJECT NO. NAME: DATE: 06-13-18	 3130 VERONA AVE BURLINGTON, GA 30518 PHN (770) 932-2443 FAX (770) 932-2489 www.nyloplast-usa.com	8 IN - 36 IN DRAIN BASIN WITH SOLID COVER QUICK SPEC INSTALLATION DETAIL DWG NO. 7001-110-236 REV E
--	---	--	---	--


NON TRAFFIC INSTALLATION

THIS PRINT DISCLOSES SUBJECT MATTER IN WHICH NYLOPLAST HAS PROPRIETARY RIGHTS. THE RECEIPT OR POSSESSION OF THIS PRINT DOES NOT CONFER, TRANSFER, OR LICENSE THE USE OF THE DESIGN OR TECHNICAL INFORMATION SHOWN HEREIN. REPRODUCTION OF THIS PRINT OR ANY INFORMATION CONTAINED HEREIN, OR MANUFACTURE OF ANY ARTICLE HEREFROM, FOR THE DISCLOSURE TO OTHERS IS FORBIDDEN, EXCEPT BY SPECIFIC WRITTEN PERMISSION FROM NYLOPLAST.	DRAWN BY: CJA DATE: 9-30-99 REVISY BY: NNH DATE: 03-11-18	MATERIAL: PROJECT NO. NAME: DATE: 03-11-18	 3130 VERONA AVE BURLINGTON, GA 30518 PHN (770) 932-2443 FAX (770) 932-2489 www.nyloplast-usa.com	8 IN - 36 IN DRAIN BASIN & INLINE DRAIN NON TRAFFIC INSTALLATION DWG NO. 7001-110-111 REV E
--	--	--	---	--

NYLOPLAST RISER EXTENSION: 29 __ AG

THIS PRINT DISCLOSES SUBJECT MATTER IN WHICH NYLOPLAST HAS PROPRIETARY RIGHTS. THE RECEIPT OR POSSESSION OF THIS PRINT DOES NOT CONFER, TRANSFER, OR LICENSE THE USE OF THE DESIGN OR TECHNICAL INFORMATION SHOWN HEREIN. REPRODUCTION OF THIS PRINT OR ANY INFORMATION CONTAINED HEREIN, OR MANUFACTURE OF ANY ARTICLE HEREFROM, FOR THE DISCLOSURE TO OTHERS IS FORBIDDEN, EXCEPT BY SPECIFIC WRITTEN PERMISSION FROM NYLOPLAST.	DRAWN BY: CJA DATE: 9-18-00 REVISY BY: NNH DATE: 3-22-18	MATERIAL: PROJECT NO. NAME: DATE: 3-22-18	 3130 VERONA AVE BURLINGTON, GA 30518 PHN (770) 932-2443 FAX (770) 932-2489 www.nyloplast-usa.com	8 IN - 36 IN RISER EXTENSION DWG NO. 7001-110-065 REV E
--	---	---	---	---


PERFORATION SCHEDULE

THIS PRINT DISCLOSES SUBJECT MATTER IN WHICH NYLOPLAST HAS PROPRIETARY RIGHTS. THE RECEIPT OR POSSESSION OF THIS PRINT DOES NOT CONFER, TRANSFER, OR LICENSE THE USE OF THE DESIGN OR TECHNICAL INFORMATION SHOWN HEREIN. REPRODUCTION OF THIS PRINT OR ANY INFORMATION CONTAINED HEREIN, OR MANUFACTURE OF ANY ARTICLE HEREFROM, FOR THE DISCLOSURE TO OTHERS IS FORBIDDEN, EXCEPT BY SPECIFIC WRITTEN PERMISSION FROM NYLOPLAST.	DRAWN BY: CJA DATE: 7-20-09 REVISY BY: NNH DATE: 11-13-18	MATERIAL: PROJECT NO. NAME: DATE: 11-13-18	 3130 VERONA AVE BURLINGTON, GA 30518 PHN (770) 932-2443 FAX (770) 932-2489 www.nyloplast-usa.com	NYLOPLAST STRUCTURE PERFORATION SCHEDULE DWG NO. 7001-110-068 REV E
--	--	--	---	---

STRUCTURE SIZE	A° ANGLE BETWEEN HOLES	B NUMBER OF HOLES
8"	90°	4
10"	90°	4
12"	60°	6
15"	60°	6
18"	45°	8
24"	45°	8
30"	36°	10
36"	30°	12

*36" Structure Size for Drain Basin only

0899CGCL

THIS PRINT DISCLOSES SUBJECT MATTER IN WHICH NYLOPLAST HAS PROPRIETARY RIGHTS. THE RECEIPT OR POSSESSION OF THIS PRINT DOES NOT CONFER, TRANSFER, OR LICENSE THE USE OF THE DESIGN OR TECHNICAL INFORMATION SHOWN HEREIN. REPRODUCTION OF THIS PRINT OR ANY INFORMATION CONTAINED HEREIN, OR MANUFACTURE OF ANY ARTICLE HEREFROM, FOR THE DISCLOSURE TO OTHERS IS FORBIDDEN, EXCEPT BY SPECIFIC WRITTEN PERMISSION FROM NYLOPLAST.	DRAWN BY: AWA DATE: 7-5-00 REVISY BY: EBC DATE: 2-20-10	MATERIAL: PROJECT NO. NAME: DATE: 2-20-10	 3130 VERONA AVE BURLINGTON, GA 30518 PHN (770) 932-2443 FAX (770) 932-2489 www.nyloplast-usa.com	8" SOLID LOCKING COVER ASSEMBLY DWG NO. 7001-110-036 REV B
--	--	---	---	--

Owner:


Greencrest TPS Hotel, L.P.

3021 Ridge Road, A-120
Rockwall, TX 75082
Phone: (214) 890-9225

~ Civil Engineer ~

F.C. CUNY CORPORATION

#2 Horizon Court • Heath, Texas 75032 • (469) 402-7700
Texas Registered Engineering Firm F-7449




TOWNEPLACE

SUITES

MARRIOTT


908 E. INTERSTATE 30
ROCKWALL, TX 75087


1/23/2021





Cameron A. Slomgren

Drawn By: F.C. CUNY
Checked By: F.C. CUNY
Date: 11/19/2018
Project No.: -
Sheet Title: Storm Sewer Plan
Scale: NTS
Sheet No.: 9B of 14

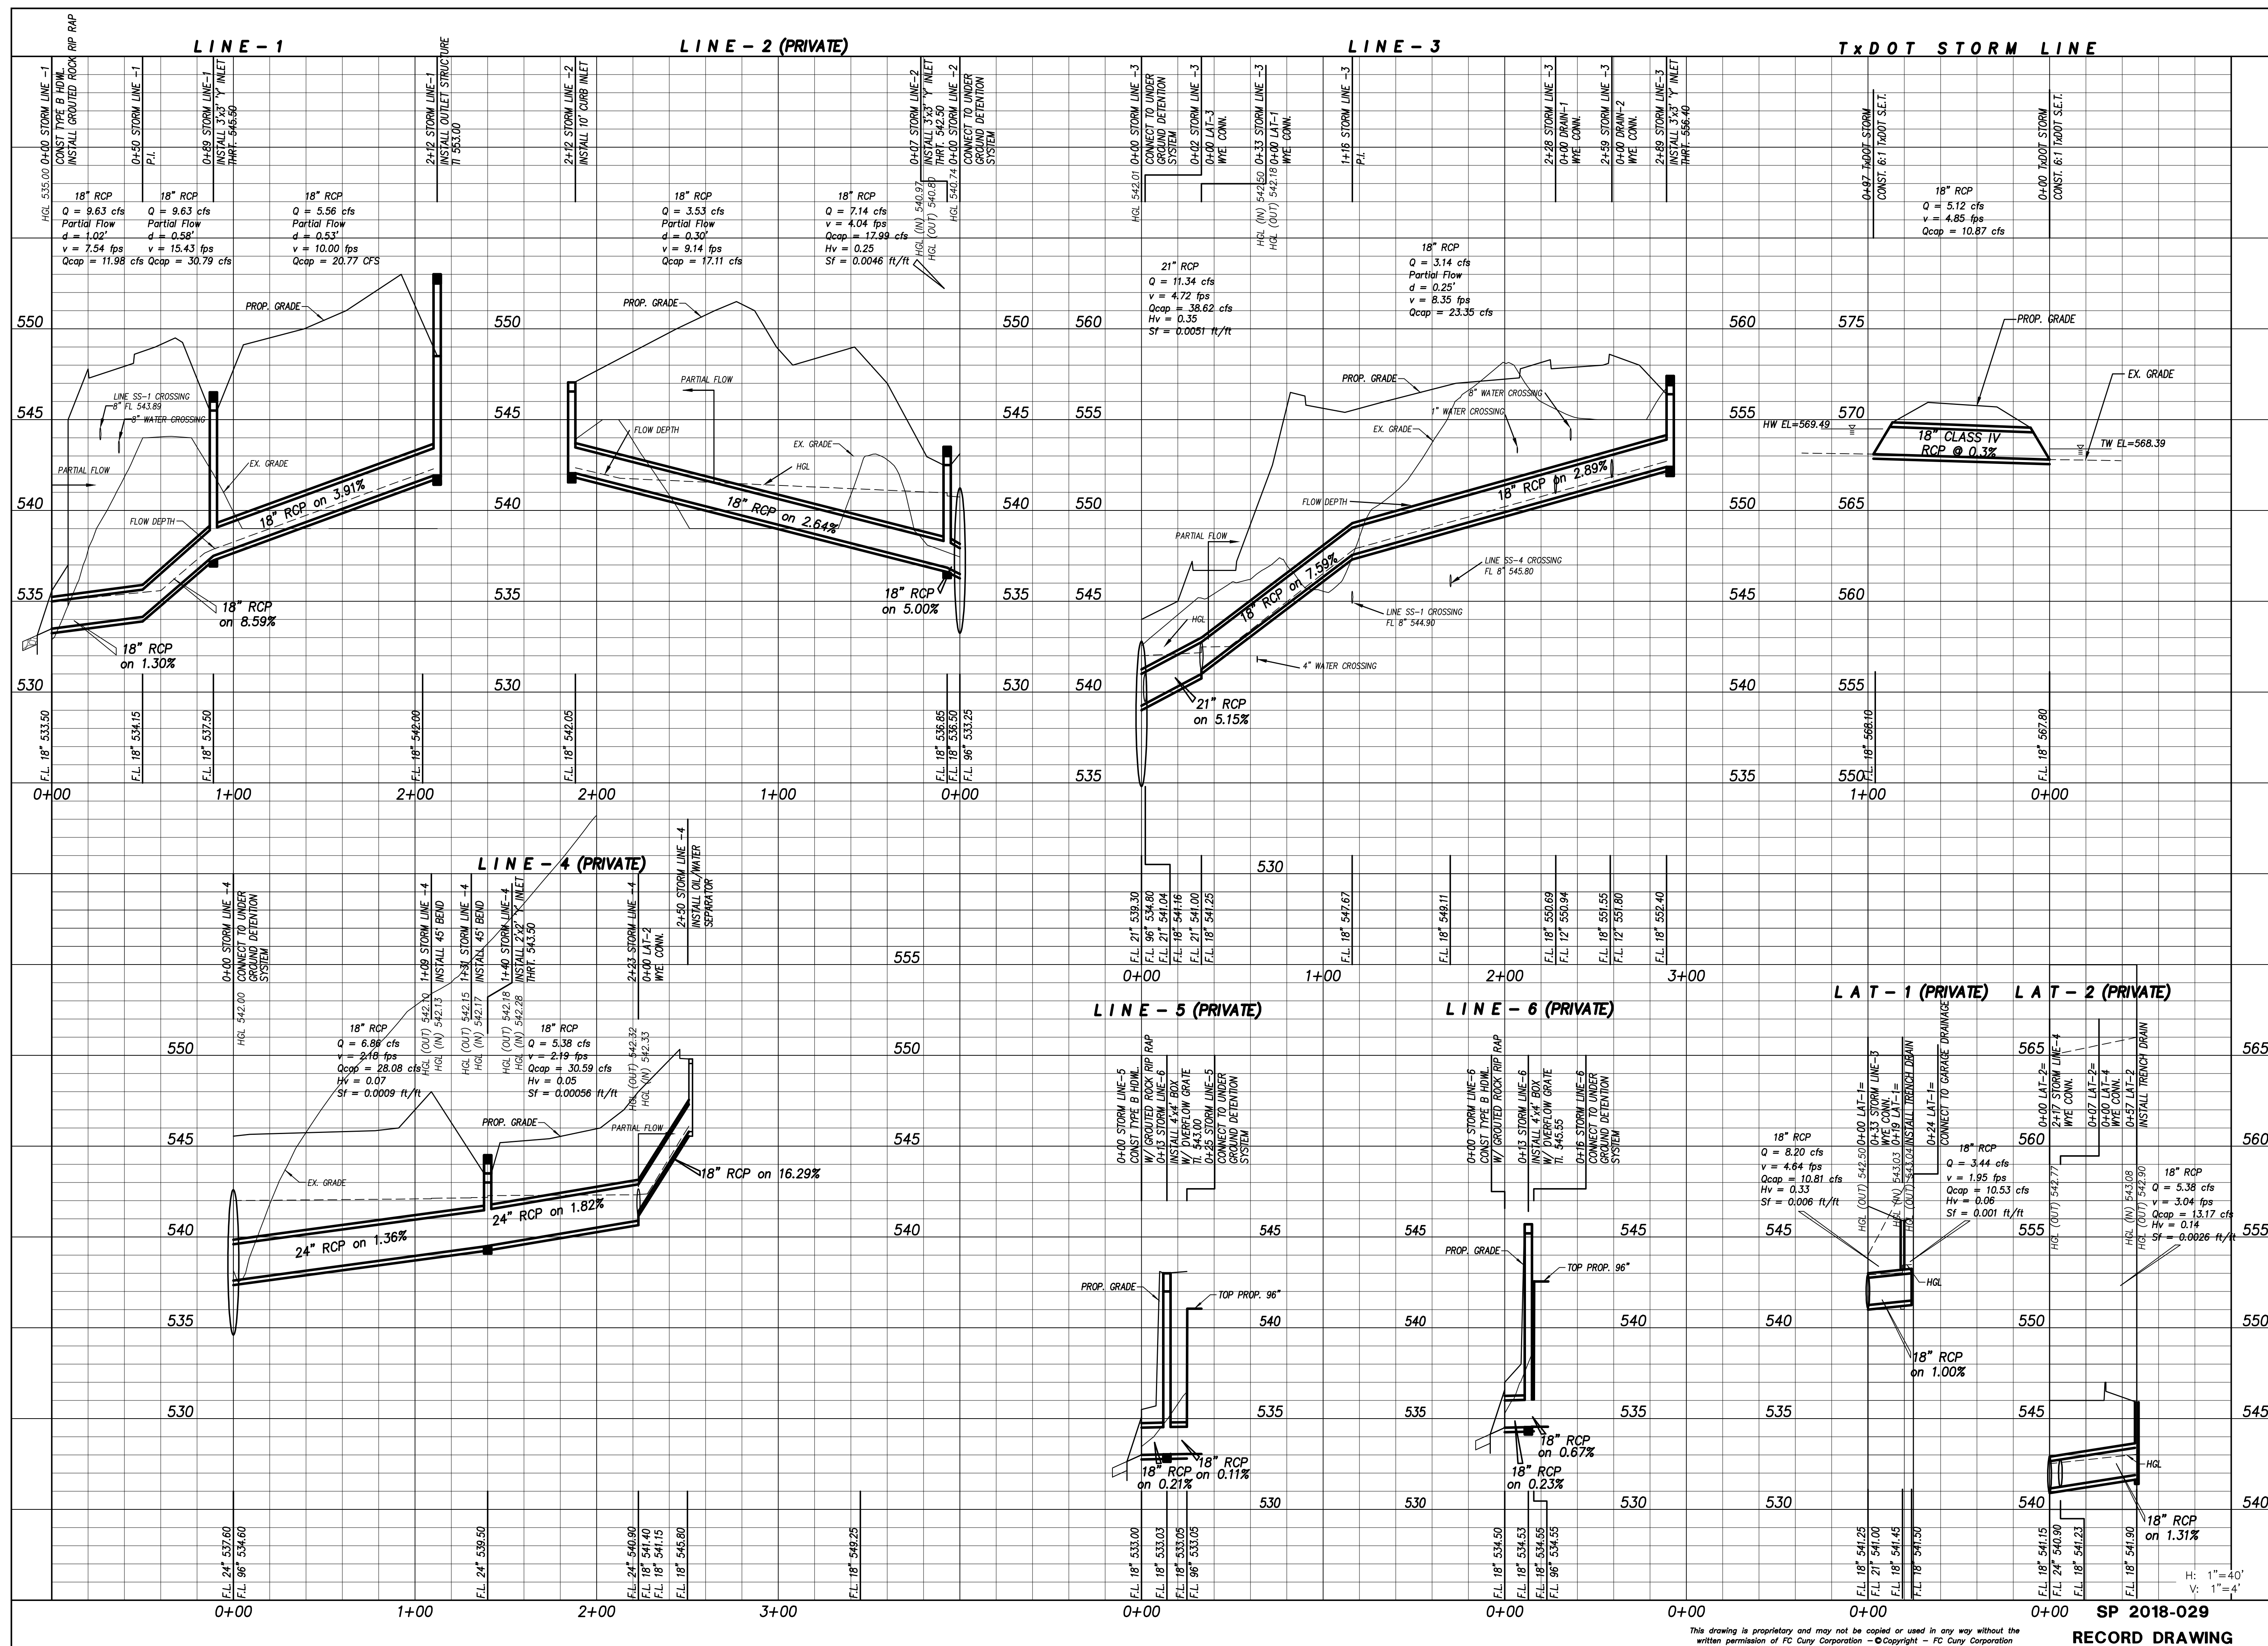[illegible]

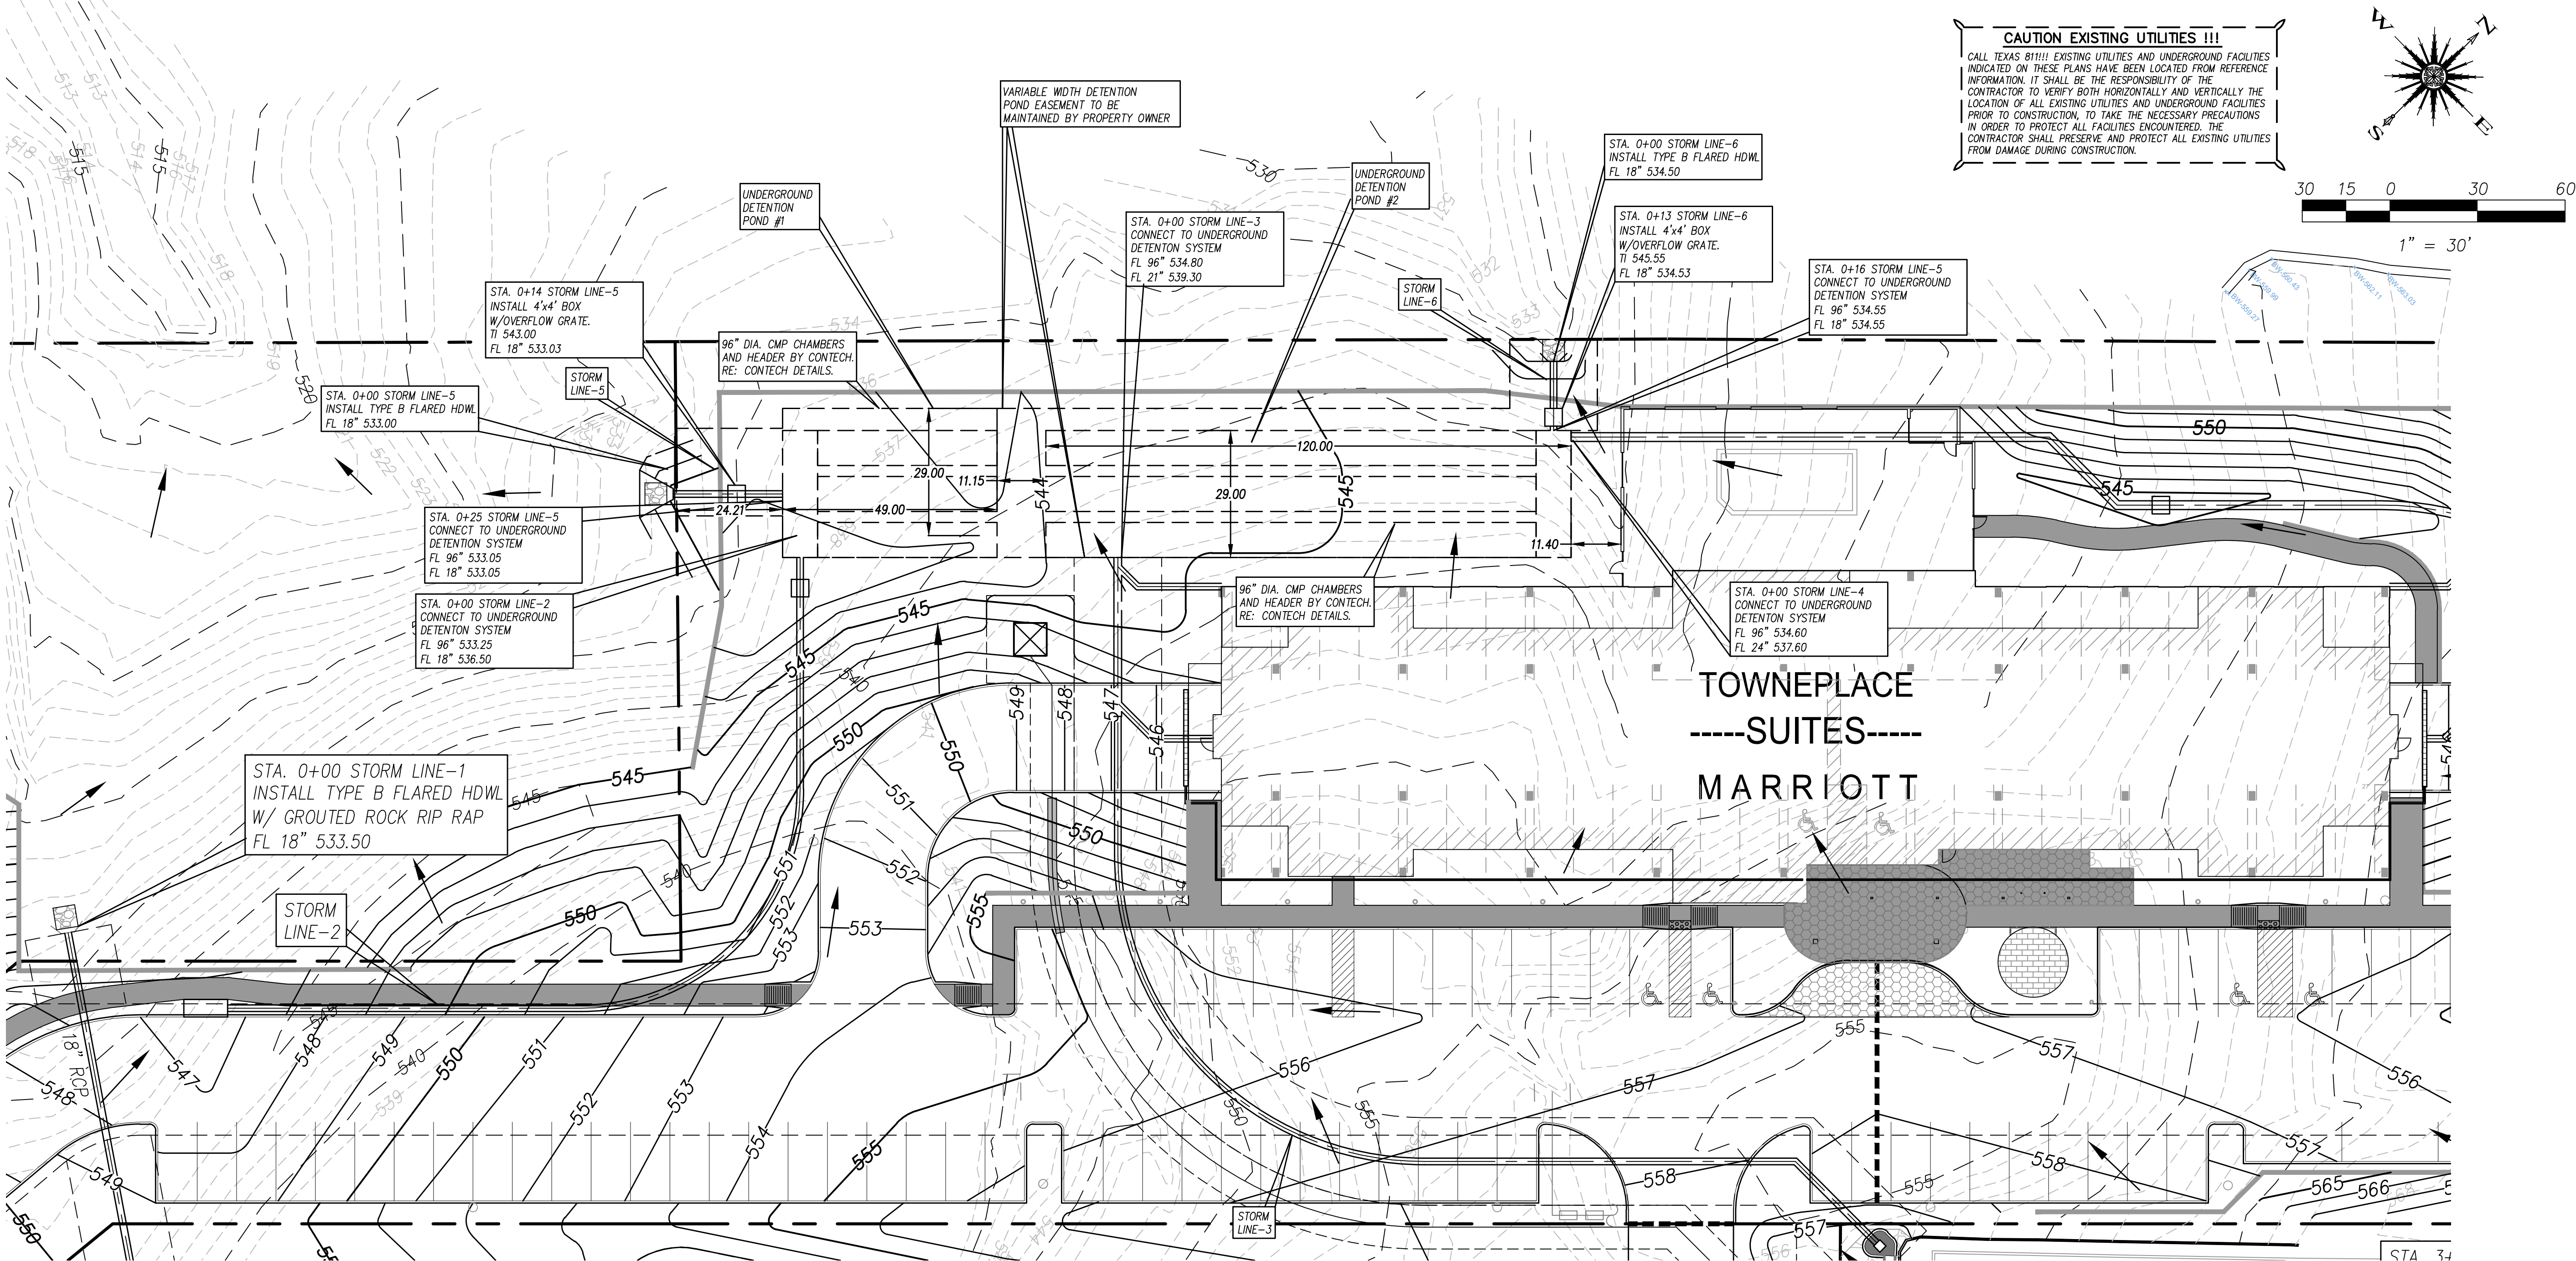

CAUTION EXISTING UTILITIES !!!
CALL TEXAS 811!!! EXISTING UTILITIES AND UNDERGROUND FACILITIES INDICATED ON THESE PLANS HAVE BEEN LOCATED FROM REFERENCE INFORMATION. IT SHALL BE THE RESPONSIBILITY OF THE CONTRACTOR TO VERIFY BOTH HORIZONTALLY AND VERTICALLY THE LOCATION OF ALL EXISTING UTILITIES AND UNDERGROUND FACILITIES PRIOR TO CONSTRUCTION, TO TAKE THE NECESSARY PRECAUTIONS IN ORDER TO PROTECT ALL FACILITIES ENCOUNTERED. THE CONTRACTOR SHALL PRESERVE AND PROTECT ALL EXISTING UTILITIES FROM DAMAGE DURING CONSTRUCTION.

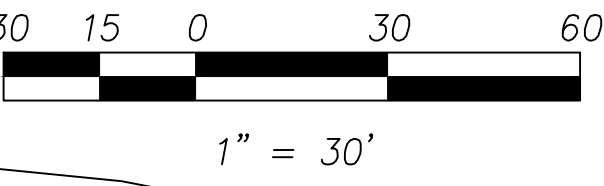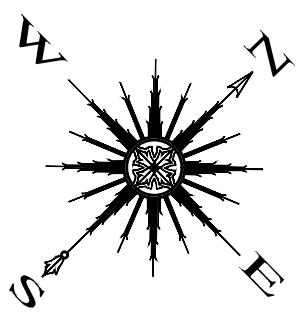

Revision	Date	Description

Owner:
Greentrest TPS Hotel, L.P.

3021 Ridge Road, A-120
Rockwall, TX 75082
Phone: (214) 890-9225

~ Civil Engineer ~
F.C. CUNY CORPORATION
#2 Horizon Court • Heath, Texas 75032 • (409) 402-7700
Texas Registered Engineering Firm F-7449


**TOWNEPLACE
SUITES
MARRIOTT**

908 E. INTERSTATE 30
ROCKWALL, TX 75087

12/23/2021


C. Slown

Drawn By: F.C. CUNY	Checked By: F.C. CUNY
Date: 11/19/2018	Project No.: -
Sheet Title: Detention Pond Plan	
Scale: 1"=30'	Sheet No.: 11 of 14



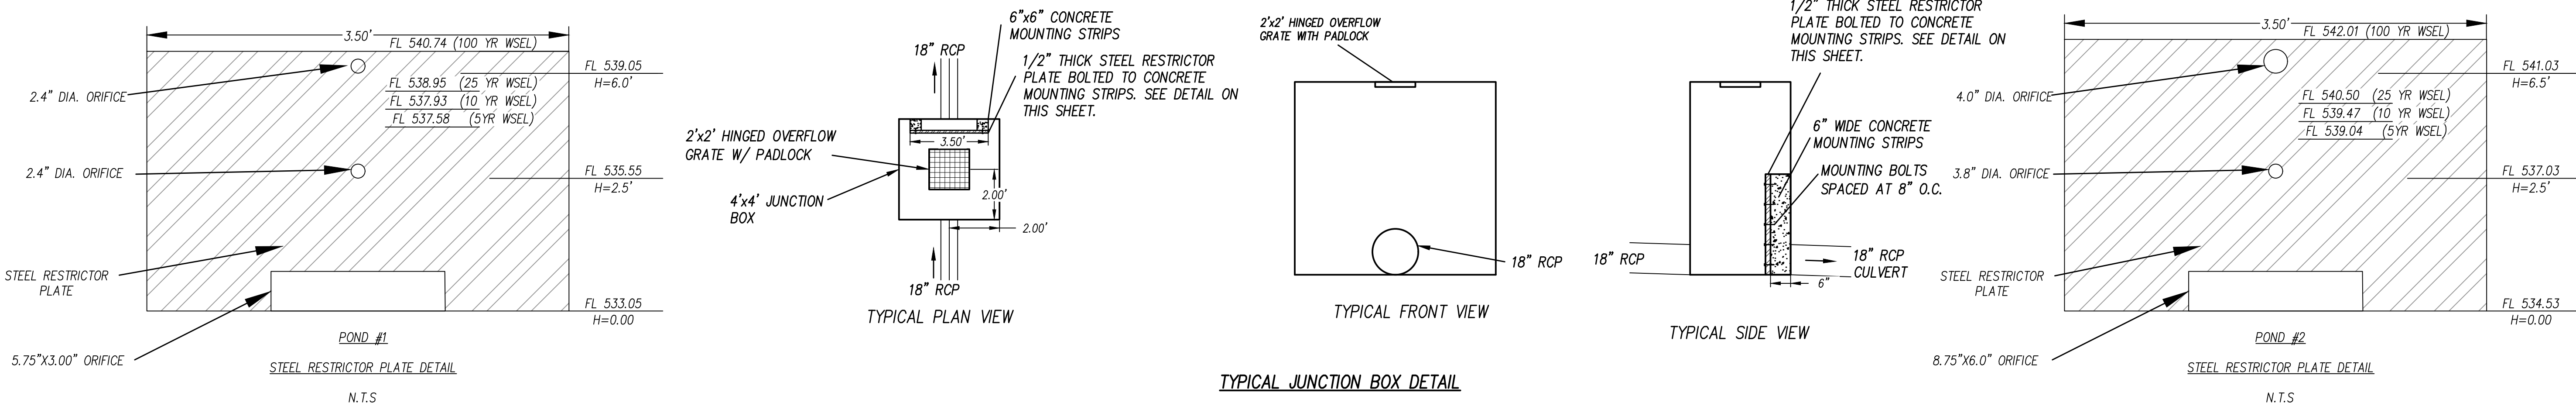


This drawing is proprietary and may not be copied or used in any way without the written permission of FC Cuny Corporation. © Copyright - FC Cuny Corporation

**SP 2018-029
RECORD DRAWING**

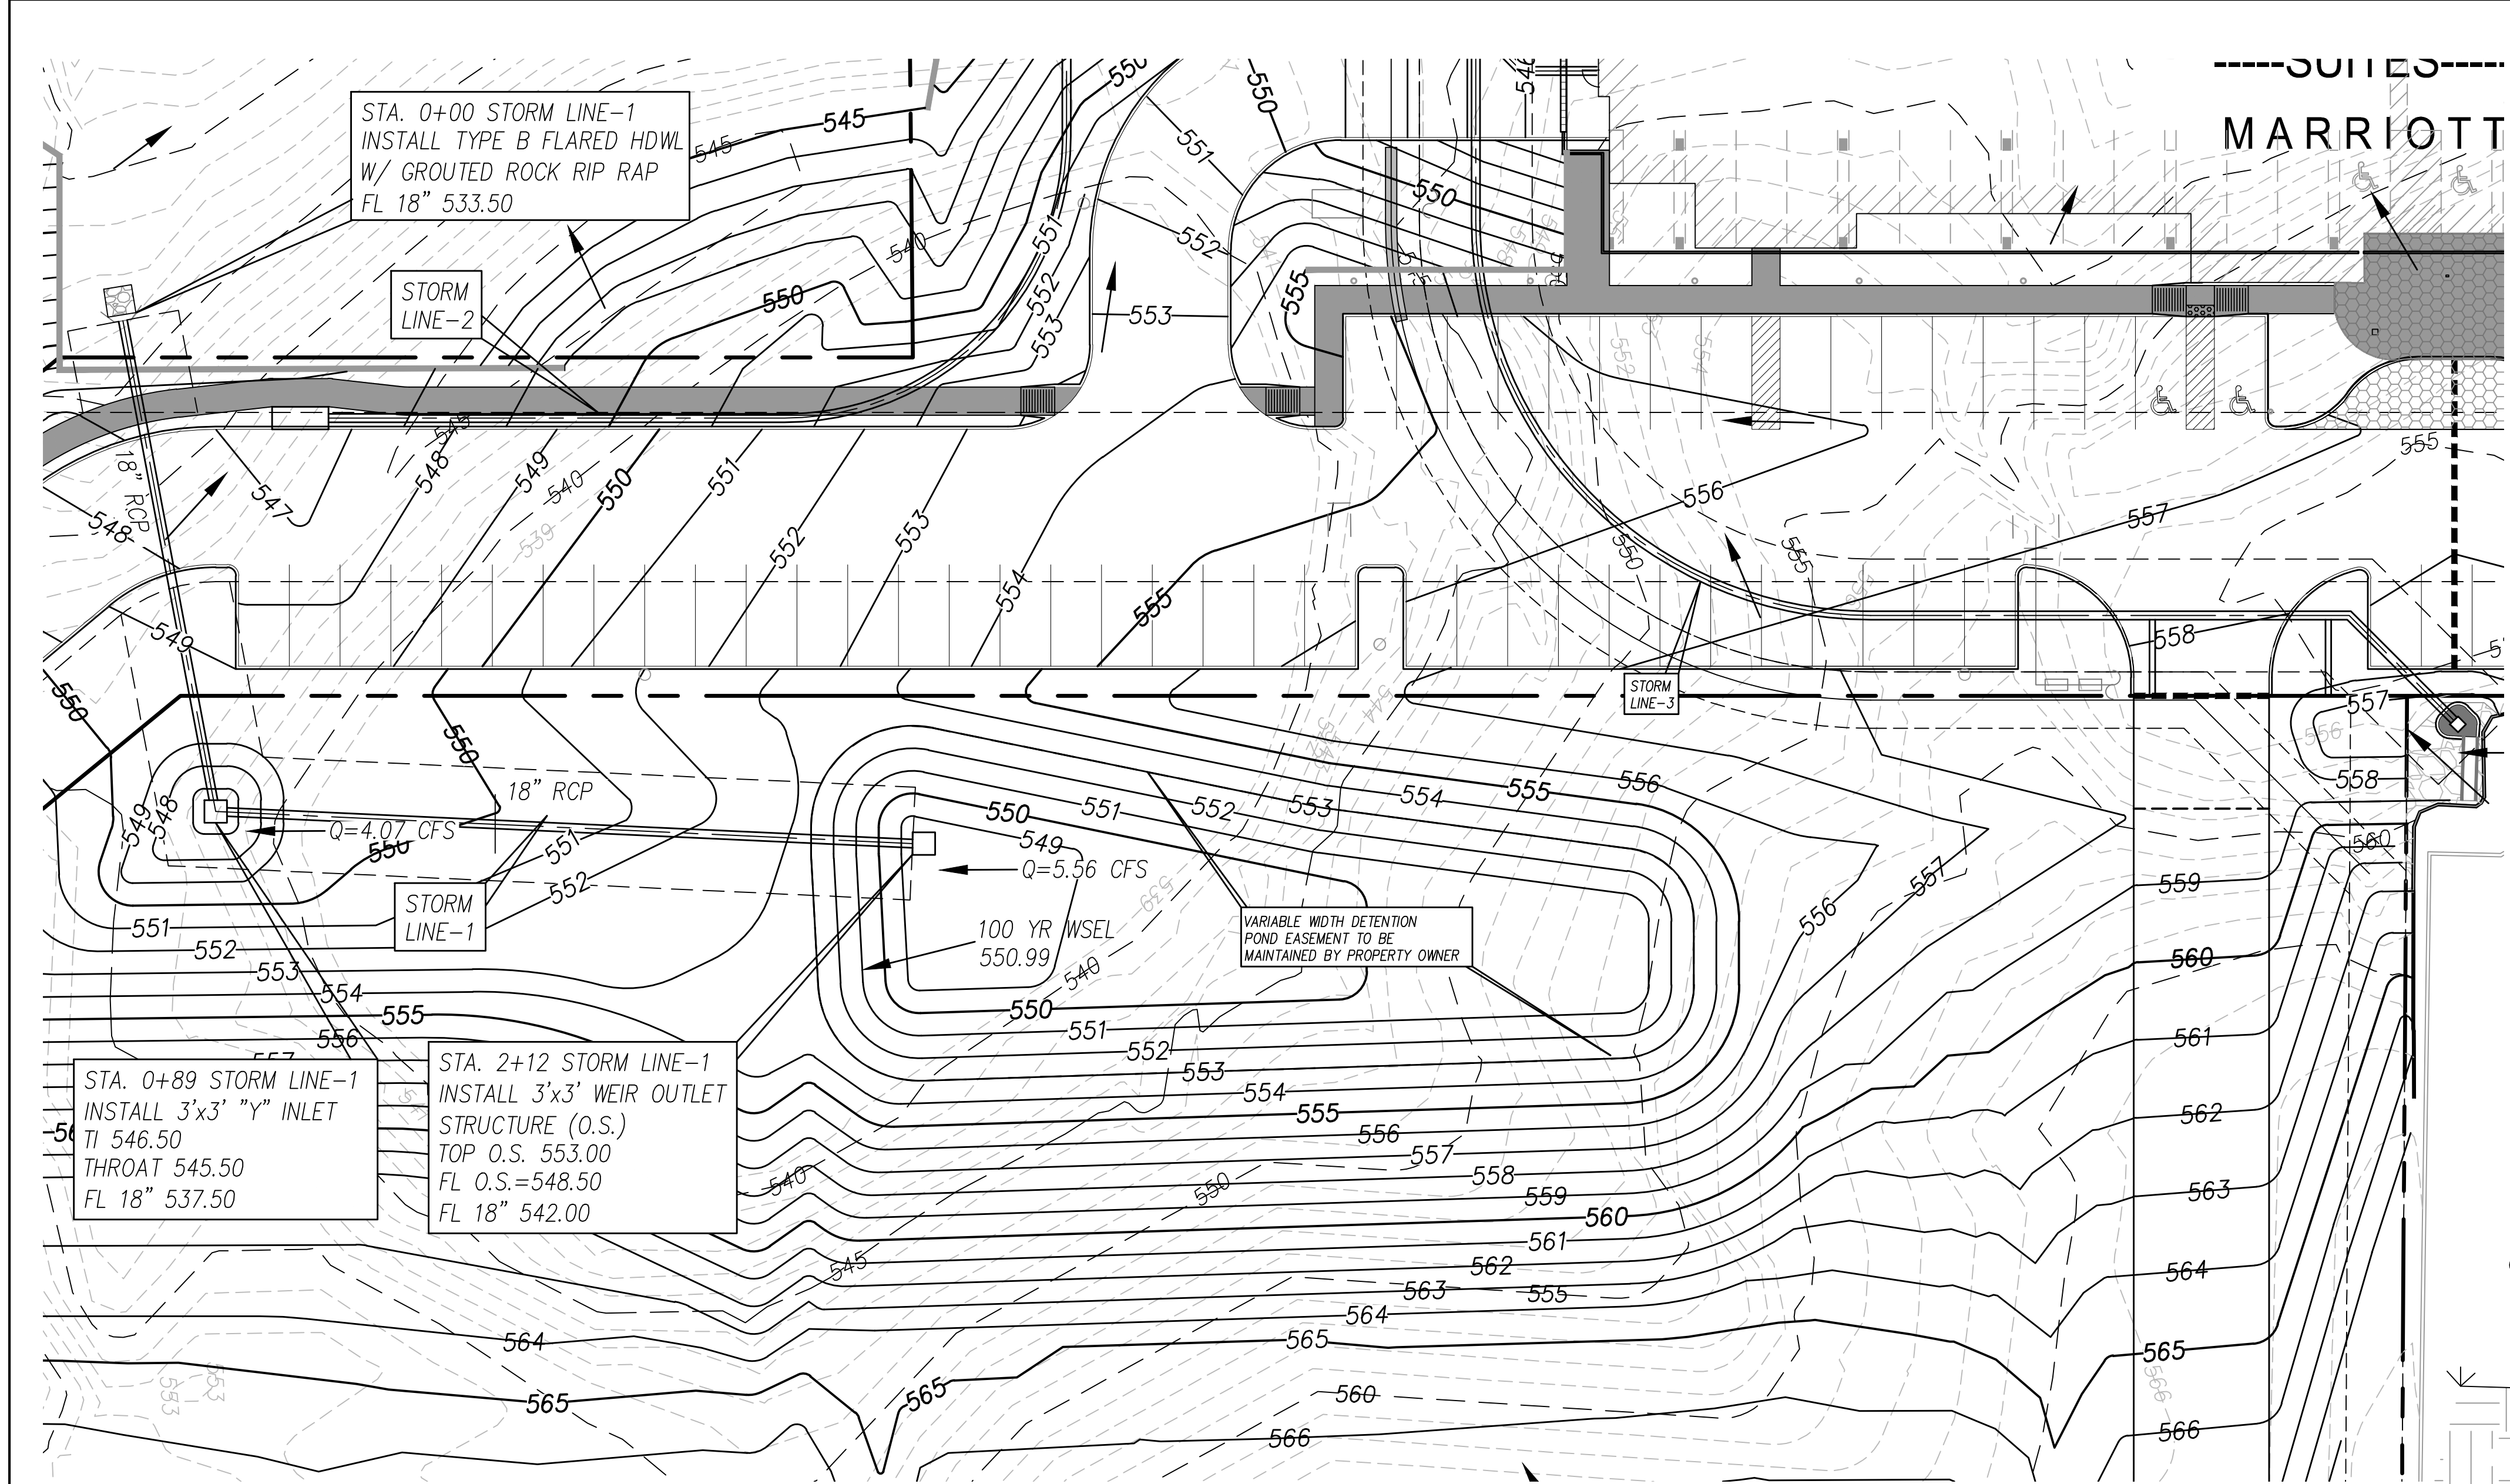

CAUTION EXISTING UTILITIES !!!
CALL TEXAS 811!!! EXISTING UTILITIES AND UNDERGROUND FACILITIES INDICATED ON THESE PLANS HAVE BEEN LOCATED FROM REFERENCE INFORMATION. IT SHALL BE THE RESPONSIBILITY OF THE CONTRACTOR TO VERIFY BOTH HORIZONTALLY AND VERTICALLY THE LOCATION OF ALL EXISTING UTILITIES AND UNDERGROUND FACILITIES PRIOR TO CONSTRUCTION, TO TAKE THE NECESSARY PRECAUTIONS IN ORDER TO PROTECT ALL FACILITIES ENCOUNTERED. THE CONTRACTOR SHALL PRESERVE AND PROTECT ALL EXISTING UTILITIES FROM DAMAGE DURING CONSTRUCTION.

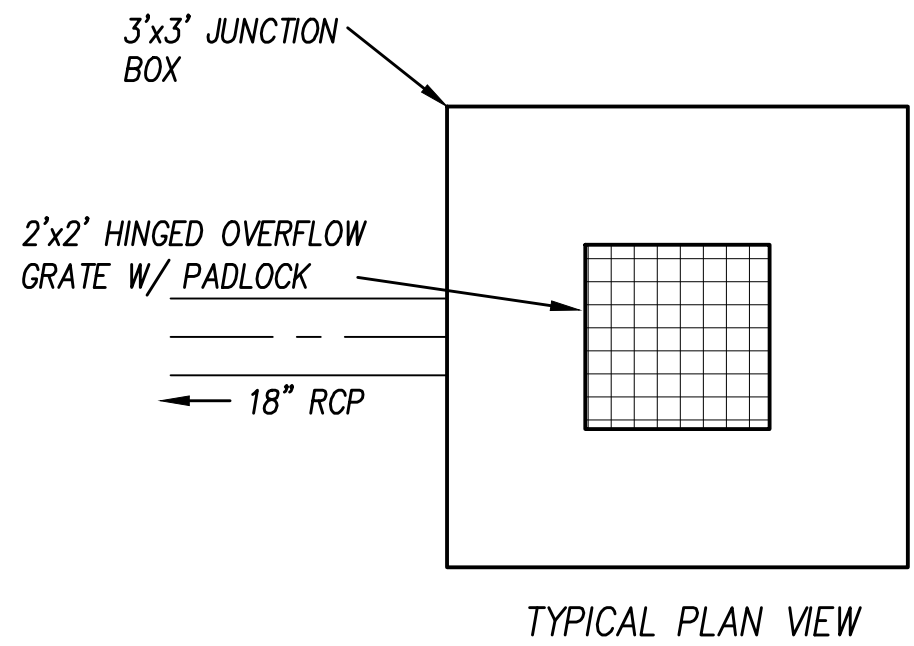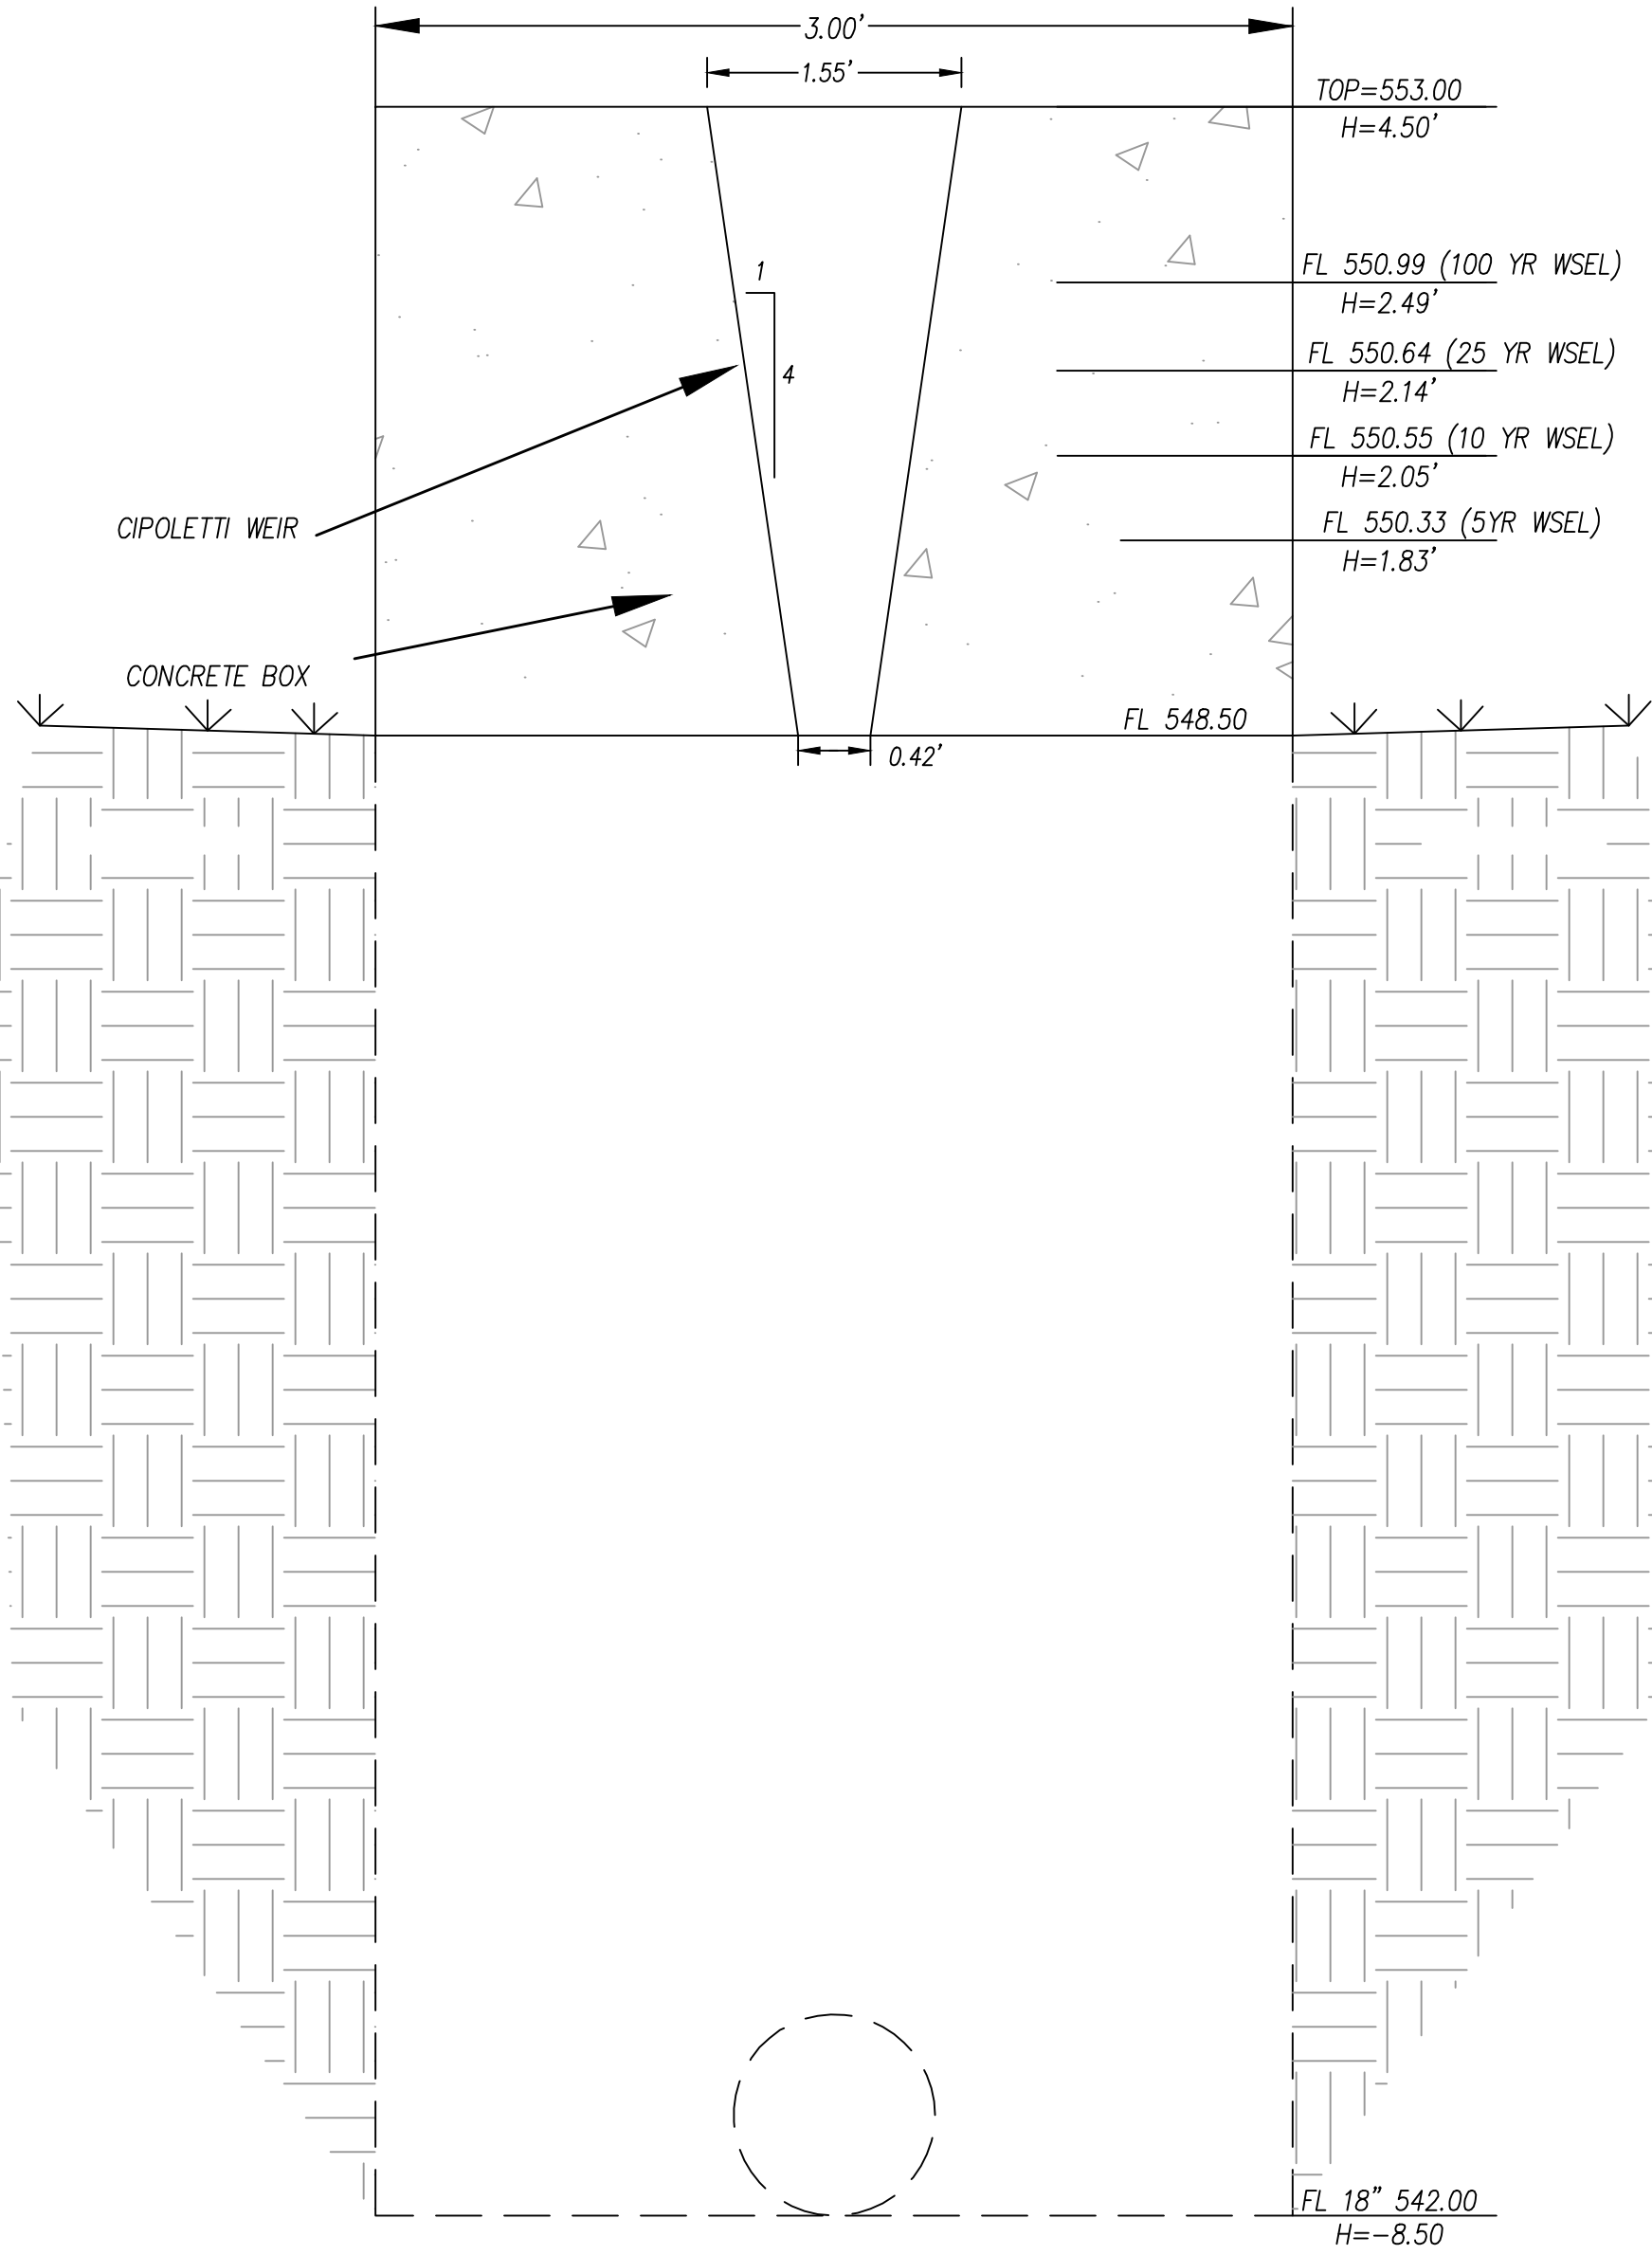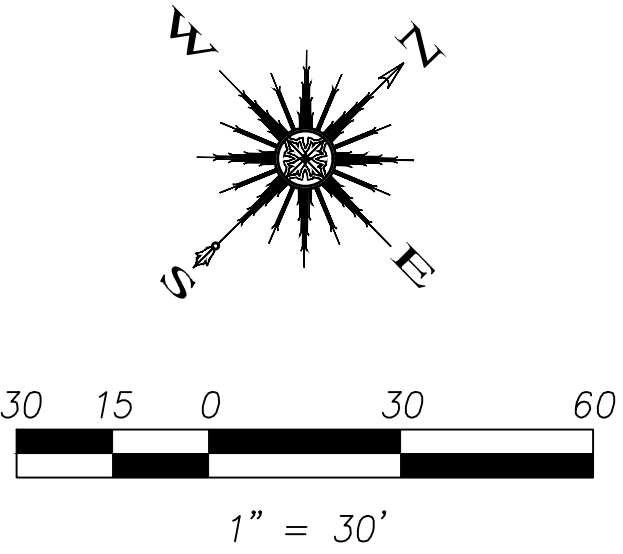

FRONT/SECTION VIEW
N.T.S.

This drawing is proprietary and may not be copied or used in any way without the written permission of FC Cuny Corporation. © Copyright - FC Cuny Corporation

SP 2018-029
RECORD DRAWING

Revision	Date	Description

Owner:

Greentrest TPS Hotel, L.P.

3021 Ridge Road, A-120
Rockwall, TX 75082
Phone: (214) 890-9225

~ Civil Engineer ~

F.C. CUNY CORPORATION
#2 Horizon Court • Heath, Texas 75032 • (469) 402-7700
Texas Registered Engineering Firm F-7449


TOWNEPLACE SUITES MARRIOTT

908 E. INTERSTATE 30
ROCKWALL, TX 75087


12/23/2021

C. Slown


Drawn By: F.C. CUNY	Checked By: F.C. CUNY
Date: 11/19/2018	Project No.: -
Sheet Title: Offsite Detention Pond Plan	
Scale:	Sheet No.:
1"=30'	11a of 14

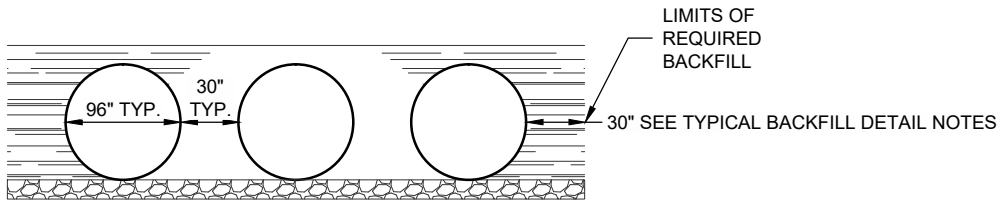


TYPICAL SECTION VIEW
NOT TO SCALE

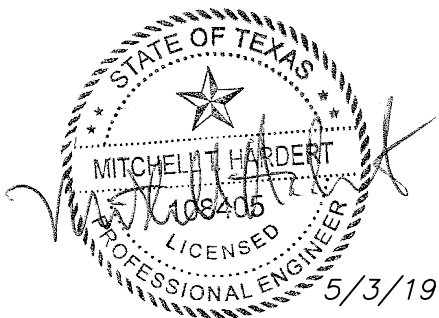

CBC ENGINEERS & ASSOCIATES, LTD.
TBPE FIRM NUMBER F-16105

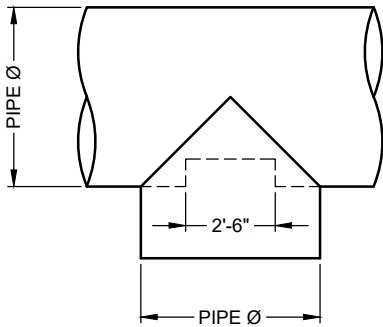


PLAN

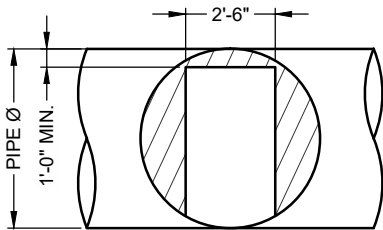

FRONT

48"Ø to 90"Ø FITTING REINFORCEMENT
MAY BE REQUIRED BASED ON HEIGHT OF
COVER AND LIVE LOAD CONDITION

TYPICAL MANWAY DETAIL
NOT TO SCALE

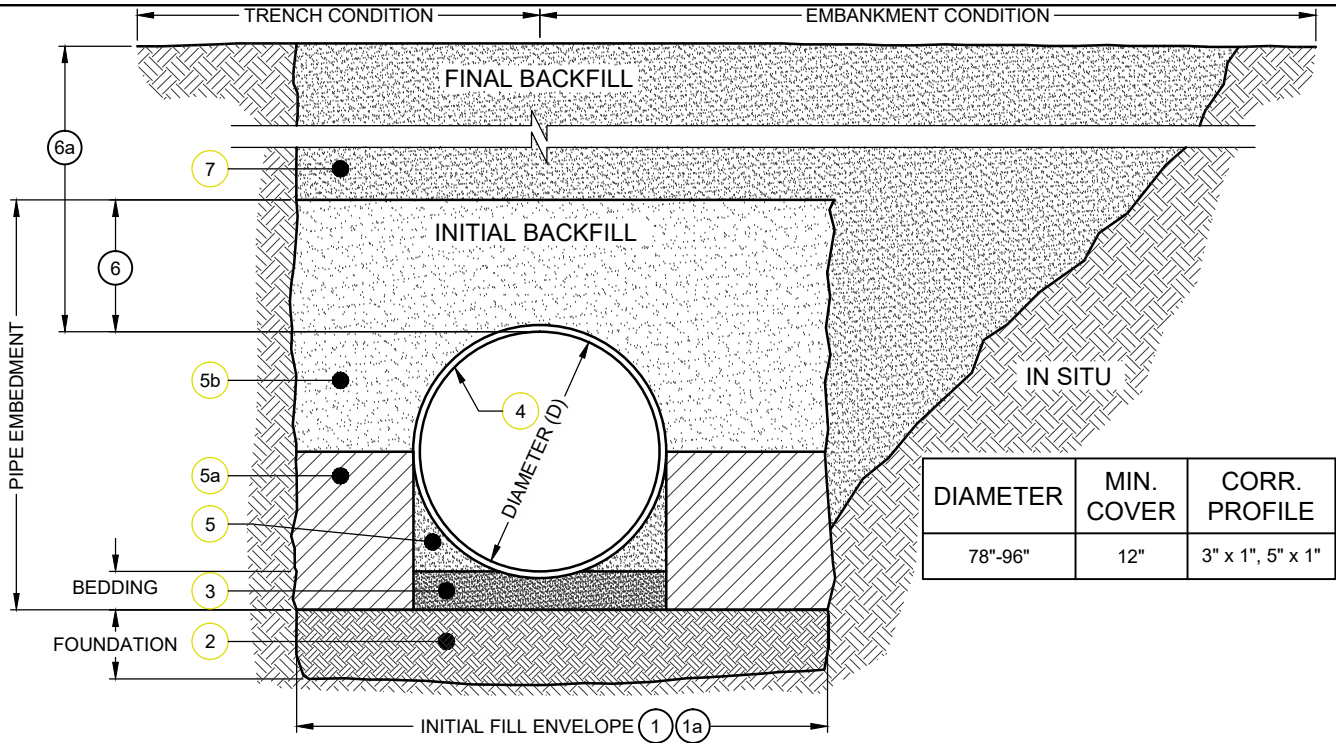

BACKFILL REQUIREMENTS FOLLOW THE GUIDELINES OF AASHTO LRFD BRIDGE DESIGN (SEC 12) AND CONSTRUCTION (SEC 26)

- 1 MINIMUM TRENCH WIDTH MUST ALLOW ROOM FOR PROPER COMPACTION OF HAUNCH MATERIALS UNDER THE PIPE.
THE MINIMUM TRENCH WIDTH (12.6.6.1):
PIPE $\leq 12"$: $D + 16"$
PIPE $> 12"$: $1.5D + 12"$
- 1a MINIMUM EMBANKMENT WIDTH (IN FEET) FOR INITIAL FILL ENVELOPE (12.6.6.2):
PIPE $< 24"$: 3.0D
PIPE 24" - 144": $D + 4'0"$
PIPE $> 144"$: $D + 10'0"$
- 2 THE FOUNDATION UNDER THE PIPE AND SIDE BACKFILL SHALL BE ADEQUATE TO SUPPORT THE LOADS ACTING UPON IT (26.5.2).
- 3 BEDDING MATERIAL SHALL BE A RELATIVELY LOOSE MATERIAL THAT IS ROUGHLY SHAPED TO FIT THE BOTTOM OF THE PIPE, AND A MINIMUM OF TWICE THE CORRUGATION DEPTH IN THICKNESS, WITH THE MAXIMUM PARTICLE SIZE OF ONE-HALF OF THE CORRUGATION DEPTH (26.3.8.1, 26.5.3).
- 4 CORRUGATED STEEL PIPE (CSP / HEL-COR), DIAMETERS 78" - 96"
- 5 HAUNCH ZONE MATERIAL SHALL BE HAND SHOVELED OR SHOVEL SLICED INTO PLACE TO ALLOW FOR PROPER COMPACTION (26.5.4).
- 5a INITIAL BACKFILL SHALL BE WELL GRADED CRUSHED ROCK UP TO 2/3 ABOVE THE INVERT OF THE PIPE.
- 5b BACKFILL PLACED ABOVE THE SPRINGLINE TO MEET AASHTO A-1, A-2 OR A-3 CLASSIFICATION, OR APPROVED EQUAL, COMPACTED TO 90% STANDARD PROCTOR (T 99). MAXIMUM PARTICLE SIZE NOT TO EXCEED 3" (12.4.1.2). ALL LIFTS PLACED IN A CONTROLLED MANNER. IT IS RECOMMENDED THAT LIFTS NOT EXCEED AN 8" UNCOMPACTED LIFT HEIGHT TO PREVENT UNEVEN LOADING, AND THE LESSER OF 1/3 THE DIAMETER OR 24" AS THE MAXIMUM DIFFERENTIAL SIDE-TO-SIDE (26.5.4).
- 6 SAND BACKFILL (AASHTO A-3 OR APPROVED EQUAL) TO BE PLACED FROM FROM 2/3 ABOVE INVERT OF THE PIPE TO 12" ABOVE PIPE.
- 6a TOTAL HEIGHT OF COMPACTED COVER FOR CONVENTIONAL HIGHWAY LOADS IS MEASURED FROM TOP OF PIPE TO BOTTOM OF FLEXIBLE PAVEMENT OR TOP OF RIGID PAVEMENT (12.6.6.3).
- 7 FINAL BACKFILL MATERIAL SELECTION AND COMPACTION REQUIREMENTS SHALL FOLLOW THE PROJECT PLANS AND SPECIFICATIONS PER THE ENGINEER OF RECORD (26.5.4.1).

- NOTES:
- GEOTEXTILE SHOULD BE CONSIDERED FOR USE TO PREVENT SOIL MIGRATION INTO VARYING SOIL TYPES (PROJECT ENGINEER).
 - FOR MULTIPLE BARREL INSTALLATIONS THE RECOMMENDED STANDARD SPACING BETWEEN PARALLEL PIPE RUNS SHALL BE PIPE DIA./2 BUT NO LESS THAN 12", OR 36" FOR PIPE DIAMETERS 72" AND LARGER. CONTACT YOUR CONTECH REPRESENTATIVE FOR NONSTANDARD SPACING (TABLE C12.6.7-1).

TYPICAL BACKFILL DETAIL
NOT TO SCALE

Approved By	MTH	Date	4/30/19	Rev.	Date	By	Description
Project No.	CBC-22340	Rev.	1	1	5/3/19	JBE	REV. 1



The design and information shown on this drawing is provided as a service to the project owner, engineer and contractor by Contech Engineered Solutions LLC ("Contech"). Neither this drawing, nor any part thereof, may be used, reproduced or modified in any manner without the prior written consent of Contech. Failure to comply is done at the user's own risk and Contech expressly disclaims any liability or responsibility for such use.

If discrepancies between the supplied information upon which the drawing is based and actual field conditions are encountered as site work progresses, these discrepancies must be reported to Contech immediately for re-evaluation of the design. Contech accepts no liability for designs based on missing, incomplete or inaccurate information supplied by others.



MARK	DATE	REVISION DESCRIPTION	BY

CONTECH
ENGINEERED SOLUTIONS LLC
www.ContechES.com
11815 NE Glenn Widing Drive, Portland, OR 97220
800-548-4667 503-240-3393 800-561-1271 FAX

CONTECH
CMP DETENTION SYSTEMS
CONTECH
PROPOSAL
DRAWING

96"Ø UNDERGROUND DETENTION SYSTEM - 609760-010
TOWNEPLACE SUITES MARRIOTT - ROCKWALL TX
ROCKWALL, TX
SITE DESIGNATION: POND #2

PROJECT No.:	609760	SEQ. No.:	010	DATE:	4/2/2019
DESIGNED:	SJ	DRAWN:	SJ	APPROVED:	SJ
CHECKED:	SJ	APPROVED:	SJ	SHEET NO.:	C2 OF 5

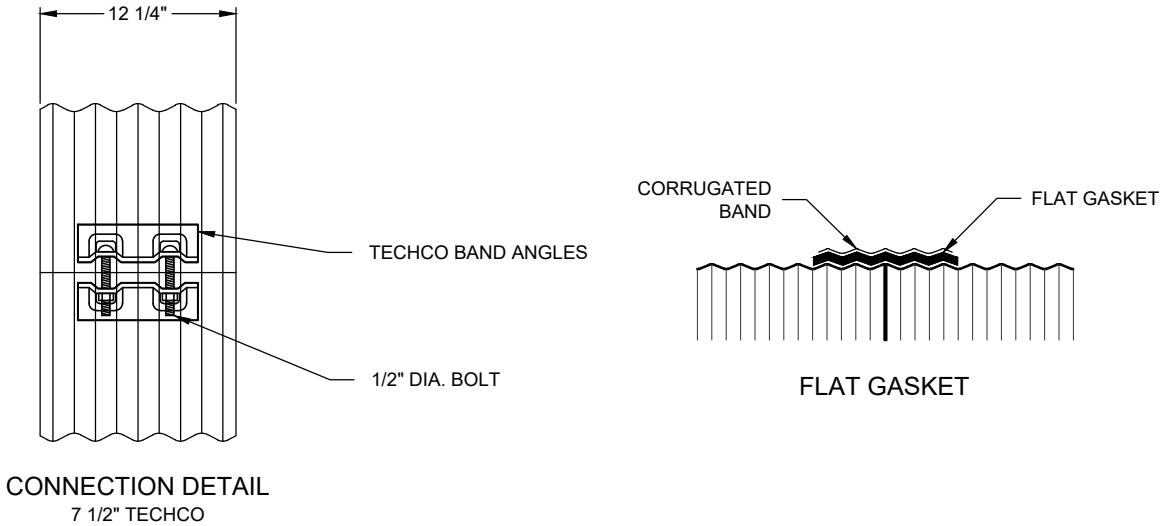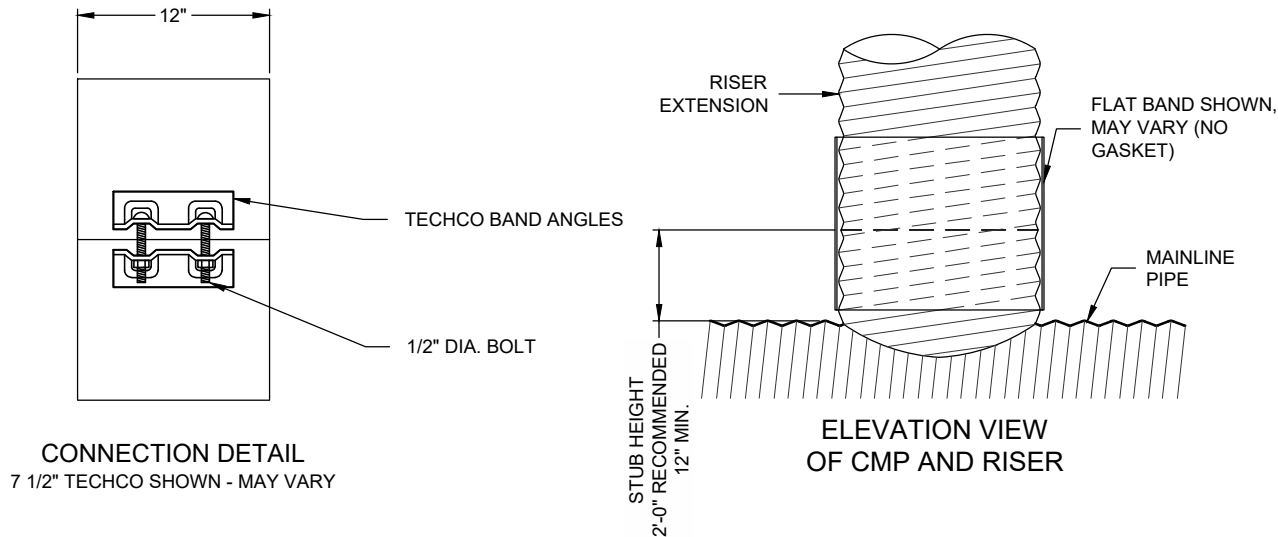


PLAIN END CMP RISER PIPE

GENERAL NOTES:

1. DELIVERED BAND STYLE AND FASTENER TYPE MAY VARY BY FABRICATION PLANT.
2. JOINT IS TO BE ASSEMBLED PER AASHTO BRIDGE CONSTRUCTION SPECIFICATION SEC 26.4.2.4.
3. BAND MATERIAL AND GAGE TO BE SAME AS RISER MATERIAL.
4. IF RISER HAS A HEIGHT OF COVER OF 10' OR MORE, USE A SLIP JOINT.
5. BANDS ARE NORMALLY FURNISHED AS FOLLOWS:
 - 12" THRU 48" 1-PIECE
 - 54" 2-PIECES
6. ALL RISER JOINT COMPONENTS WILL BE FIELD ASSEMBLED.
7. MANHOLE RISERS IN APPLICATIONS WHERE TRAFFIC LOADS ARE IMPOSED REQUIRE SPECIAL DESIGN CONSIDERATIONS.
8. DIMENSIONS SUBJECT TO MANUFACTURING TOLERANCES.

12" RISER BAND DETAIL
NOT TO SCALE

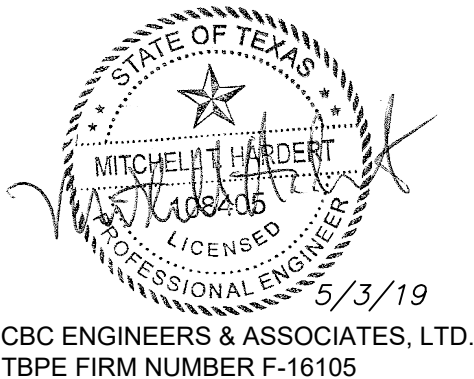

CBC ENGINEERS & ASSOCIATES, LTD.
TBPE FIRM NUMBER F-16105

2 2/3"x1/2" RIVETED PIPE

GENERAL NOTES:

1. JOINT IS TO BE ASSEMBLED PER AASHTO BRIDGE CONSTRUCTION SPECIFICATION SEC 26.4.2.4.
2. BAND MATERIALS AND/OR COATING CAN VARY BY LOCATION. CONTACT YOUR CONTECH REPRESENTATIVE FOR AVAILABILITY.
3. BANDS ARE SHAPED TO MATCH THE PIPE-ARCH WHEN APPLICABLE.
4. BANDS ARE NORMALLY FURNISHED AS FOLLOWS:
 - 12" THRU 48" 1-PIECE
 - 54" THRU 96" 2-PIECES
 - 102" THRU 144" 3-PIECES
5. BAND FASTENERS ARE ATTACHED WITH SPOT WELDS, RIVETS OR HAND WELDS.
6. ALL CMP IS REROLLED TO HAVE ANNULAR END CORRUGATIONS OF 2 2/3"x1/2"
7. DIMENSIONS ARE SUBJECT TO MANUFACTURING TOLERANCES.
8. ORDER SHALL DESIGNATE GASKET OPTION, IF REQUIRED (SEE DETAILS ABOVE).

5-C BAND DETAIL
NOT TO SCALE


Approved By MTH	Date 4/30/19		Rev.	Date	By	Description
Project No. CBC-22340	Rev. 1		1	5/3/19	JBE	REV. 1

<p>The design and information shown on this drawing is provided as a service to the project owner, engineer and contractor by Contech Engineered Solutions LLC ("Contech"). Neither this drawing, nor any part thereof, may be used, reproduced or modified in any manner without the prior written consent of Contech. Failure to comply is done at the user's own risk and Contech expressly disclaims any liability or responsibility for such use.</p> <p>If discrepancies between the supplied information upon which the drawing is based and actual field conditions are encountered as site work progresses, these discrepancies must be reported to Contech immediately for re-evaluation of the design. Contech accepts no liability for designs based on missing, incomplete or inaccurate information supplied by others.</p>	MARK	DATE	REVISION DESCRIPTION	BY

 ENGINEERED SOLUTIONS LLC www.ContechES.com 11815 NE Glenn Widing Drive, Portland, OR 97220 800-548-4667 503-240-3393 800-561-1271 FAX	 CMP DETENTION SYSTEMS CONTECH PROPOSAL DRAWING
---	--

96"Ø UNDERGROUND DETENTION SYSTEM - 609760-010 TOWNEPLACE SUITES MARRIOTT - ROCKWALL TX ROCKWALL, TX SITE DESIGNATION: POND #2		
---	--	--

PROJECT No.: 609760	SEQ. No.: 010	DATE: 4/2/2019
DESIGNED: SJ	DRAWN: SJ	
CHECKED: SJ	APPROVED: SJ	
SHEET NO.: C3 OF 5		

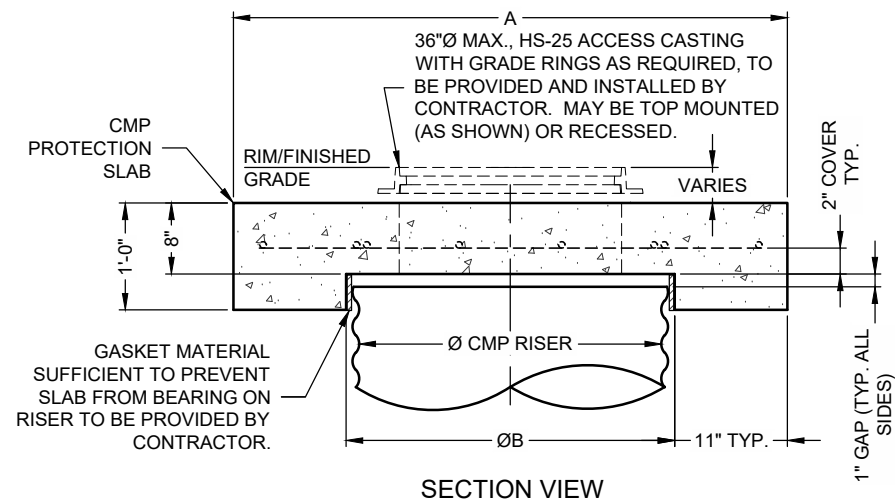

REINFORCING TABLE				
Ø CMP RISER	A	B Ø	REINFORCING	**BEARING PRESSURE (PSF)
24"	4'Ø 4'x4'	26"	#5 @ 10" OCEW #5 @ 10" OCEW	2,540 1,900
30"	4'-6"Ø 4'-6" x 4'-6"	32"	#5 @ 10" OCEW #5 @ 9" OCEW	2,260 1,670
36"	5'Ø 5' x 5'	38"	#5 @ 9" OCEW #5 @ 8" OCEW	2,060 1,500
42"	5'-6"Ø 5'-6" x 5'-6"	44"	#5 @ 8" OCEW #5 @ 8" OCEW	1,490 1,370
48"	6'Ø 6' x 6'	50"	#5 @ 7" OCEW #5 @ 7" OCEW	1,210 1,270

**** ASSUMED SOIL BEARING CAPACITY**

PIPE SPAN, INCHES	AXLE LOADS (kips)			
	18-50	50-75	75-110	110-150
<div>12-42</div> <div>48-72</div> <div>78-120</div> <div>126-144</div>	MINIMUM COVER (FT)			
	2.0	2.5	3.0	3.0
	3.0	3.0	3.5	4.0
	3.0	3.5	4.0	4.0
	3.5	4.0	4.5	4.5

*MINIMUM COVER MAY VARY, DEPENDING ON LOCAL CONDITIONS. THE CONTRACTOR MUST PROVIDE THE ADDITIONAL COVER REQUIRED TO AVOID DAMAGE TO THE PIPE. MINIMUM COVER IS MEASURED FROM THE TOP OF THE PIPE TO THE TOP OF THE MAINTAINED CONSTRUCTION ROADWAY SURFACE.

CONSTRUCTION LOADING DIAGRAM

SPECIFICATION FOR CORRUGATED STEEL PIPE-ALUMINIZED TYPE 2 STEEL

SCOPE

THIS SPECIFICATION COVERS THE MANUFACTURE AND INSTALLATION OF THE CORRUGATED STEEL PIPE (CSP) DETAILED IN THE PROJECT PLANS.

MATERIAL

THE ALUMINIZED TYPE 2 STEEL COILS SHALL CONFORM TO THE APPLICABLE REQUIREMENTS OF AASHTO M274 OR ASTM A929.

PIPE

THE CSP SHALL BE MANUFACTURED IN ACCORDANCE WITH THE APPLICABLE REQUIREMENTS OF AASHTO M36 OR ASTM A760. THE PIPE SIZES, GAGES AND CORRUGATIONS SHALL BE AS SHOWN ON THE PROJECT PLANS.

ALL FABRICATION OF THE PRODUCT SHALL OCCUR WITHIN THE UNITED STATES.


HANDLING AND ASSEMBLY

SHALL BE IN ACCORDANCE WITH RECOMMENDATIONS OF THE
NATIONAL CORRUGATED STEEL PIPE ASSOCIATION (NCSPA)


INSTALLATION

SHALL BE IN ACCORDANCE WITH AASHTO STANDARD SPECIFICATIONS FOR HIGHWAY BRIDGES, SECTION 26, DIVISION II OR ASTM A798 AND IN CONFORMANCE WITH THE PROJECT PLANS AND SPECIFICATIONS. IF THERE ARE ANY INCONSISTENCIES OR CONFLICTS THE CONTRACTOR SHOULD DISCUSS AND RESOLVE WITH THE SITE ENGINEER.

IT IS ALWAYS THE RESPONSIBILITY OF THE CONTRACTOR TO FOLLOW OSHA GUIDELINES FOR SAFE PRACTICES.

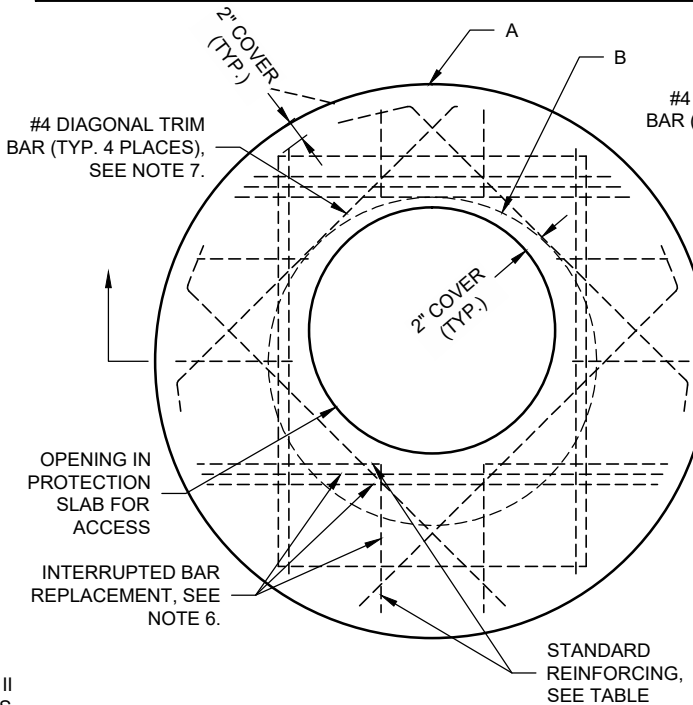

ROUND OPTION PLAN VIEW

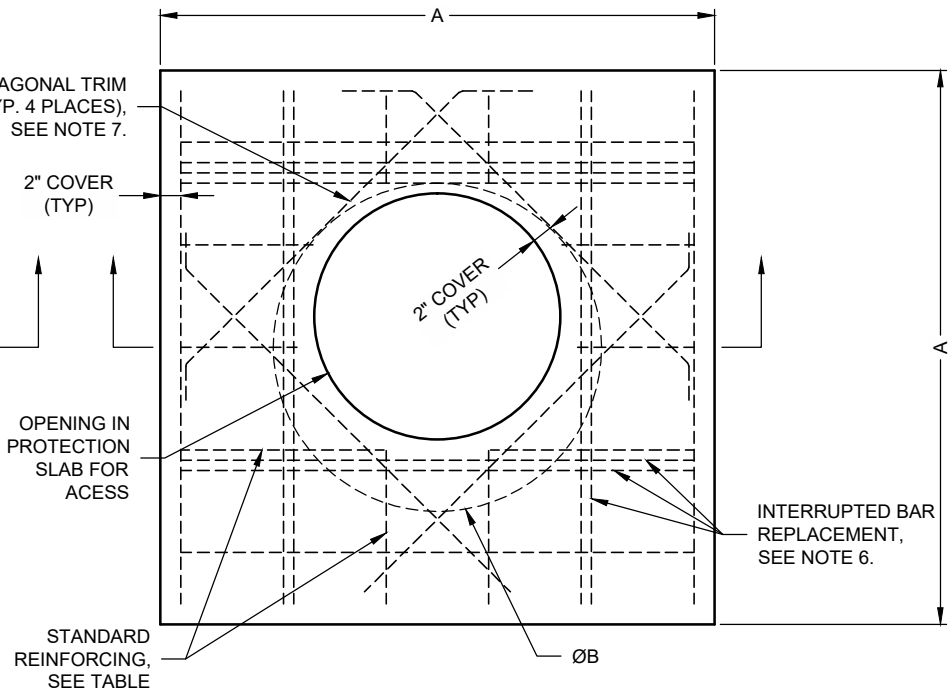

SQUARE OPTION PLAN VIEW

MATERIAL SPECIFICATION

NOT TO SCALE

Approved By	Date		Rev.	Date	By	Description
MTH	4/30/19		1	5/3/19	JBE	REV. 1
Project No.	Rev.					
CBC-22340	1					

The design and information shown on this drawing is provided as a service to the project owner, engineer and contractor by Contech Engineered Solutions LLC ("Contech"). Neither this drawing, nor any part thereof, may be used, reproduced or modified in any manner without the prior written consent of Contech. Failure to comply is done at the user's own risk and Contech expressly disclaims any liability or responsibility for such use.

If discrepancies between the supplied information upon which the drawing is based and actual field conditions are encountered as site work progresses, these discrepancies must be reported to Contech immediately for re-evaluation of the design. Contech accepts no liability for designs based on missing, incomplete or inaccurate information supplied by others.

MARK	DATE	REVISION DESCRIPTION	BY
------	------	----------------------	----

CONTRACTOR TO
ES.

STATE OF TEXAS
★
MITCHELL HARDERT
108405
LICENSED
PROFESSIONAL ENGINEER

5/3/19

CBC ENGINEERS & ASSOCIATES, LTD.
TBPE FIRM NUMBER F-16105

NOTES:


1. DESIGN IN ACCORDANCE WITH AASHTO, 17th EDITION AND ACI 350.
2. DESIGN LOAD HS25.
3. EARTH COVER = 1' MAX.
4. CONCRETE STRENGTH = 4,000 psi
5. REINFORCING STEEL = ASTM A615, GRADE 60.
6. PROVIDE ADDITIONAL REINFORCING AROUND OPENINGS EQUAL TO THE BARS INTERRUPTED, HALF EACH SIDE. ADDITIONAL BARS TO BE IN THE SAME PLANE.

7. TRIM OPENING WITH DIAGONAL #4 BARS, EXTEND BARS A MINIMUM OF 12" BEYOND OPENING, BEND BARS AS REQUIRED TO MAINTAIN BAR COVER.
8. PROTECTION SLAB AND ALL MATERIALS TO BE PROVIDED AND INSTALLED BY CONTRACTOR.
9. DETAIL DESIGN BY DELTA ENGINEERS, ARCHITECTS AND LAND SURVEYORS, ENDWELL, NY.


MANHOLE CAP DETAIL

NOT TO SCALE


PROJECT No.: 609760	SEQ. No.: 010	DATE: 4/2/2019
DESIGNED: SJ		DRAWN: SJ
CHECKED: SJ		APPROVED: SJ
SHEET NO.: C4 OF 5		

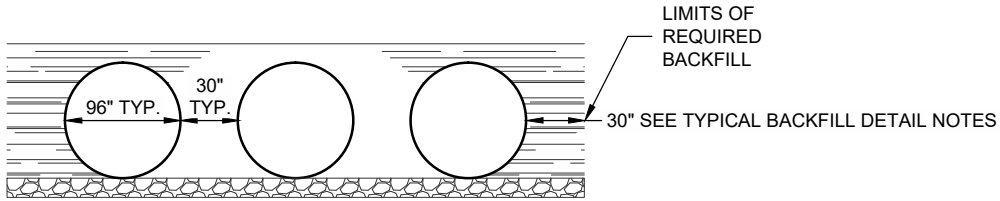


TYPICAL SECTION VIEW
NOT TO SCALE

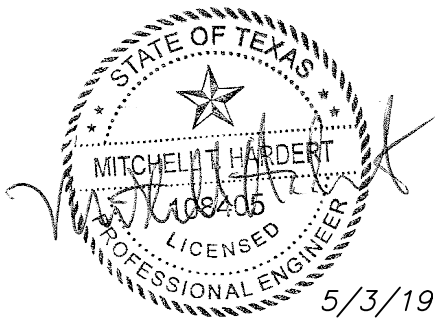

5/3/19
CBC ENGINEERS & ASSOCIATES, LTD.
TBPE FIRM NUMBER F-16105

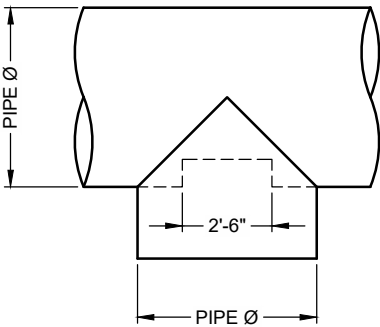


PLAN

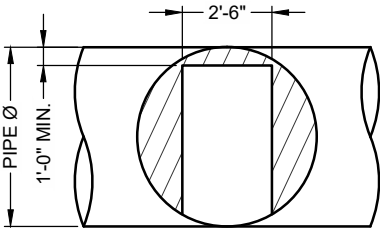

FRONT

48"Ø to 90"Ø FITTING REINFORCEMENT
MAY BE REQUIRED BASED ON HEIGHT OF
COVER AND LIVE LOAD CONDITION

TYPICAL MANWAY DETAIL
NOT TO SCALE

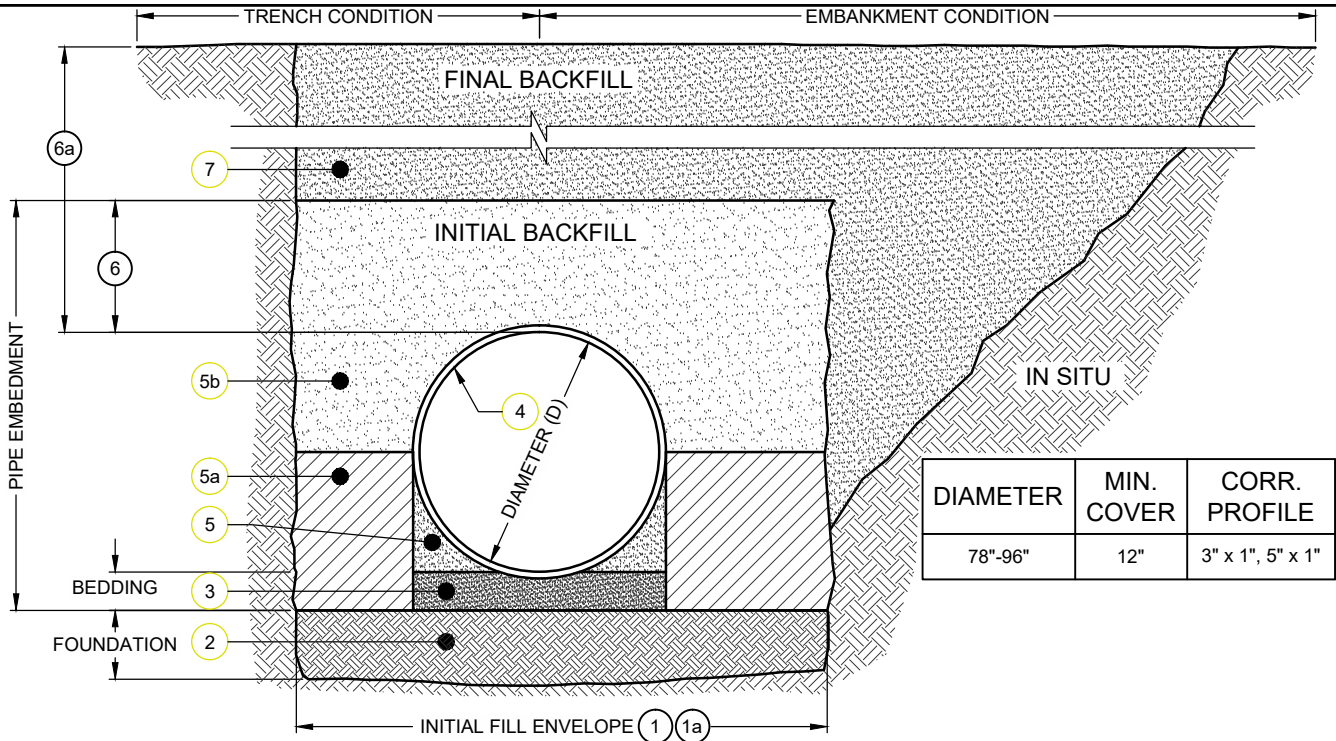

BACKFILL REQUIREMENTS FOLLOW THE GUIDELINES OF AASHTO LRFD BRIDGE DESIGN (SEC 12) AND CONSTRUCTION (SEC 26)

- 1 MINIMUM TRENCH WIDTH MUST ALLOW ROOM FOR PROPER COMPACTION OF HAUNCH MATERIALS UNDER THE PIPE.
THE MINIMUM TRENCH WIDTH (12.6.6.1):
PIPE ≤ 12": D + 16"
PIPE > 12": 1.5D + 12"
- 1a MINIMUM EMBANKMENT WIDTH (IN FEET) FOR INITIAL FILL ENVELOPE (12.6.6.2):
PIPE < 24": 3.0D
PIPE 24" - 144": D + 4'0"
PIPE > 144": D + 10'0"
- 2 THE FOUNDATION UNDER THE PIPE AND SIDE BACKFILL SHALL BE ADEQUATE TO SUPPORT THE LOADS ACTING UPON IT (26.5.2).
- 3 BEDDING MATERIAL SHALL BE A RELATIVELY LOOSE MATERIAL THAT IS ROUGHLY SHAPED TO FIT THE BOTTOM OF THE PIPE, AND A MINIMUM OF TWICE THE CORRUGATION DEPTH IN THICKNESS, WITH THE MAXIMUM PARTICLE SIZE OF ONE-HALF OF THE CORRUGATION DEPTH (26.3.8.1, 26.5.3).
- 4 CORRUGATED STEEL PIPE (CSP / HEL-COR), DIAMETERS 78" - 96"
- 5 HAUNCH ZONE MATERIAL SHALL BE HAND SHOVELED OR SHOVEL SLICED INTO PLACE TO ALLOW FOR PROPER COMPACTION (26.5.4).
- 5a INITIAL BACKFILL SHALL BE WELL GRADED CRUSHED ROCK UP TO 2/3 ABOVE THE INVERT OF THE PIPE.
- 5b BACKFILL PLACED ABOVE THE SPRINGLINE TO MEET AASHTO A-1, A-2 OR A-3 CLASSIFICATION, OR APPROVED EQUAL, COMPACTED TO 90% STANDARD PROCTOR (T 99). MAXIMUM PARTICLE SIZE NOT TO EXCEED 3" (12.4.1.2). ALL LIFTS PLACED IN A CONTROLLED MANNER. IT IS RECOMMENDED THAT LIFTS NOT EXCEED AN 8" UNCOMPACTED LIFT HEIGHT TO PREVENT UNEVEN LOADING, AND THE LESSER OF 1/3 THE DIAMETER OR 24" AS THE MAXIMUM DIFFERENTIAL SIDE-TO-SIDE (26.5.4).
- 6 SAND BACKFILL (AASHTO A-3 OR APPROVED EQUAL) TO BE PLACED FROM FROM 2/3 ABOVE INVERT OF THE PIPE TO 12" ABOVE PIPE.
- 6a TOTAL HEIGHT OF COMPACTED COVER FOR CONVENTIONAL HIGHWAY LOADS IS MEASURED FROM TOP OF PIPE TO BOTTOM OF FLEXIBLE PAVEMENT OR TOP OF RIGID PAVEMENT (12.6.6.3).
- 7 FINAL BACKFILL MATERIAL SELECTION AND COMPACTION REQUIREMENTS SHALL FOLLOW THE PROJECT PLANS AND SPECIFICATIONS PER THE ENGINEER OF RECORD (26.5.4.1).

- NOTES:
- GEOTEXTILE SHOULD BE CONSIDERED FOR USE TO PREVENT SOIL MIGRATION INTO VARYING SOIL TYPES (PROJECT ENGINEER).
 - FOR MULTIPLE BARREL INSTALLATIONS THE RECOMMENDED STANDARD SPACING BETWEEN PARALLEL PIPE RUNS SHALL BE PIPE DIA./2 BUT NO LESS THAN 12", OR 36" FOR PIPE DIAMETERS 72" AND LARGER. CONTACT YOUR CONTECH REPRESENTATIVE FOR NONSTANDARD SPACING (TABLE C12.6.7-1).

TYPICAL BACKFILL DETAIL
NOT TO SCALE

Approved By	MTH	Date	4/30/19	Rev.	Date	By	Description
Project No.	CBC-22340	Rev.	-				



The design and information shown on this drawing is provided as a service to the project owner, engineer and contractor by Contech Engineered Solutions LLC ("Contech"). Neither this drawing, nor any part thereof, may be used, reproduced or modified in any manner without the prior written consent of Contech. Failure to comply is done at the user's own risk and Contech expressly disclaims any liability or responsibility for such use.

If discrepancies between the supplied information upon which the drawing is based and actual field conditions are encountered as site work progresses, these discrepancies must be reported to Contech immediately for re-evaluation of the design. Contech accepts no liability for designs based on missing, incomplete or inaccurate information supplied by others.


MARK	DATE	REVISION DESCRIPTION	BY

CONTECH
ENGINEERED SOLUTIONS LLC
www.ContechES.com
11815 NE Glenn Widing Drive, Portland, OR 97220
800-548-4667 503-240-3393 800-561-1271 FAX

CONTECH
CMP DETENTION SYSTEMS
CONTECH
PROPOSAL
DRAWING

96"Ø UNDERGROUND DETENTION SYSTEM - 609760-020
TOWNEPLACE SUITES MARRIOTT - ROCKWALL TX
ROCKWALL, TX
SITE DESIGNATION: NORTHWEST

PROJECT No.:	609760	SEQ. No.:	020	DATE:	2/13/2019
DESIGNED:	SJ	DRAWN:	SJ	APPROVED:	SJ
CHECKED:	SJ	APPROVED:	SJ		
SHEET NO.:	C2	OF	5		

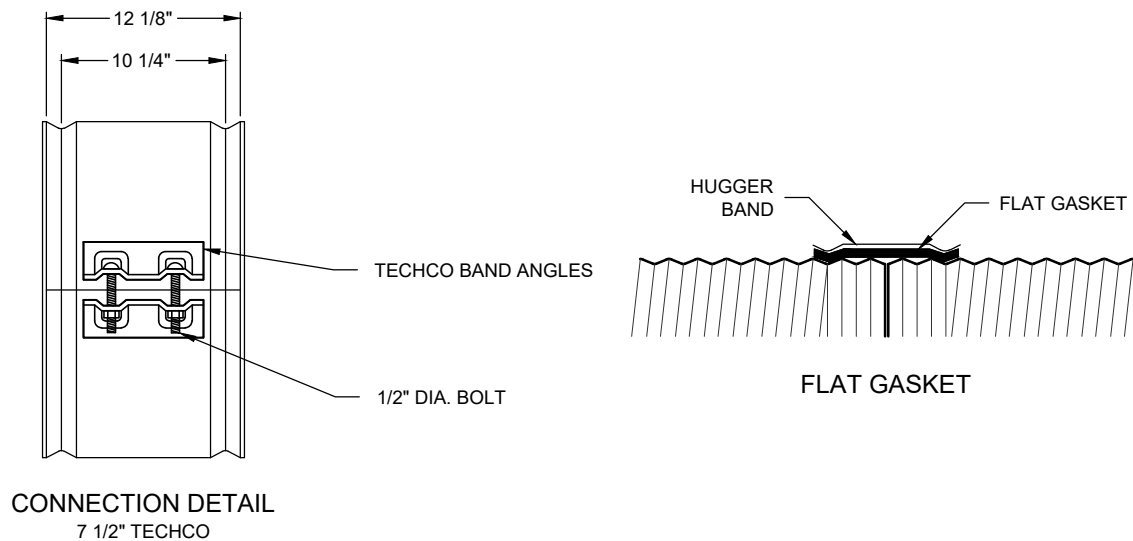


2 2/3"x1/2" RE-ROLLED END HEL-COR PIPE

GENERAL NOTES:

- JOINT IS TO BE ASSEMBLED PER AASHTO BRIDGE CONSTRUCTION SPECIFICATION SEC 26.4.2.4.
- BAND MATERIALS AND/OR COATING CAN VARY BY LOCATION. CONTACT YOUR CONTECH REPRESENTATIVE FOR AVAILABILITY.
- BANDS ARE SHAPED TO MATCH THE PIPE-ARCH WHEN APPLICABLE.
- BANDS ARE NORMALLY FURNISHED AS FOLLOWS:
 - 12" THRU 48" 1-PIECE
 - 54" THRU 96" 2-PIECES
 - 102" THRU 144" 3-PIECES
- BAND FASTENERS ARE ATTACHED WITH SPOT WELDS, RIVETS OR HAND WELDS.
- ALL CMP IS REROLLED TO HAVE ANNULAR END CORRUGATIONS OF 2 2/3"x1/2"
- DIMENSIONS ARE SUBJECT TO MANUFACTURING TOLERANCES.
- ORDER SHALL DESIGNATE GASKET OPTION, IF REQUIRED (SEE DETAILS ABOVE).

H-12 HUGGER BAND DETAIL

NOT TO SCALE

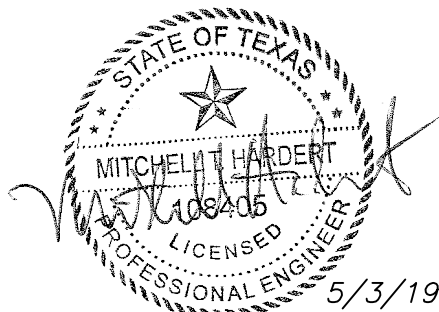

CBC ENGINEERS & ASSOCIATES, LTD.
TBPE FIRM NUMBER F-16105

Approved By	MTH	Date	4/30/19	Rev.	Date	By	Description
Project No.	CBC-22340	Rev.	-				
<div><div><div></div><div>MARK</div></div><div><div>DATE</div><div>REVISION DESCRIPTION</div></div><div><div>BY</div></div></div>							

CONTECH

ENGINEERED SOLUTIONS LLC

www.ContechES.com

11815 NE Glenn Widing Drive, Portland, OR 97220

800-548-4667 503-240-3393 800-561-1271 FAX

CONTECH

CMP DETENTION SYSTEMS


CONTECH

PROPOSAL

DRAWING

96"Ø UNDERGROUND DETENTION SYSTEM - 609760-020
TOWNEPLACE SUITES MARRIOTT - ROCKWALL TX
ROCKWALL, TX
SITE DESIGNATION: NORTHWEST

PROJECT No.:	609760	SEQ. No.:	020	DATE:	2/13/2019
DESIGNED:	SJ	DRAWN:	SJ	APPROVED:	SJ
CHECKED:	SJ	APPROVED:	SJ		
SHEET NO.:	C3	OF	5		

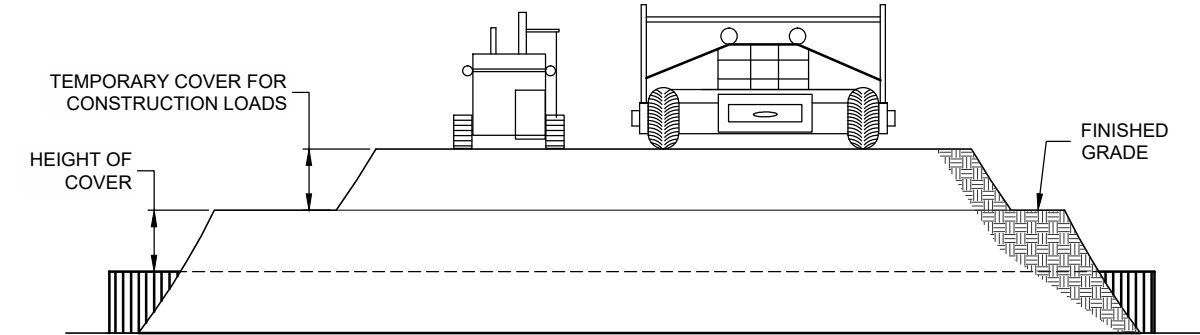

CONSTRUCTION LOADS

FOR TEMPORARY CONSTRUCTION VEHICLE LOADS, AN EXTRA AMOUNT OF COMPACTED COVER MAY BE REQUIRED OVER THE TOP OF THE PIPE. THE HEIGHT-OF-COVER SHALL MEET THE MINIMUM REQUIREMENTS SHOWN IN THE TABLE BELOW. THE USE OF HEAVY CONSTRUCTION EQUIPMENT NECESSITATES GREATER PROTECTION FOR THE PIPE THAN FINISHED GRADE COVER MINIMUMS FOR NORMAL HIGHWAY TRAFFIC.

PIPE SPAN, INCHES	AXLE LOADS (kips)			
	18-50	50-75	75-110	110-150
	MINIMUM COVER (FT)			
12-42	2.0	2.5	3.0	3.0
48-72	3.0	3.0	3.5	4.0
78-120	3.0	3.5	4.0	4.0
126-144	3.5	4.0	4.5	4.5

*MINIMUM COVER MAY VARY, DEPENDING ON LOCAL CONDITIONS. THE CONTRACTOR MUST PROVIDE THE ADDITIONAL COVER REQUIRED TO AVOID DAMAGE TO THE PIPE. MINIMUM COVER IS MEASURED FROM THE TOP OF THE PIPE TO THE TOP OF THE MAINTAINED CONSTRUCTION ROADWAY SURFACE.

CONSTRUCTION LOADING DIAGRAM

NOT TO SCALE

SPECIFICATION FOR CORRUGATED STEEL PIPE-ALUMINIZED TYPE 2 STEEL

SCOPE

THIS SPECIFICATION COVERS THE MANUFACTURE AND INSTALLATION OF THE CORRUGATED STEEL PIPE (CSP) DETAILED IN THE PROJECT PLANS.

MATERIAL

THE ALUMINIZED TYPE 2 STEEL COILS SHALL CONFORM TO THE APPLICABLE REQUIREMENTS OF AASHTO M274 OR ASTM A929.

PIPE

THE CSP SHALL BE MANUFACTURED IN ACCORDANCE WITH THE APPLICABLE REQUIREMENTS OF AASHTO M36 OR ASTM A760. THE PIPE SIZES, GAGES AND CORRUGATIONS SHALL BE AS SHOWN ON THE PROJECT PLANS.

ALL FABRICATION OF THE PRODUCT SHALL OCCUR WITHIN THE UNITED STATES.


HANDLING AND ASSEMBLY

SHALL BE IN ACCORDANCE WITH RECOMMENDATIONS OF THE NATIONAL CORRUGATED STEEL PIPE ASSOCIATION (NCSPA)

INSTALLATION


SHALL BE IN ACCORDANCE WITH AASHTO STANDARD SPECIFICATIONS FOR HIGHWAY BRIDGES, SECTION 26, DIVISION II OR ASTM A798 AND IN CONFORMANCE WITH THE PROJECT PLANS AND SPECIFICATIONS. IF THERE ARE ANY INCONSISTENCIES OR CONFLICTS THE CONTRACTOR SHOULD DISCUSS AND RESOLVE WITH THE SITE ENGINEER.

IT IS ALWAYS THE RESPONSIBILITY OF THE CONTRACTOR TO FOLLOW OSHA GUIDELINES FOR SAFE PRACTICES.

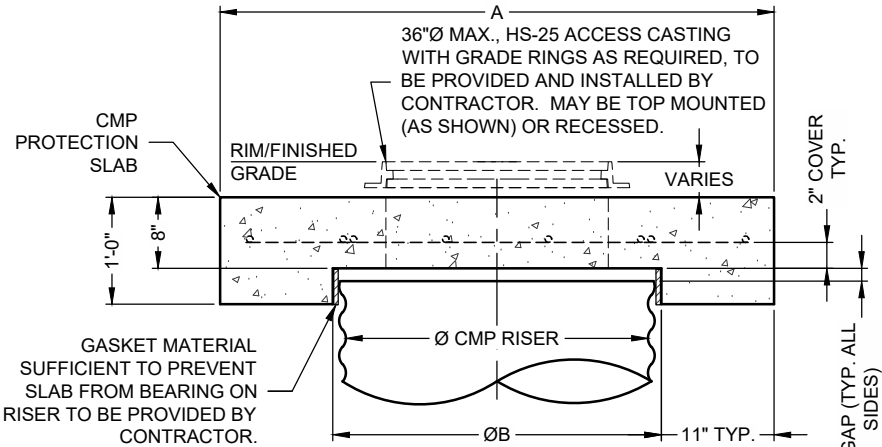


SECTION VIEW

ACCESS CASTING NOT SUPPLIED BY CONTECH

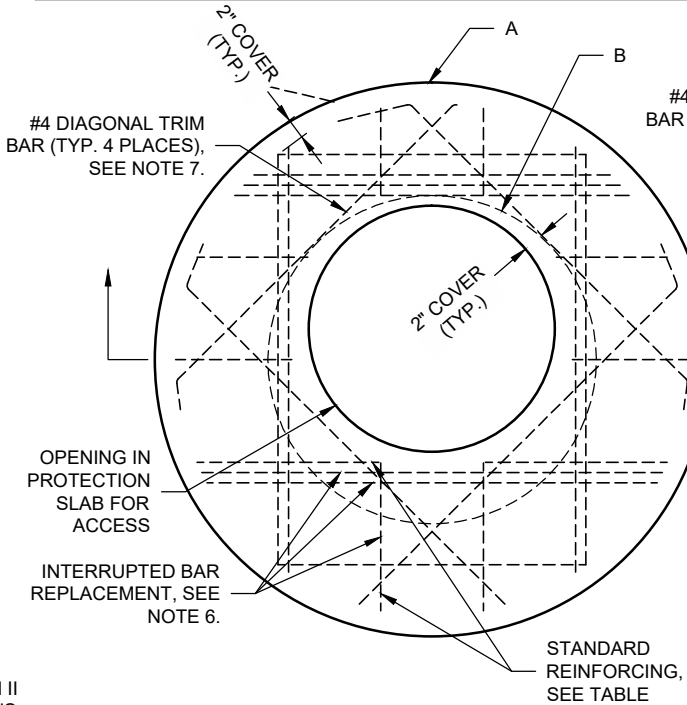

ROUND OPTION PLAN VIEW

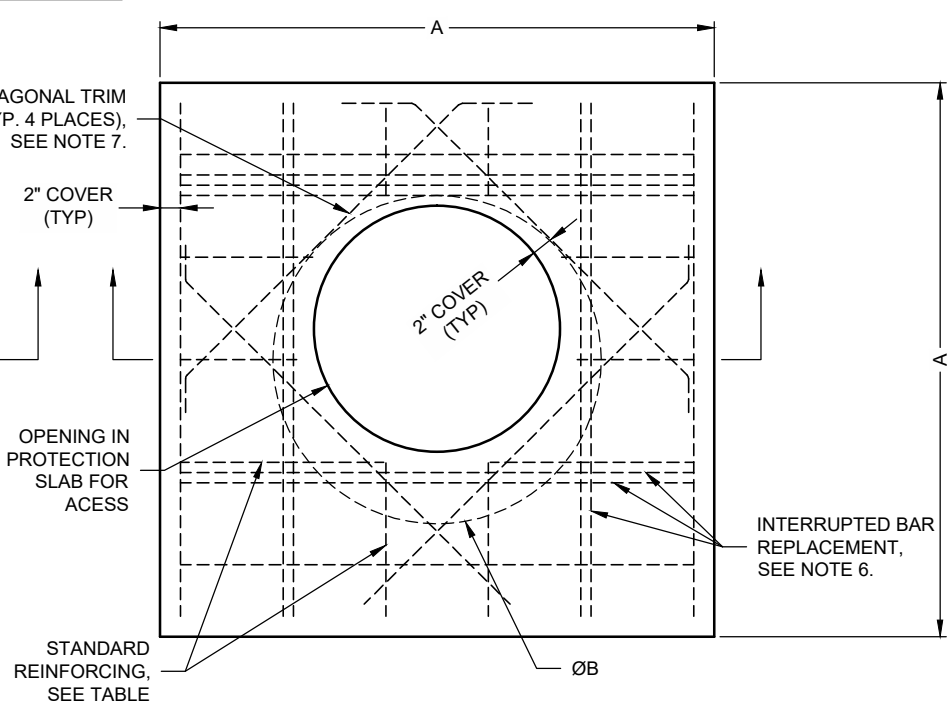

SQUARE OPTION PLAN VIEW


NOTES:

- DESIGN IN ACCORDANCE WITH AASHTO, 17th EDITION AND ACI 350.
- DESIGN LOAD HS25.
- EARTH COVER = 1' MAX.
- CONCRETE STRENGTH = 4,000 psi
- REINFORCING STEEL = ASTM A615, GRADE 60.
- PROVIDE ADDITIONAL REINFORCING AROUND OPENINGS EQUAL TO THE BARS INTERRUPTED, HALF EACH SIDE. ADDITIONAL BARS TO BE IN THE SAME PLANE.

- TRIM OPENING WITH DIAGONAL #4 BARS, EXTEND BARS A MINIMUM OF 12" BEYOND OPENING, BEND BARS AS REQUIRED TO MAINTAIN BAR COVER.
- PROTECTION SLAB AND ALL MATERIALS TO BE PROVIDED AND INSTALLED BY CONTRACTOR.
- DETAIL DESIGN BY DELTA ENGINEERS, ARCHITECTS AND LAND SURVEYORS, ENDWELL, NY.

MANHOLE CAP DETAIL

NOT TO SCALE

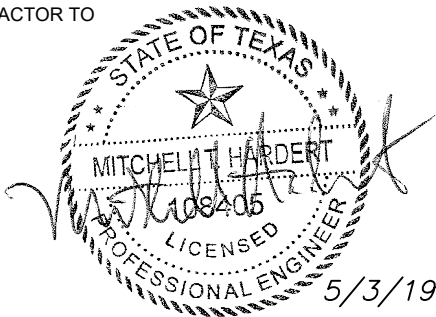

CBC ENGINEERS & ASSOCIATES, LTD.
TBPE FIRM NUMBER F-16105

CONTECH
ENGINEERED SOLUTIONS LLC
www.ContechES.com

11815 NE Glenn Widing Drive, Portland, OR 97220
800-548-4667 503-240-3393 800-561-1271 FAX

CONTECH
CMP DETENTION SYSTEMS

CONTECH
PROPOSAL
DRAWING

96"Ø UNDERGROUND DETENTION SYSTEM - 609760-020
TOWNEPLACE SUITES MARRIOTT - ROCKWALL TX
ROCKWALL, TX
SITE DESIGNATION: NORTHWEST

REINFORCING TABLE				
Ø CMP RISER	A	B Ø	REINFORCING	**BEARING PRESSURE (PSF)
24"	4'Ø 4'x4'	26"	#5 @ 10" OCEW #5 @ 10" OCEW	2,540 1,900
30"	4'-6"Ø 4'-6" x 4'-6"	32"	#5 @ 10" OCEW #5 @ 9" OCEW	2,260 1,670
36"	5'Ø 5' x 5'	38"	#5 @ 9" OCEW #5 @ 8" OCEW	2,060 1,500
42"	5'-6"Ø 5'-6" x 5'-6"	44"	#5 @ 8" OCEW #5 @ 8" OCEW	1,490 1,370
48"	6'Ø 6' x 6'	50"	#5 @ 7" OCEW #5 @ 7" OCEW	1,210 1,270

** ASSUMED SOIL BEARING CAPACITY



Approved By	Date		Rev.	Date	By	Description
MTH	4/30/19					
Project No.	Rev.					
CBC-22340	-					

The design and information shown on this drawing is provided as a service to the project owner, engineer and contractor by Contech Engineered Solutions LLC ("Contech"). Neither this drawing, nor any part thereof, may be used, reproduced or modified in any manner without the prior written consent of Contech. Failure to comply is done at the user's own risk and Contech expressly disclaims any liability or responsibility for such use.

If discrepancies between the supplied information upon which the drawing is based and actual field conditions are encountered as site work progresses, these discrepancies must be reported to Contech immediately for re-evaluation of the design. Contech accepts no liability for designs based on missing, incomplete or inaccurate information supplied by others.

MARK	DATE	REVISION DESCRIPTION	BY

PROJECT No.: 609760	SEQ. No.: 020	DATE: 2/13/2019
DESIGNED: SJ	DRAWN: SJ	
CHECKED: SJ	APPROVED: SJ	
SHEET NO.: C4	OF 5	

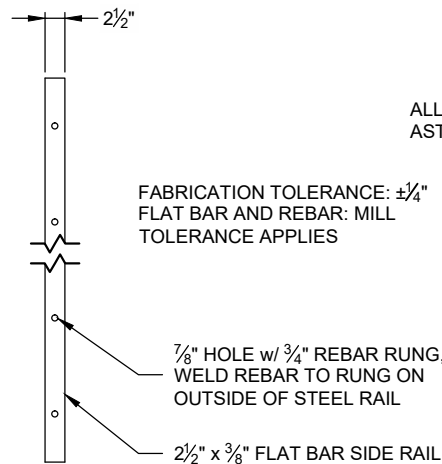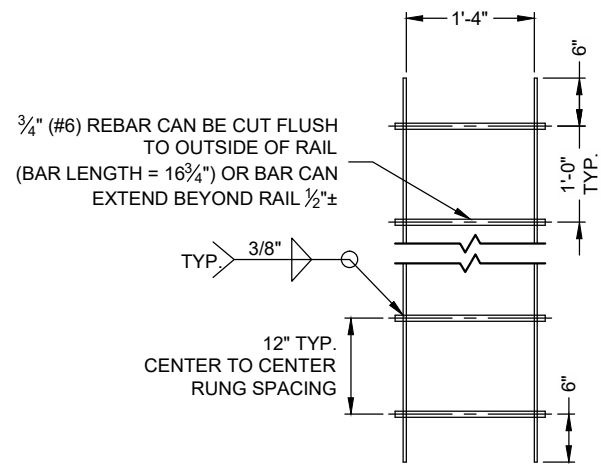

- NOTES:
1. LADDERS CAN BE MADE IN 20'-0" STANDARD LENGTHS AND CUT TO FIT
 2. ALL MATERIAL TO MEET ASTM A36
 3. LADDER TO BE HOT DIPPED GALVANIZED PER ASTM A-123 AFTER FABRICATION IS COMPLETE

STANDARD LADDER DETAIL

NOT TO SCALE
PART NO. HALAGVL16

PROVIDE MINIMUM OF 4 ATTACHMENT ANGLES (2 ON EITHER SIDE OF LADDER RAIL) TO CONNECT LADDER TO RISER EXTENSION

RISER w/ LADDER AND STEPS IF EXTENSION IS REQUIRED

RISER w/ LADDER AND STEPS

MAINLINE CMP
2 2/3 x 1 1/2, 5 x 1, 3 x 1, ETC.

1'-6" MAX.

5" x 3" x 1/4" x 16" LONG AT 1'-0" SPACING. LONG LEG TO PROJECT OUT. WELD TOP AND BOTTOM OF 3" LEG TO EACH CORRUGATION CREST (THESE ANGLES SHOULD BE USED FOR LARGER DIAMETER MAINLINES WHERE ADDITIONAL STEPS ARE NEEDED)

LADDER RAILS AND RUNGS

RISER NORMALLY CMP WITH 2 2/3" x 1/2" CORRUGATIONS

(4) 1/16" FILLET WELDS FROM EACH ANGLE TO CORRUGATION CREST (2 WELDS EACH SIDE)

3" x 3" x 3/16" 5 1/2" LONG

(2) 1/4" FILLET WELDS 1" LONG

ATTACHMENT ANGLE MINIMUM OF 4 ANGLES PER LADDER SECTION, (2 EACH SIDE OF LADDER) 6' MAX. SPACING VERTICALLY

SECTION A-A

RISER LADDER DETAIL

NOT TO SCALE

*NOTE: WHEN RISER EXTENSIONS ARE USED, THE PLANT SHOULD CUT 3" FROM THE SIDE RAILS AS SHOWN

*3" FROM BOTTOM OF LADDER RAIL TO RISER JOINT

6" FROM RUNG TO RISER JOINT

*3" FROM TOP OF LADDER RAIL TO RISER JOINT


6" FROM RUNG TO RISER JOINT

(4) 1/16" FILLET WELDS FROM EACH ANGLE CORRUGATION CREST (2 WELDS EACH SIDE)

(4) 3" x 3" x 3/16" 5 1/2" LONG

(2) 1/4" FILLET WELDS 1" LONG FROM EACH ANGLE TO LADDER RAIL

PLAN

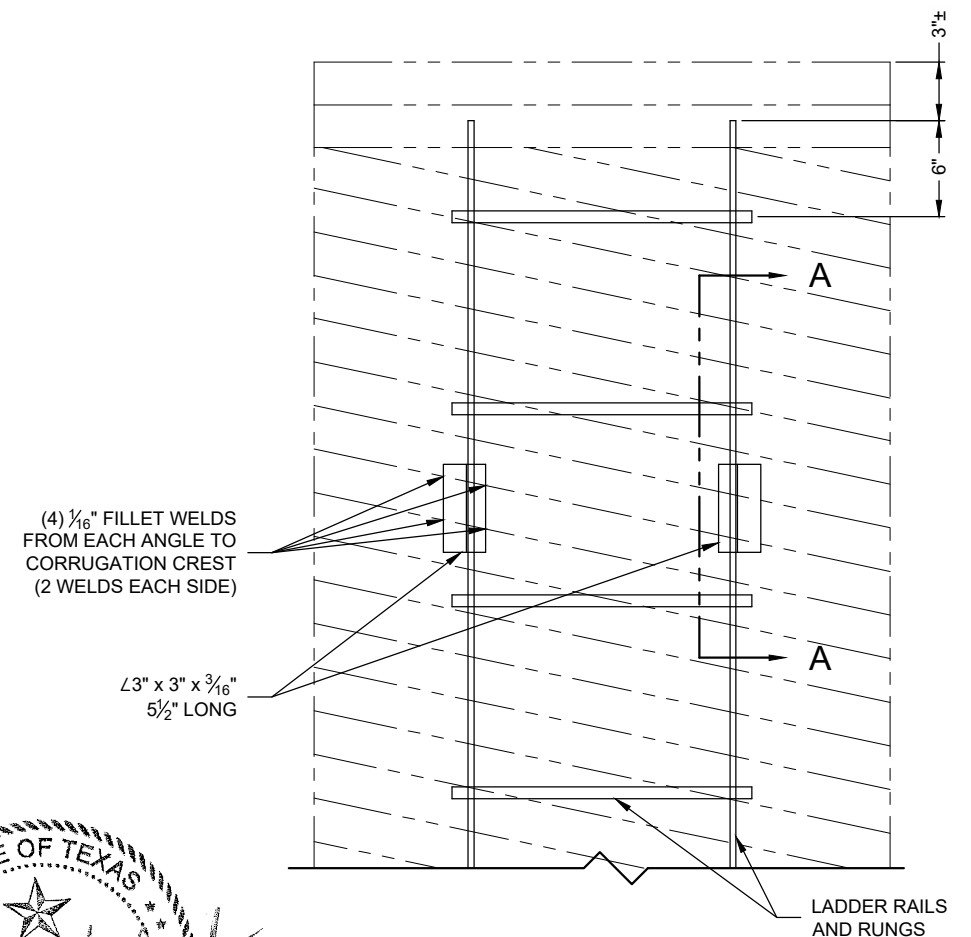

ELEVATION

NOTE:
THIS DRAWING IS INTENDED TO APPLY TO LADDERS INSTALLED IN RISERS HAVING A DIAMETER OF 30" OR LARGER. DUE TO SPACE CONSTRAINTS AND LIMITED ACCESSIBILITY, THE PRACTICALITY AND SUITABILITY OF UTILIZING RISERS SMALLER THAN 30" DIAMETER AND/OR INCORPORATING LADDERS IN THESE SMALLER DIAMETER RISERS SHOULD BE ADDRESSED BY THE OWNER AND PROJECT ENGINEER

Approved By	MTH	Date	4/30/19	Rev.	Date	By	Description
Project No.	CBC-22340	Rev.	-				



The design and information shown on this drawing is provided as a service to the project owner, engineer and contractor by Contech Engineered Solutions LLC ("Contech"). Neither this drawing, nor any part thereof, may be used, reproduced or modified in any manner without the prior written consent of Contech. Failure to comply is done at the user's own risk and Contech expressly disclaims any liability or responsibility for such use.

If discrepancies between the supplied information upon which the drawing is based and actual field conditions are encountered as site work progresses, these discrepancies must be reported to Contech immediately for re-evaluation of the design. Contech accepts no liability for designs based on missing, incomplete or inaccurate information supplied by others.

MARK	DATE	REVISION DESCRIPTION	BY


CONTECH
ENGINEERED SOLUTIONS LLC

www.ContechES.com
11815 NE Glenn Widing Drive, Portland, OR 97220
800-548-4667 503-240-3393 800-561-1271 FAX

CONTECH
CMP DETENTION SYSTEMS

CONTECH
PROPOSAL
DRAWING

96"Ø UNDERGROUND DETENTION SYSTEM - 609760-020
TOWNEPLACE SUITES MARRIOTT - ROCKWALL TX
ROCKWALL, TX
SITE DESIGNATION: NORTHWEST

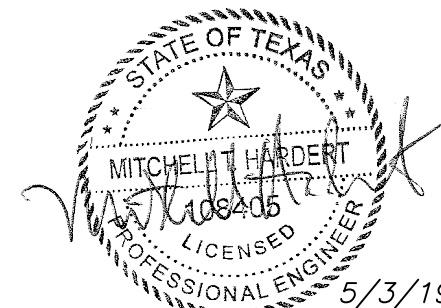

CBC ENGINEERS & ASSOCIATES, LTD.
TBPE FIRM NUMBER F-16105

PROJECT No.: 609760	SEQ. No.: 020	DATE: 2/13/2019
DESIGNED: SJ	DRAWN: SJ	
CHECKED: SJ	APPROVED: SJ	
SHEET NO.: C5	OF 5	

Present Conditions		PRE. DEVELOPED DRAINAGE AREAS	Bypass Flow		DRAINAGE AREAS
Q = CIA	Q = CIA		Q = CIA	Q = CIA	
A = 1.31		1	A = 0.18		1.8
C = 0.35			C = 0.90		
Tc = 20			Tc = 10		
I100 = 8.30			I100 = 9.80		
Q100 = 3.81	cfs		Q100 = 1.59	cfs	
Q100 = 3.81	cfs		Q100 TOTAL =	1.59 cfs	
		Q100 Allowable =	2.22 cfs		

Future Conditions		DRAINAGE AREAS
Q = CIA		
A =	0.81	2, 7
C =	0.90	
Tc =	10	
I100 =	9.80	
Q100 =	7.14	cfs

Flow for Storm Durations			
Time	I	C	Q
10	9.80	0.90	7.14
15	9.00	0.90	6.56
20	8.30	0.90	6.05
30	6.90	0.90	5.03
40	5.80	0.90	4.23
50	5.00	0.90	3.65
60	4.50	0.90	3.28
70	4.00	0.90	2.92
80	3.70	0.90	2.70
90	3.50	0.90	2.55
100	3.40	0.90	2.48
110	3.20	0.90	2.33

Storage Calculations			
10 min			
Inflow	4287	Storage =	2956
Outflow	1331		
15 min			
Inflow	5905	Storage =	4241
Outflow	1663		
20 min			
Inflow	7261	Storage =	5265
Outflow	1996		
30 min			
Inflow	9054	Storage =	6393
Outflow	2662		
40 min			
Inflow	10148	Storage =	6821
Outflow	3327		
50 min			
Inflow	10935	Storage =	6943
Outflow	3992		
60 min			
Inflow	11810	Storage =	7152
Outflow	4658		
70 min			
Inflow	12247	Storage =	6924
Outflow	5323		
80 min			
Inflow	12947	Storage =	6959
Outflow	5988		
90 min			
Inflow	13778	Storage =	7124
Outflow	6654		
100 min			
Inflow	14872	Storage =	7552
Outflow	7319		
110 min			
Inflow	15396	Storage =	7412
Outflow	7985		

Storage Required =	7552 CF
--------------------	---------

25 YR STORM

Present Conditions		PRE. DEVELOPED DRAINAGE AREAS	Bypass Flow		DRAINAGE AREAS
Q = CIA			Q = CIA		
A =	1.31	1	A =	0.18	1.8
C =	0.35		C =	0.90	
Tc =	20		Tc =	10	
I25 =	6.80		I25 =	8.30	
Q25 =	3.12		Q25 =	1.34	
Q25 =	3.12	dfs	Q25 TOTAL =	1.34	dfs
		dfs			
			Q25 Allowable =	1.77 cfs	

Future Conditions		DRAINAGE AREAS
Q = CIA		
A =	0.81	2, 7
C =	0.90	
Tc =	10	
I25 =	8.30	
Q25 =	6.05	cfs

Flow for Storm Durations			
Time	I	C	Q
10	8.30	0.90	6.05
15	7.40	0.90	5.39
20	6.80	0.90	4.96
30	5.50	0.90	4.01
40	4.70	0.90	3.43
50	4.00	0.90	2.92
60	3.50	0.90	2.55
70	3.30	0.90	2.41
80	3.10	0.90	2.26
90	2.80	0.90	2.04
100	2.60	0.90	1.90
110	2.40	0.90	1.75

Storage Calculations			
10 min			
Inflow	3630	Storage =	2567
Outflow	1064		
15 min			
Inflow	4855	Storage =	3525
Outflow	1330		
20 min			
Inflow	5949	Storage =	4353
Outflow	1596		
30 min			
Inflow	7217	Storage =	5085
Outflow	2128		
40 min			
Inflow	8223	Storage =	5563
Outflow	2660		
50 min			
Inflow	8748	Storage =	5556
Outflow	3192		
60 min			
Inflow	9185	Storage =	5462
Outflow	3724		
70 min			
Inflow	10104	Storage =	5848
Outflow	4256		
80 min			
Inflow	10848	Storage =	6060
Outflow	4788		
90 min			
Inflow	11022	Storage =	5703
Outflow	5320		
100 min			
Inflow	11372	Storage =	5521
Outflow	5852		
110 min			
Inflow	11547	Storage =	5164
Outflow	6384		

Storage Required =	6060	CF
--------------------	------	----

<u>10_YR_STORM</u>							
Present Conditions		PRE. DEVELOPED DRAINAGE AREAS		Bypass Flow		DRAINAGE AREAS	
Q = CIA		1		Q = CIA		1,8	
A =	1.31	cfs		A =	0.18	cfs	
C =	0.35			C =	0.90		
Tc =	20			Tc =	10		
I10 =	5.90			I10 =	7.10		
Q10 =	2.71			Q10 =	1.15		
Q10 =	2.71			Q10 TOTAL =	1.15		
		Q10 Allowable =		1.55 cfs			

Future Conditions		DRAINAGE AREAS
Q = CIA		
A =	0.81	
C =	0.90	
Tc =	10	
I10 =	7.10	
Q10 =	5.18	cfs

Flow for Storm Durations			
Time	I	C	Q
10	7.10	0.90	5.18
15	6.50	0.90	4.74
20	5.90	0.90	4.30
30	4.90	0.90	3.57
40	4.00	0.90	2.92
50	3.40	0.90	2.48
60	3.00	0.90	2.19
70	2.80	0.90	2.04
80	2.60	0.90	1.90
90	2.40	0.90	1.75
100	2.20	0.90	1.60
110	2.00	0.90	1.46

Storage Calculations			
10 min			
Inflow	3106	Storage =	217
Outflow	933		
15 min			
Inflow	4265	Storage =	308
Outflow	1166		
20 min			
Inflow	5161	Storage =	376
Outflow	1399		
30 min			
Inflow	6430	Storage =	456
Outflow	1866		
40 min			
Inflow	6998	Storage =	466
Outflow	2332		
50 min			
Inflow	7436	Storage =	463
Outflow	2799		
60 min			
Inflow	7873	Storage =	460
Outflow	3265		
70 min			
Inflow	8573	Storage =	484
Outflow	3732		
80 min			
Inflow	9098	Storage =	490
Outflow	4198		
90 min			
Inflow	9448	Storage =	478
Outflow	4665		
100 min			
Inflow	9623	Storage =	449
Outflow	5131		
110 min			
Inflow	9623	Storage =	402
Outflow	5598		

Storage Required =	4900	CF
--------------------	------	----

<u><i>5 YR STORM</i></u>				
Present Conditions Q = CIA		PRE. DEVELOPED DRAINAGE AREAS	Bypass Flow Q = CIA	
A =	1.31	1	A =	0.18
C =	0.35		C =	0.90
Tc =	.20		Tc =	.10
I5 =	4.90		I5 =	6.10
Q5 =	2.25	cfs	Q5 =	0.99
Q5 =	2.25	cfs	Q5 TOTAL =	0.99
O5 Allowable =			1.26 cfs	

Future Conditions		DRAINAGE AREAS 2, 7 cfs
Q = CIA		
A =	0.81	
C =	0.90	
Tc =	10	
I5 =	6.10	
Q5 =	4.45	

Flow for Storm Durations			
Time	I	C	Q
10	6.10	0.90	4.45
15	5.60	0.90	4.08
20	4.90	0.90	3.57
30	4.00	0.90	2.92
40	3.40	0.90	2.48
50	2.90	0.90	2.11
60	2.60	0.90	1.90
70	2.40	0.90	1.75
80	2.20	0.90	1.60
90	2.10	0.90	1.53
100	1.90	0.90	1.39
110	1.70	0.90	1.24

Storage Calculations			
10 min			
Inflow	2668	Storage =	1913
Outflow	755		
15 min			
Inflow	3674	Storage =	2730
Outflow	944		
20 min			
Inflow	4287	Storage =	3154
Outflow	1133		
30 min			
Inflow	5249	Storage =	3739
Outflow	1510		
40 min			
Inflow	5949	Storage =	4061
Outflow	1888		
50 min			
Inflow	6342	Storage =	4077
Outflow	2265		
60 min			
Inflow	6823	Storage =	4181
Outflow	2643		
70 min			
Inflow	7348	Storage =	4328
Outflow	3020		
80 min			
Inflow	7698	Storage =	4300
Outflow	3398		
90 min			
Inflow	8267	Storage =	4492
Outflow	3775		
100 min			
Inflow	8311	Storage =	4158
Outflow	4153		
110 min			
Inflow	8179	Storage =	3649
Outflow	4530		

Storage Required =	4492 CF
--------------------	---------

CHAMBER DETENTION VOLUME CALCULATIONS	
NUMBER OF CHAMBERS =	3
LENGTH OF CHAMBERS (FT) =	41
NUMBER OF HEADERS =	1
LENGTH OF HEADERS =	29
TOTAL LENGTH OF CHAMBERS (FT)	152
CHAMBER DIAMETER (FT) =	8
AREA OF CHAMBERS (SF)=	50.27
VOLUME OF CHAMBERS (CF) =	7640

This drawing is proprietary and may not be copied or used in any way without the written permission of FC Cuny Corporation - ©Copyright - FC Cuny Corporation

SP 2018-029
RECORD DRAWING

[illegible]

100 YR STORM									
100 YEAR 96" PIPE STORAGE CALCULATION									
PIPE DIAMETER (in.)	96.00								
AREA OF PIPE (SF)	50.27								
LENGTH OF PIPE (FT)	152.00								
PIPE AREA ITERATIONS (GIVEN d> RADIUS)									
INPUT d (in)	92.52	<= USER INPUT							
h = 2R-d	3.48								
Ø = 2arccos((r-h)/r)	0.77								
K = (r^2(Ø-sin(Ø)))/2	0.58								
A = πr^2 - K	49.68								
PROVIDED VOLUME (96 in. PIPE)	7552								
CIRCLE									
ORIFICE CALCULATION									
Equation: Q = Cd*A*((2*g*H)^0.5)									
Q =	0.20	ft³/sec						FL= 6	
Cd =	0.62								
g =	32.20	ft/sec²							
H =	1.61	ft							
A = P*R²	0.03	ft²							
D =	2.40	in							
R =	1.20	in							
CIRCLE									
ORIFICE CALCULATION									
Equation: Q = Cd*A*((2*g*H)^0.5)									
Q =	0.35	ft³/sec						FL= 2.5	
Cd =	0.62								
g =	32.20	ft/sec²							
H =	5.11	ft							
A = P*R²	0.03	ft²							
D =	2.40	in							
R =	1.20	in							
RECTANGULAR									
ORIFICE CALCULATION									
Equation: Q = Cd*A*((2*g*H)^0.5)									
Q =	1.64	ft³/sec						FL= 0	
Cd =	0.62								
g =	32.20	ft/sec²							
H =	7.59	ft							
A = BH	0.12	ft²							
B =	5.75	in							
H =	3.00	in							

$100YR\ Qallowable = 2.22\ cfs$

$Q\ total = 1.64+0.35+0.20 = 2.19\ cfs$

25 YR STORM									
25 YEAR 96" PIPE STORAGE CALCULATION									
PIPE DIAMETER (in.)	96.00								
AREA OF PIPE (SF)	50.27								
LENGTH OF PIPE (FT)	152.00								
PIPE AREA ITERATIONS (GIVEN d> RADIUS)									
INPUT d (in)	71.02	<= USER INPUT							
h = 2R-d	24.98								
Ø = 2arccos((r-h)/r)	2.14								
K = (r^2(Ø-sin(Ø)))/2	10.40								
A = πr^2 - K	39.87								
PROVIDED VOLUME (96 in. PIPE)	6060								
CIRCLE									
ORIFICE CALCULATION									
Equation: Q = Cd*A*((2*g*H)^0.5)									
Q =	0.28	ft³/sec						FL= 2.5	
Cd =	0.62								
g =	32.20	ft/sec²							
H =	3.32	ft							
A = P*R²	0.03	ft²							
D =	2.40	in							
R =	1.20	in							
RECTANGULAR									
ORIFICE CALCULATION									
Equation: Q = Cd*A*((2*g*H)^0.5)									
Q =	1.43	ft³/sec						FL= 0	
Cd =	0.62								
g =	32.20	ft/sec²							
H =	5.79	ft							
A = BH	0.12	ft²							
B =	5.75	in							
H =	3.00	in							

$25YR\ Qallowable = 1.77\ cfs$

$Qtotal = 1.43+0.28 = 1.71\ cfs$

10 YR STORM									
10 YEAR 96" PIPE STORAGE CALCULATION									
PIPE DIAMETER (in.)	96.00								
AREA OF PIPE (SF)	50.27								
LENGTH OF PIPE (FT)	152.00								
PIPE AREA ITERATIONS (GIVEN d> RADIUS)									
INPUT d (in)	58.75	<= USER INPUT							
h = 2R-d	37.25								
Ø = 2arccos((r-h)/r)	2.69								
K = (r^2(Ø-sin(Ø)))/2	18.03								
A = πr^2 - K	32.24								
PROVIDED VOLUME (96 in. PIPE)	4900								
CIRCLE									
ORIFICE CALCULATION									
Equation: Q = Cd*A*((2*g*H)^0.5)									
Q =	0.24	ft³/sec						FL= 2.5	
Cd =	0.62								
g =	32.20	ft/sec²							
H =	2.30	ft							
A = P*R²	0.03	ft²							
D =	2.40	in							
R =	1.20	in							
RECTANGULAR									
ORIFICE CALCULATION									
Equation: Q = Cd*A*((2*g*H)^0.5)									
Q =	1.30	ft³/sec						FL= 0	
Cd =	0.62								
g =	32.20	ft/sec²							
H =	4.77	ft							
A = BH	0.12	ft²							
B =	5.75	in							
H =	3.00	in							




$10YR\ Qallowable = 1.55\ cfs$

$Qtotal = 1.30+0.24 = 1.54\ cfs$

5 YR STORM									
5 YEAR 96" PIPE STORAGE CALCULATION									
PIPE DIAMETER (in.)	96.00								
AREA OF PIPE (SF)	50.27								
LENGTH OF PIPE (FT)	152.00								
PIPE AREA ITERATIONS (GIVEN d> RADIUS)									
INPUT d (in)	54.65	<= USER INPUT							
h = 2R-d	41.35								
Ø = 2arccos((r-h)/r)	2.86								
K = (r^2(Ø-sin(Ø)))/2	20.71								
A = πr^2 - K	29.55								
PROVIDED VOLUME (96 in. PIPE)	4492								
RECTANGULAR									
ORIFICE CALCULATION									
Equation: Q = Cd*A*((2*g*H)^0.5)									
Q =	1.25	ft³/sec						FL= 0	
Cd =	0.62								
g =	32.20	ft/sec²							
H =	4.43	ft							
A = BH	0.12	ft²							
B =	5.75	in							
H =	3.00	in							
5YR Qallowable = 1.26 cfs									
Qtotal = 1.25 cfs									

$5YR\ WSEL$

$533.03+54.65/12 = 537.58$

Revision	Date	Description
Owner:		Greencrest TPS Hotel, L.P.
		3021 Ridge Road, A-120 Rockwall, TX 75082 Phone: (214) 890-9225
~ Civil Engineer ~ F.C. CUNY CORPORATION #2 Horizon Court • Heath, Texas 75032 • (469) 402-7700 Texas Registered Engineering Firm F-7449		
		
TOWNEPLACE — SUITES — MARRIOTT		
908 E. INTERSTATE 30 ROCKWALL, TX 75087		
12/23/2021  		
Drawn By: F.C. CUNY	Checked By: F.C. CUNY	
Date: 11/19/2018	Project No.: -	
Sheet Title: Pond #1 Calculations		
Scale:	Sheet No.:	
N.T.S.	12b of 14	

100_YR_STORM

Present Conditions		PRE. DEVELOPED DRAINAGE AREAS	Bypass Flow (AREA 6)		DRAINAGE AREAS
Q = CIA			Q = CIA		
A =	1.49	2	A =	0.12	6
C =	0.35		C =	0.90	
Tc =	20		Tc =	10	
I100 =	8.30		I100 =	9.80	
Q100 =	4.33	cfs	Q100 =		cfs
Q100 =	4.33	cfs	Q100 TOTAL =	1.06	cfs
		Q100 Allowable =	6.41 cfs		

Future Conditions		DRAINAGE AREAS	Offsite Pass-Through		DRAINAGE AREAS
Q = CIA			Q = CIA		
A =	1.71	3,4,5,9	A =	0.98	OS-1, OS-3.3
C =	0.90		C =	0.35	0.90
Tc =	10		Tc =	20	10
I100 =	9.80		I100 =	8.30	9.80
Q100 =	15.08	cfs	Q100 =	2.85	0.29

Flow for Storm Durations				
Time	I	Cw	Q	
10	9.80	0.70	18.73	
15	9.00	0.70	17.21	
20	8.30	0.70	15.87	
30	6.90	0.70	13.19	
40	5.80	0.70	11.09	
50	5.00	0.70	9.56	
60	4.50	0.70	8.60	
70	4.00	0.70	7.65	
80	3.70	0.70	7.07	
90	3.50	0.70	6.69	
100	3.40	0.70	6.50	
110	3.20	0.70	6.12	

Storage Calculations				
10 min				
Inflow	11241	Storage =	7396	
Outflow	3845			
15 min				
Inflow	15485	Storage =	10679	
Outflow	4806			
20 min				
Inflow	19041	Storage =	13273	
Outflow	5767			
30 min				
Inflow	23743	Storage =	16054	
Outflow	7690			
40 min				
Inflow	26611	Storage =	16999	
Outflow	9612			
50 min				
Inflow	28676	Storage =	17141	
Outflow	11534			
60 min				
Inflow	30970	Storage =	17513	
Outflow	13457			
70 min				
Inflow	32117	Storage =	16737	
Outflow	15379			
80 min				
Inflow	33952	Storage =	16650	
Outflow	17302			
90 min				
Inflow	36131	Storage =	16907	
Outflow	19224			
100 min				
Inflow	38999	Storage =	17852	
Outflow	21146			
110 min				
Inflow	40375	Storage =	17306	
Outflow	23069			

25_YR_STORM

Present Conditions		PRE. DEVELOPED DRAINAGE AREAS	Bypass Flow (AREA 6)		DRAINAGE AREAS
Q = CIA			Q = CIA		
A =	1.49	2	A =	0.12	6
C =	0.35		C =	0.90	
Tc =	20		Tc =	10	
I25 =	6.80		I25 =	8.30	
Q25 =	3.55	cfs	Q25 =	0.90	cfs
Q25 =	3.55	cfs	Q25 TOTAL =	0.90	cfs
		Q25 Allowable =	5.23 cfs		

Future Conditions		DRAINAGE AREAS	Offsite Pass-Through		DRAINAGE AREAS
Q = CIA			Q = CIA		
A =	1.71	3,4,5,9	A =	0.98	OS-1, OS-3.3
C =	0.90		C =	0.35	0.90
Tc =	10		Tc =	20	10
I25 =	8.30		I25 =	6.80	8.30
Q25 =	12.77	cfs	Q25 =	2.33	0.25

Flow for Storm Durations				
Time	I	C	Q	
10	8.30	0.70	15.87	
15	7.40	0.70	14.15	
20	6.80	0.70	13.00	
30	5.50	0.70	10.51	
40	4.70	0.70	8.98	
50	4.00	0.70	7.65	
60	3.50	0.70	6.69	
70	3.30	0.70	6.31	
80	3.10	0.70	5.93	
90	2.80	0.70	5.35	
100	2.60	0.70	4.97	
110	2.40	0.70	4.59	

Storage Calculations				
10 min				
Inflow	9520	Storage =	6383	
Outflow	3137			
15 min				
Inflow	12732	Storage =	8810	
Outflow	3922			
20 min				
Inflow	15599	Storage =	10894	
Outflow	4706			
30 min				
Inflow	18926	Storage =	12651	
Outflow	6274			
40 min				
Inflow	21564	Storage =	13721	
Outflow	7843			
50 min				
Inflow	22940	Storage =	13529	
Outflow	9412			
60 min				
Inflow	24087	Storage =	13107	
Outflow	10980			
70 min				
Inflow	26496	Storage =	13947	
Outflow	12549			
80 min				
Inflow	28446	Storage =	14329	
Outflow	14118			
90 min				
Inflow	28905	Storage =	13219	
Outflow	15686			
100 min				
Inflow	29823	Storage =	12568	
Outflow	17255			
110 min				
Inflow	30281	Storage =	11458	
Outflow	18823			

CHAMBER DETENTION VOLUME CALCULATIONS			
NUMBER OF CHAMBERS =	3		
LENGTH OF CHAMBERS (FT) =	112		
NUMBER OF HEADERS =	1		
LENGTH OF HEADERS =	29		
TOTAL LENGTH OF CHAMBERS (FT)	365		
CHAMBER DIAMETER (FT) =	8		
AREA OF CHAMBERS (SF)=	50.27		
VOLUME OF CHAMBERS (CF) =	18347		

10_YR_STORM

Present Conditions		PRE. DEVELOPED DRAINAGE AREAS	Bypass Flow (AREA 6)		DRAINAGE AREAS
Q = CIA			Q = CIA		
A =	1.49	2	A =	0.12	6
C =	0.35		C =	0.90	
Tc =	20		Tc =	10	
I10 =	5.90		I10 =	7.10	
Q10 =	3.08	cfs	Q10 =	0.77	cfs
Q10 =	3.08	cfs	Q10 TOTAL =	0.77	cfs
		Q10 Allowable =	4.54 cfs		

nditions		DRAINAGE AREAS	Offsite Pass-Through		DRAINAGE AREAS
Q = CIA			Q = CIA		
1.71	3,4,5,9	A =	0.98	0.03	OS-1, OS-3.3
0.90		C =	0.35	0.90	
10		Tc =	20	10	
7.10		I25 =	5.90	7.10	
10.93	cfs	Q25 =	2.02	0.21	cfs

Flow for Storm Durations				
Time	I	C	Q	
10	7.10	0.70	13.57	
15	6.50	0.70	12.43	
20	5.90	0.70	11.28	
30	4.90	0.70	9.37	
40	4.00	0.70	7.65	
50	3.40	0.70	6.50	
60	3.00	0.70	5.74	
70	2.80	0.70	5.35	
80	2.60	0.70	4.97	
90	2.40	0.70	4.59	
100	2.20	0.70	4.21	
110	2.00	0.70	3.82	

Storage Calculations				
10 min				
Inflow	8144	Storage =	5417	
Outflow	2727			
15 min				
Inflow	11183	Storage =	7775	
Outflow	3408			
20 min				
Inflow	13535	Storage =	9445	
Outflow	4090			
30 min				
Inflow	16861	Storage =	11408	
Outflow	5454			
40 min				
Inflow	18352	Storage =	11535	
Outflow	6817			
50 min				
Inflow	19499	Storage =	11319	
Outflow	8180			
60 min				
Inflow	20646	Storage =	11103	
Outflow	9544			
70 min				
Inflow	22482	Storage =	11575	
Outflow	10907			
80 min				
Inflow	23858	Storage =	11588	
Outflow	12270			
90 min				
Inflow	24776	Storage =	11142	
Outflow	13634			
100 min				
Inflow	25234	Storage =	10237	
Outflow	14997			
110 min				
Inflow	25234	Storage =	8874	
Outflow	16361			

5_YR_STORM

Present Conditions		PRE. DEVELOPED DRAINAGE AREAS	Bypass Flow (AREA 6)		DRAINAGE AREAS
Q = CIA			Q = CIA		
A =	1.49	2	A =	0.12	6
C =	0.35		C =	0.90	
Tc =	20		Tc =	10	
I5 =	4.90		I5 =	6.10	
Q5 =	2.56	cfs	Q5 =	0.66	cfs
Q5 =	2.56	cfs	Q5 TOTAL =	0.66	cfs
		Q5 Allowable =	3.76 cfs		

nditions		DRAINAGE AREAS	Offsite Pass-Through		DRAINAGE AREAS
Q = CIA			Q = CIA		
1.71	3,4,5,9	A =	0.98	0.03	OS-1, OS-3.3
0.90		C =	0.35	0.90	
10		Tc =	20	10	
6.10		I25 =	4.90	6.10	
9.39	cfs	Q25 =	1.68	0.18	cfs

Flow for Storm Durations				
Time	I	C	Q	
10	6.10	0.70	11.66	
15	5.60	0.70	10.71	
20	4.90	0.70	9.37	
30	4.00	0.70	7.65	
40	3.40	0.70	6.50	
50	2.90	0.70	5.54	
60	2.60	0.70	4.97	
70	2.40	0.70	4.59	
80	2.20	0.70	4.21	
90	2.10	0.70	4.01	
100	1.90	0.70	3.63	
110	1.70	0.70	3.25	

Storage Calculations				
10 min				
Inflow	6997	Storage =	4742	
Outflow	2255			
15 min				
Inflow	9635	Storage =	6816	
Outflow	2819			
20 min				
Inflow	11241	Storage =	7858	
Outflow	3383			
30 min				
Inflow	13764	Storage =	9254	
Outflow	4510			
40 min				
Inflow	15599	Storage =	9962	
Outflow	5638			
50 min				
Inflow	16632	Storage =	9867	
Outflow	6765			
60 min				
Inflow	17894	Storage =	10001	
Outflow	7893			
70 min				
Inflow	19270	Storage =	10250	
Outflow	9020			
80 min				
Inflow	20188	Storage =	10040	
Outflow	10148			
90 min				
Inflow	21679	Storage =	10403	
Outflow	11275			
100 min				
Inflow	21793	Storage =	9391	
Outflow	12403			
110 min				
Inflow	21449	Storage =	7919	
Outflow	13530			

Storage Required =			


Storage Required =			

Storage Required =			

Owner:
Greentrest TPS Hotel, L.P.

3021 Ridge Road, A-120
Rockwall, TX 75032
Phone: (214) 890-9225


~ Civil Engineer ~
F.C. CUNY CORPORATION
#2 Horizon Court • Heath, Texas 75032 • (469) 402-7700
Texas Registered Engineering Firm F-7449



TOWNEPLACE
SUITES
MARRIOTT

908 E. INTERSTATE 30
ROCKWALL, TX 75087

12/23/2021

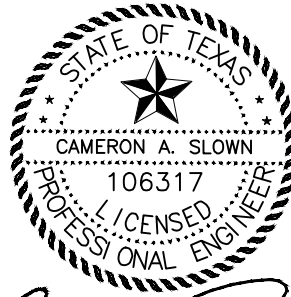
Cameron A. Slown
Professional Engineer

Drawn By: F.C. CUNY	Checked By: F.C. CUNY
Date: 11/19/2018	Project No.: -
Sheet Title: Pond #2 Calculations	
Scale:	Sheet No.:
N.T.S.	12c of 14

SP 2018-029
RECORD DRAWING

This drawing is proprietary and may not be copied or used in any way without the written permission of FC Cuny Corporation ~©Copyright ~ FC Cuny Corporation

100 YR STORM

100 YEAR 96" PIPE STORAGE CALCULATION	
PIPE DIAMETER (in.)	96.00
AREA OF PIPE (SF)	50.27
LENGTH OF PIPE (FT)	365.00
PIPE AREA ITERATIONS (GIVEN d> RADIUS)	
INPUT d (in)	89.85 <= USER INPUT
h = 2R-d	6.15
φ = 2arccos((r-h)/r)	1.02
K = (r^2(φ-sin(φ)))/2	1.36
A = πr^2 - K	48.91
PROVIDED VOLUME (96 in. PIPE)	17852

CIRCLE

ORIFICE CALCULATION	
Equation: Q = Cd*A*((2*g*H)^0.5)	
Q =	0.39 ft³/sec
Cd =	0.62
g =	32.20 ft/sec²
H =	0.82 ft
A = P1*R²	0.09 ft²
D =	4.00 in
R =	2.00 in

CIRCLE

ORIFICE CALCULATION	
Equation: Q = Cd*A*((2*g*H)^0.5)	
Q =	0.86 ft³/sec
Cd =	0.62
g =	32.20 ft/sec²
H =	4.83 ft
A = P1*R²	0.08 ft²
D =	3.80 in
R =	1.90 in

RECTANGULAR

ORIFICE CALCULATION	
Equation: Q = Cd*A*((2*g*H)^0.5)	
Q =	4.88 ft³/sec
Cd =	0.62
g =	32.20 ft/sec²
H =	7.24 ft
A = BH	0.36 ft²
B =	8.75 in
H =	6.00 in

100YR Qallowable = 6.41 cfs

Q total = 4.88+0.86+0.39 = 6.13 cfs

25 YR STORM

25 YEAR 96" PIPE STORAGE CALCULATION	
PIPE DIAMETER (in.)	96.00
AREA OF PIPE (SF)	50.27
LENGTH OF PIPE (FT)	365.00
PIPE AREA ITERATIONS (GIVEN d> RADIUS)	
INPUT d (in)	69.98 <= USER INPUT
h = 2R-d	26.02
φ = 2arccos((r-h)/r)	2.19
K = (r^2(φ-sin(φ)))/2	11.01
A = πr^2 - K	39.26
PROVIDED VOLUME (96 in. PIPE)	14329

CIRCLE

ORIFICE CALCULATION	
Equation: Q = Cd*A*((2*g*H)^0.5)	
Q =	0.70 ft³/sec
Cd =	0.62
g =	32.20 ft/sec²
H =	3.17 ft
A = P1*R²	0.08 ft²
D =	3.80 in
R =	1.90 in

RECTANGULAR

ORIFICE CALCULATION	
Equation: Q = Cd*A*((2*g*H)^0.5)	
Q =	4.29 ft³/sec
Cd =	0.62
g =	32.20 ft/sec²
H =	5.58 ft
A = BH	0.36 ft²
B =	8.75 in
H =	6.00 in

25YR Qallowable = 5.23 cfs

Qtotal = 4.29 + 0.70 = 4.99 cfs

10 YR STORM

10 YEAR 96" PIPE STORAGE CALCULATION	
PIPE DIAMETER (in.)	96.00
AREA OF PIPE (SF)	50.27
LENGTH OF PIPE (FT)	365.00
PIPE AREA ITERATIONS (GIVEN d> RADIUS)	
INPUT d (in)	58.00 <= USER INPUT
h = 2R-d	38.00
φ = 2arccos((r-h)/r)	2.72
K = (r^2(φ-sin(φ)))/2	18.51
A = πr^2 - K	31.75
PROVIDED VOLUME (96 in. PIPE)	11589

CIRCLE

ORIFICE CALCULATION	
Equation: Q = Cd*A*((2*g*H)^0.5)	
Q =	0.58 ft³/sec
Cd =	0.62
g =	32.20 ft/sec²
H =	2.18 ft
A = P1*R²	0.08 ft²
D =	3.80 in
R =	1.90 in

RECTANGULAR

ORIFICE CALCULATION	
Equation: Q = Cd*A*((2*g*H)^0.5)	
Q =	3.88 ft³/sec
Cd =	0.62
g =	32.20 ft/sec²
H =	4.58 ft
A = BH	0.36 ft²
B =	8.75 in
H =	6.00 in

10YR Qallowable = 4.54 cfs

Qtotal = 3.88 + 0.58 = 4.46 cfs

5 YR STORM

5 YEAR 96" PIPE STORAGE CALCULATION	
PIPE DIAMETER (in.)	96.00
AREA OF PIPE (SF)	50.27
LENGTH OF PIPE (FT)	365.00
PIPE AREA ITERATIONS (GIVEN d> RADIUS)	
INPUT d (in)	53.07 <= USER INPUT
h = 2R-d	42.93
φ = 2arccos((r-h)/r)	2.93
K = (r^2(φ-sin(φ)))/2	21.76
A = πr^2 - K	28.51
PROVIDED VOLUME (96 in. PIPE)	10405

RECTANGULAR

ORIFICE CALCULATION	
Equation: Q = Cd*A*((2*g*H)^0.5)	
Q =	3.71 ft³/sec
Cd =	0.62
g =	32.20 ft/sec²
H =	4.17 ft
A = BH	0.36 ft²
B =	8.75 in
H =	6.00 in

5YR Qallowable = 3.76 cfs

Qtotal = 3.71 cfs

Owner:


Greentrest TPS Hotel, L.P.

3021 Ridge Road, A-120
Rockwall, TX 75032
Phone: (214) 890-9225

~ Civil Engineer ~

F.C. CUNY CORPORATION


#2 Horizon Court • Heath, Texas 75032 • (469) 402-7700
Texas Registered Engineering Firm F-7449




TOWNEPLACE
SUITES
MARRIOTT

908 E. INTERSTATE 30
ROCKWALL, TX 75087

12/23/2021





Drawn By:
F.C. CUNY

Checked By:
F.C. CUNY

Date:
11/19/2018

Project No.:
-

Sheet Title:
Pond #2
Calculations

Scale:

Sheet No.:

N.T.S.

12d of 14

SP 2018-029

RECORD DRAWING

This drawing is proprietary and may not be copied or used in any way without the written permission of FC Cuny Corporation ~©Copyright ~ FC Cuny Corporation

100 YR STORM

Present Conditions Q = CIA		PRE. DEVELOPED DRAINAGE AREAS	
A =	2.08	OS-2.1	
C =	0.35		
Tc =	20		
I100 =	8.30		
Q100 =	6.04	cfs	
Q100 =	6.04	cfs	

Q100 Allowable = 6.04 cfs

Future Conditions		DRAINAGE AREAS	Future Conditions		DRAINAGE AREAS
Q = CIA			Q = CIA		
A =	2.00	OS-3, OS-3.2	A =	0.36	OS-3.1
C =	0.35		C =	0.90	
Tc =	20		Tc =	10	
I100 =	8.30		I100 =	9.80	
Q100 =	5.81		Q100 =	3.18	
		cfs			cfs

Flow for Storm Durations			
Time	I	Cw	Q
10	9.80	0.43	10.04
15	9.00	0.43	9.22
20	8.30	0.43	8.50
30	6.90	0.43	7.07
40	5.80	0.43	5.94
50	5.00	0.43	5.12
60	4.50	0.43	4.61
70	4.00	0.43	4.10
80	3.70	0.43	3.79
90	3.50	0.43	3.58
100	3.40	0.43	3.48
110	3.20	0.43	3.28

Storage Calculations			
10 min			
Inflow	6021	Storage =	2396
Outflow	3625		
15 min			
Inflow	8294	Storage =	3763
Outflow	4532		
20 min			
Inflow	10199	Storage =	4761
Outflow	5438		
30 min			
Inflow	12718	Storage =	5467
Outflow	7251		
40 min			
Inflow	14254	Storage =	5190
Outflow	9064		
50 min			
Inflow	15360	Storage =	4484
Outflow	10876		
60 min			
Inflow	16589	Storage =	3900
Outflow	12689		
70 min			
Inflow	17203	Storage =	2701
Outflow	14502		
80 min			
Inflow	18186	Storage =	1872
Outflow	16314		
90 min			
Inflow	19354	Storage =	1226
Outflow	18127		
100 min			
Inflow	20890	Storage =	950
Outflow	19940		
110 min			
Inflow	21627	Storage =	-126
Outflow	21753		

100 YR WSEL 550.99

Weir Equation	
Q = Cd*L*H^(3/2)	
Q =	5.56 cfs
Cd =	3.37
L =	0.42 ft
Solving for H =	2.49 ft

25 YR STORM

Present Conditions Q = CIA		PRE. DEVELOPED DRAINAGE AREAS	
A =	2.08	OS-2.1	
C =	0.35		
Tc =	20		
I25 =	6.80		
Q25 =	4.95	cfs	
Q25 =	4.95	cfs	

Q25 Allowable = 4.95 cfs

Future Conditions		DRAINAGE	Future Conditions		DRAINAGE
Q = CIA		AREAS	Q = CIA		AREAS
A =	2.00	OS-3, OS-3.2	A =	0.36	OS-3.1
C =	0.35		C =	0.90	
Tc =	20		Tc =	10	
I25 =	6.80		I25 =	8.30	
Q25 =	4.76		Q25 =	2.69	
		cfs			cfs

Flow for Storm Durations			
Time	I	C	Q
10	8.30	0.43	8.50
15	7.40	0.43	7.58
20	6.80	0.43	6.96
30	5.50	0.43	5.63
40	4.70	0.43	4.81
50	4.00	0.43	4.10
60	3.50	0.43	3.58
70	3.30	0.43	3.38
80	3.10	0.43	3.17
90	2.80	0.43	2.87
100	2.60	0.43	2.66
110	2.40	0.43	2.46

Storage Calculations			
10 min			
Inflow	5100	Storage =	2129
Outflow	2970		
15 min			
Inflow	6820	Storage =	3107
Outflow	3713		
20 min			
Inflow	8356	Storage =	3900
Outflow	4455		
30 min			
Inflow	10138	Storage =	4197
Outflow	5940		
40 min			
Inflow	11551	Storage =	4125
Outflow	7426		
50 min			
Inflow	12288	Storage =	3377
Outflow	8911		
60 min			
Inflow	12902	Storage =	2507
Outflow	10396		
70 min			
Inflow	14193	Storage =	2312
Outflow	11881		
80 min			
Inflow	15237	Storage =	1871
Outflow	13366		
90 min			
Inflow	15483	Storage =	632
Outflow	14851		
100 min			
Inflow	15974	Storage =	-362
Outflow	16336		
110 min			
Inflow	16220	Storage =	-1601
Outflow	17821		

25 YR WSEL 550.64

Weir Equation	
Q = Cd*L*H^(3/2)	
Q =	4.43 cfs
Cd =	3.37
L =	0.42 ft
H =	2.14 ft

Proposed Pond Volume			
Elevation	Area	Volume	Total Volume
548.5	10	0	0
549	801	203	203
550	2567	1684	1887
551	4654	3611	5497
552	4836	4745	10242
553	4836	4836	15078
554	4836	4836	19914
555	4836	4836	24750

10 YR STORM

Present Conditions Q = CIA		PRE. DEVELOPED DRAINAGE AREAS	
A =	2.08	OS-2.1	
C =	0.35		
Tc =	20		
I10 =	5.90		
Q10 =	4.30	cfs	
Q10 =	4.30	cfs	

Q10 Allowable = 4.30 cfs

Future Conditions		DRAINAGE	Offsite Pass-Through		
Q = CIA		AREAS	Q = CIA		
A =	2.00	OS-3, OS-3.2	A =	0.36	OS-3.1
C =	0.35		C =	0.90	
Tc =	20		Tc =	10	
I10 =	5.90		I25 =	7.10	
Q10 =	4.13		cfs	Q25 =	2.30

Flow for Storm Durations			
Time	I	C	Q
10	7.10	0.43	7.27
15	6.50	0.43	6.66
20	5.90	0.43	6.04
30	4.90	0.43	5.02
40	4.00	0.43	4.10
50	3.40	0.43	3.48
60	3.00	0.43	3.07
70	2.80	0.43	2.87
80	2.60	0.43	2.66
90	2.40	0.43	2.46
100	2.20	0.43	2.25
110	2.00	0.43	2.05

Storage Calculations			
10 min			
Inflow	4362	Storage =	1785
Outflow	2577		
15 min			
Inflow	5990	Storage =	2769
Outflow	3221		
20 min			
Inflow	7250	Storage =	3384
Outflow	3866		
30 min			
Inflow	9032	Storage =	3877
Outflow	5154		
40 min			
Inflow	9830	Storage =	3388
Outflow	6443		
50 min			
Inflow	10445	Storage =	2713
Outflow	7731		
60 min			
Inflow	11059	Storage =	2039
Outflow	9020		
70 min			
Inflow	12042	Storage =	1734
Outflow	10308		
80 min			
Inflow	12780	Storage =	1182
Outflow	11597		
90 min			
Inflow	13271	Storage =	385
Outflow	12886		
100 min			
Inflow	13517	Storage =	-657
Outflow	14174		
110 min			
Inflow	13517	Storage =	-1946
Outflow	15463		

10 YR WSEL 550.55

Weir Equation	
Q = Cd*L*H^(3/2)	
Q =	4.15 cfs
Cd =	3.37
L =	0.42 ft
H =	2.05 ft

5 YR STORM

Present Conditions Q = CIA		PRE. DEVELOPED DRAINAGE AREAS	
A =	2.08	OS-2.1	
C =	0.35		
Tc =	20		
I5 =	4.90		
Q5 =	3.57	cfs	
Q5 =	3.57	cfs	

Q5 Allowable = 3.57 cfs

Future Conditions		DRAINAGE AREAS	Offsite Pass-Through		DRAINAGE AREAS
Q = CIA		OS-3, OS-3.2	Q = CIA		OS-3.1
A =	2.00		A =	0.36	
C =	0.35		C =	0.90	
Tc =	20		Tc =	10	
I5 =	20.00		I5 =	6.10	
Q5 =	14.00	cfs	Q5 =	1.98	cfs

Flow for Storm Durations			
Time	I	C	Q
10	6.10	0.43	6.25
15	5.60	0.43	5.73
20	4.90	0.43	5.02
30	4.00	0.43	4.10
40	3.40	0.43	3.48
50	2.90	0.43	2.97
60	2.60	0.43	2.66
70	2.40	0.43	2.46
80	2.20	0.43	2.25
90	2.10	0.43	2.15
100	1.90	0.43	1.95
110	1.70	0.43	1.74

Storage Calculations			
10 min			
Inflow	3748	Storage =	1608
Outflow	2140		
15 min			
Inflow	5161	Storage =	2486
Outflow	2675		
20 min			
Inflow	6021	Storage =	2811
Outflow	3210		
30 min			
Inflow	7373	Storage =	3092
Outflow	4281		
40 min			
Inflow	8356	Storage =	3005
Outflow	5351		
50 min			
Inflow	8909	Storage =	2488
Outflow	6421		
60 min			
Inflow	9585	Storage =	2094
Outflow	7491		
70 min			
Inflow	10322	Storage =	1761
Outflow	8561		
80 min			
Inflow	10813	Storage =	1182
Outflow	9631		
90 min			
Inflow	11612	Storage =	911
Outflow	10702		
100 min			
Inflow	11674	Storage =	-98
Outflow	11772		
110 min			
Inflow	11489	Storage =	-1353
Outflow	12842		

5YR WSEL 550.33

Weir Equation	
Q = Cd*L*H^(3/2)	
Q =	3.50 cfs
Cd =	3.37
L =	0.42 ft
H =	1.83 ft

SP 2018-029


RECORD DRAWING


This drawing is proprietary and may not be copied or used in any way without the written permission of FC Cuny Corporation ~ Copyright ~ FC Cuny Corporation

Revision	Date	Description

Owner:
Greentrest TPS Hotel, L.P.

3021 Ridge Road, A-120
Rockwall, TX 75082
Phone: (214) 890-9225

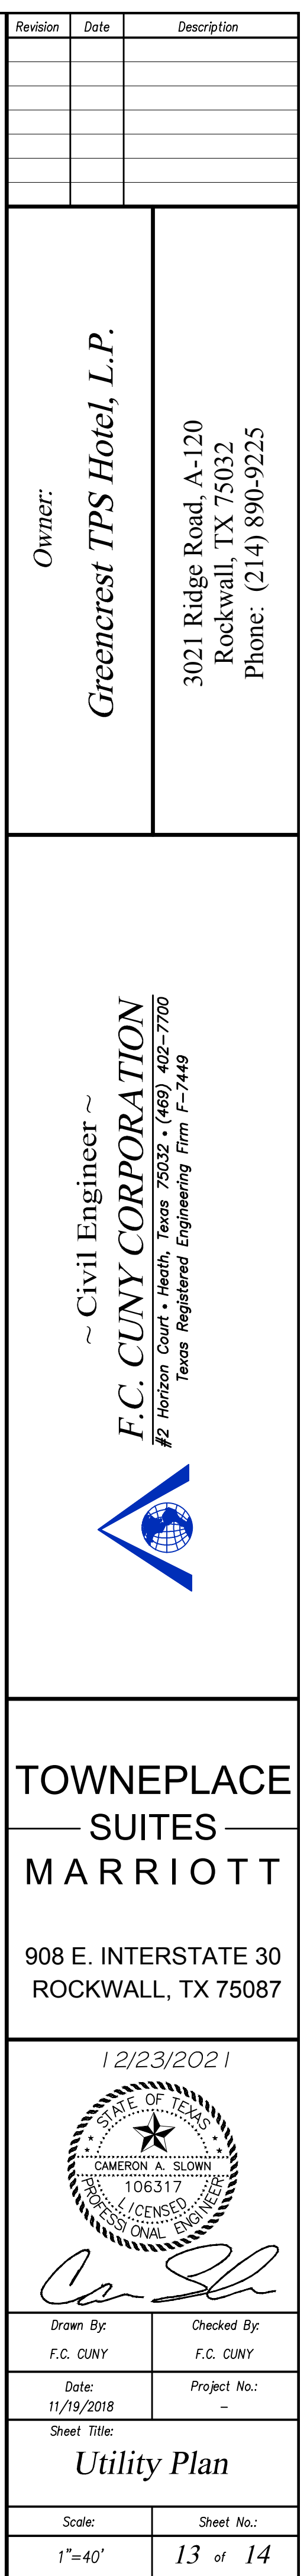

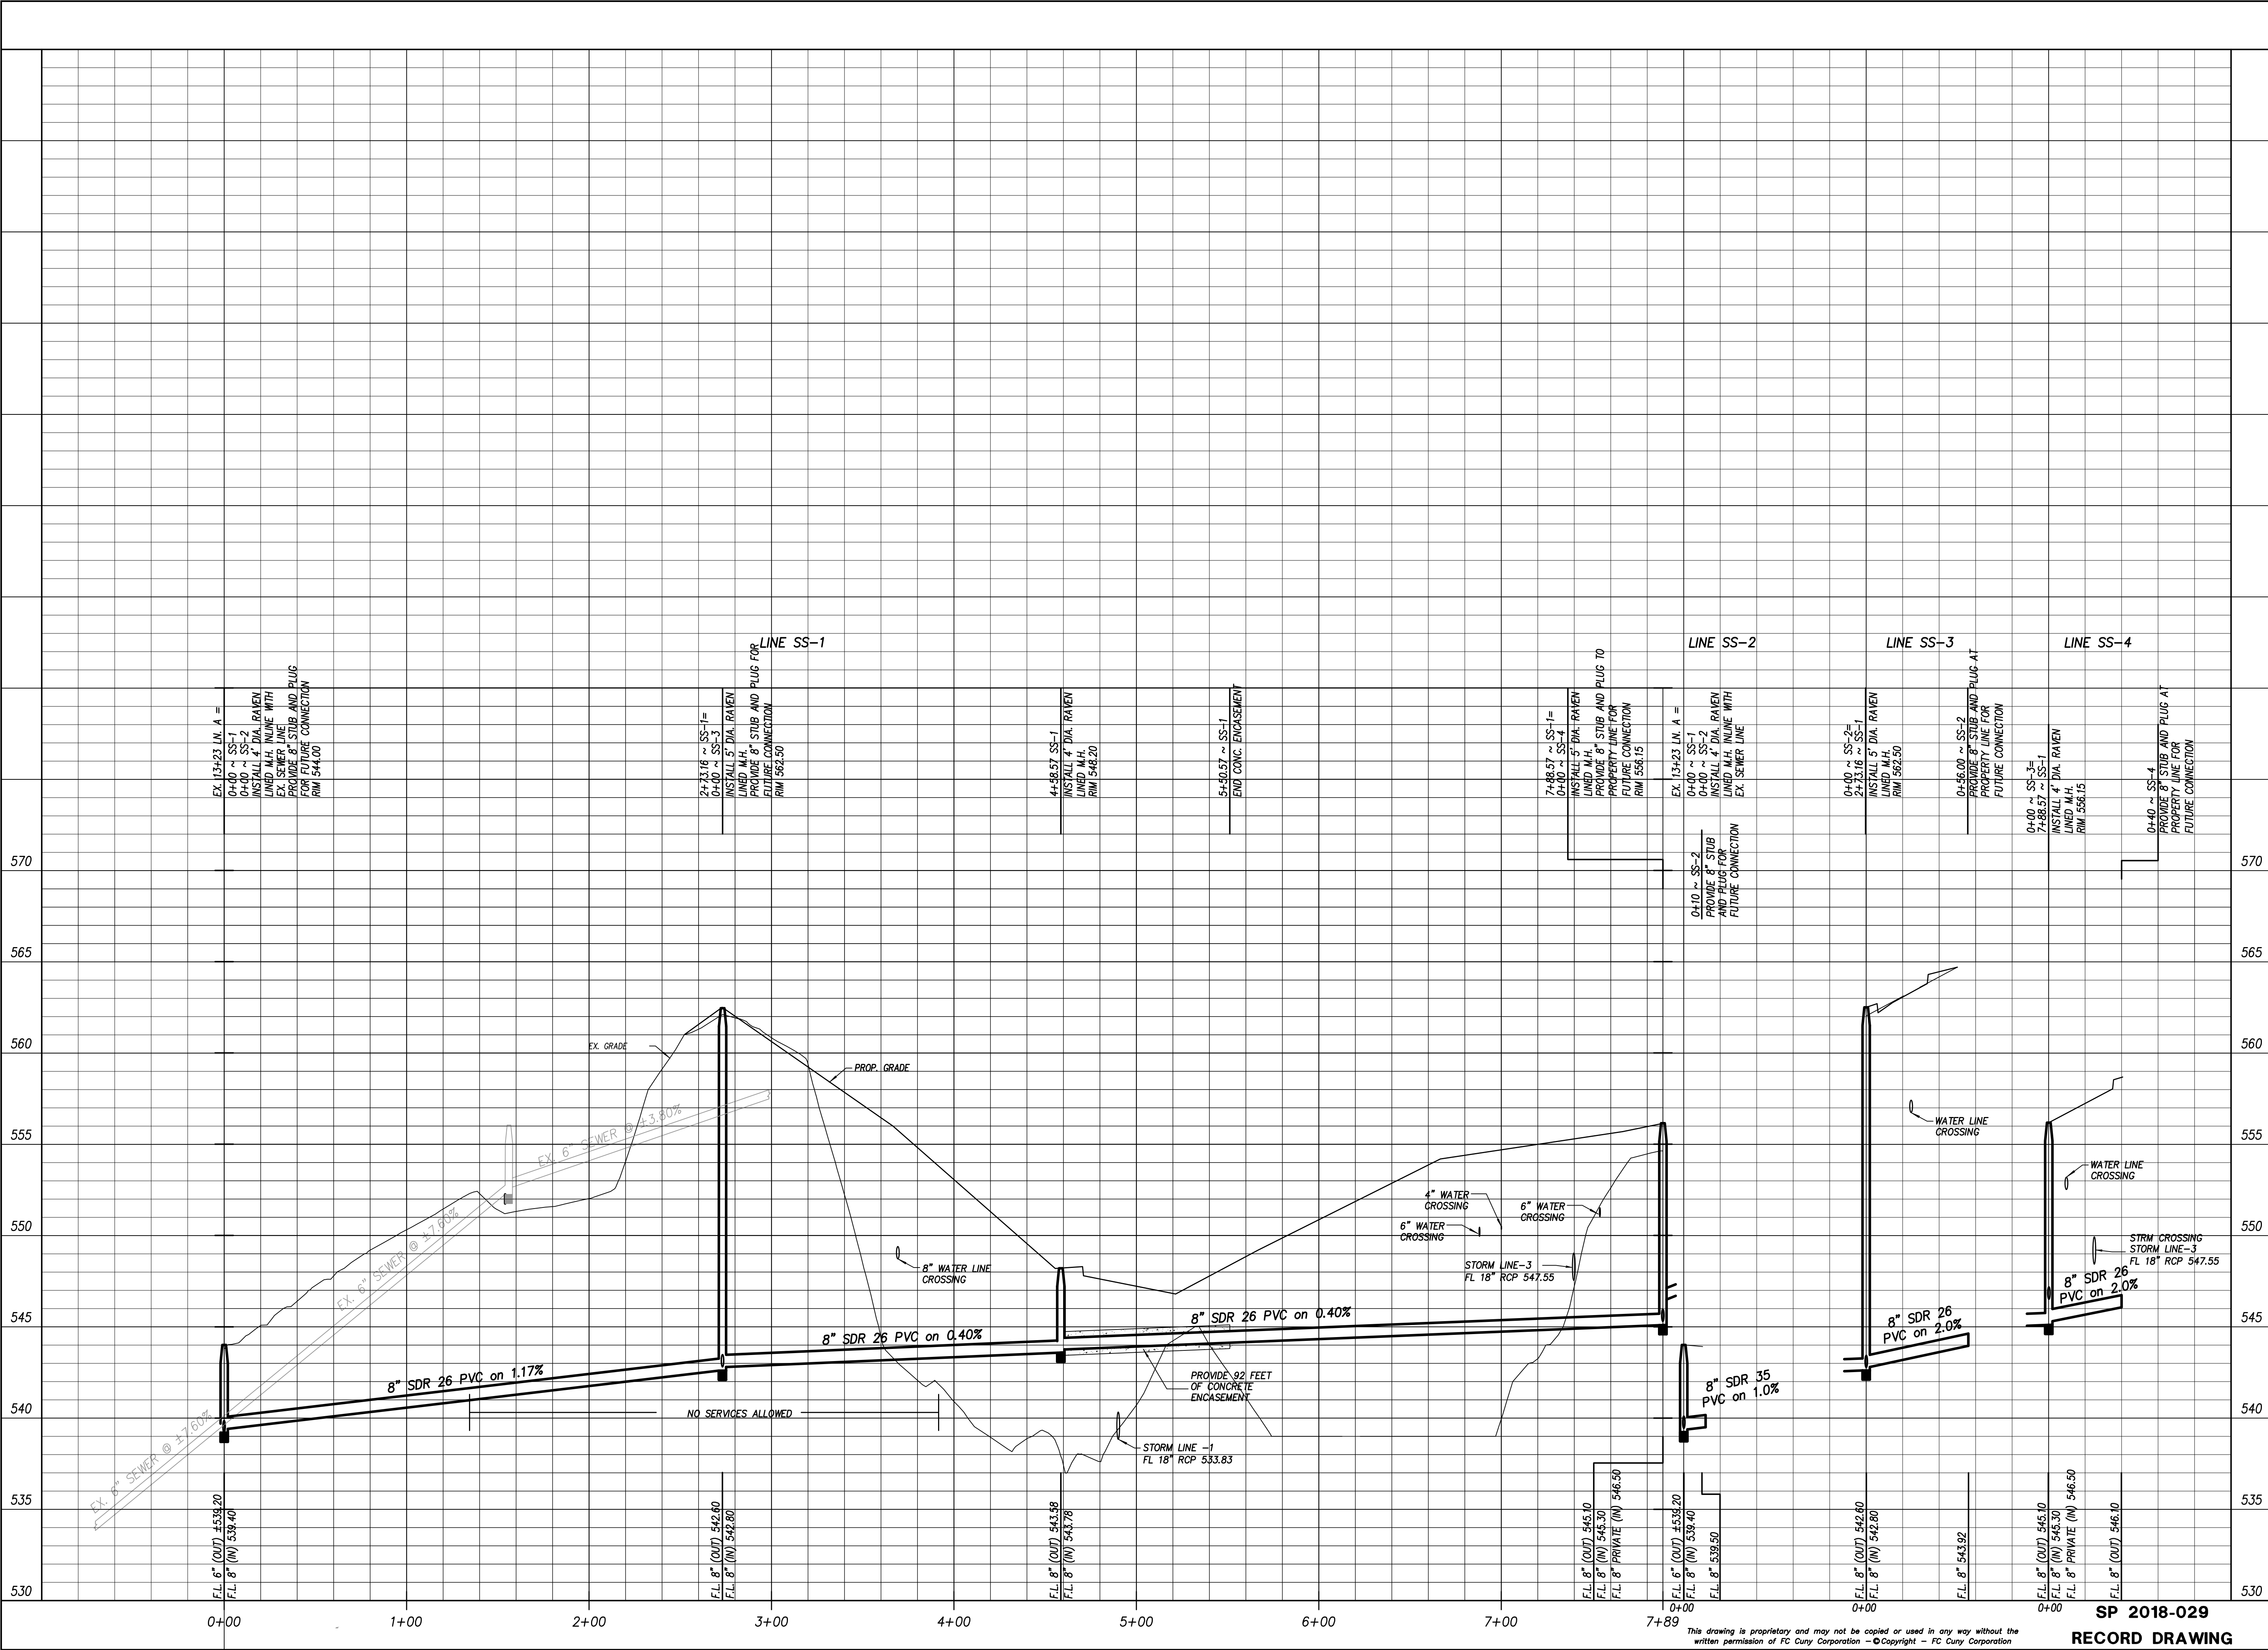


Revision	Date	Description

Owner:
Greentrest TPS Hotel, L.P.

3021 Ridge Road, A-120
Rockwall, TX 75032
Phone: (214) 890-9225


~ Civil Engineer ~
F.C. CUNY CORPORATION
#2 Horizon Court • Heath, Texas 75032 • (469) 402-7700
Texas Registered Engineering Firm F-7449



TOWNEPLACE SUITES MARRIOTT

908 E. INTERSTATE 30
ROCKWALL, TX 75087

12/23/2021

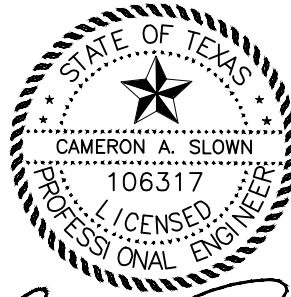
Cameron A. Slom
LICENSED PROFESSIONAL ENGINEER

Drawn By:
F.C. CUNY

Checked By:
F.C. CUNY

Date:
11/19/2018

Project No.:
-

Sheet Title:
Sanitary Sewer Profile

Scale:
V: 1"=4'
H: 1"=40'

Sheet No.:
14 of 14

