

LEGEND PROPERTY LINE ADJOINED PROPERTY EXISTING 1' CONTOUR PROPOSED 1' CONTOUR EXISTING OVER HEAD ELECTRIC EXISTING WATER LINE PROP. SPOT ELEV FLOW ARROW TOP OF GRATE TOP OF CURB TOP OF RIM TOP OF FINISH GRADE TOP OF RETAINING WALL BASE OF RETAINING WALL FLOWLINE

1. ALL UNDERGROUND UTILITIES SHOWN ARE BASED ON THE BEST AVAILABLE INFORMATION. THE CONTRACTOR SHALL VERIFY EXACT UTILITY LOCATIONS PRIOR TO ANY CONSTRUCTION. THE CONTRACTOR SHALL CALL DIG-TESS AT 1.800.344.8377 PRIOR TO ANY EXCAVATION.

HIGH POINT

- 2. IF ANY CONFLICT OR DISCREPANCY FROM THE PLANS IS FOUND, NOTIFY THE ENGINEER BEFORE CONTINUING WITH ANY FURTHER CONSTRUCTION.
- 3. ALL PIPE SHALL BE LAID STARTING AT THE OUTFALL AND LAID UPSTREAM FROM THAT POINT.
- 4. STORM SEWER PIPE SHALL BE RCP UNLESS NOTED OTHERWISE.
- 5. SPOT ELEVATIONS SHOWN ARE TO THE TOP OF PROPOSED PAVEMENT AND/OR TOP OF FINISHED GRADE, UNLESS OTHERWISE NOTED. ADD 0.5 FEET FOR TOP OF CURB ELEVATIONS.
- 6. CONTRACTOR TO OBTAIN ALL PERMITS REQUIRED BY CITY OF ROCKWALL, TEXAS PRIOR TO STARTING CONSTRUCTION.
- 7. REFER TO EROSION CONTROL PLAN, SHEET C-5.0, FOR SEQUENCE OF CONSTRUCTION.
- 8. <u>DIG-TESS</u> TEXAS ONE CALL PARTICIPANTS REQUEST 48 HOURS NOTICE BEFORE YOU DIG, DRILL OR BLAST. STOP, CALL TEXAS DIG-TESS SYSTEM AT 1.800.344.8377.

RECORD DRAWING

THE DRAWINGS CONTAINED IN THIS SET ARE "RECORD DRAWINGS". TO THE BEST OF OUR KNOWLEDGE, CARTER BURGESS, INC. HEREBY CERTIFY THAT THIS PLAN IS AS-BUILT. THE INFORMATION PROVIDED IS BASED ON SITE OBSERVATION, SURVEY CONDUCTED AT THE SITE BY THE SURVEYOR, AND INFORMATION PROVIDED BY THE CONTRACTOR.


TRENCH SAFETY

STATE OF TEXAS LAW REQUIRES THAT THE CONTRACTOR WILL PROVIDE A TRENCH SAFETY PLAN (TRENCH SHORING) FOR UTILITY TRENCHES GREATER THAN FIVE (5) FEET IN DEPTH. THIS PLAN SHALL BE PREPARED BY A PROFESSIONAL ENGINEER.


BENCHMARK

SITE BM: "X" ON TOP OF INLET, WEST SIDE OF TOWNSEND DRIVE, APPROXIMATELY 275' SOUTH OF INTERSTATE HIGHWAY NO. 30. ELEVATION = 539.62

THE LOCATION OF EXISTING UNDERGROUND UTILITIES ARE SHOWN IN AN APPROXIMATE WAY ONLY. THE CONTRACTOR TO DETERMINE THE EXACT LOCATION OF ALL EXISTING UTILITIES BEFORE COMMENCING WORK, CONTRACTOR WILL BE FULLY RESPONSIBLE FOR ANY AND ALL DAMAGES WHICH MIGHT OCCUR BY FAILURE TO EXACTLY LOCATE AND PRESERVE ANY AND ALL UNDERGROUND UTILITIES.

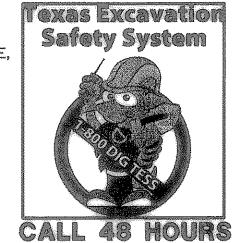


BEFORE YOU DIG

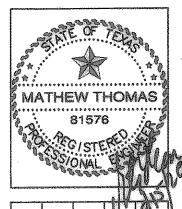

.,,.,.		less VI.			
			V	**************************************	K.
ACTION OF THE STANKE CONTRACTOR OF THE STANKE		逶	Ţ	Æ	
SSE	ISSUED FOR PERMIT	CITY REVIEW COMMENTS	DETENTION POND REVISION	ISSUE RECORD DRAWINGS	
ij	2/20/07	03/12/07	01/21/08	02/15/08	
ż			Santific Control of Co		

ERSTATI

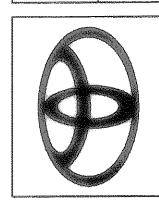

PROJECT NO. 293533.020 DRAWN BY: RAL CHECKED BY: MT

SHEET: