


6" COMPACTED SUBRADE COMPACTED TO AT LEAST 95% OF MAXIMUM DRY DENSITY AT ±3% OF THE OPTIMUM MOISTURE PER ASTM D698

CONCRETE SHALL MEET TXDOT ITEM 360 AND HAVE A 28 DAY COMPRESSIVE STRENGTH OF 3,600 psi, WITH 4-6% AIR ENTRAINMENT.


7" CONCRETE PAVEMENT SECTION (TRASH COMPACTOR/TRUCK DOCK)

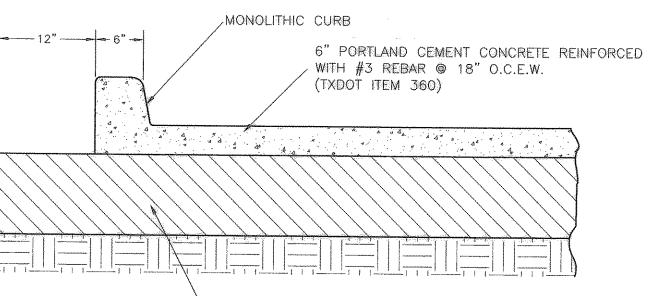

`6" COMPACTED SUBRADE MIXED WITH 8% HYDRATED LIME AND COMPACTED TO AT LEAST 95% OF MAXIMUM DRY DENSITY AT ±3% OF THE OPTIMUM MOISTURE PER ASTM

CONCRETE SHALL MEET TXDOT ITEM 360 AND HAVE A 28 DAY COMPRESSIVE STRENGTH OF 3,600 psi, WITH 4-6% AIR ENTRAINMENT.

6" PAVEMENT SECTION (FIRE LANE)

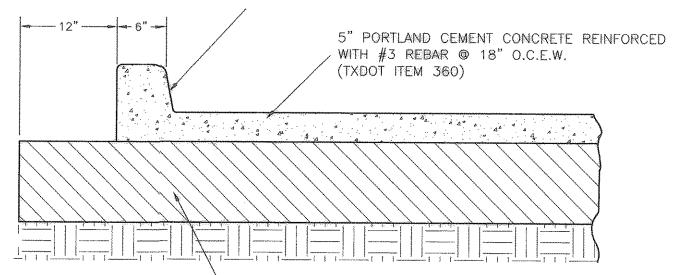



'6" COMPACTED SUBRADE AND COMPACTED TO AT LEAST 95% OF MAXIMUM DRY DENSITY AT ±3% OF THE OPTIMUM MOISTURE PER ASTM D698


CONCRETE SHALL MEET TXDOT ITEM 360 AND HAVE A 28 DAY COMPRESSIVE STRENGTH OF 3,600 psi, WITH 4-6% AIR ENTRAINMENT.


5" PAVEMENT SECTION (PARKING)


NOTE: PAVEMENT SECTION THICKNESSES AND COMPACTION RATINGS SHOWN ARE PER THE TERRACON CONSULTANTS, INC. REPORT NO.94065036, DATED FEBRUARY 16, 2006.

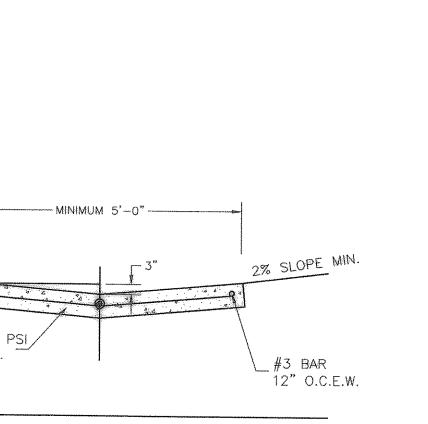

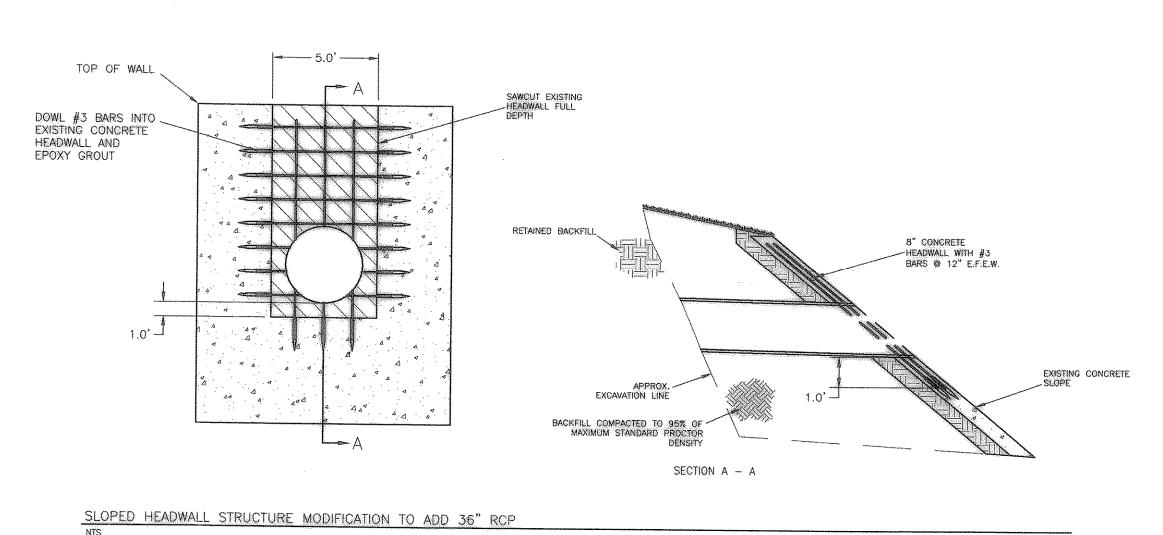

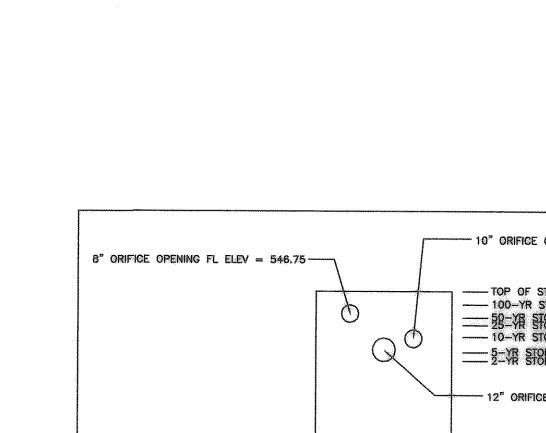

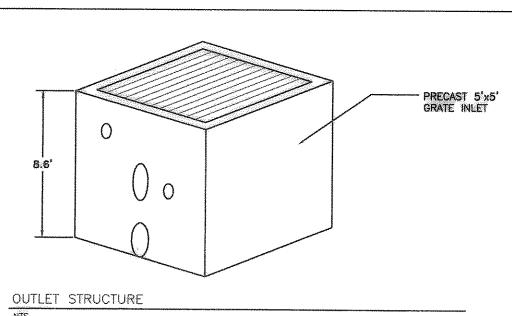

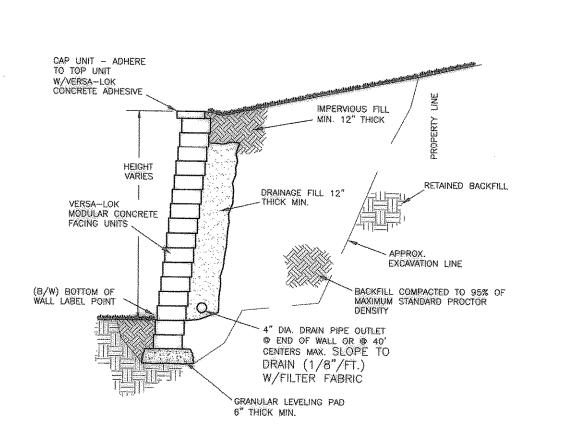

6" 3600 PSI CONC.

PILOT CHANNEL

NTS

SEGMENTAL BLOCK RETAINING WALL TYPICAL SECTION RETAINING WALL TYPE I

\* COLOR OF RETAINING WALL MODULAR BLOCKS TO BE SPECIFIED BY ARCHITECT.

REFER TO CONCRETE PAVEMENT SECTION, -STEM WALL AND VERTICAL CURB SECTION FOR RETAINING WALLS RETAINING WALL TYPE II

NON-STRUCTURAL RETAINING WALL RETAINING WALL TYPE III

2. PROVIDE EXPANSION JOINT AT 100'-0" MAX.

3. REFER TO CIVIL DRAWINGS FOR RETAINING WALL LOCATIONS AND ELEVATIONS.


#4 CONT @ 12" OC ---


— HANDRAIL 42" MIN. HEIGHT SEE: ARCH PLANS FOR DETAILS

3/4" CHAMFER (TYP.) FINISH PAVING

RECORD DRAWING


THE DRAWINGS CONTAINED IN THIS SET ARE "RECORD DRAWINGS". TO THE BEST OF OUR KNOWLEDGE, CARTER BURGESS, INC. HEREBY CERTIFY THAT THIS PLAN IS AS-BUILT. THE INFORMATION PROVIDED IS BASED ON SITE OBSERVATION, SURVEY CONDUCTED AT THE SITE BY THE SURVEYOR, AND INFORMATION PROVIDED BY THE CONTRACTOR.

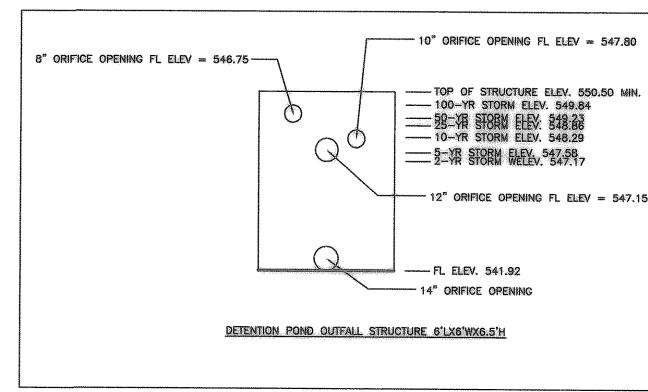

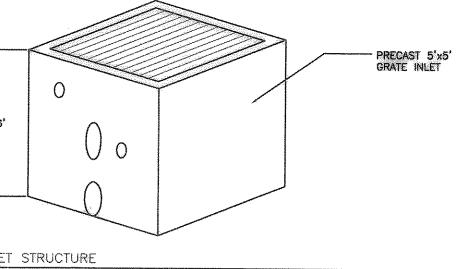

MATHEW THOMAS 81576

30 TERSTATE HIGHWAY NO. ROCKWALL, TEXAS

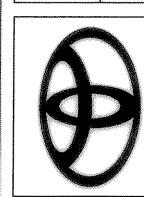

PROJECT NO. 293533.020 DRAWN BY: CHECKED BY: MT

SHEET: C - 8.0