
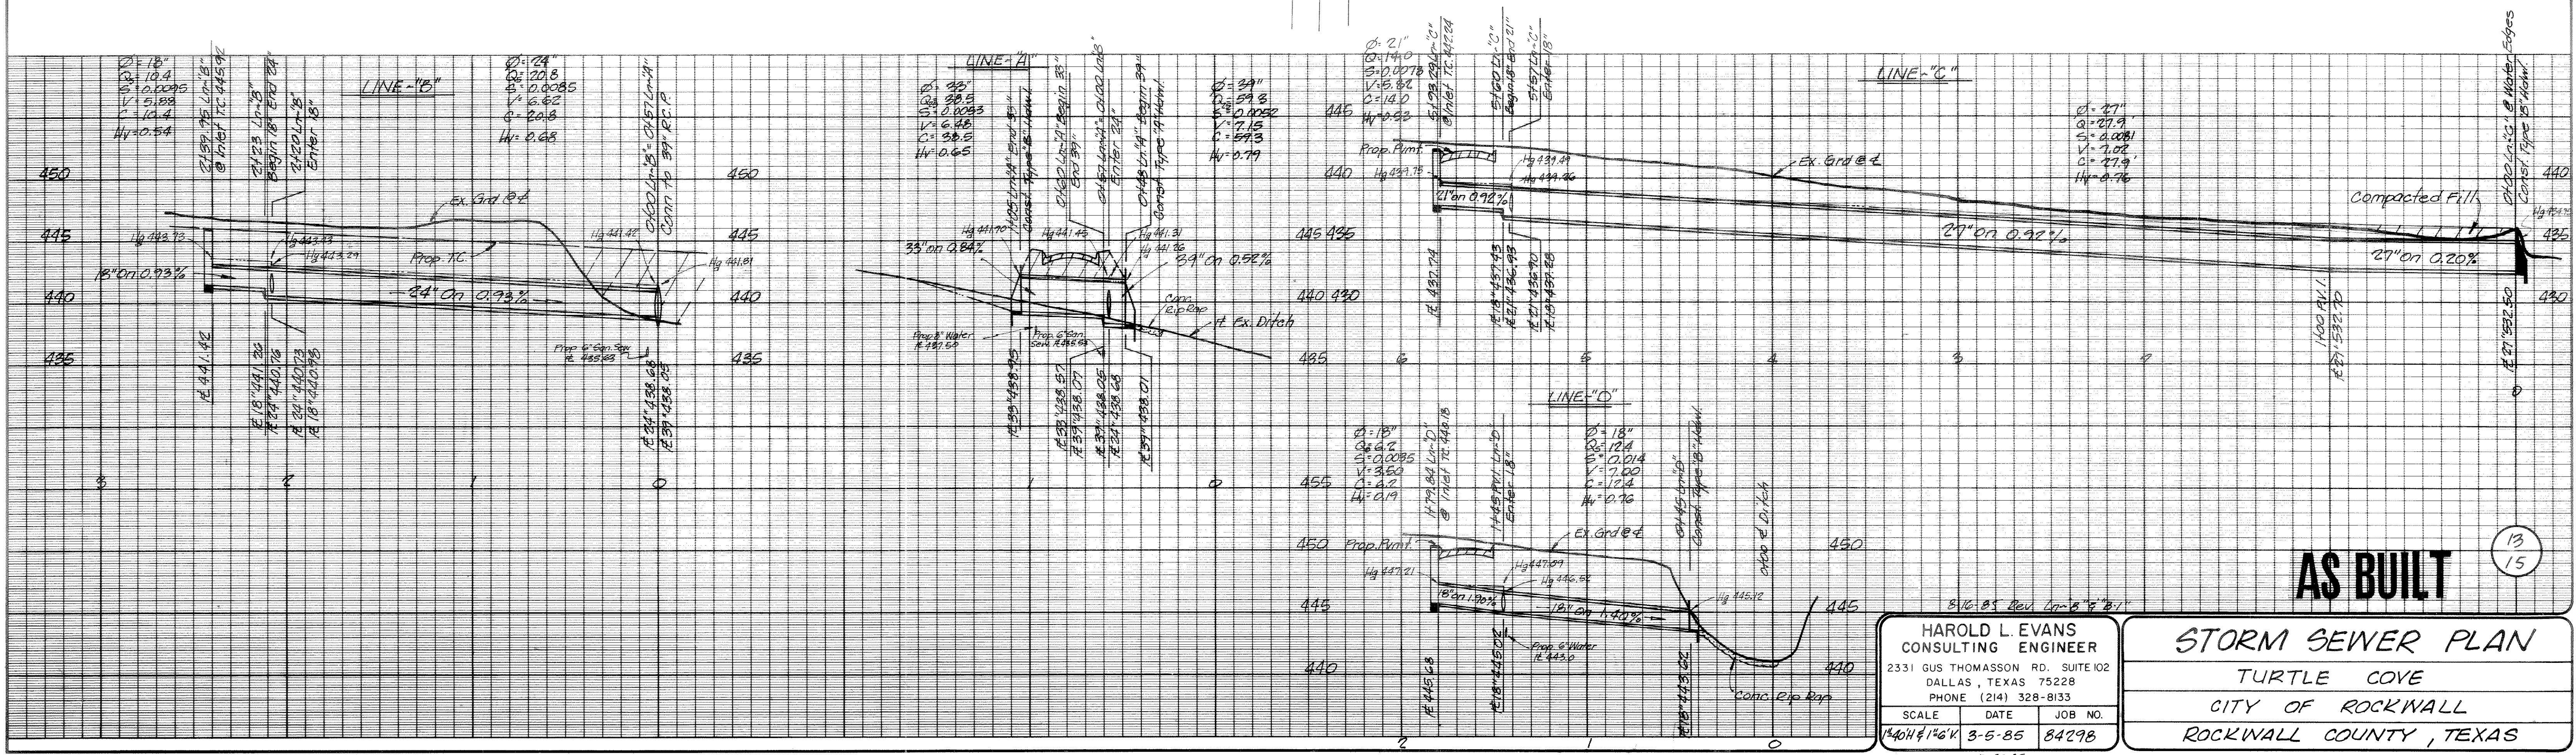


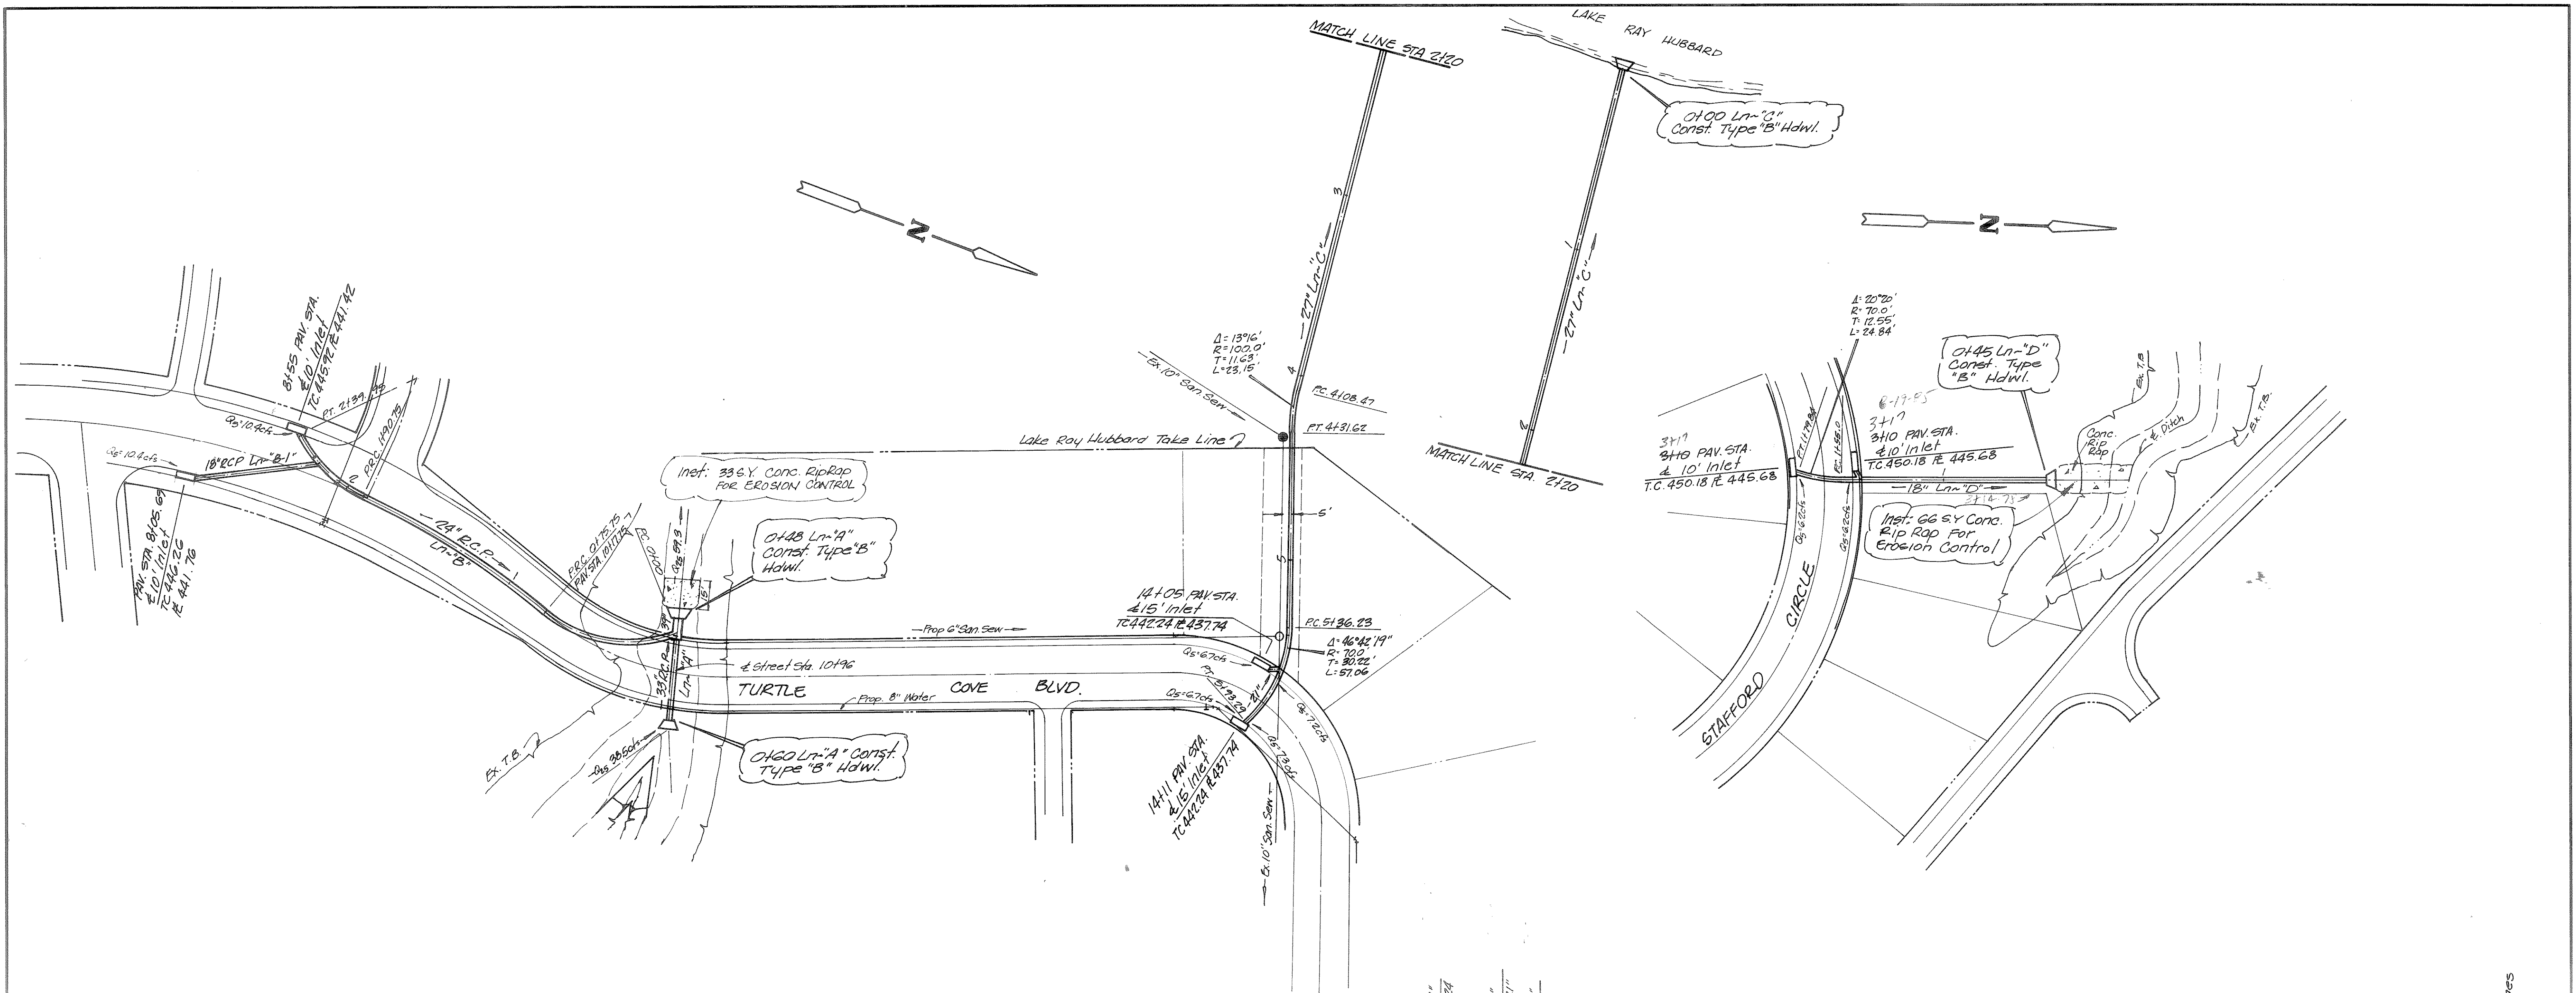

AS BUILT

HAROLD L. EVANS
CONSULTING ENGINEER
2331 GUS THOMASSON RD., SUITE 102
DALLAS, TEXAS 75228
PHONE (214) 328-8133

SCALE: 1"=40' DATE: 3-5-85 JOB NO.: 84298

STORM SEWER PLAN

TURTLE COVE

CITY OF ROCKWALL

ROCKWALL COUNTY, TEXAS