


ROCKWALL URBAN + INDUSTRIAL CENTER

ALPHA DRIVE CITY OF ROCKWALL, TEXAS

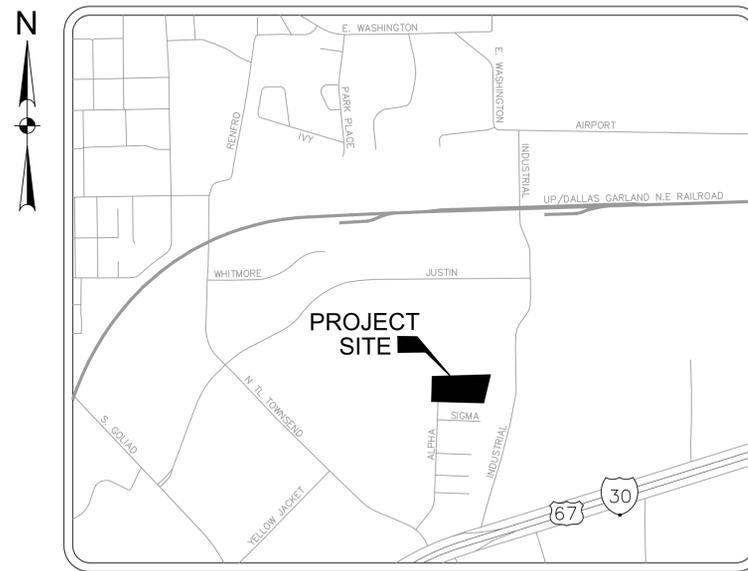

LOCATION MAP
SCALE/NOT TO SCALE

Sheet List Table

Sheet Number	Sheet Title
--	COVER SHEET
--	APPROVED SITE PLAN
--	REPLAT
C0.01	GENERAL NOTES
C0.02	DEMOLITION PLAN
C1.01	PAVING & DIMENSIONAL CONTROL PLAN
C1.02	PAVING DETAILS
C1.03	PAVING DETAILS
C2.01	GRADING PLAN
C3.01	EXISTING DRAINAGE AREA MAP
C3.02	PROPOSED DRAINAGE AREA MAP
C3.03	PROPOSED SITE DRAINAGE AREA MAP
C3.04	STORM DRAINAGE PLAN
C3.05	STORM DRAINAGE PROFILE
C3.06	STORM DRAINAGE PROFILE
C3.07	DETENTION POND PLAN
C3.08	STORM CALCULATIONS
C3.09	STORM DRAIN DETAILS
C4.01	UTILITY PLAN
C4.02	WASTEWATER PROFILE
C4.03	WASTEWATER PROFILE
C4.04	UTILITY DETAILS
C5.01	EROSION CONTROL PLAN
C5.02	EROSION CONTROL DETAILS

OWNER/DEVELOPER

LONG BOW INTERESTS
13150 COIT ROAD
DALLAS, TX. 75240
CONTACT: REID CALDWELL
EMAIL: reid@longbowinterests.com
TEL: (214) 457-8198

ENGINEER

HALFF ASSOCIATES, INC.
1201 NORTH BOWSER ROAD
RICHARDSON, TX. 75081
CONTACT: DYLAN HEDRICK
EMAIL: dhedrick@halff.com
TEL: (214) 217-6426
TBPE FIRM# F-312



1201 NORTH BOWSER ROAD
RICHARDSON, TX 75081-2275
(214) 346-6200




AVO: 35989.002 DATE: MARCH 2020

RECORD DRAWING

NOVEMBER 24, 2020

THESE RECORD DRAWINGS HAVE BEEN PREPARED BASED ON FIELD OBSERVATIONS AND INFORMATION PROVIDED BY THE CONTRACTOR. ELEVATIONS HAVE NOT BEEN FIELD VERIFIED. THE ORIGINAL SEALED CONSTRUCTION DRAWINGS ARE ON FILE AT THE OFFICES OF HALFF ASSOCIATES, INC. TBPE FIRM F-312.

ENGINEER OF RECORD
DYLAN B. HEDRICK
HALFF ASSOCIATES, INC. TBPE FIRM F-312
DATE: NOVEMBER 24, 2020

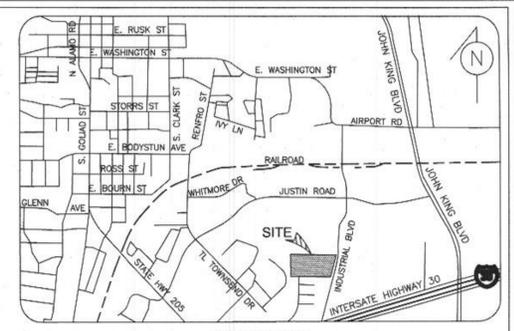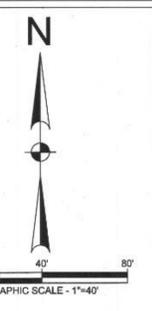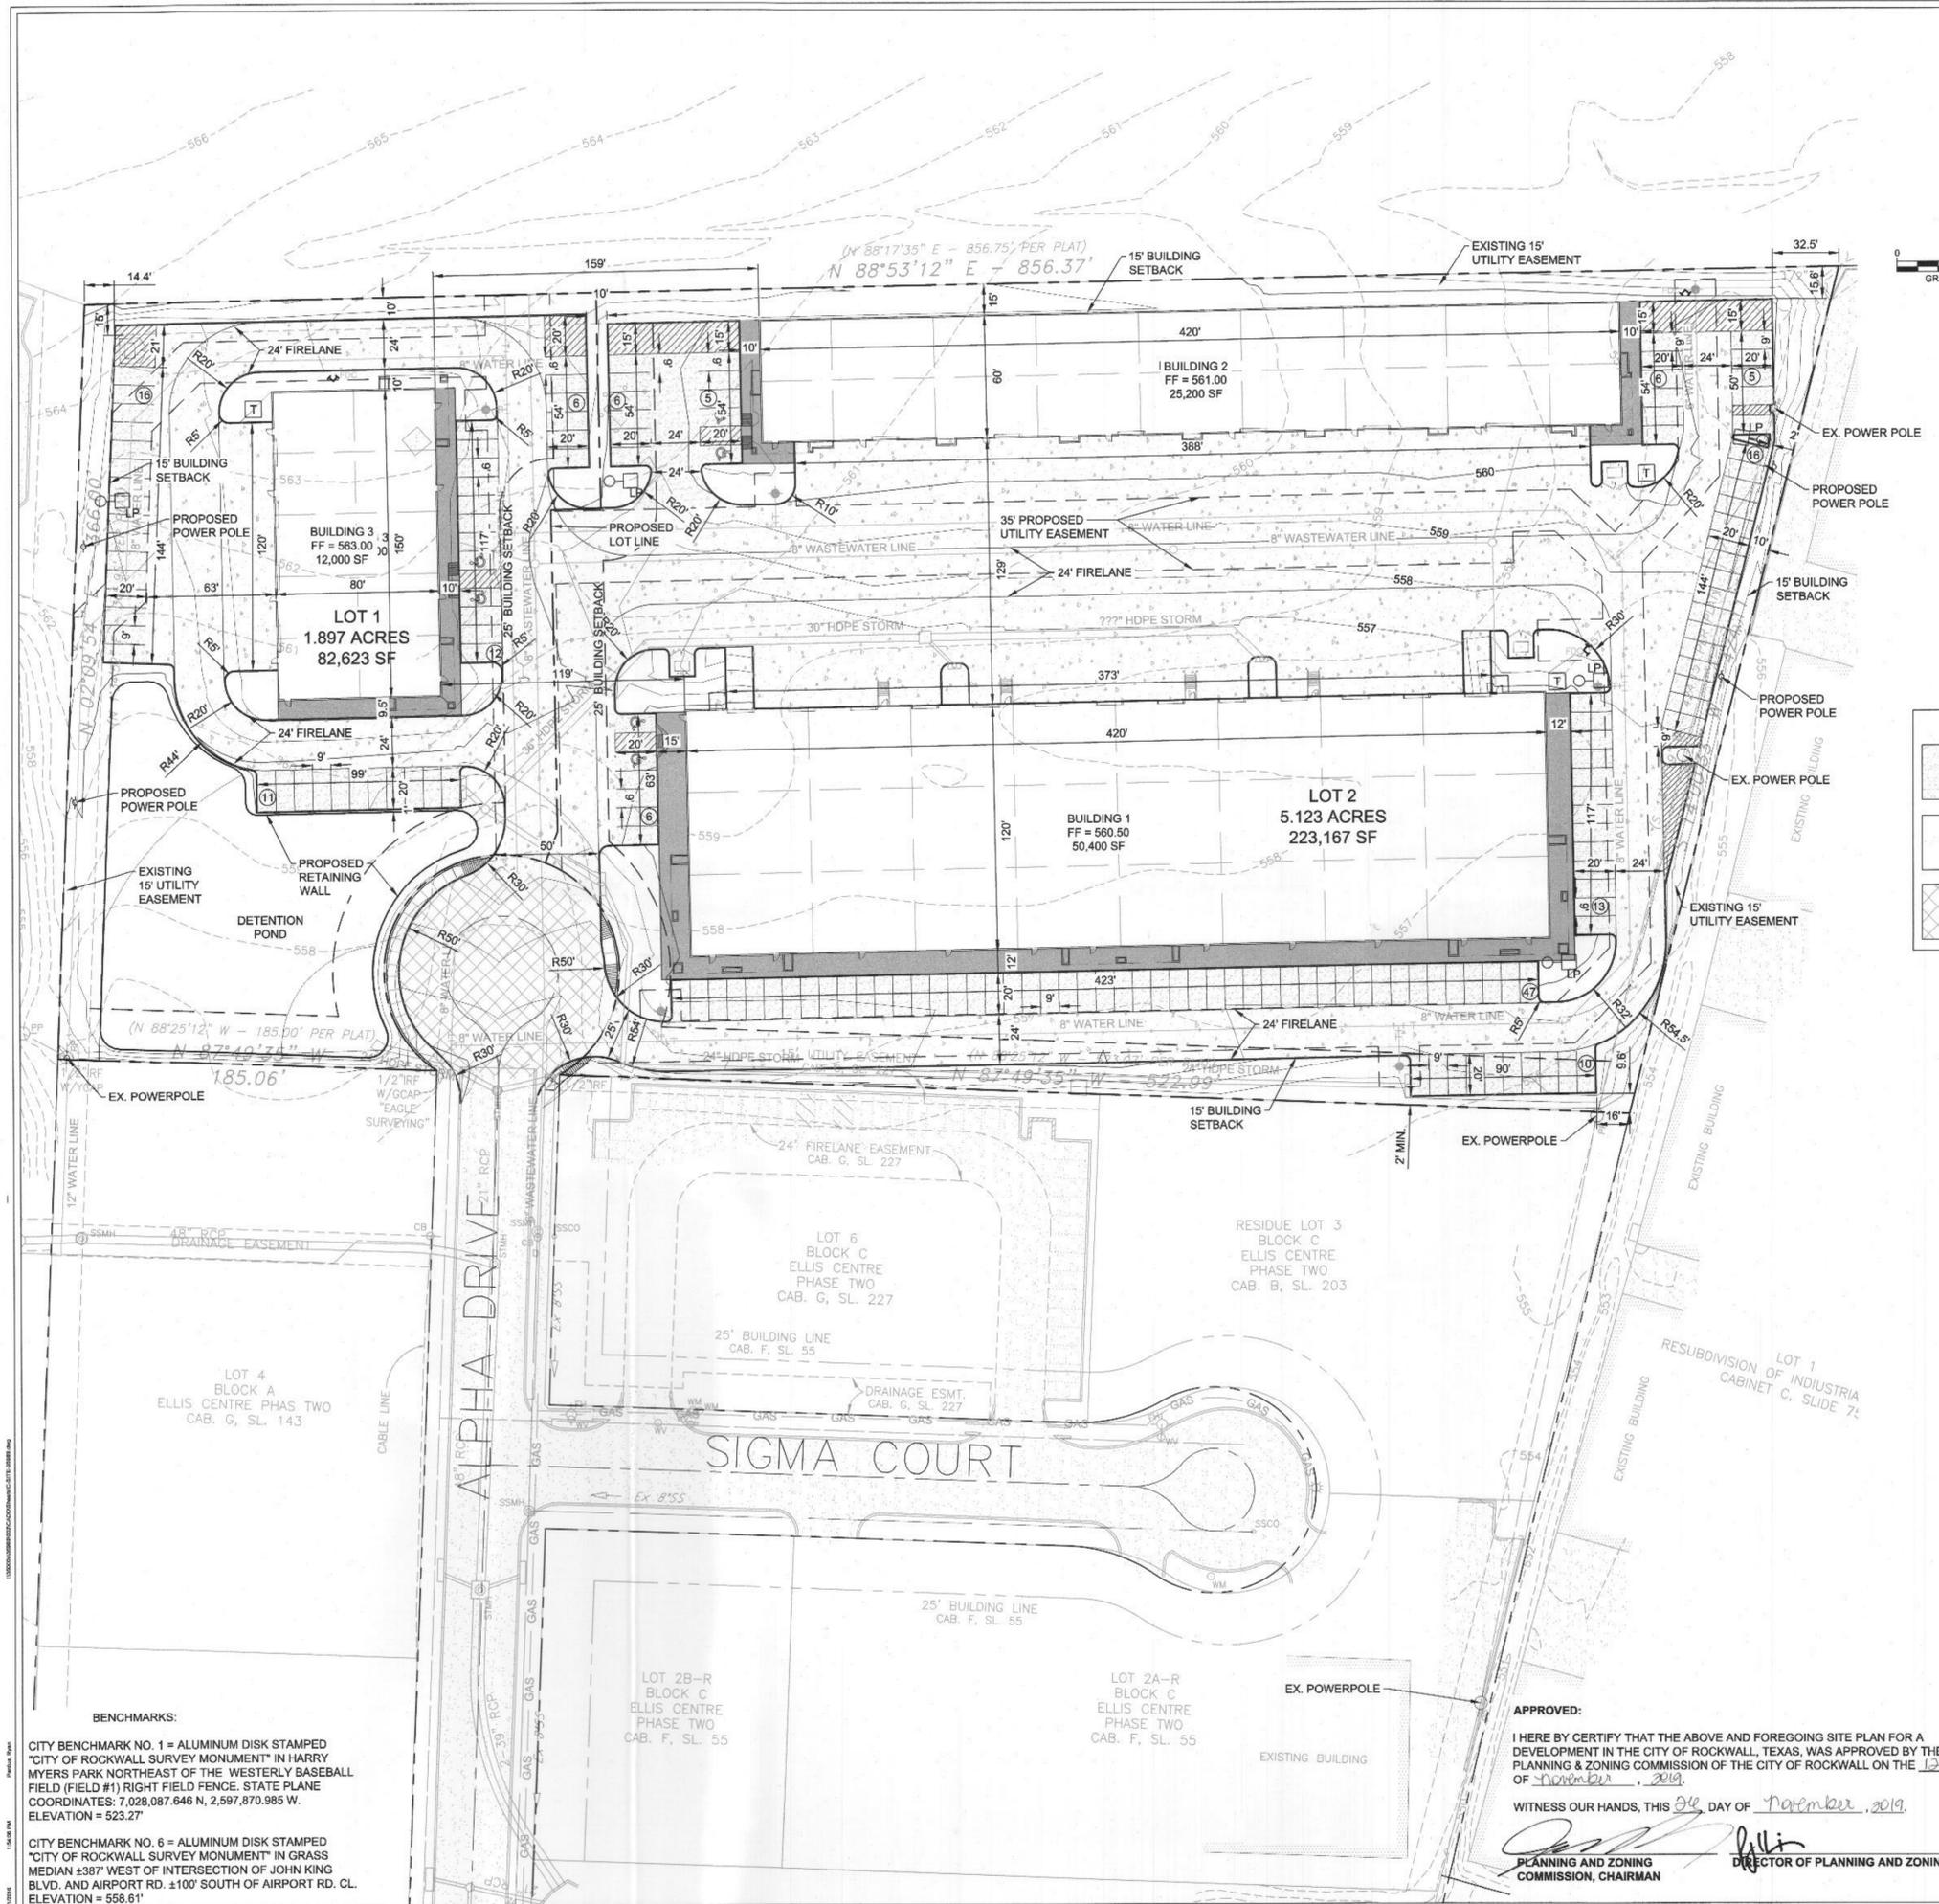

SHEET DATA:

CURRENT ZONING:	LIGHT INDUSTRIAL	
PROPOSED LAND USE:	LIGHT INDUSTRIAL	
TOTAL SITE AREA:	7.02 ACRES	
BUILDING:		
BUILDING 1	50,400	SF
BUILDING 2	25,200	SF
BUILDING 3	12,000	SF
PARKING:		
REQUIRED: 1 SPACE/1,000 SF (75%)	1 SPACE/300 SF (25%)	
TOTAL REQUIRED:	139	SPACES
PROVIDED:	159	SPACES
ACCESSIBLE SPACES PROVIDED:	6*	SPACES

*SPACES ARE INCLUDED IN TOTAL ABOVE

PAVING LEGEND




	6" 3,600 PSI CONCRETE PAVEMENT.		4" SIDEWALK
	7" 4,000 PSI CONCRETE PAVEMENT.		6" CURB
	8" 3,600 PSI CONCRETE PAVEMENT.		FIRE LANE
			PROPERTY LINE

EXISTING FEATURES LEGEND

	F.H. FIRE HYDRANT
	PP OVERHEAD POWERPOLE
	SSMH SANITARY SEWER MANHOLE
	WV WATER VALVE
	558 EXISTING CONTOURS
	FDC

PROPOSED FEATURES LEGEND

	POWER POLE
	FIRE HYDRANT
	GRATE INLET
	CURB INLET
	STORM HEADWALL
	TRANSFORMER PAD
	558 PROPOSED CONTOURS
	LIGHT POLE
	# NO. OF PARKING SPACES

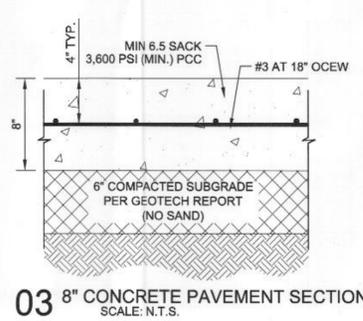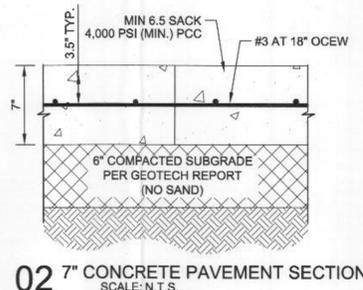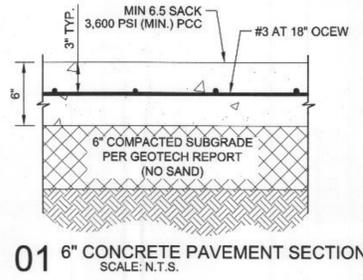

NOTES:

- ALL DIMENSIONS ARE TO FACE OF CURB UNLESS OTHERWISE NOTED.

OWNER/ DEVELOPER
ROCKWALL URBAN INDUSTRIAL, LP
13150 COIT ROAD
DALLAS, TX. 75240
CONTACT: REID CALDWELL
EMAIL: reid@longbowinterests.com
TEL: (214) 457-8198

ENGINEER
HALFF ASSOCIATES, INC.
1201 NORTH BOWSER ROAD
RICHARDSON, TX. 75081
CONTACT: DYLAN HEDRICK
EMAIL: dhedrick@halff.com
TEL: (214) 217-6426
TBPE FIRM# F-312

ALL RESPONSIBILITY FOR ADEQUACY OF DESIGN REMAIN WITH THE DESIGN ENGINEER. THE CITY OF ROCKWALL, IN REVIEWING AND RELEASING PLANS FOR CONSTRUCTION, ASSUMES NO RESPONSIBILITY FOR ADEQUACY OF DESIGN.

APPROVED:

I HEREBY CERTIFY THAT THE ABOVE AND FOREGOING SITE PLAN FOR A DEVELOPMENT IN THE CITY OF ROCKWALL, TEXAS, WAS APPROVED BY THE PLANNING & ZONING COMMISSION OF THE CITY OF ROCKWALL ON THE 12TH DAY OF November, 2019.

WITNESS OUR HANDS, THIS 12TH DAY OF November, 2019.

[Signature]
PLANNING AND ZONING COMMISSION, CHAIRMAN

[Signature]
DIRECTOR OF PLANNING AND ZONING

BENCHMARKS:

CITY BENCHMARK NO. 1 = ALUMINUM DISK STAMPED "CITY OF ROCKWALL SURVEY MONUMENT" IN HARRY MYERS PARK NORTHEAST OF THE WESTERLY BASEBALL FIELD (FIELD #1) RIGHT FIELD FENCE. STATE PLANE COORDINATES: 7,028,087.646 N, 2,597,870.985 W. ELEVATION = 523.27'

CITY BENCHMARK NO. 6 = ALUMINUM DISK STAMPED "CITY OF ROCKWALL SURVEY MONUMENT" IN GRASS MEDIAN ±387' WEST OF INTERSECTION OF JOHN KING BLVD. AND AIRPORT RD. ±100' SOUTH OF AIRPORT RD. CL. ELEVATION = 558.61'

Rockwall Urban + Industrial Center
END OF ALPHA DRIVE
ROCKWALL, TX 75087



Revision No.	Date	Description

PRELIMINARY
FOR INTERIM REVIEW ONLY
THESE DOCUMENTS ARE FOR INTERIM REVIEW AND ARE NOT INTENDED FOR REGULATORY APPROVAL, PERMITTING, BIDDING OR CONSTRUCTION PURPOSES. THEY WERE PREPARED BY, OR UNDER THE SUPERVISION OF:



DYLAN B. HEDRICK 102108
NAME P.E. NO.
DATE 11/15/2019
TBPE FIRM# F-312

Project No.:	35989
Issued:	NOVEMBER 2019
Drawn By:	REP
Checked By:	DBH
Scale:	AS SHOWN
Sheet Title	DETAILED SITE PLAN
1 OF 1	Sheet Number


~ CURVE TABLE ~

NO	RAD	DELTA	ARC	CHBRG	CH
C1	57.50'	297°15'27"	298.32	S 87°49'35" E	59.87'
C2	57.50'	168°15'55"	168.87'	N 27°40'39" E	114.40'
C3	57.50'	128°59'32"	129.45'	S 03°41'37" E	103.79'

NOTE:
THE PURPOSE OF THIS PLAT IS TO CREATE 2 LOTS FROM 1, AND DEDICATE NEW EASEMENTS.

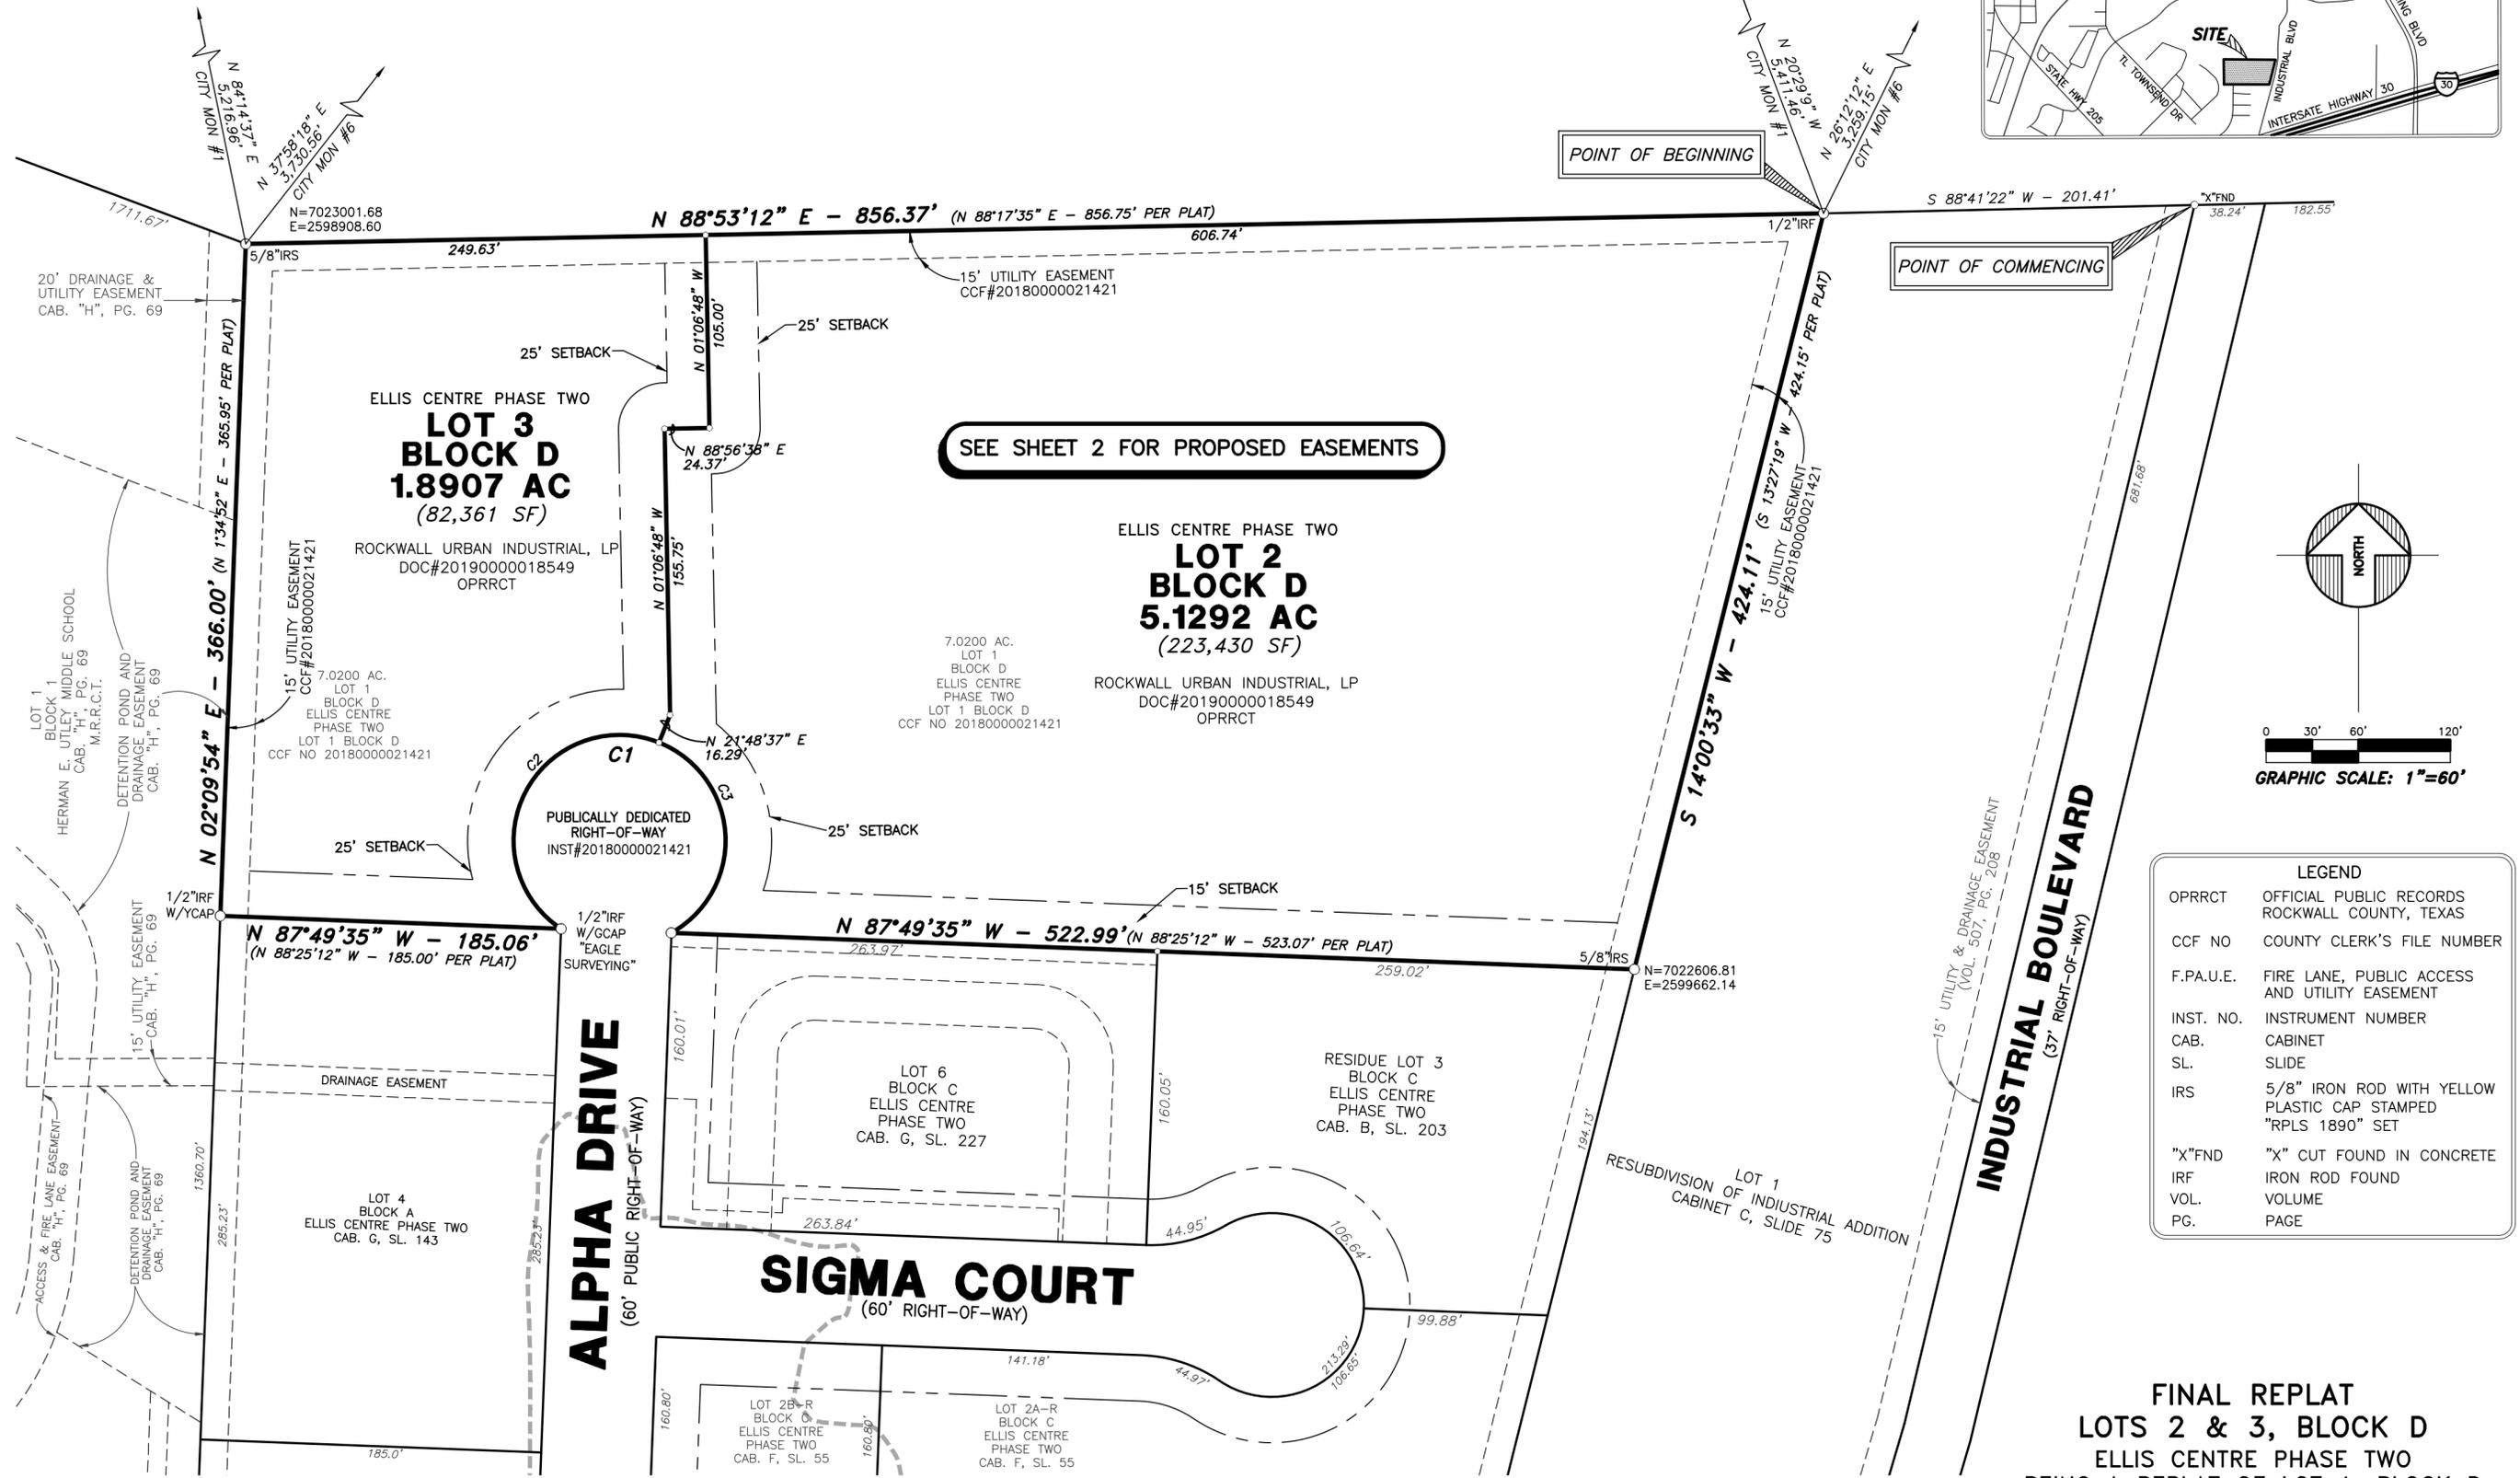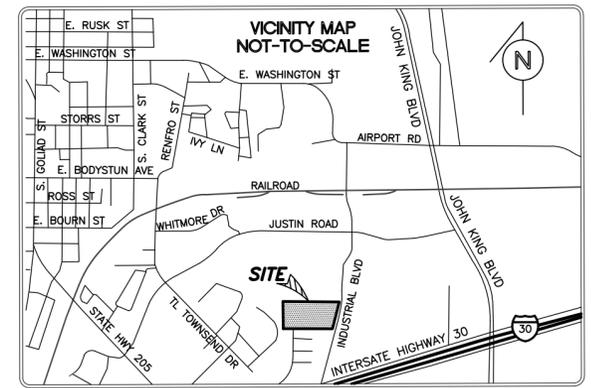

SEE SHEET 2 FOR PROPOSED EASEMENTS

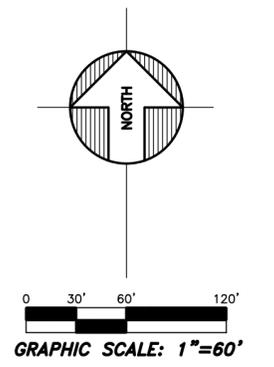



LEGEND

OPRRCT	OFFICIAL PUBLIC RECORDS ROCKWALL COUNTY, TEXAS
CCF NO	COUNTY CLERK'S FILE NUMBER
F.P.A.U.E.	FIRE LANE, PUBLIC ACCESS AND UTILITY EASEMENT
INST. NO.	INSTRUMENT NUMBER
CAB.	CABINET
SL.	SLIDE
IRS	5/8" IRON ROD WITH YELLOW PLASTIC CAP STAMPED "RPLS 1890" SET
"X" FND	"X" CUT FOUND IN CONCRETE
IRF	IRON ROD FOUND
VOL.	VOLUME
PG.	PAGE

FINAL REPLAT
LOTS 2 & 3, BLOCK D
ELLIS CENTRE PHASE TWO
BEING A REPLAT OF LOT 1, BLOCK D
ELLIS CENTRE PHASE TWO ADDITION
BEING A 7.0200-ACRE PARCEL
A. HANNA SURVEY, ABSTRACT 99
CITY OF ROCKWALL, ROCKWALL COUNTY, TEXAS

OWNER
ROCKWALL URBAN INDUSTRIAL, LP
13150 COIT ROAD, SUITE 205
DALLAS, TEXAS 75240

BLUE SKY
SURVEYING & MAPPING CORPORATION
11015 MIDWAY ROAD
DALLAS, TEXAS 75229
PHONE: (214) 358-4500
FAX: (214) 358-4600
DRPETREE@BLUESKYSURVEYING.COM
TBPLS REGISTRATION No. 10105700

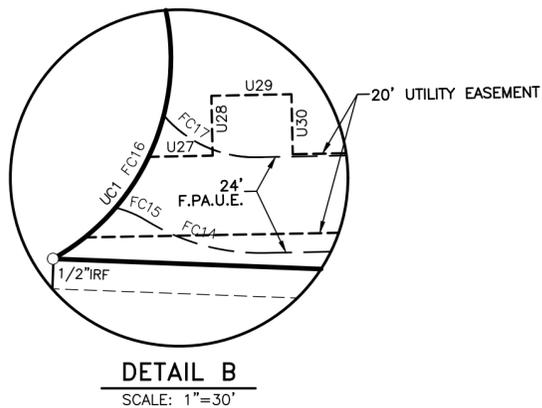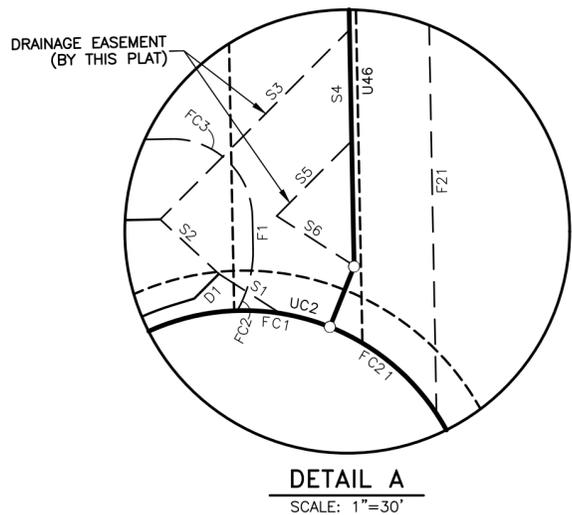


~ F.A.U.E. LINE TABLE ~

NO.	BEARING	DISTANCE
F1	N01°05'14"W	8.98'
F2	S88°53'24"W	96.29'
F3	N01°06'48"W	130.87'
F4	N88°53'12"E	95.00'
F5	S01°06'48"E	30.43'
F6	N88°53'12"E	11.00'
F7	N01°06'48"W	69.64'
F8	N88°58'46"E	24.00'
F9	S01°06'48"E	82.60'
F10	N88°53'12"E	413.59'
F11	N13°58'06"E	24.66'
F12	N01°06'48"W	43.61'
F13	N88°53'12"E	24.00'
F14	S01°06'48"E	45.00'
F15	S14°00'33"W	139.93'
F16	S01°06'48"E	102.84'
F17	S88°53'12"W	434.66'
F18	N88°53'12"E	436.00'
F19	N01°06'48"W	143.00'
F20	S88°53'12"W	435.94'
F21	S01°05'17"E	115.98'
F22	N88°53'12"E	95.00'
F23	S01°06'37"E	128.40'
F24	S88°53'12"W	94.99'
F25	N01°06'47"W	128.43'

~ F.A.U.E. CURVE TABLE ~

NO.	RADIUS	DELTA	ARC	CH. BEARING	CHORD
FC1	57.50'	23°33'06"	23.64'	N79°57'56"W	23.47'
FC2	30.00'	30°47'45"	16.12'	N14°18'35"E	15.93'
FC3	20.00'	86°32'30"	30.21'	N44°21'29"W	27.42'
FC4	44.00'	86°40'58"	66.57'	S47°46'07"E	60.40'
FC5	44.00'	90°00'00"	69.12'	S43°53'12"W	62.23'
FC6	44.00'	90°00'00"	69.12'	N46°06'48"W	62.23'
FC7	20.00'	90°00'00"	31.42'	S46°06'48"E	28.28'
FC8	20.00'	90°00'00"	31.42'	N43°53'12"E	28.28'
FC9	30.00'	90°00'00"	47.12'	S46°06'48"E	42.43'
FC10	30.00'	74°52'39"	39.21'	N51°26'53"E	36.47'
FC11	30.00'	15°04'53"	7.90'	N06°25'39"E	7.87'
FC12	44.00'	15°07'21"	11.61'	N06°26'53"E	11.58'
FC13	54.00'	90°00'00"	84.82'	N43°53'12"E	76.37'
FC14	54.00'	33°05'22"	31.19'	S74°34'07"E	30.76'
FC15	25.00'	18°50'24"	8.22'	N67°26'38"W	8.18'
FC16	57.50'	26°12'23"	26.30'	N27°28'33"E	26.07'
FC17	30.00'	50°32'42"	26.47'	S65°50'27"E	25.62'
FC18	30.00'	90°00'00"	47.12'	N43°53'12"E	42.43'
FC19	30.00'	90°00'00"	47.12'	N46°06'48"W	42.43'
FC20	30.00'	89°58'30"	47.11'	S43°53'58"W	42.42'
FC21	57.50'	34°44'58"	34.87'	N50°48'54"W	34.34'
FC22	20.00'	90°00'00"	31.42'	N46°06'48"W	28.28'
FC23	19.94'	90°10'51"	31.38'	N43°58'48"E	28.24'
FC24	20.00'	90°00'00"	31.42'	S46°06'48"E	28.28'
FC25	19.91'	90°15'55"	31.36'	S44°01'10"W	28.22'

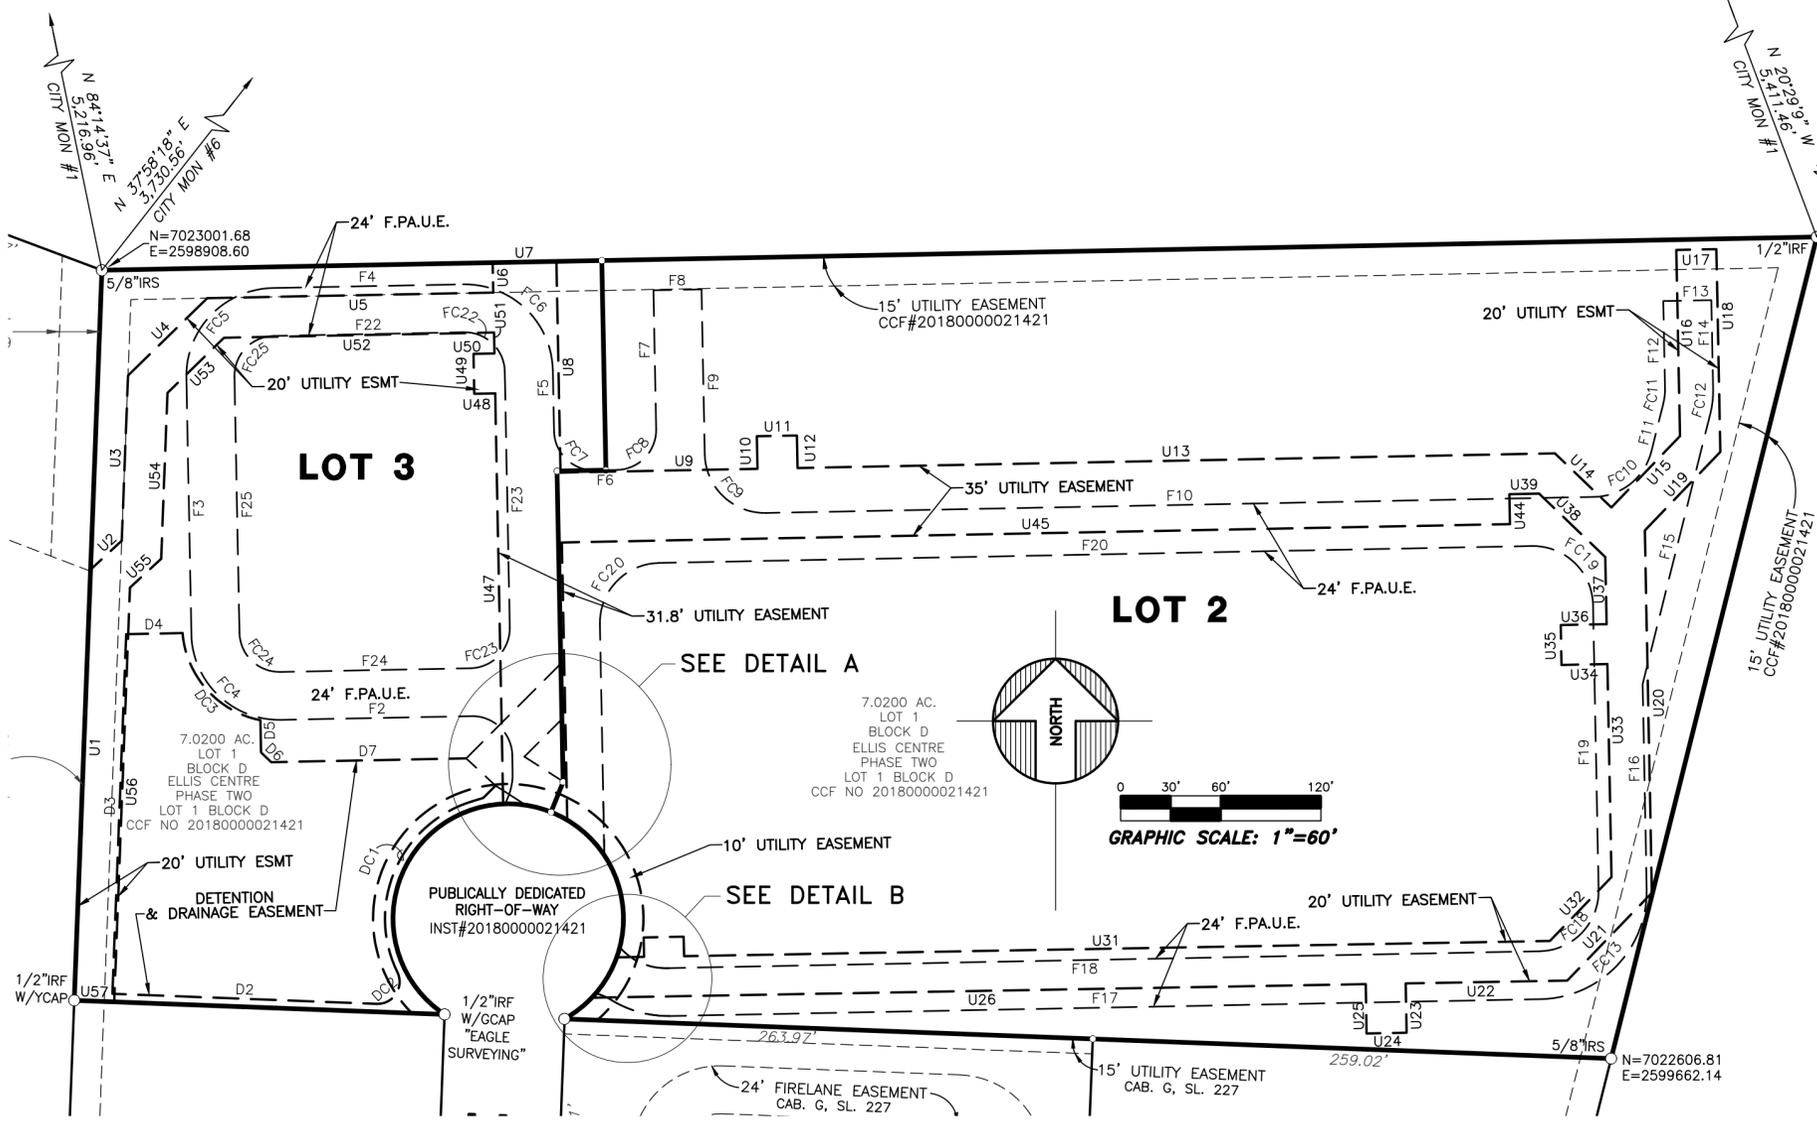

~ UTILITY ESMT CURVE TABLE ~

NO.	RADIUS	DELTA	ARC	CH. BEARING	CHORD
UC1	57.50'	25°50'31"	25.93'	N38°18'17"E	25.71'
UC2	57.50'	33°21'17"	33.47'	N75°49'32"W	33.00'

~ DETENTION ESMT CURVE TABLE ~

NO.	RADIUS	DELTA	ARC	CH. BEARING	CHORD
DC1	61.90'	103°35'16"	111.91'	S26°08'06"W	97.28'
DC2	11.03'	117°36'30"	22.63'	N33°08'43"E	18.86'
DC3	48.50'	74°05'26"	62.72'	S41°42'18"E	58.44'

~ DETENTION ESMT LINE TABLE ~

NO.	BEARING	DISTANCE
D1	S44°50'24"W	8.72'
D2	N87°48'13"W	132.08'
D3	N02°11'18"E	180.24'
D4	N88°53'12"E	28.14'
D5	S01°06'48"E	16.12'
D6	S46°06'48"E	7.07'
D7	N88°53'12"E	96.87'

~ DRAINAGE ESMT LINE TABLE ~

NO.	BEARING	DISTANCE
S1	N57°11'00"W	18.23'
S2	N47°03'10"W	20.01'
S3	N44°50'24"E	67.00'
S4	S01°06'48"E	27.83'
S5	S44°50'24"W	26.55'
S6	S57°11'00"E	23.00'

~ UTILITY ESMT LINE TABLE ~

NO.	BEARING	DISTANCE
U1	N02°09'54"E	215.96'
U2	N47°10'13"E	21.24'
U3	N02°10'13"E	82.81'
U4	N45°35'36"E	55.40'
U5	N88°53'12"E	142.79'
U6	N01°06'48"W	15.00'
U7	N88°53'12"E	31.84'
U8	S01°06'48"E	105.80'
U9	N88°53'12"E	98.36'
U10	N01°06'05"W	16.31'
U11	N88°53'55"E	20.00'
U12	S01°06'05"E	16.30'
U13	N88°53'12"E	378.21'
U14	S46°06'48"E	39.12'
U15	N43°46'26"E	49.50'
U16	N01°06'42"W	93.30'
U17	N88°53'18"E	20.00'
U18	S01°06'42"E	101.56'
U19	S43°46'26"W	54.49'
U20	S01°06'48"E	181.57'
U21	S43°53'12"W	60.99'
U22	S88°59'27"W	80.65'
U23	S01°06'48"E	19.73'
U24	S88°53'12"W	20.00'
U25	N01°06'48"W	19.75'
U26	S88°57'44"W	392.23'
U27	N88°56'53"E	15.95'
U28	N01°09'31"W	14.98'
U29	N88°50'29"E	20.00'
U30	S01°09'31"E	15.02'
U31	N88°56'53"E	427.44'
U32	N43°53'12"E	44.40'
U33	N01°06'48"W	106.72'
U34	S88°53'12"W	22.88'
U35	N01°06'48"W	20.00'
U36	N88°53'12"E	22.88'
U37	N01°06'48"W	33.60'
U38	N46°06'48"W	45.86'
U39	S88°53'12"W	14.84'
U40	S01°06'48"E	15.00'
U41	S88°53'12"W	473.45'
U42	S01°06'48"E	139.13'
U43	N01°06'48"W	205.73'
U44	S88°53'12"W	10.46'
U45	N01°06'48"W	20.00'
U46	N88°53'12"E	10.46'
U47	N01°06'48"W	10.50'
U48	S88°53'12"W	134.85'
U49	S45°35'36"W	39.49'
U50	S02°10'13"W	83.13'
U51	S47°10'13"W	21.24'
U52	S02°09'54"W	207.67'
U53	N87°50'06"W	20.00'

FINAL REPLAT
LOTS 2 & 3, BLOCK D
 ELLIS CENTRE PHASE TWO
 BEING A REPLAT OF LOT 1, BLOCK D
 ELLIS CENTRE PHASE TWO ADDITION
 BEING A 7.0200-ACRE PARCEL
 A. HANNA SURVEY, ABSTRACT 99
 CITY OF ROCKWALL, ROCKWALL COUNTY, TEXAS

BLUE SKY
 SURVEYING & MAPPING
 BLUE SKY SURVEYING & MAPPING CORPORATION
 11015 MIDWAY ROAD
 DALLAS, TEXAS 75229
 PHONE: (214) 358-4500
 FAX: (214) 358-4600
 DRPETREE@BLUESKYSURVEYING.COM
 TBPLS REGISTRATION No. 10105700

OWNER
 ROCKWALL URBAN INDUSTRIAL, LP
 13150 COIT ROAD, SUITE 205
 DALLAS, TEXAS 75240

OWNER'S CERTIFICATE

STATE OF TEXAS
COUNTY OF ROCKWALL

WHEREAS, ROCKWALL URBAN INDUSTRIAL, LP IS THE OWNER OF ALL THAT CERTAIN LOT, TRACT OR PARCEL OF LAND SITUATED IN THE CITY OF ROCKWALL, ROCKWALL COUNTY, TEXAS AND BEING KNOWN AS ALL OF LOT 1, IN BLOCK D, OF ELLIS CENTRE, PHASE TWO, LOT 1, BLOCK D, AN ADDITION TO THE CITY OF ROCKWALL, ROCKWALL COUNTY, TEXAS, ACCORDING TO THE PLAT THEREOF RECORDED IN DOCUMENT NUMBER 20180000021421 OF THE OFFICIAL PUBLIC RECORDS OF ROCKWALL COUNTY, TEXAS, AND BEING THE SAME PROPERTY DESCRIBED IN DEED TO ROCKWALL URBAN INDUSTRIAL, LP UNDER DOCUMENT NUMBER 20190000018549, OFFICIAL PUBLIC RECORDS, ROCKWALL COUNTY, TEXAS, AND BEING MORE PARTICULARLY DESCRIBED BY METES AND BOUNDS AS FOLLOWS:

COMMENCING AT AN "X" FOUND IN CONCRETE FOR CORNER IN THE NORTHWEST RIGHT-OF-WAY LINE OF INDUSTRIAL BOULEVARD (37' RIGHT-OF-WAY), SAID POINT BEING THE NORTHEAST CORNER OF LOT 1 OF RESUBDIVISION OF INDUSTRIAL ADDITION, AN ADDITION TO THE CITY OF ROCKWALL, ROCKWALL COUNTY, TEXAS, ACCORDING TO THE PLAT THEREOF RECORDED IN CABINET C, SLIDE 75 OF THE PLAT RECORDS OF ROCKWALL COUNTY, TEXAS;

THENCE SOUTH 88° 41' 22" WEST LEAVING THE NORTHWEST RIGHT-OF-WAY LINE OF INDUSTRIAL BOULEVARD AND ALONG THE NORTH LINE OF SAID LOT 1 OF RESUBDIVISION OF INDUSTRIAL ADDITION FOR A DISTANCE OF 201.41 FEET TO A 1/2" IRON ROD FOUND FOR THE POINT OF BEGINNING, SAID POINT BEING THE NORTHEAST CORNER OF SAID LOT 1 IN BLOCK D OF ELLIS CENTRE, PHASE TWO, SAID POINT ALSO BEING THE NORTHWEST CORNER OF SAID LOT 1 OF RESUBDIVISION OF INDUSTRIAL ADDITION;

THENCE SOUTH 14° 00' 33" WEST (SOUTH 13° 27' 19" WEST PER PLAT) ALONG THE EAST LINE OF SAID LOT 1 IN BLOCK D OF ELLIS CENTRE, PHASE TWO AND THE WEST LINE OF SAID LOT 1 OF RESUBDIVISION OF INDUSTRIAL ADDITION FOR A DISTANCE OF 424.11 FEET (424.15 FEET PER PLAT) TO A 5/8" IRON ROD SET FOR THE SOUTHEAST CORNER OF SAID LOT 1 IN BLOCK D OF ELLIS CENTRE, PHASE TWO;

THENCE NORTH 87° 49' 35" WEST (NORTH 88° 25' 12" WEST PER PLAT) LEAVING THE WEST LINE OF SAID LOT 1 OF RESUBDIVISION OF INDUSTRIAL ADDITION AND ALONG THE SOUTH LINE OF SAID LOT 1 IN BLOCK D OF ELLIS CENTRE, PHASE TWO, AND PASSING AT A DISTANCE OF 259.02 FEET THE NORTHEAST CORNER OF LOT 6 IN BLOCK C OF ELLIS CENTRE, PHASE TWO, AN ADDITION TO THE CITY OF ROCKWALL, ROCKWALL COUNTY, TEXAS ACCORDING TO THE PLAT THEREOF RECORDED IN CABINET "G", SLIDE 227 OF THE PLAT RECORDS OF ROCKWALL COUNTY, TEXAS; AND CONTINUING ALONG THE SOUTH LINE OF SAID LOT 1 IN BLOCK D OF ELLIS CENTRE, PHASE TWO AND THE NORTH LINE OF SAID LOT 6 IN BLOCK C OF ELLIS CENTRE, PHASE TWO, FOR A DISTANCE OF 522.99 FEET (523.07 FEET PER PLAT) TO A 1/2" IRON ROD FOUND FOR THE NORTHWEST CORNER OF SAID LOT 6 IN BLOCK C OF ELLIS CENTRE, PHASE TWO, SAID POINT BEING IN THE EAST RIGHT-OF-WAY LINE OF ALPHA DRIVE (60' RIGHT-OF-WAY), SAID POINT BEING THE BEGINNING OF A CURVE TO THE LEFT HAVING A RADIUS OF 57.50 FEET WITH A CENTRAL ANGLE OF 297° 15' 27" AND A CHORD BEARING SOUTH 87° 49' 35" EAST AT A DISTANCE OF 59.87 FEET;

THENCE NORTHWESTERLY AND FOLLOWING ALONG SAID CURVE TO THE LEFT AND THE RIGHT-OF-WAY LINE OF SAID ALPHA DRIVE FOR AN ARC DISTANCE OF 298.32 FEET TO A 1/2" IRON ROD WITH GCAP MARKED "EAGLE SURVEYING" FOUND FOR CORNER, SAID POINT BEING IN THE WEST RIGHT-OF-WAY LINE OF SAID ALPHA DRIVE AND ALSO BEING THE NORTHEAST CORNER OF LOT 4 IN BLOCK A OF ELLIS CENTRE, PHASE TWO, AN ADDITION TO THE CITY OF ROCKWALL, ROCKWALL COUNTY, TEXAS ACCORDING TO THE PLAT THEREOF RECORDED IN CABINET "G", SLIDE 143 OF THE MAP RECORDS OF ROCKWALL COUNTY, TEXAS;

THENCE NORTH 87° 49' 35" WEST (NORTH 88° 25' 12" WEST PER PLAT) AND LEAVING THE WEST LINE OF SAID ALPHA DRIVE AND FOLLOWING ALONG THE SOUTH LINE OF SAID LOT 1 IN BLOCK D OF ELLIS CENTRE, PHASE TWO AND THE NORTH LINE OF SAID LOT 4 IN BLOCK A OF ELLIS CENTRE, PHASE TWO, FOR A DISTANCE OF 185.06 FEET (185.00 FEET) TO A 1/2" IRON ROD WITH YELLOW CAP FOUND FOR CORNER IN THE EAST LINE OF LOT 1 IN BLOCK 1 OF HERMAN E. UTLEY MIDDLE SCHOOL, AN ADDITION TO THE CITY OF ROCKWALL, ROCKWALL COUNTY, TEXAS ACCORDING TO THE PLAT THEREOF RECORDED IN CABINET "H", PAGE 69 OF THE MAP RECORDS OF ROCKWALL COUNTY, TEXAS, SAID POINT BEING THE SOUTHWEST CORNER OF SAID LOT 1 IN BLOCK D OF ELLIS CENTRE, PHASE TWO AND THE NORTHWEST CORNER OF SAID LOT 4 IN BLOCK A OF ELLIS CENTRE, PHASE TWO;

THENCE NORTH 02° 09' 54" EAST (NORTH 1° 34' 52" EAST PER PLAT) AND DEPARTING THE NORTH LINE OF SAID LOT 4 IN BLOCK A OF ELLIS CENTRE, PHASE TWO, AND FOLLOWING ALONG THE WEST LINE OF SAID LOT 1 IN BLOCK D OF ELLIS CENTRE, PHASE TWO AND THE EAST LINE OF SAID LOT 1 IN BLOCK 1 OF HERMAN E. UTLEY MIDDLE SCHOOL FOR A DISTANCE OF 366.00 FEET (365.95 FEET PER PLAT) TO A 5/8" IRON ROD SET FOR CORNER, SAID POINT BEING THE NORTHWEST CORNER OF SAID LOT 1 IN BLOCK D OF ELLIS CENTRE, PHASE TWO AND THE NORTHEAST CORNER OF LOT 1 IN BLOCK 1 OF HERMAN E. UTLEY MIDDLE SCHOOL ADDITION;

THENCE NORTH 88° 53' 12" EAST (NORTH 88° 17' 35" EAST PER PLAT) ALONG THE NORTH LINE OF SAID LOT 1 IN BLOCK D OF ELLIS CENTRE, PHASE TWO FOR A DISTANCE OF 856.37 FEET (856.75 FEET PER PLAT) TO THE POINT OF BEGINNING AND CONTAINING 7.0200 ACRES OF LAND, MORE OR LESS.

BASIS OF BEARINGS = STATE PLANE COORDINATE (4202 TEXAS NORTH CENTRAL ZONE) REFERENCE FRAME NORTH AMERICAN DATUM (NAD) 83(2011)

NOW, THEREFORE, KNOW ALL MEN BY THESE PRESENTS:

STATE OF TEXAS
COUNTY OF ROCKWALL

WE, THE UNDERSIGNED OWNERS OF THE LAND SHOWN ON THIS PLAT, AND DESIGNATED HEREIN AS LOTS 2 & 3, BLOCK D, ELLIS CENTRE PHASE TWO ADDITION, A SUBDIVISION TO THE CITY OF ROCKWALL, TEXAS, AND WHOSE NAME IS SUBSCRIBED HERETO, HEREBY DEDICATE TO THE USE OF THE PUBLIC FOREVER ALL STREETS, ALLEYS, PARKS, WATER COURSES, DRAINS, EASEMENTS AND PUBLIC PLACES THEREON SHOWN ON THE PURPOSE AND CONSIDERATION THEREIN EXPRESSED. WE FURTHER CERTIFY THAT ALL OTHER PARTIES WHO HAVE A MORTGAGE OR LIEN INTEREST IN ELLIS CENTRE PHASE TWO ADDITION HAVE BEEN NOTIFIED AND SIGNED THIS PLAT.

WE UNDERSTAND AND DO HEREBY RESERVE THE EASEMENT STRIPS SHOWN ON THIS PLAT FOR THE PURPOSES STATED AND FOR THE MUTUAL USE AND ACCOMMODATION OF ALL UTILITIES DESIRING TO USE OR USING SAME. WE ALSO UNDERSTAND THE FOLLOWING;

(1) NO BUILDINGS SHALL BE CONSTRUCTED OR PLACED UPON, OVER, OR ACROSS THE UTILITY EASEMENTS AS DESCRIBED HEREIN.

(2) ANY PUBLIC UTILITY SHALL HAVE THE RIGHT TO REMOVE AND KEEP REMOVED ALL OR PART OF ANY BUILDINGS, FENCES, TREES, SHRUBS, OR OTHER GROWTHS OR IMPROVEMENTS WHICH IN ANY WAY ENDANGER OR INTERFERE WITH CONSTRUCTION, MAINTENANCE OR EFFICIENCY OF THEIR RESPECTIVE SYSTEM ON ANY OF THESE EASEMENT STRIPS; AND ANY PUBLIC UTILITY SHALL AT ALL TIMES HAVE THE RIGHT OF INGRESS OR EGRESS TO, FROM AND UPON THE SAID EASEMENT STRIPS FOR PURPOSE OF CONSTRUCTION, RECONSTRUCTION, INSPECTING, PATROLLING, MAINTAINING, AND EITHER ADDING TO OR REMOVING ALL OR PART OF THEIR RESPECTIVE SYSTEM WITHOUT THE NECESSITY OF, AT ANY TIME, PROCURING THE PERMISSION OF ANYONE.

(3) THE CITY OF ROCKWALL WILL NOT BE RESPONSIBLE FOR ANY CLAIMS OF ANY NATURE RESULTING FROM OR OCCASIONED BY THE ESTABLISHMENT OF GRADE OF STREETS IN THE SUBDIVISION.

(4) THE DEVELOPER AND SUBDIVISION ENGINEER SHALL BEAR TOTAL RESPONSIBILITY FOR STORM DRAIN IMPROVEMENTS.

(5) THE DEVELOPER SHALL BE RESPONSIBLE FOR THE NECESSARY FACILITIES TO PROVIDE DRAINAGE PATTERNS AND DRAINAGE CONTROLS SUCH THAT PROPERTIES WITHIN THE DRAINAGE AREA ARE NOT ADVERSELY AFFECTED BY STORM DRAINAGE FROM THE DEVELOPMENT.

(6) NO HOUSE DWELLING UNIT, OR OTHER STRUCTURE SHALL BE CONSTRUCTED ON ANY LOT IN THIS ADDITION BY THE OWNER OR ANY OTHER PERSON UNTIL THE DEVELOPER AND/OR OWNER HAS COMPLIED WITH ALL REQUIREMENTS OF THE SUBDIVISION REGULATIONS OF THE CITY OF ROCKWALL REGARDING IMPROVEMENTS WITH RESPECT TO THE ENTIRE BLOCK ON THE STREET OR STREETS ON WHICH PROPERTY ABUTS, INCLUDING THE ACTUAL INSTALLATION OF STREETS WITH THE REQUIRED BASE AND PAVING, CURB AND GUTTER, WATER AND SEWER, DRAINAGE STRUCTURES, STORM STRUCTURES, STORM SEWERS, AND ALLEYS, ALL ACCORDING TO THE SPECIFICATIONS OF THE CITY OF ROCKWALL; OR

(7) THE PROPERTY OWNER SHALL BE RESPONSIBLE FOR ALL MAINTENANCE, REPAIRS, AND RECONSTRUCTION OF DRAINAGE AND DETENTION EASEMENTS ON SITE.

UNTIL AN ESCROW DEPOSIT, SUFFICIENT TO PAY FOR THE COST OF SUCH IMPROVEMENTS, AS DETERMINED BY THE CITY'S ENGINEER AND/OR CITY ADMINISTRATOR, COMPUTED ON A PRIVATE COMMERCIAL RATE BASIS, HAS BEEN MADE WITH THE CITY SECRETARY, ACCOMPANIED BY AN AGREEMENT SIGNED BY THE DEVELOPER AND/OR OWNER, AUTHORIZING THE CITY TO MAKE SUCH IMPROVEMENTS AT PREVAILING PRIVATE COMMERCIAL RATES, OR HAVE THE SAME MADE BY A CONTRACTOR AND PAY FOR THE SAME OUT OF THE ESCROW DEPOSIT, SHOULD THE DEVELOPER AND/OR OWNER FAIL OR REFUSE TO INSTALL THE REQUIRED IMPROVEMENTS WITHIN THE TIME STATED IN SUCH WRITTEN AGREEMENT, BUT IN NO CASE SHALL THE CITY BE OBLIGATED TO MAKE SUCH IMPROVEMENTS ITSELF. SUCH DEPOSIT MAY BE USED BY THE OWNER AND/OR DEVELOPER AS PROGRESS PAYMENTS AS THE WORK PROGRESSES IN MAKING SUCH IMPROVEMENTS BY MAKING CERTIFIED REQUISITIONS TO THE CITY SECRETARY, SUPPORTED BY EVIDENCE OF WORK DONE; OR

UNTIL THE DEVELOPER AND/OR OWNER FILES A CORPORATE SURETY BOND WITH THE CITY SECRETARY IN A SUM EQUAL TO THE COST OF SUCH IMPROVEMENTS FOR THE DESIGNATED AREA, GUARANTEEING THE INSTALLATION THEREOF WITHIN THE TIME STATED IN THE BOND, WHICH TIME SHALL BE FIXED BY THE CITY COUNCIL OF THE CITY OF ROCKWALL.

WE FURTHER ACKNOWLEDGE THAT THE DEDICATIONS AND/OR EXACTION'S MADE HEREIN ARE PROPORTIONAL TO THE IMPACT OF THE SUBDIVISION UPON THE PUBLIC SERVICES REQUIRED IN ORDER THAT THE DEVELOPMENT WILL COMPORT WITH THE PRESENT AND FUTURE GROWTH NEEDS OF THE CITY; WE, OUR SUCCESSORS AND ASSIGNS HEREBY WAIVE ANY CLAIM, DAMAGE, OR CAUSE OF ACTION THAT WE MAY HAVE AS A RESULT OF THE DEDICATION OF EXACTIONS MADE HEREIN.

NOTE: IT SHALL BE THE POLICY OF THE CITY OF ROCKWALL TO WITHHOLD ISSUING BUILDING PERMITS UNTIL ALL STREETS, WATER, SEWER AND STORM DRAINAGE SYSTEMS HAVE BEEN ACCEPTED BY THE CITY. THE APPROVAL OF A PLAT BY THE CITY DOES NOT CONSTITUTE ANY REPRESENTATION, ASSURANCE OR GUARANTEE THAT ANY BUILDING WITHIN SUCH PLAT SHALL BE APPROVED, AUTHORIZED OR PERMIT THEREFORE ISSUED, NOR SHALL SUCH APPROVAL CONSTITUTE ANY REPRESENTATION, ASSURANCE OR GUARANTEE BY THE CITY OF THE ADEQUACY AND AVAILABILITY FOR WATER FOR PERSONAL USE AND FIRE PROTECTION WITHIN SUCH PLAT, AS REQUIRED UNDER ORDINANCE 83-54.

THIS PLAT APPROVED SUBJECT TO ALL PLATTING ORDINANCES, RULES, REGULATIONS, AND RESOLUTIONS OF THE CITY OF ROCKWALL.

WITNESS, MY HAND AT DALLAS, TEXAS, THIS THE _____ DAY OF _____, 2020.

ELLIS CENTRE PHASE TWO ADDITION

BY: _____
(NAME / TITLE)

STATE OF TEXAS
COUNTY OF ROCKWALL

BEFORE ME, THE UNDERSIGNED AUTHORITY, ON THIS DAY PERSONALLY APPEARED _____ KNOWN TO ME TO BE THE PERSON WHOSE NAME IS SUBSCRIBED TO THE FOREGOING INSTRUMENT, AND ACKNOWLEDGED TO ME THAT HE EXECUTED THE SAME FOR THE PURPOSE AND CONSIDERATION THEREIN STATED.

GIVEN UPON MY HAND AND SEAL OF OFFICE THIS _____ DAY OF _____, 2020.

NOTARY PUBLIC IN AND FOR THE STATE OF TEXAS
MY COMMISSION EXPIRES:

SURVEYOR'S CERTIFICATE

NOW, THEREFORE KNOW ALL MEN BY THESE PRESENTS: THAT I, DAVID PETREE, DO HEREBY CERTIFY THAT I PREPARED THIS PLAT FROM AN ACTUAL AND ACCURATE SURVEY OF THE LAND, AND THAT THE CORNER MONUMENTS SHOWN THEREON WERE PROPERLY PLACED UNDER MY PERSONAL SUPERVISION.

DAVID PETREE
REGISTERED PROFESSIONAL
LAND SURVEYOR NO. 1890

RECOMMENDED FOR FINAL APPROVAL

PLANNING AND ZONING COMMISSION

PLANNING & ZONING

APPROVED

I HEREBY CERTIFY THAT THE ABOVE AND FOREGOING PLAT OF AN ADDITION TO THE CITY OF ROCKWALL, TEXAS, WAS APPROVED BY THE CITY COUNCIL OF THE CITY OF ROCKWALL ON THE _____ DAY OF _____, 2020.

THIS APPROVAL SHALL BE INVALID UNLESS THE APPROVED PLAT FOR SUCH ADDITION IS RECORDED IN THE OFFICE OF THE COUNTY CLERK OF ROCKWALL, COUNTY, TEXAS, WITHIN ONE HUNDRED EIGHTY (180) DAYS FROM SAID DATE OF FINAL APPROVAL.

WITNESS OUR HANDS, THIS _____ DAY OF _____, 2020.

MAYOR, CITY OF ROCKWALL

CITY SECRETARY

CITY ENGINEER



BLUE SKY SURVEYING
& MAPPING, CORPORATION
11015 MIDWAY ROAD
DALLAS, TEXAS 75229
PHONE: (214) 358-4500
FAX: (214) 358-4600
DRPETREE@BLUESKYSURVEYING.COM
TBPLS REGISTRATION No. 10105700

OWNER
ROCKWALL URBAN INDUSTRIAL, LP
13150 COIT ROAD, SUITE 205
DALLAS, TEXAS 75240

NOTE:


THE PURPOSE OF THIS PLAT IS TO ABANDON EXISTING AND DEDICATE NEW EASEMENTS.

FINAL REPLAT
LOTS 2 & 3, BLOCK D
ELLIS CENTRE PHASE TWO
BEING A REPLAT OF LOT 1, BLOCK D
ELLIS CENTRE PHASE TWO ADDITION
BEING A 7.0200-ACRE PARCEL
A. HANNA SURVEY, ABSTRACT 99
CITY OF ROCKWALL, ROCKWALL COUNTY, TEXAS

AUGUST 18, 2020

CASE NO. P2020-018

SHEET 3 OF 3

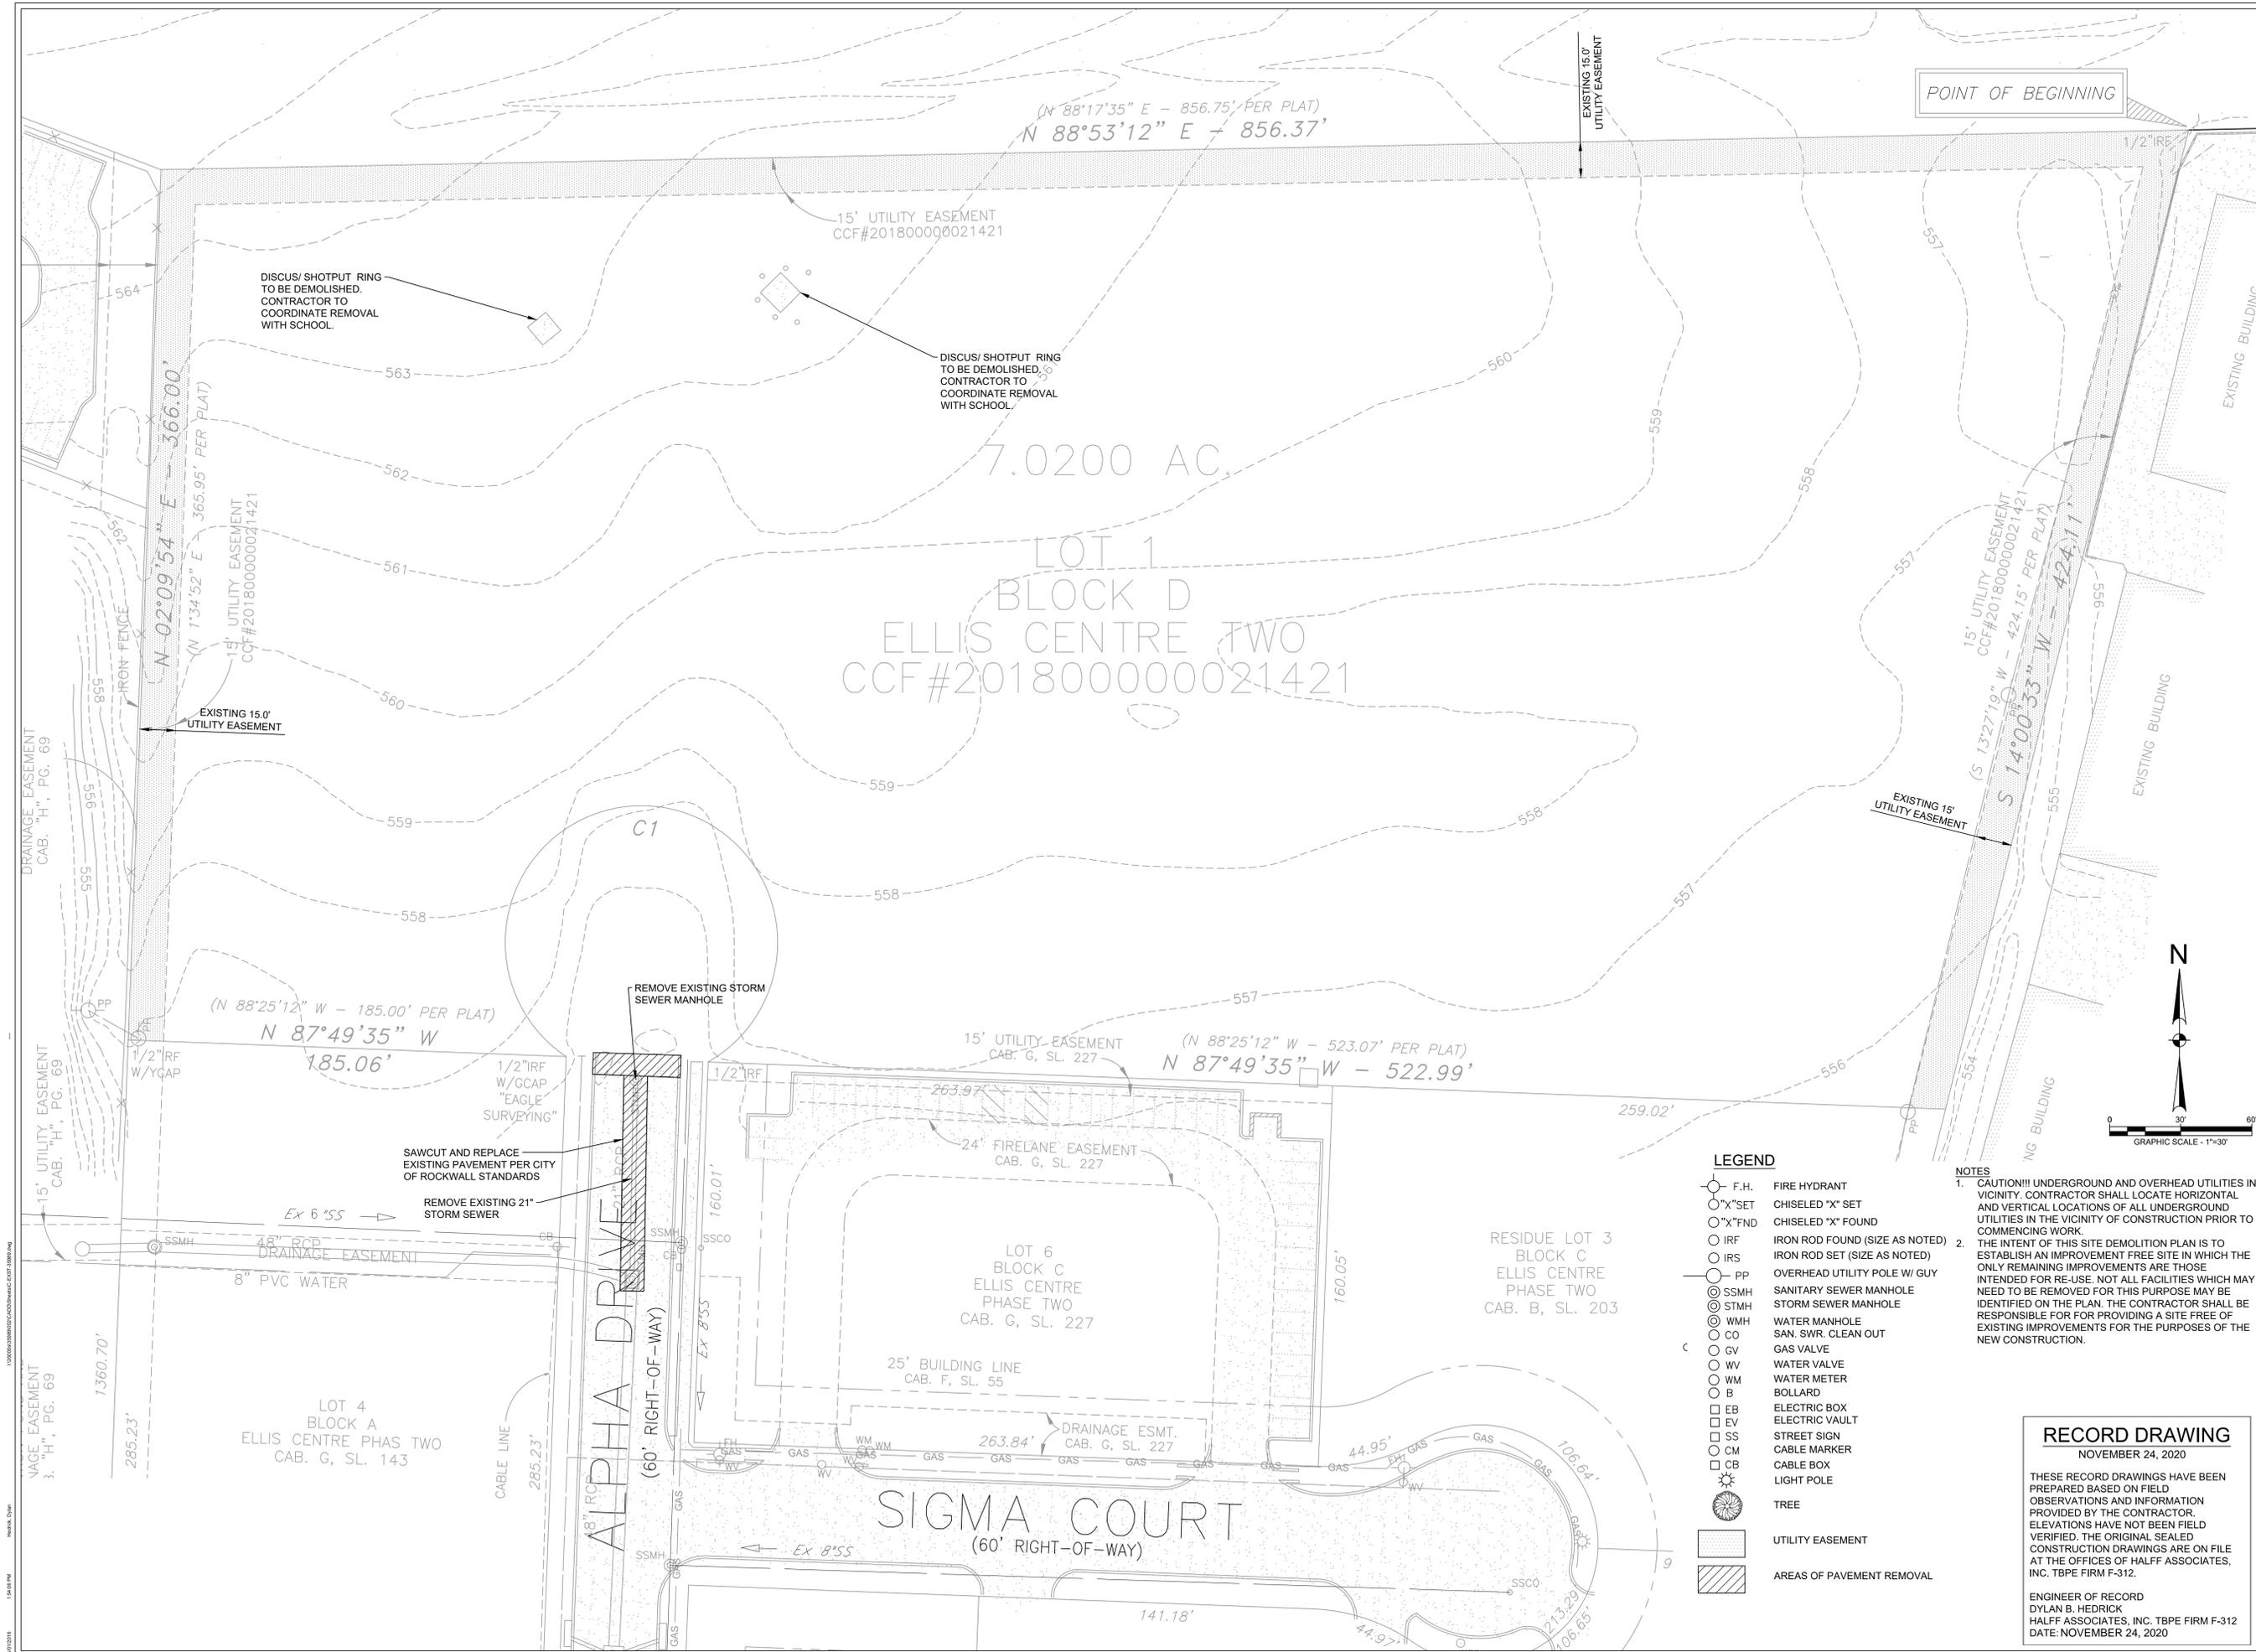

POINT OF BEGINNING

(N 88°17'35" E - 856.75' PER PLAT)
N 88°53'12" E - 856.37'

7.0200 AC
LOT 1
BLOCK D
ELLIS CENTRE TWO
CCF#201800000021421

DISCUS/ SHOTPUT RING
TO BE DEMOLISHED.
CONTRACTOR TO
COORDINATE REMOVAL
WITH SCHOOL.

DISCUS/ SHOTPUT RING
TO BE DEMOLISHED.
CONTRACTOR TO
COORDINATE REMOVAL
WITH SCHOOL.

EXISTING 15.0'
UTILITY EASEMENT

(N 88°25'12" W - 185.00' PER PLAT)
N 87°49'35" W
185.06'

(N 88°25'12" W - 523.07' PER PLAT)
N 87°49'35" W - 522.99'

SAWCUT AND REPLACE
EXISTING PAVEMENT PER CITY
OF ROCKWALL STANDARDS

REMOVE EXISTING 21"
STORM SEWER

REMOVE EXISTING STORM
SEWER MANHOLE

15' UTILITY EASEMENT
CAB. G, SL. 227

24' FIRELANE EASEMENT
CAB. G, SL. 227

LOT 6
BLOCK C
ELLIS CENTRE
PHASE TWO
CAB. G, SL. 227

RESIDUE LOT 3
BLOCK C
ELLIS CENTRE
PHASE TWO
CAB. B, SL. 203

LOT 4
BLOCK A
ELLIS CENTRE PHAS TWO
CAB. G, SL. 143

SIGMA COURT
(60' RIGHT-OF-WAY)

LEGEND

- F.H. FIRE HYDRANT
- CHISELED "X" SET
- CHISELED "X" FOUND
- IRF IRON ROD FOUND (SIZE AS NOTED)
- IRS IRON ROD SET (SIZE AS NOTED)
- PP OVERHEAD UTILITY POLE W/ GUY
- SSMH SANITARY SEWER MANHOLE
- STMH STORM SEWER MANHOLE
- WMH WATER MANHOLE
- CO SAN. SWR. CLEAN OUT
- GV GAS VALVE
- WV WATER VALVE
- WM WATER METER
- B BOLLARD
- EB ELECTRIC BOX
- EV ELECTRIC VAULT
- SS STREET SIGN
- CM CABLE MARKER
- CB CABLE BOX
- LP LIGHT POLE
- TREE
- UTILITY EASEMENT
- AREAS OF PAVEMENT REMOVAL

NOTES


1. CAUTION!!! UNDERGROUND AND OVERHEAD UTILITIES IN VICINITY. CONTRACTOR SHALL LOCATE HORIZONTAL AND VERTICAL LOCATIONS OF ALL UNDERGROUND UTILITIES IN THE VICINITY OF CONSTRUCTION PRIOR TO COMMENCING WORK.
2. THE INTENT OF THIS SITE DEMOLITION PLAN IS TO ESTABLISH AN IMPROVEMENT FREE SITE IN WHICH THE ONLY REMAINING IMPROVEMENTS ARE THOSE INTENDED FOR RE-USE. NOT ALL FACILITIES WHICH MAY NEED TO BE REMOVED FOR THIS PURPOSE MAY BE IDENTIFIED ON THE PLAN. THE CONTRACTOR SHALL BE RESPONSIBLE FOR PROVIDING A SITE FREE OF EXISTING IMPROVEMENTS FOR THE PURPOSES OF THE NEW CONSTRUCTION.

RECORD DRAWING

NOVEMBER 24, 2020

THESE RECORD DRAWINGS HAVE BEEN PREPARED BASED ON FIELD OBSERVATIONS AND INFORMATION PROVIDED BY THE CONTRACTOR. ELEVATIONS HAVE NOT BEEN FIELD VERIFIED. THE ORIGINAL SEALED CONSTRUCTION DRAWINGS ARE ON FILE AT THE OFFICES OF HALFF ASSOCIATES, INC. TBPE FIRM F-312.

ENGINEER OF RECORD
DYLAN B. HEDRICK
HALFF ASSOCIATES, INC. TBPE FIRM F-312
DATE: NOVEMBER 24, 2020

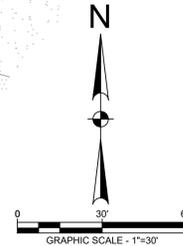

ROCKWALL URBAN + INDUSTRIAL CENTER
END OF ALPHA DRIVE
ROCKWALL, TX 75087


HALFF
1201 NORTH BOWSER ROAD
RICHARDSON, TX 75081-2275
(214) 346-6200

Revision No.	Date	Description


Project No.: 38050
Issued: NOVEMBER 2020
Drawn By: REP
Checked By: DBH
Scale: AS SHOWN
Sheet Title

DEMOLITION PLAN


C0.02
Sheet Number

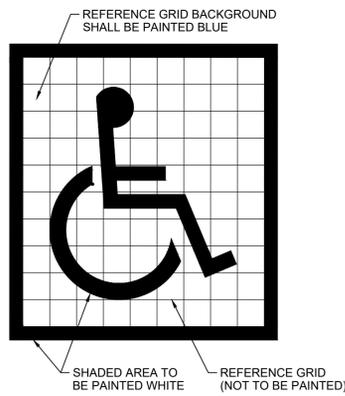


01 H.C. PARKING SYMBOL
N.T.S.

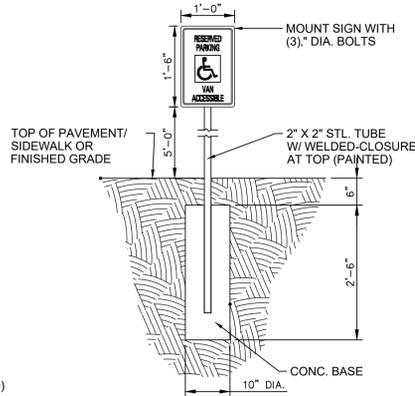


02 H.C. PARKING SIGN
N.T.S.

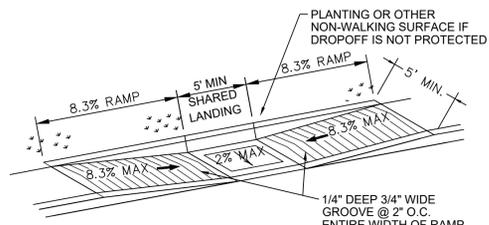


03 PARALLEL CURB RAMP W/CURB
N.T.S.

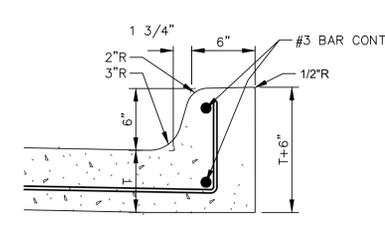


04 INTEGRAL CURB DETAIL
N.T.S.

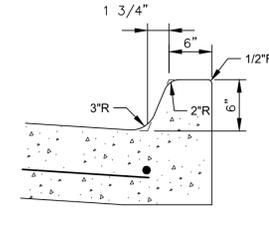


05 MONOLITHIC CURB
N.T.S.

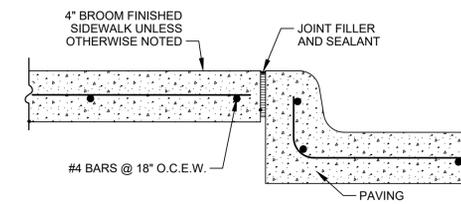


06 TYPICAL CURB JOINT (PRIVATE)
N.T.S.

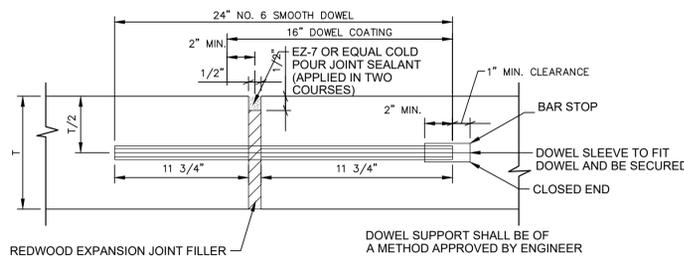


07 EXPANSION JOINT
N.T.S.

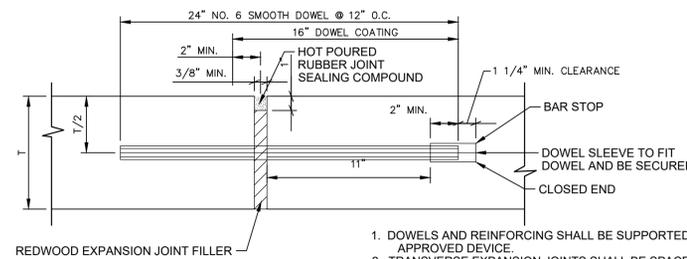


08 TRANSVERSE EXPANSION JOINT
N.T.S.

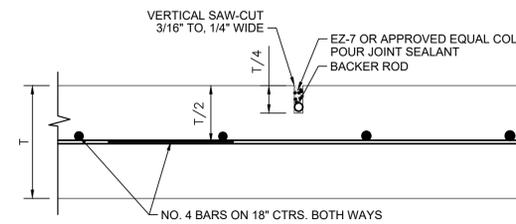

09 SAWED DUMMY JOINT
N.T.S.

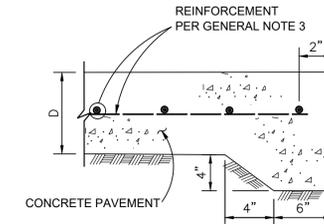


10 STANDARD CONCRETE PAVING HEADER
N.T.S.

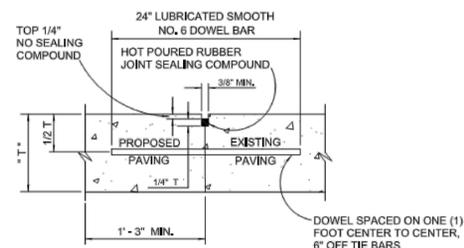


NOTES: T = PAVEMENT

- LONGITUDINAL BUTT CONSTRUCTION MAY BE UTILIZED IN PLACE OF LONGITUDINAL HINGED (KEYWAY) JOINT AT CONTRACTORS OPTION.
- DOWEL BARS SHALL BE DRILLED INTO PAVEMENT HORIZONTALLY BY USE OF A MECHANICAL RIG.
- DRILLING BY HAND IS NOT ACCEPTABLE. PUSHING DOWEL BARS INTO GREEN CONCRETE NOT ACCEPTABLE.


LONGITUDINAL BUTT JOINT
NOT TO SCALE

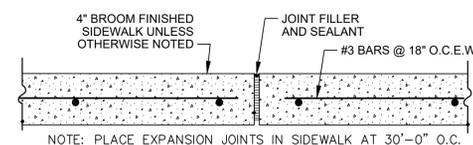


11 SIDEWALK EXPANSION JOINT
N.T.S.

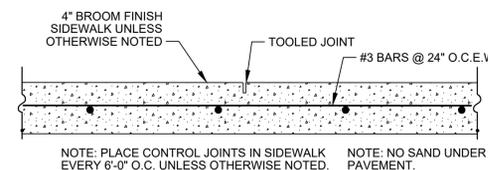


12 SIDEWALK CONTROL JOINT
N.T.S.

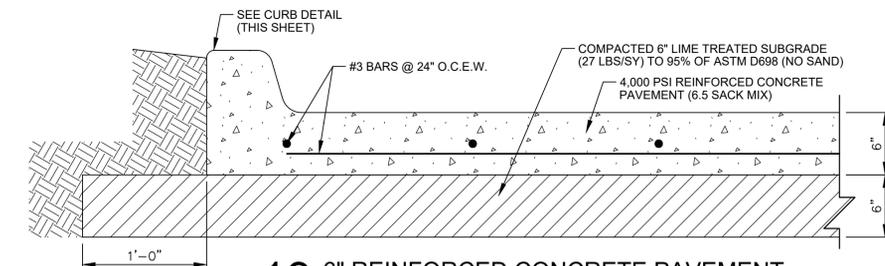

13 6" REINFORCED CONCRETE PAVEMENT
N.T.S.

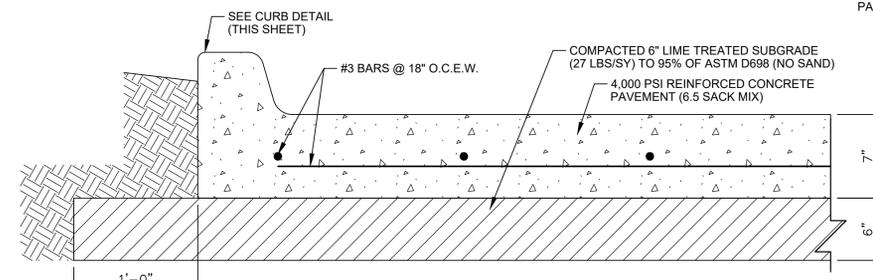

14 7" REINFORCED CONCRETE PAVEMENT
N.T.S.

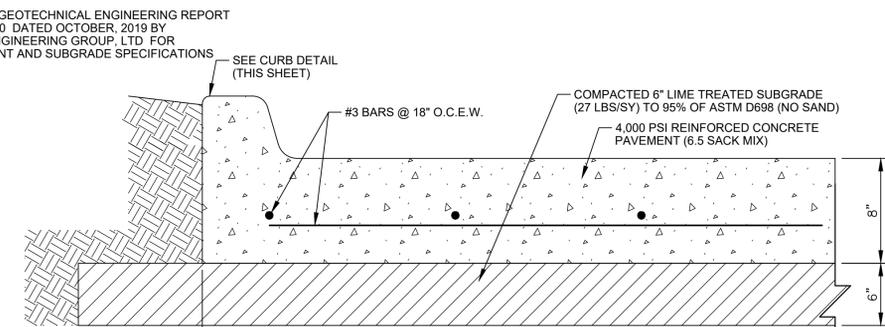

15 8" REINFORCED CONCRETE PAVEMENT
N.T.S.

RECORD DRAWING
NOVEMBER 24, 2020

THESE RECORD DRAWINGS HAVE BEEN PREPARED BASED ON FIELD OBSERVATIONS AND INFORMATION PROVIDED BY THE CONTRACTOR. ELEVATIONS HAVE NOT BEEN FIELD VERIFIED. THE ORIGINAL SEALED CONSTRUCTION DRAWINGS ARE ON FILE AT THE OFFICES OF HALFF ASSOCIATES, INC. TBPE FIRM F-312.

ENGINEER OF RECORD
DYLAN B. HEDRICK
HALFF ASSOCIATES, INC. TBPE FIRM F-312
DATE: NOVEMBER 24, 2020

Project No.:	38050
Issued:	NOVEMBER 2020
Drawn By:	REP
Checked By:	DBH
Scale:	AS SHOWN
Sheet Title	PAVING DETAILS
Sheet Number	C1.02


ROCKWALL URBAN + INDUSTRIAL CENTER
END OF ALPHA DRIVE
ROCKWALL, TX 75087

HALFF
1201 NORTH BOWSER ROAD
RICHARDSON, TX 75081-2275
(214) 346-6200

Revision No.	Date	Description

15048 FM - HEDRICK.DWG - 11/24/2020 10:00 AM

REINFORCED CONCRETE PAVEMENT	CITY OF ROCKWALL
LONGITUDINAL BUTT JOINT	DATE: OCT. '17 DRAWING NO: R-2051

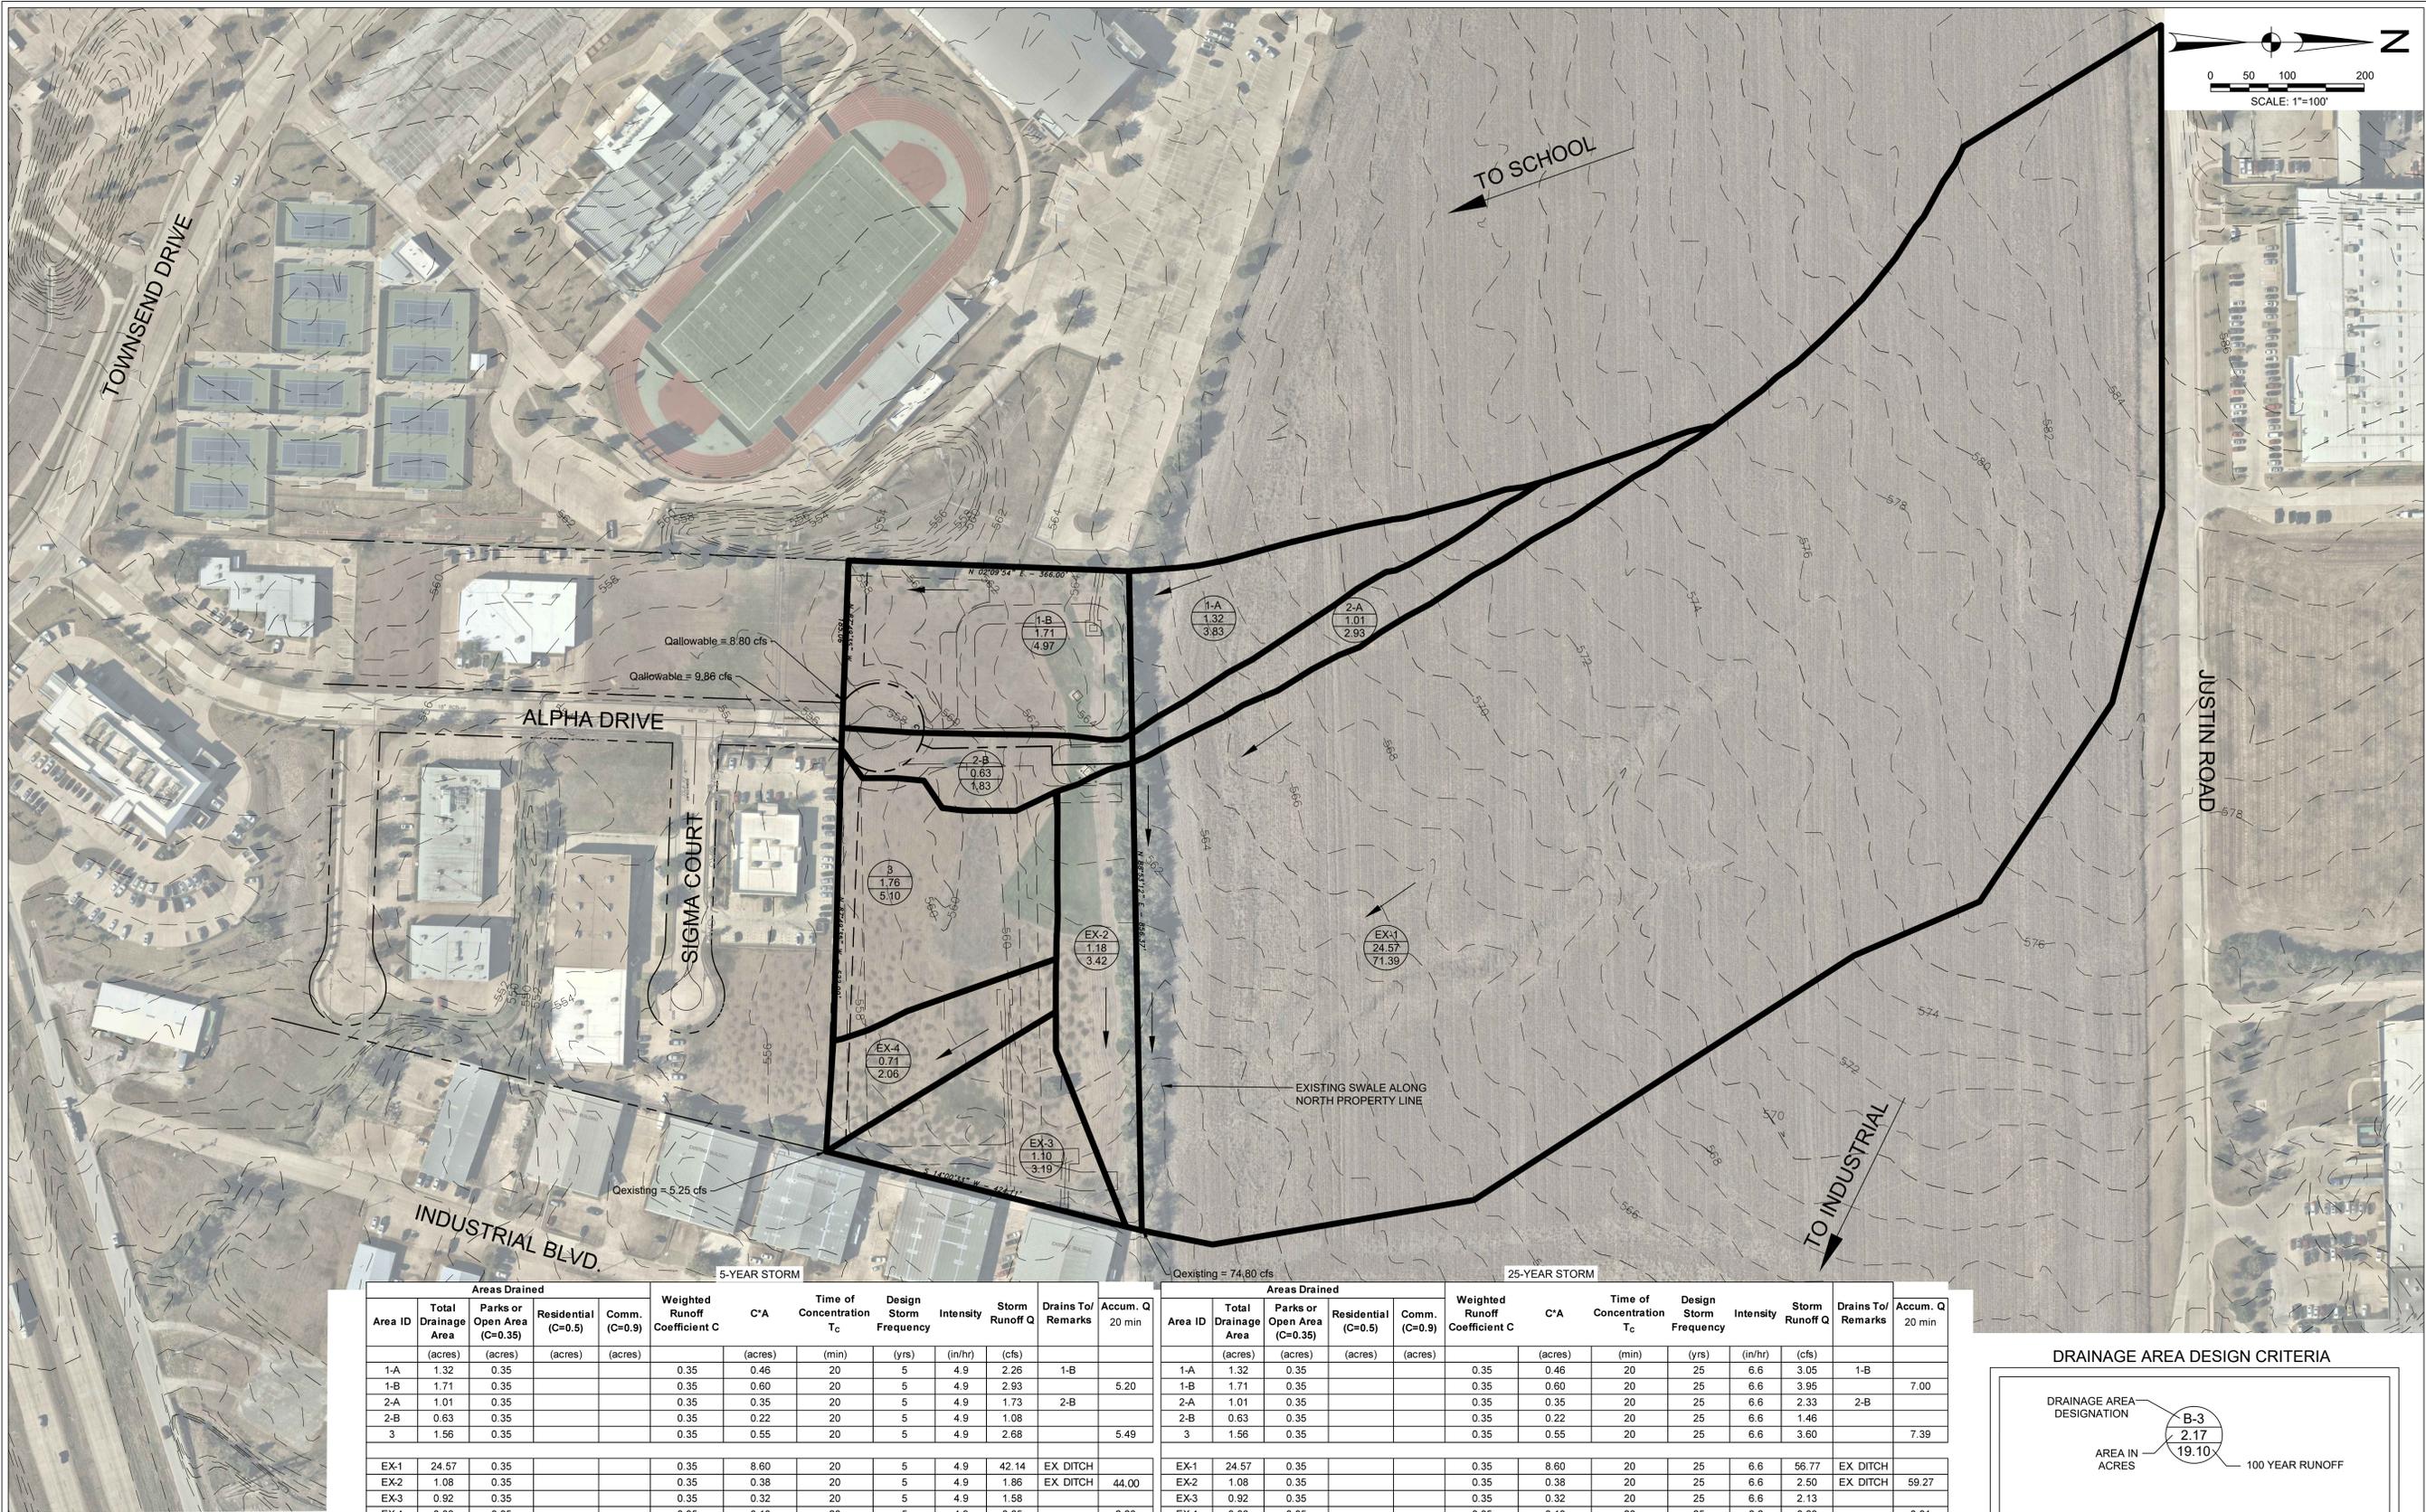

ROCKWALL URBAN + INDUSTRIAL CENTER
 END OF ALPHA DRIVE
 ROCKWALL, TX 75087

HALFF
 1201 NORTH BOWSER ROAD
 RICHARDSON, TX 75081-2275
 (214) 346-6200

Revision No.	Date	Description




5-YEAR STORM												
Areas Drained				Weighted Runoff Coefficient C	C'A	Time of Concentration T _c	Design Storm Frequency	Intensity	Storm Runoff Q	Drains To/Remarks	Accum. Q 20 min	
Area ID	Total Drainage Area (acres)	Parks or Open Area (C=0.35)	Residential (C=0.5)									Comm. (C=0.9)
1-A	1.32	0.35			0.35	0.46	20	5	4.9	2.26	1-B	
1-B	1.71	0.35			0.35	0.60	20	5	4.9	2.93		5.20
2-A	1.01	0.35			0.35	0.35	20	5	4.9	1.73	2-B	
2-B	0.63	0.35			0.35	0.22	20	5	4.9	1.08		
3	1.56	0.35			0.35	0.55	20	5	4.9	2.68		5.49
EX-1	24.57	0.35			0.35	8.60	20	5	4.9	42.14	EX DITCH	
EX-2	1.08	0.35			0.35	0.38	20	5	4.9	1.86	EX DITCH	44.00
EX-3	0.92	0.35			0.35	0.32	20	5	4.9	1.58		
EX-4	0.38	0.35			0.35	0.13	20	5	4.9	0.65		2.23

10-YEAR STORM												
Areas Drained				Weighted Runoff Coefficient C	C'A	Time of Concentration T _c	Design Storm Frequency	Intensity	Storm Runoff Q	Drains To/Remarks	Accum. Q 20 min	
Area ID	Total Drainage Area (acres)	Parks or Open Area (C=0.35)	Residential (C=0.5)									Comm. (C=0.9)
1-A	1.32	0.35			0.35	0.46	20	10	5.9	2.73	1-B	
1-B	1.71	0.35			0.35	0.60	20	10	5.9	3.53		6.26
2-A	1.01	0.35			0.35	0.35	20	10	5.9	2.09	2-B	
2-B	0.63	0.35			0.35	0.22	20	10	5.9	1.30		
3	1.56	0.35			0.35	0.55	20	10	5.9	3.22		6.81
EX-1	24.57	0.35			0.35	8.60	20	10	5.9	50.75	EX DITCH	
EX-2	1.08	0.35			0.35	0.38	20	10	5.9	2.24	EX DITCH	52.98
EX-3	0.92	0.35			0.35	0.32	20	10	5.9	1.90		
EX-4	0.38	0.35			0.35	0.13	20	10	5.9	0.79		2.69

25-YEAR STORM												
Areas Drained				Weighted Runoff Coefficient C	C'A	Time of Concentration T _c	Design Storm Frequency	Intensity	Storm Runoff Q	Drains To/Remarks	Accum. Q 20 min	
Area ID	Total Drainage Area (acres)	Parks or Open Area (C=0.35)	Residential (C=0.5)									Comm. (C=0.9)
1-A	1.32	0.35			0.35	0.46	20	25	6.6	3.05	1-B	
1-B	1.71	0.35			0.35	0.60	20	25	6.6	3.95		7.00
2-A	1.01	0.35			0.35	0.35	20	25	6.6	2.33	2-B	
2-B	0.63	0.35			0.35	0.22	20	25	6.6	1.46		
3	1.56	0.35			0.35	0.55	20	25	6.6	3.60		7.39
EX-1	24.57	0.35			0.35	8.60	20	25	6.6	56.77	EX DITCH	
EX-2	1.08	0.35			0.35	0.38	20	25	6.6	2.50	EX DITCH	59.27
EX-3	0.92	0.35			0.35	0.32	20	25	6.6	2.13		
EX-4	0.38	0.35			0.35	0.13	20	25	6.6	0.88		3.01

100-YEAR STORM												
Areas Drained				Weighted Runoff Coefficient C	C'A	Time of Concentration T _c	Design Storm Frequency	Intensity	Storm Runoff Q	Drains To/Remarks	Accum. Q 20 min	
Area ID	Total Drainage Area (acres)	Parks or Open Area (C=0.35)	Residential (C=0.5)									Comm. (C=0.9)
1-A	1.32	0.35			0.35	0.46	20	100	8.3	3.83	1-B	
1-B	1.71	0.35			0.35	0.60	20	100	8.3	4.97		8.80
2-A	1.01	0.35			0.35	0.35	20	100	8.3	2.93	2-B	
2-B	0.63	0.35			0.35	0.22	20	100	8.3	1.83		
3	1.76	0.35			0.35	0.61	20	100	8.3	5.10		9.86
EX-1	24.57	0.35			0.35	8.60	20.00	100	8.3	71.39	EX DITCH	
EX-2	1.18	0.35			0.35	0.41	20.00	100	8.3	3.42	EX DITCH	74.80
EX-3	1.10	0.35			0.35	0.38	20.00	100	8.3	3.19		
EX-4	0.71	0.35			0.35	0.25	20.00	100	8.3	2.06		5.25

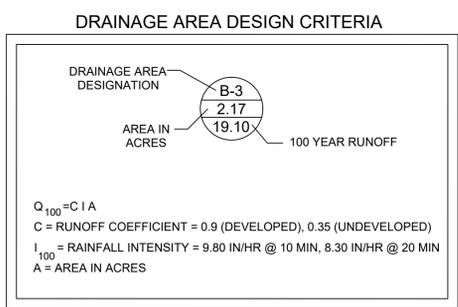

RECORD DRAWING
 NOVEMBER 24, 2020


THESE RECORD DRAWINGS HAVE BEEN PREPARED BASED ON FIELD OBSERVATIONS AND INFORMATION PROVIDED BY THE CONTRACTOR. ELEVATIONS HAVE NOT BEEN FIELD VERIFIED. THE ORIGINAL SEALED CONSTRUCTION DRAWINGS ARE ON FILE AT THE OFFICES OF HALFF ASSOCIATES, INC. TBPE FIRM F-312.

ENGINEER OF RECORD
 DYLAN B. HEDRICK
 HALFF ASSOCIATES, INC. TBPE FIRM F-312
 DATE: NOVEMBER 24, 2020

Project No.: 38050
 Issued: NOVEMBER 2020
 Drawn By: REP
 Checked By: DBH
 Scale: AS SHOWN
 Sheet Title
EXISTING DRAINAGE AREA MAP
C3.01
 Sheet Number


5-YEAR STORM											
Area ID	Areas Drained		Residential (C=0.5)	Comm. (C=0.9)	Weighted Runoff Coefficient C	C'A	Time of Concentration T _c (min)	Design Storm Frequency (yrs)	Intensity (in/hr)	Storm Runoff Q (cfs)	Drains To/Remarks
	Total Drainage Area (acres)	Parks or Open Area (C=0.35) (acres)									
1-A	1.32	0.35			0.35	0.46	20	5	4.90	2.26	EX DITCH
2-A	1.01	0.35			0.35	0.35	20	5	4.90	1.73	EX DITCH
EX-1	24.57	0.35			0.35	8.60	20	5	4.90	42.14	EX DITCH
OS-1	0.35				0.9	0.31	20	5	4.90	1.54	BYPASS POND
OS-2	0.15				0.9	0.14	20	5	4.90	0.68	BYPASS POND
OS-3	0.04				0.9	0.03	20	5	4.90	0.17	BYPASS POND
OS-4	0.23				0.9	0.21	20	5	4.90	1.03	BYPASS POND
A-1	1.94			0.9	0.9	1.75	10	5	6.10	10.66	A-2
A-2	2.10			0.9	0.9	1.89	10	5	6.10	11.52	POND
B-1	0.80			0.9	0.9	0.72	10	5	6.10	4.40	POND
C-1	0.51			0.9	0.9	0.46	10	5	6.10	2.79	C-2
C-2	0.28			0.9	0.9	0.25	10	5	6.10	1.54	C-3
C-3	0.19			0.9	0.9	0.17	10	5	6.10	1.06	POND
D-1	0.58			0.9	0.9	0.52	10	5	6.10	3.17	D-2
E-1	0.07			0.9	0.9	0.07	10	5	6.10	0.40	BYPASS POND
TOTALS (onsite)	7.02									37.94	

10-YEAR STORM											
Area ID	Areas Drained		Residential (C=0.5)	Comm. (C=0.9)	Weighted Runoff Coefficient C	C'A	Time of Concentration T _c (min)	Design Storm Frequency (yrs)	Intensity (in/hr)	Storm Runoff Q (cfs)	Drains To/Remarks
	Total Drainage Area (acres)	Parks or Open Area (C=0.35) (acres)									
1-A	1.32	0.35			0.35	0.46	20	10	5.90	2.73	EX DITCH
2-A	1.01	0.35			0.35	0.35	20	10	5.90	2.09	EX DITCH
EX-1	24.57	0.35			0.35	8.60	20	10	5.90	50.74	EX DITCH
OS-1	0.35			0.9	0.9	0.31	20	10	5.90	1.85	BYPASS POND
OS-2	0.15			0.9	0.9	0.14	20	10	5.90	0.82	BYPASS POND
OS-3	0.04			0.9	0.9	0.03	20	10	5.90	0.20	BYPASS POND
OS-4	0.23			0.9	0.9	0.21	20	10	5.90	1.24	BYPASS POND
A-1	1.94			0.9	0.9	1.75	10	10	7.10	12.41	A-2
A-2	2.10			0.9	0.9	1.89	10	10	7.10	13.41	POND
B-1	0.80			0.9	0.9	0.72	10	10	7.10	5.12	POND
C-1	0.51			0.9	0.9	0.46	10	10	7.10	3.25	C-2
C-2	0.28			0.9	0.9	0.25	10	10	7.10	1.80	C-3
C-3	0.19			0.9	0.9	0.17	10	10	7.10	1.23	POND
D-1	0.58			0.9	0.9	0.52	10	10	7.10	3.69	D-2
E-1	0.07			0.9	0.9	0.07	10	10	7.10	0.47	BYPASS POND
TOTALS (onsite)	7.02									44.25	

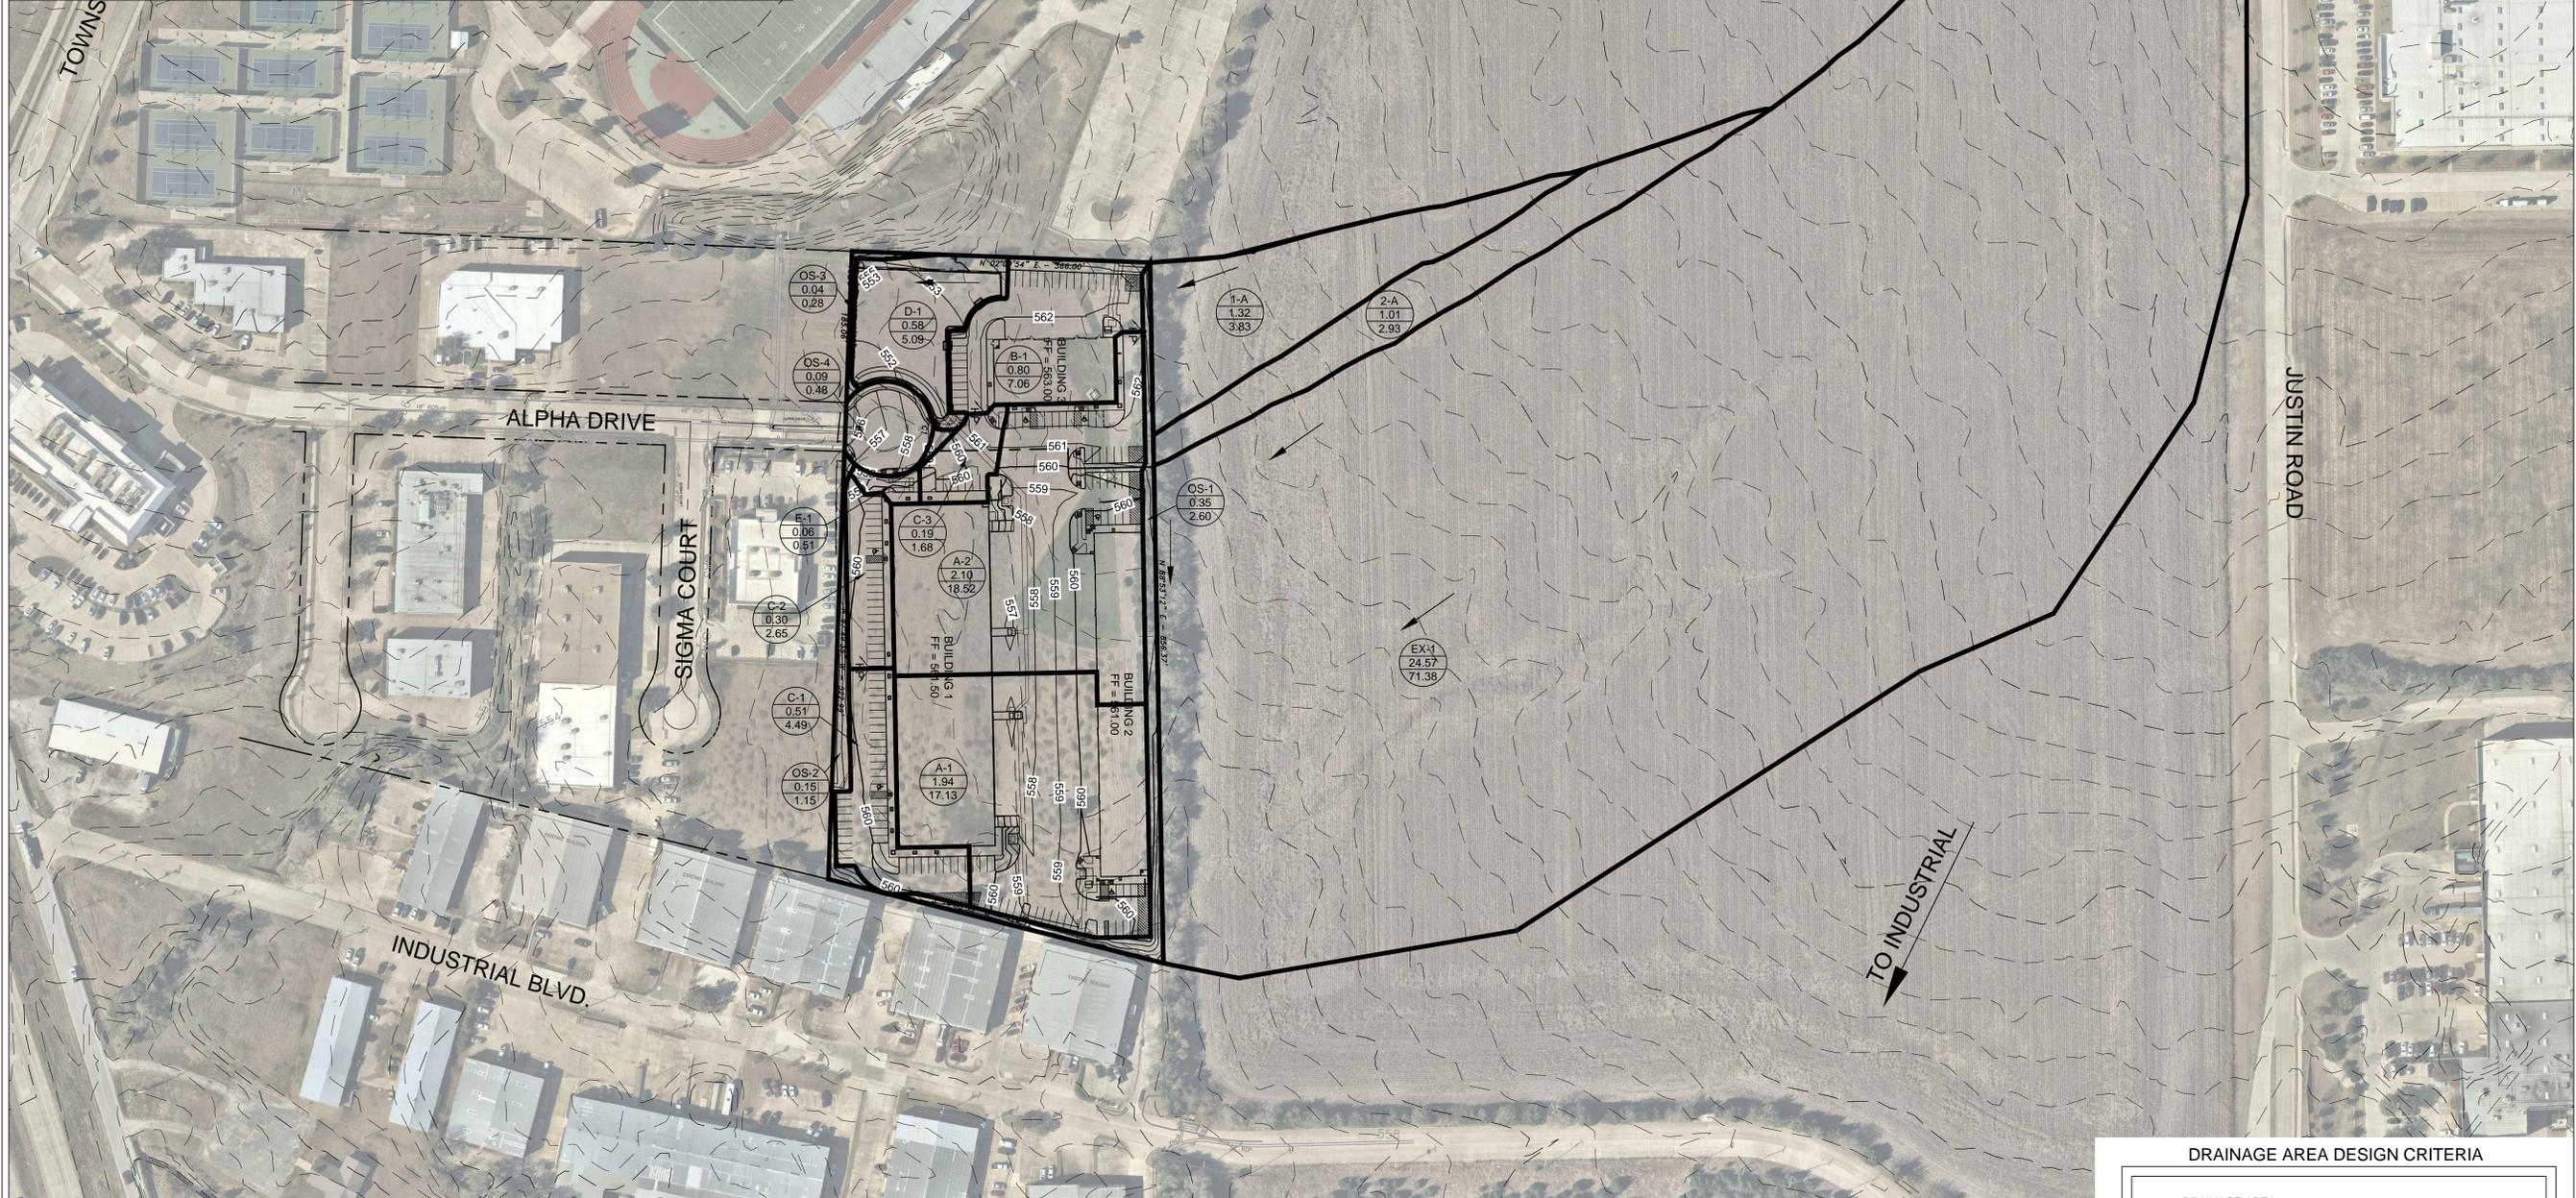

25-YEAR STORM											
Area ID	Areas Drained		Residential (C=0.5)	Comm. (C=0.9)	Weighted Runoff Coefficient C	C'A	Time of Concentration T _c (min)	Design Storm Frequency (yrs)	Intensity (in/hr)	Storm Runoff Q (cfs)	Drains To/Remarks
	Total Drainage Area (acres)	Parks or Open Area (C=0.35) (acres)									
1-A	1.32	0.35			0.35	0.46	20	25	6.60	3.05	EX DITCH
2-A	1.01	0.35			0.35	0.35	20	25	6.60	2.33	EX DITCH
EX-1	24.57	0.35			0.35	8.60	20	25	6.60	56.76	EX DITCH
OS-1	0.35			0.9	0.9	0.31	20	25	6.60	2.07	BYPASS POND
OS-2	0.15			0.9	0.9	0.14	20	25	6.60	0.91	BYPASS POND
OS-3	0.04			0.9	0.9	0.03	20	25	6.60	0.23	BYPASS POND
OS-4	0.23			0.9	0.9	0.21	20	25	6.60	1.39	BYPASS POND
A-1	1.94			0.9	0.9	1.75	10	25	8.30	14.51	A-2
A-2	2.10			0.9	0.9	1.89	10	25	8.30	15.68	POND
B-1	0.80			0.9	0.9	0.72	10	25	8.30	5.98	POND
C-1	0.51			0.9	0.9	0.46	10	25	8.30	3.80	C-2
C-2	0.28			0.9	0.9	0.25	10	25	8.30	2.10	C-3
C-3	0.19			0.9	0.9	0.17	10	25	8.30	1.44	POND
D-1	0.58			0.9	0.9	0.52	10	25	8.30	4.31	D-2
E-1	0.07			0.9	0.9	0.07	10	25	8.30	0.55	BYPASS POND
TOTALS (onsite)	7.02									51.59	

100-YEAR STORM											
Area ID	Areas Drained		Residential (C=0.5)	Comm. (C=0.9)	Weighted Runoff Coefficient C	C'A	Time of Concentration T _c (min)	Design Storm Frequency (yrs)	Intensity (in/hr)	Storm Runoff Q (cfs)	Drains To/Remarks
	Total Drainage Area (acres)	Parks or Open Area (C=0.35) (acres)									
1-A	1.32	0.35			0.35	0.46	20	100	8.30	3.83	EX DITCH
2-A	1.01	0.35			0.35	0.35	20	100	8.30	2.93	EX DITCH
EX-1	24.57	0.35			0.35	8.60	20	100	8.30	71.38	EX DITCH
OS-1	0.35			0.9	0.9	0.31	20	100	8.30	2.60	BYPASS POND
OS-2	0.15			0.9	0.9	0.14	20	100	8.30	1.15	BYPASS POND
OS-3	0.04			0.9	0.9	0.03	20	100	8.30	0.28	BYPASS POND
OS-4	0.09			0.9	0.9	0.08	20	100	8.30	0.68	BYPASS POND
A-1	1.94			0.9	0.9	1.75	10	100	9.80	17.13	A-2
A-2	2.10			0.9	0.9	1.89	10	100	9.80	18.52	POND
B-1	0.80			0.9	0.9	0.72	10	100	9.80	7.06	POND
C-1	0.51			0.9	0.9	0.46	10	100	9.80	4.49	C-2
C-2	0.28			0.9	0.9	0.27	10	100	9.80	2.55	C-3
C-3	0.19			0.9	0.9	0.17	10	100	9.80	1.58	POND
D-1	0.58			0.9	0.9	0.52	10	100	9.80	5.09	D-2
E-1	0.06			0.9	0.9	0.05	10	100	9.80	0.51	BYPASS POND
TOTALS (onsite)	7.02									61.17	

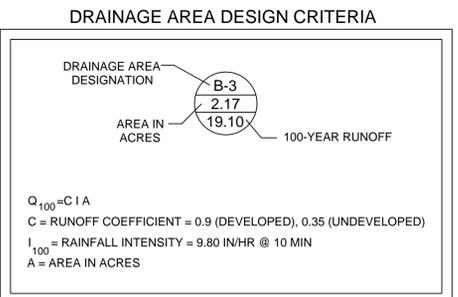

RECORD DRAWING
NOVEMBER 24, 2020

THESE RECORD DRAWINGS HAVE BEEN PREPARED BASED ON FIELD OBSERVATIONS AND INFORMATION PROVIDED BY THE CONTRACTOR. ELEVATIONS HAVE NOT BEEN FIELD VERIFIED. THE ORIGINAL SEALED CONSTRUCTION DRAWINGS ARE ON FILE AT THE OFFICES OF HALFF ASSOCIATES, INC. TBPE FIRM F-312.


ENGINEER OF RECORD
DYLAN B. HEDRICK
HALFF ASSOCIATES, INC. TBPE FIRM F-312
DATE: NOVEMBER 24, 2020

ROCKWALL URBAN + INDUSTRIAL CENTER
END OF ALPHA DRIVE
ROCKWALL, TX 75087


HALFF
1201 NORTH BOWSER ROAD
RICHARDSON, TX 75081-2275
(214) 346-6200

Revision No.	Date	Description

Project No.: 38050
Issued: NOVEMBER 2020
Drawn By: REP
Checked By: DBH
Scale: AS SHOWN
Sheet Title
PROPOSED DRAINAGE AREA MAP
C3.02
Sheet Number

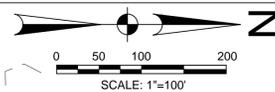

N 88°53'12" E - 856.37'

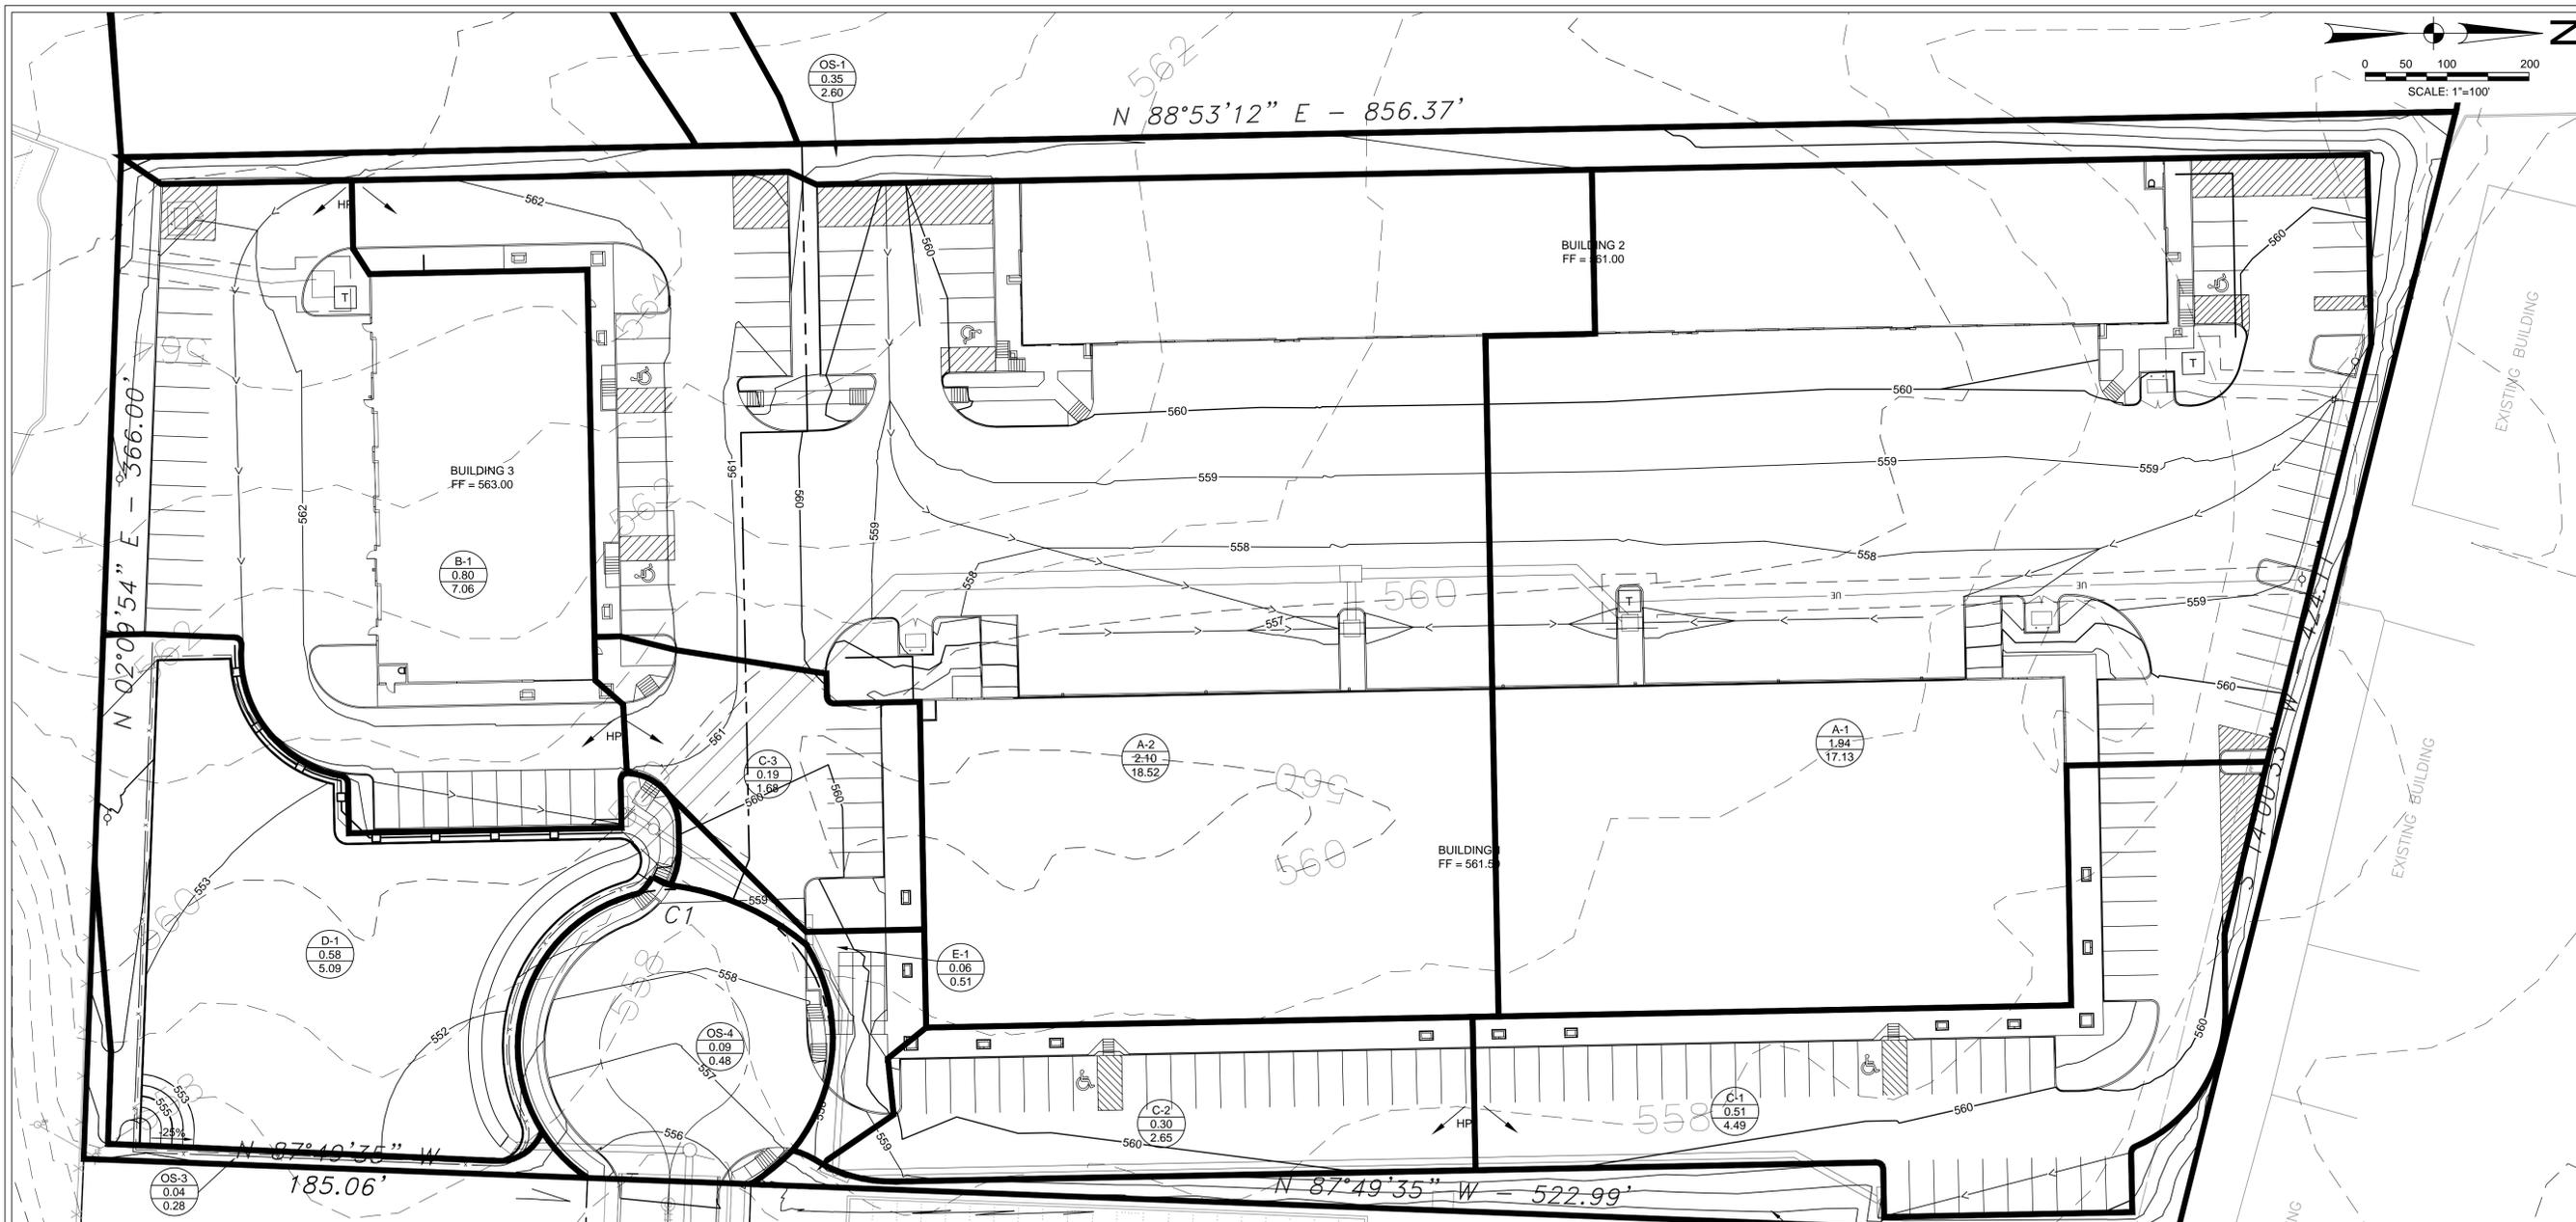

ROCKWALL URBAN + INDUSTRIAL CENTER
END OF ALPHA DRIVE
ROCKWALL, TX 75087



Revision No.	Date	Description

5-YEAR STORM

Area ID	Total Drainage Area (acres)	Parks or Open Area (C=0.35) (acres)	Residential (C=0.5) (acres)	Comm. (C=0.9) (acres)	Weighted Runoff Coefficient C	C'A	Time of Concentration T _c (min)	Design Storm Frequency (yrs)	Intensity (in/hr)	Storm Runoff Q (cfs)	Drains To/Remarks
1-A	1.32	0.35			0.35	0.46	20	5	4.90	2.26	EX DITCH
2-A	1.01	0.35			0.35	0.35	20	5	4.90	1.73	EX DITCH
EX-1	24.57	0.35			0.35	8.60	20	5	4.90	42.14	EX DITCH
OS-1	0.35				0.9	0.31	20	5	4.90	1.54	BYPASS POND
OS-2	0.15				0.9	0.14	20	5	4.90	0.68	BYPASS POND
OS-3	0.04				0.9	0.03	20	5	4.90	0.17	BYPASS POND
OS-4	0.23				0.9	0.21	20	5	4.90	1.03	BYPASS POND
A-1	1.94		0.9		0.9	1.75	10	5	6.10	10.66	A-2
A-2	2.10		0.9		0.9	1.89	10	5	6.10	11.52	POND
B-1	0.80		0.9		0.9	0.72	10	5	6.10	4.40	POND
C-1	0.51		0.9		0.9	0.46	10	5	6.10	2.79	C-2
C-2	0.28		0.9		0.9	0.25	10	5	6.10	1.54	C-3
C-3	0.19		0.9		0.9	0.17	10	5	6.10	1.06	POND
D-1	0.58		0.9		0.9	0.52	10	5	6.10	3.17	D-2
E-1	0.07		0.9		0.9	0.07	10	5	6.10	0.40	BYPASS POND
TOTALS (onsite)	7.02									37.94	

10-YEAR STORM

Area ID	Total Drainage Area (acres)	Parks or Open Area (C=0.35) (acres)	Residential (C=0.5) (acres)	Comm. (C=0.9) (acres)	Weighted Runoff Coefficient C	C'A	Time of Concentration T _c (min)	Design Storm Frequency (yrs)	Intensity (in/hr)	Storm Runoff Q (cfs)	Drains To/Remarks
1-A	1.32	0.35			0.35	0.46	20	10	5.90	2.73	EX DITCH
2-A	1.01	0.35			0.35	0.35	20	10	5.90	2.09	EX DITCH
EX-1	24.57	0.35			0.35	8.60	20	10	5.90	50.74	EX DITCH
OS-1	0.35			0.9	0.9	0.31	20	10	5.90	1.85	BYPASS POND
OS-2	0.15			0.9	0.9	0.14	20	10	5.90	0.82	BYPASS POND
OS-3	0.04			0.9	0.9	0.03	20	10	5.90	0.20	BYPASS POND
OS-4	0.23			0.9	0.9	0.21	20	10	5.90	1.24	BYPASS POND
A-1	1.94		0.9		0.9	1.75	10	10	7.10	12.41	A-2
A-2	2.10		0.9		0.9	1.89	10	10	7.10	13.41	POND
B-1	0.80		0.9		0.9	0.72	10	10	7.10	5.12	POND
C-1	0.51		0.9		0.9	0.46	10	10	7.10	3.25	C-2
C-2	0.28		0.9		0.9	0.25	10	10	7.10	1.80	C-3
C-3	0.19		0.9		0.9	0.17	10	10	7.10	1.23	POND
D-1	0.58		0.9		0.9	0.52	10	10	7.10	3.69	D-2
E-1	0.07		0.9		0.9	0.07	10	10	7.10	0.47	BYPASS POND
TOTALS (onsite)	7.02									44.25	

25-YEAR STORM

Area ID	Total Drainage Area (acres)	Parks or Open Area (C=0.35) (acres)	Residential (C=0.5) (acres)	Comm. (C=0.9) (acres)	Weighted Runoff Coefficient C	C'A	Time of Concentration T _c (min)	Design Storm Frequency (yrs)	Intensity (in/hr)	Storm Runoff Q (cfs)	Drains To/Remarks
1-A	1.32	0.35			0.35	0.46	20	25	6.60	3.05	EX DITCH
2-A	1.01	0.35			0.35	0.35	20	25	6.60	2.33	EX DITCH
EX-1	24.57	0.35			0.35	8.60	20	25	6.60	56.76	EX DITCH
OS-1	0.35			0.9	0.9	0.31	20	25	6.60	2.07	BYPASS POND
OS-2	0.15			0.9	0.9	0.14	20	25	6.60	0.91	BYPASS POND
OS-3	0.04			0.9	0.9	0.03	20	25	6.60	0.23	BYPASS POND
OS-4	0.23			0.9	0.9	0.21	20	25	6.60	1.39	BYPASS POND
A-1	1.94		0.9		0.9	1.75	10	25	8.30	14.51	A-2
A-2	2.10		0.9		0.9	1.89	10	25	8.30	15.68	POND
B-1	0.80		0.9		0.9	0.72	10	25	8.30	5.98	POND
C-1	0.51		0.9		0.9	0.46	10	25	8.30	3.80	C-2
C-2	0.28		0.9		0.9	0.25	10	25	8.30	2.10	C-3
C-3	0.19		0.9		0.9	0.17	10	25	8.30	1.44	POND
D-1	0.58		0.9		0.9	0.52	10	25	8.30	4.31	D-2
E-1	0.07		0.9		0.9	0.07	10	25	8.30	0.55	BYPASS POND
TOTALS (onsite)	7.02									51.59	

100-YEAR STORM

Area ID	Total Drainage Area (acres)	Parks or Open Area (C=0.35) (acres)	Residential (C=0.5) (acres)	Comm. (C=0.9) (acres)	Weighted Runoff Coefficient C	C'A	Time of Concentration T _c (min)	Design Storm Frequency (yrs)	Intensity (in/hr)	Storm Runoff Q (cfs)	Drains To/Remarks
1-A	1.32	0.35			0.35	0.46	20	100	8.30	3.83	EX DITCH
2-A	1.01	0.35			0.35	0.35	20	100	8.30	2.93	EX DITCH
EX-1	24.57	0.35			0.35	8.60	20	100	8.30	71.38	EX DITCH
OS-1	0.35			0.9	0.9	0.31	20	100	8.30	2.60	BYPASS POND
OS-2	0.15			0.9	0.9	0.14	20	100	8.30	1.15	BYPASS POND
OS-3	0.04			0.9	0.9	0.03	20	100	8.30	0.28	BYPASS POND
OS-4	0.09			0.9	0.9	0.08	20	100	8.30	0.68	BYPASS POND
A-1	1.94		0.9		0.9	1.75	10	100	9.80	17.13	A-2
A-2	2.10		0.9		0.9	1.89	10	100	9.80	18.52	POND
B-1	0.80		0.9		0.9	0.72	10	100	9.80	7.05	POND
C-1	0.51		0.9		0.9	0.46	10	100	9.80	4.49	C-2
C-2	0.30		0.9		0.9	0.27	10	100	9.80	2.65	C-3
C-3	0.19		0.9		0.9	0.17	10	100	9.80	1.68	POND
D-1	0.58		0.9		0.9	0.52	10	100	9.80	5.09	D-2
E-1	0.06		0.9		0.9	0.05	10	100	9.80	0.51	BYPASS POND
TOTALS (onsite)	7.02									61.17	

DRAINAGE AREA DESIGN CRITERIA

DRAINAGE AREA DESIGNATION: B-3
AREA IN ACRES: 2.17
100-YEAR RUNOFF: 19.10

Q₁₀₀ = C I A
C = RUNOFF COEFFICIENT = 0.9 (DEVELOPED), 0.35 (UNDEVELOPED)
I₁₀₀ = RAINFALL INTENSITY = 9.80 IN/HR @ 10 MIN
A = AREA IN ACRES

RECORD DRAWING
NOVEMBER 24, 2020

THESE RECORD DRAWINGS HAVE BEEN PREPARED BASED ON FIELD OBSERVATIONS AND INFORMATION PROVIDED BY THE CONTRACTOR. ELEVATIONS HAVE NOT BEEN FIELD VERIFIED. THE ORIGINAL SEALED CONSTRUCTION DRAWINGS ARE ON FILE AT THE OFFICES OF HALFF ASSOCIATES, INC. TBPE FIRM F-312.

ENGINEER OF RECORD
DYLAN B. HEDRICK
HALFF ASSOCIATES, INC. TBPE FIRM F-312
DATE: NOVEMBER 24, 2020

Project No.:	38050
Issued:	NOVEMBER 2020
Drawn By:	REP
Checked By:	DBH
Scale:	AS SHOWN
Sheet Title:	PROPOSED SITE DRAINAGE AREA MAP
Sheet Number:	C3.03



Revision No.	Date	Description

RECORD DRAWING
NOVEMBER 24, 2020



THESE RECORD DRAWINGS HAVE BEEN PREPARED BASED ON FIELD OBSERVATIONS AND INFORMATION PROVIDED BY THE CONTRACTOR. ELEVATIONS HAVE NOT BEEN FIELD VERIFIED. THE ORIGINAL SEALED CONSTRUCTION DRAWINGS ARE ON FILE AT THE OFFICES OF HALFF ASSOCIATES, INC. TBPE FIRM F-312.

ENGINEER OF RECORD
DYLAN B. HEDRICK
HALFF ASSOCIATES, INC. TBPE FIRM F-312
DATE: NOVEMBER 24, 2020

NOTE:
CONTRACTOR TO FIELD VERIFY LOCATIONS OF ALL EXISTING UTILITIES AND NOTIFY ENGINEER OF ANY DISCREPANCIES.

LEGEND

---	PROPERTY LINE
- - -	EASEMENT LINE
---	EXISTING CONTOUR
---	PROPOSED MAJOR CONTOUR
---	PROPOSED MINOR CONTOUR
---	PROPOSED STORM DRAINAGE

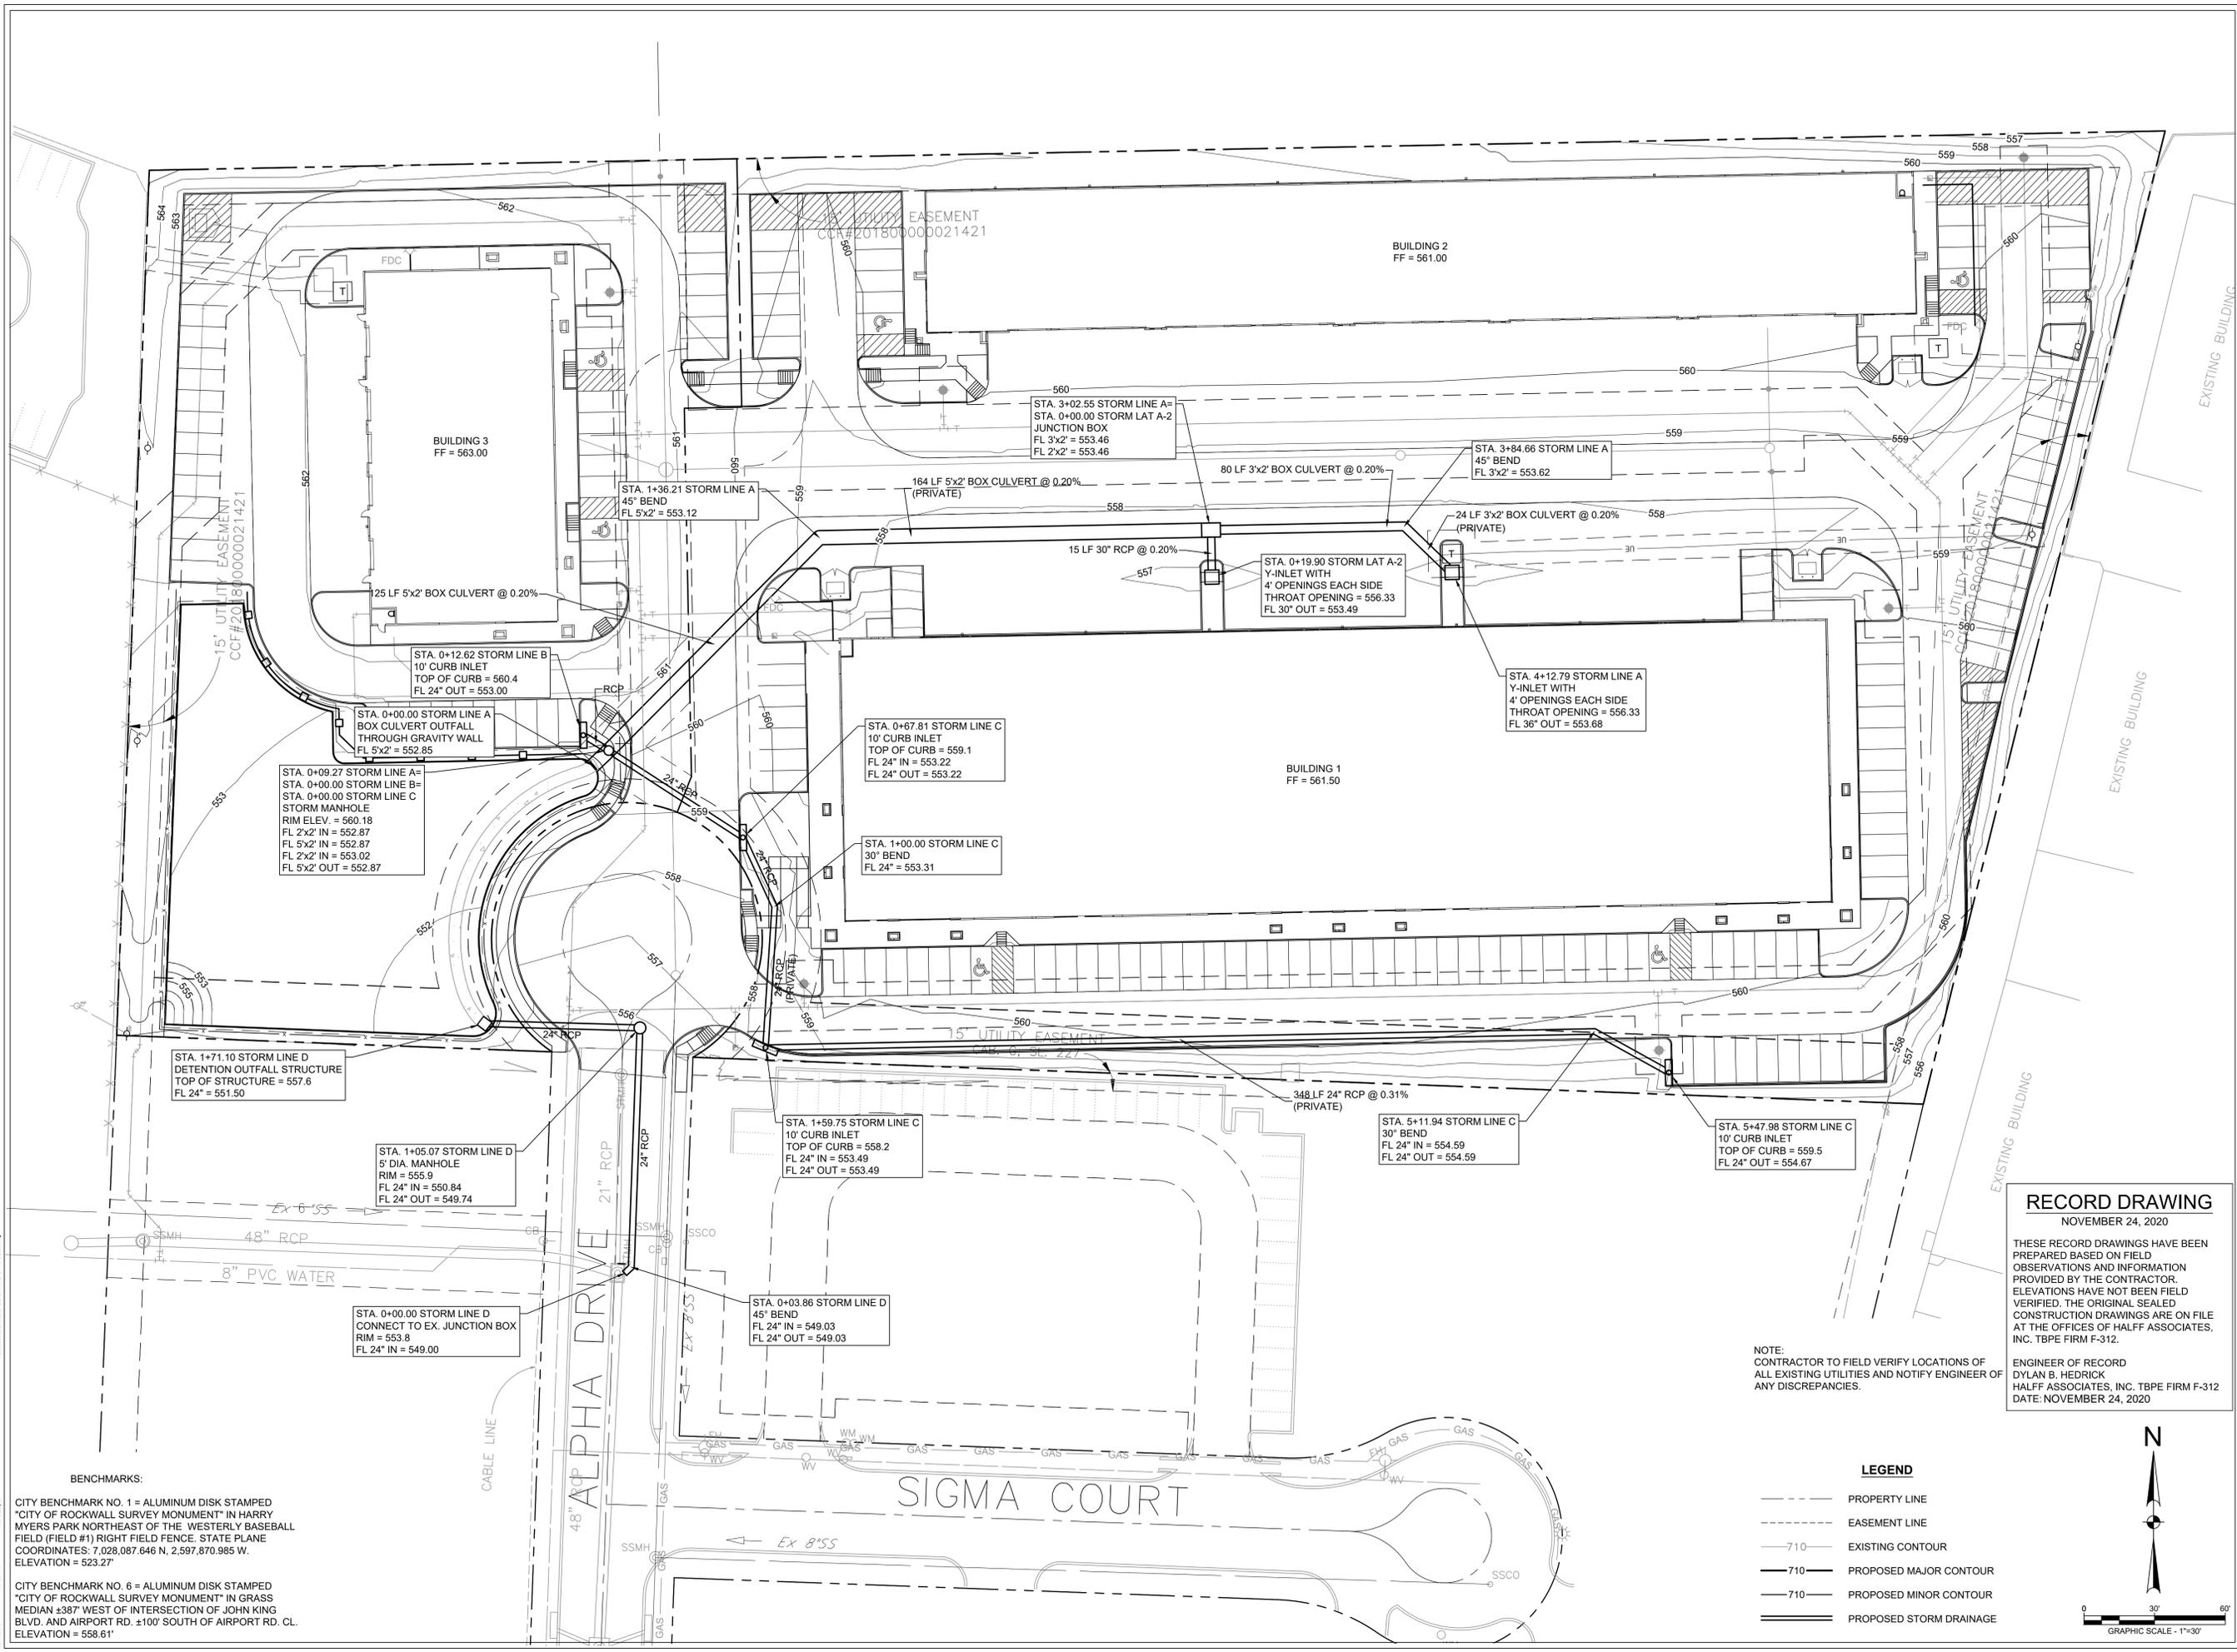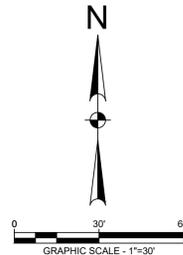


BENCHMARKS:


CITY BENCHMARK NO. 1 = ALUMINUM DISK STAMPED
"CITY OF ROCKWALL SURVEY MONUMENT" IN HARRY MYERS PARK NORTHEAST OF THE WESTERLY BASEBALL FIELD (FIELD #1) RIGHT FIELD FENCE. STATE PLANE COORDINATES: 7,028,087.646 N, 2,597,870.985 W. ELEVATION = 523.27'

CITY BENCHMARK NO. 6 = ALUMINUM DISK STAMPED
"CITY OF ROCKWALL SURVEY MONUMENT" IN GRASS MEDIAN ±387' WEST OF INTERSECTION OF JOHN KING BLVD. AND AIRPORT RD. ±100' SOUTH OF AIRPORT RD. CL. ELEVATION = 558.61'

Project No.:	38050
Issued:	NOVEMBER 2020
Drawn By:	REP
Checked By:	DBH
Scale:	AS SHOWN
Sheet Title	STORM DRAINAGE PLAN
Sheet Number	C3.04

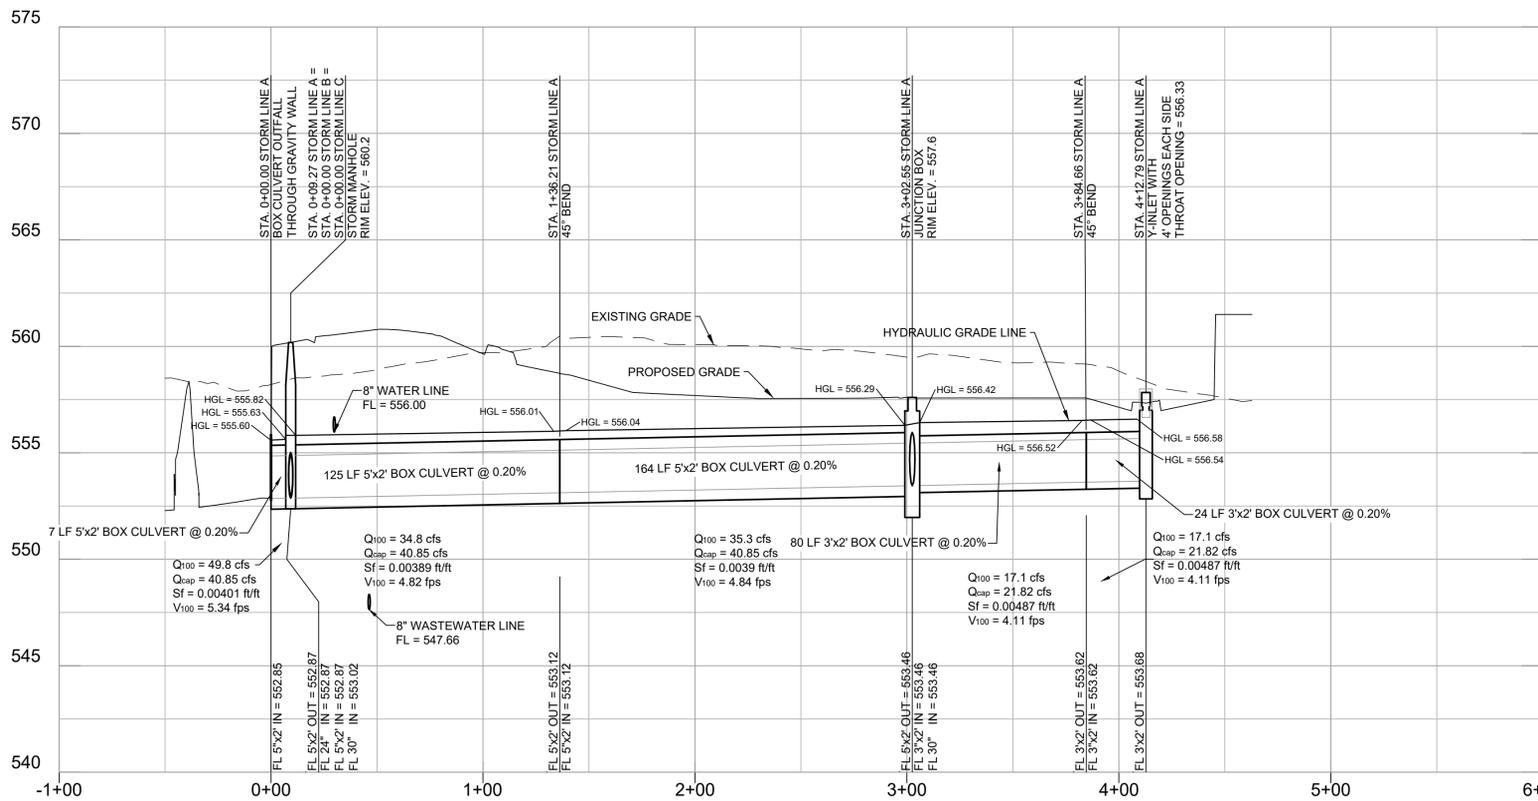

STORM LINE A PROFILE
(PRIVATE)

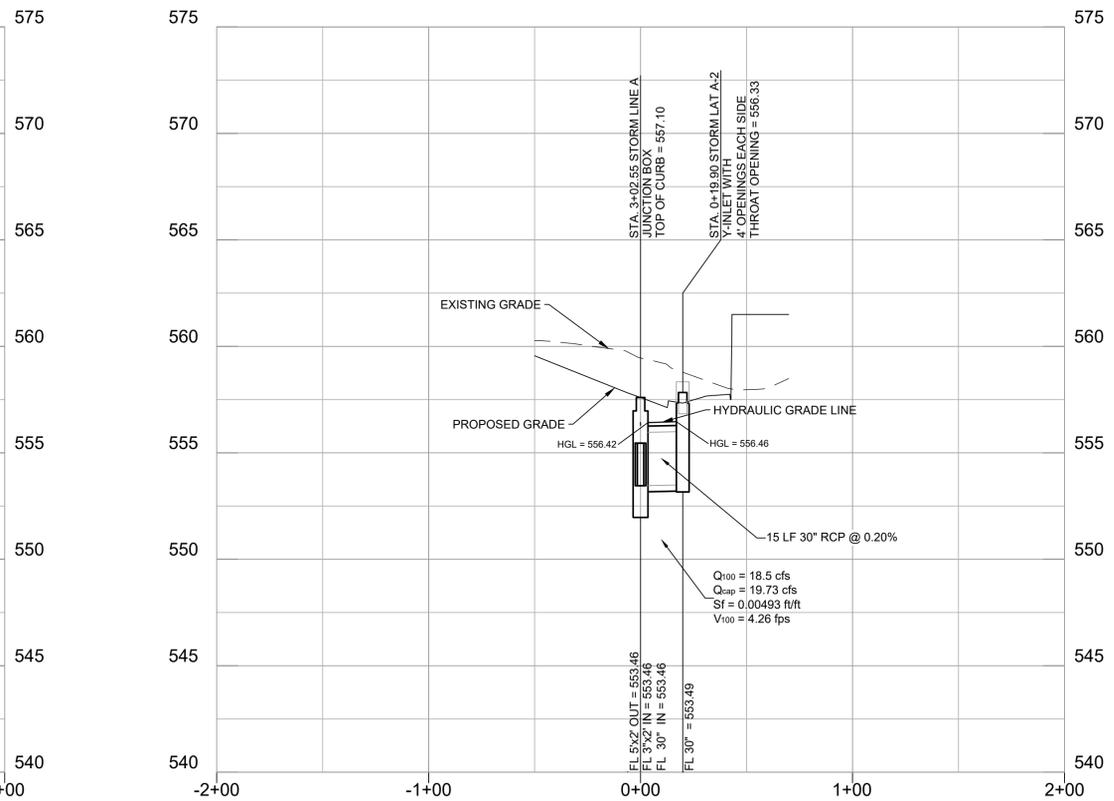


STORM LAT A-2 PROFILE


RECORD DRAWING
NOVEMBER 24, 2020

THESE RECORD DRAWINGS HAVE BEEN PREPARED BASED ON FIELD OBSERVATIONS AND INFORMATION PROVIDED BY THE CONTRACTOR. ELEVATIONS HAVE NOT BEEN FIELD VERIFIED. THE ORIGINAL SEALED CONSTRUCTION DRAWINGS ARE ON FILE AT THE OFFICES OF HALFF ASSOCIATES, INC. TBPE FIRM F-312.

ENGINEER OF RECORD
DYLAN B. HEDRICK
HALFF ASSOCIATES, INC. TBPE FIRM F-312
DATE: NOVEMBER 24, 2020

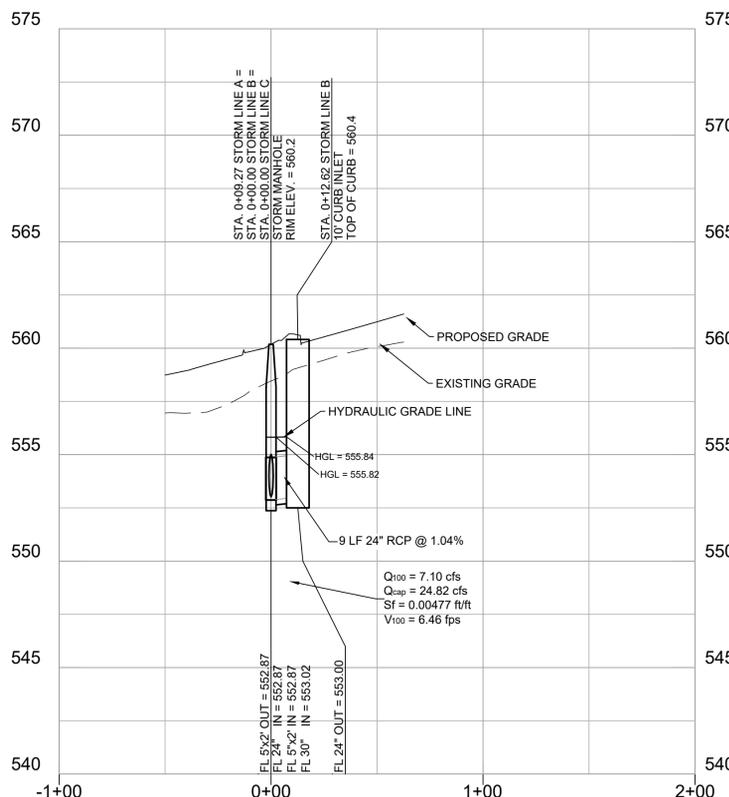


STORM LINE B PROFILE
(PRIVATE)

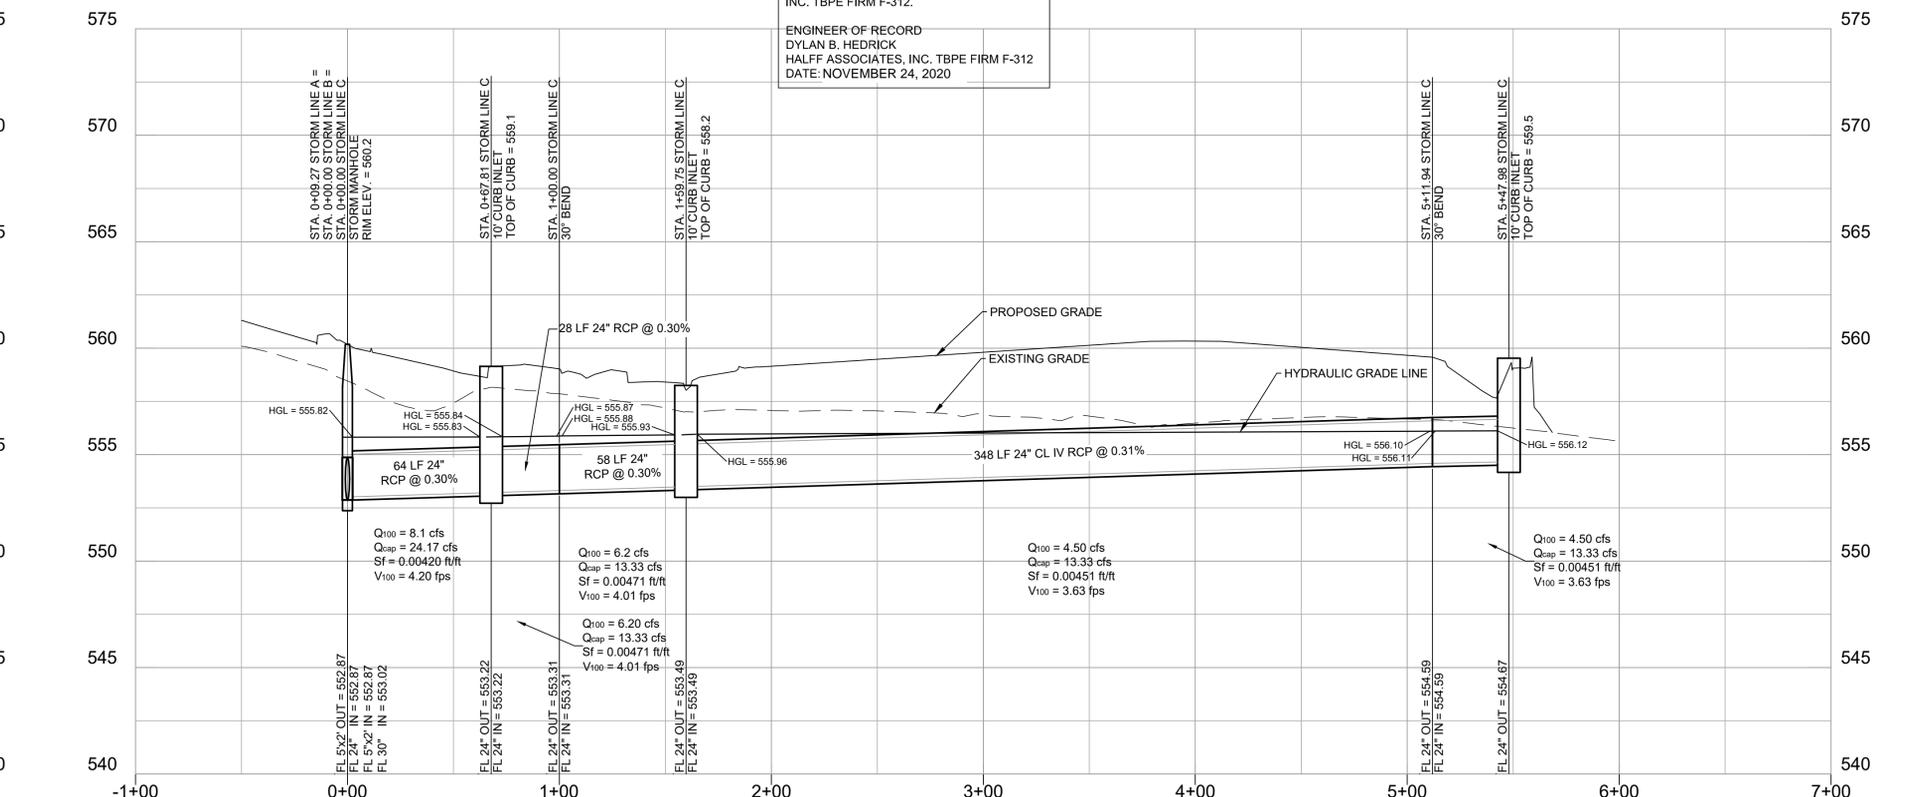

STORM LINE C PROFILE
(PRIVATE)

Revision No.	Date	Description

Project No.:	38050
Issued:	NOVEMBER 2020
Drawn By:	REP
Checked By:	DBH
Scale:	AS SHOWN

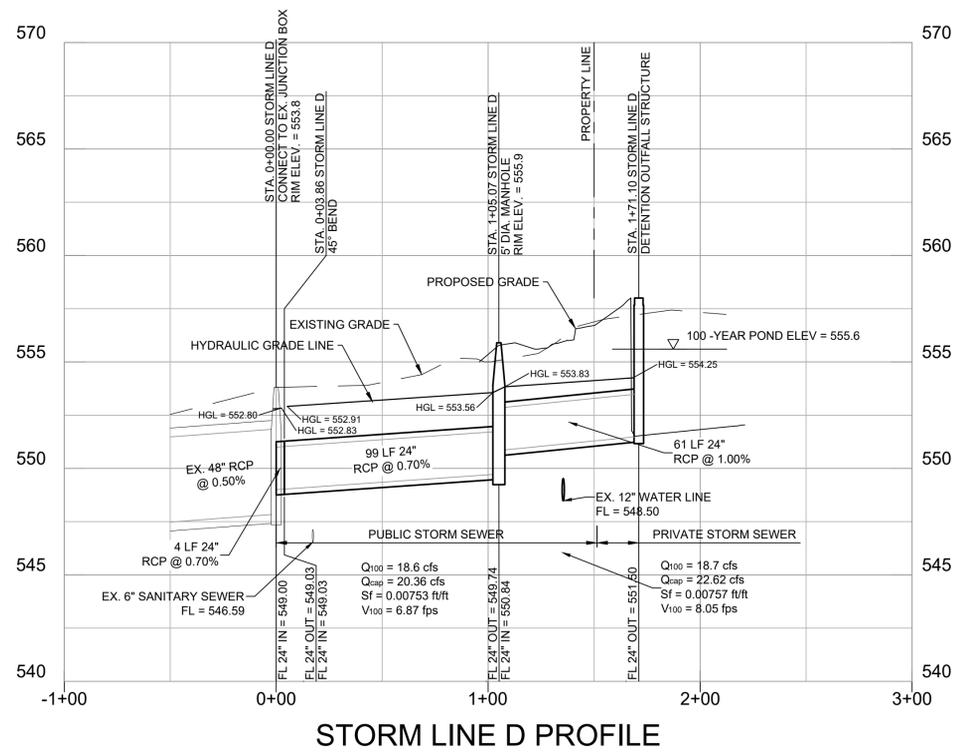

STORM LINE D PROFILE

ROCKWALL URBAN + INDUSTRIAL CENTER
 END OF ALPHA DRIVE
 ROCKWALL, TX 75087




Revision No.	Date	Description

RECORD DRAWING
 NOVEMBER 24, 2020


THESE RECORD DRAWINGS HAVE BEEN PREPARED BASED ON FIELD OBSERVATIONS AND INFORMATION PROVIDED BY THE CONTRACTOR. ELEVATIONS HAVE NOT BEEN FIELD VERIFIED. THE ORIGINAL SEALED CONSTRUCTION DRAWINGS ARE ON FILE AT THE OFFICES OF HALFF ASSOCIATES, INC. TBPE FIRM F-312.

ENGINEER OF RECORD
 DYLAN B. HEDRICK
 HALFF ASSOCIATES, INC. TBPE FIRM F-312
 DATE: NOVEMBER 24, 2020


Project No.:	38050
Issued:	NOVEMBER 2020
Drawn By:	REP
Checked By:	DBH
Scale:	AS SHOWN
Sheet Title	STORM DRAINAGE PROFILE
Sheet Number	C3.06

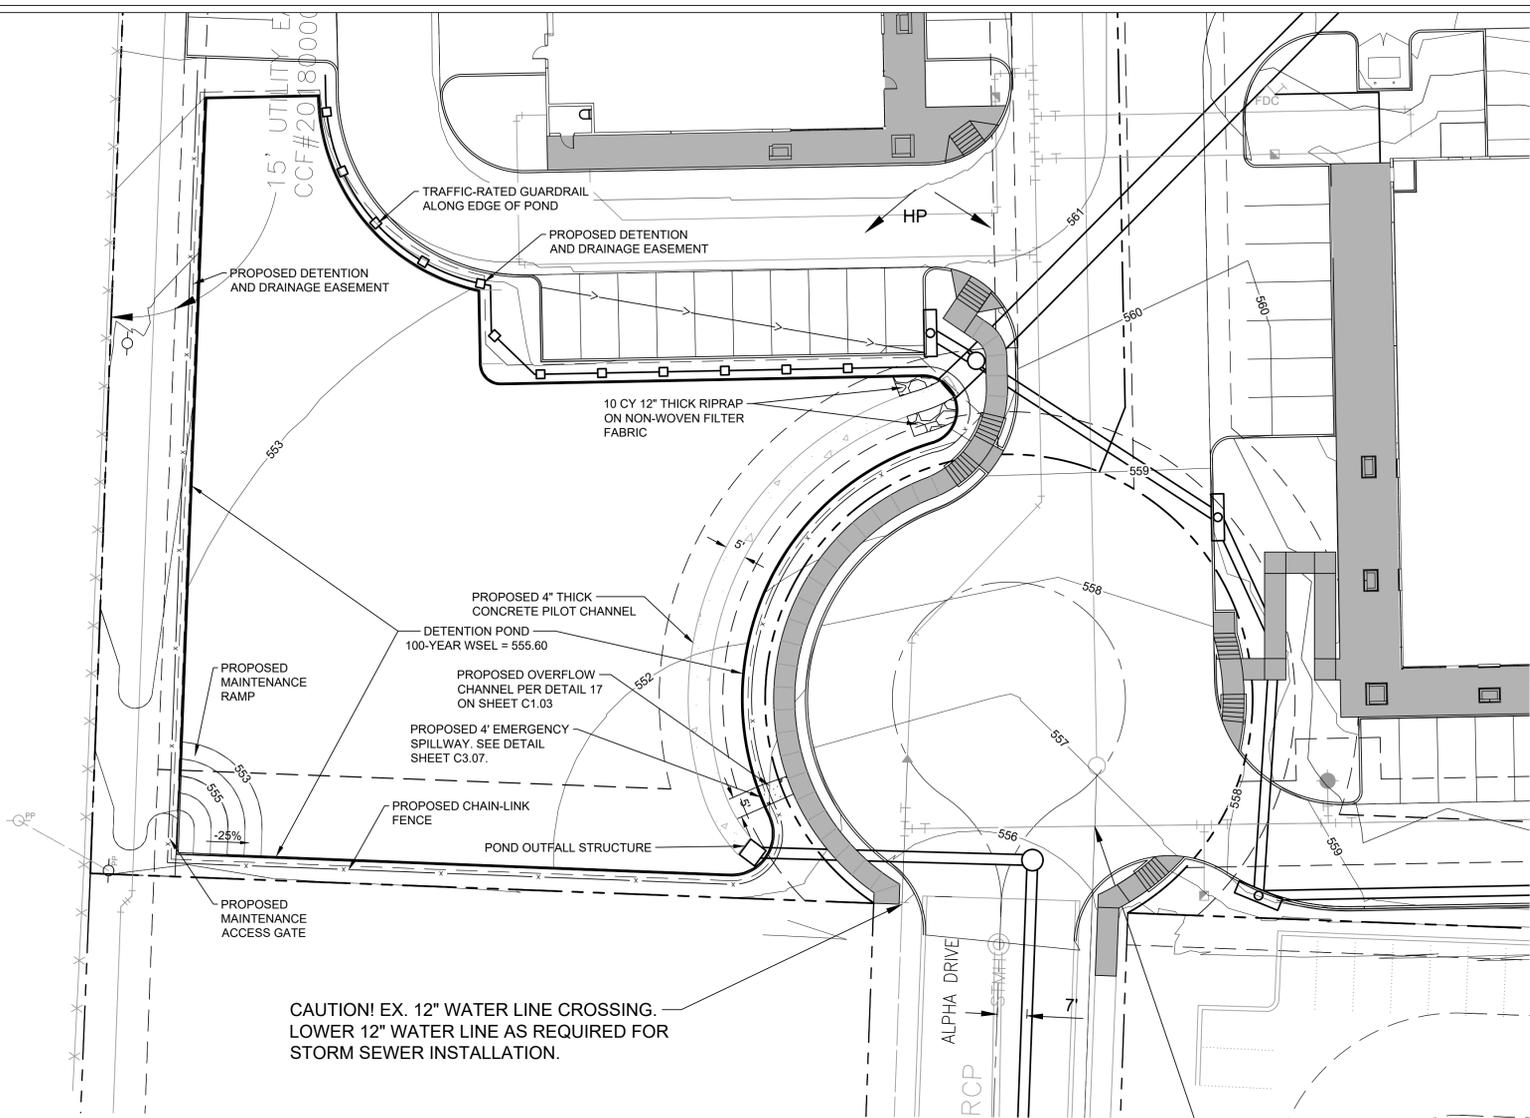

CAUTION! EX. 12" WATER LINE CROSSING.
LOWER 12" WATER LINE AS REQUIRED FOR
STORM SEWER INSTALLATION.

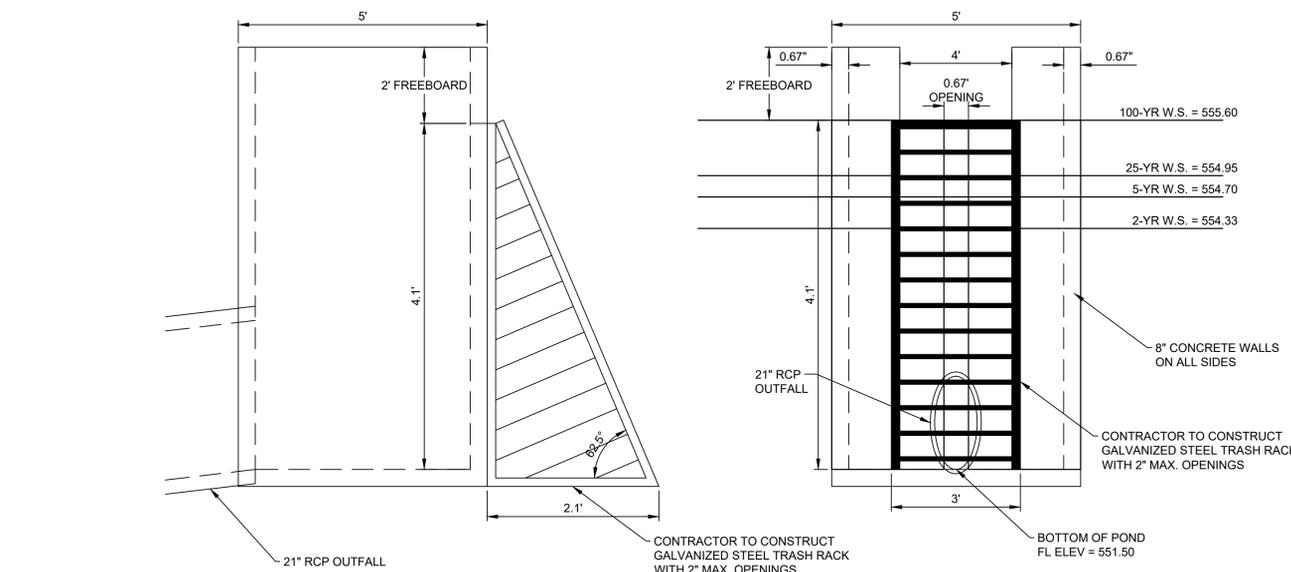

DETENTION OUTFALL STRUCTURE
SCALE: NOT TO SCALE

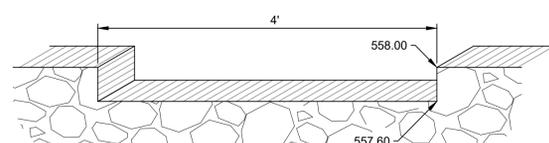

EMERGENCY SPILLWAY DETAIL
SCALE: NOT TO SCALE

DETENTION POND DETENTION (MODIFIED RATIONAL METHOD - HYDRO 35) 5-YR						
Drainage Area =	6.40	acres	(does not include bypass areas)			
Allowable Outflow Rate - Q_5 =	10.68	cfs	(does not include bypass runoff)			
Proposed Runoff Coefficient C =	0.9					
Time of Concentration - T_c =	10.00	minutes				
Frequency Factor - K =	1					
Duration (minutes)	Intensity (inches/hr)	Depth (inches)	Inflow Discharge Q=KCiA (inches)	Inflow Volume Cu. Ft.	Outflow Volume (minutes)	Outflow Volume Cu. Ft.
10	6.10	1.02	35.1	21,090	20	6,411
15	5.50	1.38	31.7	28,523	25	8,013
20	4.90	1.63	28.2	33,882	30	9,616
30	4.10	2.05	23.6	42,526	40	12,821
40	3.40	2.27	19.6	47,020	50	16,027
50	2.80	2.33	16.1	48,403	60	19,232
60	2.60	2.60	15.0	53,935	70	22,437
70	2.40	2.80	13.8	58,084	80	25,643
80	2.30	3.07	13.3	63,615	90	28,848
90	2.10	3.15	12.1	65,344	100	32,053
100	1.90	3.17	10.9	65,690	110	35,259
110	1.80	3.30	10.4	68,456	120	38,464
			Required Storage Vol.	34,767	cubic feet	0.80 acre-feet

DETENTION POND DETENTION (MODIFIED RATIONAL METHOD - HYDRO 35) 10-YR						
Drainage Area =	6.40	acres	(does not include bypass areas)			
Allowable Outflow Rate - Q_{10} =	12.86	cfs	(does not include bypass runoff)			
Proposed Runoff Coefficient C =	0.9					
Time of Concentration - T_c =	10.00	minutes				
Frequency Factor - K =	1					
Duration (minutes)	Intensity (inches/hr)	Depth (inches)	Inflow Discharge Q=KCiA (inches)	Inflow Volume Cu. Ft.	Outflow Volume (minutes)	Outflow Volume Cu. Ft.
10	7.10	1.18	40.9	24,547	20	7,719
15	6.50	1.63	37.5	33,709	25	9,649
20	5.90	1.97	34.0	40,797	30	11,578
30	4.80	2.40	27.7	49,786	40	15,438
40	4.00	2.67	23.0	55,318	50	19,297
50	3.50	2.92	20.2	60,504	60	23,157
60	3.00	3.00	17.3	62,233	70	27,016
70	2.80	3.27	16.1	67,764	80	30,876
80	2.60	3.47	15.0	71,913	90	34,735
90	2.50	3.75	14.4	77,791	100	38,595
100	2.40	4.00	13.8	82,977	110	42,454
110	2.30	4.22	13.3	87,471	120	46,314
			Required Storage Vol.	41,157	cubic feet	0.94 acre-feet

DETENTION POND DETENTION (MODIFIED RATIONAL METHOD - HYDRO 35) 25-YR						
Drainage Area =	6.40	acres	(does not include bypass areas)			
Allowable Outflow Rate - Q_{25} =	14.39	cfs	(does not include bypass runoff)			
Proposed Runoff Coefficient C =	0.9					
Time of Concentration - T_c =	10.00	minutes				
Frequency Factor - K =	1					
Duration (minutes)	Intensity (inches/hr)	Depth (inches)	Inflow Discharge Q=KCiA (inches)	Inflow Volume Cu. Ft.	Outflow Volume (minutes)	Outflow Volume Cu. Ft.
10	8.30	1.38	47.8	28,696	20	8,635
15	7.50	1.88	43.2	38,895	25	10,793
20	6.60	2.20	38.0	45,637	30	12,952
30	5.50	2.75	31.7	57,046	40	17,270
40	4.60	3.07	26.5	63,615	50	21,587
50	4.00	3.33	23.0	69,147	60	25,904
60	3.50	3.50	20.2	72,605	70	30,222
70	3.30	3.85	19.0	79,865	80	34,539
80	3.10	4.13	17.9	85,743	90	38,857
90	2.90	4.35	16.7	90,237	100	43,174
100	2.70	4.50	15.6	93,349	110	47,491
110	2.50	4.58	14.4	95,077	120	51,809
			Required Storage Vol.	47,063	cubic feet	1.08 acre-feet


DETENTION POND DETENTION (MODIFIED RATIONAL METHOD - HYDRO 35) 100-YR						
Drainage Area =	6.40	acres	(does not include bypass areas)			
Allowable Outflow Rate - Q_{100} =	18.66	cfs	(does not include bypass runoff)			
Proposed Runoff Coefficient C =	0.9					
Time of Concentration - T_c =	10.00	minutes				
Frequency Factor - K =	1					
Duration (minutes)	Intensity (inches/hr)	Depth (inches)	Inflow Discharge Q=KCiA (inches)	Inflow Volume Cu. Ft.	Outflow Volume (minutes)	Outflow Volume Cu. Ft.
10	9.80	1.63	56.5	33,882	20	11,199
15	9.00	2.25	51.9	46,674	25	13,999
20	8.30	2.77	47.8	57,392	30	16,798
30	6.60	3.30	38.0	68,456	40	22,398
40	5.80	3.87	33.4	80,211	50	27,997
50	5.00	4.17	28.8	86,434	60	33,597
60	4.50	4.50	25.9	93,349	70	39,196
70	4.00	4.67	23.0	96,806	80	44,796
80	3.70	4.93	21.3	102,338	90	50,395
90	3.50	5.25	20.2	108,907	100	55,995
100	3.40	5.67	19.6	117,550	110	61,594
110	3.20	5.87	18.4	121,699	120	67,194
			Required Storage Vol.	55,956	cubic feet	1.28 acre-feet

- NOTES:
- ONSITE DRAINAGE AREAS OS-1, OS-2, OS-3, OS-4 AND E-1 ARE NOT INCLUDED IN THE DETENTION POND CALCULATIONS AS THEY BYPASS THE POND. THE TOTAL AREA BYPASSING THE POND IS 0.85 ACRES (5.22 CFS).
 - EXISTING DRAINAGE AREAS EX-2, EX-3, AND EX-4 FLOW OFF-SITE WITH A COMBINED AREA OF 2.99 ACRES AT 8.67 CFS RUNOFF. PROPOSED DRAINAGE AREAS OS-1, OS-2, OS-3, OS-4 AND E-1 FLOW OFF-SITE WITH A COMBINED AREA OF 1.19 ACRES AT 5.22 CFS RUNOFF.
 - NO PAVING OPERATIONS, INCLUDING SLAB, ARE ALLOWED UNTIL DETENTION POND IS FULLY INSTALLED WITH EROSION PROTECTION ON THE SIDES AND BOTTOM

DETENTION POND STAGE STORAGE TABLE					
ELEV	AREA (sq. ft.)	DEPT H (ft)	AVG END INC. VOL. (cu. yd.)	AVG END TOTAL VOL. (cu. yd.)	TOTAL VOL. (ac. ft.)
551.50	0	0	0	0	0
552.00	1985	0.5	8.54	8.54	0.01
553.00	16121	1	245.07	253.61	0.16
554.00	19519	1	662.65	916.26	0.57
555.00	19553	1	720.17	1636.43	1.01
555.60	19571	0.6	433.98	2070.41	1.28
556.00	19586	0.4	289.99	2360.40	1.46
557.00	19620	1	727.04	3087.44	1.91
558.00	19654	1	729.27	3816.71	2.37

Weir Sizing				
WSEL BASED ON SET WIDTH "b"				
	5-YR	10-YR	25-YR	100-YR
Q(allowable)	10.68	12.86	14.39	18.66
Pond FL	551.5	551.5	551.5	551.5
b (width)	0.67	0.67	0.67	0.67
Height	2.83	3.20	3.45	4.10
WSEL	554.33	554.70	554.95	555.60
Q(out, actual)	10.68	12.86	14.39	18.66

Elevation Vs. Discharge Table	
Water Surface Elevation	Weir Discharge (cfs)
557.60	46.92
557.00	28.65
556.00	21.19
555.60	18.66
555.00	14.72
554.95	14.39
554.70	12.86
554.33	10.68
554.00	8.88
553.00	4.13
552.00	0.79
551.50	0.00

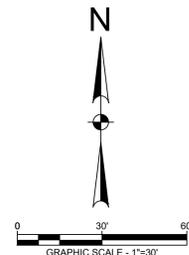

- LEGEND**
- PROPERTY LINE
 - EASEMENT LINE
 - - - 710 EXISTING CONTOUR
 - 710 PROPOSED MAJOR CONTOUR
 - 710 PROPOSED MINOR CONTOUR
 - == PROPOSED STORM DRAINAGE

RECORD DRAWING
NOVEMBER 24, 2020

THESE RECORD DRAWINGS HAVE BEEN PREPARED BASED ON FIELD OBSERVATIONS AND INFORMATION PROVIDED BY THE CONTRACTOR. ELEVATIONS HAVE NOT BEEN FIELD VERIFIED. THE ORIGINAL SEALED CONSTRUCTION DRAWINGS ARE ON FILE AT THE OFFICES OF HALFF ASSOCIATES, INC. TPBE FIRM F-312.

ENGINEER OF RECORD
DYLAN B. HEDRICK
HALFF ASSOCIATES, INC. TPBE FIRM F-312
DATE: NOVEMBER 24, 2020

ROCKWALL URBAN + INDUSTRIAL CENTER
END OF ALPHA DRIVE
ROCKWALL, TX 75087


HALFF
1201 NORTH BOWSER ROAD
RICHARDSON, TX 75081-2275
(214) 346-6200

Revision No.	Date	Description

Project No.:	38050
Issued:	NOVEMBER 2020
Drawn By:	REP
Checked By:	DBH
Scale:	AS SHOWN
Sheet Title	DETENTION POND PLAN

Sheet No.	C3.07
Sheet Number	

BENCHMARKS:
CITY BENCHMARK NO. 1 = ALUMINUM DISK STAMPED "CITY OF ROCKWALL SURVEY MONUMENT" IN HARRY MYERS PARK NORTHEAST OF THE WESTERLY BASEBALL FIELD (FIELD #1) RIGHT FIELD FENCE. STATE PLANE COORDINATES: 7,028,087.646 N, 2,597,870.985 W. ELEVATION = 523.27'
CITY BENCHMARK NO. 6 = ALUMINUM DISK STAMPED "CITY OF ROCKWALL SURVEY MONUMENT" IN GRASS MEDIAN ±387' WEST OF INTERSECTION OF JOHN KING BLVD. AND AIRPORT RD. ±100' SOUTH OF AIRPORT RD. CL. ELEVATION = 558.61'

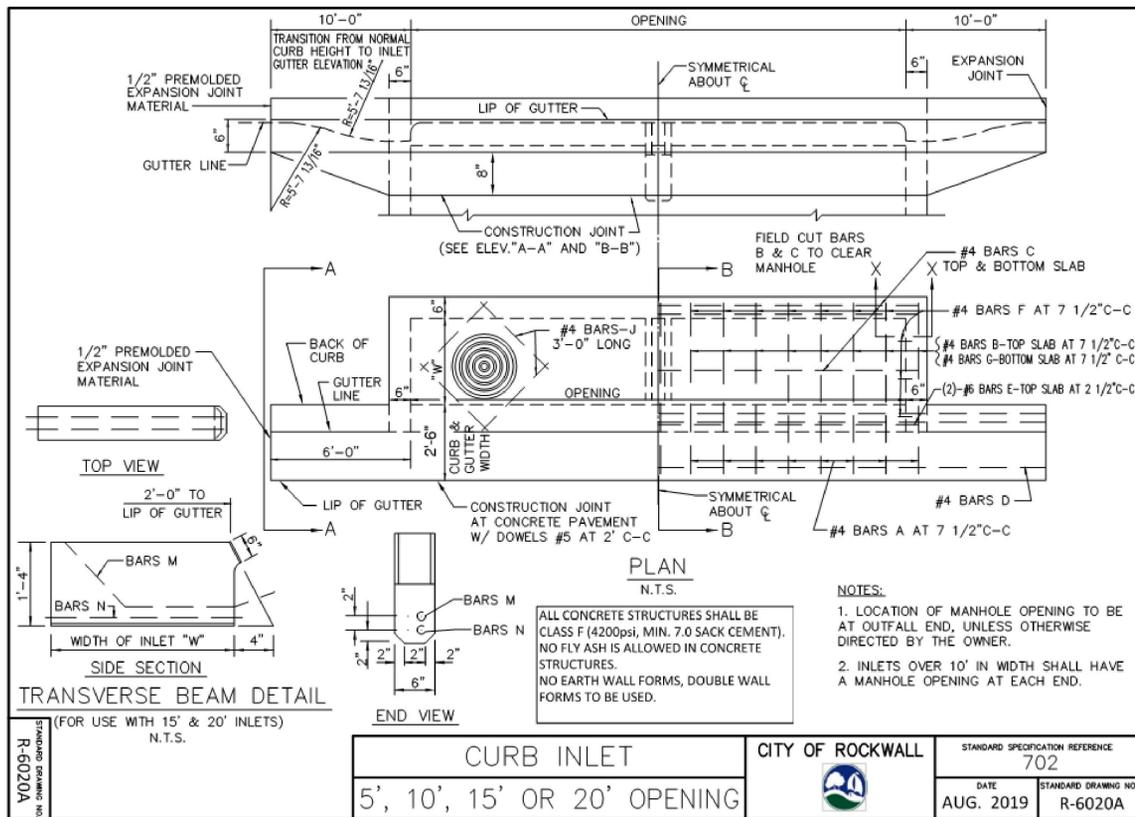


CURB INLET
5', 10', 15' OR 20' OPENING

CITY OF ROCKWALL

STANDARD SPECIFICATION REFERENCE: 702

DATE: AUG. 2019

STANDARD DRAWING NO.: R-6020A

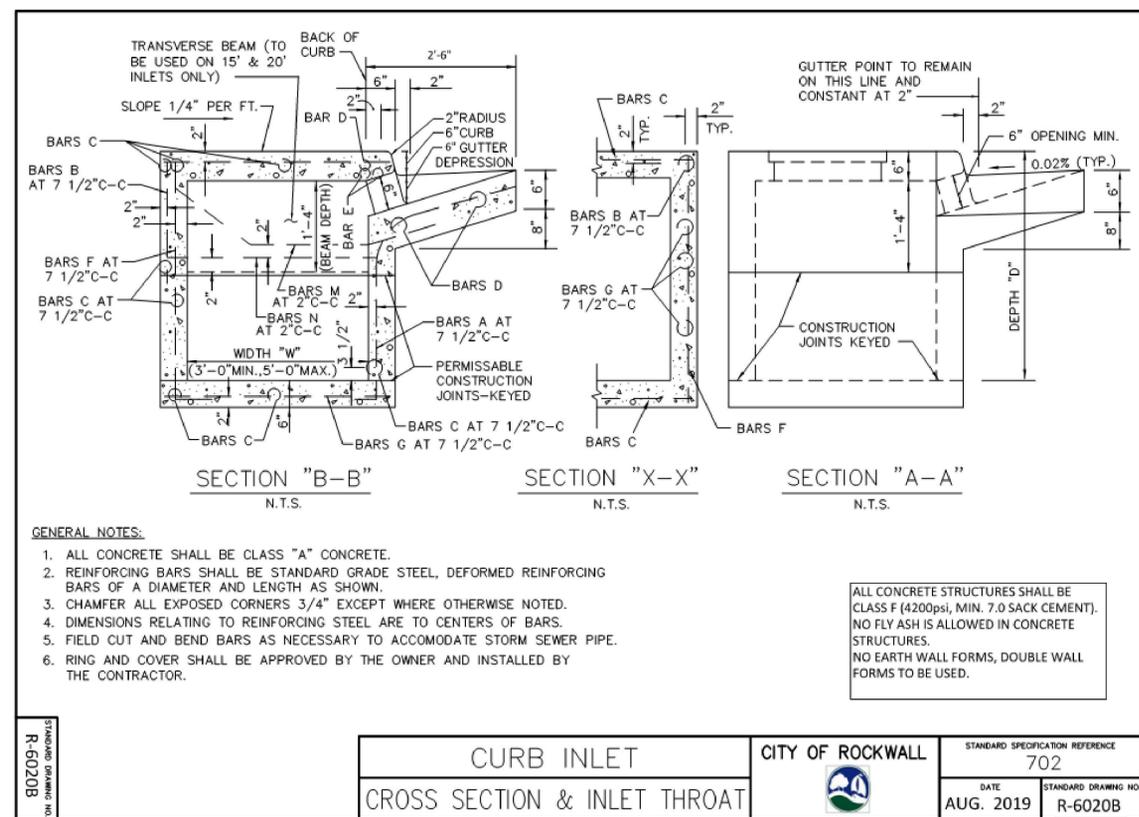


CURB INLET
CROSS SECTION & INLET THROAT

CITY OF ROCKWALL

STANDARD SPECIFICATION REFERENCE: 702

DATE: AUG. 2019

STANDARD DRAWING NO.: R-6020B

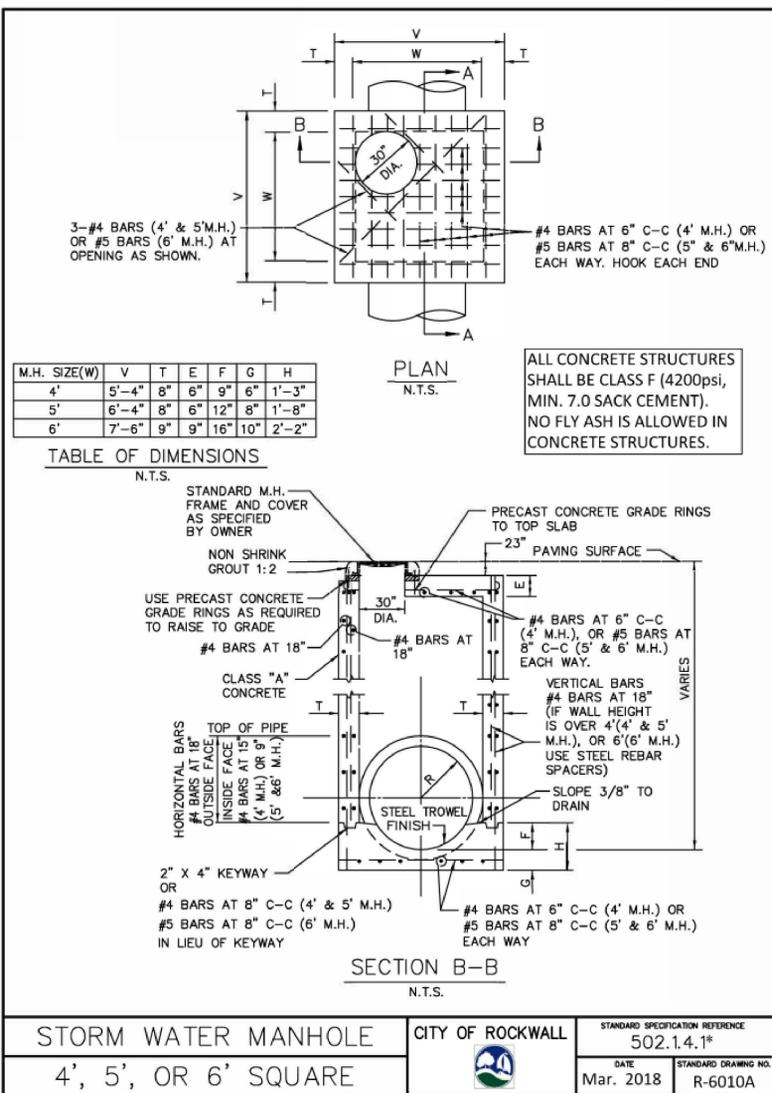


STORM WATER MANHOLE
4', 5', OR 6' SQUARE

CITY OF ROCKWALL

STANDARD SPECIFICATION REFERENCE: 502.14.1*

DATE: Mar. 2018

STANDARD DRAWING NO.: R-6010A

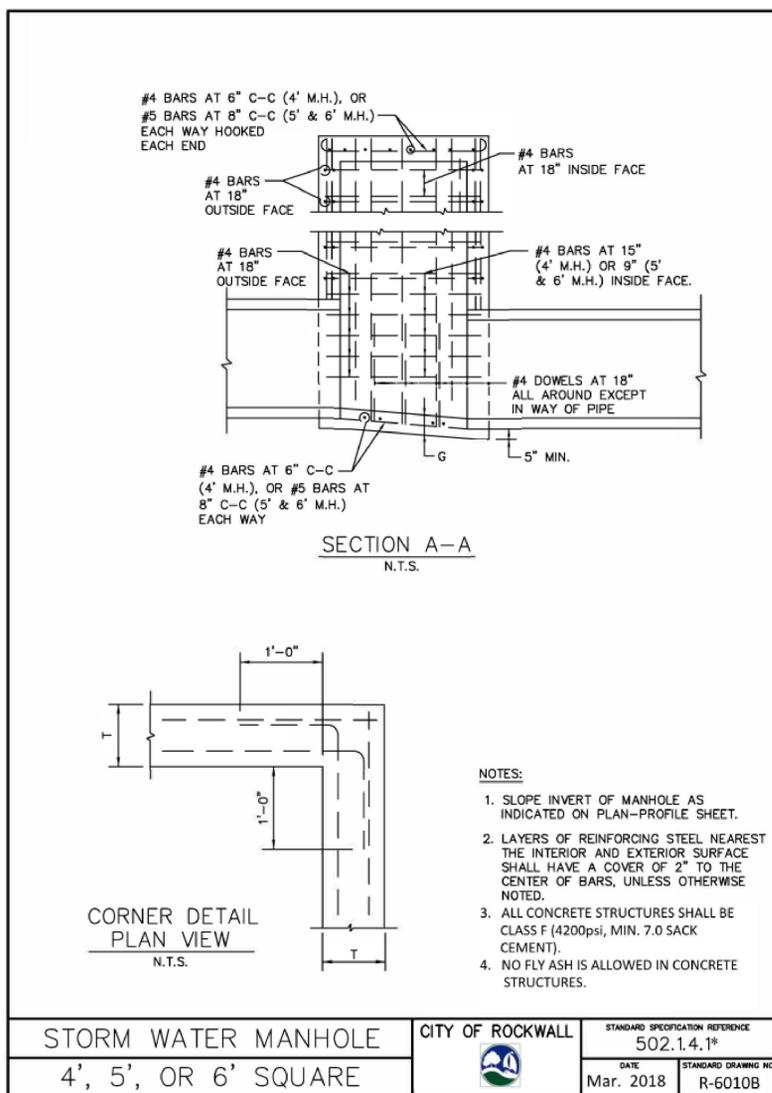


STORM WATER MANHOLE
4', 5', OR 6' SQUARE

CITY OF ROCKWALL

STANDARD SPECIFICATION REFERENCE: 502.14.1*

DATE: Mar. 2018

STANDARD DRAWING NO.: R-6010B

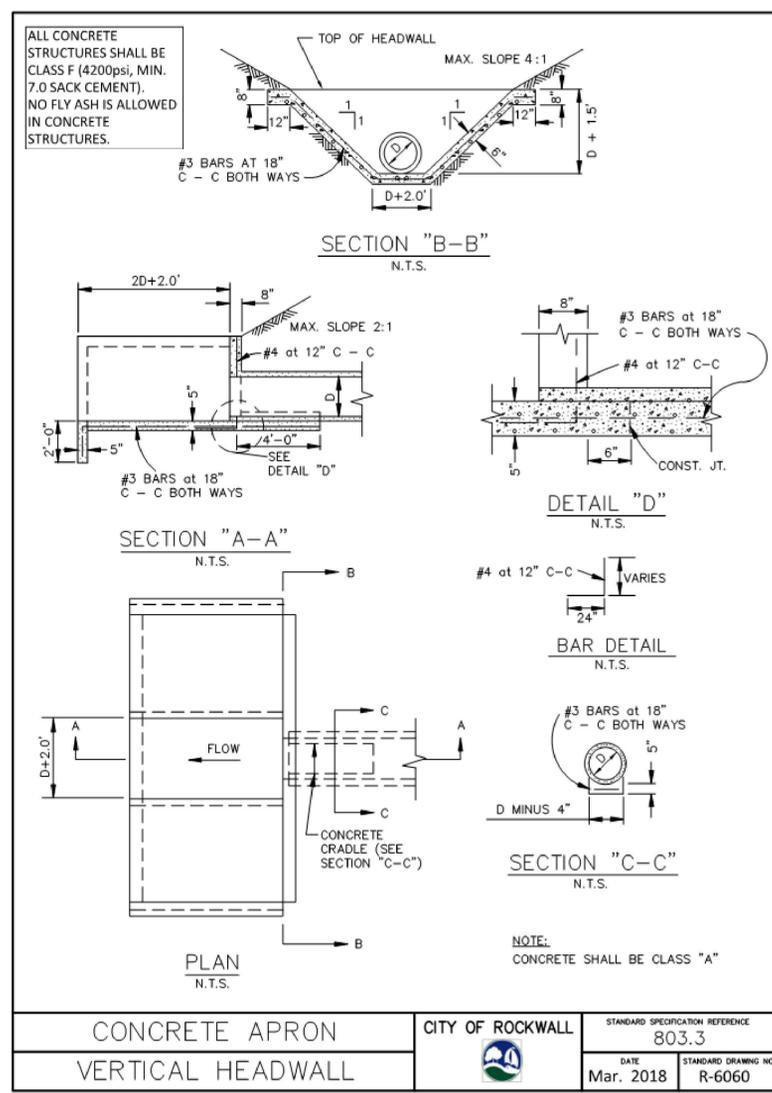

CONCRETE APRON VERTICAL HEADWALL

CITY OF ROCKWALL

STANDARD SPECIFICATION REFERENCE: 803.3

DATE: Mar. 2018

STANDARD DRAWING NO.: R-6060

RECORD DRAWING
NOVEMBER 24, 2020

THESE RECORD DRAWINGS HAVE BEEN PREPARED BASED ON FIELD OBSERVATIONS AND INFORMATION PROVIDED BY THE CONTRACTOR. ELEVATIONS HAVE NOT BEEN FIELD VERIFIED. THE ORIGINAL SEALED CONSTRUCTION DRAWINGS ARE ON FILE AT THE OFFICES OF HALFF ASSOCIATES, INC. TBPE FIRM F-312.

ENGINEER OF RECORD
DYLAN B. HEDRICK
HALFF ASSOCIATES, INC. TBPE FIRM F-312
DATE: NOVEMBER 24, 2020

Project No.: 38050
Issued: NOVEMBER 2020
Drawn By: REP
Checked By: DBH
Scale: AS SHOWN
Sheet Title: STORM DRAIN DETAILS
Sheet Number: C3.09




Revision No.	Date	Description




Revision No.	Date	Description
1	4/11/2020	WATER LINE PER CITY COMMENTS
2	5/14/2020	SANITARY SEWER
3	6/10/2020	SANITARY SEWER

Project No.	Issued	Drawn By	Checked By	Scale
38050	NOVEMBER 2020	REP	DBH	AS SHOWN

Sheet Title	Utility Plan
C4.01	Sheet Number

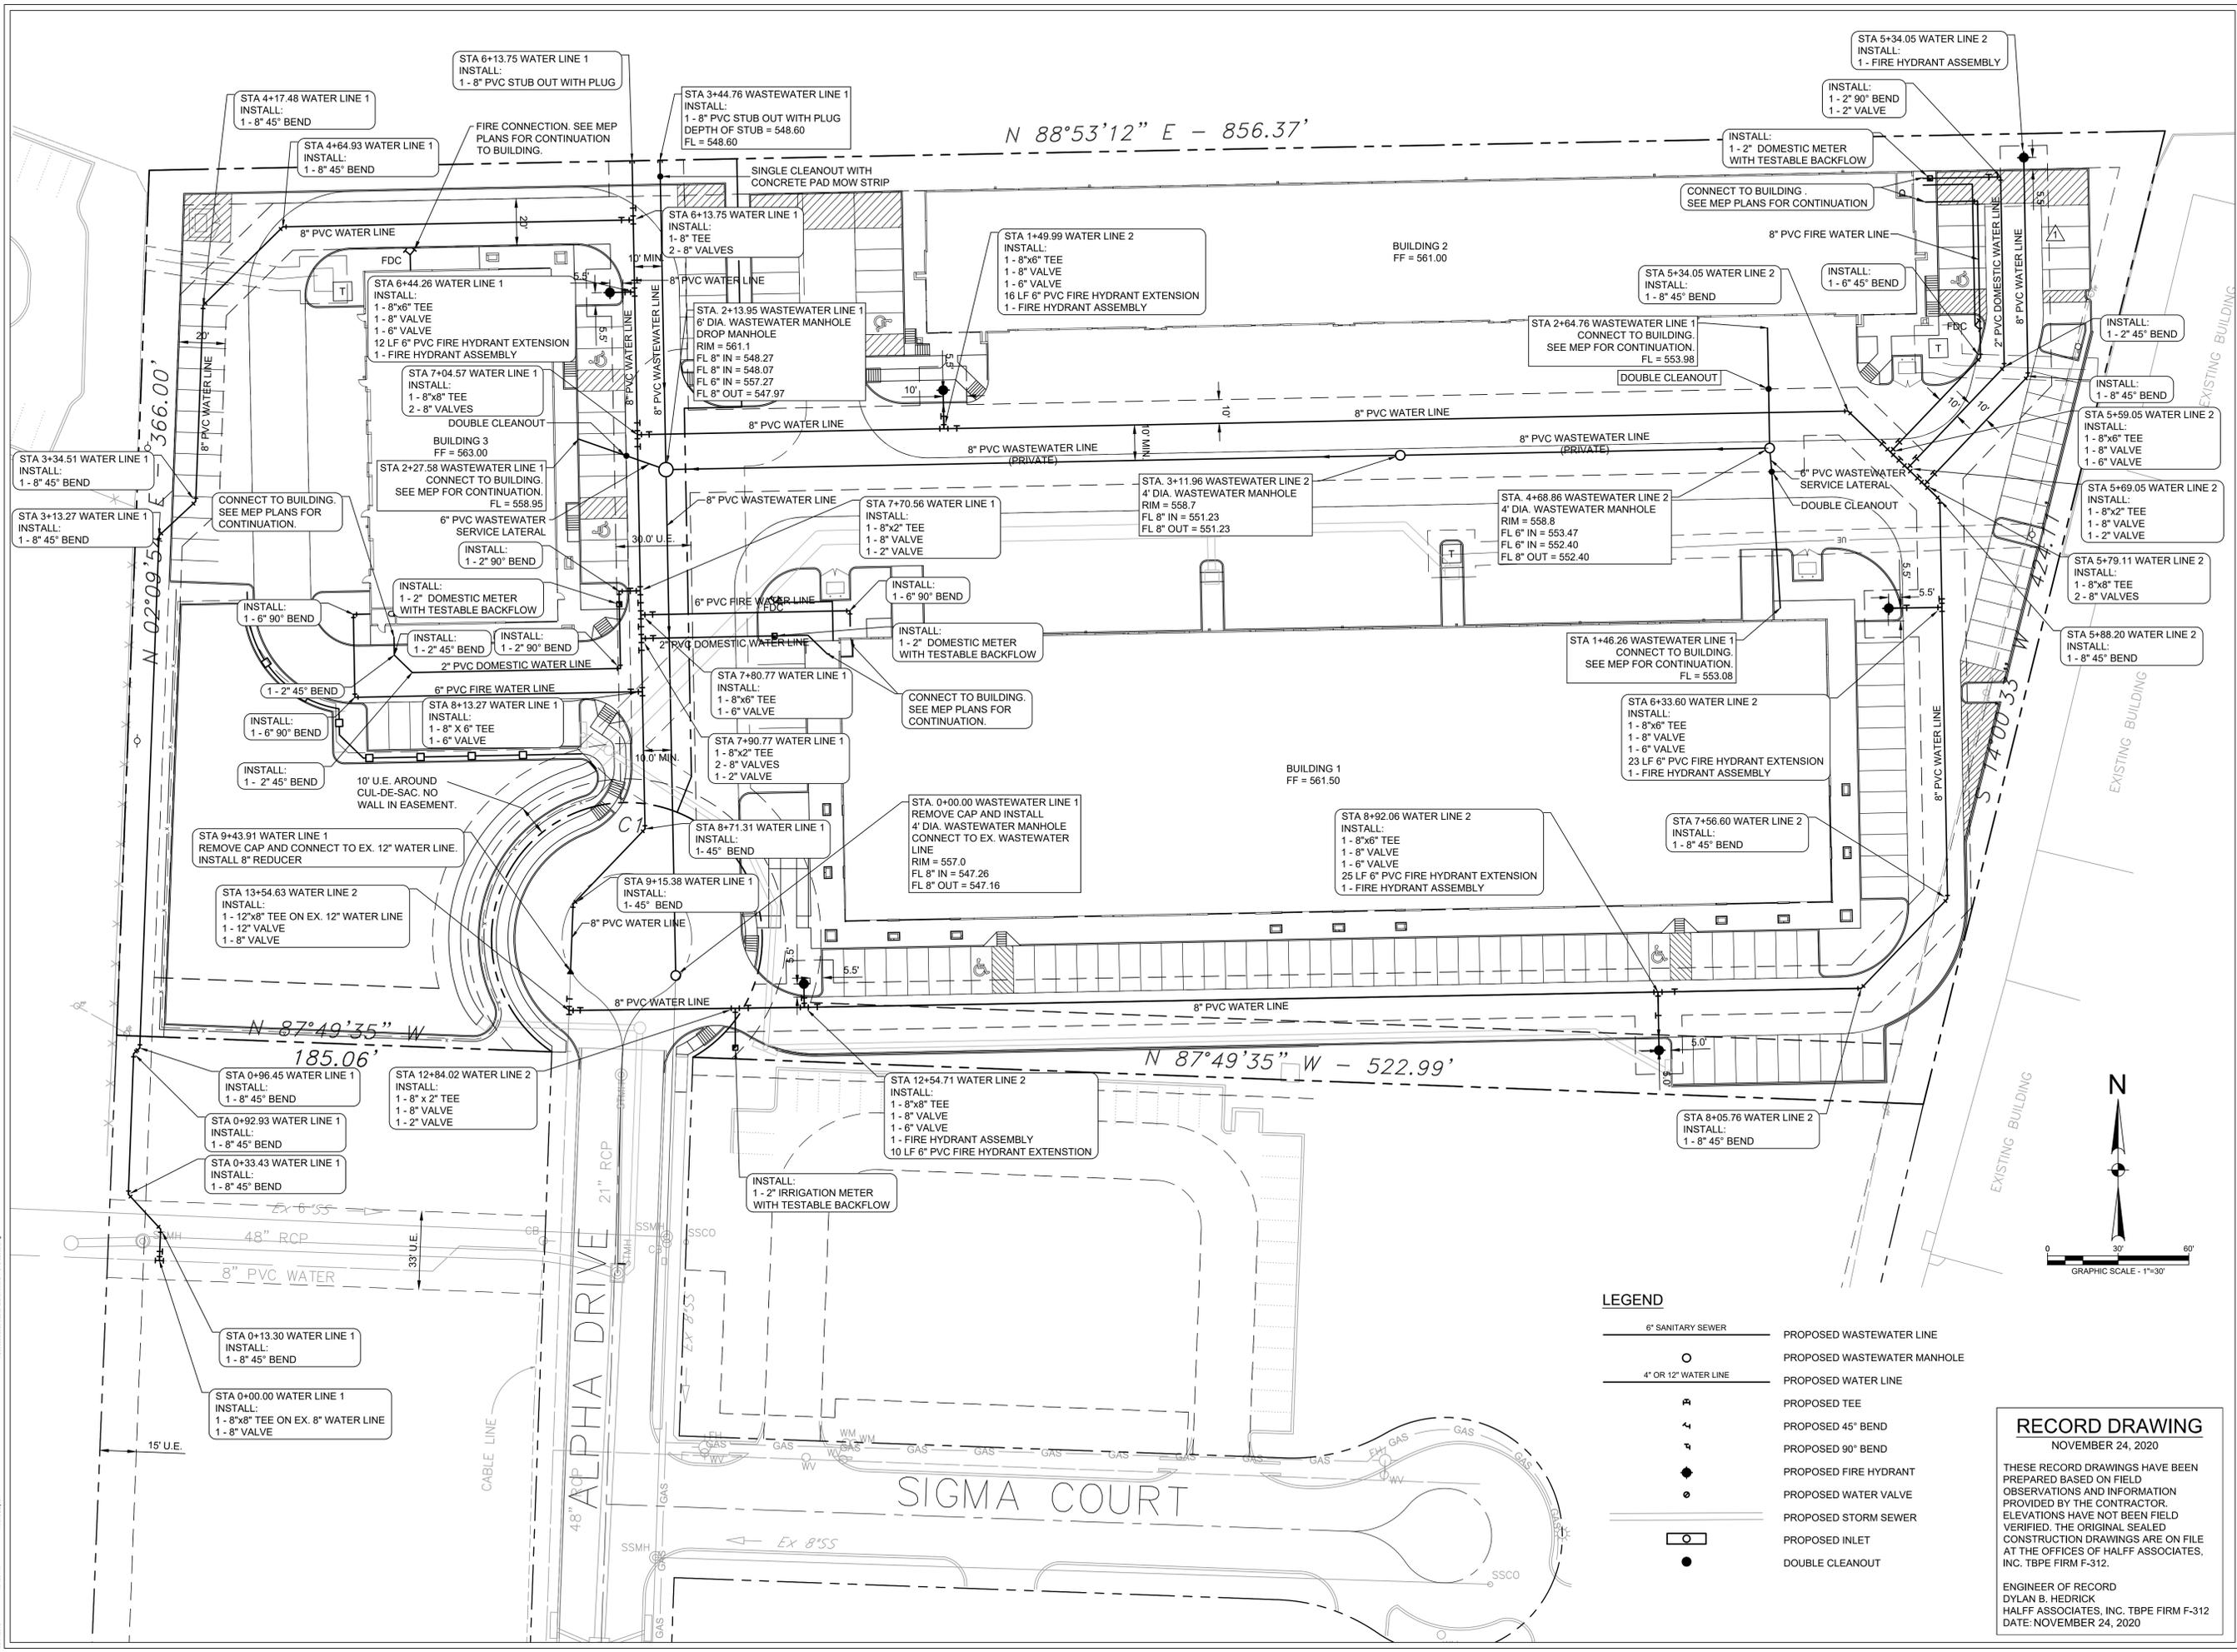

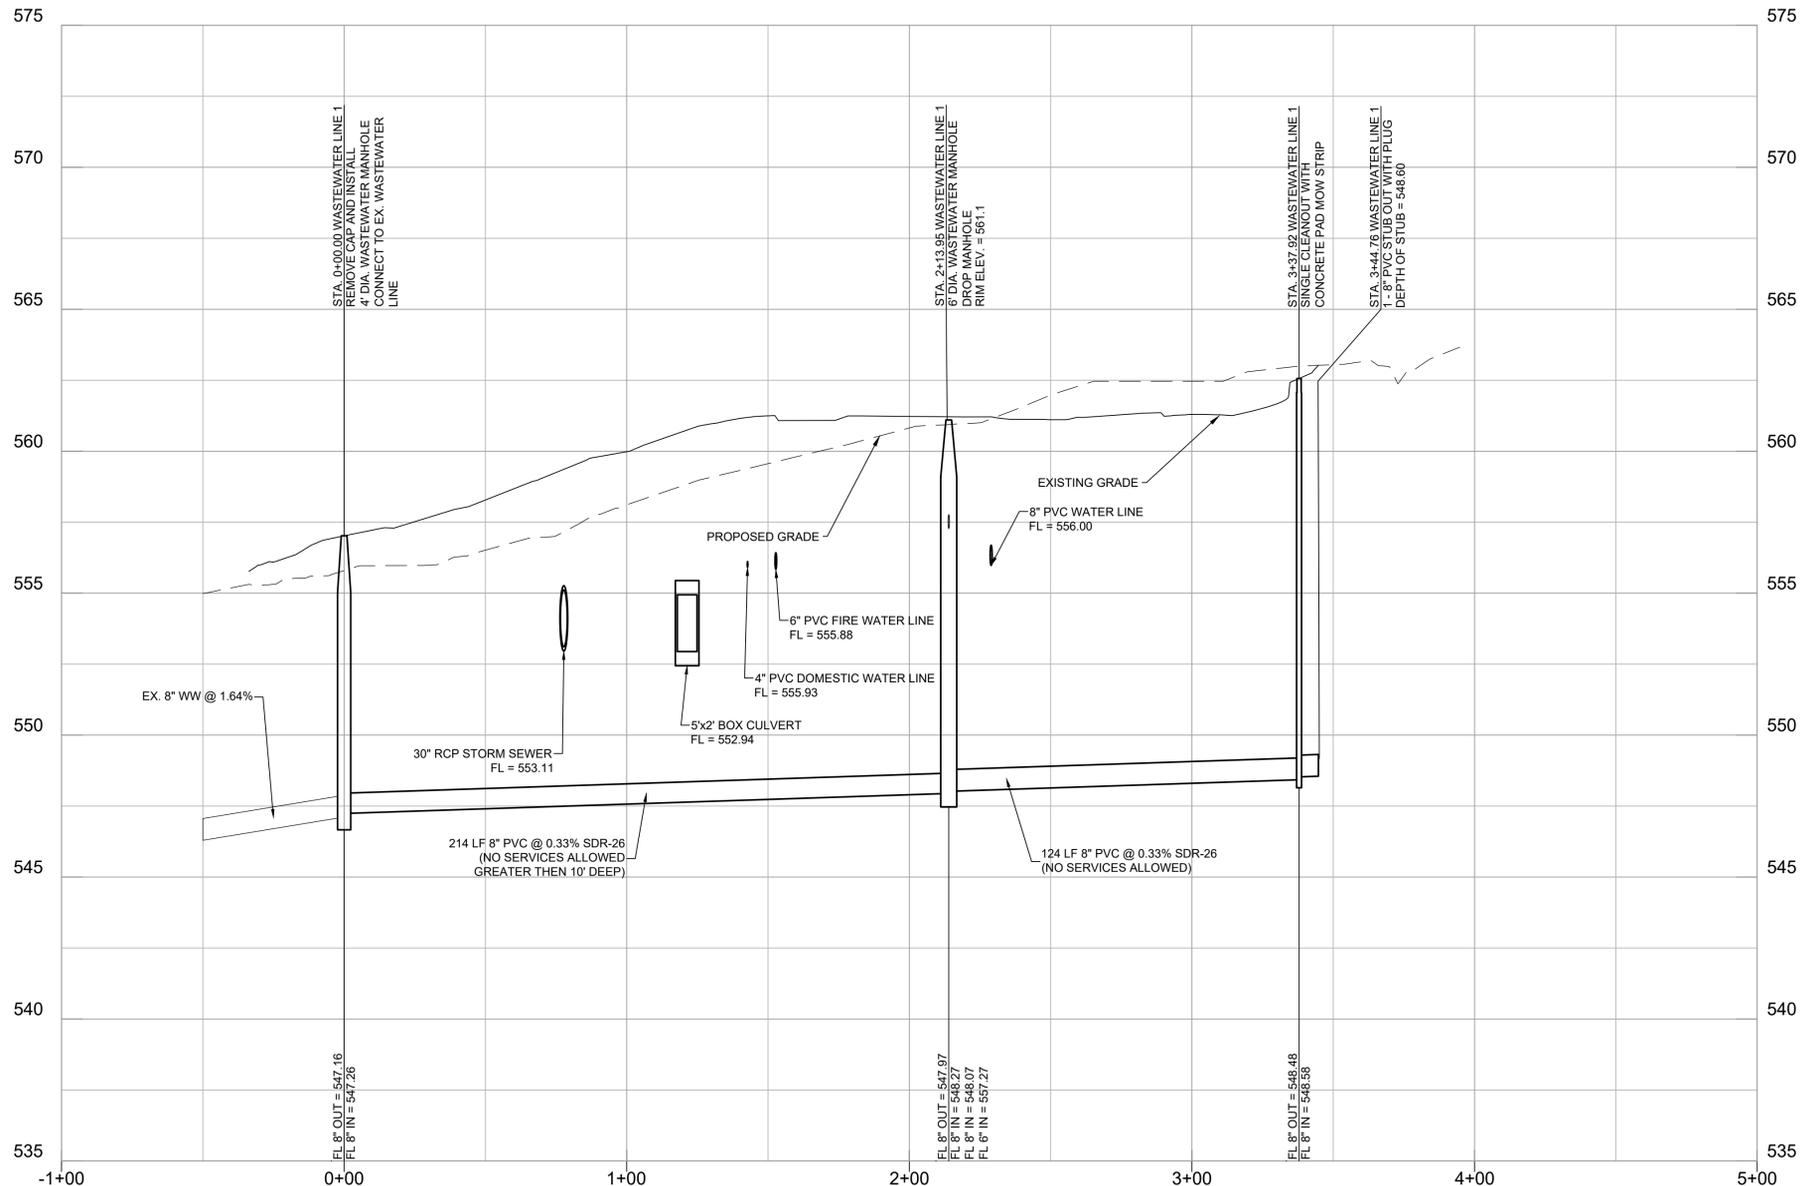

WASTEWATER LINE 1 PROFILE

ROCKWALL URBAN + INDUSTRIAL CENTER
 END OF ALPHA DRIVE
 ROCKWALL, TX 75087



Revision No.	Date	Description
1	5/14/2020	SANITARY SEWER


RECORD DRAWING
 NOVEMBER 24, 2020

THESE RECORD DRAWINGS HAVE BEEN PREPARED BASED ON FIELD OBSERVATIONS AND INFORMATION PROVIDED BY THE CONTRACTOR. ELEVATIONS HAVE NOT BEEN FIELD VERIFIED. THE ORIGINAL SEALED CONSTRUCTION DRAWINGS ARE ON FILE AT THE OFFICES OF HALFF ASSOCIATES, INC. TBPE FIRM F-312.

ENGINEER OF RECORD
 DYLAN B. HEDRICK
 HALFF ASSOCIATES, INC. TBPE FIRM F-312
 DATE: NOVEMBER 24, 2020

Project No.:	38050
Issued:	NOVEMBER 2020
Drawn By:	REP
Checked By:	DBH
Scale:	AS SHOWN
Sheet Title	WASTEWATER PROFILE
Sheet Number	C4.02

1:5000 XREF: 10/14/2019 10:40:00 AM 1:5000 XREF: 10/14/2019 10:40:00 AM

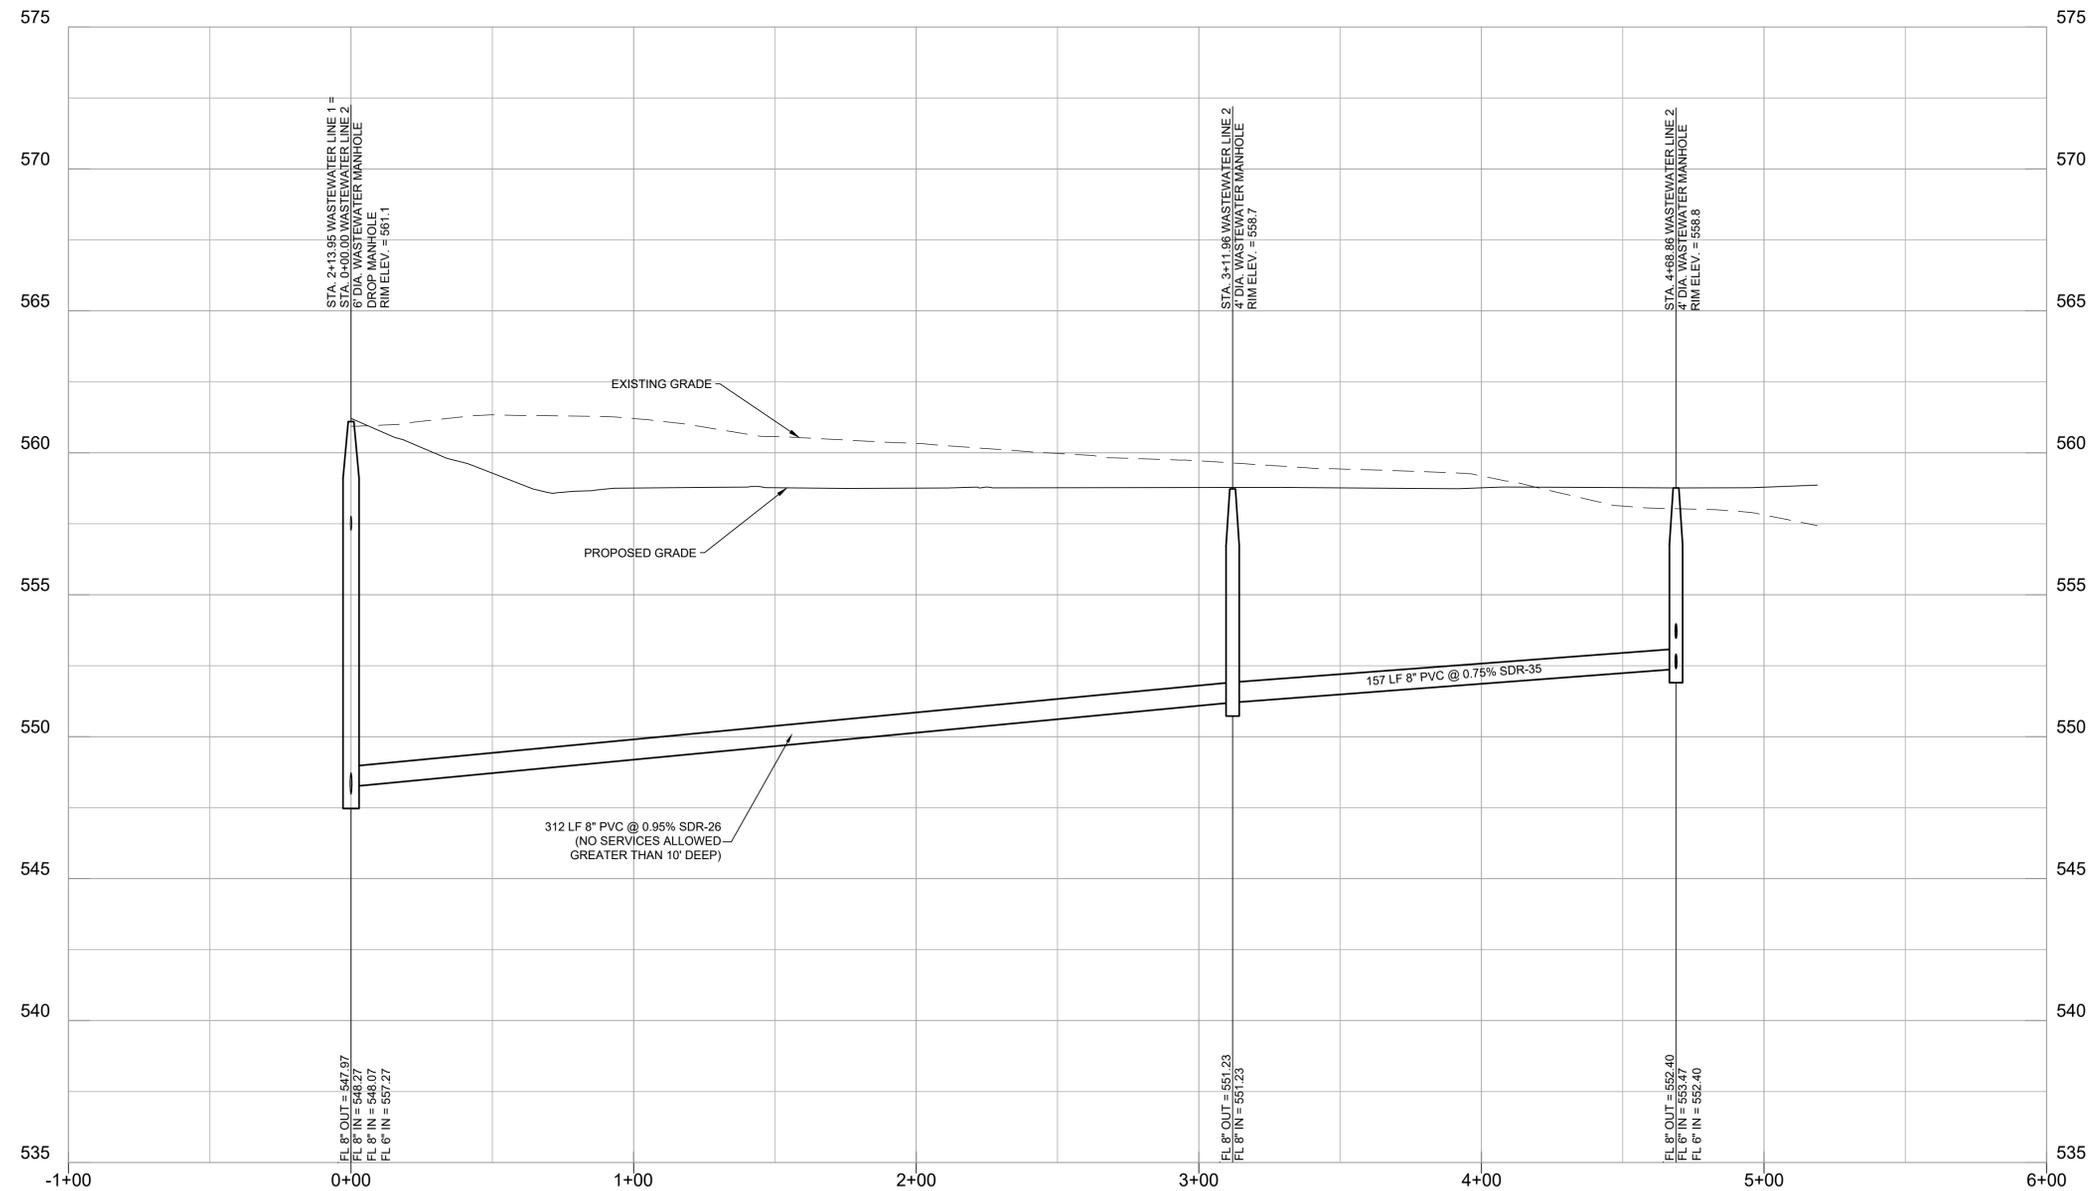

WASTEWATER LINE 2 PROFILE

1/24/20 11:54:08 AM H:\DWG\DWG\2020\38050\38050-01.dwg

RECORD DRAWING
 NOVEMBER 24, 2020

THESE RECORD DRAWINGS HAVE BEEN PREPARED BASED ON FIELD OBSERVATIONS AND INFORMATION PROVIDED BY THE CONTRACTOR. ELEVATIONS HAVE NOT BEEN FIELD VERIFIED. THE ORIGINAL SEALED CONSTRUCTION DRAWINGS ARE ON FILE AT THE OFFICES OF HALFF ASSOCIATES, INC. TBPE FIRM F-312.


ENGINEER OF RECORD
 DYLAN B. HEDRICK
 HALFF ASSOCIATES, INC. TBPE FIRM F-312
 DATE: NOVEMBER 24, 2020

ROCKWALL URBAN + INDUSTRIAL CENTER
 END OF ALPHA DRIVE
 ROCKWALL, TX 75087



Revision No.	Date	Description

Project No.:	38050
Issued:	NOVEMBER 2020
Drawn By:	REP
Checked By:	DBH
Scale:	AS SHOWN
Sheet Title	WASTEWATER PROFILE
Sheet Number	C4.03

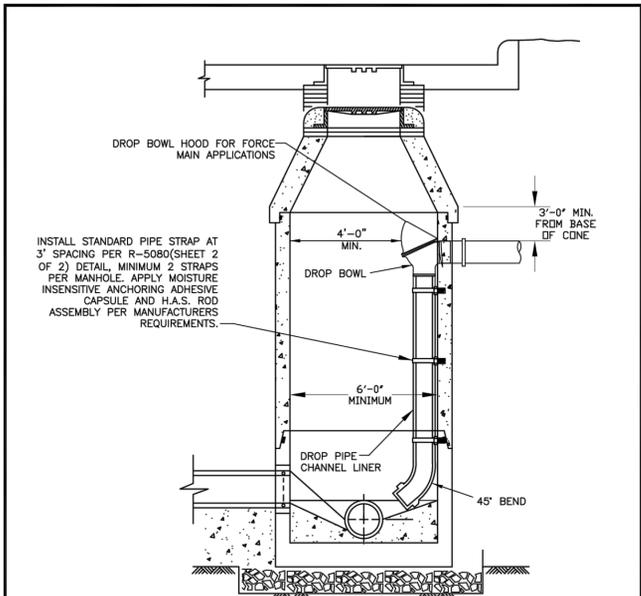


ELEVATION
N.T.S.

NOTE:
1. DROP BOWL, DROP PIPE CHANNEL LINER AND STAINLESS STEEL PIPE CLAMPS AS MANUFACTURED BY RELINER/DURAN INC. OR APPROVED EQUAL.

SHEET 1 OF 2


WASTEWATER MANHOLE	CITY OF ROCKWALL	DATE	DRAWING NO.
DROP CONNECTIONS		AUG '19	R-5080

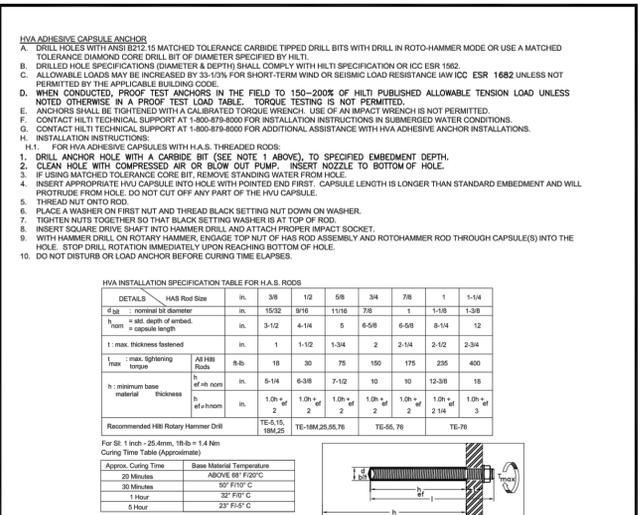

- INSTALLATION INSTRUCTIONS:
- SET THE DRILL DEPTH GAUGE AND DRILL A HOLE TO THE REQUIRED HOLE DEPTH. IMPORTANT: CLEAN OUT DUST AND DEBRIS. USE COMPRESSED AIR OR VACUUM AT BOTTOM OF THE HOLE. WHEN USING THE HILTI MATCHED TOLERANCE DIAMOND CORE BIT, IMMEDIATELY REMOVE STANDING WATER.
 - INSERT APPROPRIATE DIAMETER HVA ADHESIVE CAPSULE INTO PRE-DRILLED HOLE IN BASE MATERIAL. NOTE: THE BEST METHOD FOR SETTING MULTIPLE CAPSULES IS TO CRUSH THE FIRST CAPSULE(S) INTO THE HOLE AND THEN INSERT THE NEXT CAPSULE. DO NOT CUT OFF CAPSULES PARTIALLY PROTRUDING FROM THE HOLE.
 - CAPSULE LENGTH IS LONGER THAN STANDARD EMBED. DEPTH AND WILL PROTRUDE FROM THE HOLE.
 - THREAD A H.A.S. NUT ON THE H.A.S. ROD. PLACE A WASHER ON TOP OF THE FIRST NUT AND THEN THREAD A BLACK SETTING NUT DOWN ON TOP OF THE WASHER. TIGHTEN THE TWO NUTS TOGETHER "LOCKING" THE WASHER BETWEEN THEM. THE TOP NUT SHOULD BE FLUSH WITH THE TOP OF THE ROD.
 - INSERT A SQUARE DRIVE SHAFT INTO THE HAMMER DRILL AND ATTACH THE PROPER IMPACT SOCKET. AT THE ROTARY HAMMER DRILL SETTING, ENGAGE THE TOP NUT OF THE HAS ROD ASSEMBLY WITH THE SOCKET AND DRIVE THE ROD DOWN THROUGH THE CAPSULE(S). STOP DRILL ROTATION IMMEDIATELY UPON REACHING BOTTOM OF HOLE.
 - DO NOT DISTURB OR LOAD THE SET ANCHOR BEFORE THE SPECIFIED CURING TIME ELAPSES.

SHEET 2 OF 2

WASTEWATER MANHOLE	CITY OF ROCKWALL	DATE	DRAWING NO.
DROP CONNECTIONS		AUG '19	R-5080

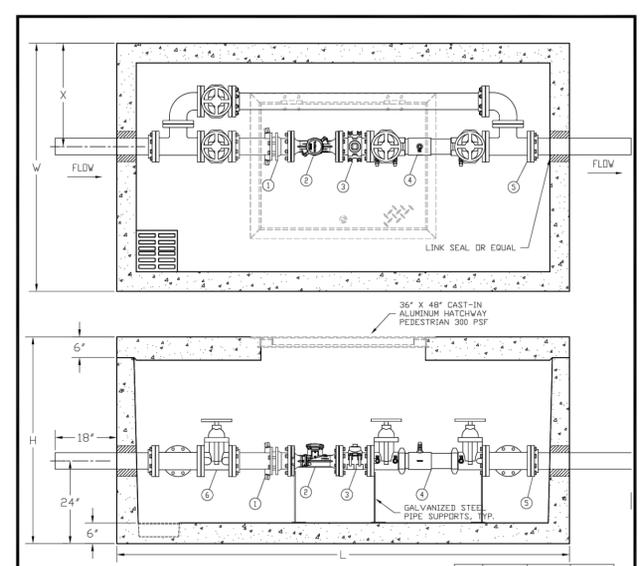


SIZE	L	W	H
3"	11'-0"	6'-0"	5'-0"
4"	8'-0"	5'-0"	5'-0"
6"	11'-0"	6'-0"	5'-0"

- NOTES:
- CONCRETE SHALL HAVE MIN STRENGTH OF 4200 PSI AT 28 DAYS. NO CAST IN PLACE VAULTS SHALL BE ALLOWED.
 - REINFORCEMENT SHALL BE GRADE 60, STEEL BAR SHALL CONFORM TO ASTM A615 ON REQUIRED CENTERS OR EQUALS.
 - ACCESS IS 1/4" ALUMINUM DIAMOND PLATE COVER WITH ALUMINUM FRAME. HATCH TO BE FURNISHED WITH 316 STAINLESS STEEL SLAM LOCK & HINGES.

ITEM	DESCRIPTION
1	FLANGE COUPLING ADAPTER
2	MASTER METER OCTAVE METER
3	STRAPPING SADDLE 1/2" NPT PLUG
4	DOUBLE CHECK ASSEMBLY
5	FLG X P.E. SPOOL, D.I.
6	FLG NRS GATE VALVE

IRRIGATION WATER METER VAULT	CITY OF ROCKWALL	DATE	DRAWING NO.
3", 4" OR 6" LINE		AUG '19	R-4160

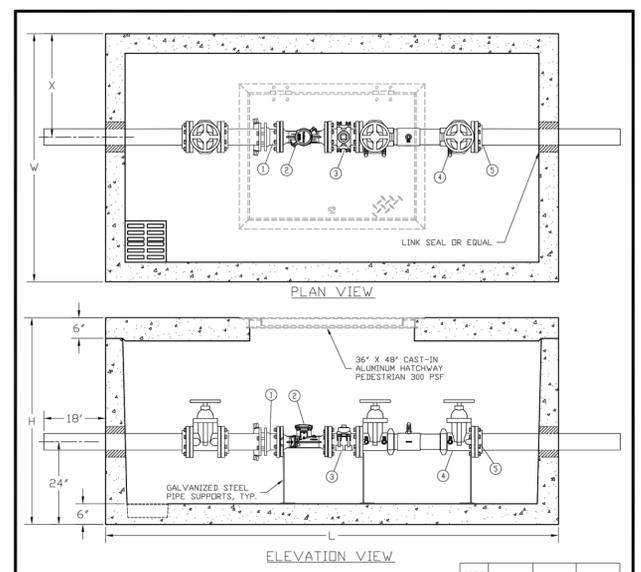

SIZE	L	W	H
3"	11'-0"	6'-0"	5'-0"
4"	8'-0"	5'-0"	5'-0"
6"	11'-0"	6'-0"	5'-0"

- NOTES:
- CONCRETE SHALL HAVE MIN STRENGTH OF 4200 PSI AT 28 DAYS. NO CAST IN PLACE VAULTS SHALL BE ALLOWED.
 - REINFORCEMENT SHALL BE GRADE 60, STEEL BAR SHALL CONFORM TO ASTM A615 ON REQUIRED CENTERS OR EQUALS.
 - ACCESS IS 1/4" ALUMINUM DIAMOND PLATE COVER WITH ALUMINUM FRAME. HATCH TO BE FURNISHED WITH 316 STAINLESS STEEL SLAM LOCK & HINGES.

ITEM	DESCRIPTION
1	FLANGE COUPLING ADAPTER
2	MASTER METER OCTAVE METER
3	STRAPPING SADDLE W/2" NPT PLUG
4	DOUBLE CHECK ASSEMBLY
5	FLG X P.E. SPOOL, D.I.

IRRIGATION WATER METER VAULT	CITY OF ROCKWALL	DATE	DRAWING NO.
3", 4" OR 6" LINE		AUG '19	R-4170

RECORD DRAWING
NOVEMBER 24, 2020

THESE RECORD DRAWINGS HAVE BEEN PREPARED BASED ON FIELD OBSERVATIONS AND INFORMATION PROVIDED BY THE CONTRACTOR. ELEVATIONS HAVE NOT BEEN FIELD VERIFIED. THE ORIGINAL SEALED CONSTRUCTION DRAWINGS ARE ON FILE AT THE OFFICES OF HALFF ASSOCIATES, INC. TBPE FIRM F-312.

ENGINEER OF RECORD
DYLAN B. HEDRICK
HALFF ASSOCIATES, INC. TBPE FIRM F-312
DATE: NOVEMBER 24, 2020

ROCKWALL URBAN + INDUSTRIAL CENTER
END OF ALPHA DRIVE
ROCKWALL, TX 75087

HALFF
1201 NORTH BOWSER ROAD
RICHARDSON, TX 75081-2275
(214) 346-6200





Revision No.	Date	Description

Project No.: 38050
Issued: NOVEMBER 2020
Drawn By: REP
Checked By: DBH
Scale: AS SHOWN
Sheet Title
UTILITY DETAILS


C4.04
Sheet Number

STANDARD SWPP NOTES



- CONSTRUCTION ACTIVITY IN THE CITY OF ROCKWALL SHALL COMPLY WITH THE REQUIREMENTS OF THE TPDES GENERAL PERMIT TXR150000 AND ALL APPLICABLE CITY OF ROCKWALL ORDINANCES.
- NO CONSTRUCTION RELATED ACTIVITIES MAY BEGIN ON THE PROJECT SITE UNTIL A STORM WATER POLLUTION PREVENTION PLAN (SWPPP) HAS BEEN ACCEPTED BY THE CITY, AND THE CITY AND/OR CONTRACTOR SITE NOTICES ARE POSTED ON SITE. SWPPP DOCUMENTATION AND RECORDS SHALL BE MAINTAINED ON SITE THROUGHOUT CONSTRUCTION.
- IF FIVE (5) ACRES OR GREATER WILL BE DISTURBED, A NOI MUST BE SUBMITTED TO TCEQ AND THE CITY PRIOR TO THE START OF CONSTRUCTION RELATED ACTIVITIES.
- REVISIONS TO THE SWPPP SHALL BE DATED AND INITIALED BY THE PERMITTEE OR HIS REPRESENTATIVE.
- AREAS TO REMAIN UNDISTURBED AND/OR TO BE PROTECTED DURING CONSTRUCTION (INCLUDING ALL WATERBODIES, WETLAND AREAS, EROSION CLEAR ZONES, DRIP LINE OF TREES TO REMAIN AFTER CONSTRUCTION, NATURAL AREAS, ETC.) SHALL BE CLEARLY DELINEATED PRIOR TO THE START OF CONSTRUCTION.
- SEDIMENT AND EROSION CONTROL DEVICES SHALL BE INSTALLED AND FUNCTIONING PRIOR TO ANY EARTH DISTURBING ACTIVITIES. THEY SHALL REMAIN IN PLACE UNTIL THE COMPLETION OF ALL CONSTRUCTION ACTIVITIES AND/OR UNTIL ALL DISTURBED AREAS HAVE BEEN PERMANENTLY STABILIZED.
- REFER TO THE CITY OF ROCKWALL DESIGN CRITERIA MANUAL AND THE ISWM CONSTRUCTION CONTROLS MANUAL FOR SELECTION AND DESIGN OF STORMWATER CONTROLS.
- CONSTRUCTION WASTE, DEBRIS AND SOIL BLOWN, TRACKED OR WASHED FROM THE SITE DURING CONSTRUCTION ACTIVITY SHALL BE CLEANED UP DAILY.
- EROSION CONTROL PLANS ARE CONSIDERED MINIMUM REQUIREMENTS. ADDITIONAL CONTROL DEVICES MAY BE REQUIRED DURING CONSTRUCTION IN ORDER TO CONTROL EROSION AND SEDIMENTATION.
- WETLANDS AND STREAMS SHALL BE PROTECTED AT ALL TIMES DURING CONSTRUCTION WITH EROSION AND SEDIMENT CONTROLS AS WELL AS NATURAL BUFFERS. ALL APPLICABLE PERMITS MUST BE OBTAINED PRIOR TO CONSTRUCTION IN FLOODPLAIN, WETLANDS AND/OR STREAMS. ANY WORK IN A FLOODPLAIN AND/OR STREAM SHALL COMPLY WITH ALL APPLICABLE FEDERAL, STATE AND LOCAL REGULATIONS AND PERMITS.
- IF SOIL DISTURBANCE IS OCCURRING WITHIN A CITY OF ROCKWALL EASEMENT, AN EASEMENT USE AGREEMENT MUST BE OBTAINED PRIOR TO CONSTRUCTION.
- A STABILIZED CONSTRUCTION ENTRANCE SHALL BE INSTALLED AND MAINTAINED ON THE PROJECT SITE.
- STORM WATER INLET PROTECTION SHALL BE PROVIDED FOR ALL INLETS (UPSTREAM AND DOWNSTREAM) WITHIN 50 FT. OF THE CONSTRUCTION ENTRANCE (ON BOTH SIDES OF THE PUBLIC ROADWAY).
- TO SECURE THE PROJECT SITE, LOCATE LIMITS OF CONSTRUCTION, PROTECT AREAS THAT ARE TO REMAIN UNDISTURBED, AND PREVENT MIGRATION OF CONSTRUCTION DEBRIS.
- CARE SHALL BE TAKEN WHEN INSTALLING STORMWATER CONTROLS TO NOT OBSCURE ONCOMING TRAFFIC AT INTERSECTIONS, ADJACENT DRIVEWAYS AND THE PROJECT CONSTRUCTION ENTRANCE.
- A QUALIFIED REPRESENTATIVE OF EACH OPERATOR SHALL INSPECT THE CONSTRUCTION ACTIVITY EITHER ONCE EVERY 14 CALENDAR DAYS AND WITHIN 24 HOURS OF A STORM EVENT OF 1/4-INCH OR GREATER OR WEEKLY AT A SPECIFIED DAY AND TIME REGARDLESS OF PRECIPITATION. A WRITTEN SWPPP INSPECTION REPORT SHALL BE COMPLETED FOR EACH INSPECTION.
- AT A MINIMUM, SEDIMENT SHALL BE REMOVED FROM CONTROLS WHEN THEIR CAPACITY IS REDUCED BY 50% UNLESS MORE FREQUENT CLEANING IS SPECIFIED IN THE SWPPP.
- IF ANY CONTROL IS FOUND TO BE INEFFECTIVE, INSTALLED INCORRECTLY, OR DAMAGED, IT SHALL BE MODIFIED OR REPLACED WITHIN 7 DAYS OF INSPECTION OR AS REQUIRED BY THE CITY.
- ALL EXISTING AND NEW STORM WATER STRUCTURES, AFFECTED BY THIS PROJECT, SHALL BE INSPECTED AND MAINTAINED ON THE SAME SCHEDULE AS THE STORMWATER CONTROLS. SEDIMENT DISCHARGED INTO THE MUNICIPAL SEPARATE STORM SEWER SYSTEM (STREETS, GUTTERS, STORM DRAINS, FLUMES, CHANNELS, ETC.) FROM THE CONSTRUCTION ACTIVITY SHALL BE NOTED IN THE SWPPP INSPECTIONS AND SHALL BE REMOVED WITHIN 7 DAYS OF INSPECTION OR AS REQUIRED BY THE CITY.
- DURING DRY AND WINDY PERIODS, DISTURBED SOIL SHALL BE SPRINKLED WITH WATER UNTIL DAMPENED AND REPEATED AS NEEDED TO PREVENT DUST GENERATION.
- STABILIZATION MEASURES SHALL BE INITIATED AS SOON AS PRACTICABLE IN PORTIONS OF THE SITE WHERE CONSTRUCTION ACTIVITIES HAVE TEMPORARILY OR PERMANENTLY CEASED, BUT IN NO CASE MORE THAN FOURTEEN (14) DAYS AFTER WORK HAS CEASED.
- THE CONTRACTOR SHALL DESIGNATE AN AREA TO BE USED FOR CONCRETE WASH WATER. A PIT LARGE ENOUGH TO CONTAIN THE WASH WATER WITHOUT OVERFLOWING SHALL BE EXCAVATED. IF CONCRETE PLACEMENT WILL OCCUR OVER A PERIOD OF TIME GREATER THAN A WEEK, A SIGN DESIGNATING THE AREA AS THE CONCRETE WASHOUT AREA SHALL BE POSTED IN A LOCATION VISIBLE FROM THE STREET.
- SLURRY FROM CONCRETE SAWCUTTING SHALL BE VACUUMED OR RECOVERED BY OTHER MEANS FOR PROPER DISPOSAL. IF A CURB INLET IS NEAR THE PAVEMENT TO BE CUT, THE INLET SHALL BE BLOCKED WITH SANDBAGS DURING SAWCUTTING TO PREVENT SLURRY FROM ENTERING THE STORM DRAIN.
- TEMPORARY CONSTRUCTION CROSSINGS IN OR ACROSS ANY WATER BODY OR WETLAND SHALL NOT BE INSTALLED WITHOUT THE PRIOR APPROVAL OF THE APPROPRIATE RESOURCE AGENCIES AND THE CITY.
- DISPOSAL OF ALL RECOVERED SEDIMENTS, CONSTRUCTION DEBRIS, OR OTHER POLLUTANTS SHALL BE IN ACCORDANCE WITH ALL APPLICABLE CITY, STATE AND FEDERAL REGULATIONS. NO SEDIMENTS, CONSTRUCTION DEBRIS, OR OTHER POLLUTANTS SHALL BE DISPOSED OR FLUSHED INTO THE STORM WATER SYSTEM.
- STORE ALL TRASH AND WASTE MATERIALS IN COVERED BINS OR OTHER ENCLOSURES UNTIL PROPER DISPOSAL AT OFF-SITE FACILITIES. TRASH AND WASTE SHALL BE REMOVED FROM THE SITE AT REGULAR INTERVALS TO PREVENT OVERFLOW OF THE CONTAINERS.
- TEMPORARY STOCKPILING OF USEABLE OR WASTE MATERIALS SHALL HAVE APPROPRIATE EROSION AND SEDIMENT CONTROL MEASURES INSTALLED. TEMPORARY STOCKPILES SHALL BE PLACED AWAY FROM STORM WATER INLET STRUCTURES, ADJACENT PROPERTY AND PUBLIC ROADWAYS.
- APPLICATION OF LIME OR OTHER CHEMICAL STABILIZERS SHALL BE LIMITED TO THE AMOUNT THAT CAN BE MIXED AND COMPACTED BY THE END OF EACH WORKING DAY. STABILIZER SHALL BE APPLIED AT RATES THAT RESULT IN NO RUNOFF FROM THE SITE. STABILIZATION SHALL BE DELAYED IF RAIN IS FORECAST FOR THE WORKING DAY. NO TRAFFIC OTHER THAN WATER TRUCKS AND MIXING EQUIPMENT SHALL PASS OVER THE SPREAD STABILIZER UNTIL AFTER MIXING IS COMPLETED.
- HAZARDOUS MATERIALS SHALL BE STORED IN CLOSED CONTAINERS, AND THE CONTAINERS SHALL BE PLACED IN A SHELTER THAT PREVENTS CONTACT WITH RAINFALL AND RUNOFF. THE AMOUNT OF HAZARDOUS MATERIALS STORED ON-SITE SHALL BE MINIMIZED AND LIMITED TO THE MATERIALS NECESSARY FOR THE CURRENT PHASE OF CONSTRUCTION. HAZARDOUS MATERIAL STORAGE SHALL BE IN ACCORDANCE WITH ALL FEDERAL, STATE AND LOCAL LAWS AND REGULATIONS.
- SPILLS AND RELEASES OF ANYTHING OTHER THAN STORM WATER SHALL BE IMMEDIATELY REPORTED TO THE CITY OF ROCKWALL. IN ADDITION, SPILLS AND RELEASES OF HAZARDOUS MATERIALS GREATER THAN THE REGULATED REPORTABLE QUANTITY SHALL BE REPORTED TO STATE AND FEDERAL AUTHORITIES WITHIN 24 HOURS.
- SUPER-CHLORINATED WATER FROM WATER LINE DISINFECTION SHALL NOT BE ALLOWED TO ENTER THE STORM DRAINAGE SYSTEM.
- PORTABLE TOILET FACILITIES SHALL NOT BE LOCATED WITHIN 25 FT. OF ANY STORM WATER STRUCTURE AND/OR WITHIN 50 FT. OF ANY WATERCOURSE, WETLAND AREA, STREAM, FLOODPLAIN, OR LAKE.
- DISCHARGE FROM DEWATERING ACTIVITIES SHALL BE RELEASED THROUGH AN ON-SITE SEDIMENT TRAP OR BASIN, THROUGH AN UNDISTURBED AREA THROUGH A NON-EROSIVE OUTLET, OR INTO A DIRT BAG (120Z, NON-WOVEN FABRIC) OR APPROVED EQUIVALENT LOCATED IN AN UNDISTURBED AREA.
- SMALL SITES CONSTRUCTED AS PART OF A LARGER COMMON PLAN OF DEVELOPMENT REQUIRE EROSION CONTROL FEATURES FOR INFRASTRUCTURE AS WELL AS FOR INDIVIDUAL SITE CONSTRUCTION. INDIVIDUAL SMALL CONSTRUCTION SITES SHALL FOLLOW THESE PLANS DURING CONSTRUCTION OR PROVIDE AN INDIVIDUAL PLAN.
- THE SITE SHALL BE CONSIDERED PERMANENTLY STABILIZED WHEN ALL SURFACE DISTURBING ACTIVITIES ARE COMPLETE AND A UNIFORM (E.G., EVENLY DISTURBED, WITHOUT LARGE BARE AREAS) PERENNIAL VEGETATIVE COVER WITH A DENSITY OF 80% HAS BEEN ESTABLISHED ON ALL UNPAVED AREAS AND AREAS NOT COVERED BY PERMANENT STRUCTURES.
- ALL TEMPORARY CONTROL DEVICES SHALL BE REMOVED ONCE CONSTRUCTION IS COMPLETE AND THE SITE IS PERMANENTLY STABILIZED.
- CONTRACTOR SHALL SOD ALL DISTURBED AREAS IN CITY RIGHT-OF-WAY.

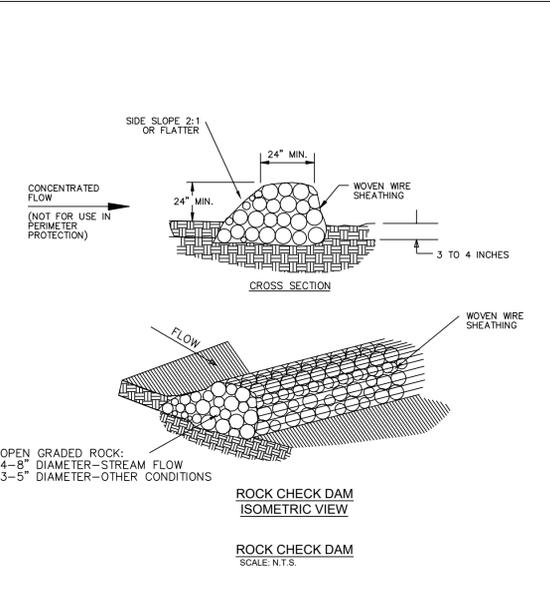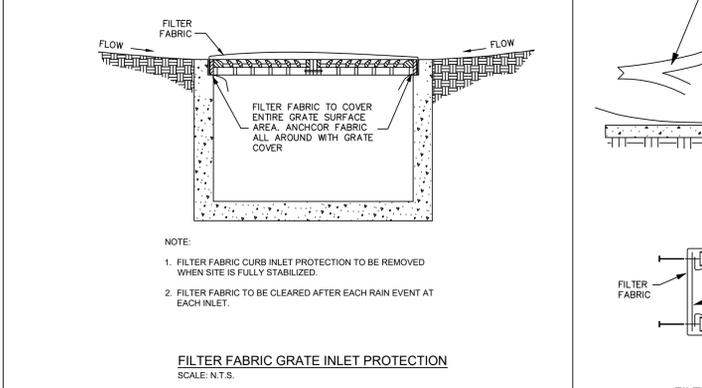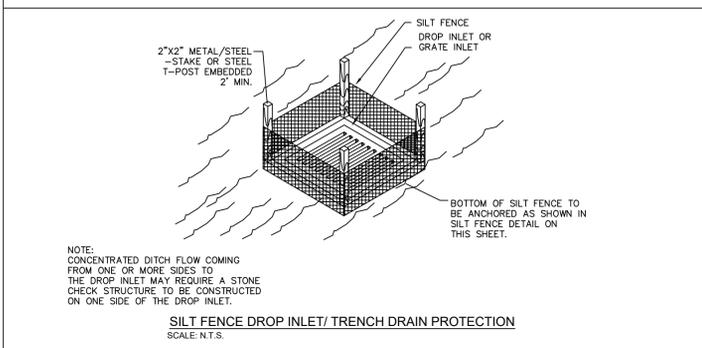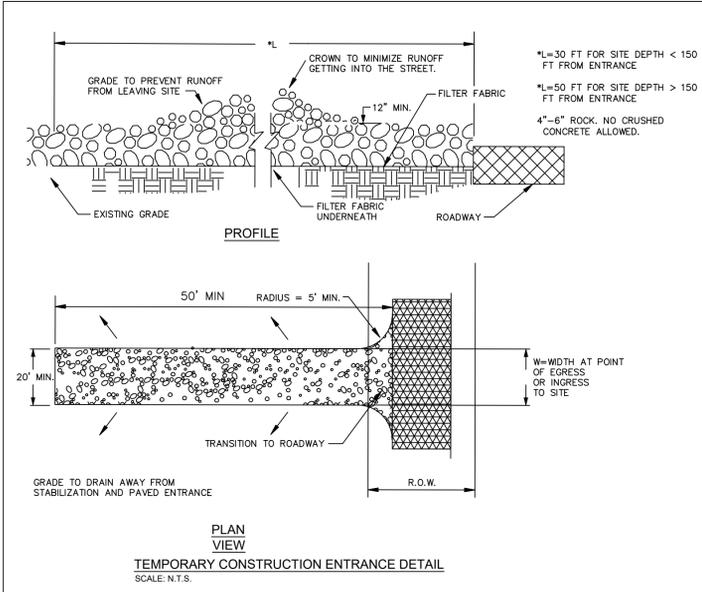

- ROCK CHECK DAM GENERAL NOTES**
- WOVEN WIRE SHEATHING SHALL HAVE MAXIMUM OPENING OF ONE (1) INCH AND A MINIMUM WIRE SIZE OF 20 GAUGE AND SHALL BE SECURED WITH SHOT RINGS.
 - THE ROCK BERM SHALL BE INSPECTED WEEKLY OR AFTER EACH RAIN AND SHALL BE REPLACED WHEN THE STRUCTURE CEASES TO FUNCTION PROPERLY.
 - WHEN SILT REACHES A DEPTH EQUAL TO ONE-THIRD OF THE HEIGHT OF THE BERM OR ONE FOOT, WHICHEVER IS LESS, THE SILT SHALL BE REMOVED AND DISPOSED OF IN AN APPROVED MANNER.
 - WHEN THE SITE IS COMPLETELY STABILIZED, THE BERM AND ACCUMULATED SILT SHALL BE REMOVED AND DISPOSED OF IN AN APPROVED MANNER.

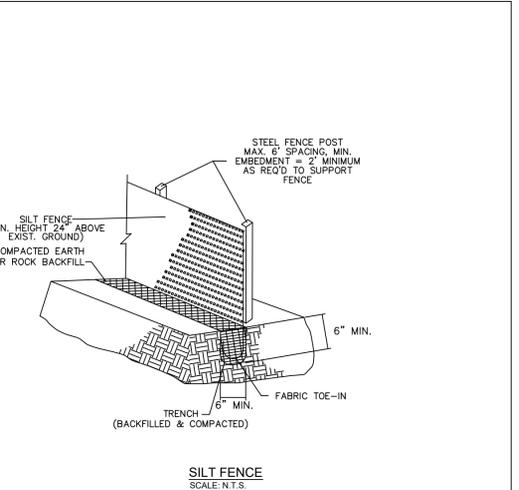

- SILT FENCE GENERAL NOTES**
- STEEL POSTS WHICH SUPPORT THE SILT FENCE SHALL BE INSTALLED WITH A SLIGHT ANGLE TOWARD THE ANTICIPATED RUNOFF SOURCE. POST MUST BE EMBEDDED A MINIMUM OF ONE FOOT.
 - THE TOE OF THE SILT FENCE SHALL BE TRENCHED IN WITH A SPADE OR MECHANICAL TRENCHER, SO THAT THE DOWNSLOPE FACE OF THE TRENCH IS FLAT AND PERPENDICULAR TO THE LINE OF FLOW, WHERE FENCE CANNOT BE TRENCHED IN (e.g. PAVEMENT), WEIGHT FABRIC FLAP WITH WASHED GRAVEL OR WHIRL FENCE TO PREVENT FLOW UNDER FENCE.
 - THE TRENCH MUST BE A MINIMUM OF 6 INCHES DEEP AND 6 INCHES WIDE TO ALLOW FOR THE SILT FENCE FABRIC TO BE LAID IN THE GROUND AND BACKFILLED WITH COMPACTED MATERIAL.
 - SILT FENCE SHOULD BE SECURELY FASTENED TO EACH STEEL SUPPORT POST OR TO WOVEN WIRE, WHICH IS IN TURN ATTACHED TO THE STEEL FENCE POST. THERE SHALL BE A 6\"/>

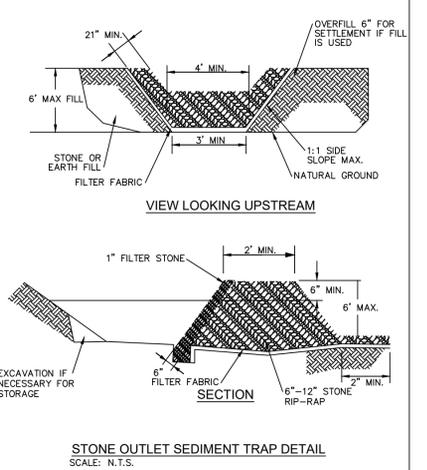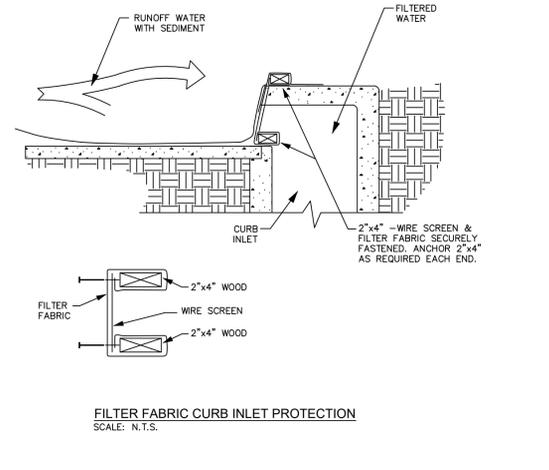

RECORD DRAWING
NOVEMBER 24, 2020

THESE RECORD DRAWINGS HAVE BEEN PREPARED BASED ON FIELD OBSERVATIONS AND INFORMATION PROVIDED BY THE CONTRACTOR. ELEVATIONS HAVE NOT BEEN FIELD VERIFIED. THE ORIGINAL SEALED CONSTRUCTION DRAWINGS ARE ON FILE AT THE OFFICES OF HALFF ASSOCIATES, INC. TBPE FIRM F-312.

ENGINEER OF RECORD
DYLAN B. HEDRICK
HALFF ASSOCIATES, INC. TBPE FIRM F-312
DATE: NOVEMBER 24, 2020

ROCKWALL URBAN + INDUSTRIAL CENTER
END OF ALPHA DRIVE
ROCKWALL, TX 75087

HALFF
1201 NORTH BOWSER ROAD
RICHARDSON, TX 75081-2275
(214) 348-6200

Revision No.	Date	Description

Project No.: 38050
Issued: NOVEMBER 2020
Drawn By: REP
Checked By: DBH
Scale: AS SHOWN
Sheet Title
EROSION CONTROL DETAILS
C5.02
Sheet Number