



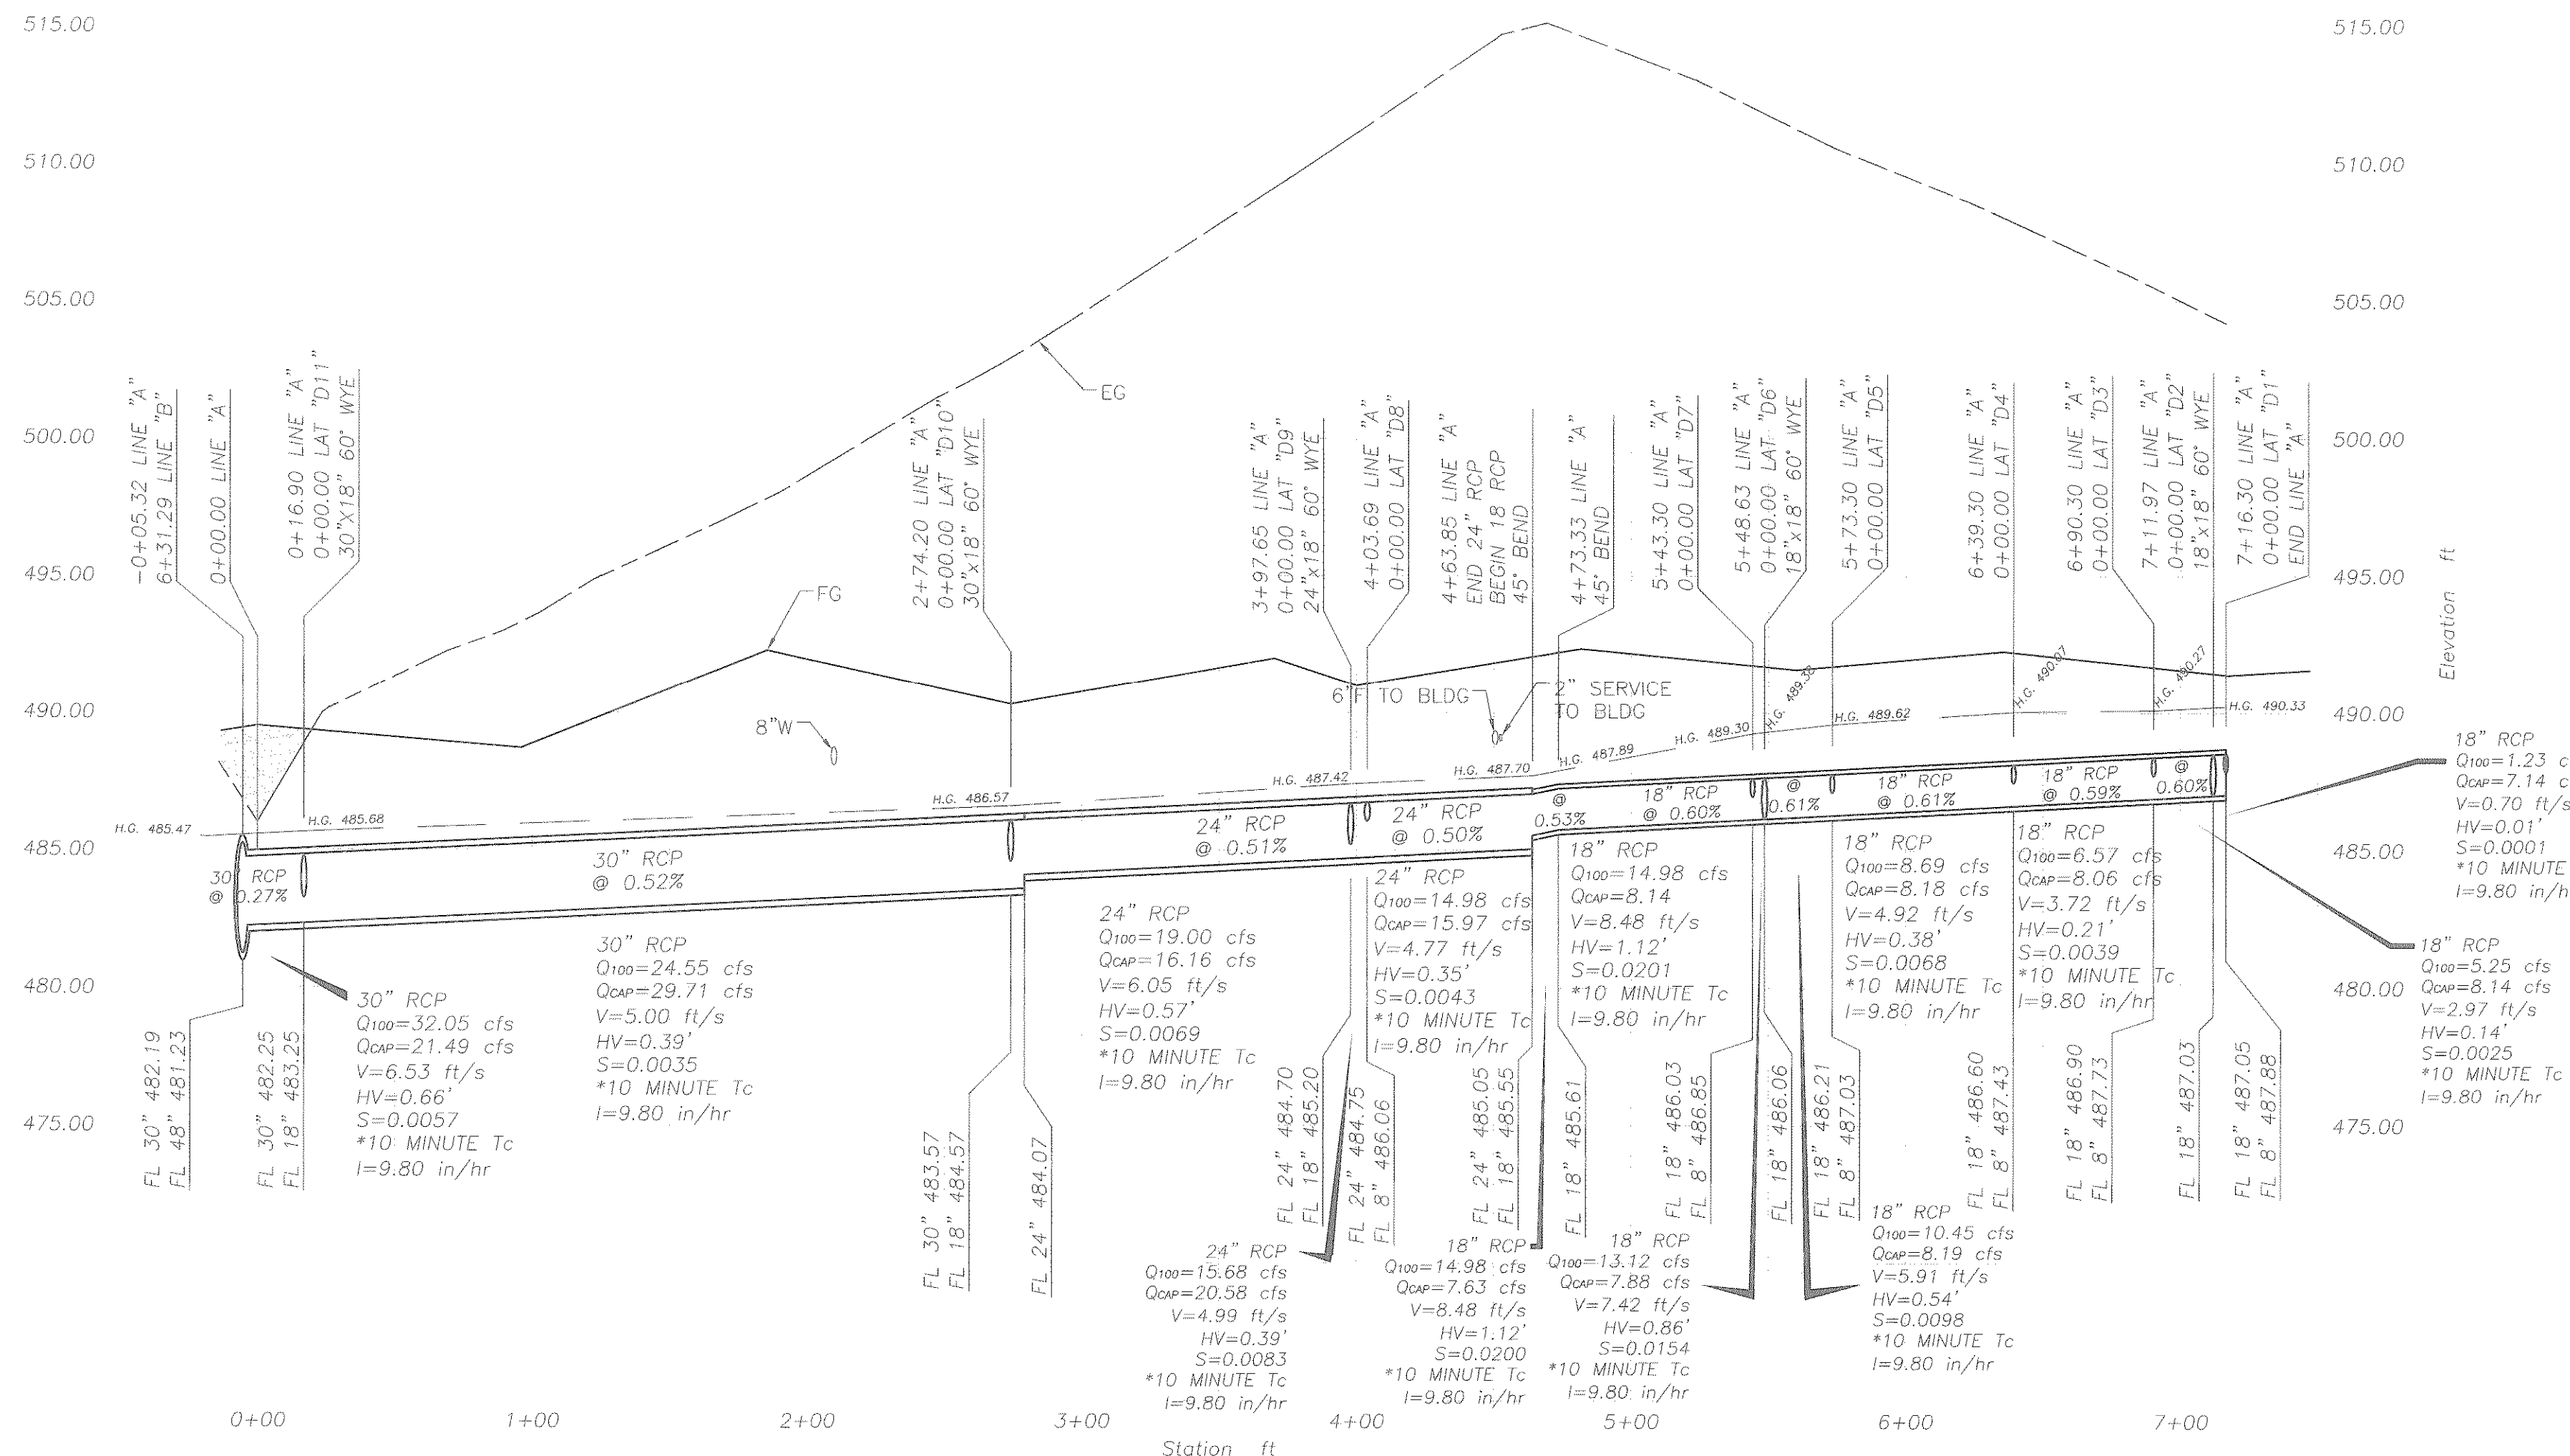

LINE "A" - STORM PROFILE

1"=50' (H)
1"=5' (V)

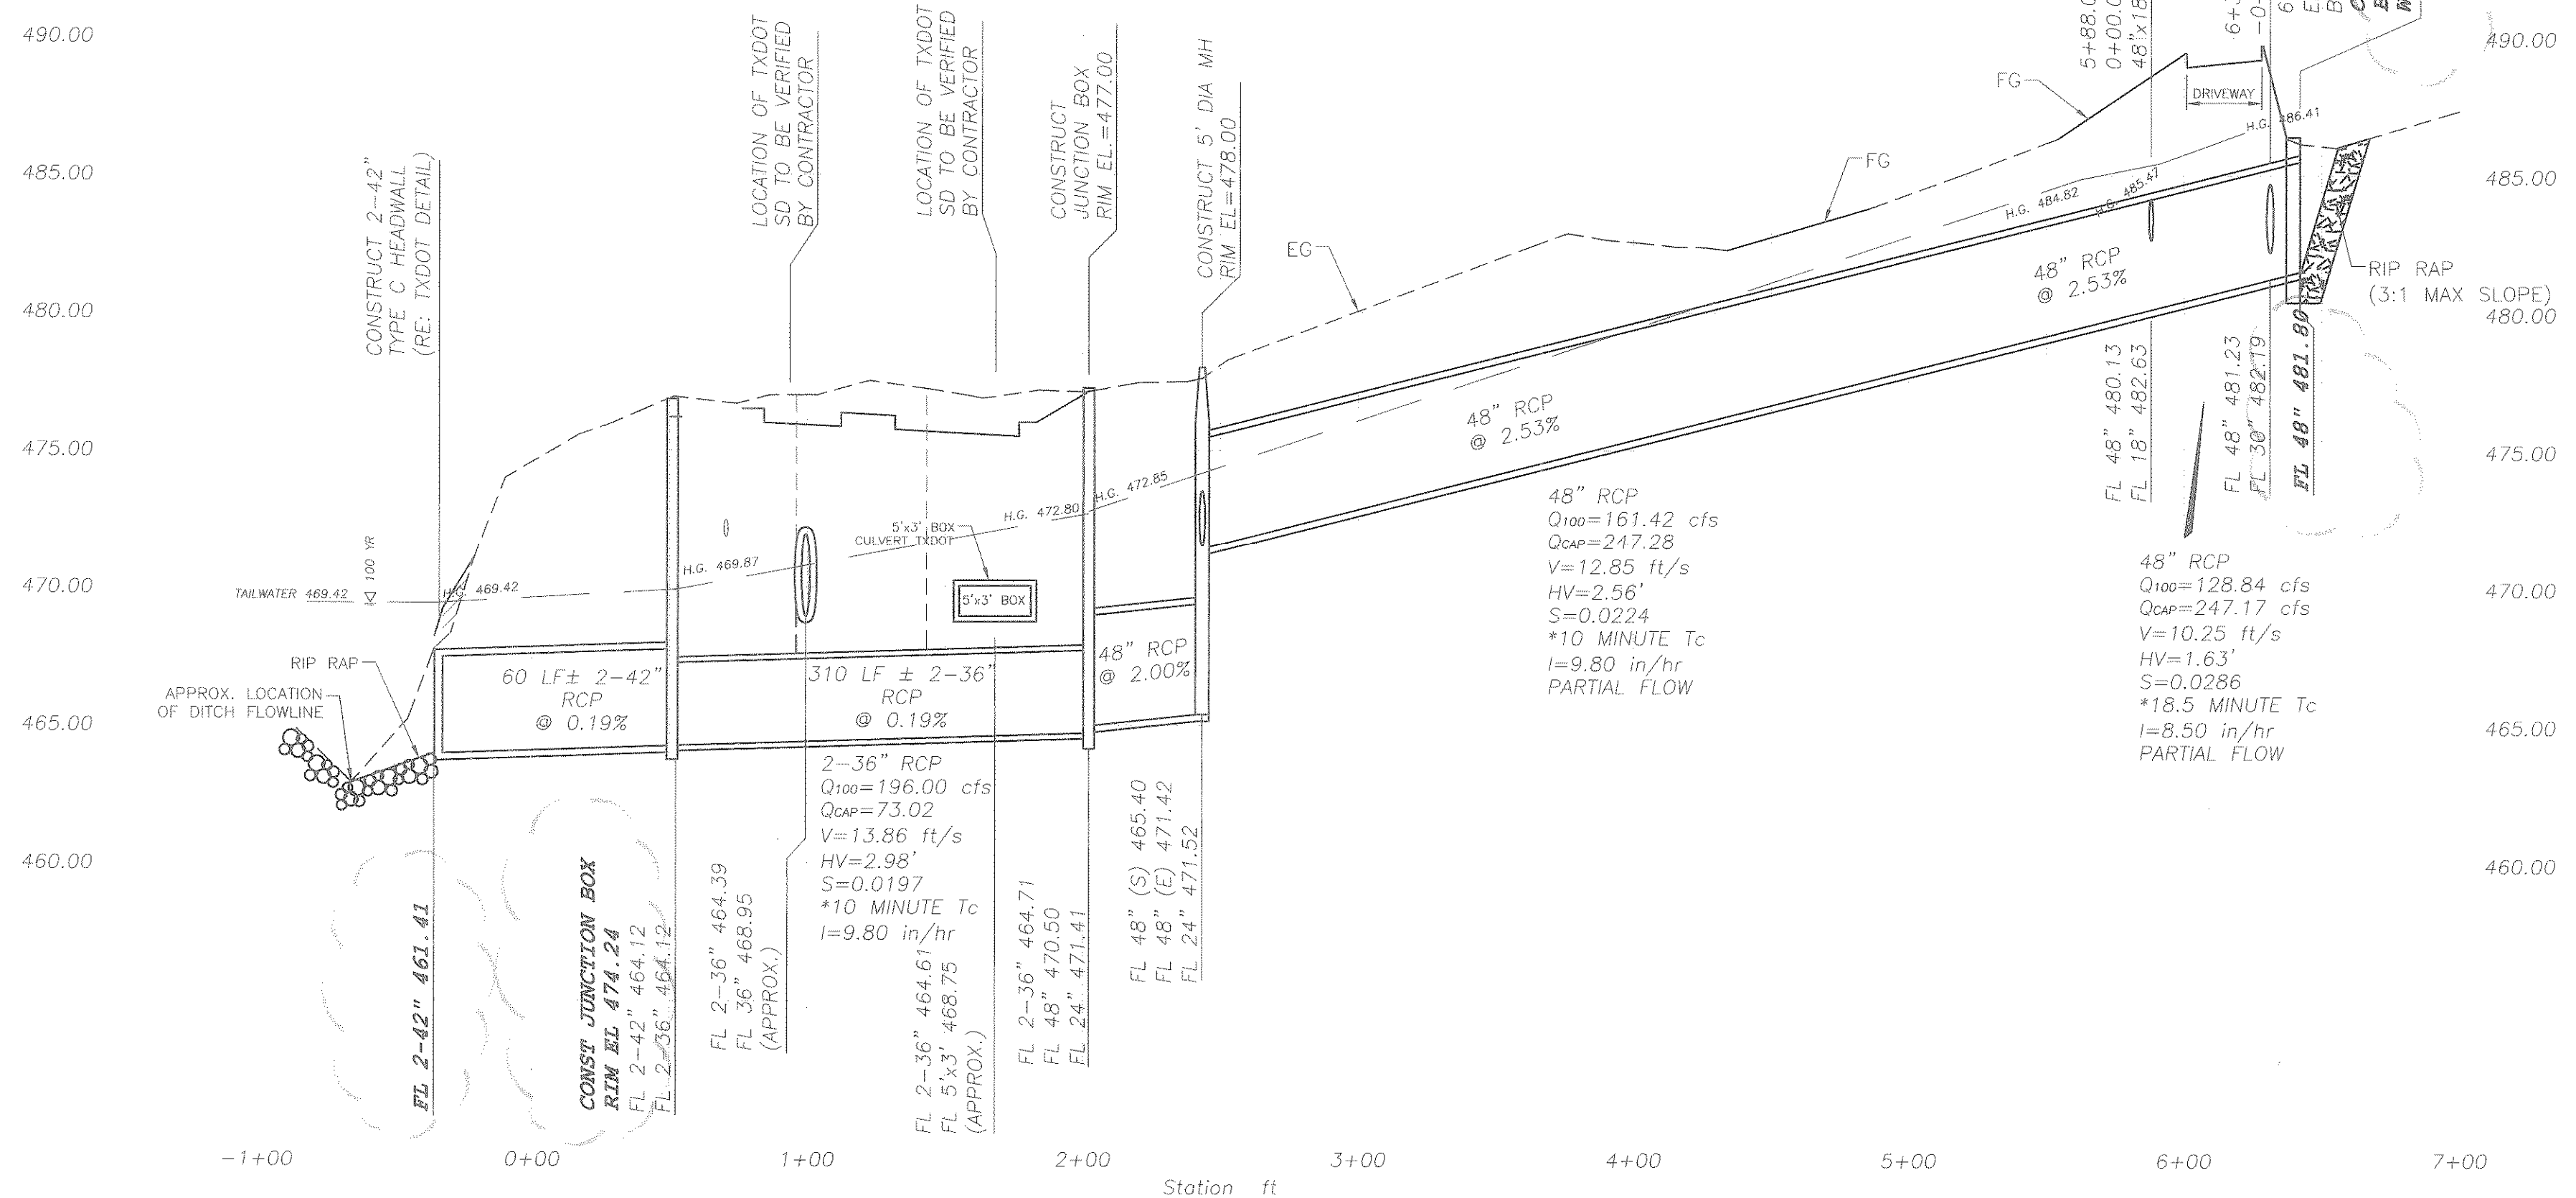

LINE "B" - STORM PROFILE

1"=50' (H)
1"=5' (V)

0+05.22 LAT "D14"
CONST. 10' C.I.
RIM EL = 484.40
FL = 479.10

RECORD DRAWING
INFORMATION CLOUDED

RECORD DRAWING BASED ON SURVEY INFORMATION
PROVIDED BY JOHN VICAIN, P.L.S. #4097, AND DRAWINGS
PROVIDED BY THE CONTRACTOR.

BENCHMARKS:


- 1.) CITY OF ROCKWALL CONTROL MONUMENTATION
MONUMENT #R012 - ELEV. 593.85.
- 2.) SQUARE CUT ON MEDIAN NOSE OF NORTH LAKESHORE
DRIVE APPROXIMATELY 500' NORTH OF STATE HIGHWAY
66 - ELEV. 474.35.
- 3.) SQUARE CUT ON MEDIAN NOSE OF NORTH LAKESHORE
DRIVE APPROXIMATELY 900' NORTH OF STATE HIGHWAY
66 - ELEV. 487.99

Scale: AS SHOWN
Designed by: FRB
Drawn by: TDK
Checked by: JRH
Date: FEBRUARY 13, 2002
Project No. 067811010

STORM DRAINAGE PROFILES
(RECORD DRAWING)

WAL-MART ROCKWALL, TX
STORE #3530-00, NewNM
S.H. 66 & N. LAKE SHORE DR. SITE

Kimley-Horn
and Associates, Inc.

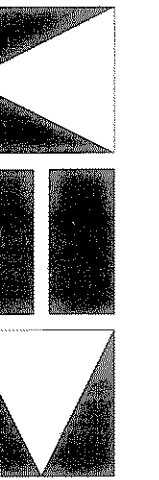

12700 Park Central Drive, Suite 1800
Dallas, Texas 75251

Tel. No. (972) 770-1300
Fax No. (972) 239-9820