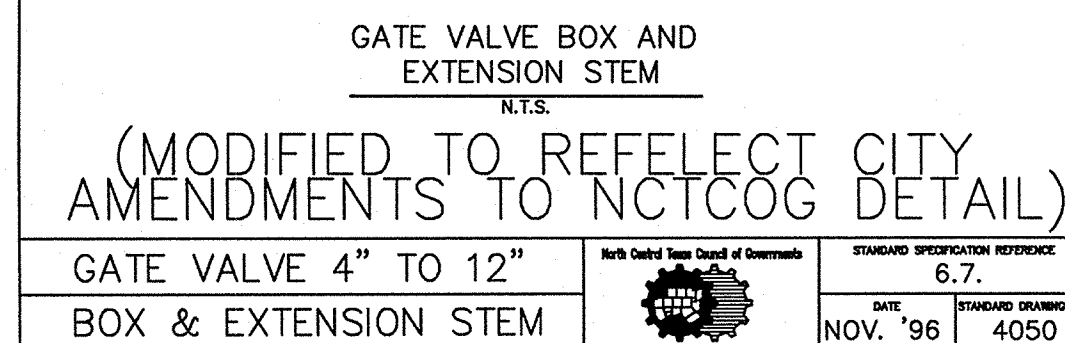


1. REFERENCE CITY OF ROCKWALL STANDARD DRAWINGS FOR ALL OTHER APPLICABLE DETAILS. REFERENCE CITY OF ROCKWALL AMENDMENTS TO THE NCTCOG STANDARD DRAWINGS (AS
2. CLOUDED ON THE MODIFIED NCTCOG STANDARD DRAWINGS SHOWN ON THIS PAGE).

NO.	DATE	BY	DESCRIPTION	CONST
-----	------	----	-------------	-------

STATE OF TEXAS
DAVID K. KOCHALKA
87781
LICENSED
PROFESSIONAL ENGINEER
2-27-08

DATE: 12-21-07

1	2	3	466
---	---	---	---	---	---	---	---	---	----	----	-----	-----	
10

OF **15** DWGS.