

XREF 2246-WG -XREF XAs Build-WG -XREF XBody-WG -XREF XSide-WG -XREF XRoad-Future -XREF XRoll-out-WG -XREF XArm-WG -XREF XTogo-WG -XREF XBeach-WG
D:\XREF\WATG\222008-453 PM
19/08/2008 17:00
C:\GREEN'S ROCKS\MILL\COORDINANCE AREA\WARDWG
19/08/2008 PM


IMAGES

XREFS

FILE NAME

LAST SAVED

NOTE: EXISTING AREAS
R8, OS-1, AND OS-2

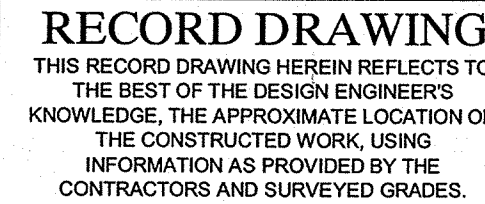

Elev. 470.06'

Elev. 477.90'

INTERSECTION OF THE
E AND THE NORTH
THEAST OF A
AIL RUN ROAD.
Elev. 471.31'

BUILDING PERMIT REVIEW:	SCALE: <u>AS NOTED</u>	DRAWING NO.
_____ ADA / TAS EAB #:	DRAWN BY: _____ K.F.D.	C-5
_____ A8804095	REVIEWED BY:	
BID/PRICING SET:	_____ D.K.K.	
_____ 01-15-08	ISSUE DATE: <u>12-21-07</u>	
CONSTRUCTION SET:		OF 15 DWGS.

C-5

100

OF **15** DWGS.