


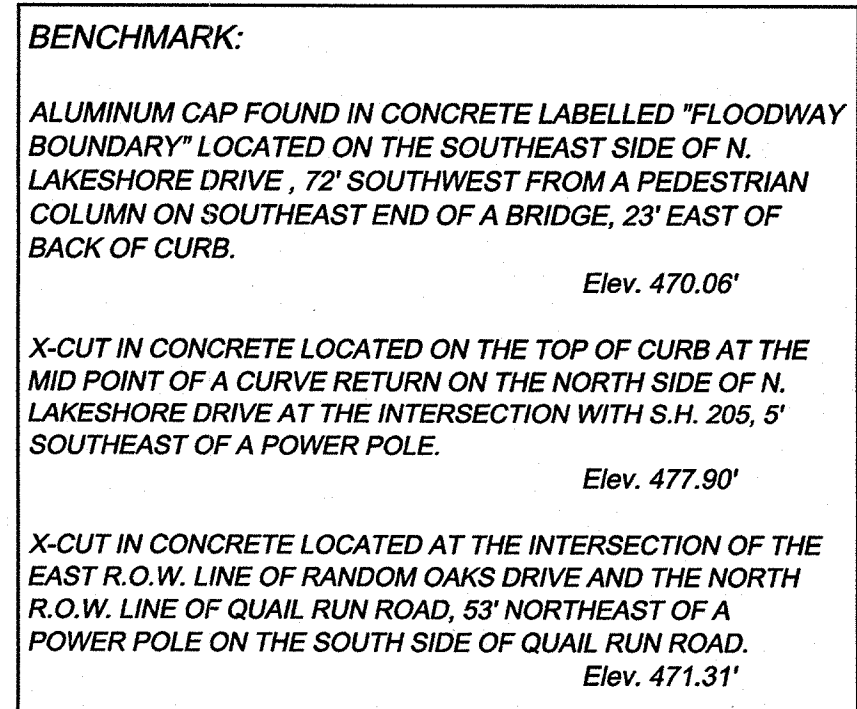

PROJECT NO: 2006-000000 N. Lakeshore Dr. & Hwy 205 Rockwall, TX		
DRAWING TITLE STORM SEWER PLAN		
BUILDING PERMIT REVIEW: ADA / TAS EAB # _____ A8804095 BID/PRICING SET: 01-15-08 CONSTRUCTION SET:	SCALE: <u>AS NOTED</u> DRAWN BY: <u>K.F.D.</u> REVIEWED BY: <u>D.K.K.</u> ISSUE DATE: <u>12-21-07</u>	DRAWING NO. C-7 OF 15 DWGS

XREF 2456-WG -XREF XAF Bas-UW - XREF YBdy-WG -XREF rste-WG -XREF Xel Utility-WG -XREF XRoad-Future -XREF and WG -XREF wrm-WG -XREF sf-and-WG -XREF Grad-WG -XREF ssm-WG
MAGNES
DANKEER, KATE 10/27/2008 833 AM
G-00237901-WALGREENS ROCKWALL HURSTORM SEWER PLANDWG
LOTTOED BY NAME