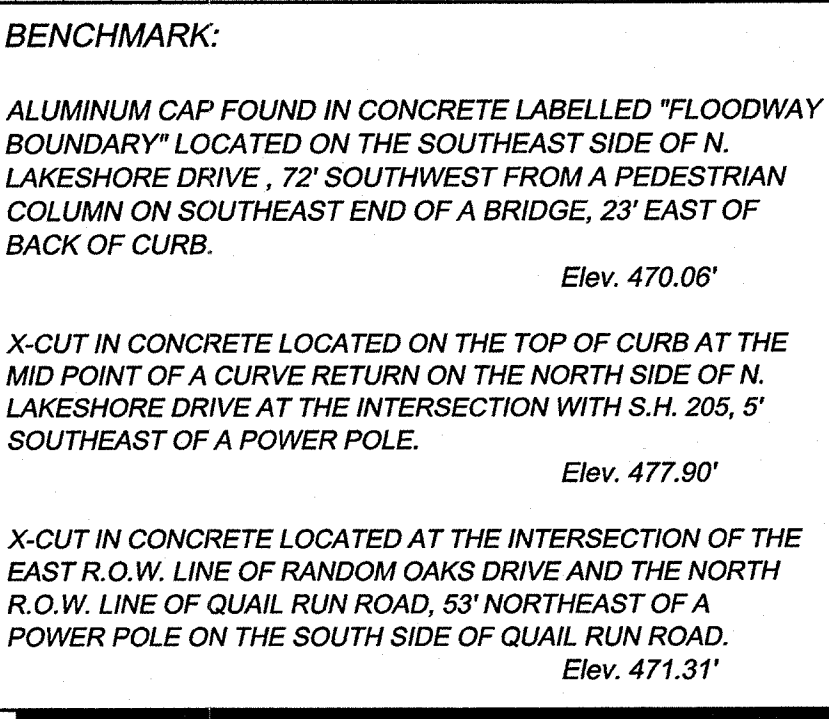


[illegible]

XREF 2x4-WG - XREF X-6 Build-WG - XREF XBody-WG - XREF XSide-WG - XREF XTop-Future - XREF XRoad-Future - XREF XArch-WG - XREF XTerm-WG - XREF XBeam-WG - XREF XPost-Strut-WG  
 IMAGES  
 XREFS  
 PLOTTED BY DANKEER, KATE 2/6/2008 4:57 PM  
 DWG NAME 19-0827001-WALGREENS ROCKWALL HURSTOWN SEWER PROFILES.DWG  
 LAST SAVED 1/9/2008 7:10 PM