

CIVIL CONSTRUCTION PLANS
FOR
Walgreens

CITY OF ROCKWALL
ROCKWALL, TEXAS

Project No. 26332.000
Store No. 11519

PLANS SUBMITTAL/REVIEW LOG

FIRST SUBMITTAL TO CITY OF ROCKWALL 11/30/2007
- NOT FOR CONSTRUCTION.
SECOND SUBMITTAL TO CITY OF ROCKWALL 01/10/2008
- NOT FOR CONSTRUCTION.
THIRD SUBMITTAL TO CITY OF ROCKWALL 01/14/2008
- NOT FOR CONSTRUCTION

ENGINEER:

KIMLEY-HORN AND ASSOCIATES, INC.
5750 Genesis Court, Suite 200
Frisco, Texas 75034
Phone: (972) 335-3580
Fax: (972) 335-3779
Contact: David Kochalka, P.E.

ARCHITECT:

LEVINSON ALCOSER ASSOCIATES, LP
1177 West Loop South, Suite 900
Houston, Texas 77027
Phone: (713) 600-3622
Fax: (713) 600-3672
Contact: Wes Gustin, RA

STRUCTURAL ENGINEER:

PSS PARTNERSHIP, INC.
6117 Richmond Avenue, Suite 250
Houston, Texas 77057
Phone: (713) 782-1040
Fax: (713) 782-2040
Contact: Ivan Pieratt

OWNER / DEVELOPER:

SALVO REAL ESTATE SOLUTIONS
5005 L.B.J. Freeway, Suite 840
Dallas, Texas 75244
Phone: (972) 331-2050
Fax: (972) 331-0020

LANDSCAPE ARCHITECTURE:


SMR ARCHITECTS
1708 N. Griffin
Dallas, Texas 75202
Phone: (214) 871-0083
Fax: (214) 871-0545
Contact: Steve Rahn

MEP ENGINEER:

RH GEORGE & ASSOCIATES
10930 W. Sam Houston Parkway
Houston, Texas 77064
Phone: (281) 664-1900
Fax: (281) 664-1912
Contact: Charles Mueller

PREPARED BY:


**Kimley-Horn and Associates, Inc.**
5750 Genesis Court, Suite 200
Frisco, Texas 75034
Tel. No. (972) 335-3580
Fax No. (972) 335-3779

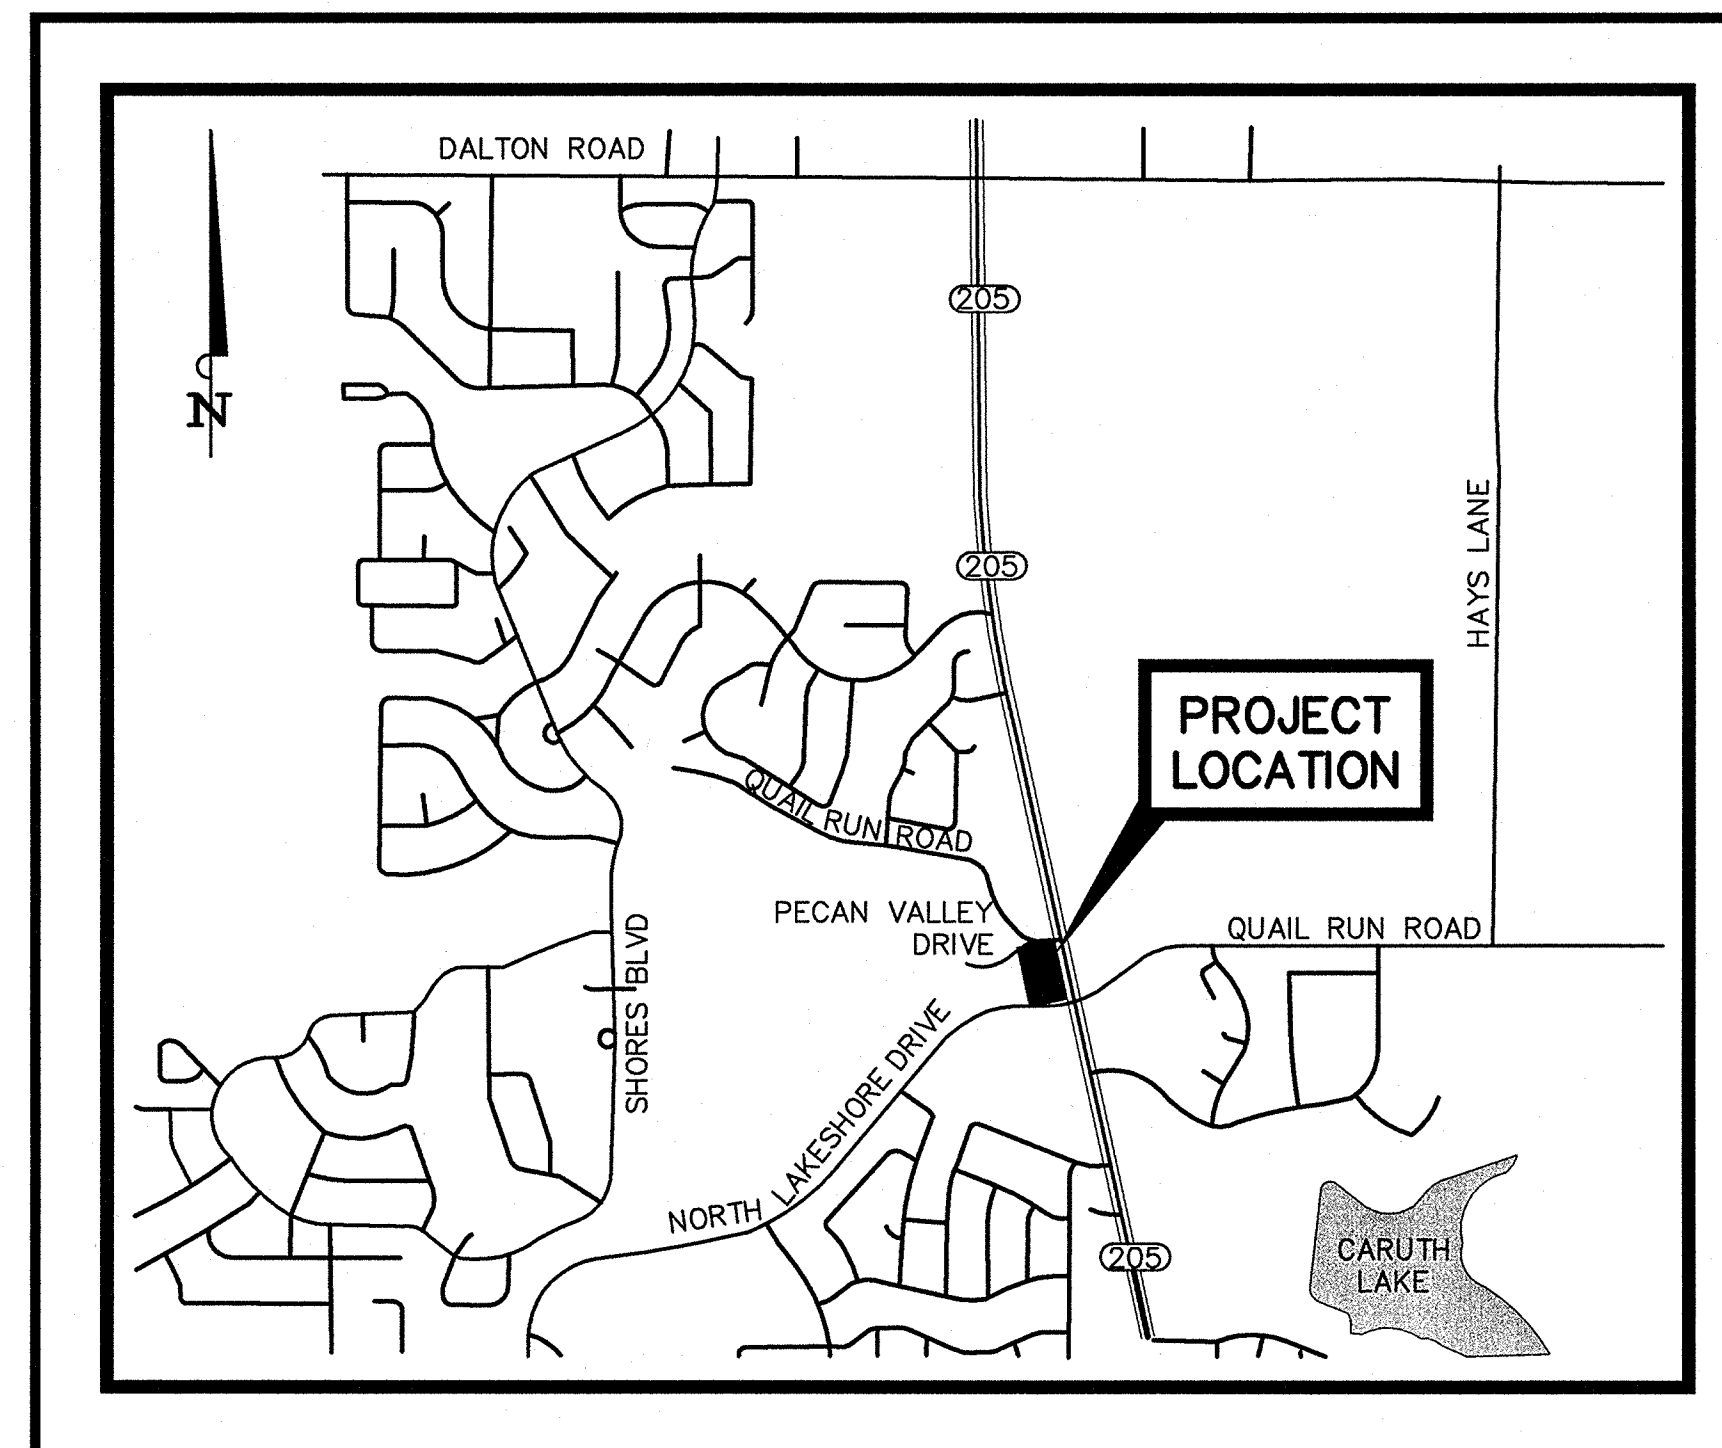

Location Map
Not To Scale

INDEX OF SHEETS

SHEET NO.	DESCRIPTION	DATE	REVISION
	COVER SHEET	02/27/08	
1 of 2	FINAL PLAT	02/19/08	
2 of 2	FINAL PLAT	02/19/08	
C-1	GENERAL NOTES	02/27/08	
C-2	SITE PLAN	02/27/08	
C-3	PAVING AND DIMENSION CONTROL PLAN	02/27/08	
C-4	GRADING PLAN	02/27/08	10/01/08
	DRAINAGE PLANS		
C-5	DRAINAGE AREA MAP	02/27/08	
C-6	DRAINAGE CALCULATIONS	02/27/08	
C-7	STORM SEWER PLAN	02/27/08	10/01/08
C-8	STORM SEWER PROFILES	02/27/08	
C-9	UTILITY PLAN	02/27/08	04/24/08
	STORMWATER POLLUTION PREVENTION PLANS		
C-10	EROSION CONTROL PLAN	02/27/08	
C-11	EROSION CONTROL DETAILS	02/27/08	
	DETAILS		
C-12	PAVEMENT DETAILS	02/27/08	
C-13	STORM SEWER DETAILS	02/27/08	
C-14	WATER AND SANITARY SEWER DETAILS	02/27/08	
C-15	WATER AND SANITARY SEWER DETAILS	02/27/08	
FW-0	TXDOT CONCRETE WINGWALLS TYPE "FW-0"	MAY 2005	
TCP(1-4)-98	TXDOT TRAFFIC CONTROL PLAN	DEC. 1985	
PED-05	PEDESTRIAN FACILITIES	MARCH 2002	
	UNDERGROUND DETENTION PLANS		
1	UNDERGROUND DETENTION PLAN - COVER SHEET	01/07/08	
2	UNDERGROUND DETENTION PLAN - ASSEMBLY	01/07/08	
3	UNDERGROUND DETENTION PLAN - DETAILS	01/07/08	
4	UNDERGROUND DETENTION PLAN - DETAILS	01/07/08	
5	UNDERGROUND DETENTION PLAN - CONSTRUCTION DETAILS	01/07/08	

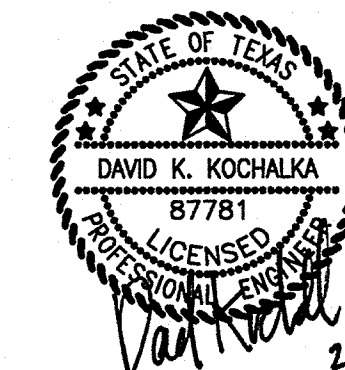

RECORD DRAWING
THIS RECORD DRAWING HEREIN REFLECTS TO
THE BEST OF THE DESIGN ENGINEER'S
KNOWLEDGE, THE APPROXIMATE LOCATION OF
THE CONSTRUCTED WORK USING
INFORMATION AS PROVIDED BY THE
CONTRACTORS AND SURVEYED GRADES.

February 27, 2008