
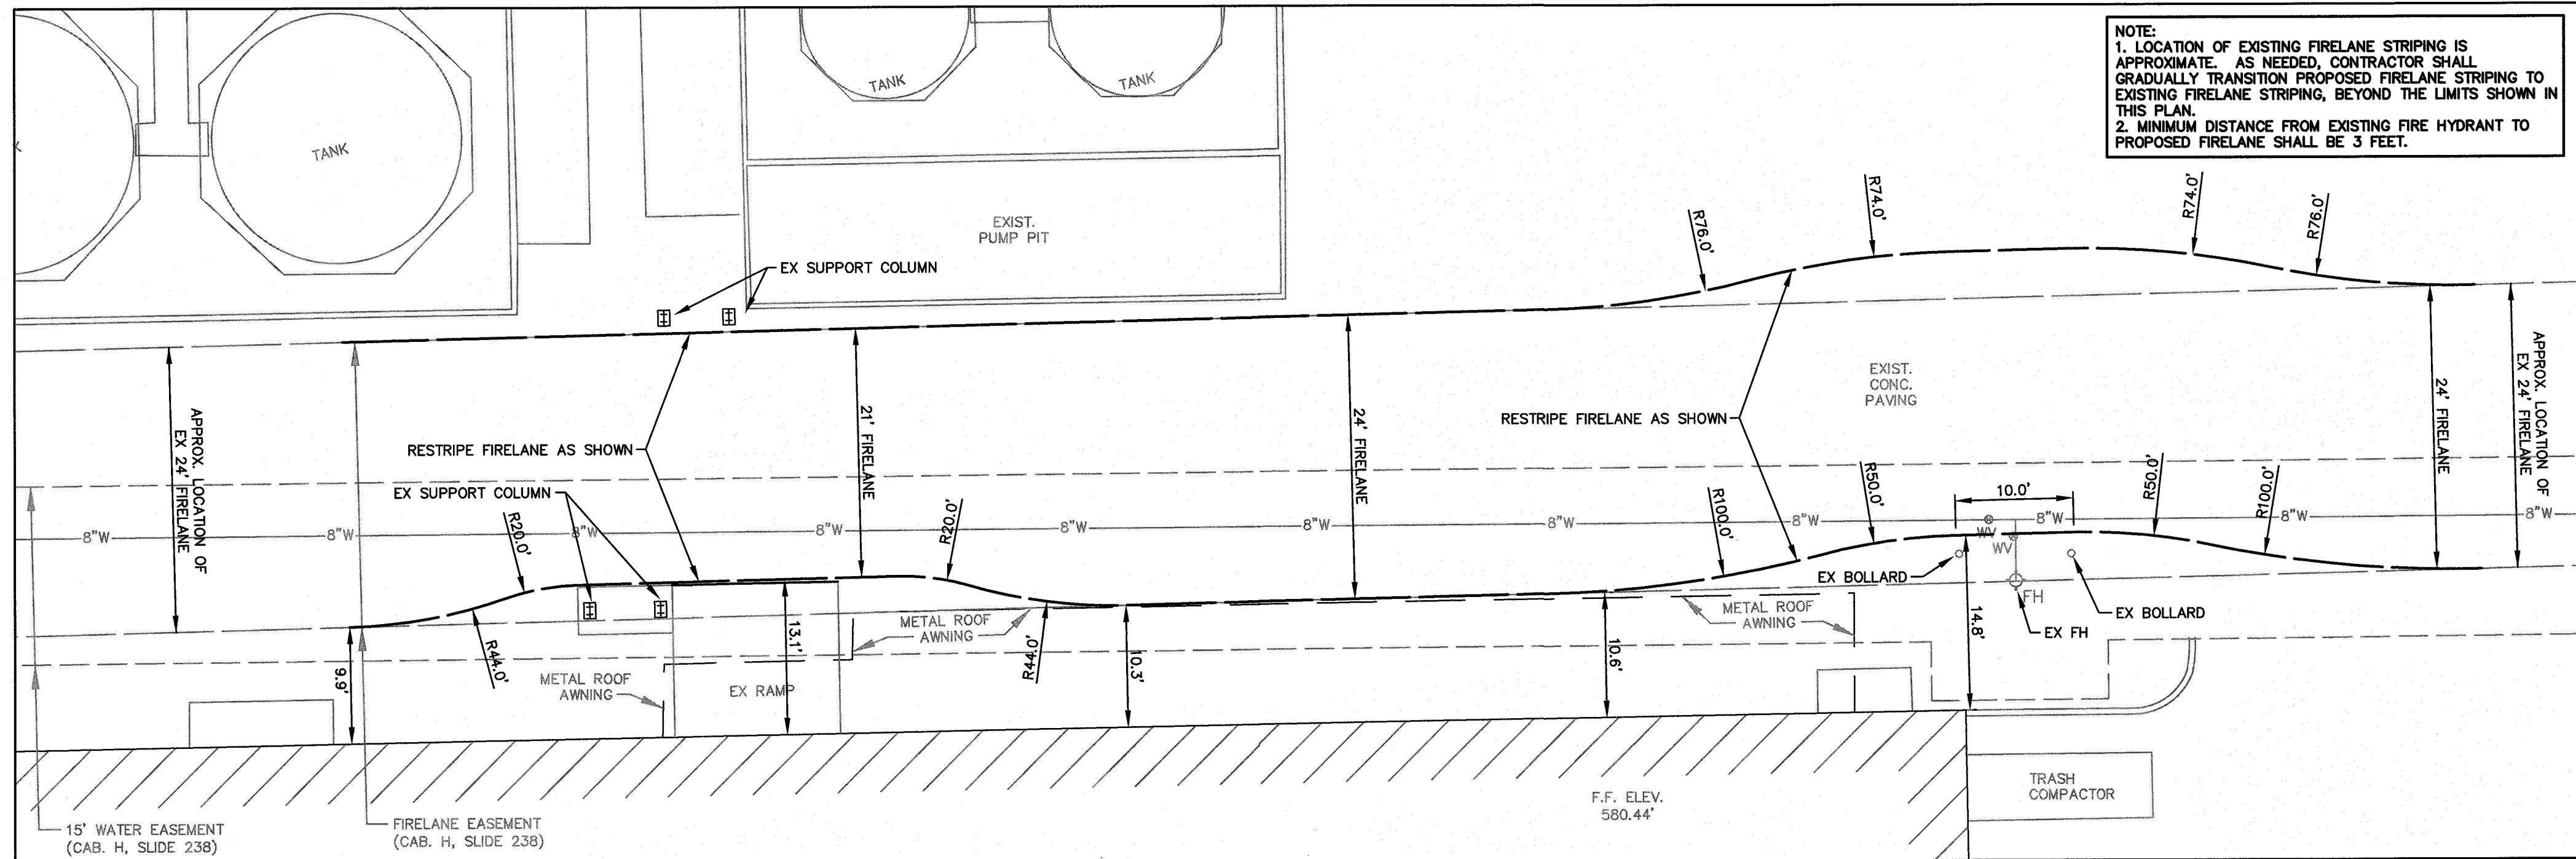
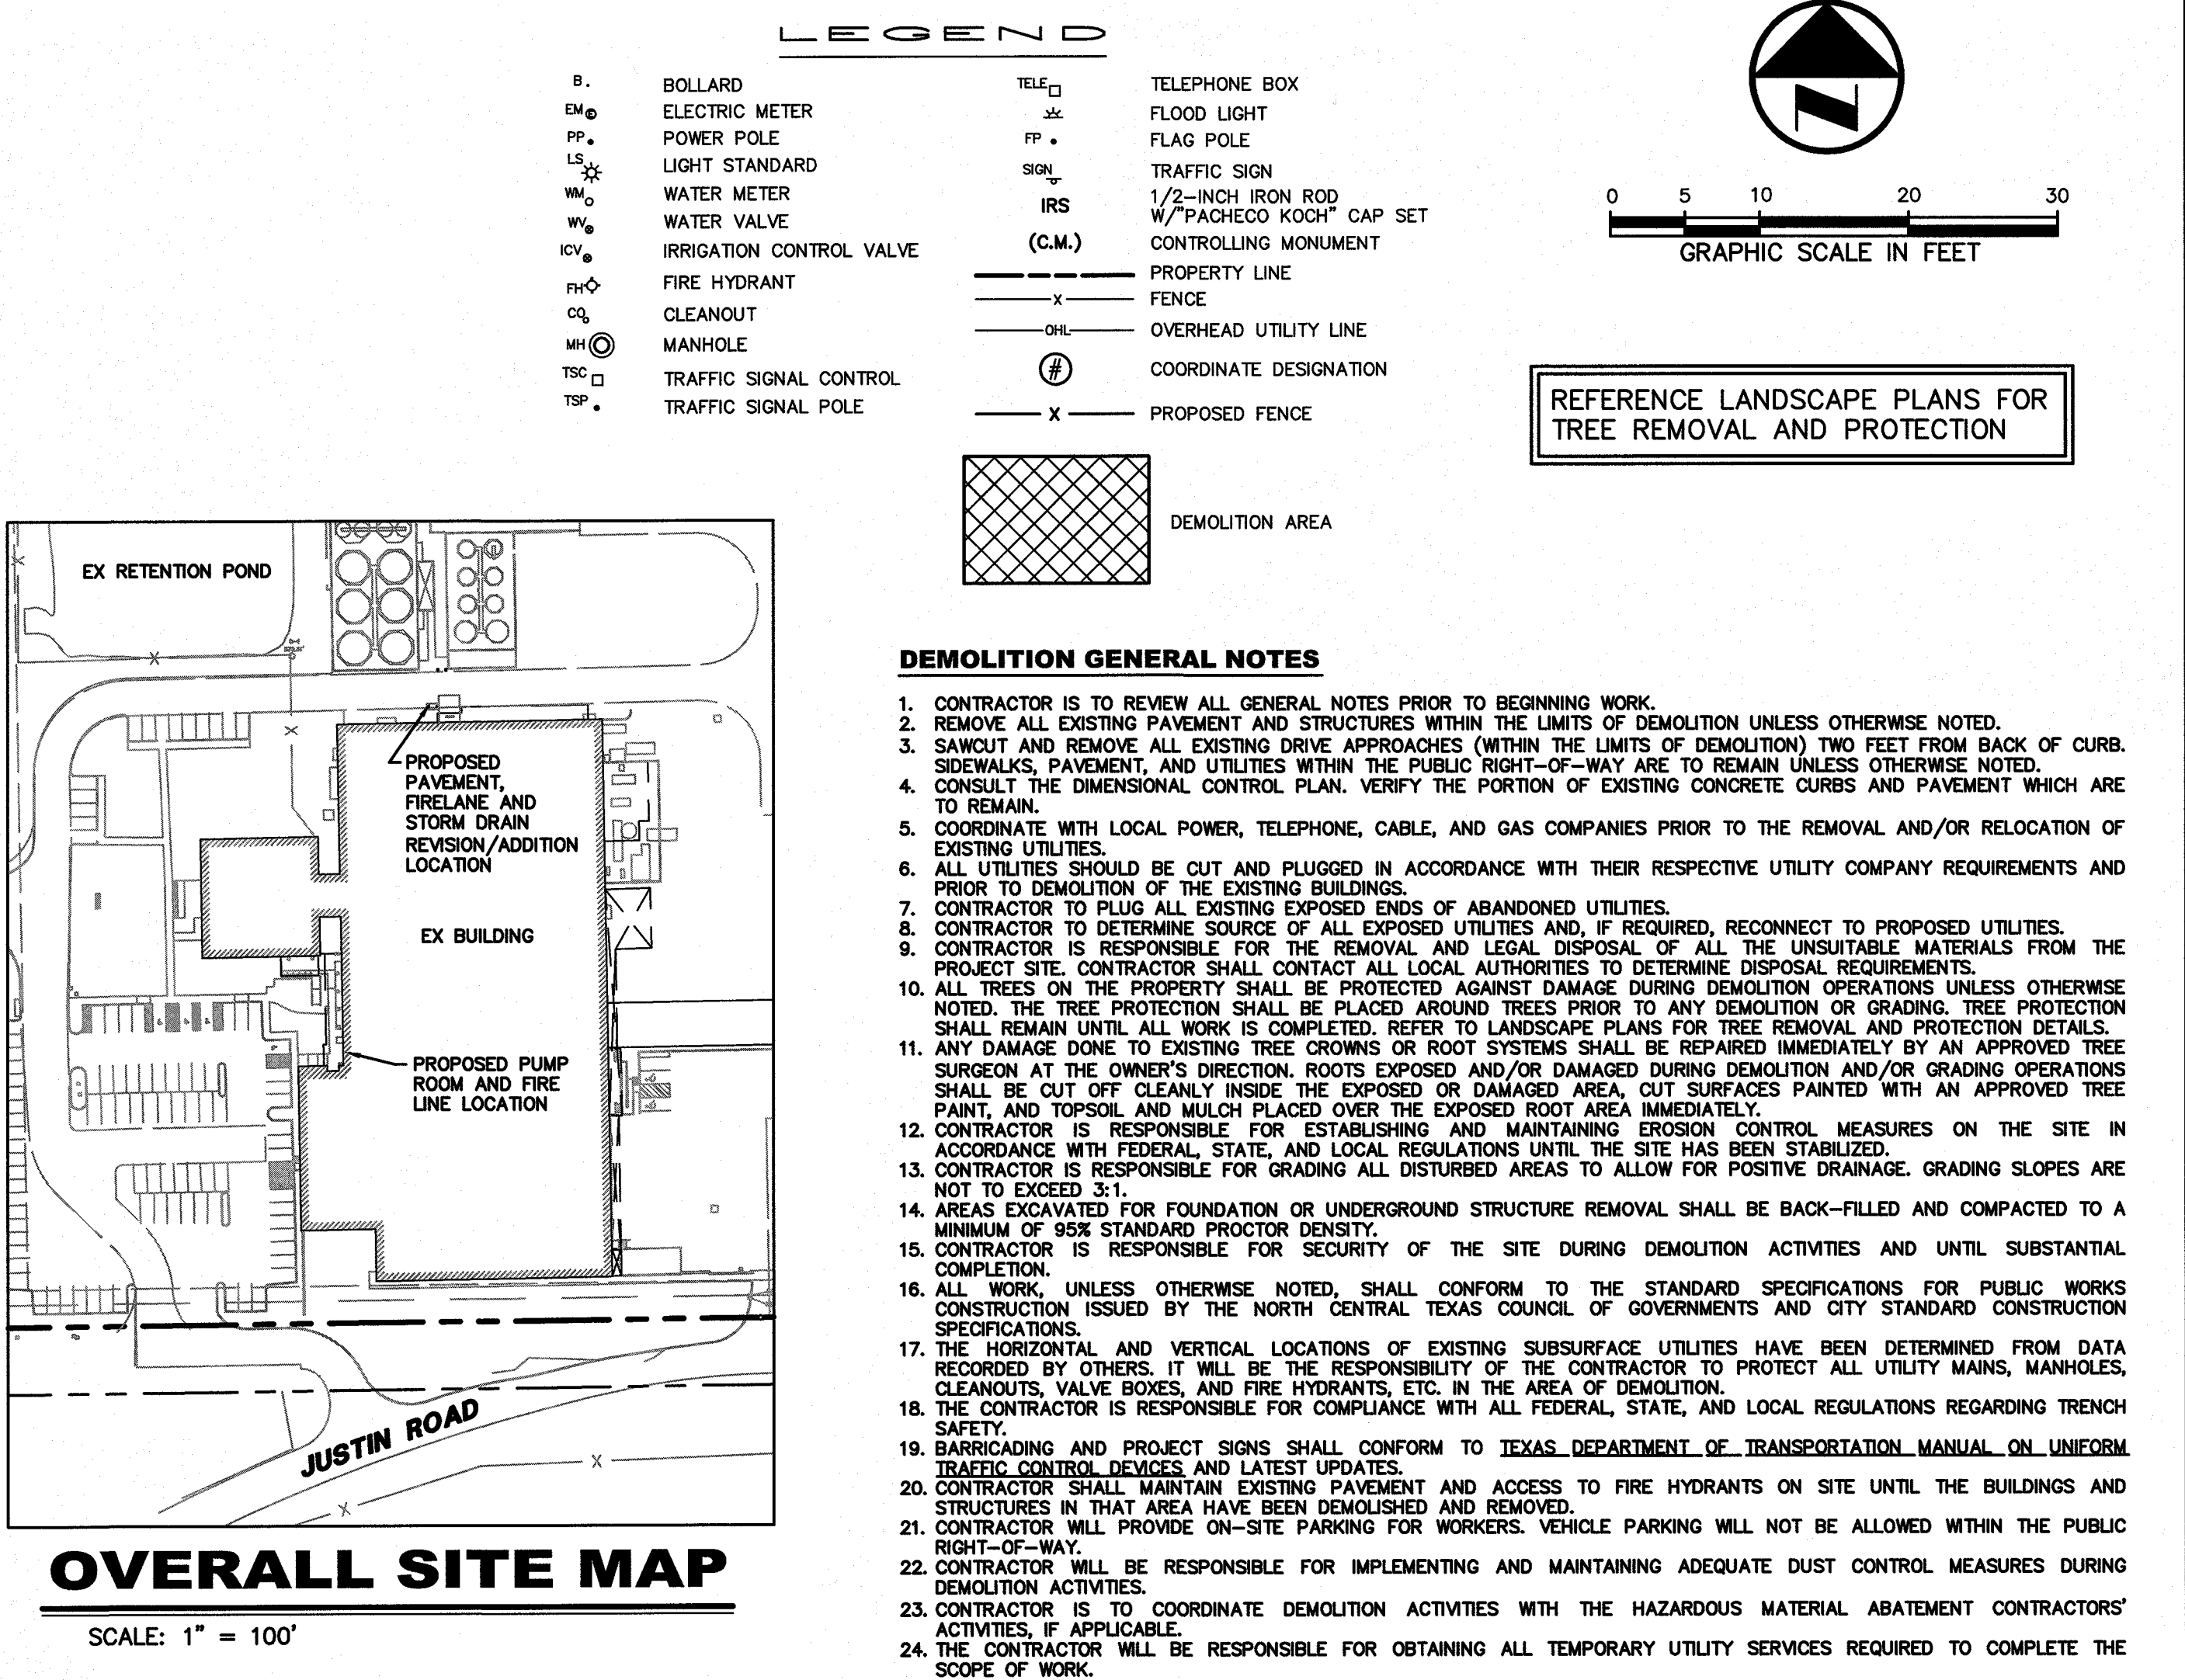


INQUIRIES
07/15/2014 - 9:38AM
M:\DWG-32\3273-13.288\DWG\CIVIL C3D 2012\3273-13.288-CV.DWG

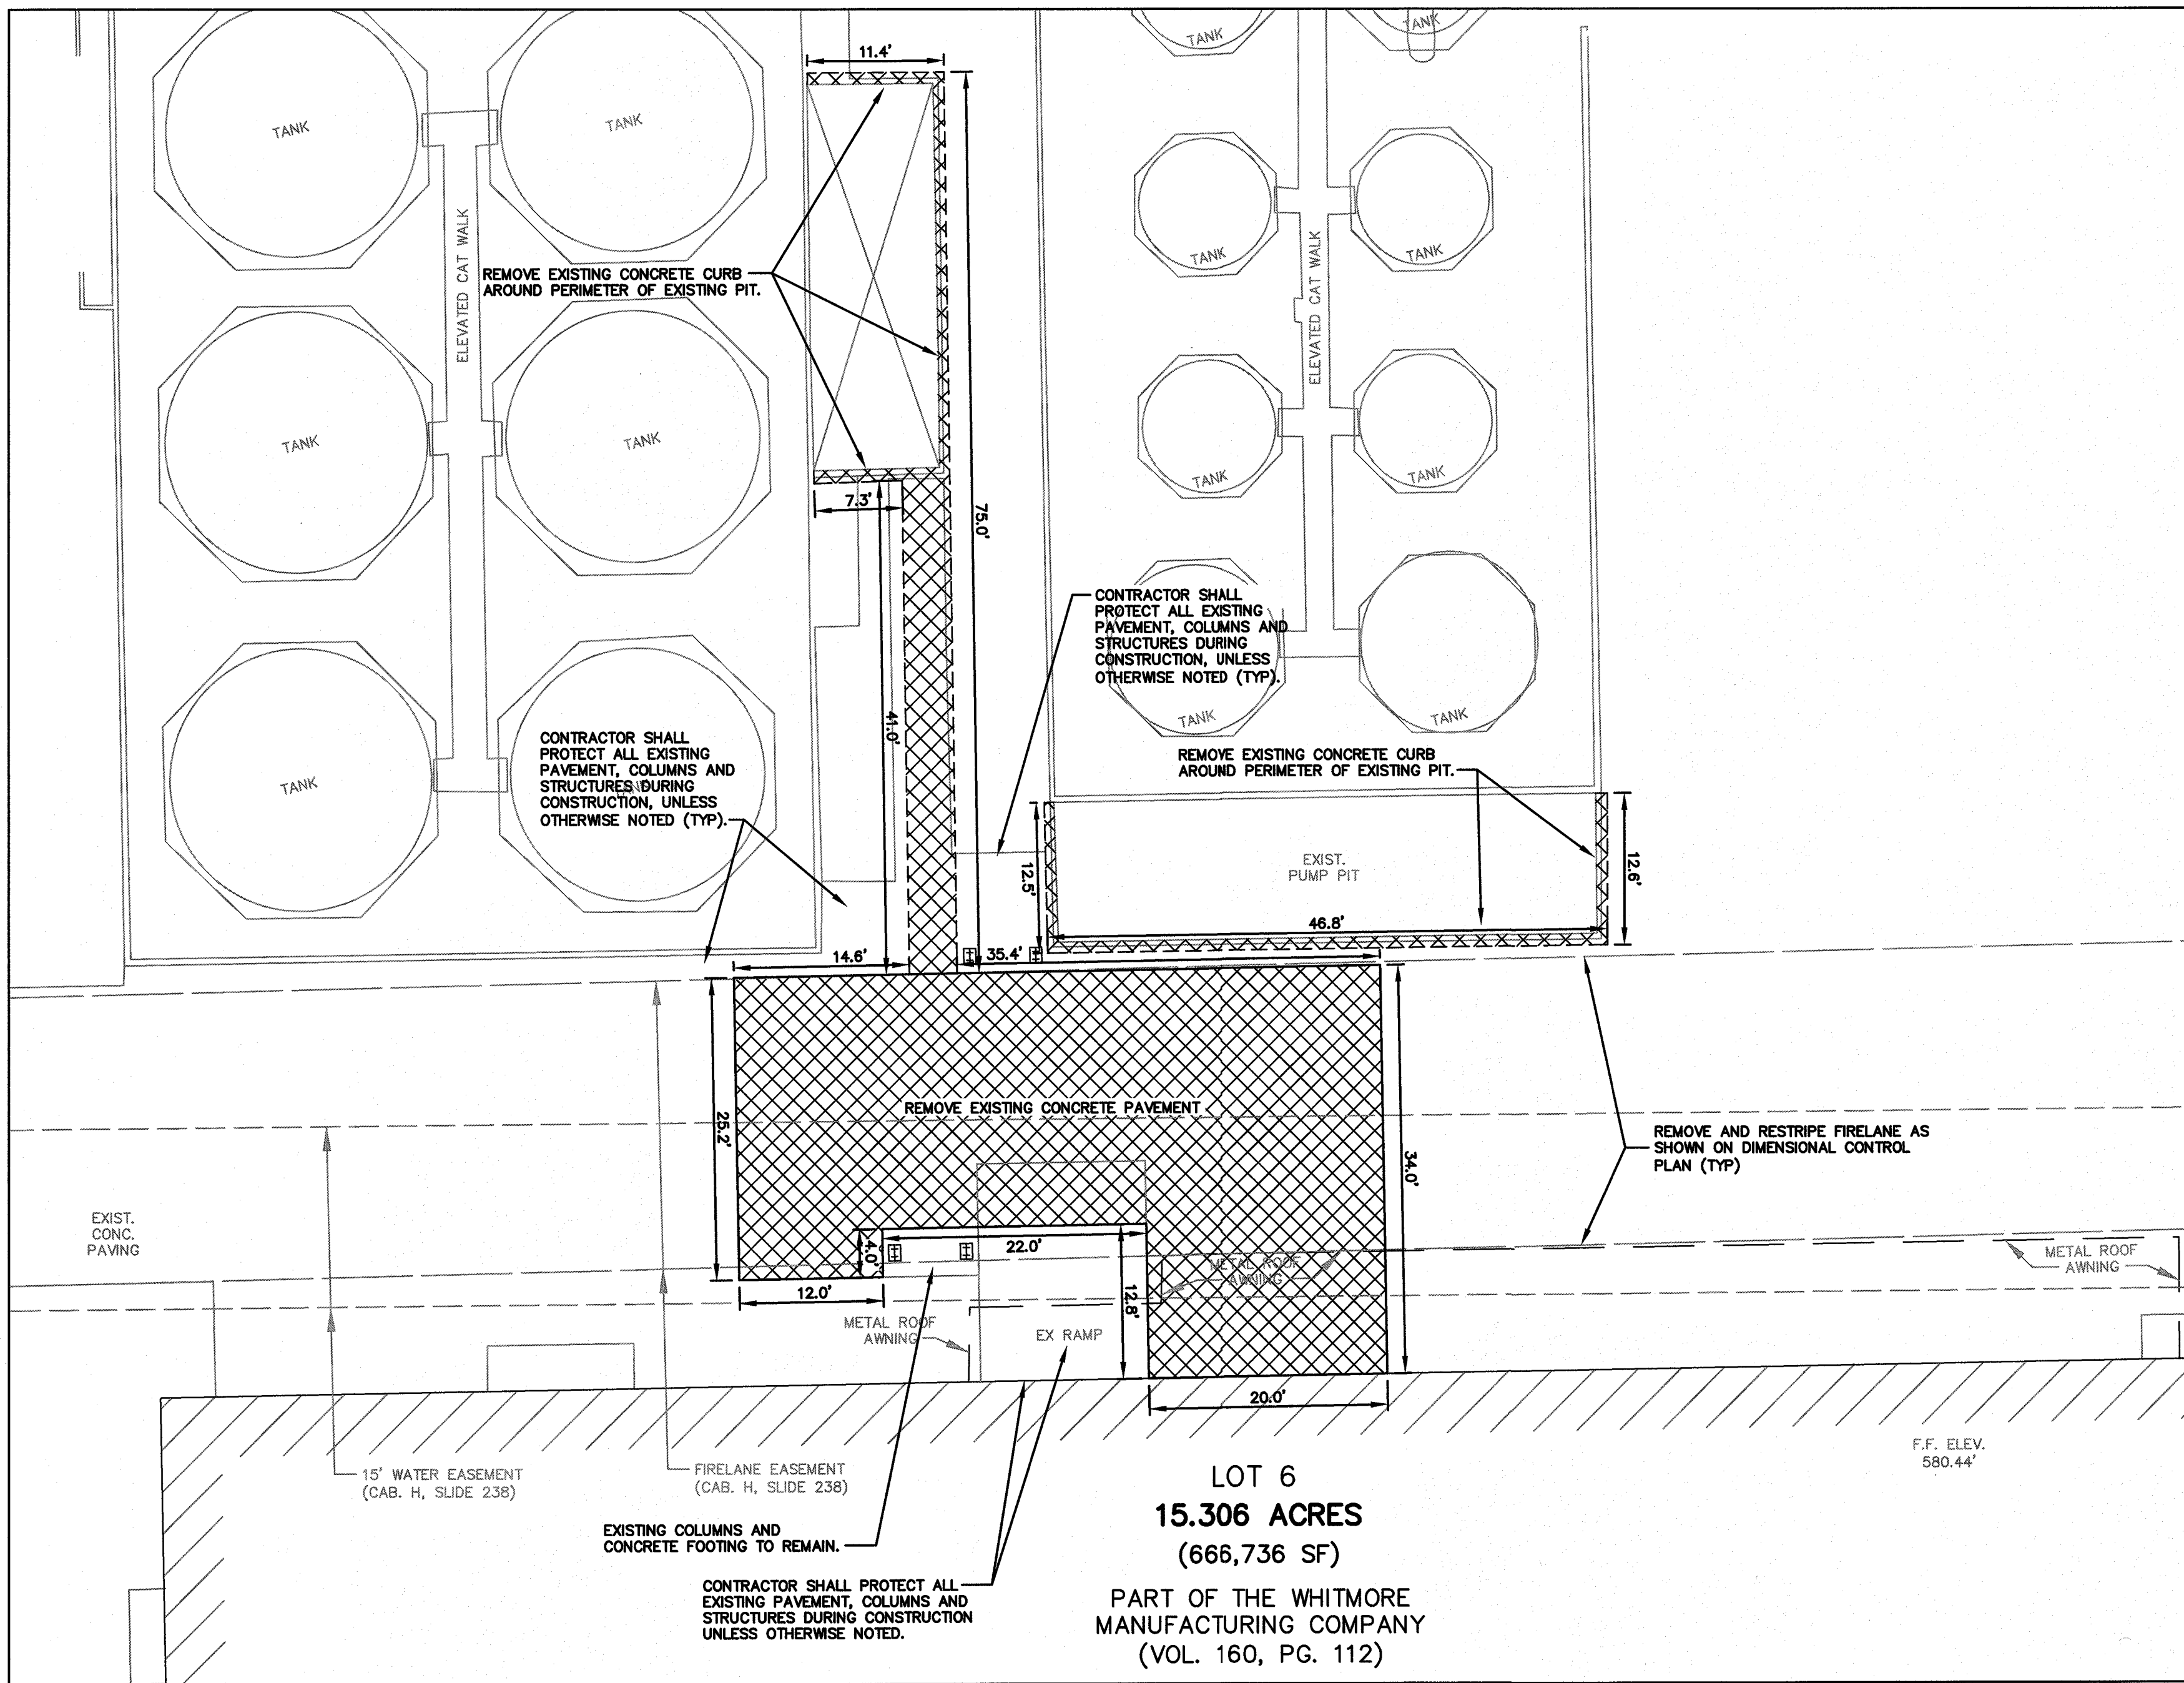

RECORD DRAWING

THE SIGNED AND SEALED CONSTRUCTION DOCUMENT HAS BEEN REVISED TO REFLECT CONSTRUCTION RECORDS MAINTAINED AND PROVIDED BY THE CONTRACTOR FOR THIS PROJECT. THE INFORMATION SHOWN ON THIS RECORD DRAWING, WHICH WAS PROVIDED BY THE CONTRACTOR, OR OTHERS NOT ASSOCIATED WITH THE DESIGN ENGINEER, CANNOT BE VERIFIED FOR ACCURACY OR COMPLETENESS. PACHECO KOCH SHALL ASSUME NO LIABILITY FOR ANY CHANGES MADE DURING CONSTRUCTION THAT WERE NOT SPECIFICALLY APPROVED BY THE ENGINEER PRIOR TO CONSTRUCTION. THE SEALED CONSTRUCTION DRAWINGS ARE ON FILE AT THE OFFICES OF PACHECO KOCH.


ATTESTED BY:

SIGNATURE: *[Signature]*

ENGINEER OF RECORD: KYLE F. WHITIS

CONTRACTOR: BECK

DATE REVISED: 07/07/2014

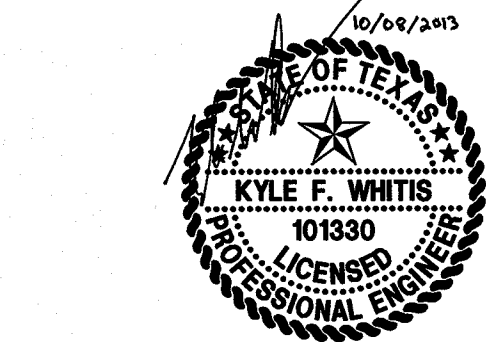

THE SEAL APPEARING ON THIS DOCUMENT WAS AUTHORIZED BY KYLE F. WHITIS, P.E. 101330 ON 10/08/2013. ALTERATION OF A SEALED DOCUMENT WITHOUT PROPER NOTIFICATION TO THE RESPONSIBLE ENGINEER IS AN OFFENSE UNDER THE TEXAS ENGINEERING PRACTICE ACT.

NOTE:
ELEVATIONS SHOWN HAVE NOT BEEN VERIFIED ON THE GROUND BY PACHECO KOCH AND ARE BASED ON A TOPOGRAPHIC SURVEY PROVIDED BY THE OWNER. SEVERAL SITE IMPROVEMENTS HAVE BEEN MADE SINCE SURVEY WAS DONE. CONTRACTOR IS TO CONFIRM EXISTING ELEVATIONS PRIOR TO COMMENCING WORK.

TOPOGRAPHIC SURVEY PREPARED BY:
NORTH TEXAS SURVEYING, LLC
MICHAEL B. ARTHUR, RPLS NO. 5686
DATED: 12/09/2011

NOTE:
ALL RESPONSIBILITY FOR ADEQUACY OF DESIGN REMAINS WITH THE ENGINEER. THE CITY OF ROCKWALL, IN REVIEWING AND RELEASING PLANS FOR CONSTRUCTION, ASSUMES NO RESPONSIBILITY FOR ADEQUACY OR ACCURACY OF DESIGN.

NO.	DATE	REVISION

Pacheco Koch 8350 N. CENTRAL EXPWY, SUITE 1000 DALLAS, TX 75208 972.235.3031
TX REG. ENGINEERING FIRM F-14439
TX REG. SURVEYING FIRM LS-101938-05

DEMO. & DIM. CONTROL PLAN

WHITMORE MANUFACTURING

PHASE 2B

930 WHITMORE DRIVE

CITY OF ROCKWALL, ROCKWALL COUNTY, TEXAS

DESIGN	DRAWN	DATE	SCALE	NOTES	FILE	NO.
JGW	JGW	OCT 2013	1"=10'			C1.1