




ALL RESPONSIBILITY FOR ADEQUACY OF DESIGN REMAINS WITH THE ENGINEER. THE CITY OF ROCKWALL, IN REVIEWING AND RELEASING PLANS FOR CONSTRUCTION, ASSUMES NO

RESPONSIBILITY FOR ADEQUACY OR ACCURACY OF DESIGN.

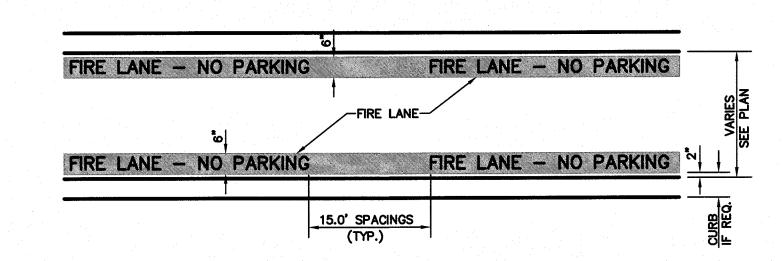


A. STRIPING TO BE DONE IN ACCORDANCE WITH CITY STANDARDS.


## STRIPING DETAIL NOTE:

- 1. STRIPE SHALL BE SIX (6) INCHES WIDE PAINTED WITH AN EXTERIOR ACRYLIC LATEX PAINT.
- A. COLOR SHALL BE "TRAFFIC RED" GLIDDEN NO. 63251 OR EQUAL. 2. LETTERS SHALL BE FOUR (4) INCHES HIGH PAINTED WITH AN EXTERIOR ACRYLIC LATEX PAINT.
- B. COLOR SHALL BE "TRAFFIC WHITE" GLIDDEN NO. 563245 OR EQUAL.
- B. APPLICATION:
- 1. STRIPE MAY BE BRUSHED OR SPRAYED, ONE COAT TO FINISH. 2. LETTERS SHALL BE STENCIL FORMED, BRUSH APPLIED AND SPACED AS DETAILED ON THIS SHEET.



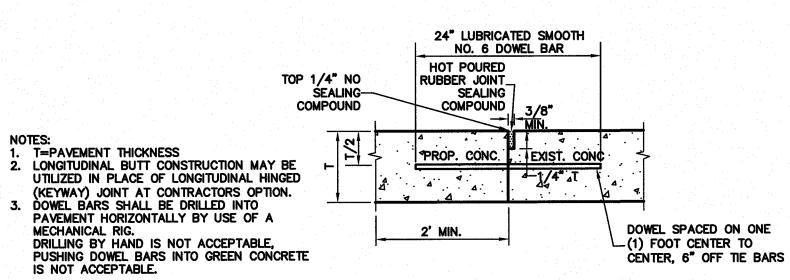

LONGITUDINAL **BUTT JOINT** NOT TO SCALE

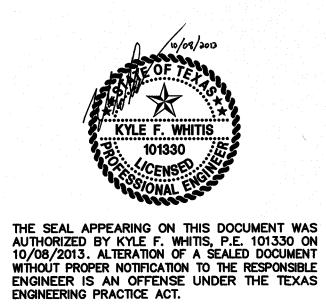

**RECORD DRAWING** THE SIGNED AND SEALED CONSTRUCTION DOCUMENT HAS BEEN REVISED TO REFLECT CONSTRUCTION RECORDS MAINTAINED AND PROVIDED BY THE CONTRACTOR FOR THIS PROJECT. THE INFORMATION SHOWN ON THIS RECORD DRAWING, WHICH WAS PROVIDED BY THE CONTRACTOR, OR OTHERS NOT ASSOCIATED WITH THE DESIGN ENGINEER, CANNOT BE VERIFIED FOR ACCURACY OR COMPLETENESS. PACHECO KOCH SHALL ASSUME NO LIABILITY FOR ANY CHANGES MADE DURING CONSTRUCTION THAT WERE NOT SPECIFICALLY APPROVED BY THE ENGINEER PRIOR TO CONSTRUCTION. THE SEALED CONSTRUCTION DRAWINGS ARE ON FILE AT THE OFFICES OF PACHECO KOCH. ENGINEER OF RECORD: KYLE F. WHITIS CONTRACTOR: BECK DATE REVISED: 07/07/2014

			PARTITION OF THE PARTIT	
NO.	DATE	<b>/</b>	REVISION	
	Pache	eco Koch	8350 N. CENTRAL EXPWY. SUITE 1000 DALLAS, TX 75206 972.235.3031 TX REG. ENGINEERING FIRM F-14439 TX REG. SURVEYING FIRM LS-101938-08	

## PAVING DETAILS

WHITMORE MANUFACTURING

CITY OF ROCKWALL, ROCKWALL COUNTY, TEXAS DESIGN DRAWN DATE SCALE NOTES

JGW PK FILE: 3273-13.288

**C2.2** DWG FILE: 3273-13.288-GR PAV.DWG XREF FILE: 3273-13.288-BA.DWG

PHASE 2B

930 WHITMORE DRIVE

OCT 2013 NTS