



FUTURE DEVELOPED CONDITIONS:
25 YR. STORM

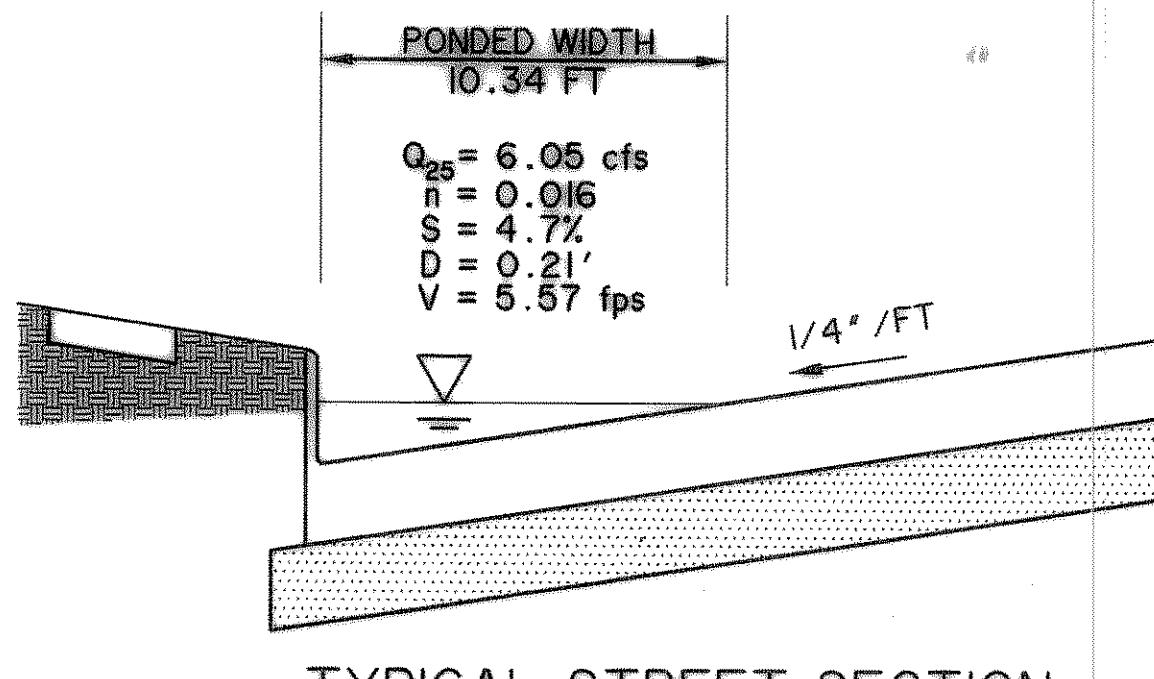


TYPICAL STREET SECTION
'A-A'

FUTURE DEVELOPED CONDITIONS:
CONDITIONS: 100 YR. STORM

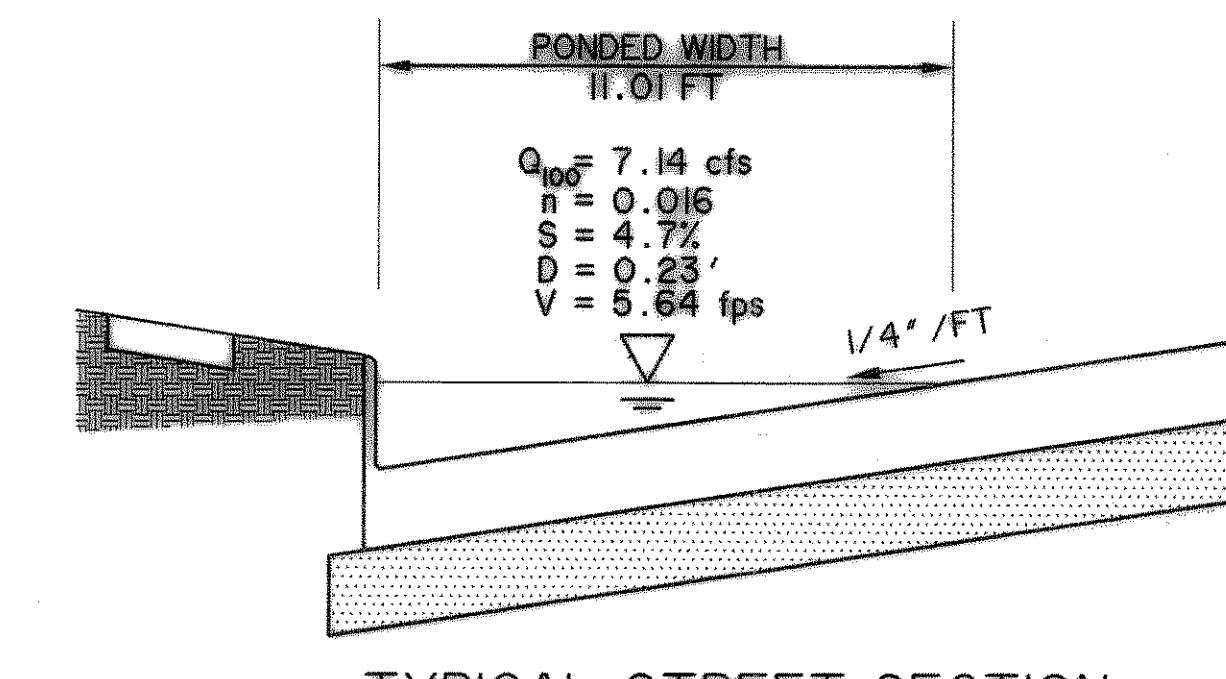

TYPICAL STREET SECTION
'A-A'

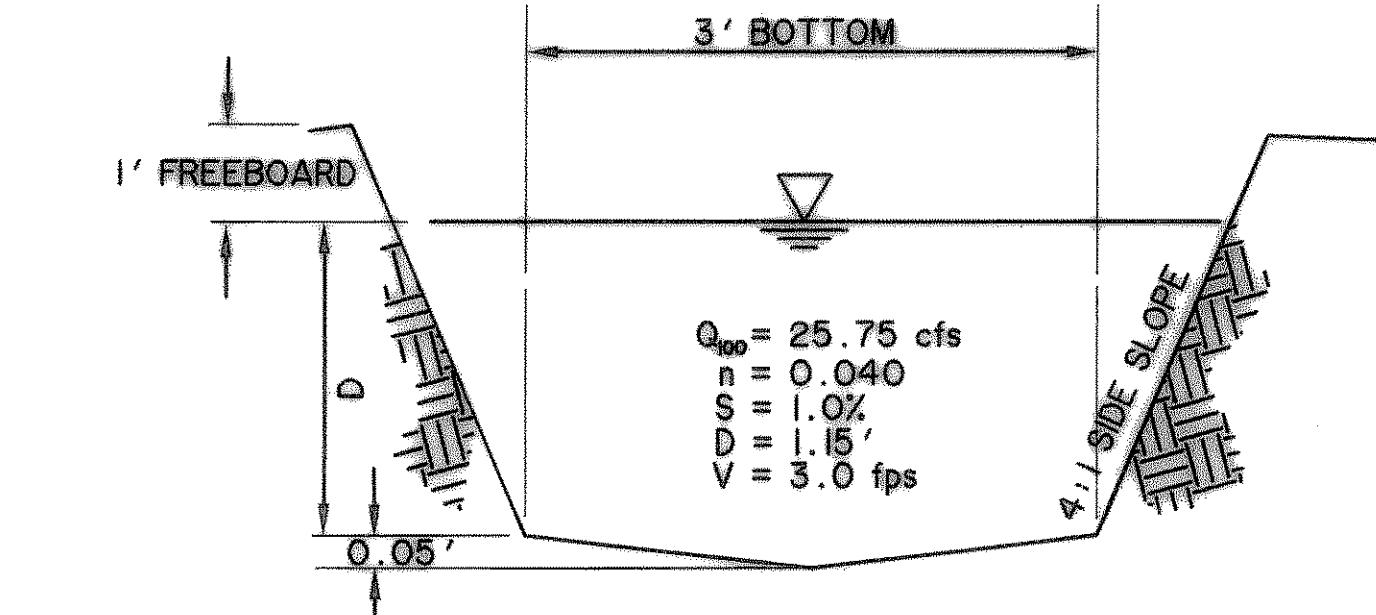


TYPICAL CHANNEL SECTION
'B-B'


CAUTION !!!
UNDERGROUND UTILITIES

EXISTING UTILITIES AND UNDERGROUND FACILITIES INDICATED ON THESE PLANS HAVE BEEN LOCATED FROM REFERENCE INFORMATION SUPPLIED BY VARIOUS OWNERS OF THE FACILITIES. THE ENGINEER DOES NOT ACCEPT THE RESPONSIBILITY FOR THE UTILITY LOCATIONS SHOWN. IT SHALL BE THE RESPONSIBILITY OF THE CONTRACTOR TO VERIFY BOTH HORIZONTALLY AND VERTICALLY THE LOCATION OF ALL EXISTING UTILITIES AND UNDERGROUND FACILITIES PRIOR TO CONSTRUCTION, TO TAKE NECESSARY PRECAUTIONS IN ORDER TO PROTECT ALL FACILITIES ENCOUNTERED, AND TO NOTIFY THE ENGINEER PROMPTLY OF ALL CONFLICTS OF THE WORK WITH EXISTING FACILITIES. THE CONTRACTOR SHALL PRESERVE AND PROTECT ALL EXISTING UTILITIES FROM DAMAGE DURING CONSTRUCTION. ANY DAMAGE BY THE CONTRACTOR TO EXISTING UTILITIES SHALL BE REPAIRED BY THE CONTRACTOR AT HIS EXPENSE.


0 30 60 90 120

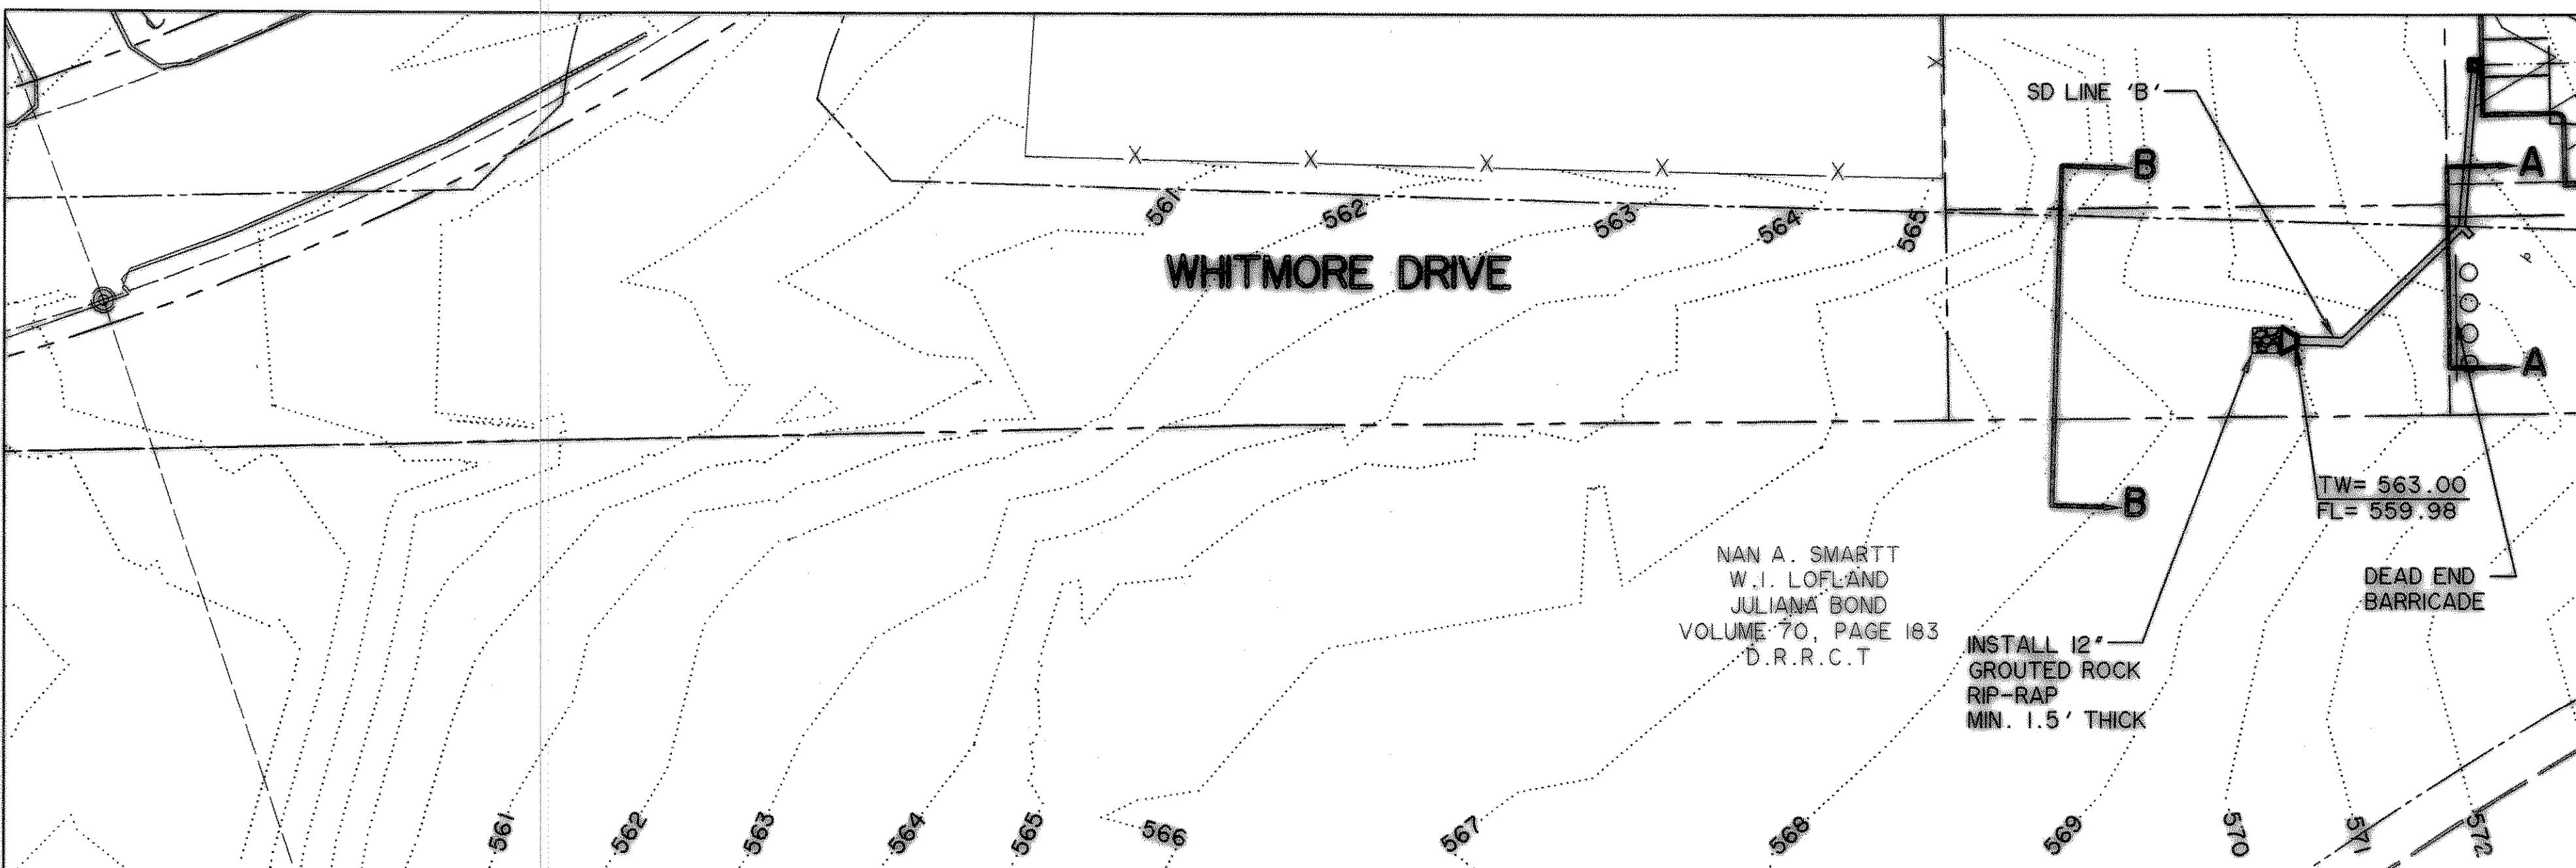


GRADING CROSS SECTIONS

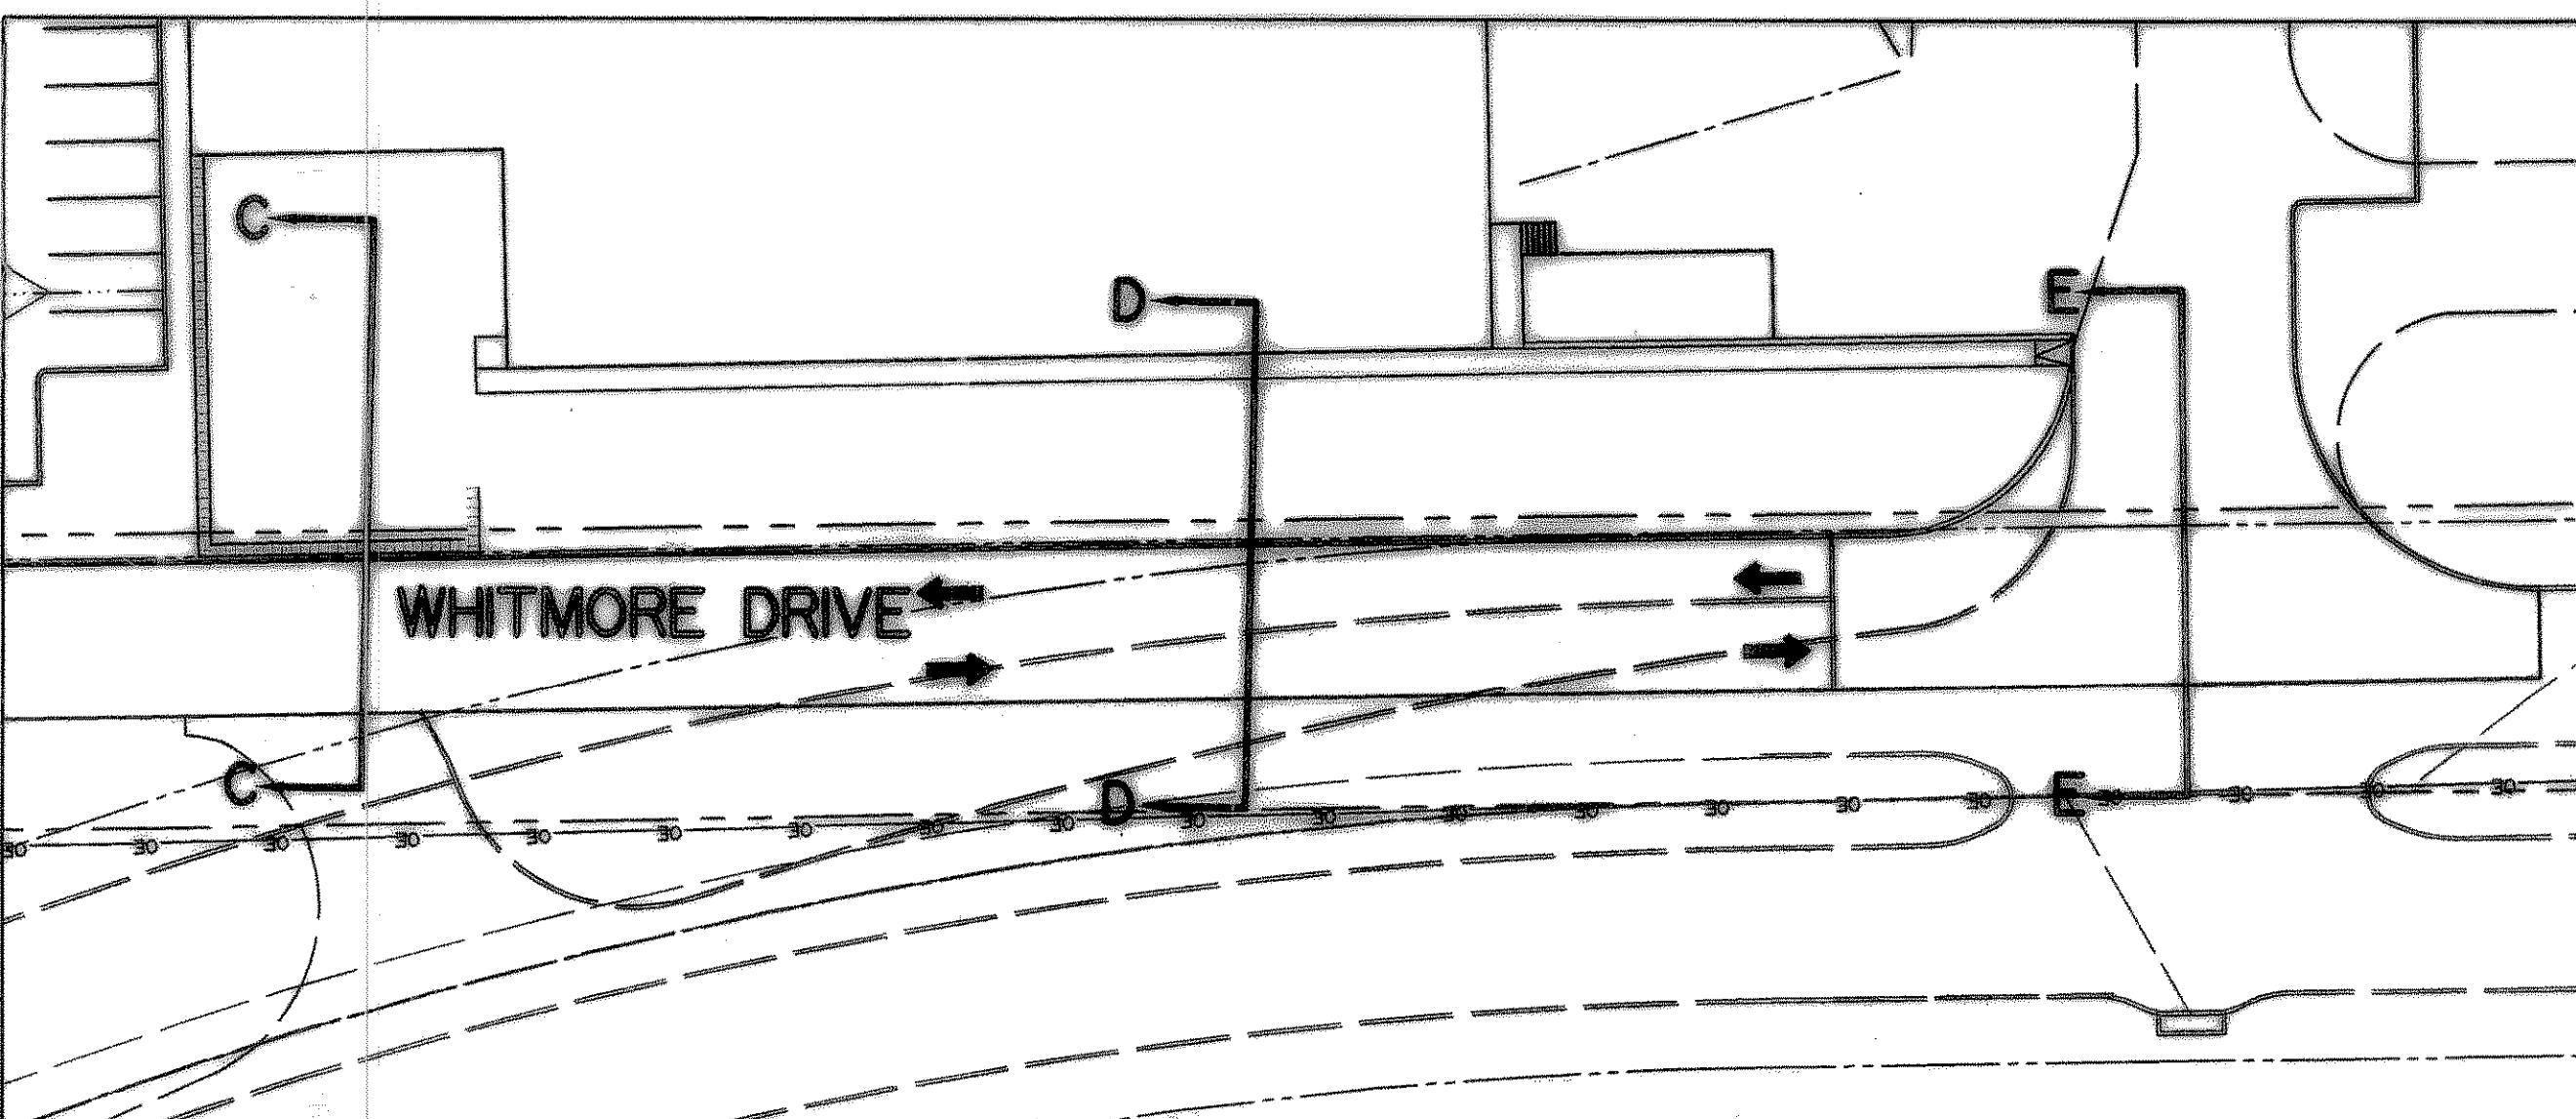


**RECORD
DRAWING
03/13/07**

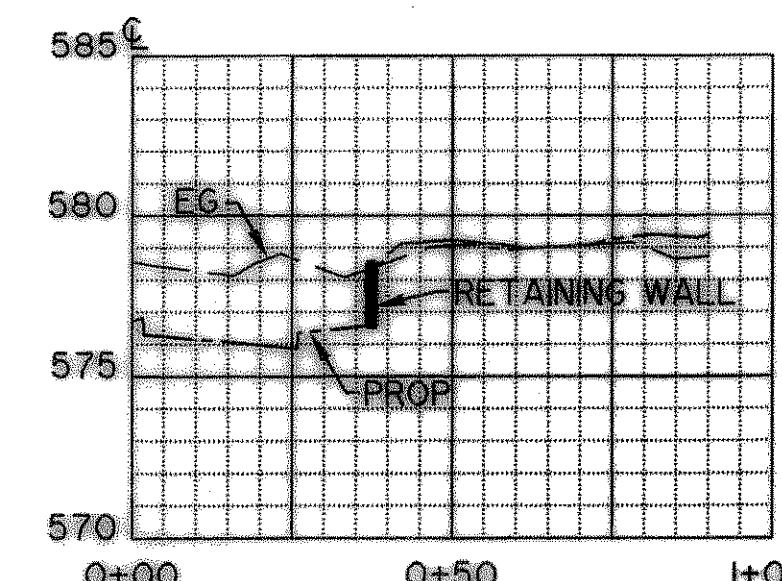


CROSS SECTION
'C-C'

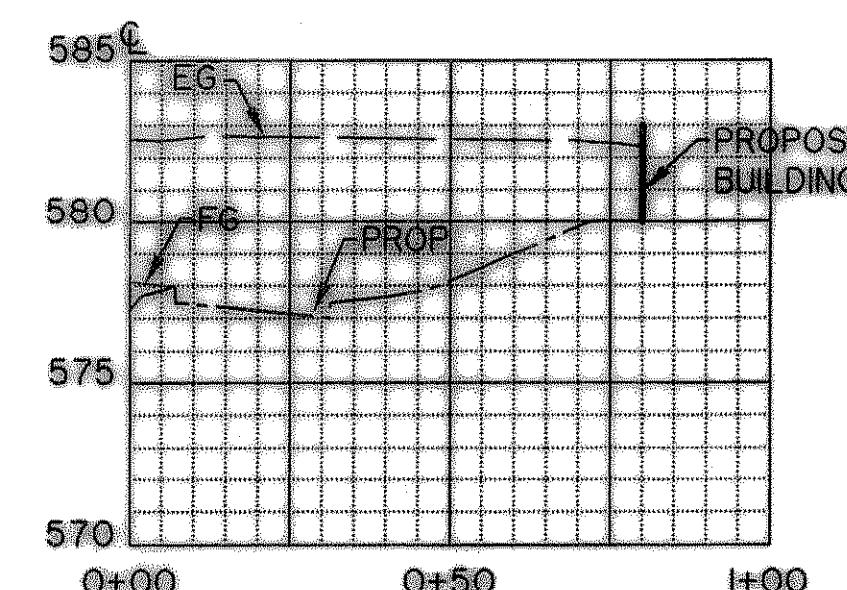


CROSS SECTION
'D-D'

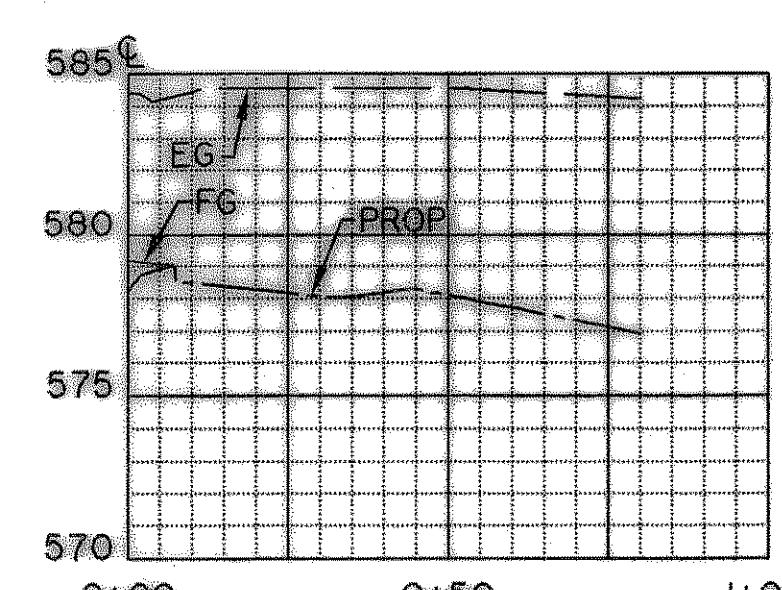

CROSS SECTION
'E-E'

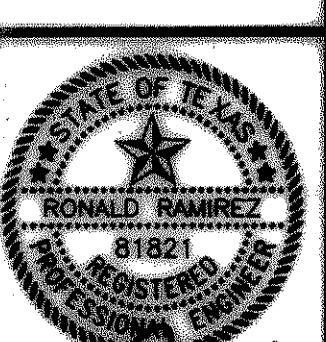

COPYRIGHT ©
WIER & ASSOCIATES, INC.
LAST SHEET EDIT
DATE 03/13/2007
WA# 04124.02
SHEET NO.
G002

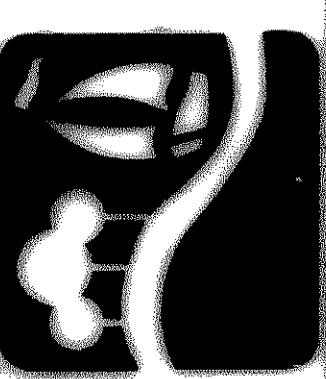

**CITY OF
ROCKWALL
WHITMORE'S
EXPANSION**

**GRADING
PLAN**

PREPARED BY:
WIER & ASSOCIATES, INC.
ENGINEERS SURVEYORS LAND PLANNERS
4300 BELTMAY PLACE, SUITE 130 ALEXANDRIA, TEXAS 76013 METRO (615) 467-7700
1300 U.S. HIGHWAY 207 N, SUITE 101 WIMBERLEY, TEXAS 78650 METRO (615) 477-0700
6849 ELM STREET FRISCO, TEXAS 75034 METRO (214) 387-8000
www.wierassociates.com