

CONSTRUCTION DRAWINGS
FOR
LOLLICUP USA WAREHOUSE
CITY OF ROCKWALL
"THE NEW HORIZON"

RECORD DRAWINGS
MARCH 6, 2018

JIM PRUITT * MAYOR

BENNIE DANIELS
JOHN HOHENSHELT * MAYOR PRO-TEM
KEVIN FOWLER
DENNIS LEWIS
DANA MACALIK
MIKE TOWNSEND


RICK CROWLEY * CITY MANAGER

OWNER
ALAN YU, LOLLICUP USA
6185 KIMBALL AVE.
CHINO, CA 91708
PH: 626.965.8882
EM: ALAN.YU@LOLLICUP.COM

ENGINEER
BRETT BRISTOW, P.E.
TXPE# 101000
FREESE AND NICHOLS
PH: 214.217.2225
EM: BMB@FREESE.COM

**FREESE
AND
NICHOLS**
2711 NORTH HASKELL AVE, SUITE 3300
DALLAS, TEXAS 75204
PHONE - 214.217.2200
FAX - 214.217.2201

SITE ADDRESS - 3201 CAPITAL BLVD. ROCKWALL, TX 75032
PROJECT NO. - SP2017-042
SUBDIVISION - ROCKWALL TECHNOLOGY PARK, PHASE 2
BLOCK - A
LOT NO. - 2
PARCEL NO. - 0125-000-0002-01-0R

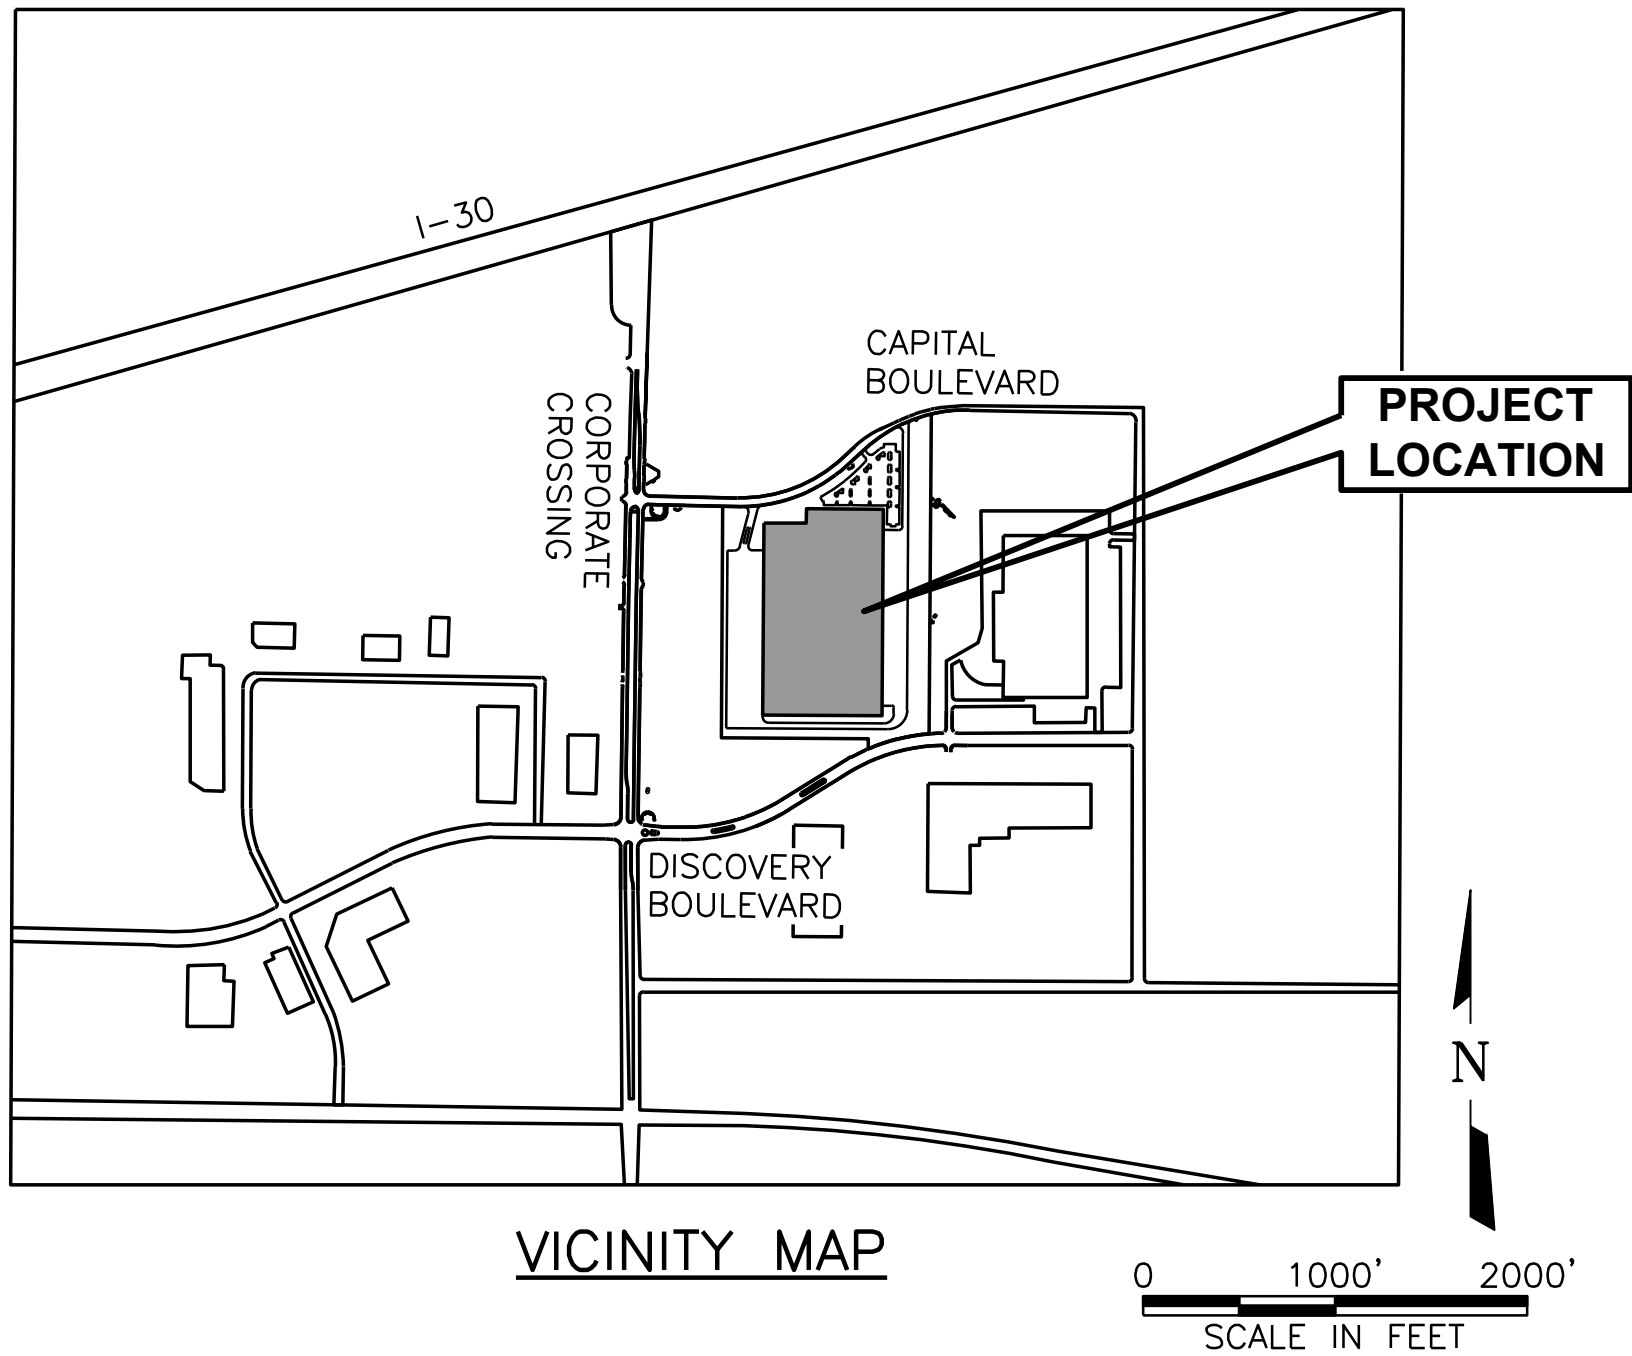

SHEET	DESCRIPTION
C00-00	COVER
C00-01	FINAL PLAT
C01-00	APPROVED SITE PLAN
C01-01	GENERAL NOTES
C01-02	PAVING AND DIMENSION CONTROL PLAN
C02-00	PAVING AND DIMENSION CONTROL PLAN
C02-01	COORDINATE POINTS
C02-02	OVERALL GRADING AND EROSION CONTROL PLAN
C02-03	DETAILED GRADING PLAN
C03-00	DETAILED GRADING PLAN
C03-01	DETAILED PARKING LOT GRADING PLAN
C04-00	DRAINAGE AREA MAP AND CALCULATIONS
C04-01	PROJECT CALCULATIONS
C04-02	OVERALL STORM DRAINAGE PLAN
C04-03	OVERALL STORM DRAINAGE PLAN
C04-04	STORM DRAIN LINE A PLAN AND PROFILE
C04-05	STORM DRAIN LINE A PLAN AND PROFILE
C04-06	STORM DRAIN LINE B PLAN AND PROFILE
C04-07	STORM DRAIN LINE B PLAN AND PROFILE
C04-08	STORM DRAIN LINE B PLAN AND PROFILE
C04-09	STORM DRAIN LINE B PLAN AND PROFILE
C04-10	STORM DRAIN LINE C PLAN AND PROFILE
C04-11	STORM DRAIN LINE D-1 PLAN AND PROFILE
C04-12	STORM DRAIN LINE D-1 PLAN AND PROFILE
C04-13	STORM DRAIN LINE D-2 PLAN AND PROFILE
C04-14	STORM DRAIN LINE E AND F PLAN AND PROFILE
C04-15	STORM DRAIN B LATERALS
C04-16	STORM DRAIN D, B-7, AND B-8 LATERALS
C05-00	OVERALL UTILITY PLAN
C05-01	OVERALL UTILITY PLAN
C05-02	SANITARY SEWER PLAN AND PROFILE
C06-00	PAVING DETAILS
C06-01	EROSION CONTROL DETAILS
C06-02	TXDOT SAFETY END TREATMENT DETAILS

REVISION

-ISSUED FOR REVIEW - 02-02-2018
-SECOND REVIEW - 03-02-2018
-THIRD REVIEW - 03-23-2018
-ISSUED FOR CONSTRUCTION - 04-10-2018
-RECORD DRAWINGS - 03-06-2019

THE SEAL THAT ORIGINALLY APPEARED ON THIS DOCUMENT
WAS AUTHORIZED BY BRETT M. BRISTOW, P.E.
TEXAS NO. 101000 ON 3/20/2018
ALTERNATION OF A SEALED DOCUMENT WITHOUT PROPER
NOTIFICATION OF THE RESPONSIBLE ENGINEER IS AN
OFFENSE UNDER THE TEXAS ENGINEERING PRACTICE ACT.

This Record Drawing is a combination of the
sealed engineering contract drawings for this
project, modified by information furnished by the
contractor reflecting changes in the Project made
during construction. The original sealed drawings
are on file at the offices of
FREESE AND NICHOLS, INC.
RECORD DRAWINGS PREPARED ON:
3/6/2018

Freese and Nichols, Inc.
Texas Registered Engineering Firm F-2144

12/2/2017 1:31:05 PM

BENCHMARKS:
BENCHMARK A—AN "X" CUT IN THE CENTER OF THE SIDEWALK AT THE END OF THE HANDICAP RAMP AT THE SOUTHEAST CORNER OF THE INTERSECTION OF DISCOVERY BLVD. AND DATA DR., 11 FEET SOUTHEAST OF THE CURB LINE.
ELEV=600.44
BENCHMARK B—AN "X" CUT ON THE CURB ON THE NORTH SIDE OF DISCOVERY BLVD. 580 FEET EAST OF CORPORATE CROSSING, 11 FEET SOUTHEAST OF A FIRE HYDRANT, AND 19 FEET NORTHEAST OF TWO (2) WATER VALVES.
ELEV=599.67

Copyright © 2017 Forum Studio, Inc.


E

D

C

B

A

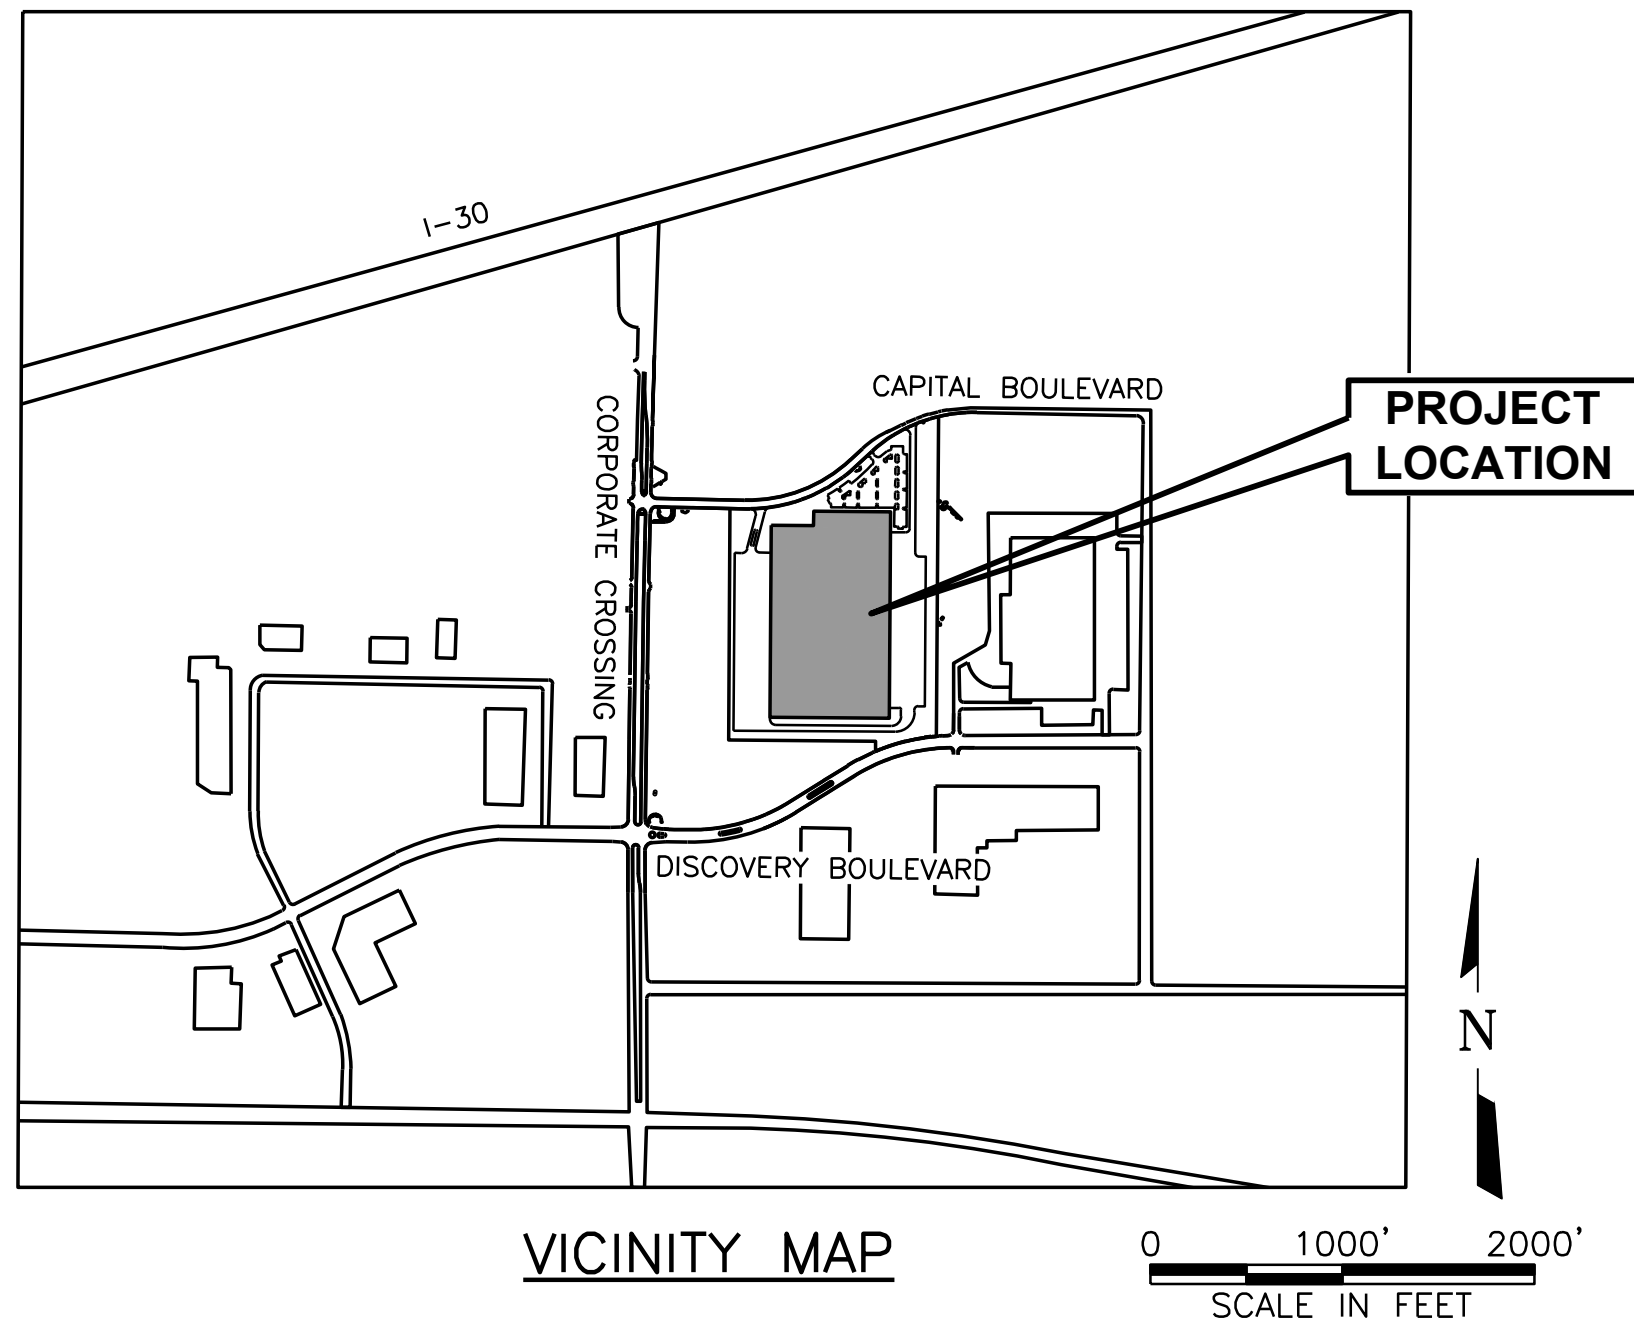

VICINITY MAP

PROJECT LOCATION


SITE PLAN INFORMATION		
SECTION 2.1		
TOTAL LOT AREA	34.23 AC	
BUILDING AREA	650,000 SF	
SECTION 2.2		
PARKING SPACES	REQUIRED	PROVIDED
	VARIANCE	196 SPACES
ADA SPACES	REQUIRED	PROVIDED
	7	7
DEPTHS/TYPES	TRUCK DRIVE/PARKING	PARKING LOT
PAVEMENT	8" CONCRETE	6" CONCRETE
LIME STABILIZATION	6"	6"

DATA TABLE

- LEGEND**
- ② PARKING SPACE QUANTITY
 - 24' FIRELANE, PUBLIC ACCESS, AND UTILITY EASEMENT
 - PROPOSED LOT TO BE PLATTED DURING DESIGN (34.23 AC)
 - PROPOSED 5' SIDEWALK

NOTES

- REFER TO LANDSCAPE ARCHITECTURE PLANS FOR LANDSCAPE BUFFER STRIPS ALONG DISCOVERY BLVD. AND CAPITAL BLVD.

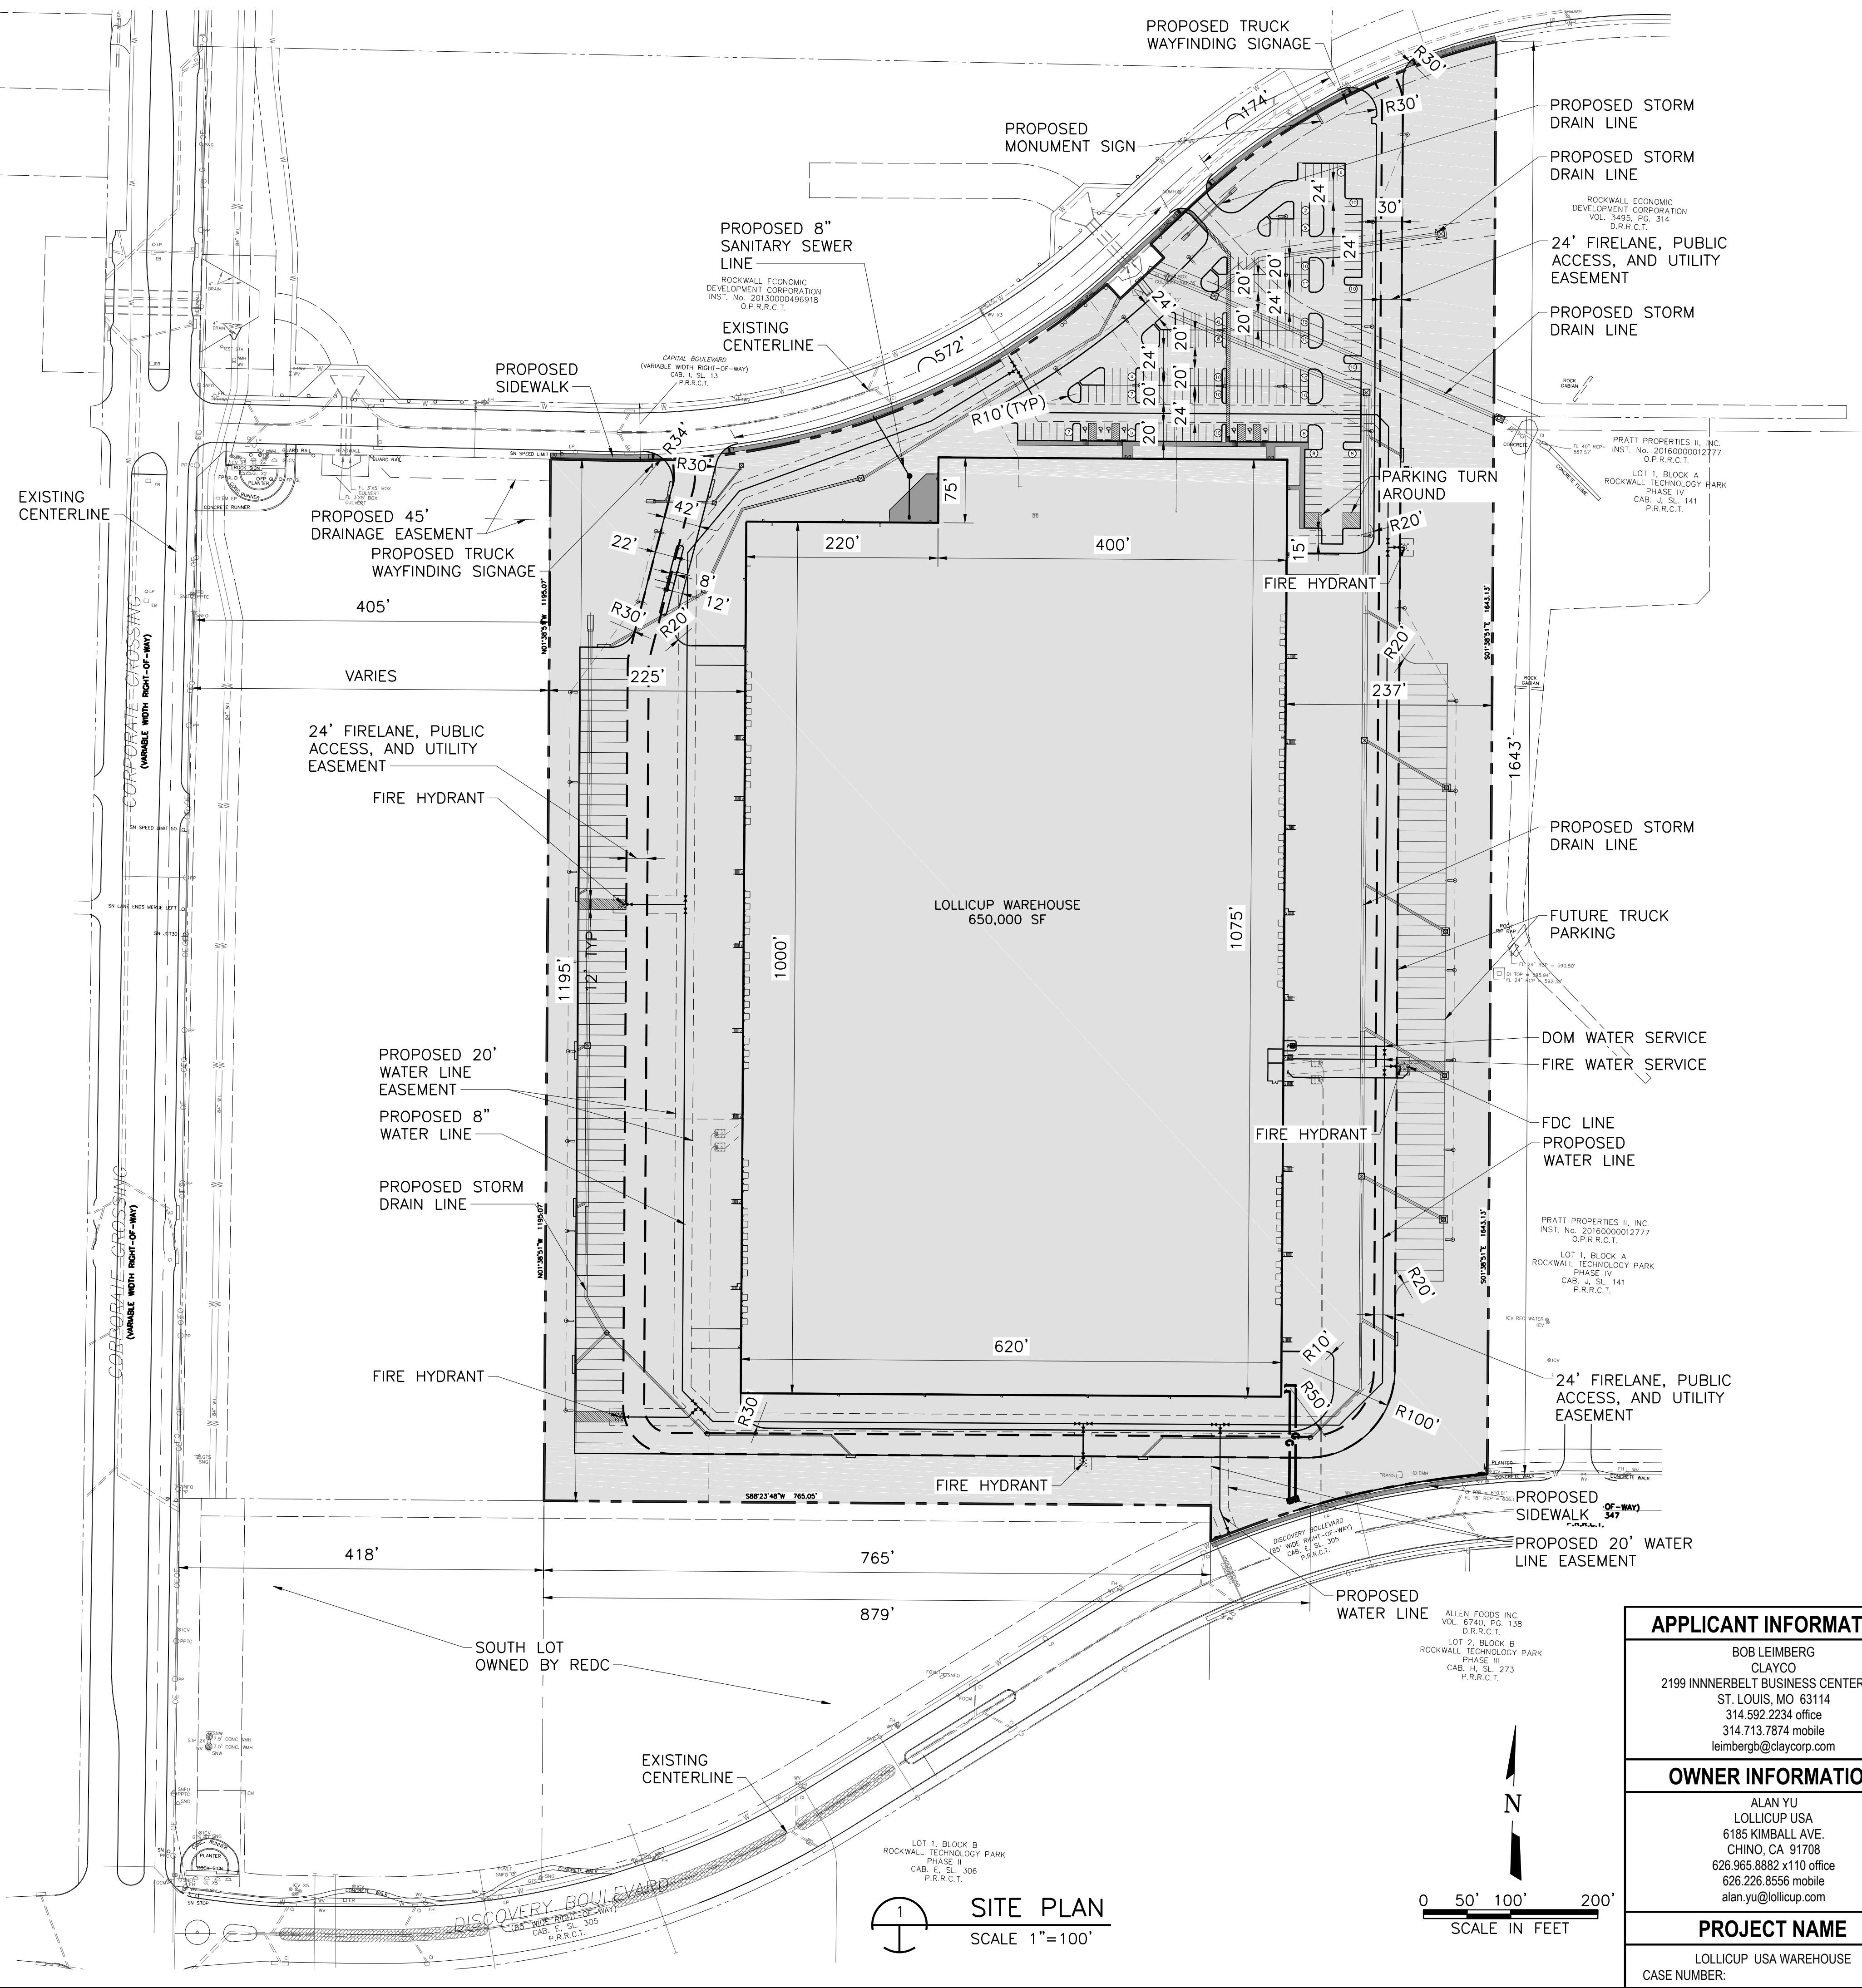

SITE PLAN
SCALE 1"=100'

0 50' 100' 200'
SCALE IN FEET

APPLICANT INFORMATION		DESCRIPTION	DATE
BOB LEIMBERG CLAYCO 2199 INNERBELT BUSINESS CENTER DR. ST. LOUIS, MO 63114 314.592.2234 office 314.713.7874 mobile leimbergb@claycorp.com		ENGINEERING SUBMITTAL	2/2/2018
		CITY OF ROCKWALL	
		ENGINEERING REVIEW	3/2/2018
		2ND SUBMITTAL	
		ENGINEERING REVIEW	3/23/2018
		3RD SUBMITTAL	
		ISSUED FOR CONSTRUCTION	4/10/2018
OWNER INFORMATION		RECORD DRAWING	3/6/2019
ALAN YU LOLLICUP USA 6185 KIMBALL AVE. CHINO, CA 91708 626.965.8882 x110 office 626.226.8556 mobile alan.yu@lolicup.com		DRAWING TITLE	
		SITE PLAN	
LOLLICUP USA WAREHOUSE CASE NUMBER:		DRAWING NO.	
		C00-00	
		Forum #	601-03049
		Consult #	101-03049

THE SEAL THAT ORIGINALLY APPEARED ON THIS DOCUMENT WAS AUTHORIZED BY: BRIET M. BRISLOW, P.E.
TEXAS NO. 109000 ON 2/20/2018
ALTERNATION OF A SEALED DOCUMENT WITHOUT PROPER NOTIFICATION OF THE RESPONSIBLE ENGINEER IS AN OFFENSE UNDER THE TEXAS ENGINEERING PRACTICE ACT.

This Record Drawing is a combination of the sealed engineering contract drawings for this project, modified by information furnished by the contractor reflecting changes in the Project made during construction. The original sealed drawings are on file at the offices of:
FREESE AND NICHOLS, INC.
RECORD DRAWINGS PREPARED ON: 3/6/2019

4
CLAYCO
THE ART & SCIENCE OF BUILDING
2199 INNERBELT BUSINESS CENTER DRIVE
ST. LOUIS, MISSOURI 63114
PH 314.428.5100 FX 314.428.3137

ARCHITECT
FORUM
2199 INNERBELT BUSINESS CENTER DRIVE
ST. LOUIS, MISSOURI 63114
PH 314.428.1010 FX 314.428.7770

CONTRACTOR / DEVELOPER
CLAYCO

LANDSCAPE ARCHITECT
FORUM

CIVIL ENGINEER
FREESE & NICHOLS

STRUCTURAL ENGINEER

MECHANICAL ENGINEER

ELECTRICAL ENGINEER

PLUMBING ENGINEER

FIRE PROTECTION ENGINEER

2
Lolicup
ROCKWALL TECHNOLOGY PARK
ROCKWALL, TEXAS

DRAWING ISSUE

DESCRIPTION	DATE
ENGINEERING SUBMITTAL	2/2/2018
CITY OF ROCKWALL	
ENGINEERING REVIEW	3/2/2018
2ND SUBMITTAL	
ENGINEERING REVIEW	3/23/2018
3RD SUBMITTAL	
ISSUED FOR CONSTRUCTION	4/10/2018
RECORD DRAWING	3/6/2019

DRAWING TITLE
SITE PLAN

DRAWING NO.

C00-00

Forum # 601-03049 Consult # 101-03049

12/22/2017 1:31:05 PM

Copyright © 2017 Forum Studio, Inc.


E

D

C

B

A

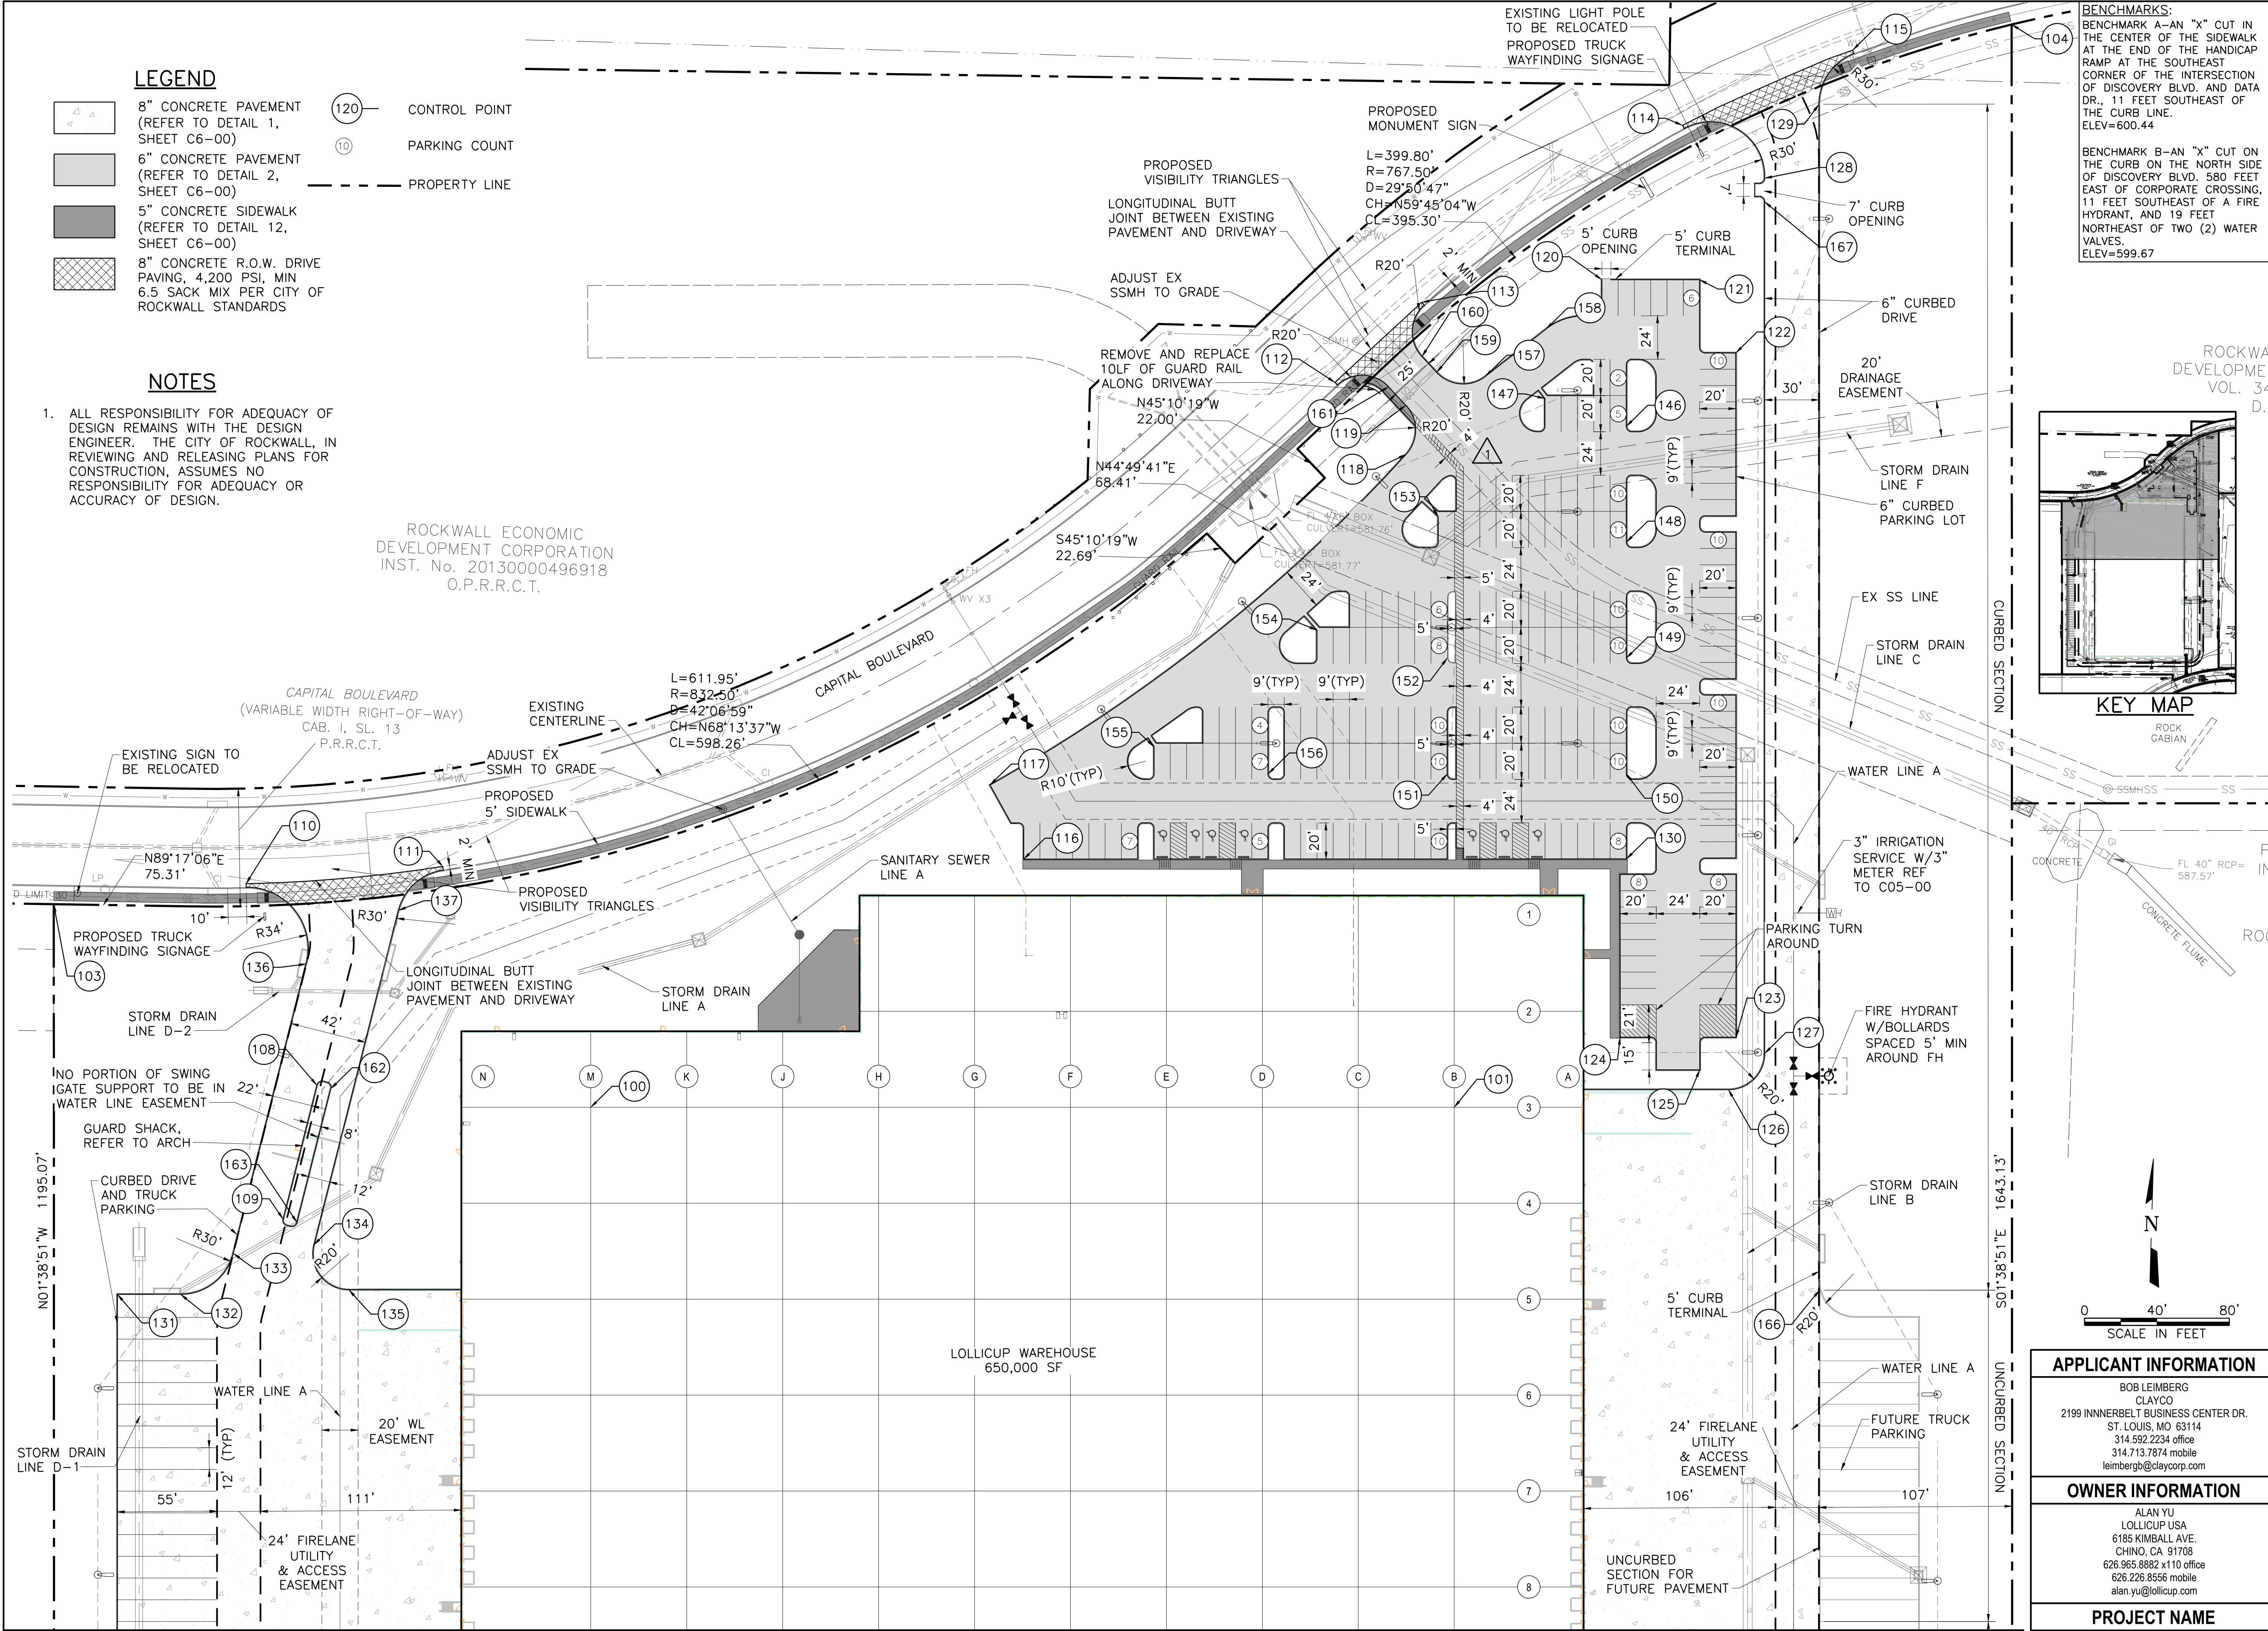

LEGEND


- 8" CONCRETE PAVEMENT (REFER TO DETAIL 1, SHEET C6-00)
- 6" CONCRETE PAVEMENT (REFER TO DETAIL 2, SHEET C6-00)
- 5" CONCRETE SIDEWALK (REFER TO DETAIL 12, SHEET C6-00)
- 8" CONCRETE R.O.W. DRIVE PAVING, 4,200 PSI, MIN 6.5 SACK MIX PER CITY OF ROCKWALL STANDARDS
- CONTROL POINT
- PARKING COUNT
- PROPERTY LINE

NOTES

- ALL RESPONSIBILITY FOR ADEQUACY OF DESIGN REMAINS WITH THE DESIGN ENGINEER. THE CITY OF ROCKWALL, IN REVIEWING AND RELEASING PLANS FOR CONSTRUCTION, ASSUMES NO RESPONSIBILITY FOR ADEQUACY OR ACCURACY OF DESIGN.

ROCKWALL ECONOMIC
DEVELOPMENT CORPORATION
INST. No. 20130000496918
O.P.R.R.C.T.

BENCHMARKS:
BENCHMARK A-AN "X" CUT IN THE CENTER OF THE SIDEWALK AT THE END OF THE HANDICAP RAMP AT THE SOUTHEAST CORNER OF THE INTERSECTION OF DISCOVERY BLVD. AND DATA DR., 11 FEET SOUTHEAST OF THE CURB LINE. ELEV=600.44
BENCHMARK B-AN "X" CUT ON THE CURB ON THE NORTH SIDE OF DISCOVERY BLVD. 580 FEET EAST OF CORPORATE CROSSING, 11 FEET SOUTHEAST OF A FIRE HYDRANT, AND 19 FEET NORTHEAST OF TWO (2) WATER VALVES. ELEV=599.67

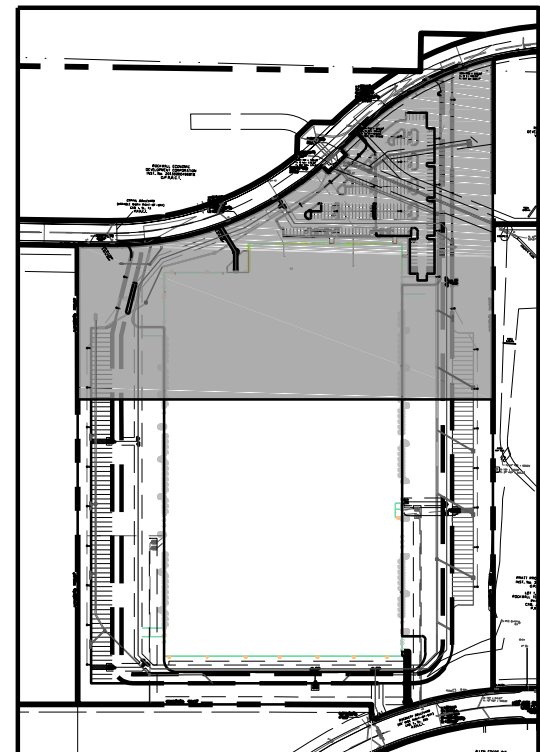

KEY MAP

THE SEAL THAT ORIGINALLY APPEARED ON THIS DOCUMENT WAS AUTHORIZED BY: JEFFREY M. BROSOWSKI, EITC, TEXAS NO. 10100, EXPIRATION DATE: 12/22/2018. ALTERNATION OF A SEALED DOCUMENT WITHOUT PROPER NOTIFICATION OF THE RESPONSIBLE ENGINEER IS AN OFFENSE UNDER THE TEXAS ENGINEERING PRACTICE ACT.

This Record Drawing is a combination of the sealed engineering contract drawings for this project, modified by information furnished by the contractor reflecting changes in the Project made during construction. The original sealed drawings are on file at the offices of:

FREESE AND NICHOLS, INC.
RECORD DRAWINGS PREPARED ON: 3/6/2019

CLAYCO
THE ART & SCIENCE OF BUILDING
2199 INNERBELT BUSINESS CENTER DRIVE
ST. LOUIS, MISSOURI 63114
Ph 314.429.1010 Fx 314.429.3137

FORUM
2199 INNERBELT BUSINESS CENTER DRIVE
ST. LOUIS, MISSOURI 63114
Ph 314.429.1010 Fx 314.429.7770

CONTRACTOR / DEVELOPER
CLAYCO

LANDSCAPE ARCHITECT
FORUM

CIVIL ENGINEER
FREESE & NICHOLS

STRUCTURAL ENGINEER

MECHANICAL ENGINEER

ELECTRICAL ENGINEER

PLUMBING ENGINEER

FIRE PROTECTION ENGINEER

Lolicup
ROCKWALL TECHNOLOGY PARK
ROCKWALL, TEXAS

DRAWING ISSUE

DESCRIPTION	DATE
ENGINEERING SUBMITTAL	2/2/2018
CITY OF ROCKWALL	
ENGINEERING REVIEW	3/2/2018
2ND SUBMITTAL	
ENGINEERING REVIEW	3/23/2018
3RD SUBMITTAL	
ISSUED FOR CONSTRUCTION	4/10/2018
ADA REVISIONS	6/22/2018
RECORD DRAWING	3/6/2019


DRAWING TITLE
PAVING AND DIMENSION
CONTROL PLAN

DRAWING NO.
C01-00

PROJECT NAME
LOLLICUP USA WAREHOUSE

CASE NUMBER:
601-03049


Consult#
101-03049

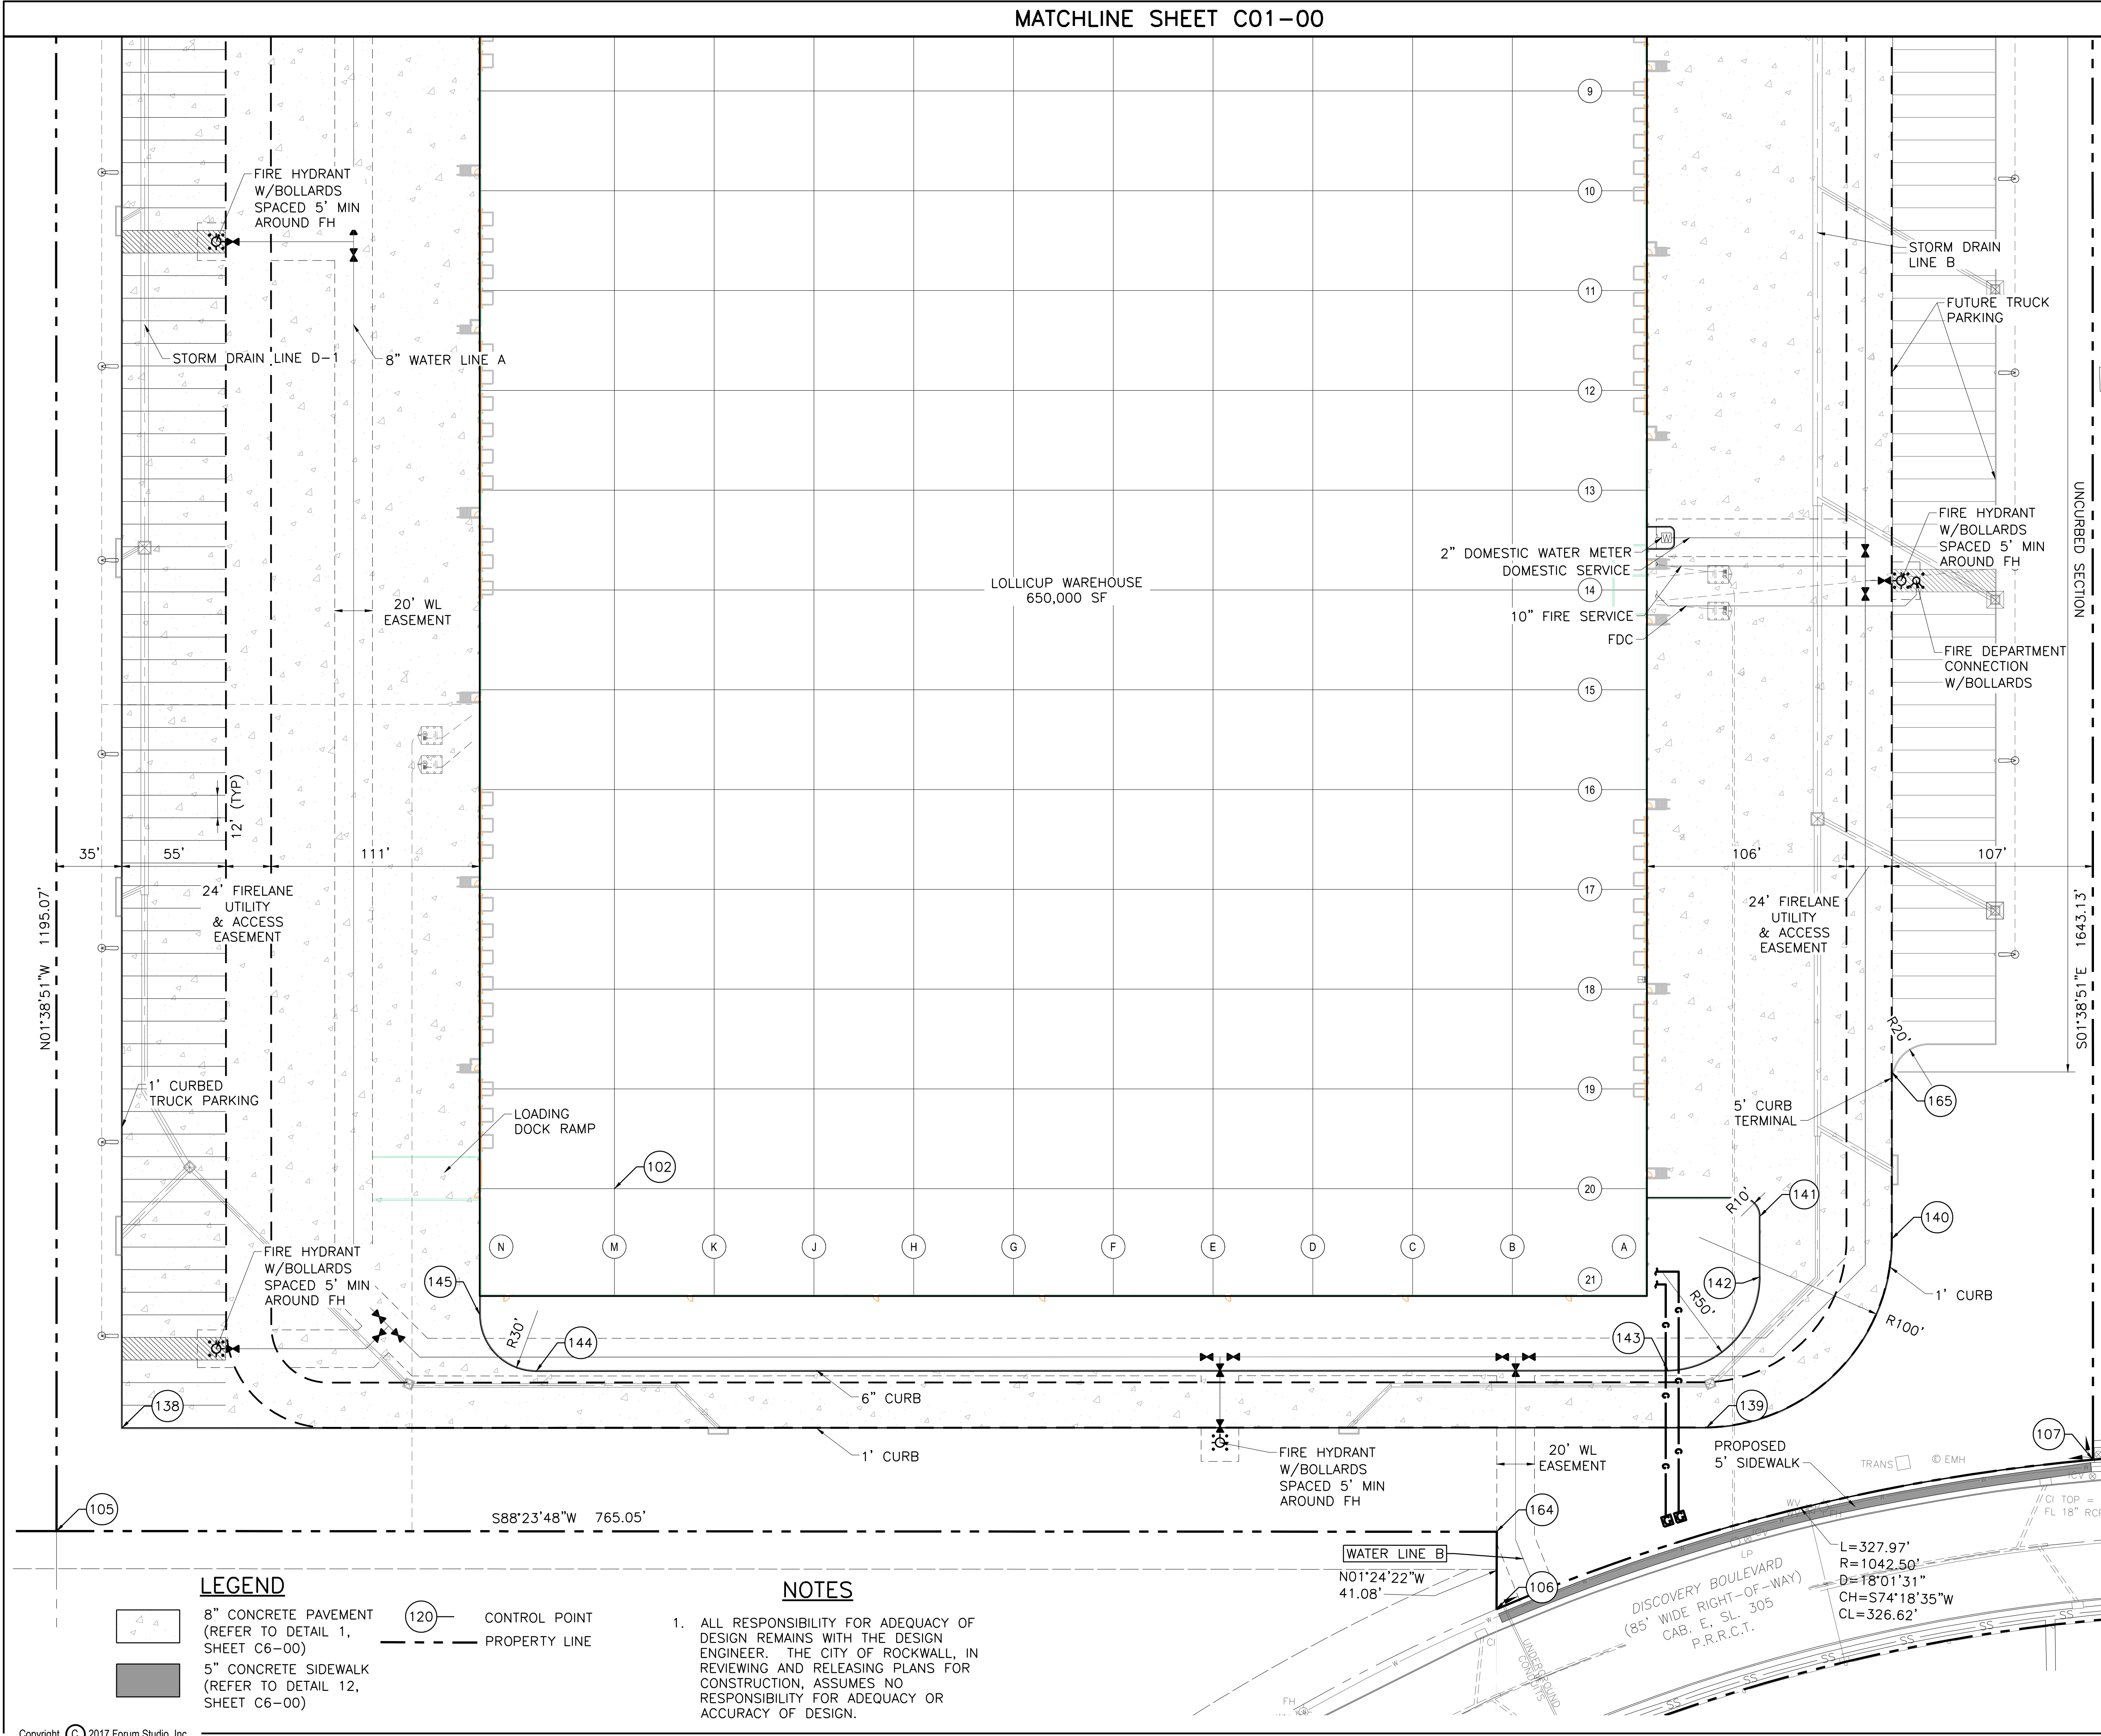

BENCHMARKS:
BENCHMARK A-AN "X" CUT IN THE CENTER OF THE SIDEWALK AT THE END OF THE HANDICAP RAMP AT THE SOUTHEAST CORNER OF THE INTERSECTION OF DISCOVERY BLVD. AND DATA DR., 11 FEET SOUTHEAST OF THE CURB LINE.
ELEV=600.44


BENCHMARK B-AN "X" CUT ON THE CURB ON THE NORTH SIDE OF DISCOVERY BLVD. 580 FEET EAST OF CORPORATE CROSSING, 11 FEET SOUTHEAST OF A FIRE HYDRANT, AND 19 FEET NORTHEAST OF TWO (2) WATER VALVES.
ELEV=599.67

ROCK R/P R/P
FL 24" RCP = 590.50'
DI TOP = 595.94'
FL 24" RCP = 592.33'

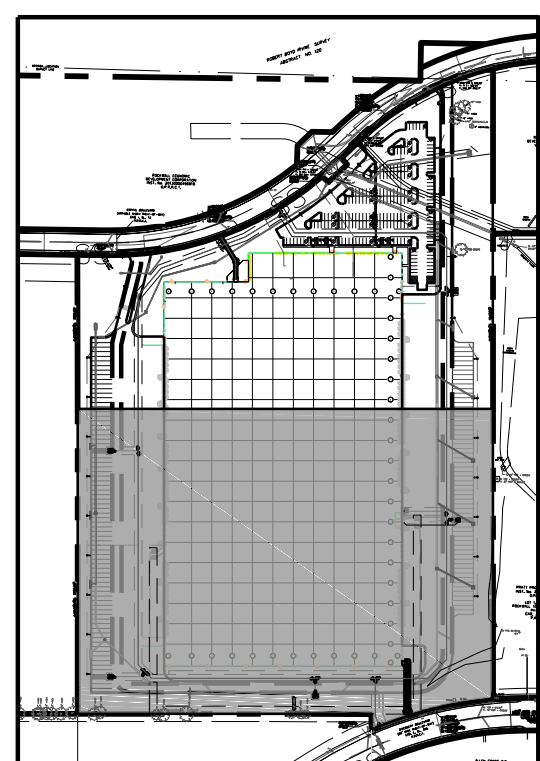

PRATT PROPERTIES
INST. No. 201600C
O.P.R.R.C.T.

LOT 1, BLOCK
ROCKWALL TECHNOL
PHASE IV
CAB. J, SL.
P.R.R.C.T.

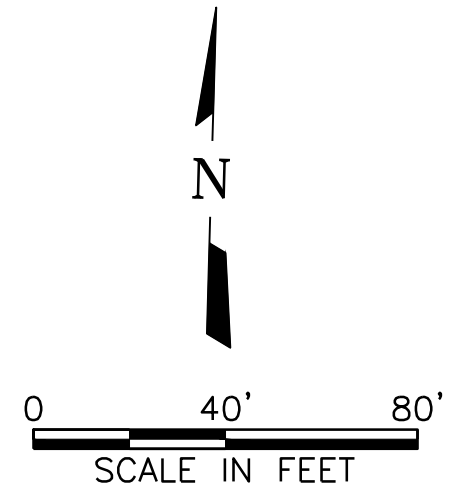

- LEGEND**
- 8" CONCRETE PAVEMENT (REFER TO DETAIL 1, SHEET C6-00)
 - 5" CONCRETE SIDEWALK (REFER TO DETAIL 12, SHEET C6-00)
 - CONTROL POINT
 - PROPERTY LINE

- NOTES**
- ALL RESPONSIBILITY FOR ADEQUACY OF DESIGN REMAINS WITH THE DESIGN ENGINEER. THE CITY OF ROCKWALL, IN REVIEWING AND RELEASING PLANS FOR CONSTRUCTION, ASSUMES NO RESPONSIBILITY FOR ADEQUACY OR ACCURACY OF DESIGN.

DRAWING ISSUE		
DESCRIPTION	DATE	
ENGINEERING SUBMITTAL	2/2/2018	
CITY OF ROCKWALL		
ENGINEERING REVIEW	3/2/2018	
2ND SUBMITTAL		
ENGINEERING REVIEW	3/23/2018	
3RD SUBMITTAL		
ISSUED FOR CONSTRUCTION	4/10/2018	
RECORD DRAWING	3/6/2019	
DRAWING TITLE		
PAVING AND DIMENSION CONTROL PLAN		
DRAWING NO.		
C01-01		
PROJECT NAME		
LOLLICUP USA WAREHOUSE		
CASE NUMBER:		
Forum #	601-03049	Consult#
		101-03049

CLAYCO
THE ART & SCIENCE OF BUILDING
2199 INNERBELT BUSINESS CENTER DRIVE
ST. LOUIS, MISSOURI 63114
Ph 314.429.5100 Fx 314.429.3137

ARCHITECT
FORUM
2199 INNERBELT BUSINESS CENTER DRIVE
ST. LOUIS, MISSOURI 63114
Ph 314.429.1010 Fx 314.429.7770

CONTRACTOR / DEVELOPER
CLAYCO

LANDSCAPE ARCHITECT
FORUM

CIVIL ENGINEER
FREES & NICHOLS

STRUCTURAL ENGINEER

MECHANICAL ENGINEER

ELECTRICAL ENGINEER

PLUMBING ENGINEER

FIRE PROTECTION ENGINEER

Lollicup
ROCKWALL TECHNOLOGY PARK
ROCKWALL, TEXAS

POINT TABLE			
PNT	NORTHING	EASTING	DESCRIPTION
100	7022182.84	2608002.88	COLUMN M3
101	7022196.42	2608479.69	COLUMN B3
102	7021282.21	2608028.52	COLUMN M21
103	7022286.56	2607703.17	PROPERTY CORNER
104	7022803.09	2608770.49	PROPERTY CORNER
105	7021091.98	2607737.53	PROPERTY CORNER
106	7021072.31	2608503.29	PROPERTY CORNER
107	7021160.64	2608817.73	PROPERTY CORNER
108	7022190.75	2607851.27	FACE OF CURB
109	7022116.32	2607834.70	FACE OF CURB
110	7022300.89	2607809.04	SAWCUT CORNER
111	7022313.50	2607917.34	SAWCUT CORNER
112	7022594.82	2608402.42	SAWCUT CORNER
113	7022640.41	2608449.10	SAWCUT CORNER
114	7022742.21	2608590.31	SAWCUT CORNER

POINT TABLE			
PNT	NORTHING	EASTING	DESCRIPTION
115	7022786.39	2608683.04	SAWCUT CORNER
116	7022326.68	2608238.05	FACE OF CURB
117	7022367.08	2608218.26	FACE OF CURB
118	7022556.23	2608442.85	FACE OF CURB
119	7022583.30	2608441.89	FACE OF CURB/ADA RAMP
120	7022655.73	2608548.18	FACE OF CURB
121	7022657.28	2608602.16	FACE OF CURB
122	7022617.38	2608623.32	FACE OF CURB
123	7022239.53	2608634.19	FACE OF CURB
124	7022237.69	2608570.21	FACE OF CURB
125	7022220.96	2608614.71	FACE OF CURB
126	7022210.49	2608630.85	FACE OF CURB
127	7022231.05	2608650.27	FACE OF CURB
128	7022714.30	2608636.51	CURB OPENING
129	7022756.00	2608665.34	FACE OF CURB



POINT TABLE			
PNT	NORTHING	EASTING	DESCRIPTION
130	7022336.25	2608570.91	FACE OF CURB
131	7022072.11	2607744.43	FACE OF CURB
132	7022073.10	2607779.33	FACE OF CURB
133	7022096.57	2607807.76	FACE OF CURB
134	7022102.55	2607852.12	FACE OF CURB
135	7022078.21	2607872.21	FACE OF CURB
136	7022257.52	2607843.60	FACE OF CURB
137	7022288.49	2607893.53	FACE OF CURB
138	7021147.76	2607770.75	FACE OF CURB
139	7021171.96	2608612.13	FACE OF CURB
140	7021274.71	2608707.51	FACE OF CURB
141	7021284.87	2608637.20	FACE OF CURB
142	7021252.71	2608638.11	FACE OF CURB
143	7021201.36	2608590.77	FACE OF CURB
144	7021184.08	2607989.81	FACE OF CURB

POINT TABLE			
PNT	NORTHING	EASTING	DESCRIPTION
145	7021213.21	2607958.96	FACE OF CURB
146	7022575.15	2608564.04	FACE OF CURB
147	7022589.22	2608518.62	FACE OF CURB
148	7022511.18	2608565.88	FACE OF CURB
149	7022447.20	2608567.72	FACE OF CURB
150	7022383.23	2608569.56	FACE OF CURB
151	7022380.39	2608470.60	FACE OF CURB
152	7022444.36	2608468.76	FACE OF CURB
153	7022522.45	2608461.51	FACE OF CURB/FLUME
154	7022457.77	2608396.34	FACE OF CURB
155	7022390.81	2608308.23	FACE OF CURB
156	7022377.54	2608371.64	FACE OF CURB
157	7022600.58	2608485.44	FACE OF CURB
158	7022627.68	2608518.23	FACE OF CURB
159	7022601.94	2608458.47	FACE OF CURB



POINT TABLE			
PNT	NORTHING	EASTING	DESCRIPTION
160	7022610.45	2608450.07	FACE OF CURB
161	7022593.21	2608432.11	FACE OF CURB
162	7022189.01	2607859.08	FACE OF CURB
163	7022114.58	2607842.51	FACE OF CURB
164	7021113.38	2608502.14	PROPERTY CORNER
165	7021363.45	2608704.99	CURB TERMINUS
166	7022101.16	2608684.23	CURB TERMINUS
167	7022701.30	2608636.88	CURB OPENING

BENCHMARKS:
BENCHMARK A--AN "X" CUT IN THE CENTER OF THE SIDEWALK AT THE END OF THE HANDICAP RAMP AT THE SOUTHEAST CORNER OF THE INTERSECTION OF DISCOVERY BLVD. AND DATA DR., 11 FEET SOUTHEAST OF THE CURB LINE.
ELEV=600.44

BENCHMARK B--AN "X" CUT ON THE CURB ON THE NORTH SIDE OF DISCOVERY BLVD. 580 FEET EAST OF CORPORATE CROSSING, 11 FEET SOUTHEAST OF A FIRE HYDRANT, AND 19 FEET NORTHEAST OF TWO (2) WATER VALVES.
ELEV=599.67

THE SEAL THAT ORIGINALLY APPEARED ON THIS DOCUMENT WAS AUTHORIZED BY JRETT M. ROSSIGNOL, P.E. TEXAS NO. 101000, EXPIRATION DATE 8/22/2018. ALTERATION OF A SEALED DOCUMENT WITHOUT PROPER NOTIFICATION OF THE RESPONSIBLE ENGINEER IS AN OFFENSE UNDER THE TEXAS ENGINEERING PRACTICE ACT.

This Record Drawing is a combination of the sealed engineering contract drawings for this project, modified by information furnished by the contractor reflecting changes in the Project made during construction. The original sealed drawings are on file at the offices of

FREESE AND NICHOLS, INC.
RECORD DRAWINGS PREPARED ON: 3/6/2019

CLAYCO
THE ART & SCIENCE OF BUILDING
2199 INNERBELT BUSINESS CENTER DRIVE
ST. LOUIS, MISSOURI 63114
Ph 314.429.5100 Fx 314.429.3137

ARCHITECT
FORUM
2199 INNERBELT BUSINESS CENTER DRIVE
ST. LOUIS, MISSOURI 63114
Ph 314.429.1010 Fx 314.429.7770

CONTRACTOR / DEVELOPER
CLAYCO

LANDSCAPE ARCHITECT
FORUM

CIVIL ENGINEER
FREESE & NICHOLS

STRUCTURAL ENGINEER

MECHANICAL ENGINEER

ELECTRICAL ENGINEER

PLUMBING ENGINEER

FIRE PROTECTION ENGINEER

Lollicup
ROCKWALL TECHNOLOGY PARK
ROCKWALL, TEXAS


DRAWING ISSUE

APPLICANT INFORMATION	DESCRIPTION	DATE
BOB LEIMBERG CLAYCO 2199 INNERBELT BUSINESS CENTER DR. ST. LOUIS, MO 63114 314.592.2234 office 314.713.7874 mobile leimbergb@claycorp.com	ENGINEERING SUBMITTAL	2/2/2018
	CITY OF ROCKWALL	
	ENGINEERING REVIEW	3/2/2018
	2ND SUBMITTAL	
	ENGINEERING REVIEW	3/23/2018
	3RD SUBMITTAL	
	ISSUED FOR CONSTRUCTION	4/10/2018

OWNER INFORMATION	ADA REVISIONS
ALAN YU LOLLICUP USA 6185 KIMBALL AVE. CHINO, CA 91708 626.965.8882 x110 office 626.226.8556 mobile alan.yu@lollicup.com	

PROJECT NAME
LOLLICUP USA WAREHOUSE

CASE NUMBER:	Forum #	601-03049	Consult #	101-03049
--------------	---------	-----------	-----------	-----------

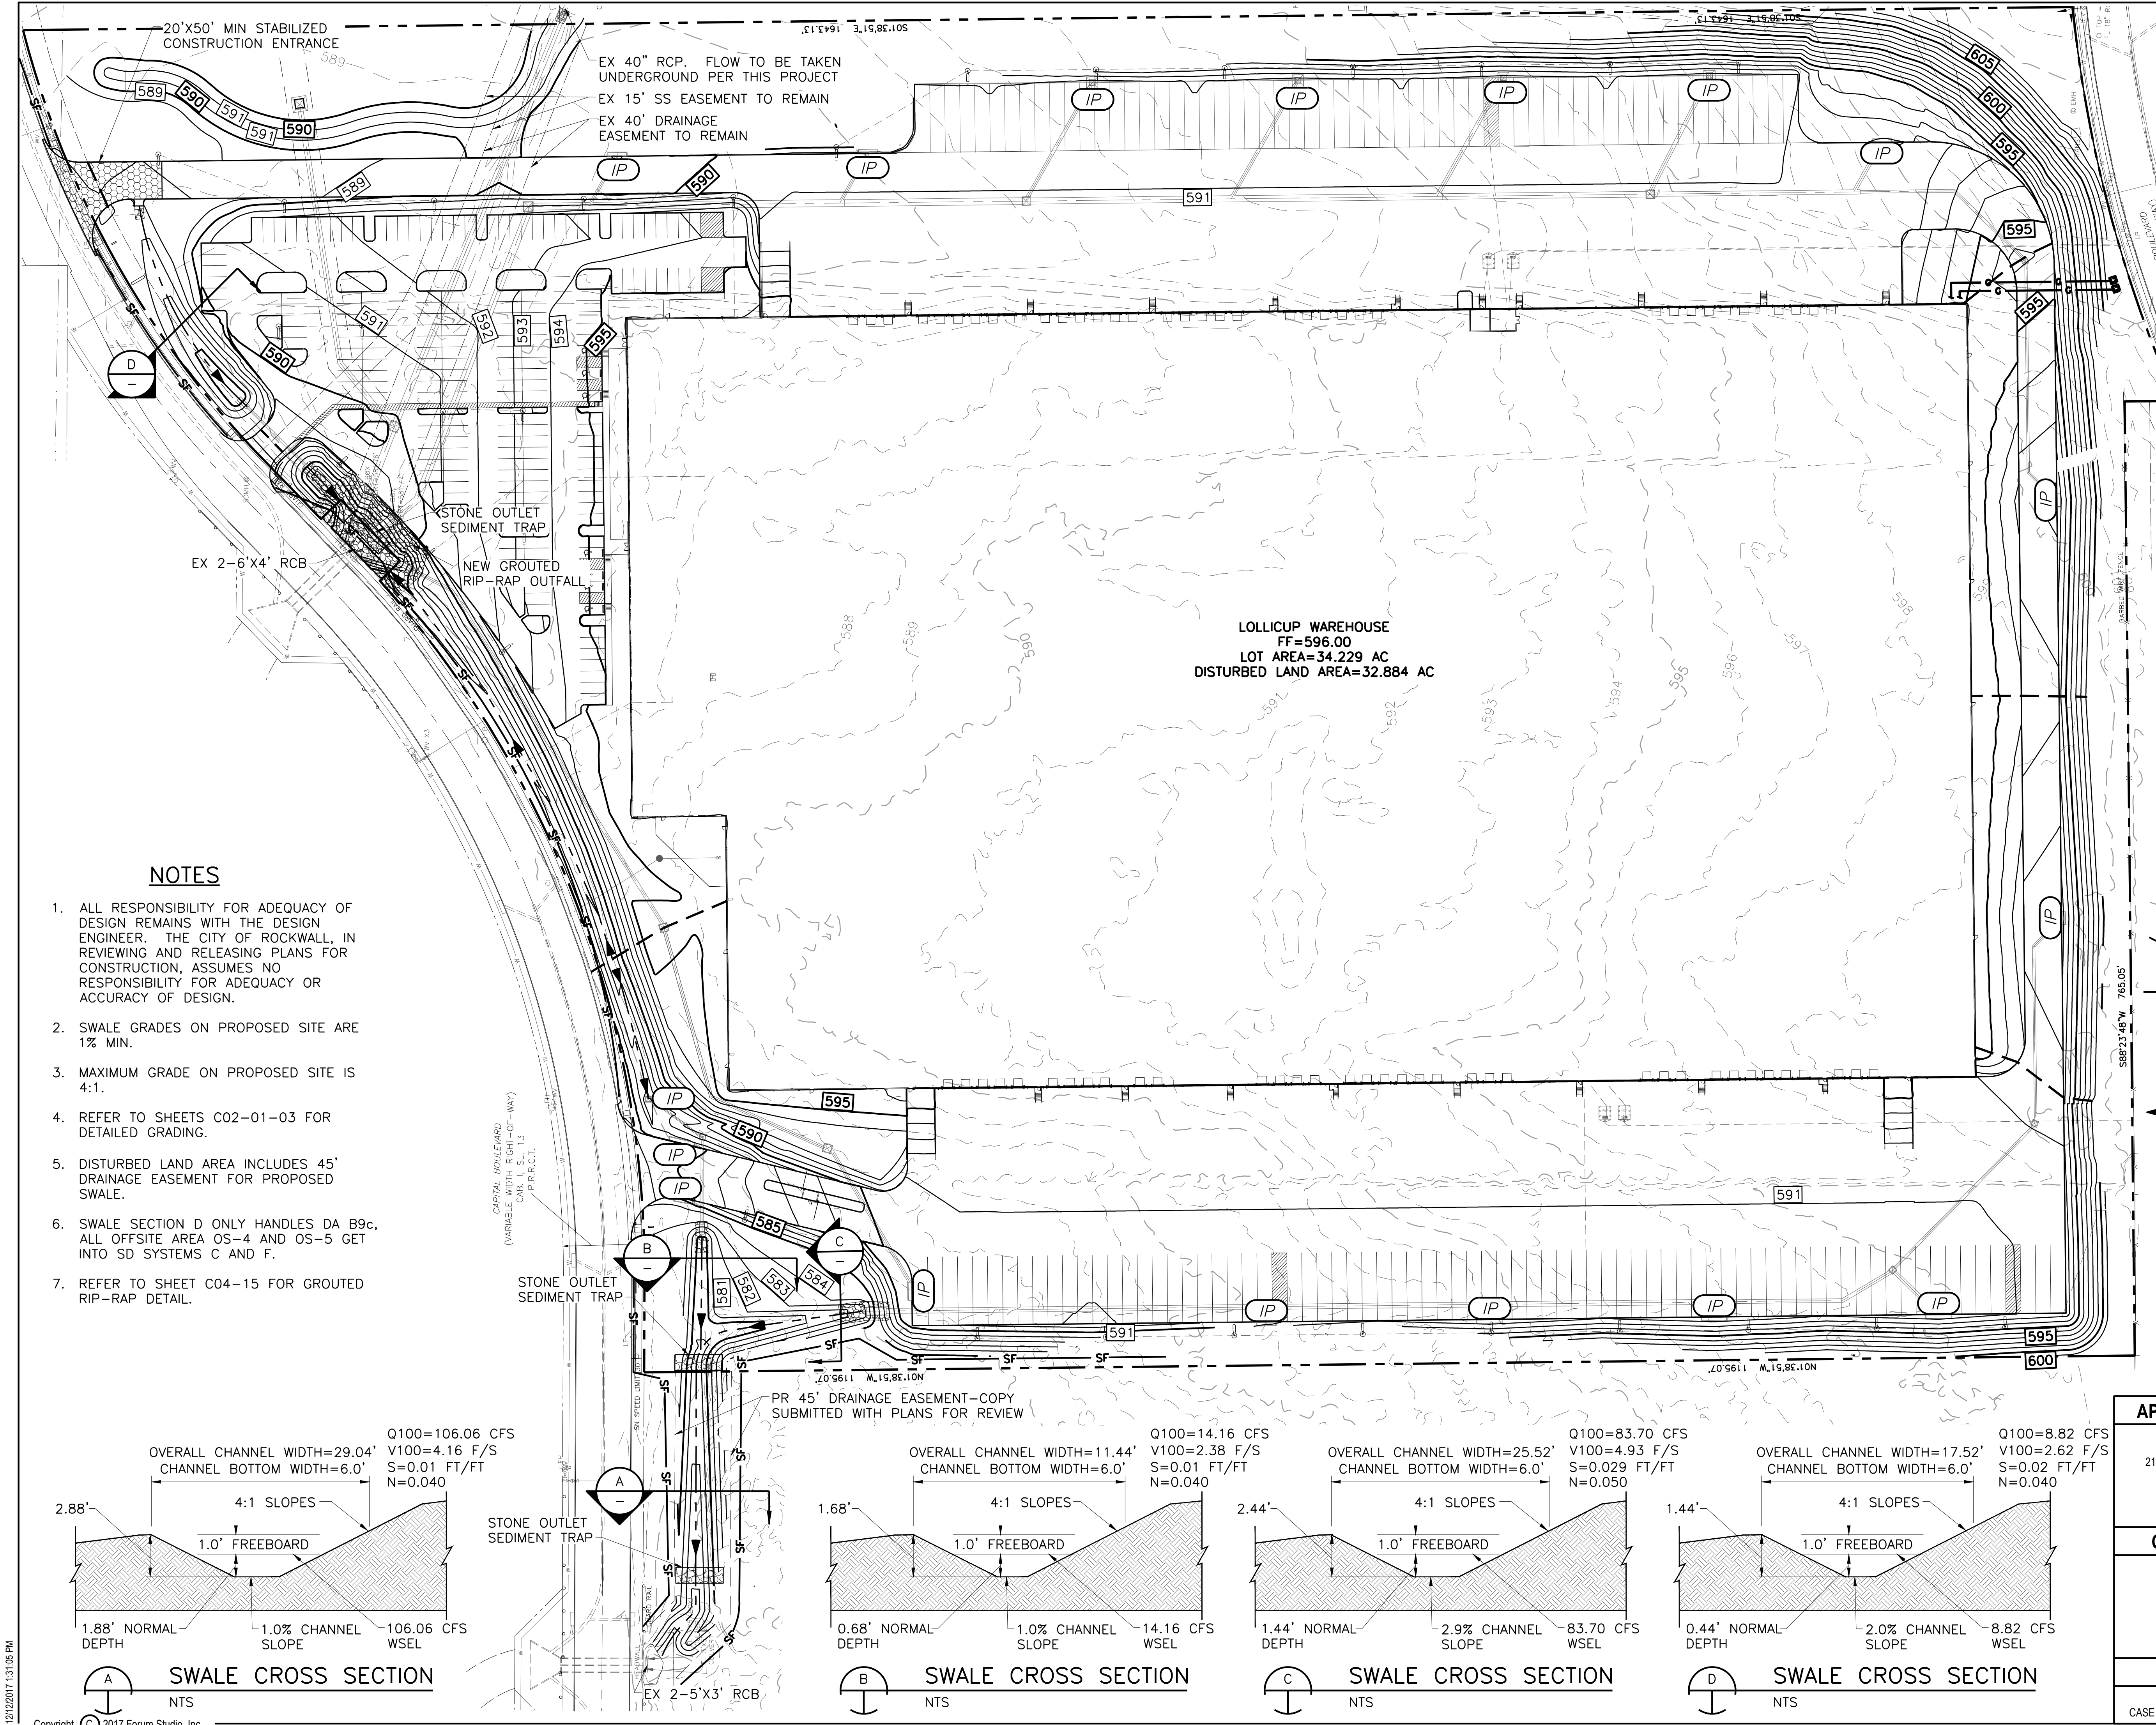

BENCHMARKS:
BENCHMARK A-AN "X" CUT IN THE CENTER OF THE SIDEWALK AT THE END OF THE HANDICAP RAMP AT THE SOUTHEAST CORNER OF THE INTERSECTION OF DISCOVERY BLVD. AND DATA DR., 11 FEET SOUTHEAST OF THE CURB LINE. ELEV=600.44
BENCHMARK B-AN "X" CUT ON THE CURB ON THE NORTH SIDE OF DISCOVERY BLVD. 580 FEET EAST OF CORPORATE CROSSING, 11 FEET SOUTHEAST OF A FIRE HYDRANT, AND 19 FEET NORTHEAST OF TWO (2) WATER VALVES. ELEV=599.67

LEGEND

- EXISTING CONTOURS
- PROPOSED CONTOURS
- SILT FENCE
- INLET PROTECTION
- GRADE BREAK
- FLOW LINE
- STONE OUTLET SEDIMENT TRAP
- STABILIZED CONSTRUCTION ENTRANCE

0 20' 40' 60' 120'
SCALE IN FEET

APPLICANT INFORMATION		
BOB LEIMBERG CLAYCO 2199 INNERBELT BUSINESS CENTER DR. ST. LOUIS, MO 63114 314.592.2234 office 314.713.7874 mobile leimbergb@claycorp.com	ENGINEERING SUBMITTAL CITY OF ROCKWALL ENGINEERING REVIEW 2ND SUBMITTAL ENGINEERING REVIEW 3RD SUBMITTAL ISSUED FOR CONSTRUCTION RECORD DRAWING	22/2018 3/2/2018 3/23/2018 4/10/2018 3/6/2019
OWNER INFORMATION		
ALAN YU LOLLICUP USA 6185 KIMBALL AVE. CHINO, CA 91708 626.965.8882 x110 office 626.226.8556 mobile alan.yu@lolicup.com	DRAWING TITLE OVERALL GRADING AND EROSION CONTROL PLAN	DRAWING NO. C02-00
PROJECT NAME		
LOLLICUP USA WAREHOUSE		
CASE NUMBER:		

CLAYCO
THE ART & SCIENCE OF BUILDING
2199 INNERBELT BUSINESS CENTER DRIVE
ST. LOUIS, MISSOURI 63114
PH 314.429.1010 FX 314.429.3137

FORUM
2199 INNERBELT BUSINESS CENTER DRIVE
ST. LOUIS, MISSOURI 63114
PH 314.429.1010 FX 314.429.7770

CONTRACTOR / DEVELOPER
CLAYCO

LANDSCAPE ARCHITECT
FORUM

CIVIL ENGINEER
FREESE & NICHOLS

STRUCTURAL ENGINEER

MECHANICAL ENGINEER

ELECTRICAL ENGINEER

PLUMBING ENGINEER

FIRE PROTECTION ENGINEER

Lollicup
ROCKWALL TECHNOLOGY PARK
ROCKWALL, TEXAS

DRAWING ISSUE

DESCRIPTION	DATE
ENGINEERING SUBMITTAL CITY OF ROCKWALL	22/2018
ENGINEERING REVIEW 2ND SUBMITTAL	3/2/2018
ENGINEERING REVIEW 3RD SUBMITTAL	3/23/2018
ISSUED FOR CONSTRUCTION	4/10/2018
RECORD DRAWING	3/6/2019

DRAWING TITLE
OVERALL GRADING AND
EROSION CONTROL PLAN

DRAWING NO.
C02-00

Form # 601-03049 Consult # 101-03049

NOTES

- ALL RESPONSIBILITY FOR ADEQUACY OF DESIGN REMAINS WITH THE DESIGN ENGINEER. THE CITY OF ROCKWALL, IN REVIEWING AND RELEASING PLANS FOR CONSTRUCTION, ASSUMES NO RESPONSIBILITY FOR ADEQUACY OR ACCURACY OF DESIGN.
- SWALE GRADES ON PROPOSED SITE ARE 1% MIN.
- MAXIMUM GRADE ON PROPOSED SITE IS 4:1.
- REFER TO SHEETS C02-01-03 FOR DETAILED GRADING.
- DISTURBED LAND AREA INCLUDES 45' DRAINAGE EASEMENT FOR PROPOSED SWALE.
- SWALE SECTION D ONLY HANDLES DA B9c, ALL OFFSITE AREA OS-4 AND OS-5 GET INTO SD SYSTEMS C AND F.
- REFER TO SHEET C04-15 FOR GROUTED RIP-RAP DETAIL.

SWALE CROSS SECTION
NTS

OVERALL CHANNEL WIDTH=29.04'
CHANNEL BOTTOM WIDTH=6.0'
4:1 SLOPES
1.0' FREEBOARD
1.88' NORMAL DEPTH
1.0% CHANNEL SLOPE
106.06 CFS WSEL

Q100=106.06 CFS
V100=4.16 F/S
S=0.01 FT/FT
N=0.040

SWALE CROSS SECTION
NTS

OVERALL CHANNEL WIDTH=11.44'
CHANNEL BOTTOM WIDTH=6.0'
4:1 SLOPES
1.0' FREEBOARD
0.68' NORMAL DEPTH
1.0% CHANNEL SLOPE
14.16 CFS WSEL

Q100=14.16 CFS
V100=2.38 F/S
S=0.01 FT/FT
N=0.040

SWALE CROSS SECTION
NTS

OVERALL CHANNEL WIDTH=25.52'
CHANNEL BOTTOM WIDTH=6.0'
4:1 SLOPES
1.0' FREEBOARD
1.44' NORMAL DEPTH
2.9% CHANNEL SLOPE
83.70 CFS WSEL

Q100=83.70 CFS
V100=4.93 F/S
S=0.029 FT/FT
N=0.050

SWALE CROSS SECTION
NTS

OVERALL CHANNEL WIDTH=17.52'
CHANNEL BOTTOM WIDTH=6.0'
4:1 SLOPES
1.0' FREEBOARD
0.44' NORMAL DEPTH
2.0% CHANNEL SLOPE
8.82 CFS WSEL

Q100=8.82 CFS
V100=2.62 F/S
S=0.02 FT/FT
N=0.040

SWALE CROSS SECTION
NTS

OVERALL CHANNEL WIDTH=17.52'
CHANNEL BOTTOM WIDTH=6.0'
4:1 SLOPES
1.0' FREEBOARD
0.44' NORMAL DEPTH
2.0% CHANNEL SLOPE
8.82 CFS WSEL

Q100=8.82 CFS
V100=2.62 F/S
S=0.02 FT/FT
N=0.040

12/22/2017 1:31:05 PM

12/2/2017 1:05 PM

Copyright © 2017 Forum Studio, Inc.

E

D

C

B

A

MATCHLINE SHEET C02-02

MATCHLINE THIS SHEET

MATCHLINE THIS SHEET

MATCHLINE THIS SHEET

LEGEND

- 590.00 TOP OF CURB
590.00 TOP OF PAVEMENT
590.00 NATURAL GROUND
590.00 EXISTING SHOT
590.00 EXISTING CONTOURS
590.00 PROPOSED CONTOURS
- HIGH POINT
--- FLOW LINE


NOTES

- ALL RESPONSIBILITY FOR ADEQUACY OF DESIGN REMAINS WITH THE DESIGN ENGINEER. THE CITY OF ROCKWALL, IN REVIEWING AND RELEASING PLANS FOR CONSTRUCTION, ASSUMES NO RESPONSIBILITY FOR ADEQUACY OR ACCURACY OF DESIGN.
- SWALE GRADES ON PROPOSED SITE ARE 1% MIN.
- MAXIMUM GRADE ON PROPOSED SITE IS 4:1.
- REFER TO SHEET C04-15 FOR GROUTED RIP-RAP DETAIL.

BENCHMARKS:

BENCHMARK A-AN "X" CUT IN THE CENTER OF THE SIDEWALK AT THE END OF THE HANDICAP RAMP AT THE SOUTHEAST CORNER OF THE INTERSECTION OF DISCOVERY BLVD. AND DATA DR., 11 FEET SOUTHEAST OF THE CURB LINE. ELEV=600.44

BENCHMARK B-AN "X" CUT ON THE CURB ON THE NORTH SIDE OF DISCOVERY BLVD. 580 FEET EAST OF CORPORATE CROSSING, 11 FEET SOUTHEAST OF A FIRE HYDRANT, AND 19 FEET NORTHEAST OF TWO (2) WATER VALVES. ELEV=599.67

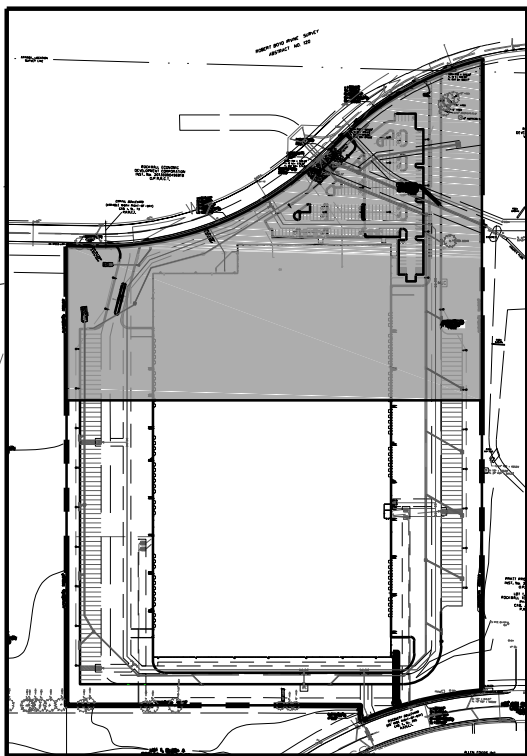

KEY MAP

HIGH POINT TOP OF BERM 591.75

NEW BERM TO DIRECT OFF-SITE FLOW TO SD LINE F



0 40' 80'
SCALE IN FEET

APPLICANT INFORMATION

BOB LEIMBERG
CLAYCO
2199 INNERBELT BUSINESS CENTER DR.
ST. LOUIS, MO 63114
314.592.2234 office
314.713.7874 mobile
leimbergb@claycorp.com

OWNER INFORMATION

ALAN YU
LOLLICUP USA
6185 KIMBALL AVE.
CHINO, CA 91708
626.965.8882 x110 office
626.226.8556 mobile
alan.yu@lolicup.com

PROJECT NAME

LOLLICUP USA WAREHOUSE
CASE NUMBER:

FORUM

2199 INNERBELT BUSINESS CENTER DRIVE
ST. LOUIS, MISSOURI 63114
PH 314.429.1010 FX 314.429.7770

CONTRACTOR / DEVELOPER

CLAYCO

LANDSCAPE ARCHITECT

FORUM

CIVIL ENGINEER

FREESE & NICHOLS

STRUCTURAL ENGINEER

MECHANICAL ENGINEER

ELECTRICAL ENGINEER

PLUMBING ENGINEER

FIRE PROTECTION ENGINEER

Lolicup

ROCKWALL TECHNOLOGY PARK
ROCKWALL, TEXAS

DRAWING ISSUE


DESCRIPTION	DATE
ENGINEERING SUBMITTAL CITY OF ROCKWALL	2/2/2018
ENGINEERING REVIEW 2ND SUBMITTAL	3/2/2018
ENGINEERING REVIEW 3RD SUBMITTAL	3/23/2018
ISSUED FOR CONSTRUCTION	4/10/2018
ASI NO. 5	8/2/2018
GAS AND ELECTRIC RECORD DRAWING	3/6/2019

DRAWING TITLE
DETAILED GRADING PLAN

DRAWING NO.

C02-01

Forum # 601-03049 Consult # 101-03049

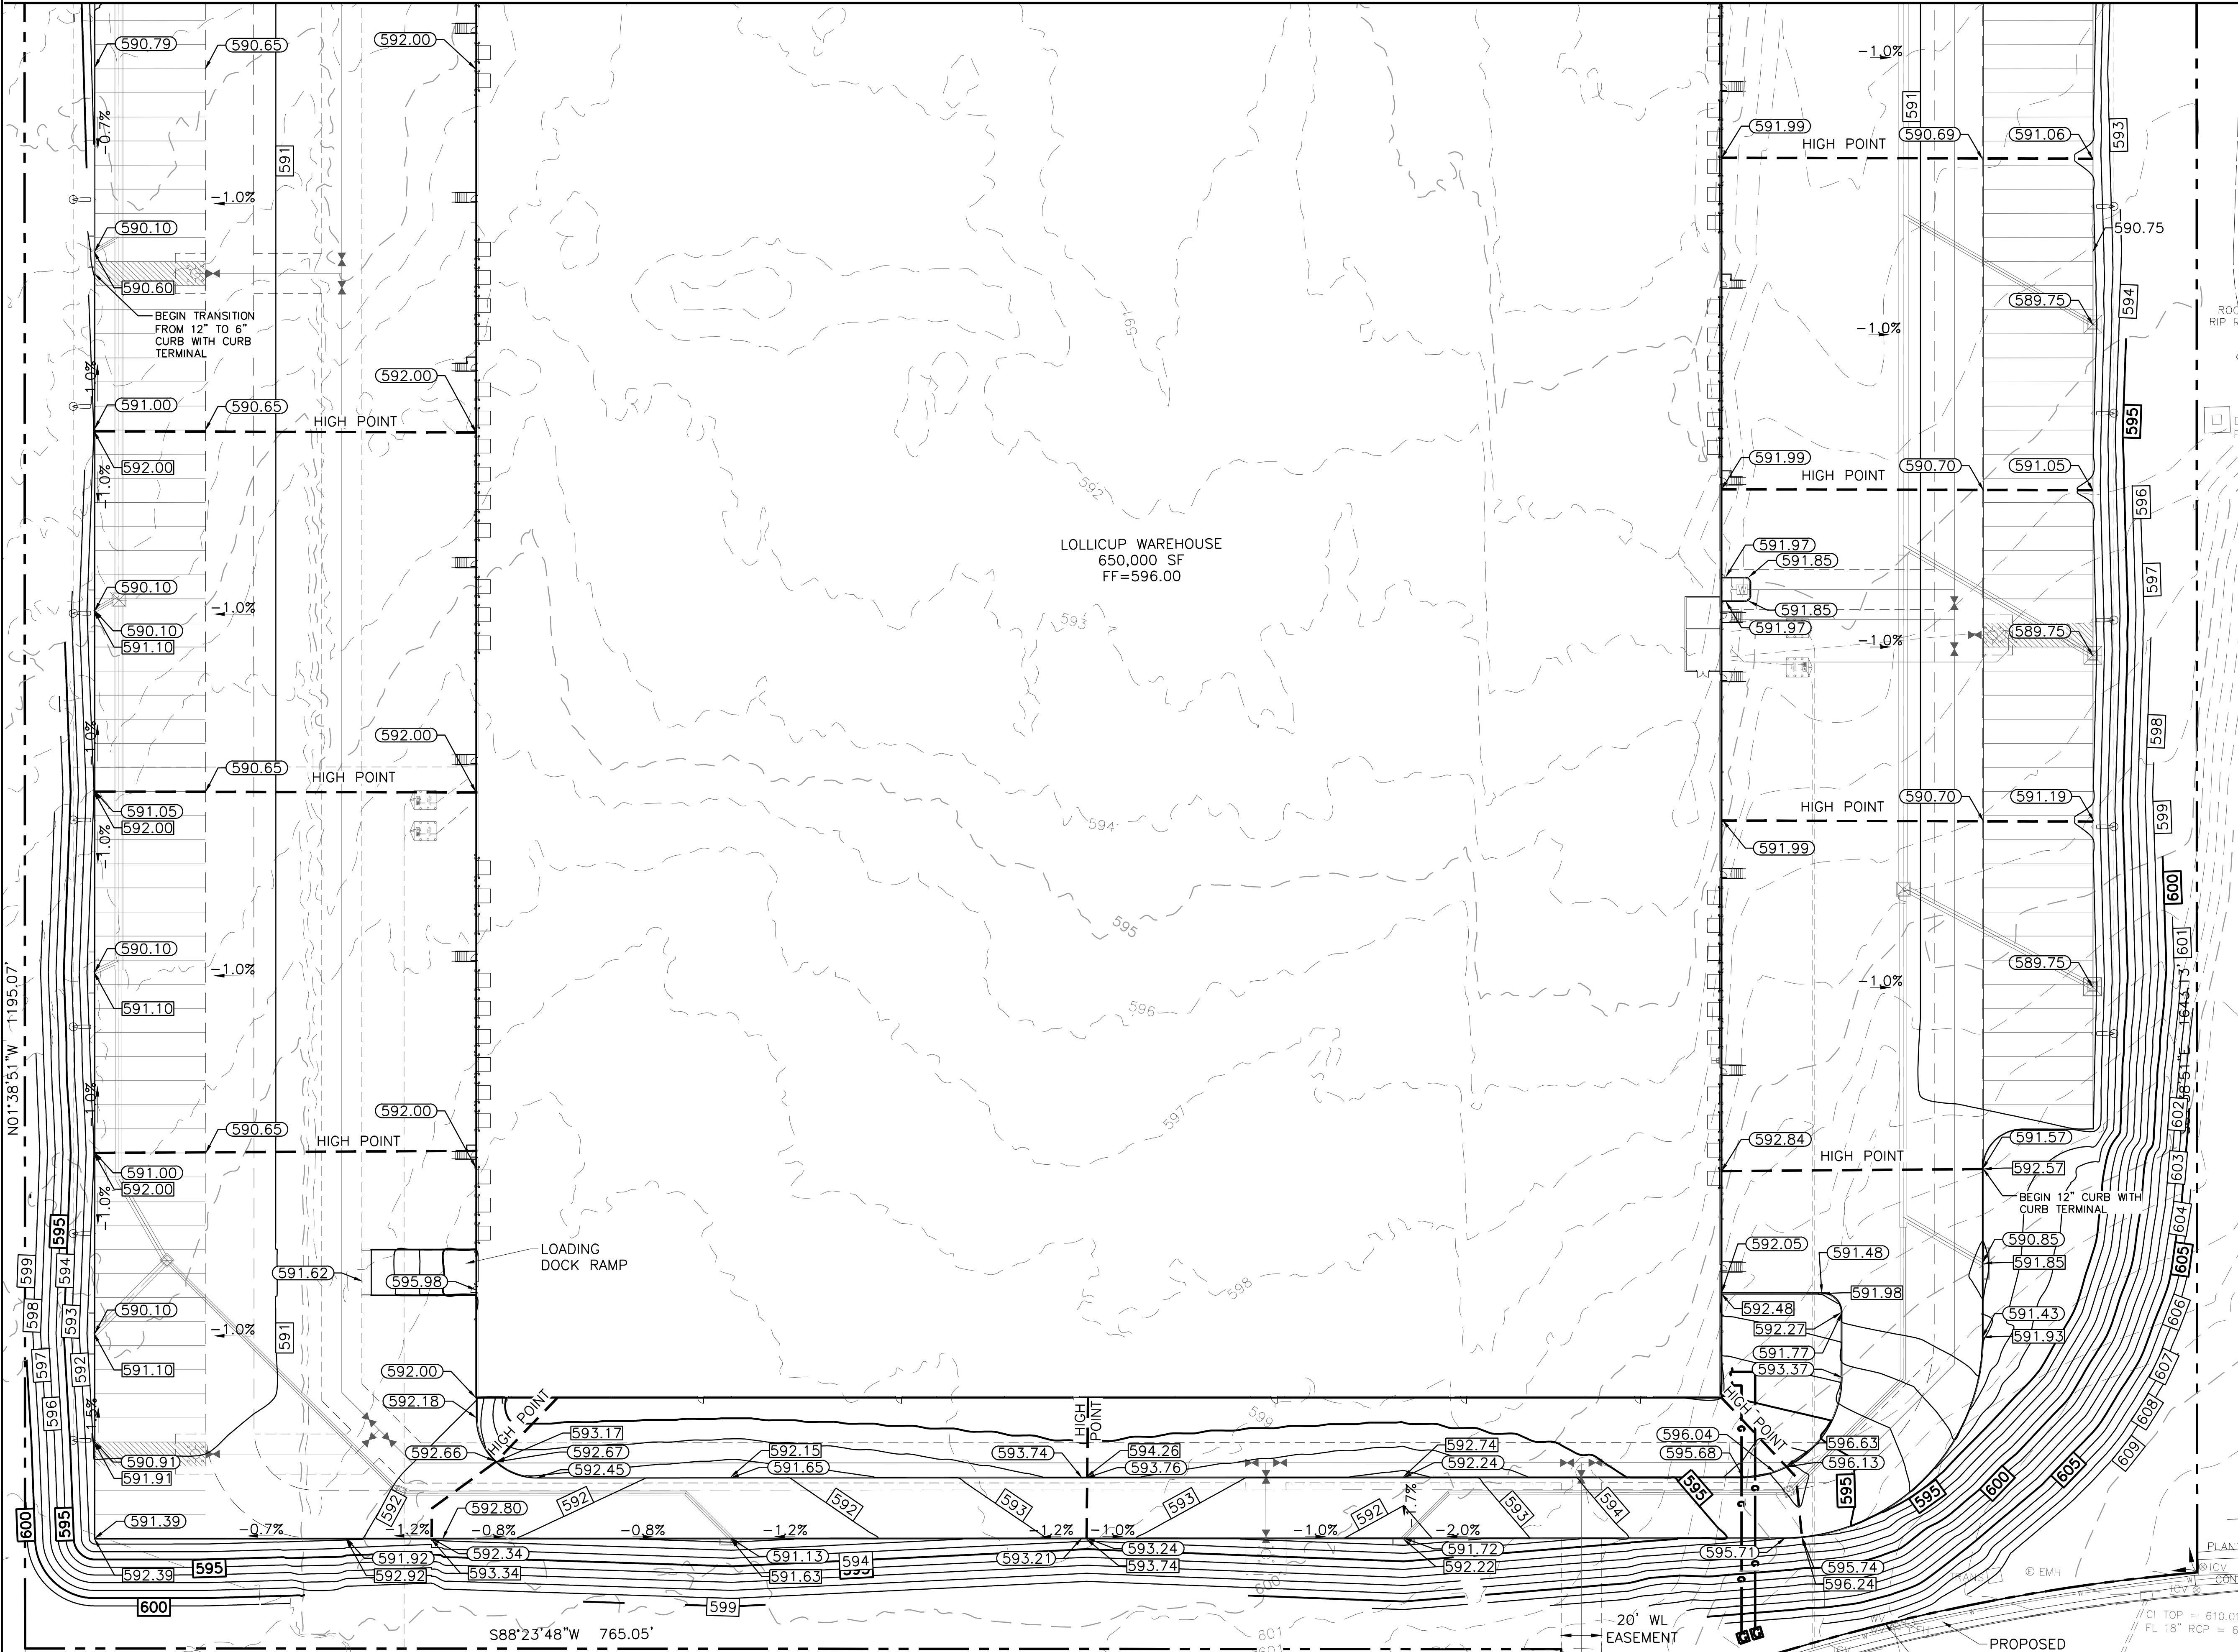


73.00	TOP OF CURB	65	PROPOSED CONTOURS	---	HIGH POINT
73.00	TOP OF PAVEMENT	64	EXISTING CONTOURS	---	FLOW LINE
73.00	NATURAL GROUND	715.50	EXISTING SHOT	---	

NOTES

1. ALL RESPONSIBILITY FOR ADEQUACY OF DESIGN REMAINS WITH THE DESIGN ENGINEER. THE CITY OF ROCKWALL, IN REVIEWING AND RELEASING PLANS FOR CONSTRUCTION, ASSUMES NO RESPONSIBILITY FOR ADEQUACY OR ACCURACY OF DESIGN.


BENCHMARKS:
BENCHMARK A-AN "X" CUT IN THE CENTER OF THE SIDEWALK AT THE END OF THE HANDICAP RAMP AT THE SOUTHEAST CORNER OF THE INTERSECTION OF DISCOVERY BLVD. AND DATA DR., 11 FEET SOUTHEAST OF THE CURB LINE. ELEV=600.44
BENCHMARK B-AN "X" CUT ON THE CURB ON THE NORTH SIDE OF DISCOVERY BLVD. 580 FEET EAST OF CORPORATE CROSSING, 11 FEET SOUTHEAST OF A FIRE HYDRANT, AND 19 FEET NORTHEAST OF TWO (2) WATER VALVES. ELEV=599.67

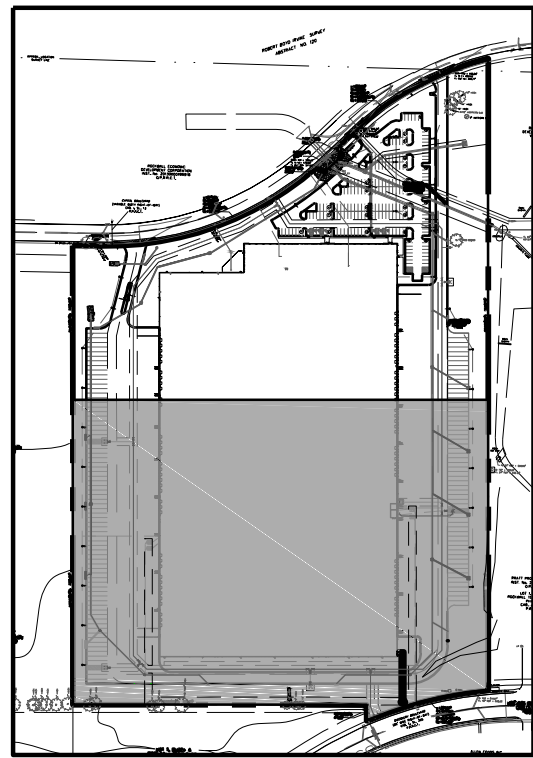

KEY MAP

PRATT PROPERTIES I
INST. No. 201600000
O.P.R.R.C.T.

LOT 1, BLOCK A
ROCKWALL TECHNOLOG
PHASE IV
CAB. J, SL. 141
P.R.R.C.T.

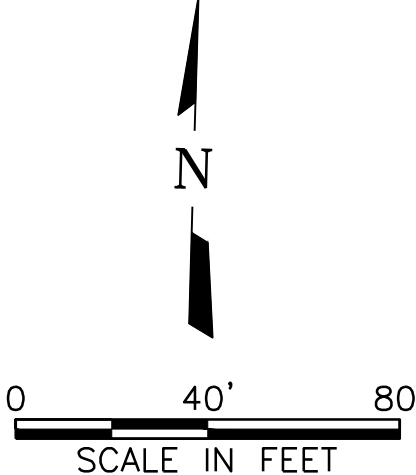

APPLICANT INFORMATION

BOB LEIMBERG
CLAYCO
2199 INNERBELT BUSINESS CENTER DR.
ST. LOUIS, MO 63114
314.592.2234 office
314.713.7874 mobile
leimberg@claycorp.com

OWNER INFORMATION

ALAN YU
LOLLICUP USA
6185 KIMBALL AVE.
CHINO, CA 91708
626.965.8882 x110 office
626.226.8556 mobile
alan.yu@lolicup.com

PROJECT NAME

LOLLICUP USA WAREHOUSE

THE SEAL THAT ORIGINALLY APPEARED ON THIS DOCUMENT WAS AUTHORIZED BY: BRIET M. BRISLOW, P.E.
TEAS NO. 191000, EXPIRATION DATE 12/31/2018
ALTERATION OF A SEALED DOCUMENT WITHOUT PROPER NOTIFICATION OF THE RESPONSIBLE ENGINEER IS AN OFFENSE UNDER THE TEXAS ENGINEERING PRACTICE ACT.

This Record Drawing is a combination of the sealed engineering contract drawings for this project, modified by information furnished by the contractor reflecting changes in the Project made during construction. The original sealed drawings are on file at the offices of:

FREESE AND NICHOLS, INC.
RECORD DRAWINGS PREPARED ON: 3/6/2019

CLAYCO
THE ART & SCIENCE OF BUILDING
2199 INNERBELT BUSINESS CENTER DRIVE
ST. LOUIS, MISSOURI 63114
Ph 314.429.1010 Fx 314.429.3137

ARCHITECT
FORUM
2199 INNERBELT BUSINESS CENTER DRIVE
ST. LOUIS, MISSOURI 63114
Ph 314.429.1010 Fx 314.429.7770

CONTRACTOR / DEVELOPER
CLAYCO

LANDSCAPE ARCHITECT
FORUM

CIVIL ENGINEER
FREESE & NICHOLS

STRUCTURAL ENGINEER

MECHANICAL ENGINEER

ELECTRICAL ENGINEER

PLUMBING ENGINEER

FIRE PROTECTION ENGINEER


DRAWING ISSUE


DESCRIPTION	DATE
ENGINEERING SUBMITTAL CITY OF ROCKWALL	2/22/2018
ENGINEERING REVIEW 2ND SUBMITTAL	3/2/2018
ENGINEERING REVIEW 3RD SUBMITTAL	3/23/2018
ISSUED FOR CONSTRUCTION	4/10/2018
ASI NO. 5 GAS AND ELECTRIC RECORD DRAWING	8/2/2018
	3/6/2019

DRAWING TITLE
DETAILED GRADING PLAN


DRAWING NO.
C02-02

Form # 601-03049 Consult # 101-03049

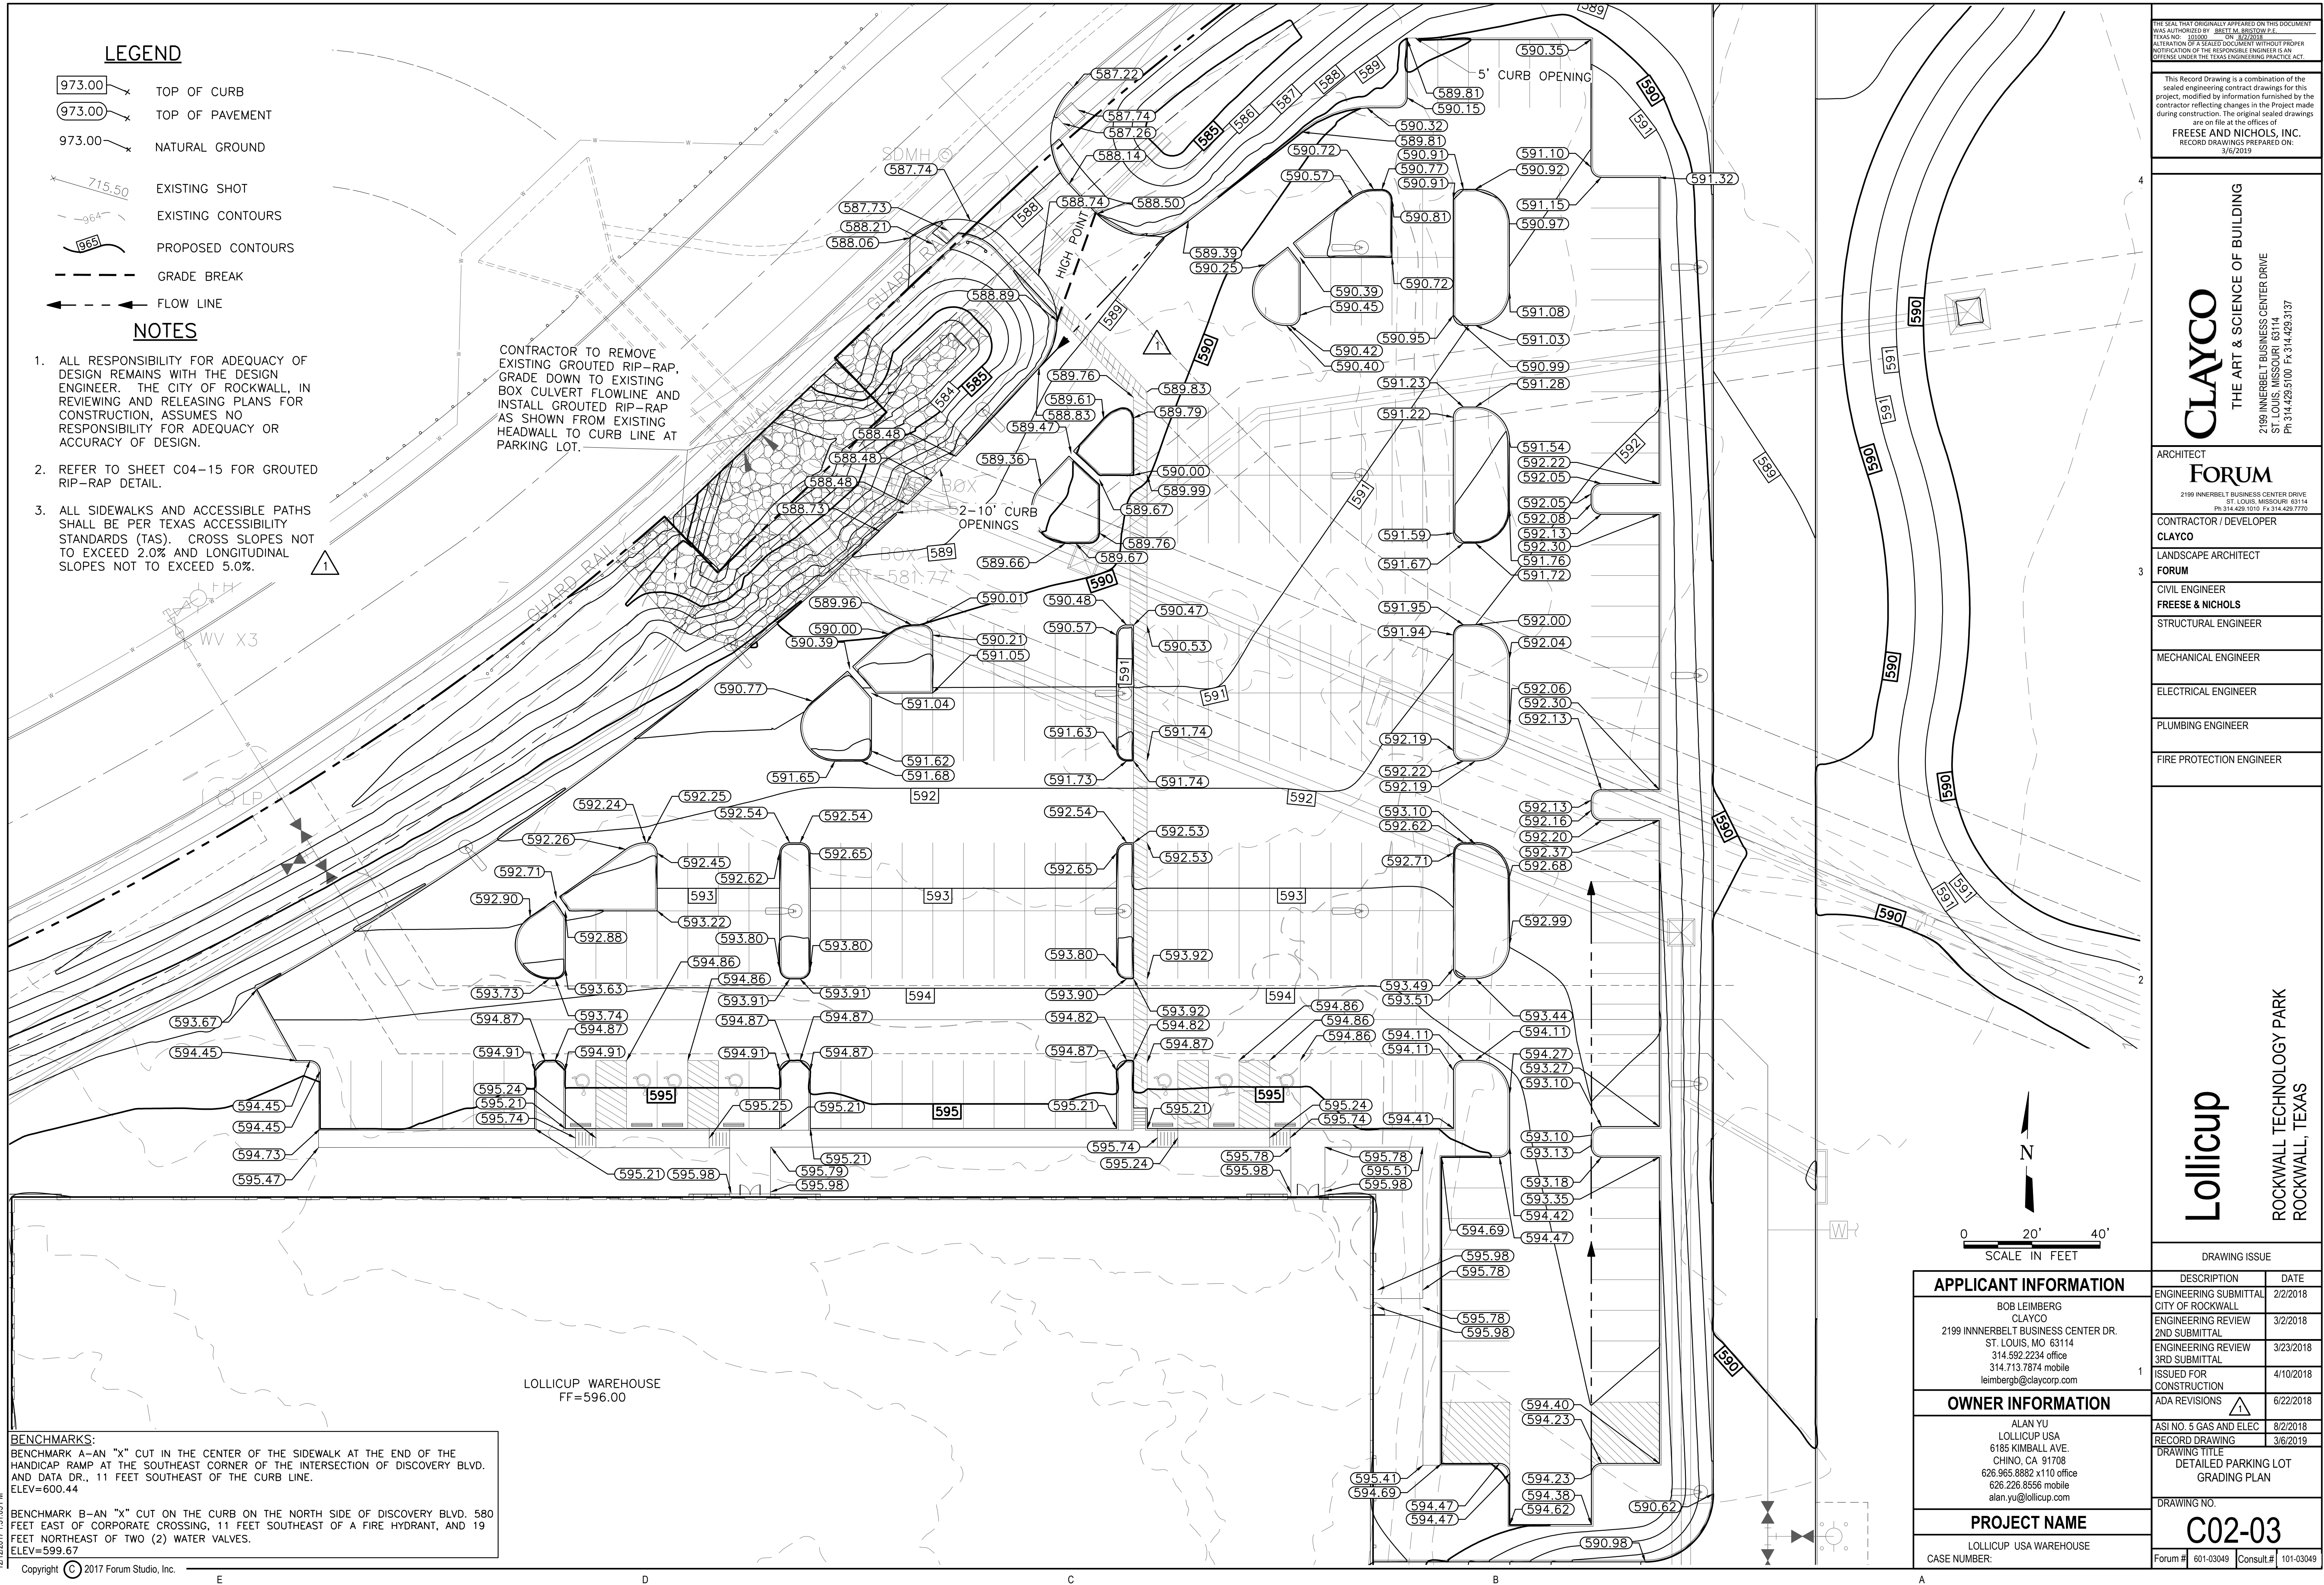

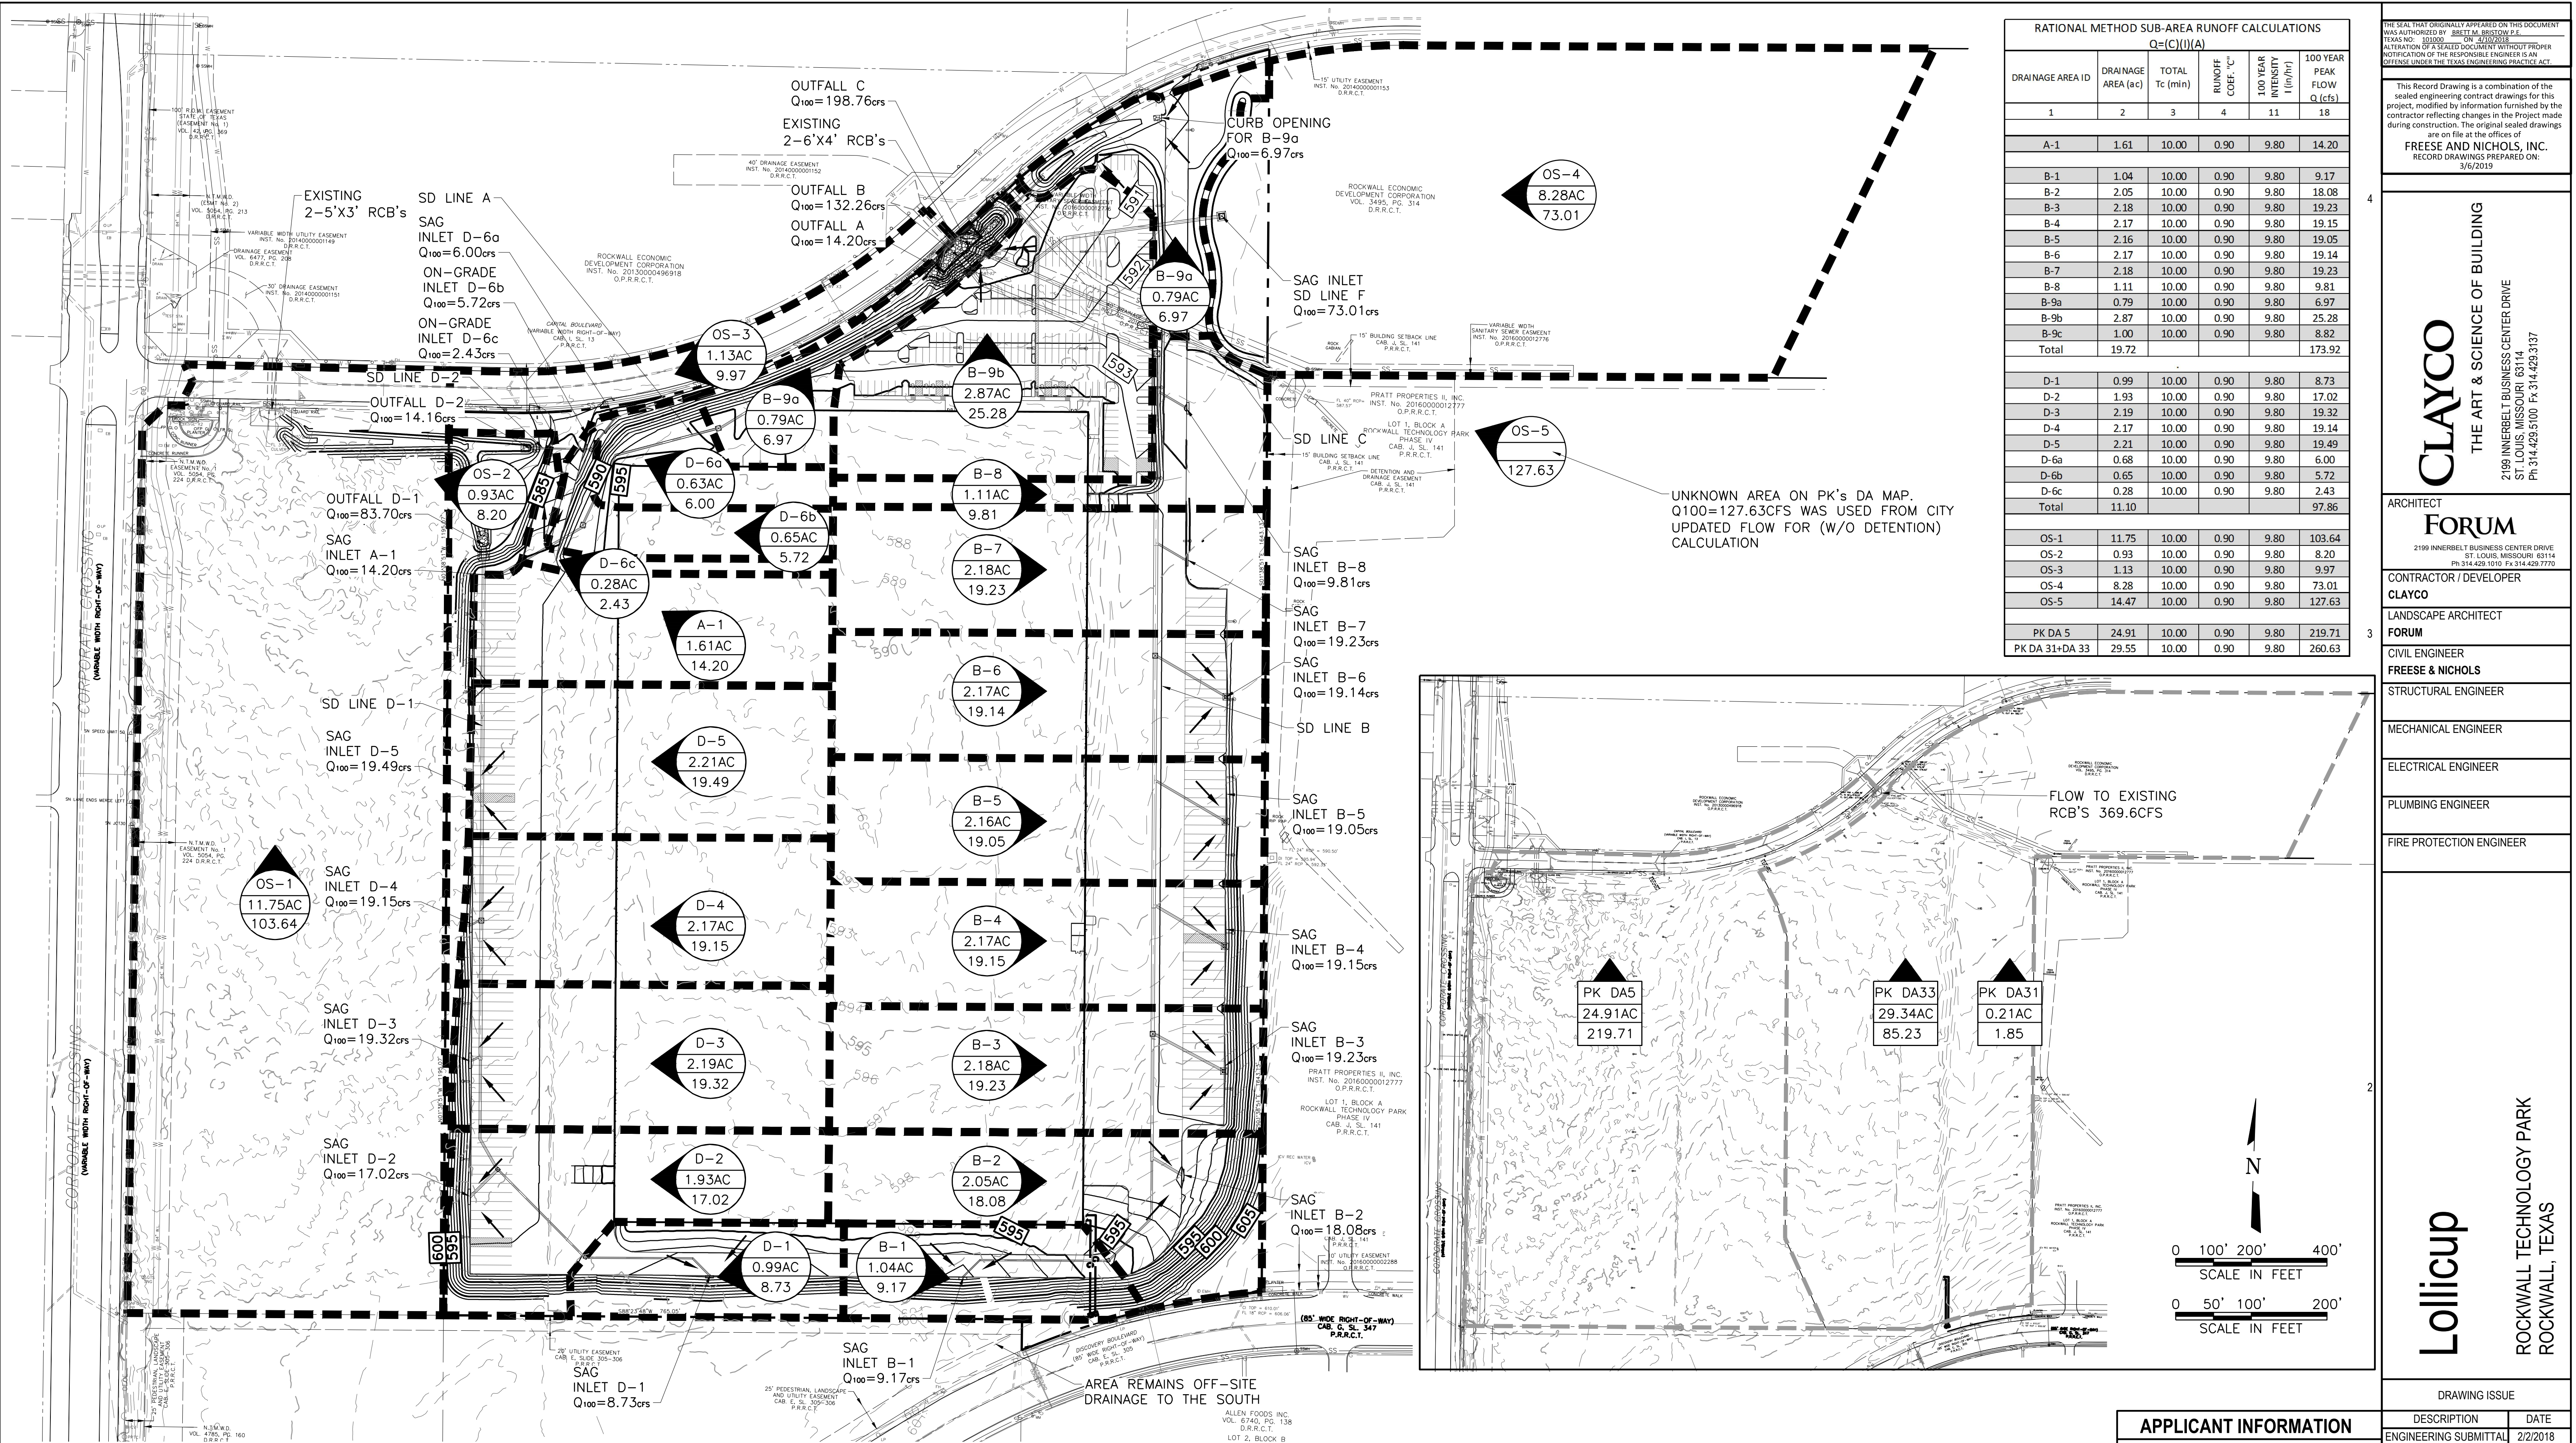

STORM DRAIN HYDRAULIC CALCULATIONS TABLE																																			
FROM	TO	PIPE LENGTH feet	Drainage Area		Runoff "c"	Incr. cA	Total cA	Time of Concentration			5-yr Intensity in/hr.	100-yr Intensity in/hr.	Q5 Runoff cfs	Q100 Runoff cfs	100-yr Inlet Bypass cfs	Q pipe cfs	Pipe Size in.	No. of Barrels	n	Sf	HEAD LOSS CALCULATIONS								Design U/S HGL Elev.	T/C ELEV. ft.	HGL Depth Below T/C- T/I ft.	DESCRIPTION	NOTES		
			Incremental No.	Area				Inlet min.	Travel min.	Total min.											D/S Elev.	U/S Elev.	V1 (in) ft/sec	V2 (out) ft/sec	V1 ² /2G ft.	V2 ² /2G ft.	KJ	KJV1 ² /2G ft.						Hk ft.	
1	2	3	4	5	6	7	8	9	10	11	12	13	14	15	16	17	18	19	20	21	22	23	24	25	26	27	28	29	30	31	32	35	36	37	
LINE A																																			
07+39.79	06+10.33	129.46	A-1	1.61	1.61	0.90	1.45	1.45	10.00	0.75	10.00	5.85	9.80	8.48	14.20	0.00	14.20	30	1	0.013	0.0012	588.21	588.37	0.00	2.89	0.000	0.130	1.25	0.00	0.16	588.53	590.63	2.10	Inlet at Beg. of Line	
06+10.33	05+08.36	101.97		0.00	1.61			1.45	0.00	0.64	10.75	5.70	9.00	8.26	13.05	0.00	13.05	30	1	0.013	0.0010	588.01	588.11	2.89	2.66	0.130	0.110	0.42	0.05	0.10	588.21	591.60		MH on Line w/45° Bend	
05+08.36	03+67.66	140.70		0.00	1.61			1.45	0.00	0.90	11.39	5.58	8.82	8.08	12.79	0.00	12.79	30	1	0.013	0.0010	587.77	587.91	2.66	2.60	0.110	0.105	0.37	0.04	0.10	588.01	591.60		Bends where radius = diam, 45° Bend	
03+67.66	00+47.64	320.02		0.00	1.61			1.45	0.00	2.10	12.29	5.41	8.59	7.84	12.44	0.00	12.44	30	1	0.013	0.0009	587.38	587.67	2.60	2.53	0.105	0.100	1.00	0.11	0.10	587.77	591.60		MH on Line w/0° Lat	
00+47.64	00+00.00	47.64		0.00	1.61			1.45	0.00	0.33	14.39	5.06	8.08	7.33	11.71	0.00	11.71	30	1	0.013	0.0008	587.24	587.28	2.53	2.39	0.100	0.088	0.25	0.02	0.10	587.38	590.50		Bends where radius = diam, 30° Bend	HGL Controlled by Updated Headwater with Lower FLs of Box Culverts
LINE B																																			
17+20.59	16+88.77	31.82	B-1	1.04	1.04	0.90	0.94	0.94	10.00	0.18	10.00	5.85	9.80	5.48	9.17	0.00	9.17	24	1	0.013	0.0016	589.93	589.99	2.92	2.92	0.132	0.132	1.25	0.17	0.17	590.15	592.72	2.57	Inlet at Beg. of Line	
16+88.77	15+19.26	169.51		0.00	1.04			0.94	0.00	1.03	10.18	5.82	9.17	5.44	8.58	0.00	8.58	24	1	0.013	0.0014	589.59	589.83	2.92	2.73	0.132	0.116	0.37	0.05	0.10	589.93	591.16		Bends where radius = diam, 45° Bend	
15+19.26	14+39.18	80.08		0.00	1.04			0.94	0.00	0.64	11.22	5.61	8.87	5.25	8.30	0.00	8.30	27	1	0.013	0.0007	589.43	589.49	2.73	2.09	0.116	0.068	0.42	0.05	0.10	589.59	591.16		MH on Line w/45° Bend	
14+39.18	13+58.60	80.58		0.00	1.04			0.94	0.00	0.66	11.85	5.49	8.70	5.14	8.14	0.00	8.14	27	1	0.013	0.0007	589.28	589.33	2.09	2.05	0.068	0.065	0.37	0.03	0.10	589.43	591.16		Bends where radius = diam, 45° Bend	
13+58.60	11+95.98	162.62	B-2	2.05	3.09	0.90	1.85	2.78	10.00	1.10	12.51	5.37	8.53	14.93	23.72	0.00	23.72	42	1	0.013	0.0006	589.09	589.18	2.05	2.47	0.065	0.094	0.35	0.02	0.10	589.28	591.16		60° Wye connection	
11+95.98	10+24.23	171.75	B-3	2.18	5.27	0.90	1.96	4.74	10.00	1.16	13.61	5.18	8.26	24.59	39.18	0.00	39.18	54	1	0.013	0.0004	588.92	588.99	2.47	2.46	0.094	0.094	0.35	0.03	0.10	589.09	591.16		MH on Line w/60° Lat	
10+24.23	08+59.33	164.90	B-4	2.17	7.44	0.90	1.95	6.70	10.00	1.01	14.77	5.00	8.00	33.51	53.56	0.00	53.56	60	1	0.013	0.0004	588.75	588.82	2.46	2.73	0.094	0.116	0.35	0.03	0.10	588.92	591.16		60° Wye connection	
08+59.33	06+96.15	163.18	B-5	2.16	9.60	0.90	1.94	8.64	10.00	0.79	15.78	4.86	7.78	41.97	67.27	0.00	67.27	60	1	0.013	0.0007	588.50	588.61	2.73	3.43	0.116	0.182	0.35	0.04	0.14	588.75	591.16		60° Wye connection	
06+96.15	05+45.61	150.54	B-6	2.17	11.77	0.90	1.95	10.59	10.00	0.74	16.57	4.75	7.63	50.31	80.79	0.00	80.79	66	1	0.013	0.0006	588.29	588.38	3.43	3.40	0.182	0.180	0.35	0.06	0.12	588.50	591.16		60° Wye connection	
05+45.61	03+44.61	201.00	B-7	2.18	13.95	0.90	1.96	12.56	10.00	0.85	17.31	4.65	7.49	58.43	93.98	0.00	93.98	66	1	0.013	0.0008	587.96	588.11	3.40	3.96	0.180	0.243	0.35	0.06	0.18	588.29	591.50		60° Wye connection	
03+44.61	02+95.85	48.76	B-8	1.11	15.06	0.90	1.00	13.56	10.00	0.19	18.16	4.55	7.33	61.66	99.38	0.00	99.38	66	1	0.013	0.0009	587.73	587.77	3.96	4.18	0.243	0.272	0.35	0.09	0.19	587.96	591.50		60° Wye connection	
02+95.85	00+44.53	251.32		0.00	15.06			13.56	0.00	1.01	18.35	4.53	7.30	61.35	98.91	0.00	98.91	66	1	0.013	0.0009	587.40	587.61	4.18	4.16	0.272	0.269	0.42	0.11	0.11	587.73	591.50		MH on Line w/45° Bend	
00+44.53	00+00.00	44.53		0.00	15.06			13.56	0.00	0.18	19.36	4.41	7.12	59.77	96.58	0.00	96.58	66	1	0.013	0.0008	587.26	587.30	4.16	4.07	0.269	0.257	0.25	0.07	0.10	587.40	588.70		Bends where radius = diam, 30° Bend	HGL at Pipe Soffit
LINE C																																			
04+36.13	00+79.07	357.06	OS-5	14.47	14.47	0.90	13.02	13.02	10.00	0.92	10.00	5.85	9.80	76.24	127.63	0.00	127.63	60	1	0.013	0.0024	588.13	588.99	0.00	6.50	0.000	0.656	0.23	0.00	0.15	589.14	591.75	2.61	Sudden Enlargement, D2/D1 =1.4	J8 in line with Pipe Size Change, Connect to PK line HGL below top of existing pipe.
00+79.07	00+19.16	59.91	OS-4	8.28	22.75	0.90	7.45	20.47	10.00	0.13	10.92	5.67	8.95	116.01	183.34	0.00	183.34	66	1	0.013	0.0030	587.26	587.44	6.50	7.72	0.656	0.925	0.35	0.23	0.70	588.13	590.50		MH on Line w/60° Lat	HGL at Pipe Soffit
LINE D-1																																			
11+71.20	11+38.88	32.32	D-1	0.99	0.99	0.90	0.89	0.89	10.00	0.19	10.00	5.85	9.80	5.22	8.73	0.00	8.73	24	1	0.013	0.0015	589.23	589.28	2.78	2.78	0.120	0.120	1.25	0.15	0.15	589.43	592.16	2.73	Inlet at Beg. of Line	
11+38.88	09+96.80	142.08		0.00	0.99			0.89	0.00	0.91	10.19	5.81	9.17	5.18	8.17	0.00	8.17	24	1	0.013	0.0013	588.94	589.13	2.78	2.60	0.120	0.105	0.37	0.04	0.10	589.23	591.60		Bends where radius = diam, 45° Bend	
09+96.80	08+32.96	163.84		0.00	0.99			0.89	0.00	1.08	11.10	5.63	8.90	5.02	7.93	0.00	7.93	24	1	0.013	0.0012	588.64	588.84	2.60	2.52	0.105	0.099	0.42	0.04	0.10	588.94	591.60		MH on Line w/45° Bend	
08+32.96	07+85.88	47.08	D-2	1.93	2.92	0.90	1.74	2.63	10.00	0.25	12.19	5.43	8.61	14.26	22.63	0.00	22.63	36	1	0.013	0.0012	588.46	588.52	2.52	3.20	0.099	0.159	0.35	0.03	0.12	588.64	591.60		60° Wye connection	
07+85.88	06+77.31	108.57		0.00	2.92			2.63	0.00	0.57	12.43	5.38	8.55	14.15	22.46	0.00	22.46	36	1	0.013	0.0011	588.24	588.36	3.20	3.18	0.159	0.157	0.37	0.06	0.10	588.46	591.60		Bends where radius = diam, 45° Bend	
06+77.31	04+97.32	179.99	D-3	2.19	5.11	0.90	1.97	4.60	10.00	0.98	13.00	5.28	8.41	24.31	38.66	0.00	38.66	48	1	0.013	0.0007	588.01	588.14	3.18	3.08	0.157	0.147	0.35	0.05	0.10	588.24	591.60		MH on Line w/60° Lat	
04+97.32	03+16.80	180.52	D-4	2.17	7.28	0.90	1.95	6.55	10.00	0.71	13.98	5.13	8.18	33.58	53.56	0.00	53.56	48	1	0.013	0.0014	587.55	587.80	3.08	4.26	0.147	0.282	0.50	0.07	0.21	588.01	591.60		MH on Trunk Line w/45° Branch Lat	
03+16.80	00+00.00	316.80	D-5	2.21	9.49	0.90	1.99	8.54	10.00	0.97	14.68	5.02	8.02	42.85	68.47	0.00	68.47	48	1	0.013	0.0023	586.47	587.19	4.26	5.45	0.282	0.461	0.35	0.10	0.36	587.55	590.50		60° Wye connection	HGL at Pipe Soffit
LINE D-2																																			
01+34.64	00+81.00	53.64	D-6a	0.68	0.68	0.90	0.61	0.61	10.00	0.26	10.00	5.85	9.80	3.58	6.00	0.00	6.00	18	1	0.013	0.0033	583.01	583.18	0.00	3.39	0.000	0.179	1.25	0.00	0.22	583.41	585.82	2.41	Inlet at Beg. of Line	
00+81.00	00+71.13	9.87		0.00	0.68			0.61	0.00	0.05	10.26	5.80	9.14	3.55	5.60	0.00	5.60	18	1	0.013	0.0028	582.88	582.91	3.39	3.17	0.179	0.156	0.42	0.08	0.10	583.01	587.67		MH on Line w/45° Bend	
00+71.13	00+23.95	47.18	D-6b	0.65	1.33																														

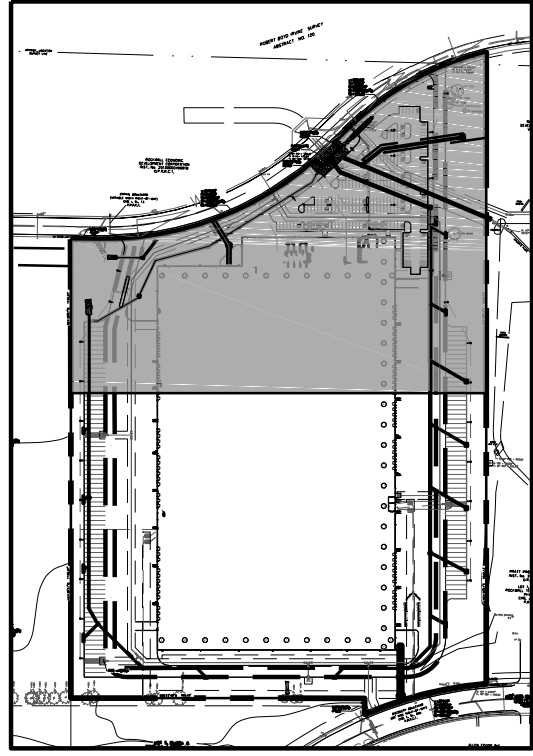


KEY MAP

NOTES

- ALL RESPONSIBILITY FOR ADEQUACY OF DESIGN REMAINS WITH THE DESIGN ENGINEER. THE CITY OF ROCKWALL, IN REVIEWING AND RELEASING PLANS FOR CONSTRUCTION, ASSUMES NO RESPONSIBILITY FOR ADEQUACY OR ACCURACY OF DESIGN.
- ALL ON-SITE STORM DRAINAGE LINES SHALL BE PRIVATE EXCEPT FOR STORM DRAIN LINE C. STORM DRAIN LINE C IS LOCATED IN THE PUBLIC DRAINAGE EASEMENT AND WILL REMAIN PUBLIC.
- REFER TO SHEET C04-15 FOR GROUTED RIP-RAP DETAIL.

ROCKWALL ECONOMIC
DEVELOPMENT CORPORATION
INST. No. 20130000496918
O.P.R.R.C.T.

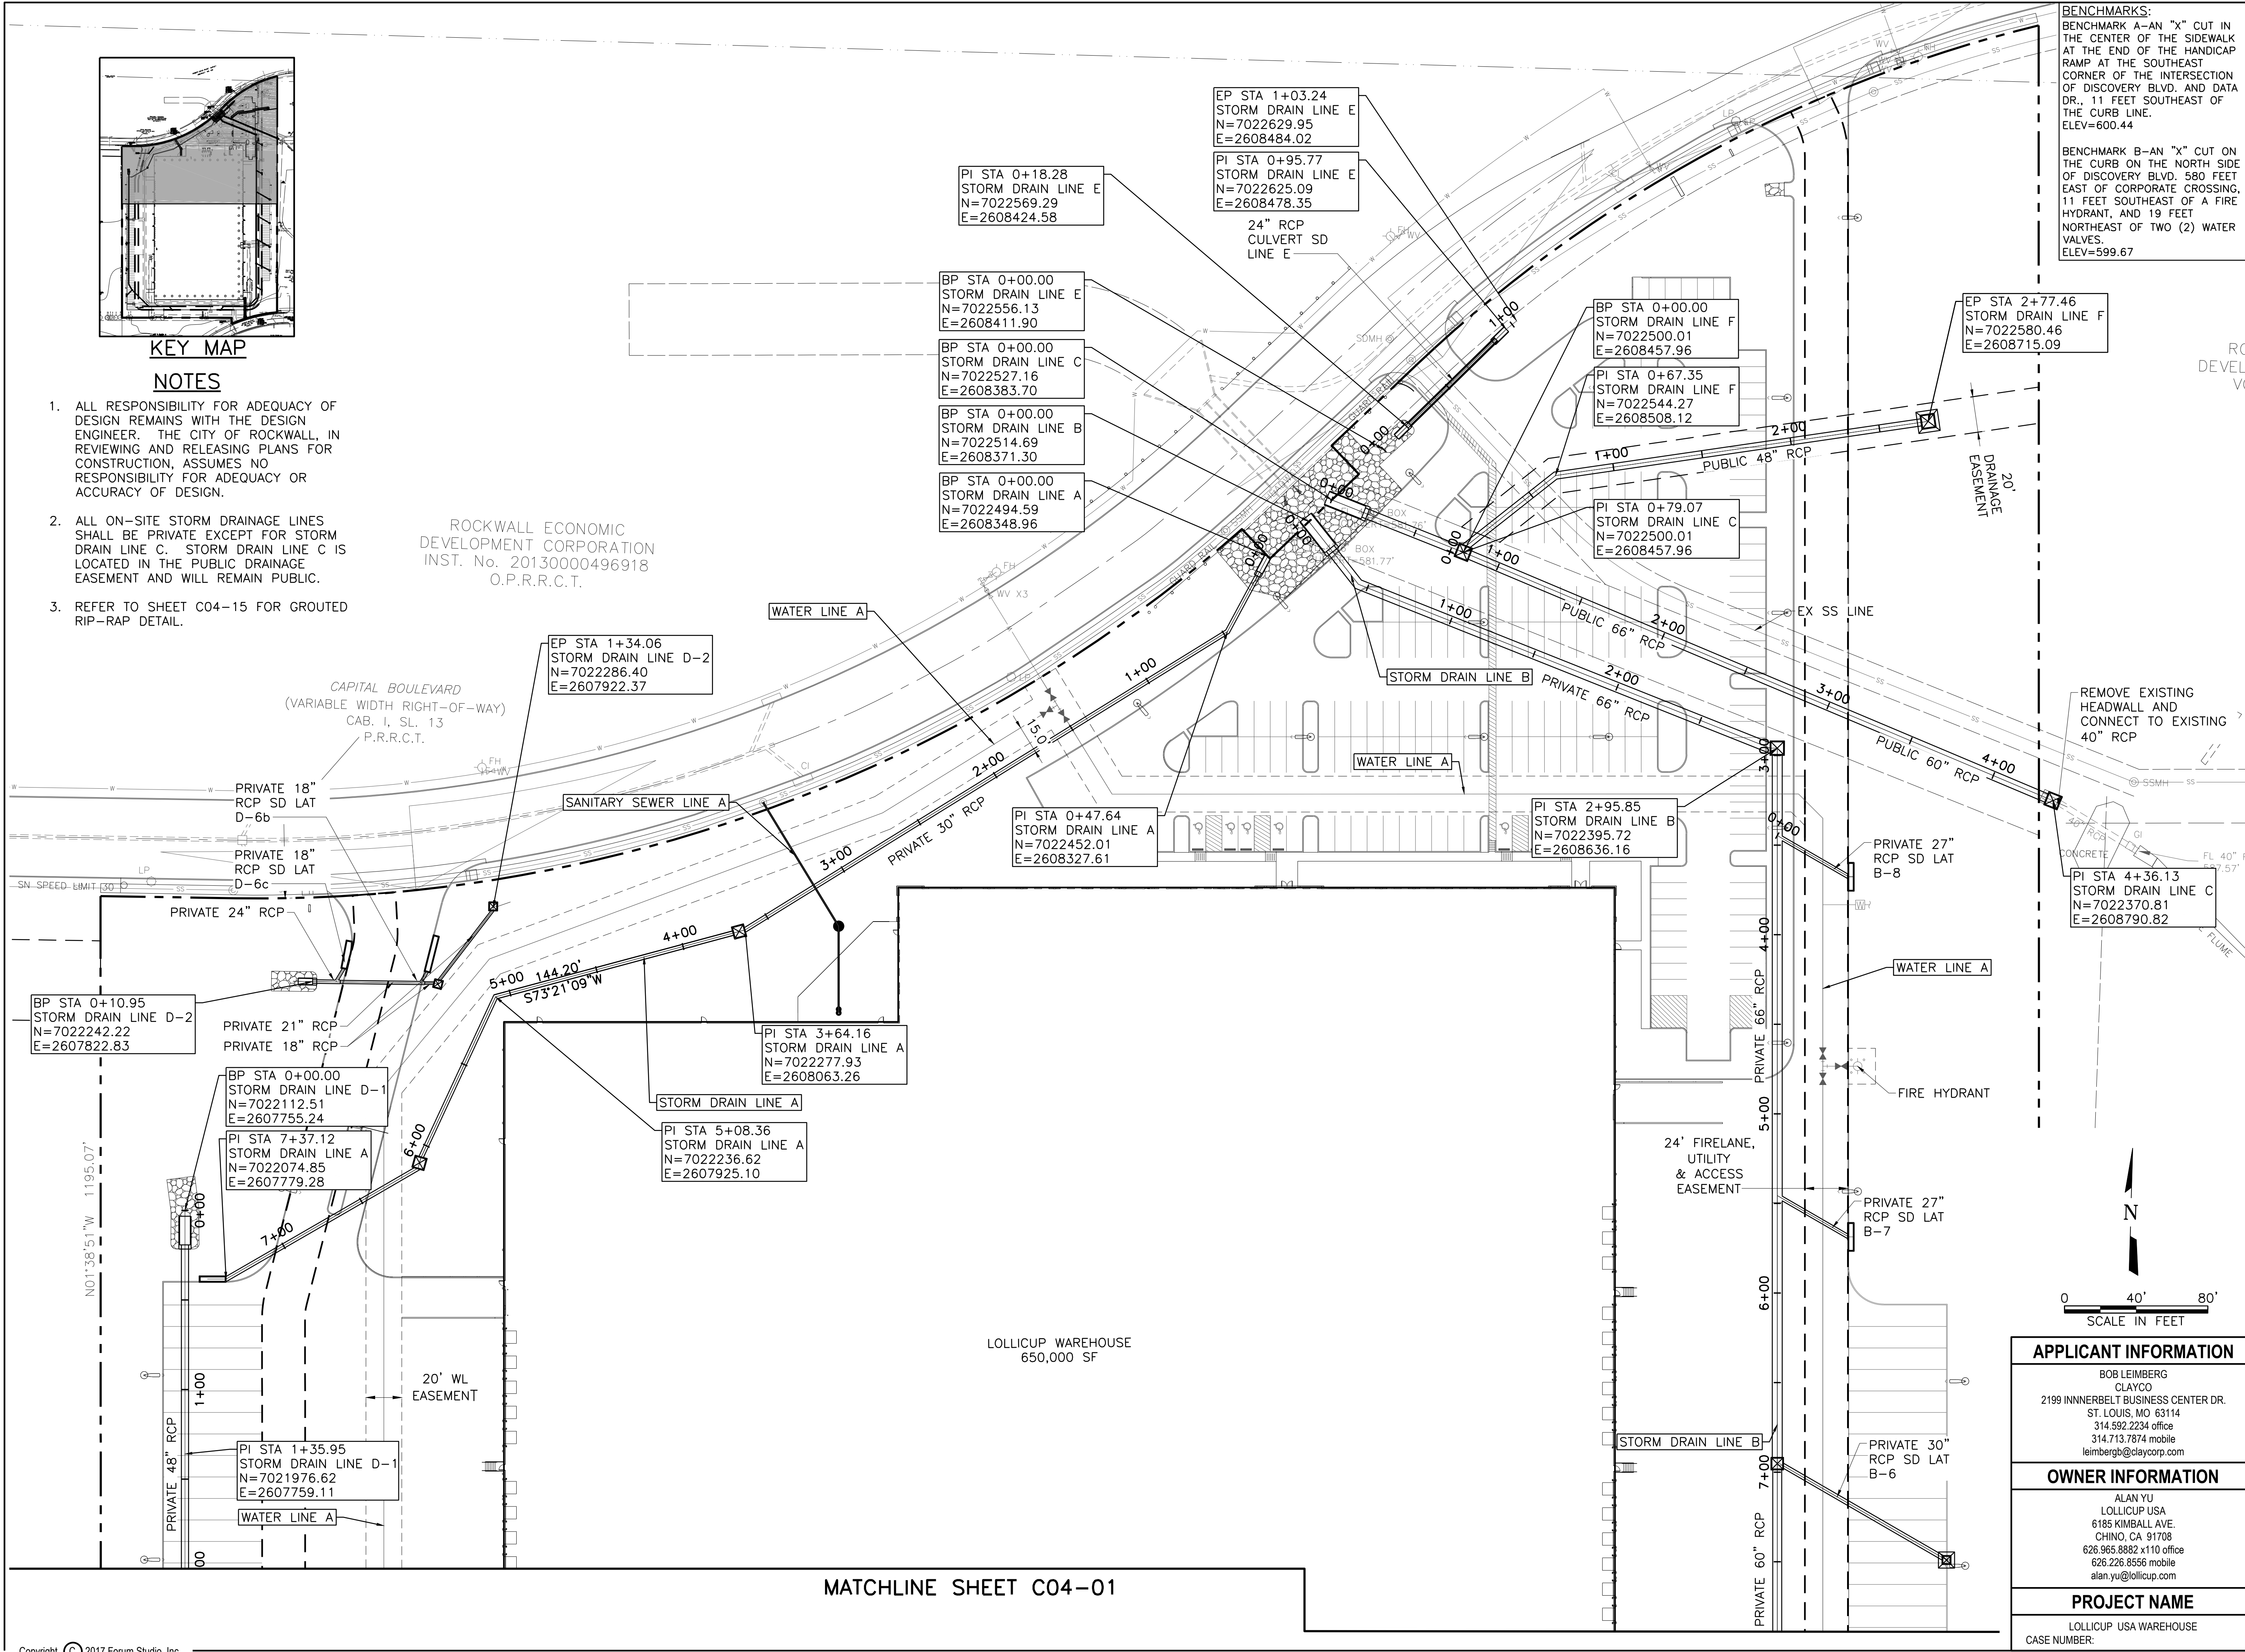

BENCHMARKS:
BENCHMARK A-AN "X" CUT IN THE CENTER OF THE SIDEWALK AT THE END OF THE HANDICAP RAMP AT THE SOUTHEAST CORNER OF THE INTERSECTION OF DISCOVERY BLVD. AND DATA DR., 11 FEET SOUTHEAST OF THE CURB LINE. ELEV=600.44
BENCHMARK B-AN "X" CUT ON THE CURB ON THE NORTH SIDE OF DISCOVERY BLVD. 580 FEET EAST OF CORPORATE CROSSING, 11 FEET SOUTHEAST OF A FIRE HYDRANT, AND 19 FEET NORTHEAST OF TWO (2) WATER VALVES. ELEV=599.67

THE SEAL THAT ORIGINALLY APPEARED ON THIS DOCUMENT WAS AUTHORIZED BY: BRIET M. BRISLOW, P.E.
TEAS NO.: 100000 ON: 2/20/2018
ALTERNATION OF A SEALED DOCUMENT WITHOUT PROPER NOTIFICATION OF THE RESPONSIBLE ENGINEER IS AN OFFENSE UNDER THE TEXAS ENGINEERING PRACTICE ACT.
This Record Drawing is a combination of the sealed engineering contract drawings for this project, modified by information furnished by the contractor reflecting changes in the Project made during construction. The original sealed drawings are on file at the offices of:
FREES & NICHOLS, INC.
RECORD DRAWINGS PREPARED ON: 3/6/2019

CLAYCO

THE ART & SCIENCE OF BUILDING

2199 INNERBELT BUSINESS CENTER DRIVE
ST. LOUIS, MISSOURI 63114
Ph 314.428.1010 Fx 314.428.7770

ARCHITECT

FORUM

2199 INNERBELT BUSINESS CENTER DRIVE
ST. LOUIS, MISSOURI 63114
Ph 314.428.1010 Fx 314.428.7770

CONTRACTOR / DEVELOPER

CLAYCO

LANDSCAPE ARCHITECT

FORUM

CIVIL ENGINEER

FREES & NICHOLS

STRUCTURAL ENGINEER

MECHANICAL ENGINEER

ELECTRICAL ENGINEER

PLUMBING ENGINEER

FIRE PROTECTION ENGINEER

Lollicup

ROCKWALL TECHNOLOGY PARK
ROCKWALL, TEXAS

DRAWING ISSUE

DESCRIPTION	DATE
ENGINEERING SUBMITTAL	2/2/2018
CITY OF ROCKWALL	
ENGINEERING REVIEW	3/2/2018
2ND SUBMITTAL	
ENGINEERING REVIEW	3/23/2018
3RD SUBMITTAL	
ISSUED FOR CONSTRUCTION	4/10/2018
RECORD DRAWING	3/6/2019

APPLICANT INFORMATION

BOB LEIMBERG
CLAYCO
2199 INNERBELT BUSINESS CENTER DR.
ST. LOUIS, MO 63114
314.592.2234 office
314.713.7874 mobile
leimbergb@claycorp.com

OWNER INFORMATION

ALAN YU
LOLLICUP USA
6185 KIMBALL AVE.
CHINO, CA 91708
626.965.8882 x110 office
626.226.8556 mobile
alan.yu@lollicup.com

PROJECT NAME

LOLLICUP USA WAREHOUSE

CASE NUMBER:

601-03049

DRAWING TITLE

OVERALL STORM DRAINAGE PLAN

DRAWING NO.

C04-00

Forum #


601-03049

Consult.#



101-03049

12/12/2017 1:31:05 PM


MATCHLINE SHEET C04-00

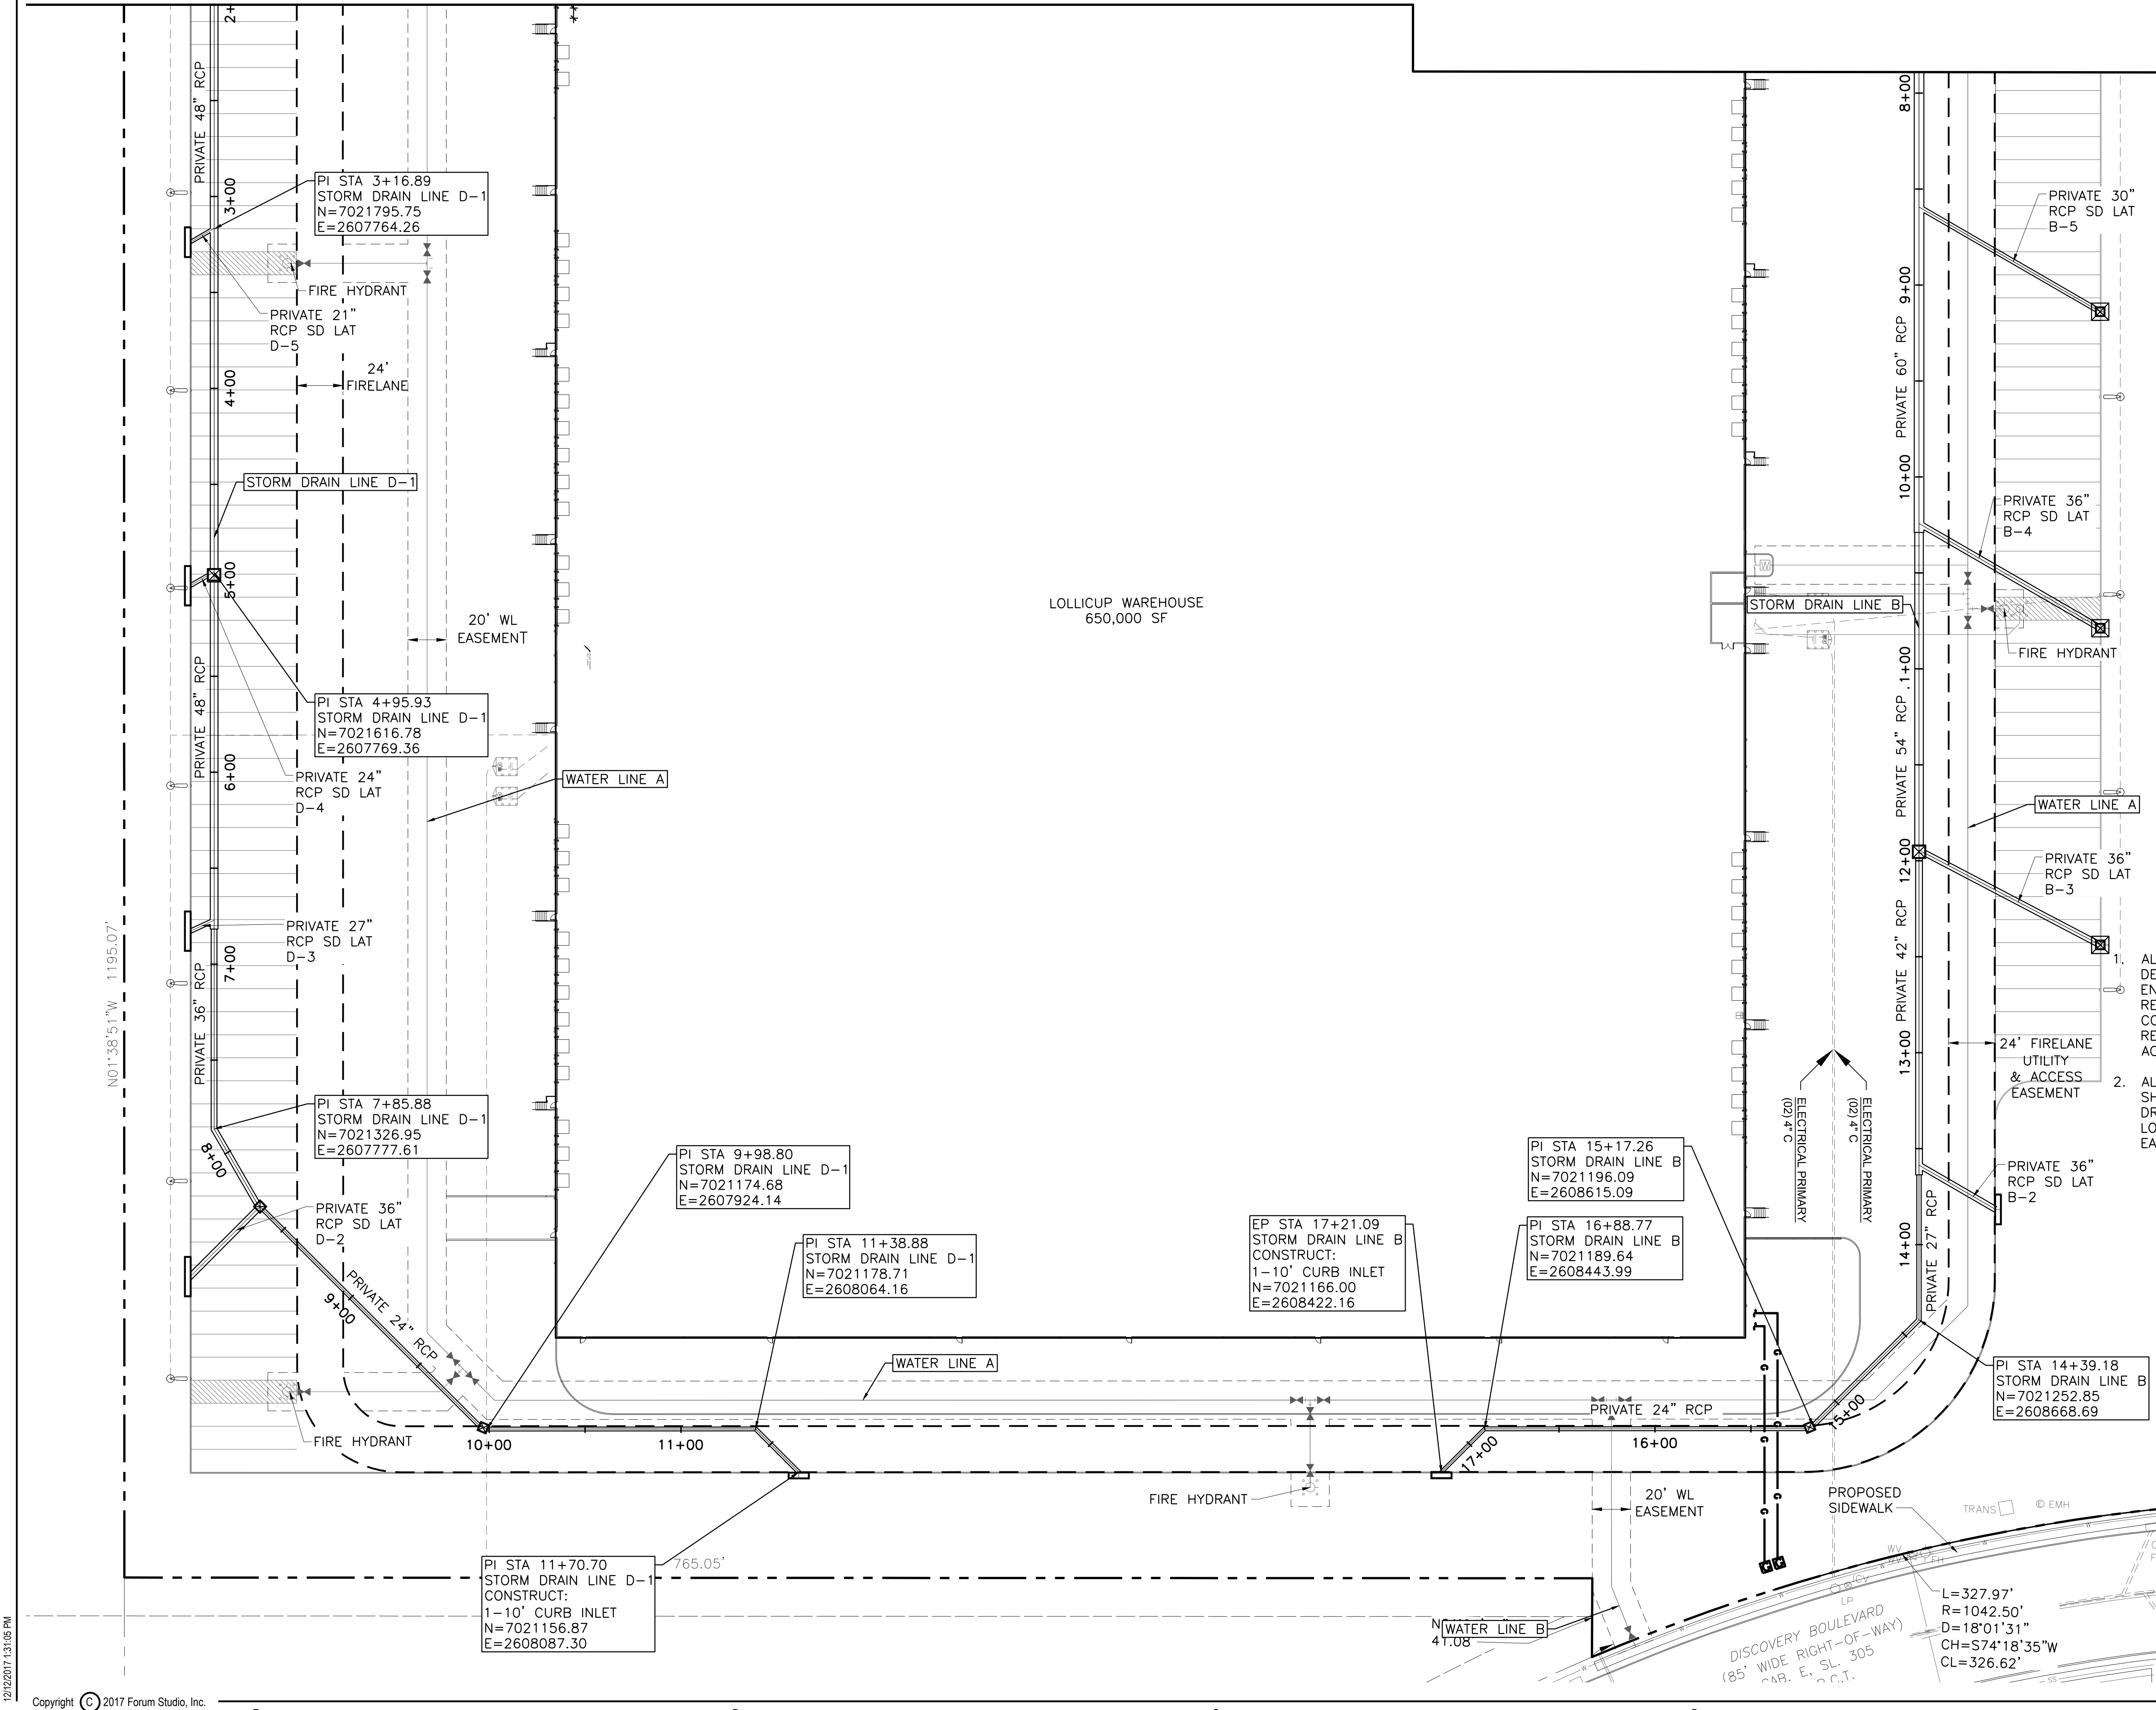

BENCHMARKS:
BENCHMARK A-AN "X" CUT IN THE CENTER OF THE SIDEWALK AT THE END OF THE HANDICAP RAMP AT THE SOUTHEAST CORNER OF THE INTERSECTION OF DISCOVERY BLVD. AND DATA DR., 11 FEET SOUTHEAST OF THE CURB LINE. ELEV=600.44
BENCHMARK B-AN "X" CUT ON THE CURB ON THE NORTH SIDE OF DISCOVERY BLVD. 580 FEET EAST OF CORPORATE CROSSING, 11 FEET SOUTHEAST OF A FIRE HYDRANT, AND 19 FEET NORTHEAST OF TWO (2) WATER VALVES. ELEV=599.67

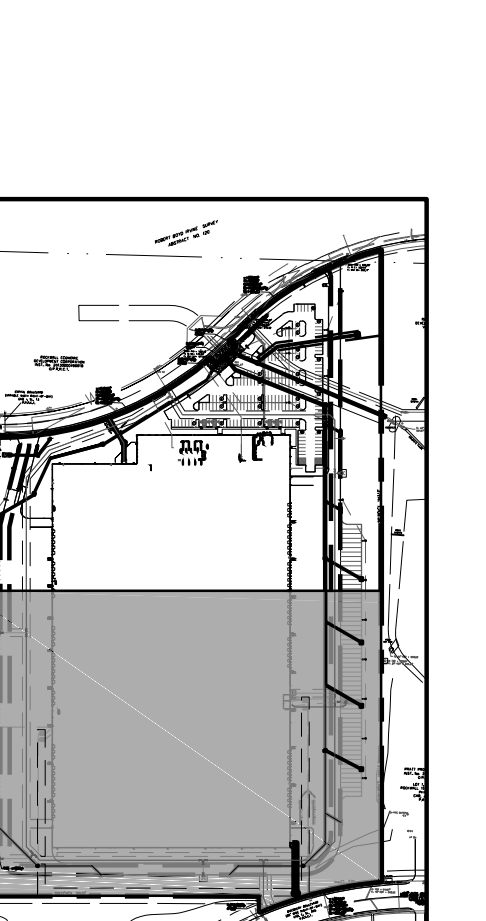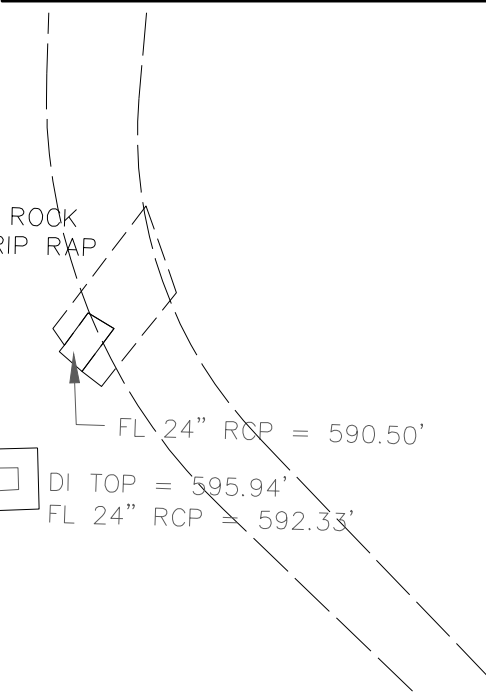

NOTES
1. ALL RESPONSIBILITY FOR ADEQUACY OF DESIGN REMAINS WITH THE DESIGN ENGINEER. THE CITY OF ROCKWALL, IN REVIEWING AND RELEASING PLANS FOR CONSTRUCTION, ASSUMES NO RESPONSIBILITY FOR ADEQUACY OR ACCURACY OF DESIGN.
2. ALL ON-SITE STORM DRAINAGE LINES SHALL BE PRIVATE EXCEPT FOR STORM DRAIN LINE C. STORM DRAIN LINE C IS LOCATED IN THE PUBLIC DRAINAGE EASEMENT AND WILL REMAIN PUBLIC.

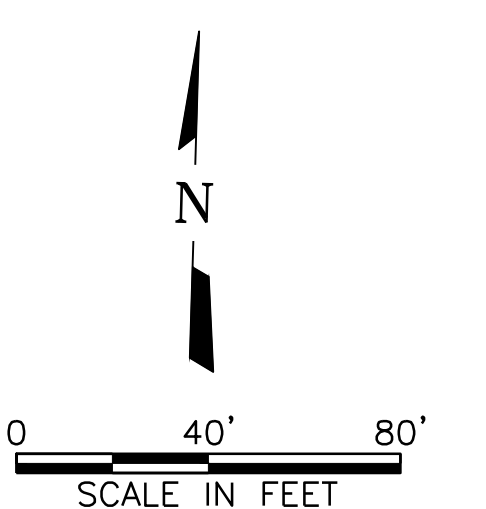

APPLICANT INFORMATION		
BOB LEIMBERG CLAYCO 2199 INNERBELT BUSINESS CENTER DR. ST. LOUIS, MO 63114 314.592.2234 office 314.713.7874 mobile leimbergb@claycorp.com	1	22/2018
OWNER INFORMATION		
ALAN YU LOLLICUP USA 6185 KIMBALL AVE. CHINO, CA 91708 626.965.8882 x110 office 626.226.8556 mobile alan.yu@lolicup.com		
PROJECT NAME		
LOLLICUP USA WAREHOUSE		
CASE NUMBER:		

THE SEAL THAT ORIGINALLY APPEARED ON THIS DOCUMENT WAS AUTHORIZED BY: BRIET M. BRISLOW, P.E.
T.E.A.S. NO. 101000 ON 1/20/2018
ALTERATION OF A SEALED DOCUMENT WITHOUT PROPER NOTIFICATION OF THE RESPONSIBLE ENGINEER IS AN OFFENSE UNDER THE T.E.A.S. ENGINEERING PRACTICE ACT.

This Record Drawing is a combination of the sealed engineering contract drawings for this project, modified by information furnished by the contractor reflecting changes in the Project made during construction. The original sealed drawings are on file at the offices of:

FREESE AND NICHOLS, INC.
RECORD DRAWINGS PREPARED ON: 3/6/2019

CLAYCO
THE ART & SCIENCE OF BUILDING
2199 INNERBELT BUSINESS CENTER DRIVE
ST. LOUIS, MISSOURI 63114
Ph 314.428.5100 Fx 314.428.3137

ARCHITECT
FORUM
2199 INNERBELT BUSINESS CENTER DRIVE
ST. LOUIS, MISSOURI 63114
Ph 314.428.1010 Fx 314.428.7770

CONTRACTOR / DEVELOPER
CLAYCO

LANDSCAPE ARCHITECT
FORUM

CIVIL ENGINEER
FREESE & NICHOLS

STRUCTURAL ENGINEER

MECHANICAL ENGINEER


ELECTRICAL ENGINEER

PLUMBING ENGINEER

FIRE PROTECTION ENGINEER

Lollicup
ROCKWALL TECHNOLOGY PARK
ROCKWALL, TEXAS



DRAWING ISSUE		
DESCRIPTION	DATE	
ENGINEERING SUBMITTAL CITY OF ROCKWALL	2/22/2018	
ENGINEERING REVIEW 2ND SUBMITTAL	3/2/2018	
ENGINEERING REVIEW 3RD SUBMITTAL	3/23/2018	
ISSUED FOR CONSTRUCTION	4/10/2018	
RECORD DRAWING	3/6/2019	
DRAWING TITLE		
OVERALL STORM DRAINAGE PLAN		
DRAWING NO.		
C04-01		
Form #	601-03049	Consult #
101-03049		

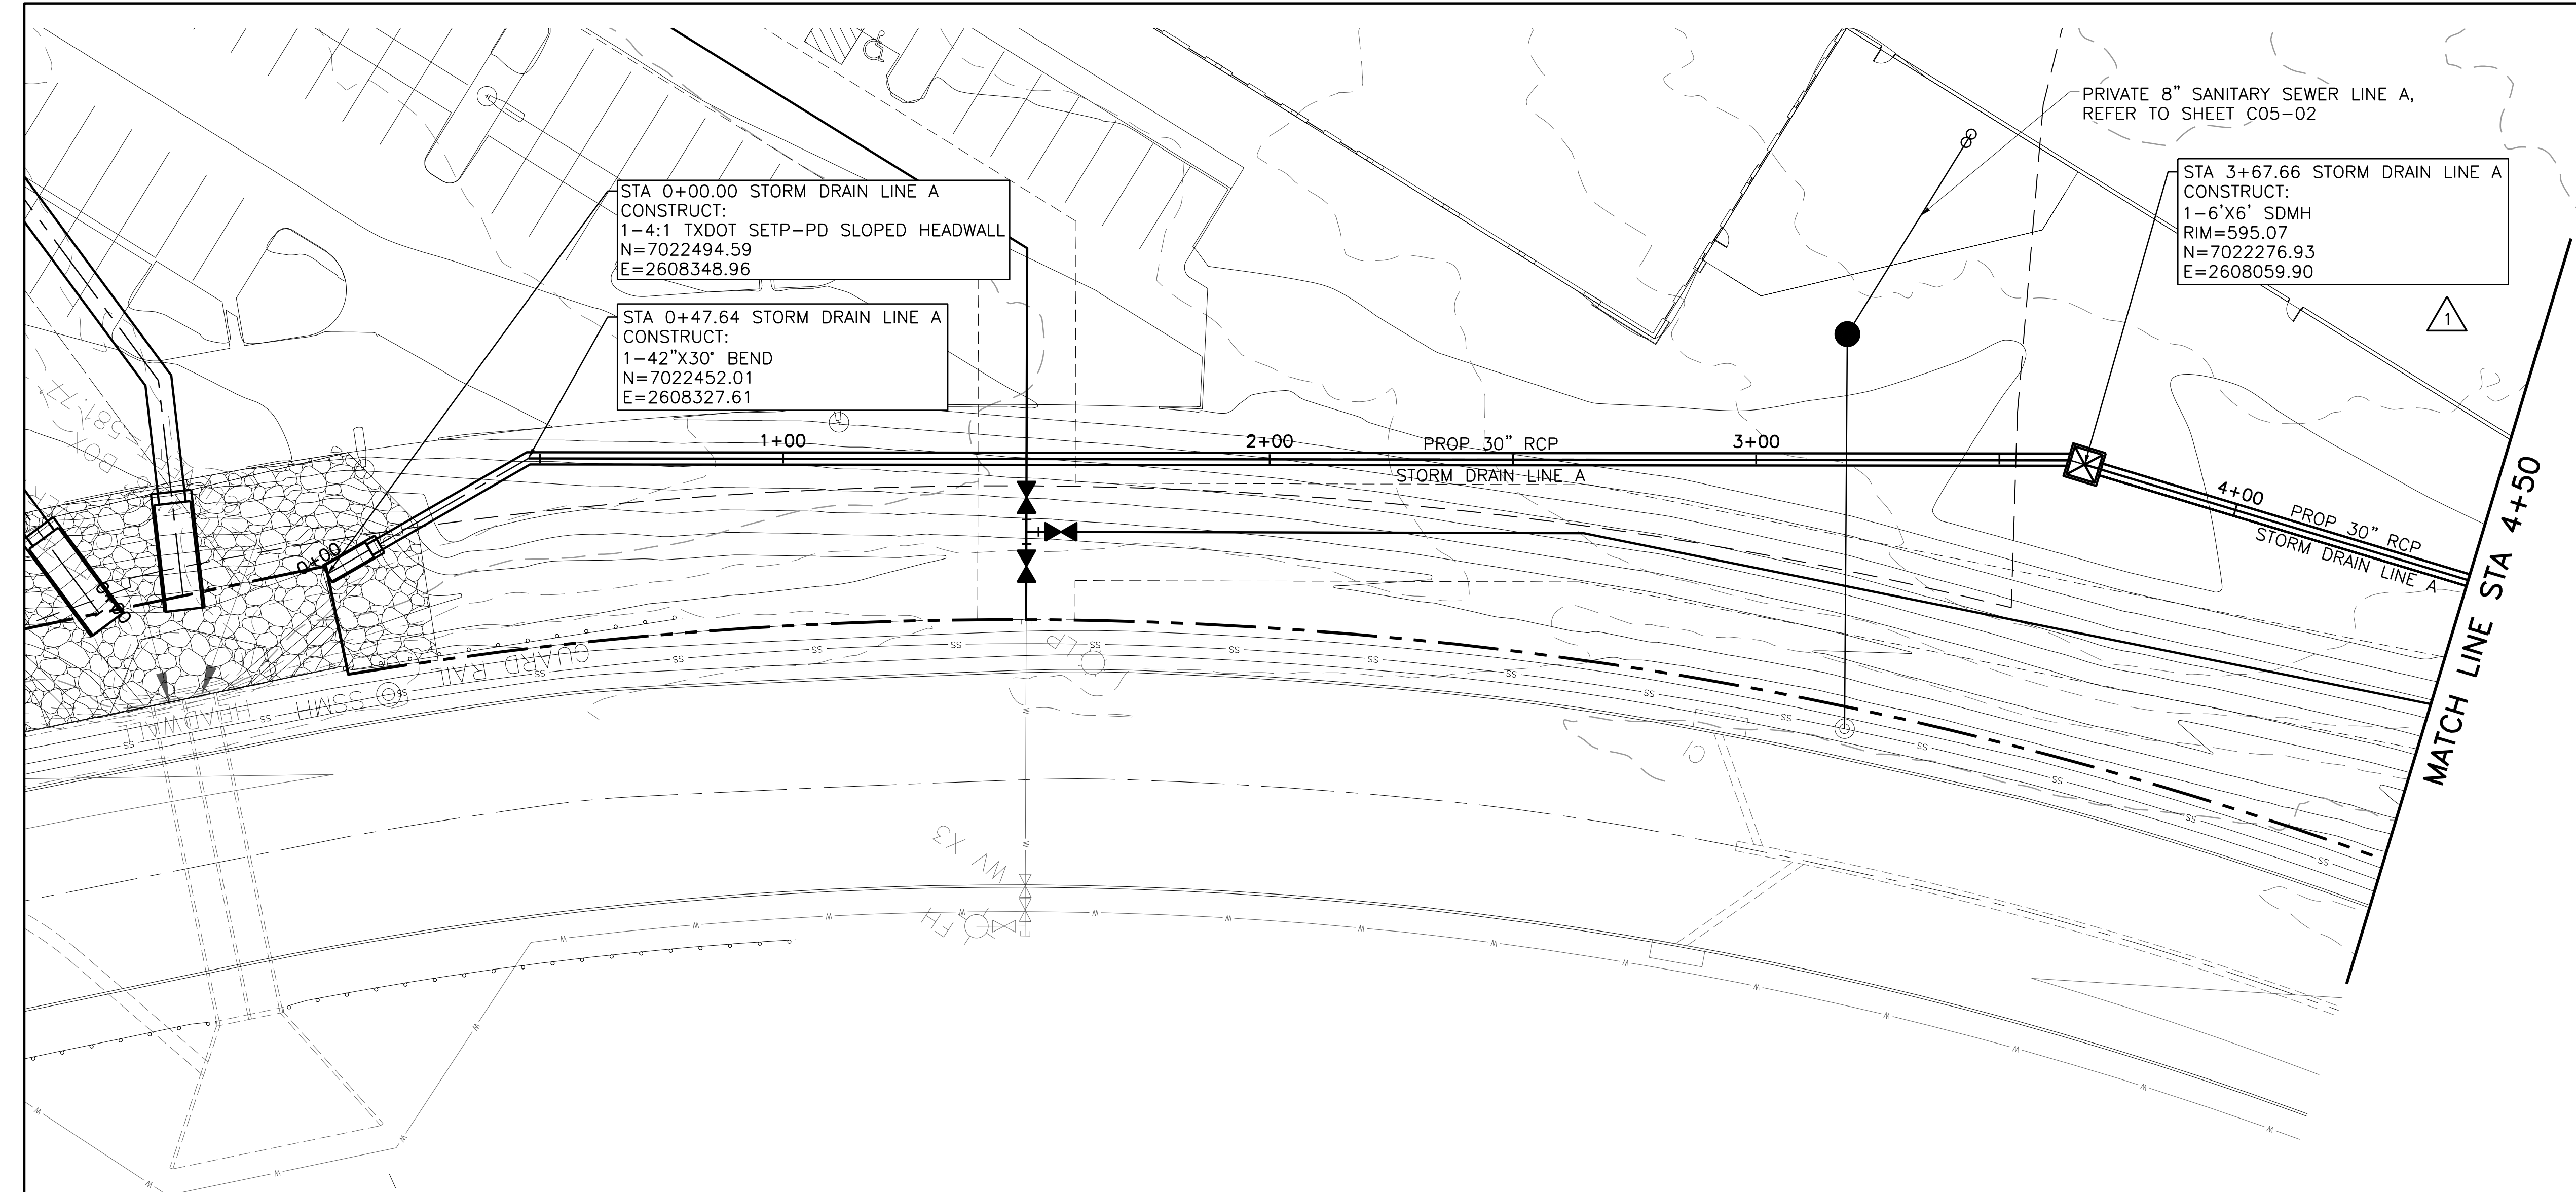



BENCHMARKS:
BENCHMARK A-AN "X" CUT IN THE CENTER OF THE SIDEWALK AT THE END OF THE HANDICAP RAMP AT THE SOUTHEAST CORNER OF THE INTERSECTION OF DISCOVERY BLVD. AND DATA DR., 11 FEET SOUTHEAST OF THE CURB LINE. ELEV=600.44
BENCHMARK B-AN "X" CUT ON THE CURB ON THE NORTH SIDE OF DISCOVERY BLVD. 580 FEET EAST OF CORPORATE CROSSING, 11 FEET SOUTHEAST OF A FIRE HYDRANT, AND 19 FEET NORTHEAST OF TWO (2) WATER VALVES. ELEV=599.67

NOTES

- ALL RESPONSIBILITY FOR ADEQUACY OF DESIGN REMAINS WITH THE DESIGN ENGINEER. THE CITY OF ROCKWALL, IN REVIEWING AND RELEASING PLANS FOR CONSTRUCTION, ASSUMES NO RESPONSIBILITY FOR ADEQUACY OR ACCURACY OF DESIGN.
- REFER TO SHEET C04-15 FOR GROUTED RIP-RAP DETAIL.
- REFER TO SHEET C06-02 FOR TXDOT SETP-PD DETAIL

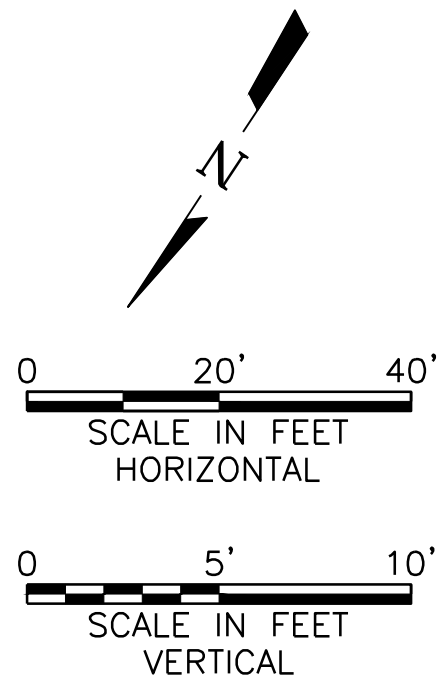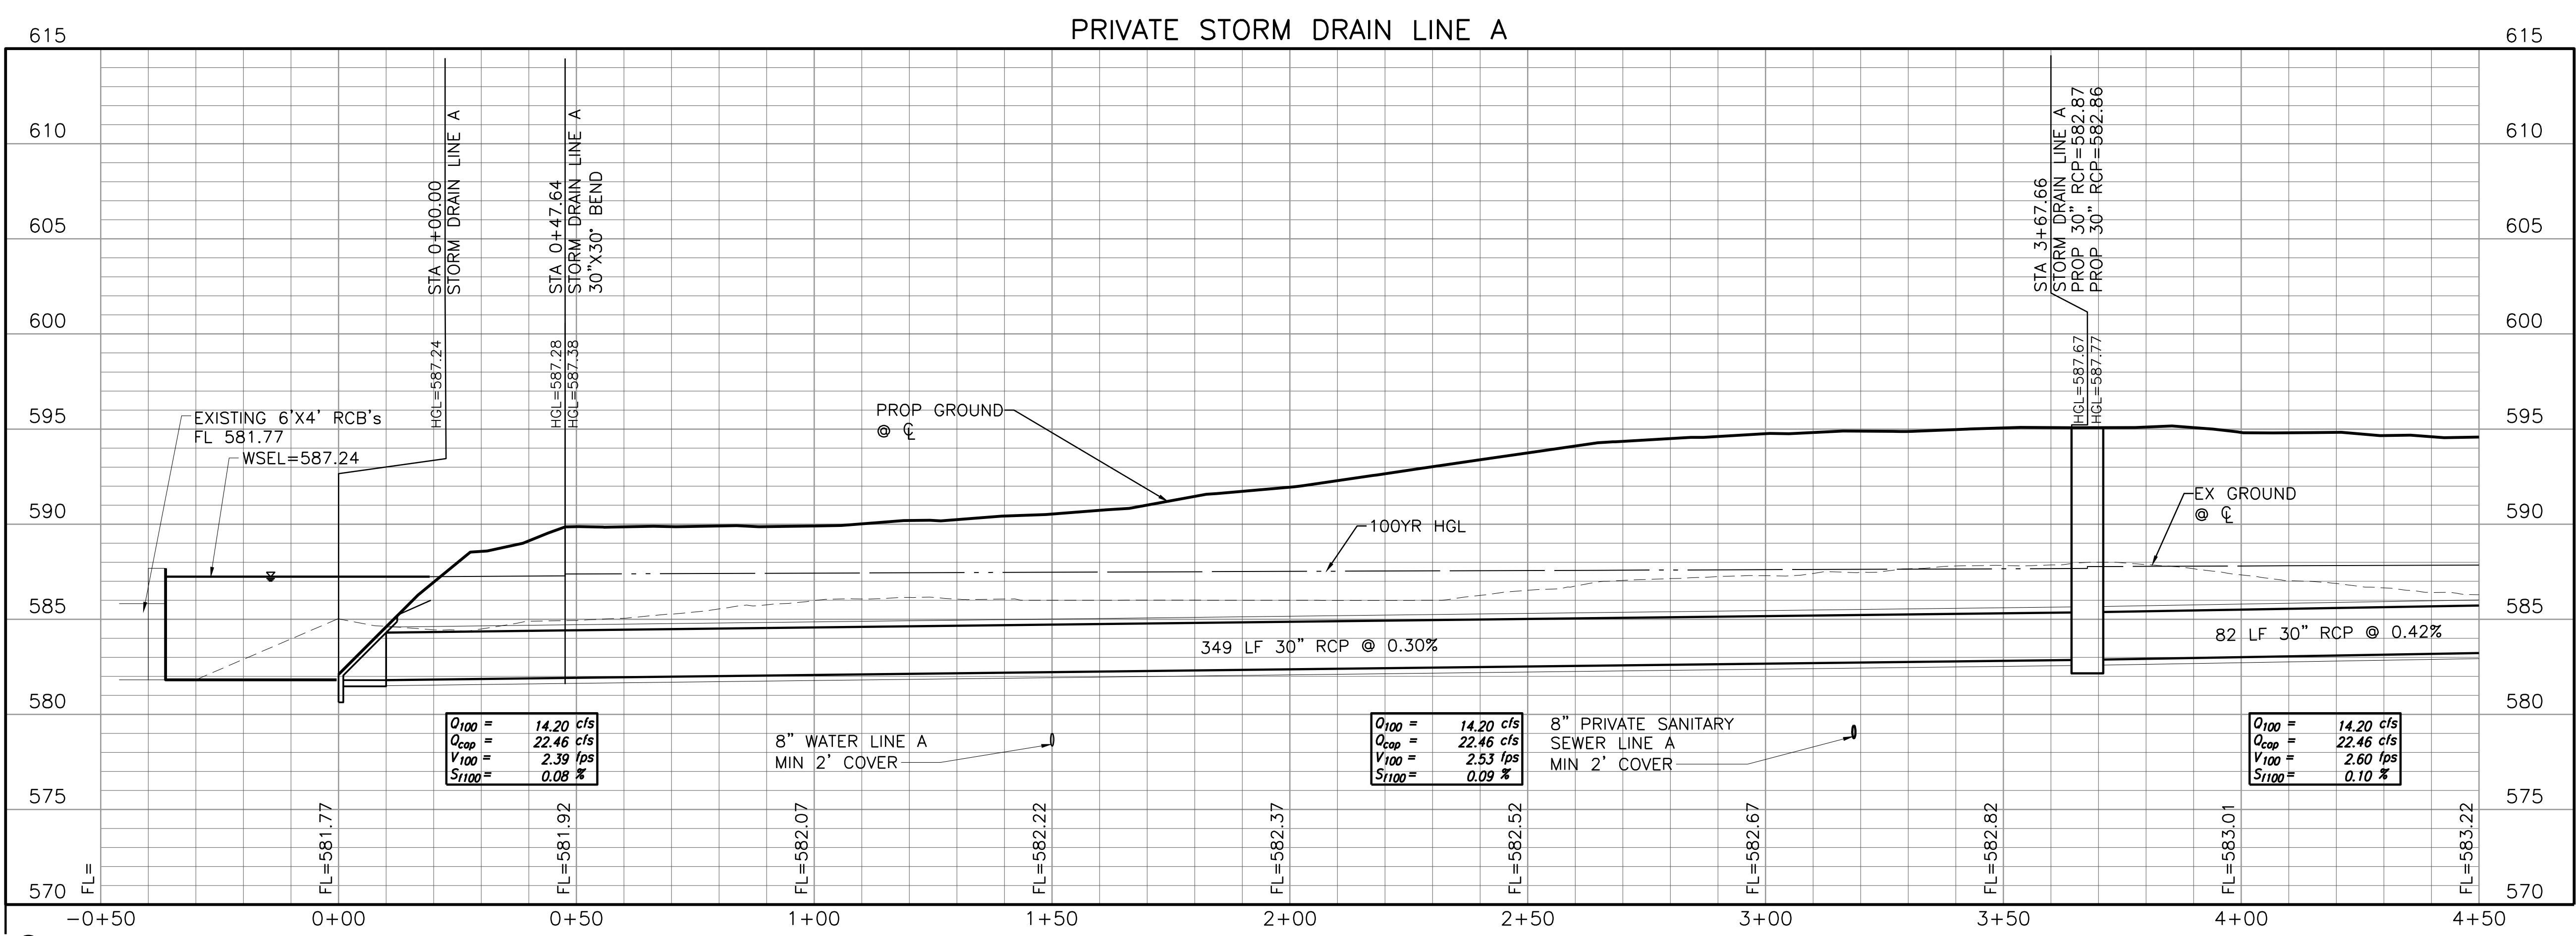

<p>THE SEAL THAT ORIGINALLY APPEARED ON THIS DOCUMENT WAS AUTHORIZED BY: BRET M. BRISLOW, P.E. ON: 5/13/2018. ALTERATION OF A SEALED DOCUMENT WITHOUT PROPER NOTIFICATION OF THE RESPONSIBLE ENGINEER IS AN OFFENSE UNDER THE TEXAS ENGINEERING PRACTICE ACT.</p> <p>This Record Drawing is a combination of the sealed engineering contract drawings for this project, modified by information furnished by the contractor reflecting changes in the Project made during construction. The original sealed drawings are on file at the offices of:</p> <p>FREES AND NICHOLS, INC. RECORD DRAWINGS PREPARED ON: 3/6/2019</p>	
<p>CLAYCO THE ART & SCIENCE OF BUILDING 2199 INNERBELT BUSINESS CENTER DRIVE ST. LOUIS, MISSOURI 63114 Ph 314.429.5100 Fx 314.429.3137</p>	
<p>ARCHITECT FORUM 2199 INNERBELT BUSINESS CENTER DRIVE ST. LOUIS, MISSOURI 63114 Ph 314.429.1010 Fx 314.429.7770</p>	
<p>CONTRACTOR / DEVELOPER CLAYCO</p>	
<p>LANDSCAPE ARCHITECT FORUM</p>	
<p>CIVIL ENGINEER FREES & NICHOLS</p>	
<p>STRUCTURAL ENGINEER</p>	
<p>MECHANICAL ENGINEER</p>	
<p>ELECTRICAL ENGINEER</p>	
<p>PLUMBING ENGINEER</p>	
<p>FIRE PROTECTION ENGINEER</p>	
<p>Lollicup ROCKWALL TECHNOLOGY PARK ROCKWALL, TEXAS</p>	
<p>DRAWING ISSUE</p>	
<p>APPLICANT INFORMATION</p>	<p>DESCRIPTION DATE</p>
<p>BOB LEIMBERG CLAYCO 2199 INNERBELT BUSINESS CENTER DR. ST. LOUIS, MO 63114 314.592.2234 office 314.713.7874 mobile leimbergb@claycorp.com</p>	<p>ENGINEERING SUBMITTAL CITY OF ROCKWALL 2/2/2018</p>
	<p>ENGINEERING REVIEW 2ND SUBMITTAL 3/2/2018</p>
	<p>ENGINEERING REVIEW 3RD SUBMITTAL 3/23/2018</p>
	<p>ISSUED FOR CONSTRUCTION 4/10/2018</p>
<p>OWNER INFORMATION</p>	<p>SD R/FIS 6/13/2018</p>
<p>ALAN YU LOLLICUP USA 6185 KIMBALL AVE. CHINO, CA 91708 626.965.8882 x110 office 626.226.8556 mobile alan.yu@lollicup.com</p>	<p>RECORD DRAWING 3/6/2019</p>
	<p>DRAWING TITLE STORM DRAIN LINE A PLAN AND PROFILE</p>
<p>PROJECT NAME</p>	<p>DRAWING NO.</p>
<p>LOLLICUP USA WAREHOUSE CASE NUMBER:</p>	<p>C04-02</p>
<p>Forum # 601-03049</p>	<p>Consult # 101-03049</p>

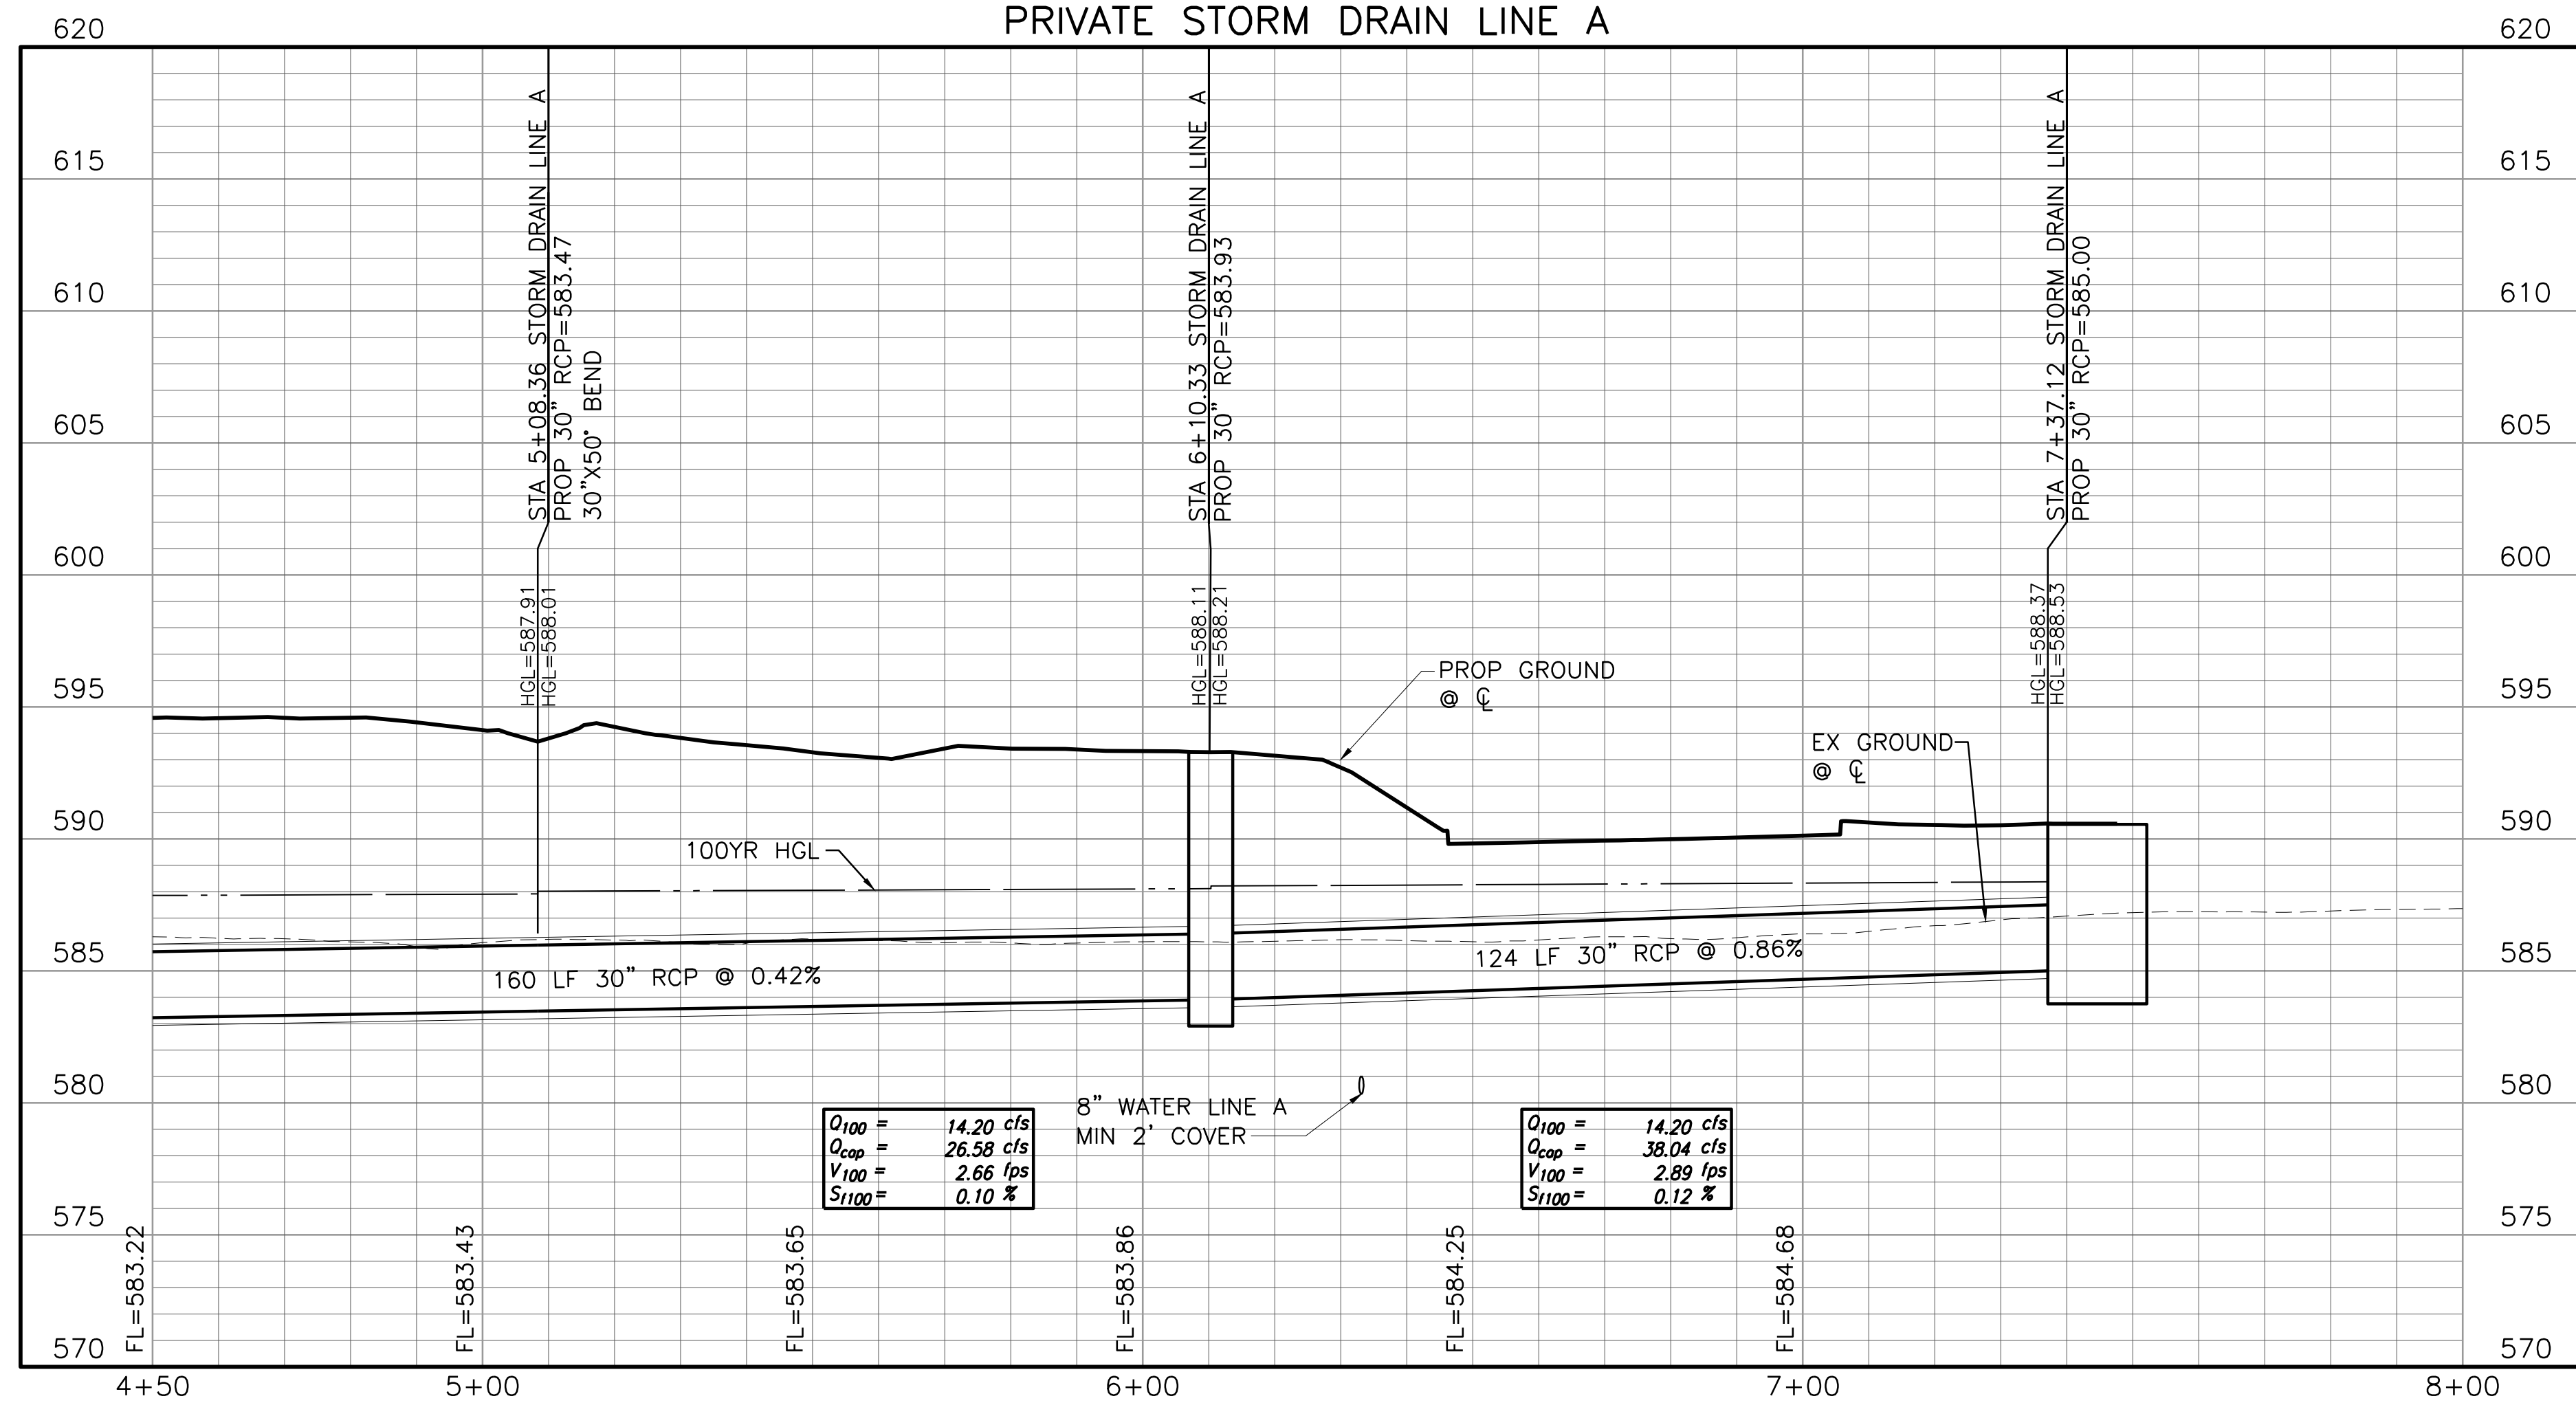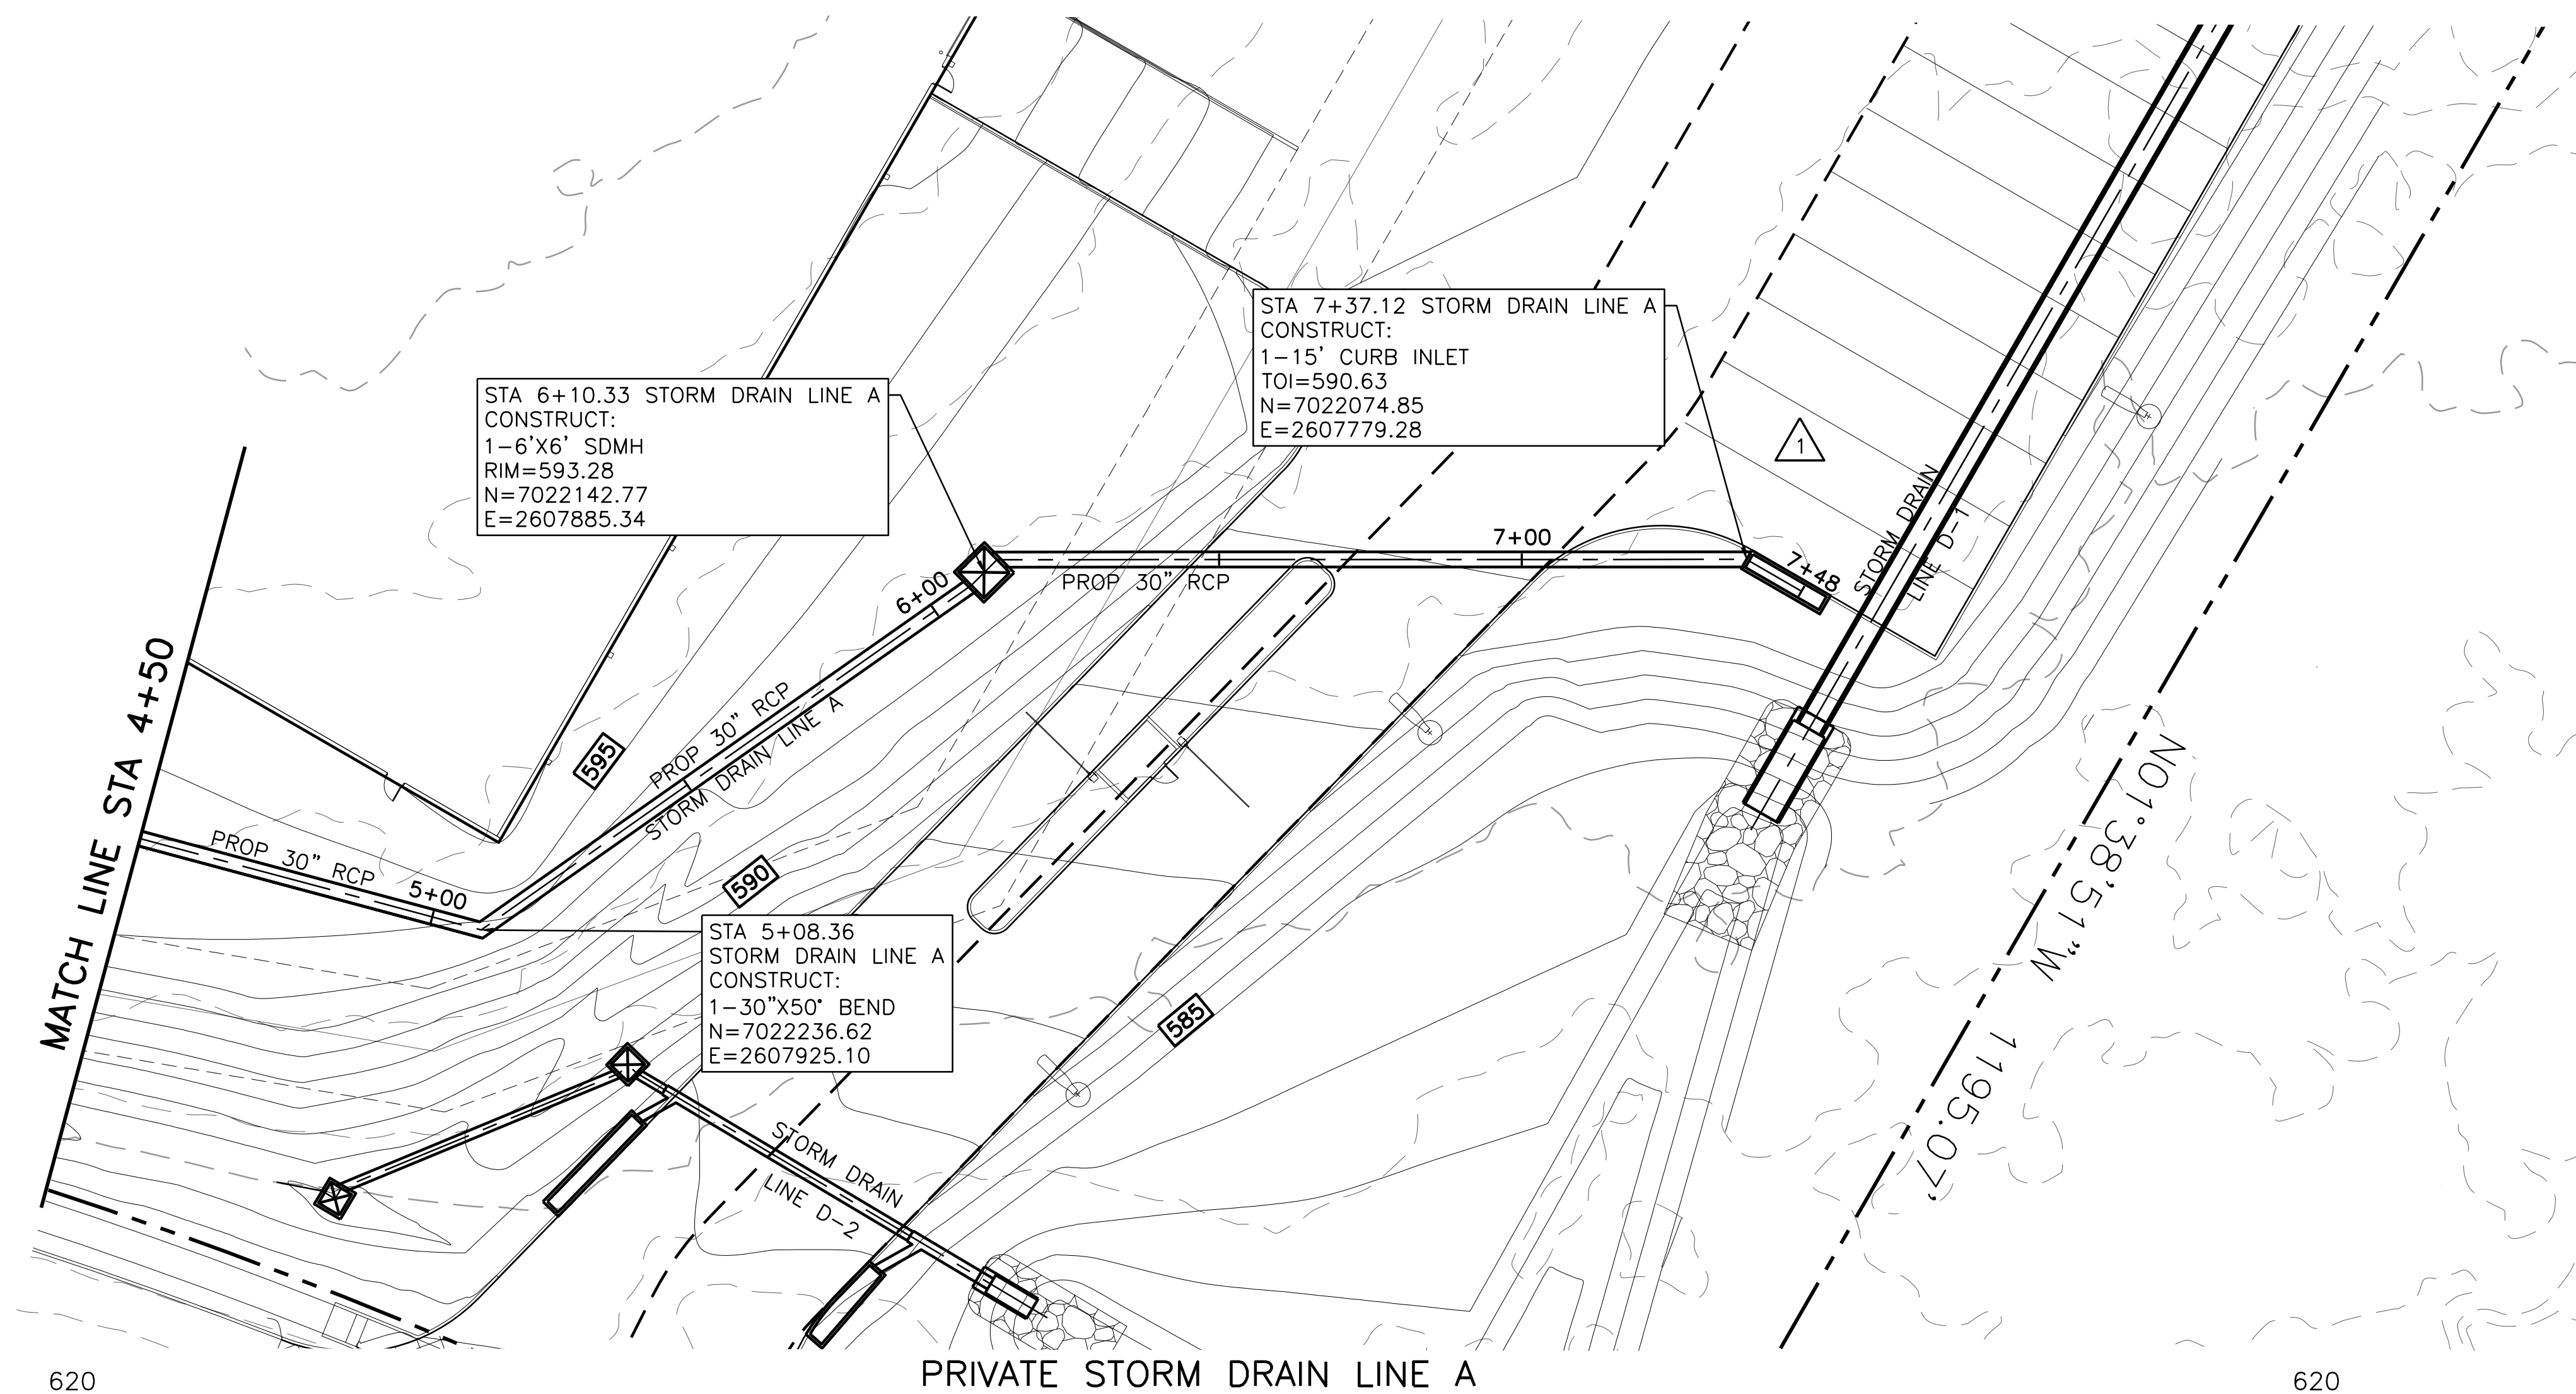

BENCHMARKS:

BENCHMARK A--AN "X" CUT IN THE CENTER OF THE SIDEWALK AT THE END OF THE HANDICAP RAMP AT THE SOUTHEAST CORNER OF THE INTERSECTION OF DISCOVERY BLVD. AND DATA DR., 11 FEET SOUTHEAST OF THE CURB LINE.
ELEV=600.44

BENCHMARK B-AN "X" CUT ON THE CURB ON THE NORTH SIDE OF DISCOVERY BLVD. 580 FEET EAST OF CORPORATE CROSSING, 11 FEET SOUTHEAST OF A FIRE HYDRANT, AND 19 FEET NORTHEAST OF TWO (2) WATER VALVES.
ELEV=599.67

THE SEAL THAT ORIGINALLY APPEARED ON THIS DOCUMENT
 WAS AUTHORIZED BY BRETT M. BRISTOW P.E.
 TEXAS NO: 101000 ON 6/13/2018
 ALTERATION OF A SEALED DOCUMENT WITHOUT PROPER
 NOTIFICATION OF THE RESPONSIBLE ENGINEER IS AN
 OFFENSE UNDER THE TEXAS ENGINEERING PRACTICE ACT.

This Record Drawing is a combination of the sealed engineering contract drawings for this project, modified by information furnished by the contractor reflecting changes in the Project made during construction. The original sealed drawings are on file at the offices of

FREESE AND NICHOLS, INC.
RECORD DRAWINGS PREPARED ON:
3/6/2019

CLAYCO
THE ART & SCIENCE OF BUILDING
2199 INNERBELT BUSINESS CENTER DRIVE
ST. LOUIS, MISSOURI 63114
Ph 314.429.5100 Fx 314.429.3137

ARCHITECT

FORUM

2199 INNERBELT BUSINESS CENTER DRIVE
ST. LOUIS, MISSOURI 63114
Ph 314.429.1010 Fx 314.429.7770

CONTRACTOR / DEVELOPER
CLAYCO

LANDSCAPE ARCHITECT
FORUM

CIVIL ENGINEER
FREESE & NICHOLS

STRUCTURAL ENGINEER

MECHANICAL ENGINEER

ELECTRICAL ENGINEER


PLUMBING ENGINEER

FIRE PROTECTION ENGINEER

Lollicup


ROCKWALL TECHNOLOGY PARK
ROCKWALL, TEXAS

DRAWING ISSUE

APPLICANT INFORMATION		DESCRIPTION	DATE
BOB LEIMBERG CLAYCO 2199 INNERBELT BUSINESS CENTER DR. ST. LOUIS, MO 63114 314.592.2234 office 314.713.7874 mobile leimbergb@claycorp.com	1	ENGINEERING SUBMITTAL CITY OF ROCKWALL	2/2/2018
		ENGINEERING REVIEW 2ND SUBMITTAL	3/2/2018
		ENGINEERING REVIEW 3RD SUBMITTAL	3/23/2018
		ISSUED FOR CONSTRUCTION	4/10/2018
		SD RF'IS	6/13/2018
OWNER INFORMATION		RECORD DRAINING	 3/6/2019
ALAN YU LOLLICUP USA 6185 KIMBALL AVE. CHINO, CA 91708 626.965.8882 x110 office 626.226.8556 mobile alan.yu@lollcup.com		DRAWING TITLE STORM DRAIN LINE A PLAN AND PROFILE	
		DRAWING NO.	
		C04-03	
PROJECT NAME		Forum #	601-03049
CASE NUMBER: LOLLICUP USA WAREHOUSE		Consultant #	101-03049

12/12/2017 1:31:05 PM

Copyright © 2017 Forum Studio, Inc.


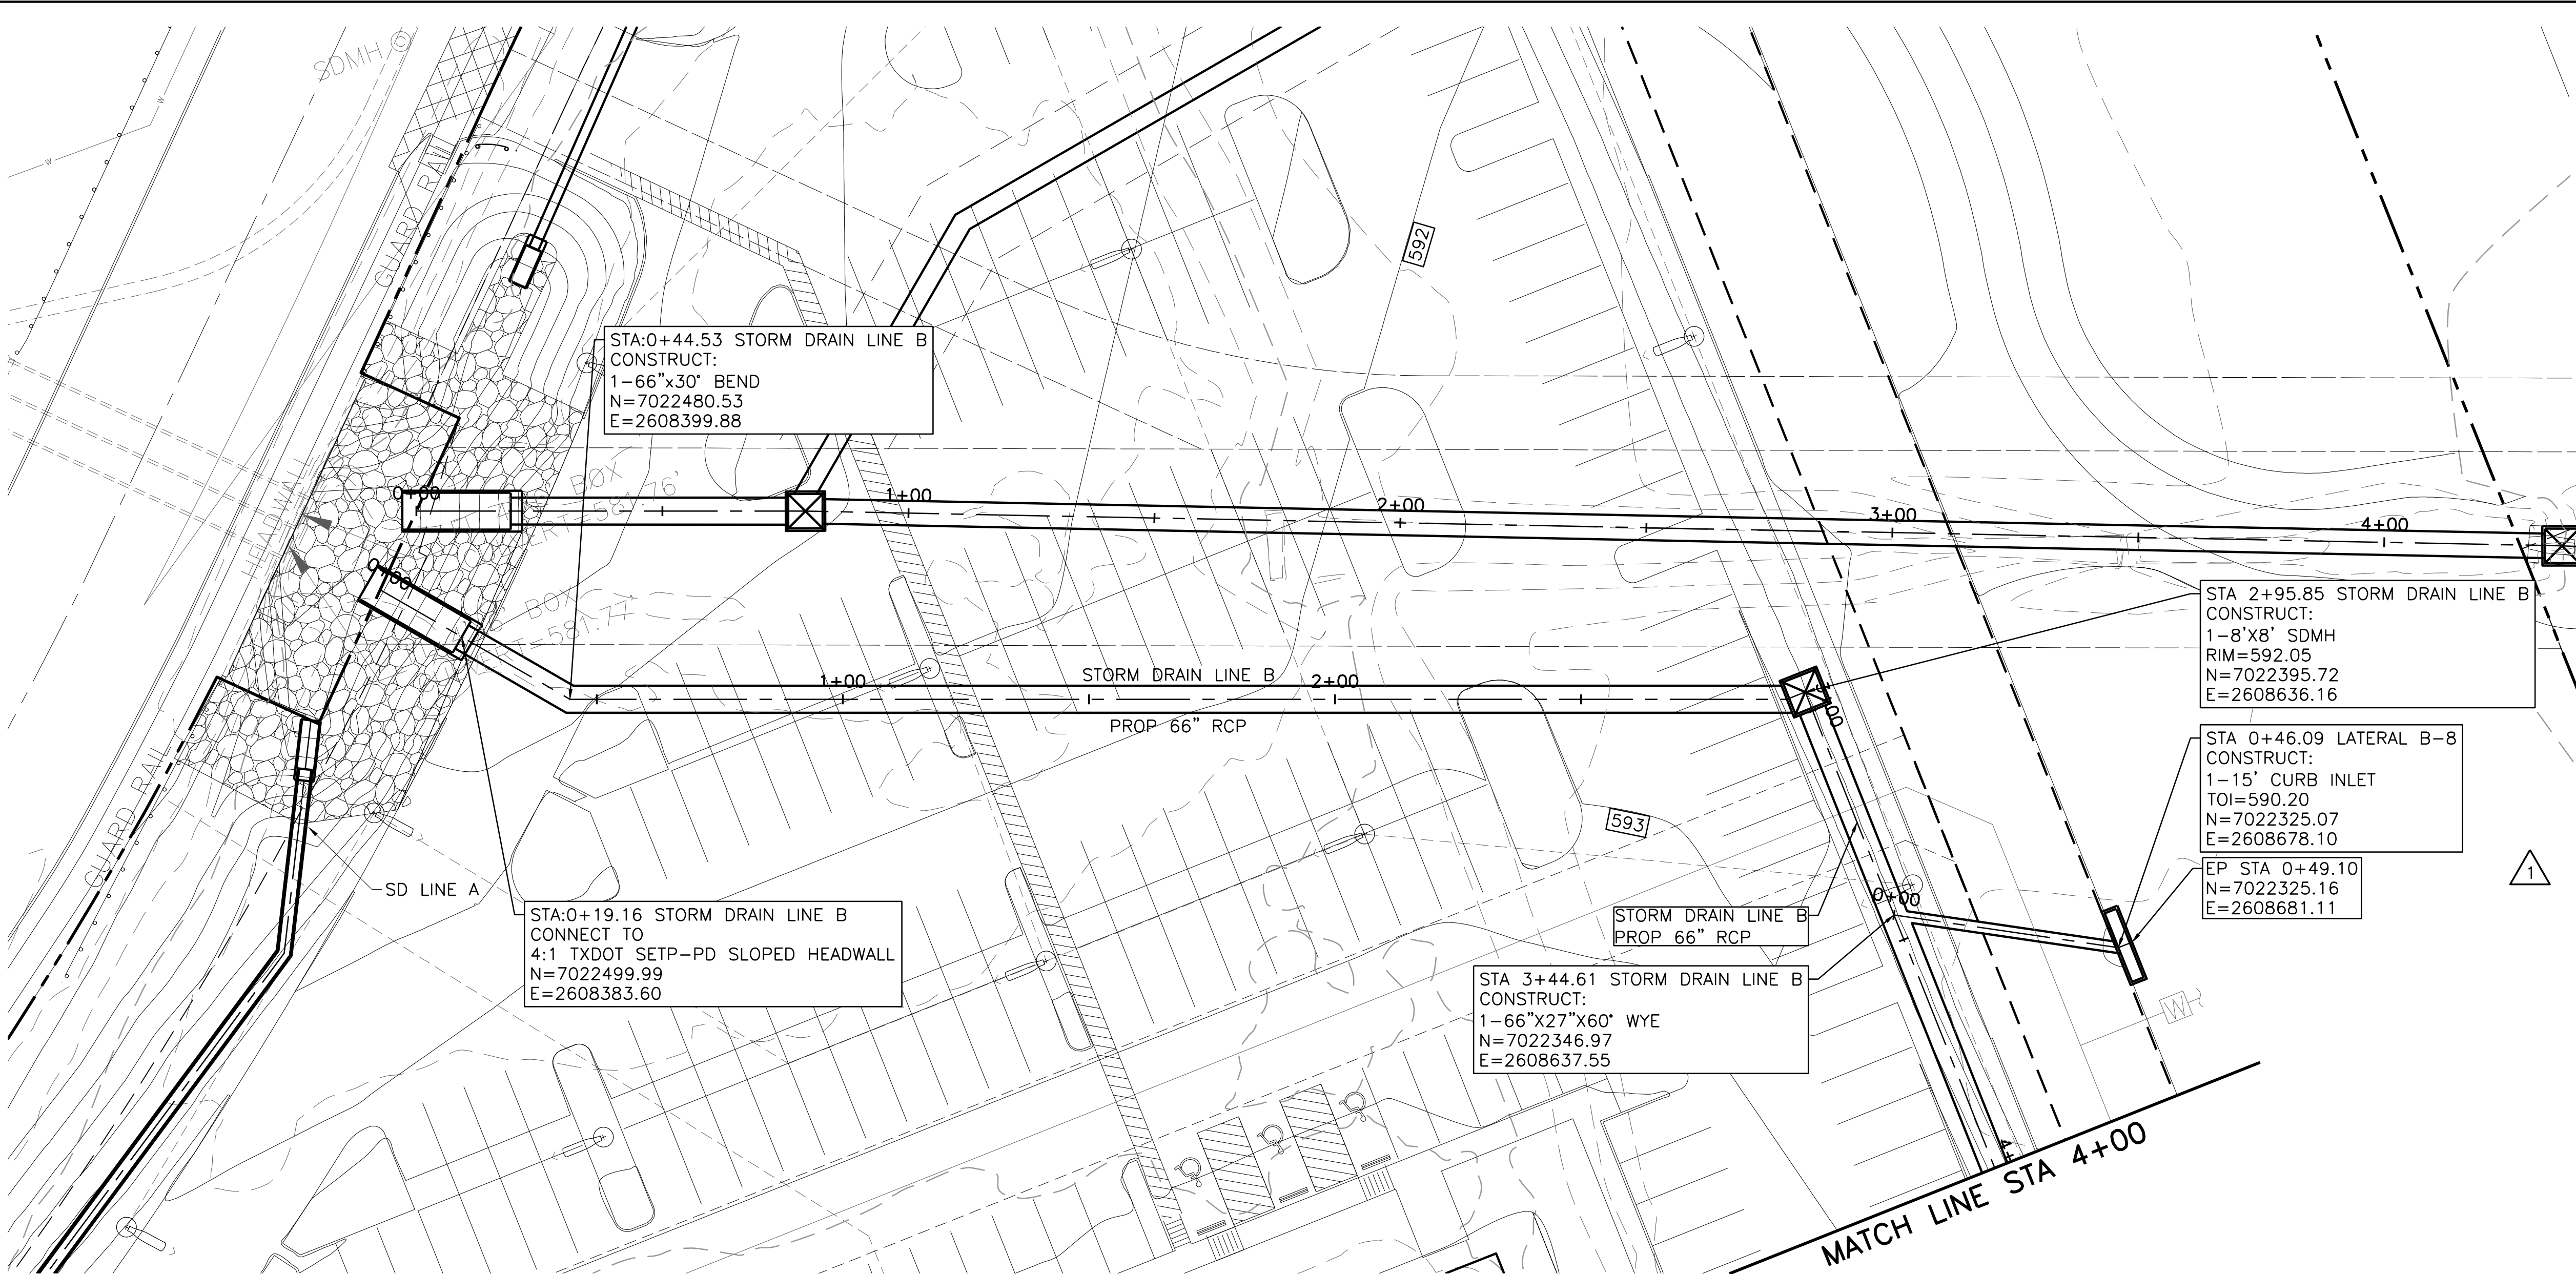


BENCHMARKS:
BENCHMARK A-AN "X" CUT IN THE CENTER OF THE SIDEWALK AT THE END OF THE HANDICAP RAMP AT THE SOUTHEAST CORNER OF THE INTERSECTION OF DISCOVERY BLVD. AND DATA DR., 11 FEET SOUTHEAST OF THE CURB LINE. ELEV=600.44
BENCHMARK B-AN "X" CUT ON THE CURB ON THE NORTH SIDE OF DISCOVERY BLVD. 580 FEET EAST OF CORPORATE CROSSING, 11 FEET SOUTHEAST OF A FIRE HYDRANT, AND 19 FEET NORTHEAST OF TWO (2) WATER VALVES. ELEV=599.67

THE SEAL THAT ORIGINALLY APPEARED ON THIS DOCUMENT WAS AUTHORIZED BY: BRETT M. BRISLOW, P.E. ON: 03/13/2019. ALTERATION OF A SEALED DOCUMENT WITHOUT PROPER NOTIFICATION OF THE RESPONSIBLE ENGINEER IS AN OFFENSE UNDER THE TEXAS ENGINEERING PRACTICE ACT.
This Record Drawing is a combination of the sealed engineering contract drawings for this project, modified by information furnished by the contractor reflecting changes in the Project made during construction. The original sealed drawings are on file at the offices of:
FREESE AND NICHOLS, INC.
RECORD DRAWINGS PREPARED ON: 3/6/2019


CLAYCO
THE ART & SCIENCE OF BUILDING
2199 INNERBELT BUSINESS CENTER DRIVE
ST. LOUIS, MISSOURI 63114
Ph 314.429.1010 Fx 314.429.3137

ARCHITECT
FORUM
2199 INNERBELT BUSINESS CENTER DRIVE
ST. LOUIS, MISSOURI 63114
Ph 314.429.1010 Fx 314.429.7770
CONTRACTOR / DEVELOPER
CLAYCO
LANDSCAPE ARCHITECT
FORUM
CIVIL ENGINEER
FREESE & NICHOLS
STRUCTURAL ENGINEER
MECHANICAL ENGINEER
ELECTRICAL ENGINEER
PLUMBING ENGINEER
FIRE PROTECTION ENGINEER

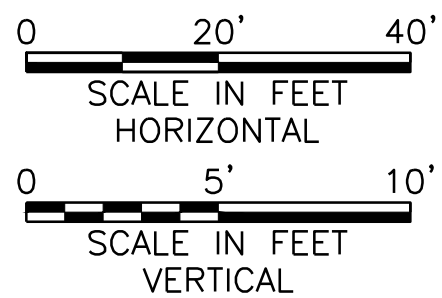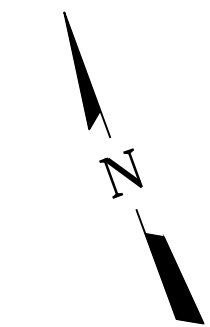

NOTES

- ALL RESPONSIBILITY FOR ADEQUACY OF DESIGN REMAINS WITH THE DESIGN ENGINEER. THE CITY OF ROCKWALL, IN REVIEWING AND RELEASING PLANS FOR CONSTRUCTION, ASSUMES NO RESPONSIBILITY FOR ADEQUACY OR ACCURACY OF DESIGN.
- REFER TO SHEET C04-15 FOR GROUTED RIP-RAP DETAIL.
- REFER TO SHEET C06-02 FOR TXDOT SETP-PD DETAIL.

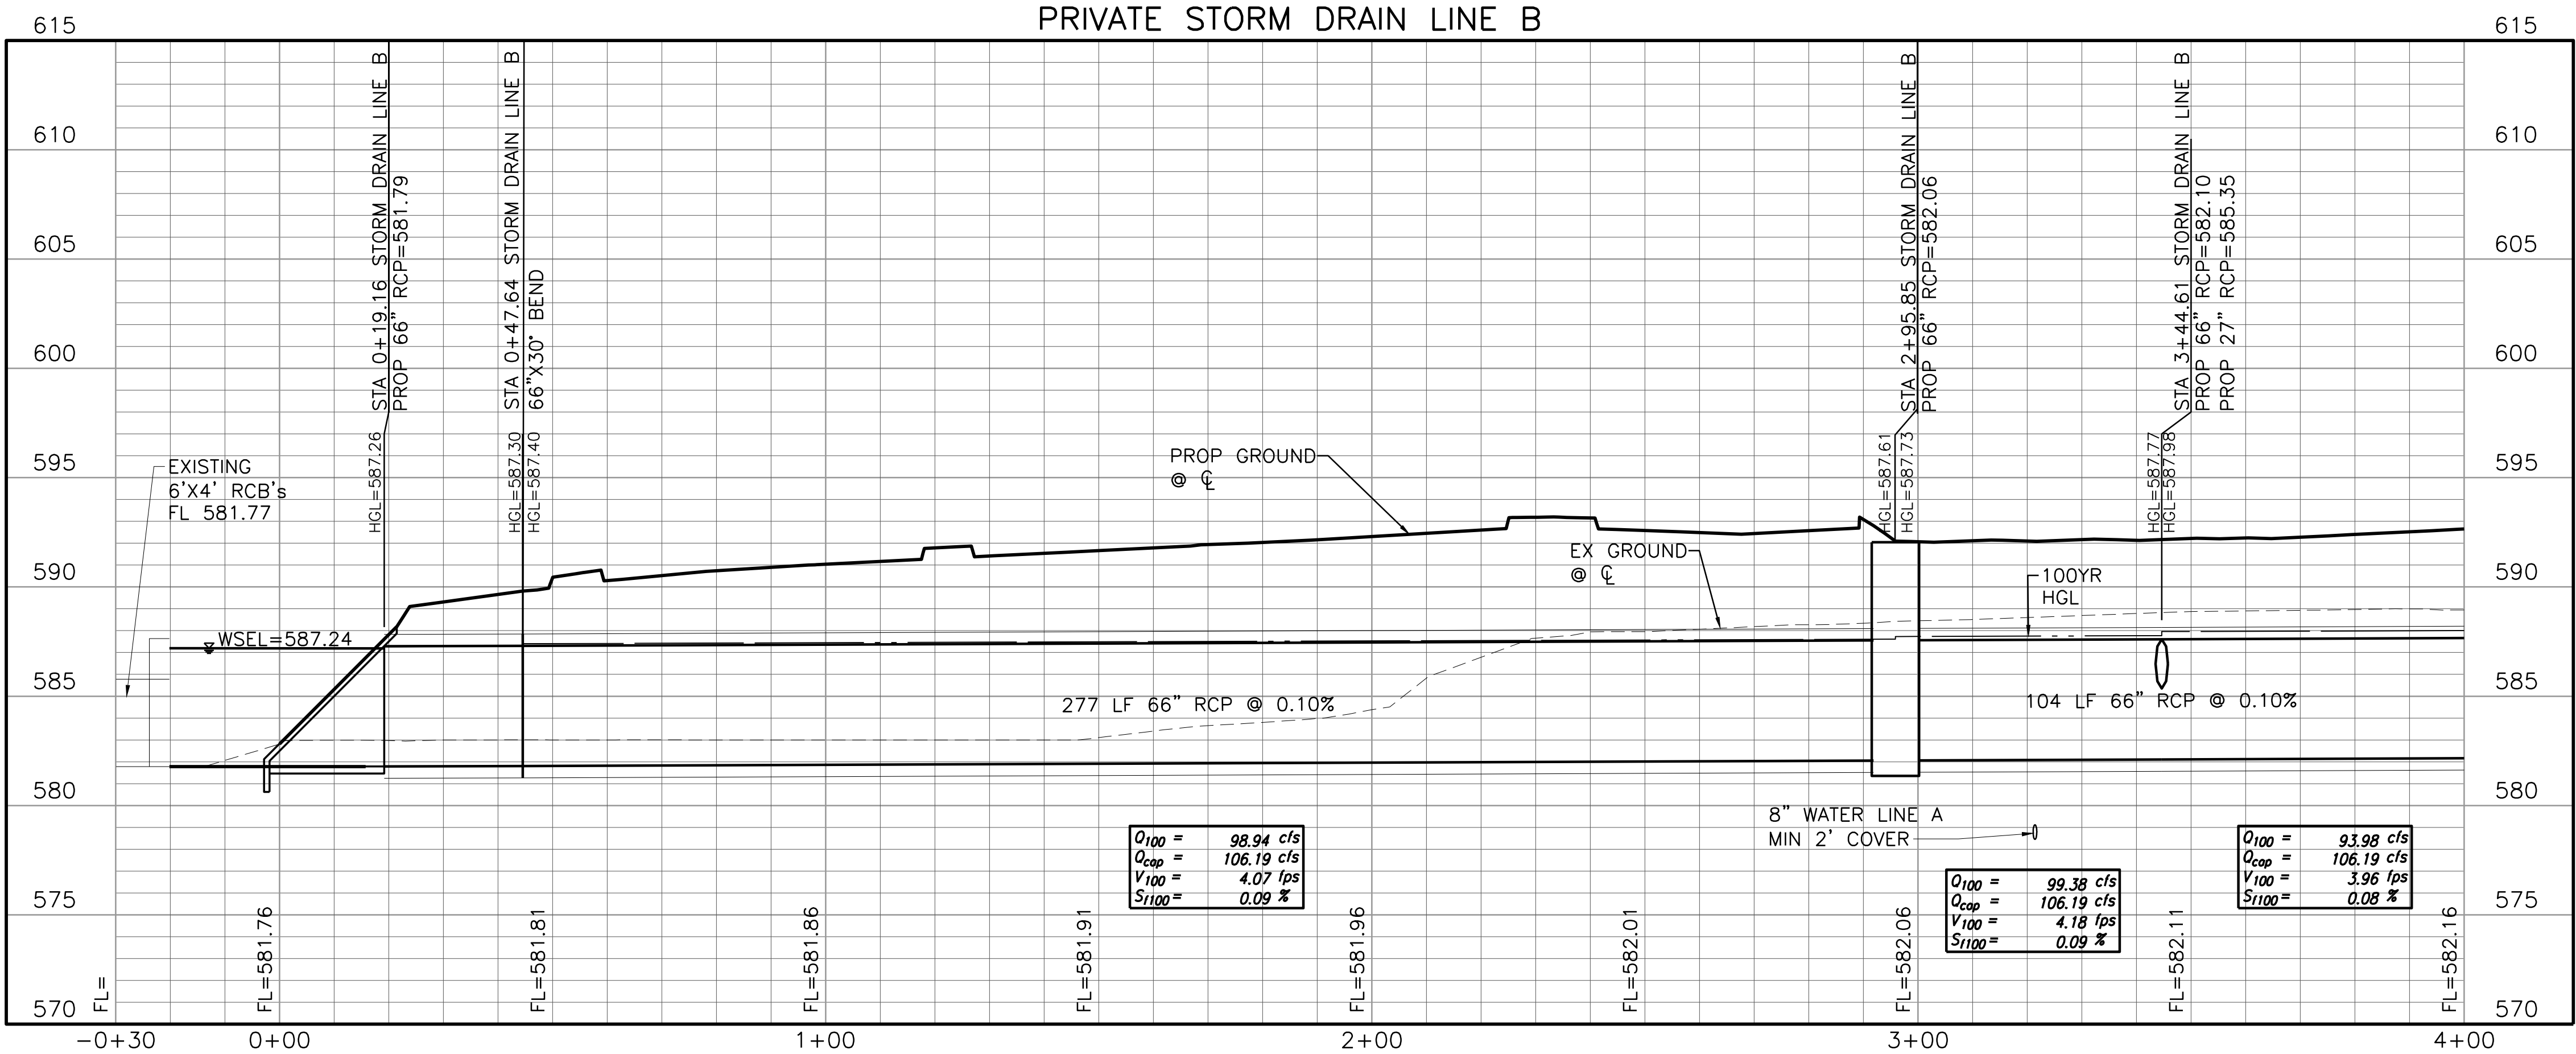

Lollicup
ROCKWALL TECHNOLOGY PARK
ROCKWALL, TEXAS

APPLICANT INFORMATION

BOB LEIMBERG
CLAYCO
2199 INNERBELT BUSINESS CENTER DR.
ST. LOUIS, MO 63114
314.592.2234 office
314.713.7874 mobile
leimberg@claycorp.com

OWNER INFORMATION


ALAN YU
LOLLICUP USA
6185 KIMBALL AVE.
CHINO, CA 91708
626.965.8882 x110 office
626.226.8556 mobile
alan.yu@lollicup.com

PROJECT NAME

LOLLICUP USA WAREHOUSE
CASE NUMBER:


DRAWING ISSUE	
DESCRIPTION	DATE
ENGINEERING SUBMITTAL	2/2/2018
CITY OF ROCKWALL	
ENGINEERING REVIEW	3/2/2018
2ND SUBMITTAL	
ENGINEERING REVIEW	3/23/2018
3RD SUBMITTAL	
ISSUED FOR CONSTRUCTION	4/10/2018
SD RFI'S	6/13/2018
RECORD DRAWING	3/6/2019
DRAWING TITLE	STORM DRAIN LINE B PLAN AND PROFILE
DRAWING NO.	C04-04

MATCH LINE STA 4+00

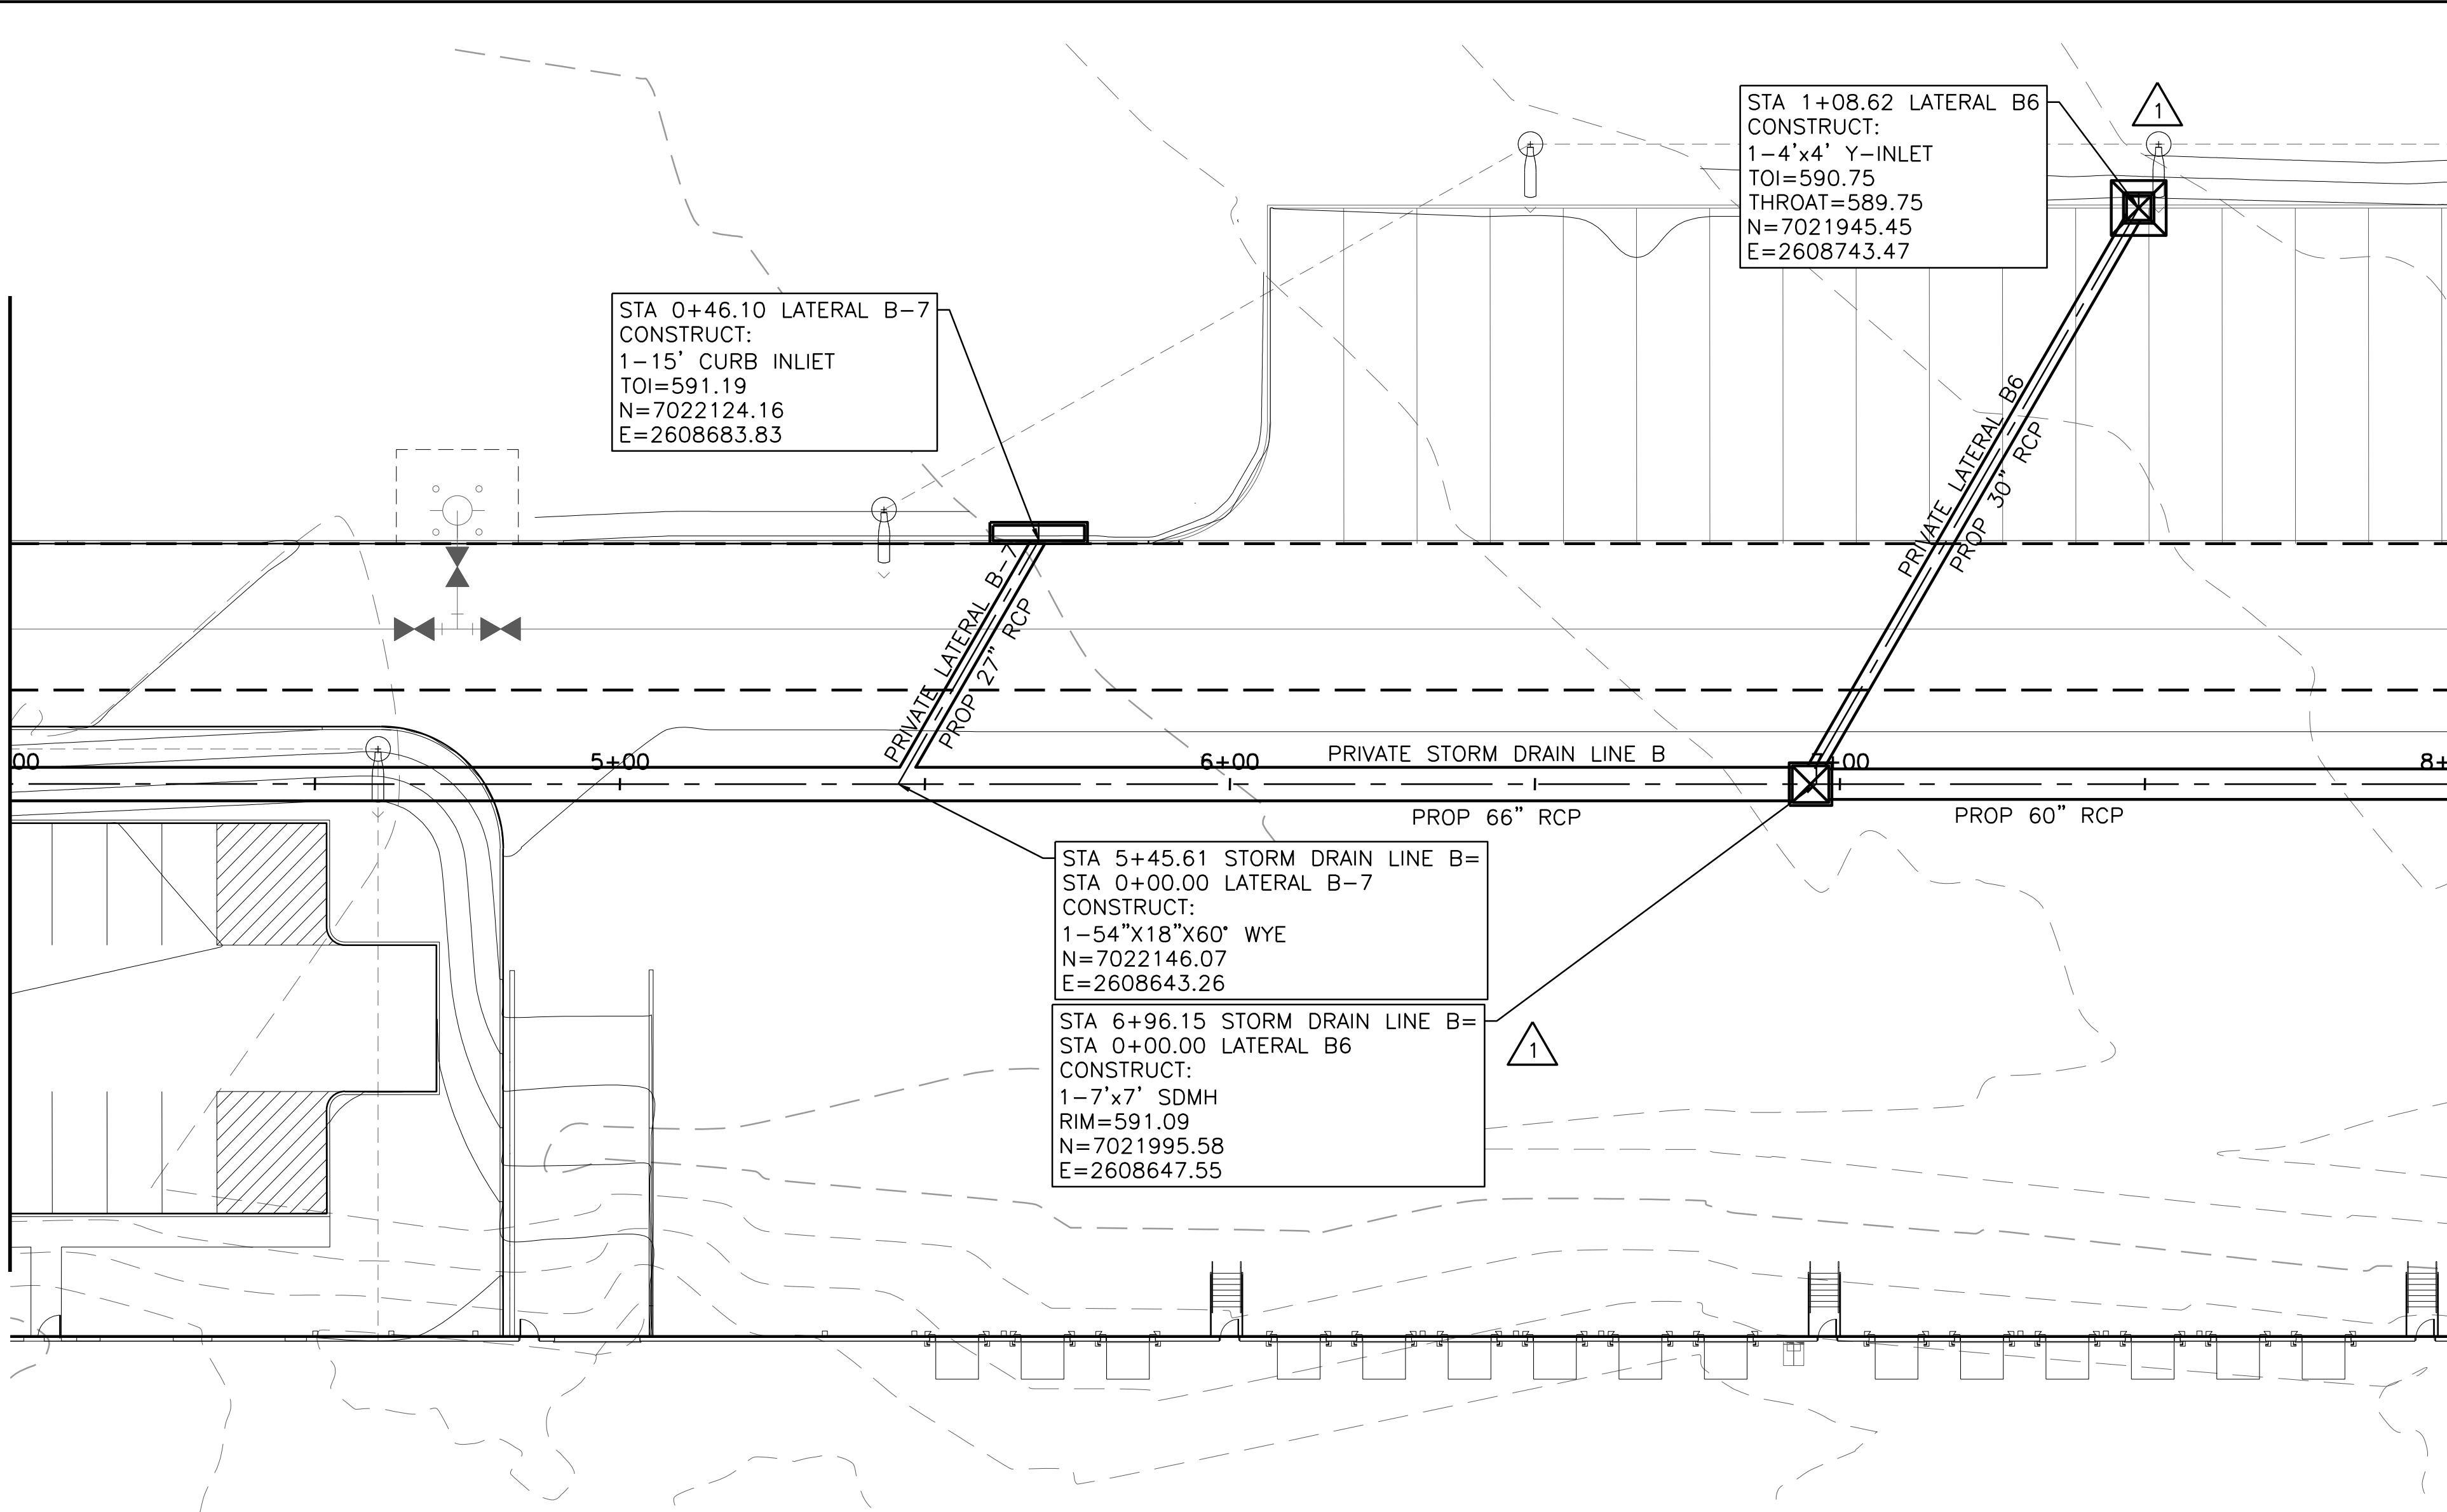

MATCH LINE STA 8+00

PRIVATE STORM DRAIN LINE B

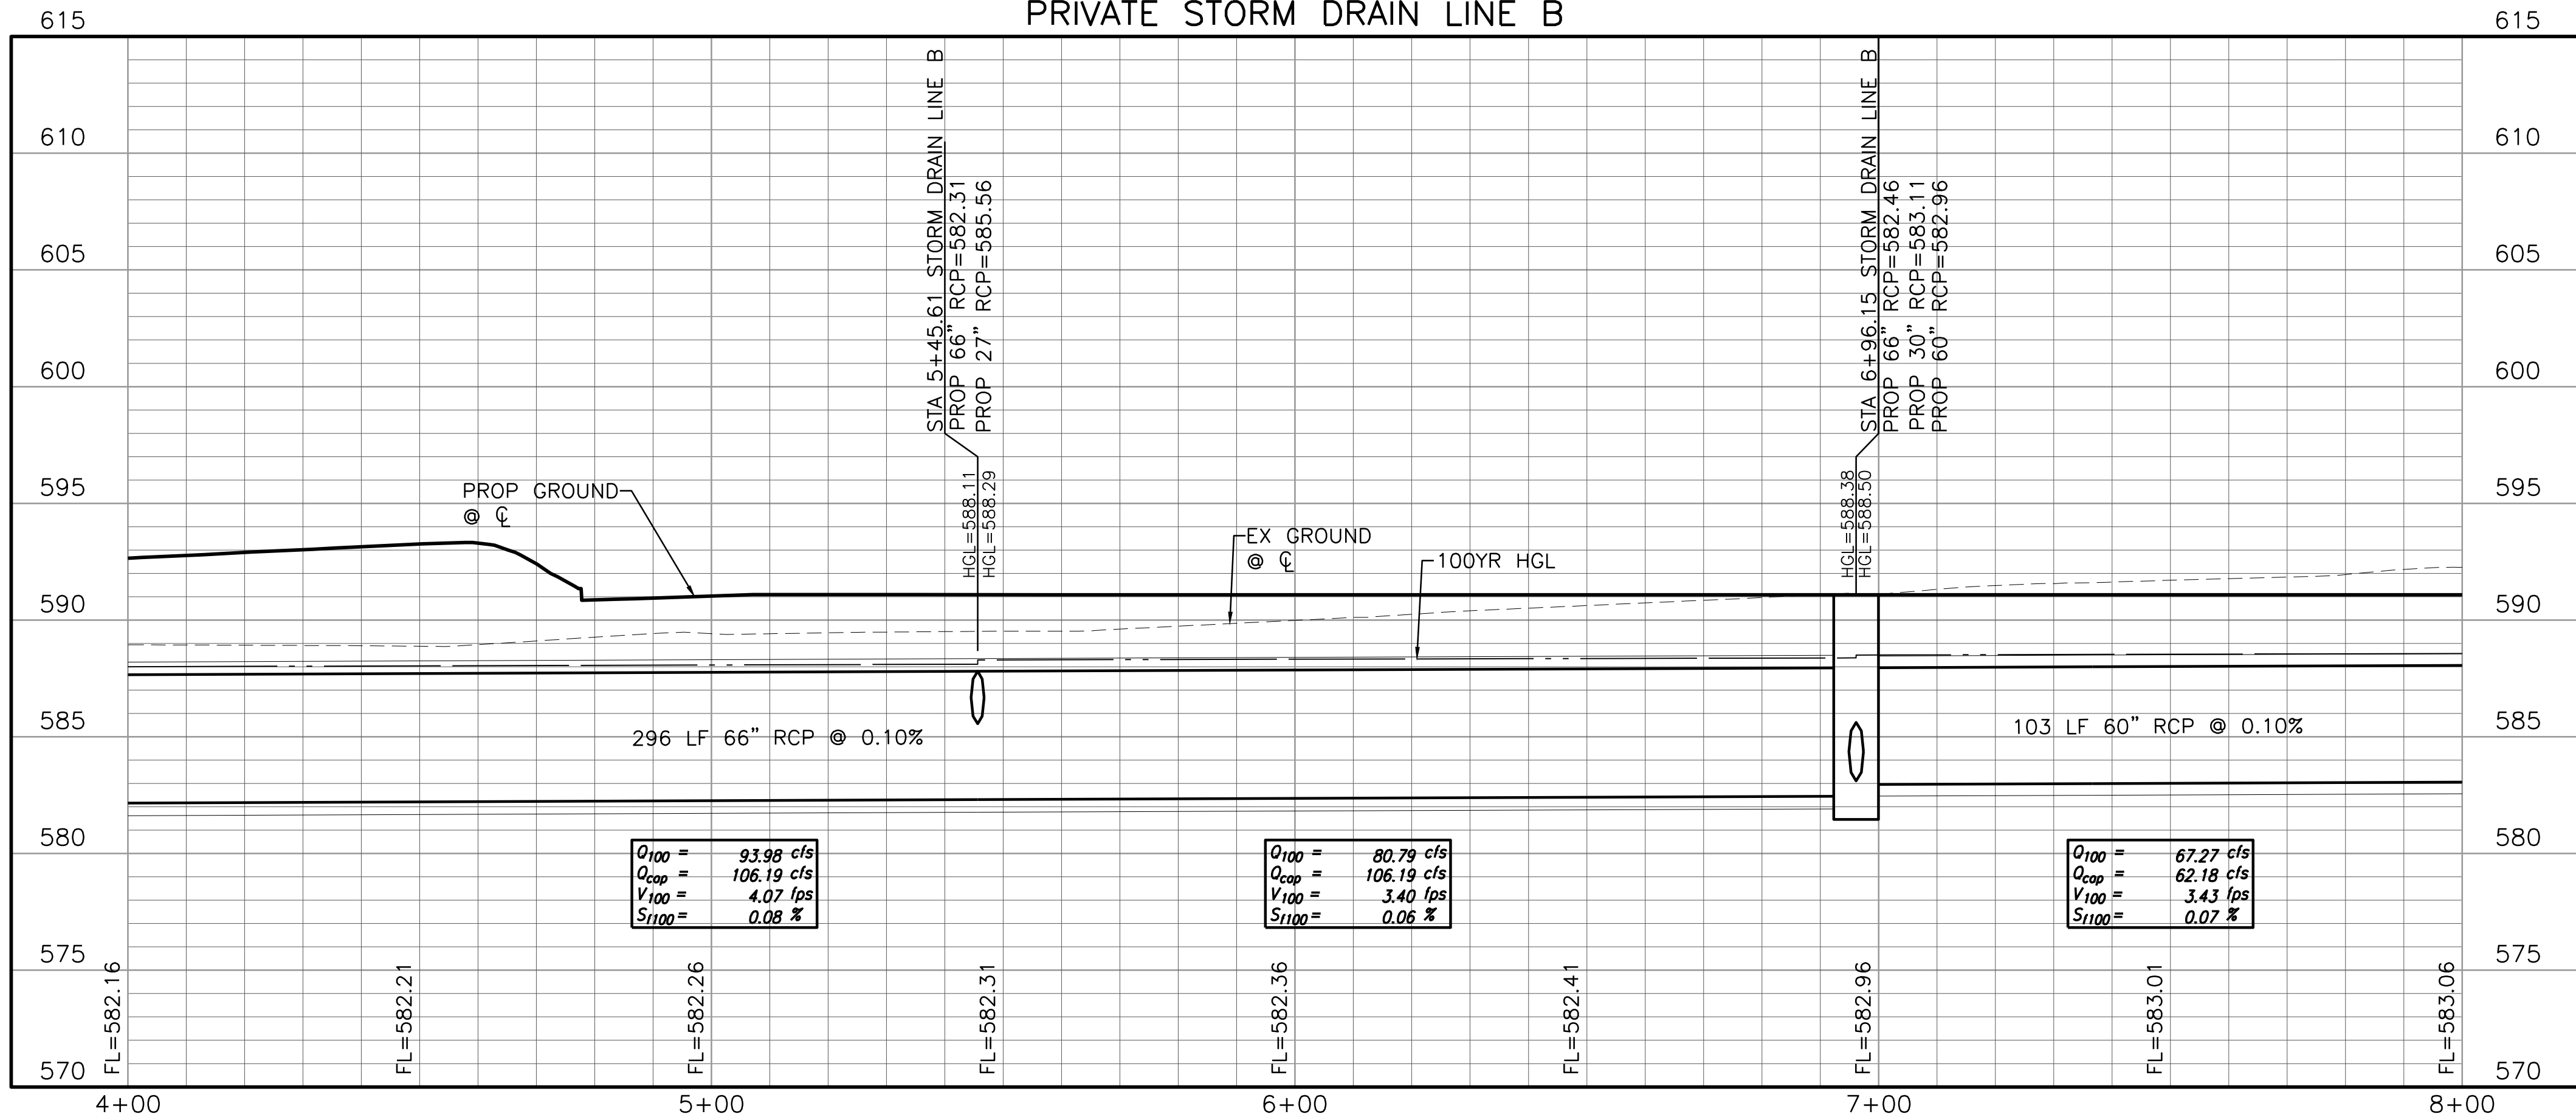


BENCHMARKS:
BENCHMARK A-AN "X" CUT IN THE CENTER OF THE SIDEWALK AT THE END OF THE HANDICAP RAMP AT THE SOUTHEAST CORNER OF THE INTERSECTION OF DISCOVERY BLVD. AND DATA DR., 11 FEET SOUTHEAST OF THE CURB LINE.
ELEV=600.44
BENCHMARK B-AN "X" CUT ON THE CURB ON THE NORTH SIDE OF DISCOVERY BLVD. 580 FEET EAST OF CORPORATE CROSSING, 11 FEET SOUTHEAST OF A FIRE HYDRANT, AND 19 FEET NORTHEAST OF TWO (2) WATER VALVES.
ELEV=599.67

THE SEAL THAT ORIGINALLY APPEARED ON THIS DOCUMENT WAS AUTHORIZED BY: BRIET M. BRISLOW, P.E.
TEXAS NO. 389200
DATE: 03/23/2018
ALTERNATION OF A SEALED DOCUMENT WITHOUT PROPER NOTIFICATION OF THE RESPONSIBLE ENGINEER IS AN OFFENSE UNDER THE TEXAS ENGINEERING PRACTICE ACT.
This Record Drawing is a combination of the sealed engineering contract drawings for this project, modified by information furnished by the contractor reflecting changes in the Project made during construction. The original sealed drawings are on file at the offices of:
FREESE AND NICHOLS, INC.
RECORD DRAWINGS PREPARED ON: 3/6/2019

CLAYCO
THE ART & SCIENCE OF BUILDING
2199 INNERBELT BUSINESS CENTER DRIVE
ST. LOUIS, MISSOURI 63114
Ph 314.429.5100 Fx 314.429.3137

ARCHITECT
FORUM
2199 INNERBELT BUSINESS CENTER DRIVE
ST. LOUIS, MISSOURI 63114
Ph 314.429.1010 Fx 314.429.7770
CONTRACTOR / DEVELOPER
CLAYCO
LANDSCAPE ARCHITECT
FORUM
CIVIL ENGINEER
FREESE & NICHOLS
STRUCTURAL ENGINEER
MECHANICAL ENGINEER
ELECTRICAL ENGINEER
PLUMBING ENGINEER
FIRE PROTECTION ENGINEER

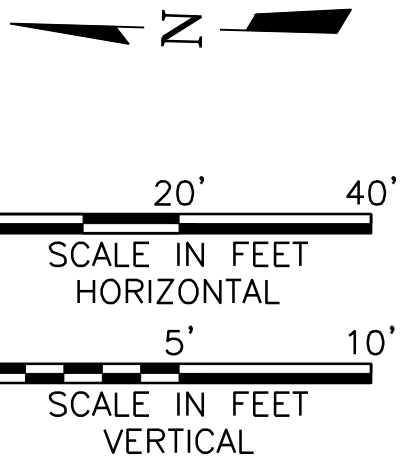


NOTES

- ALL RESPONSIBILITY FOR ADEQUACY OF DESIGN REMAINS WITH THE DESIGN ENGINEER. THE CITY OF ROCKWALL, IN REVIEWING AND RELEASING PLANS FOR CONSTRUCTION, ASSUMES NO RESPONSIBILITY FOR ADEQUACY OR ACCURACY OF DESIGN.

Lollicup
ROCKWALL TECHNOLOGY PARK
ROCKWALL, TEXAS


APPLICANT INFORMATION		DESCRIPTION	DATE
BOB LEIMBERG CLAYCO 2199 INNERBELT BUSINESS CENTER DR. ST. LOUIS, MO 63114 314.592.2234 office 314.713.7874 mobile leimbergb@claycorp.com		ENGINEERING SUBMITTAL	2/2/2018
		CITY OF ROCKWALL	
		ENGINEERING REVIEW	3/2/2018
		2ND SUBMITTAL	
		ENGINEERING REVIEW	3/23/2018
		3RD SUBMITTAL	
OWNED INFORMATION		ISSUED FOR CONSTRUCTION	4/10/2018
		SD RFI'S	6/13/2018
		RECORD DRAWING	3/6/2019
		DRAWING TITLE	STORM DRAIN LINE B PLAN AND PROFILE
		DRAWING NO.	C04-05
PROJECT NAME		LOLLICUP USA WAREHOUSE	
CASE NUMBER:		601-03049	101-03049

MATCH LINE STA 8+00

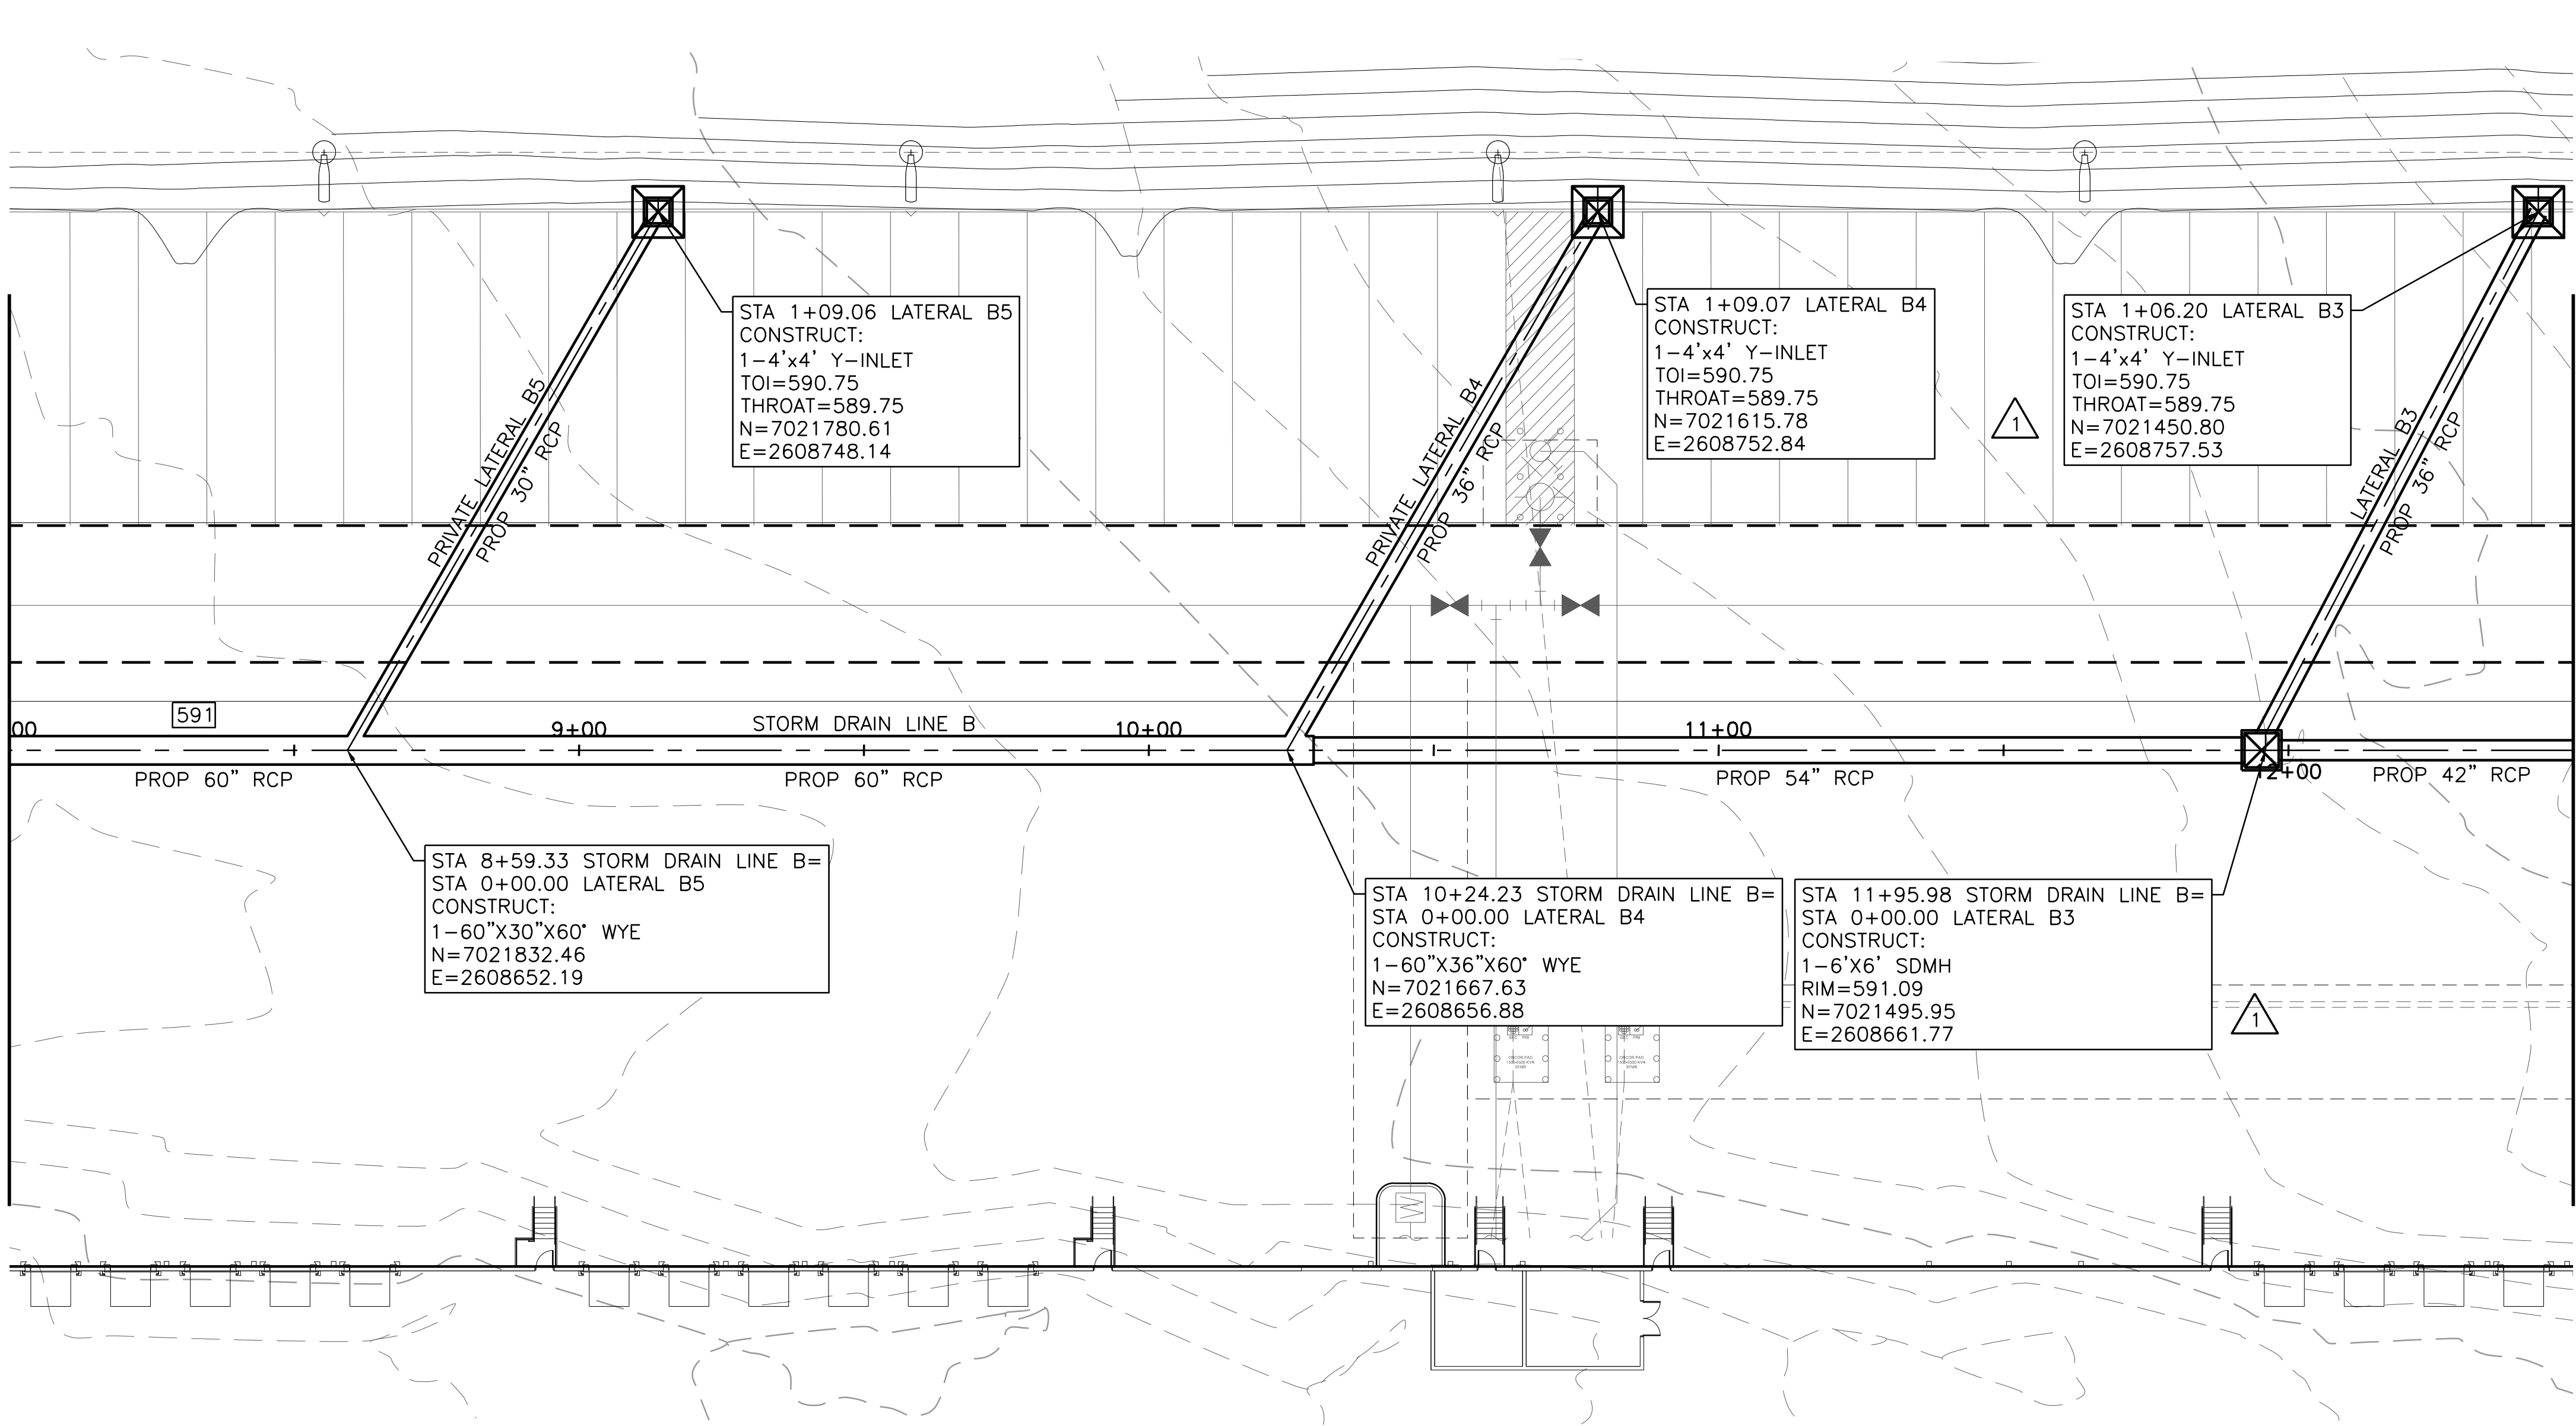

MATCH LINE STA 12+50

PRIVATE STORM DRAIN LINE B

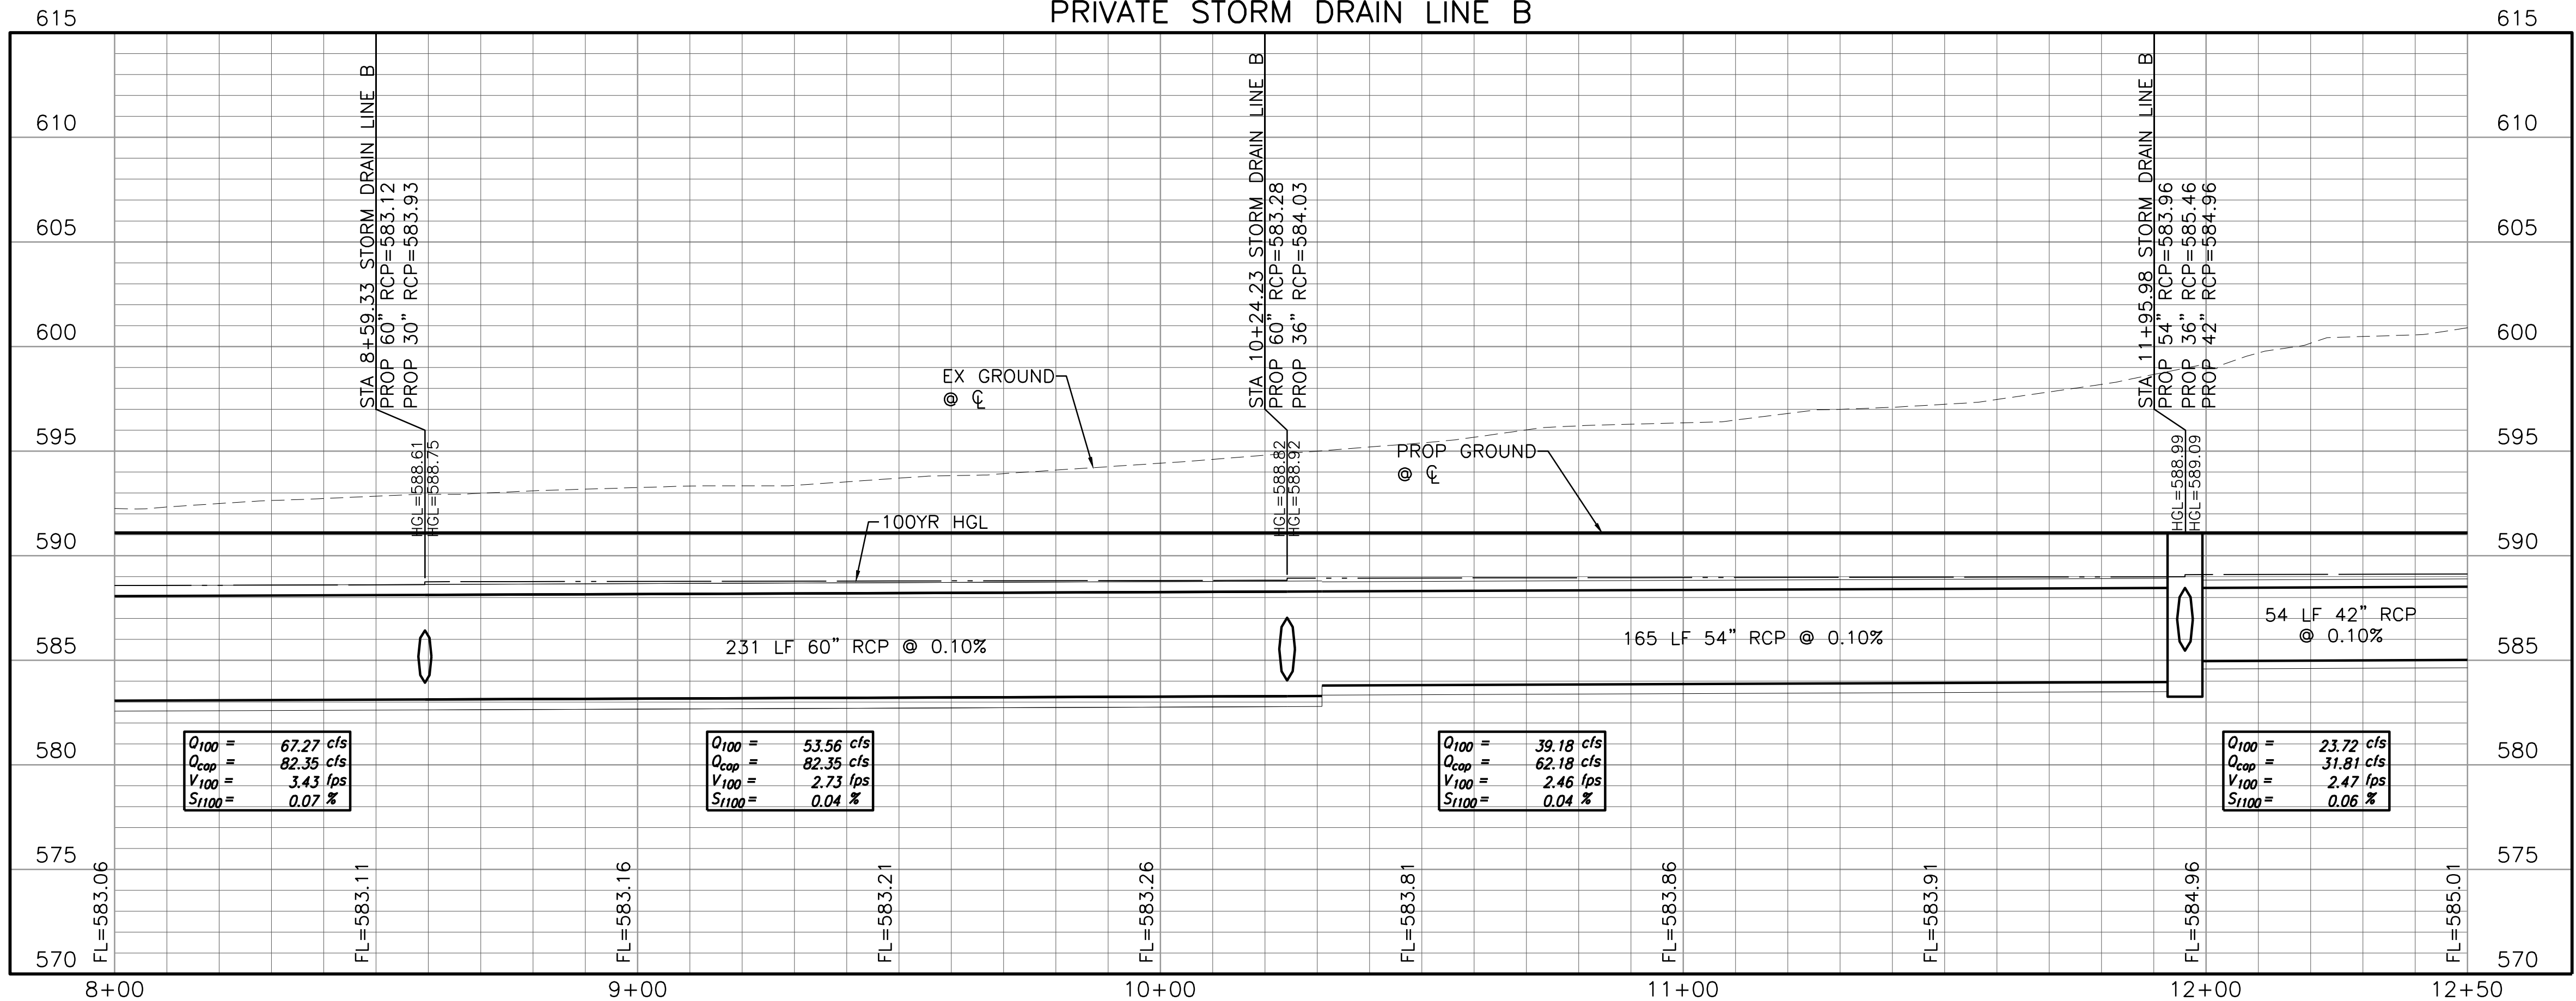

BENCHMARKS:

BENCHMARK A-AN "X" CUT IN THE CENTER OF THE SIDEWALK AT THE END OF THE HANDICAP RAMP AT THE SOUTHEAST CORNER OF THE INTERSECTION OF DISCOVERY BLVD. AND DATA DR. 11 FEET SOUTHEAST OF THE CURB LINE. ELEV=600.44

BENCHMARK B-AN "X" CUT ON THE CURB ON THE NORTH SIDE OF DISCOVERY BLVD. 580 FEET EAST OF CORPORATE CROSSING, 11 FEET SOUTHEAST OF A FIRE HYDRANT, AND 19 FEET NORTHEAST OF TWO (2) WATER VALVES. ELEV=599.67

THE SEAL THAT ORIGINALLY APPEARED ON THIS DOCUMENT WAS AUTHORIZED BY: BRIET M. BRISLOW, P.E. TEXAS NO. 100000 EXP. 03/31/2018 ALTERNATION OF A SEALED DOCUMENT WITHOUT PROPER NOTIFICATION OF THE RESPONSIBLE ENGINEER IS AN OFFENSE UNDER THE TEXAS ENGINEERING PRACTICE ACT.

This Record Drawing is a combination of the sealed engineering contract drawings for this project, modified by information furnished by the contractor reflecting changes in the Project made during construction. The original sealed drawings are on file at the offices of:

FREESE AND NICHOLS, INC.
RECORD DRAWINGS PREPARED ON: 3/6/2019

CLAYCO
THE ART & SCIENCE OF BUILDING
2199 INNERBELT BUSINESS CENTER DRIVE
ST. LOUIS, MISSOURI 63114
Ph 314.429.5100 Fx 314.429.3137

ARCHITECT
FORUM
2199 INNERBELT BUSINESS CENTER DRIVE
ST. LOUIS, MISSOURI 63114
Ph 314.429.1010 Fx 314.429.7770

CONTRACTOR / DEVELOPER
CLAYCO

LANDSCAPE ARCHITECT
FORUM

CIVIL ENGINEER
FREESE & NICHOLS

STRUCTURAL ENGINEER

MECHANICAL ENGINEER

ELECTRICAL ENGINEER

PLUMBING ENGINEER

FIRE PROTECTION ENGINEER



0 20' 40'
SCALE IN FEET
HORIZONTAL

0 5' 10'
SCALE IN FEET
VERTICAL

NOTES

- ALL RESPONSIBILITY FOR ADEQUACY OF DESIGN REMAINS WITH THE DESIGN ENGINEER. THE CITY OF ROCKWALL, IN REVIEWING AND RELEASING PLANS FOR CONSTRUCTION, ASSUMES NO RESPONSIBILITY FOR ADEQUACY OR ACCURACY OF DESIGN.

Lollicup
ROCKWALL TECHNOLOGY PARK
ROCKWALL, TEXAS

APPLICANT INFORMATION

BOB LEIMBERG
CLAYCO
2199 INNERBELT BUSINESS CENTER DR.
ST. LOUIS, MO 63114
314.592.2234 office
314.713.7874 mobile
leimbergb@claycorp.com

OWNER INFORMATION

ALAN YU
LOLLICUP USA
6185 KIMBALL AVE.
CHINO, CA 91708
626.965.8882 x110 office
626.226.8556 mobile
alan.yu@lollicup.com


PROJECT NAME

LOLLICUP USA WAREHOUSE
CASE NUMBER:

DRAWING ISSUE


DESCRIPTION	DATE
ENGINEERING SUBMITTAL CITY OF ROCKWALL	2/2/2018
ENGINEERING REVIEW 2ND SUBMITTAL	3/2/2018
ENGINEERING REVIEW 3RD SUBMITTAL	3/23/2018
ISSUED FOR CONSTRUCTION	4/10/2018
SD RFI'S	6/13/2018
RECORD DRAWING	3/6/2019
DRAWING TITLE STORM DRAIN LINE B PLAN AND PROFILE	
DRAWING NO.	C04-06
Forum #	601-03049
Consult #	101-03049

MATCH LINE STA 12+00

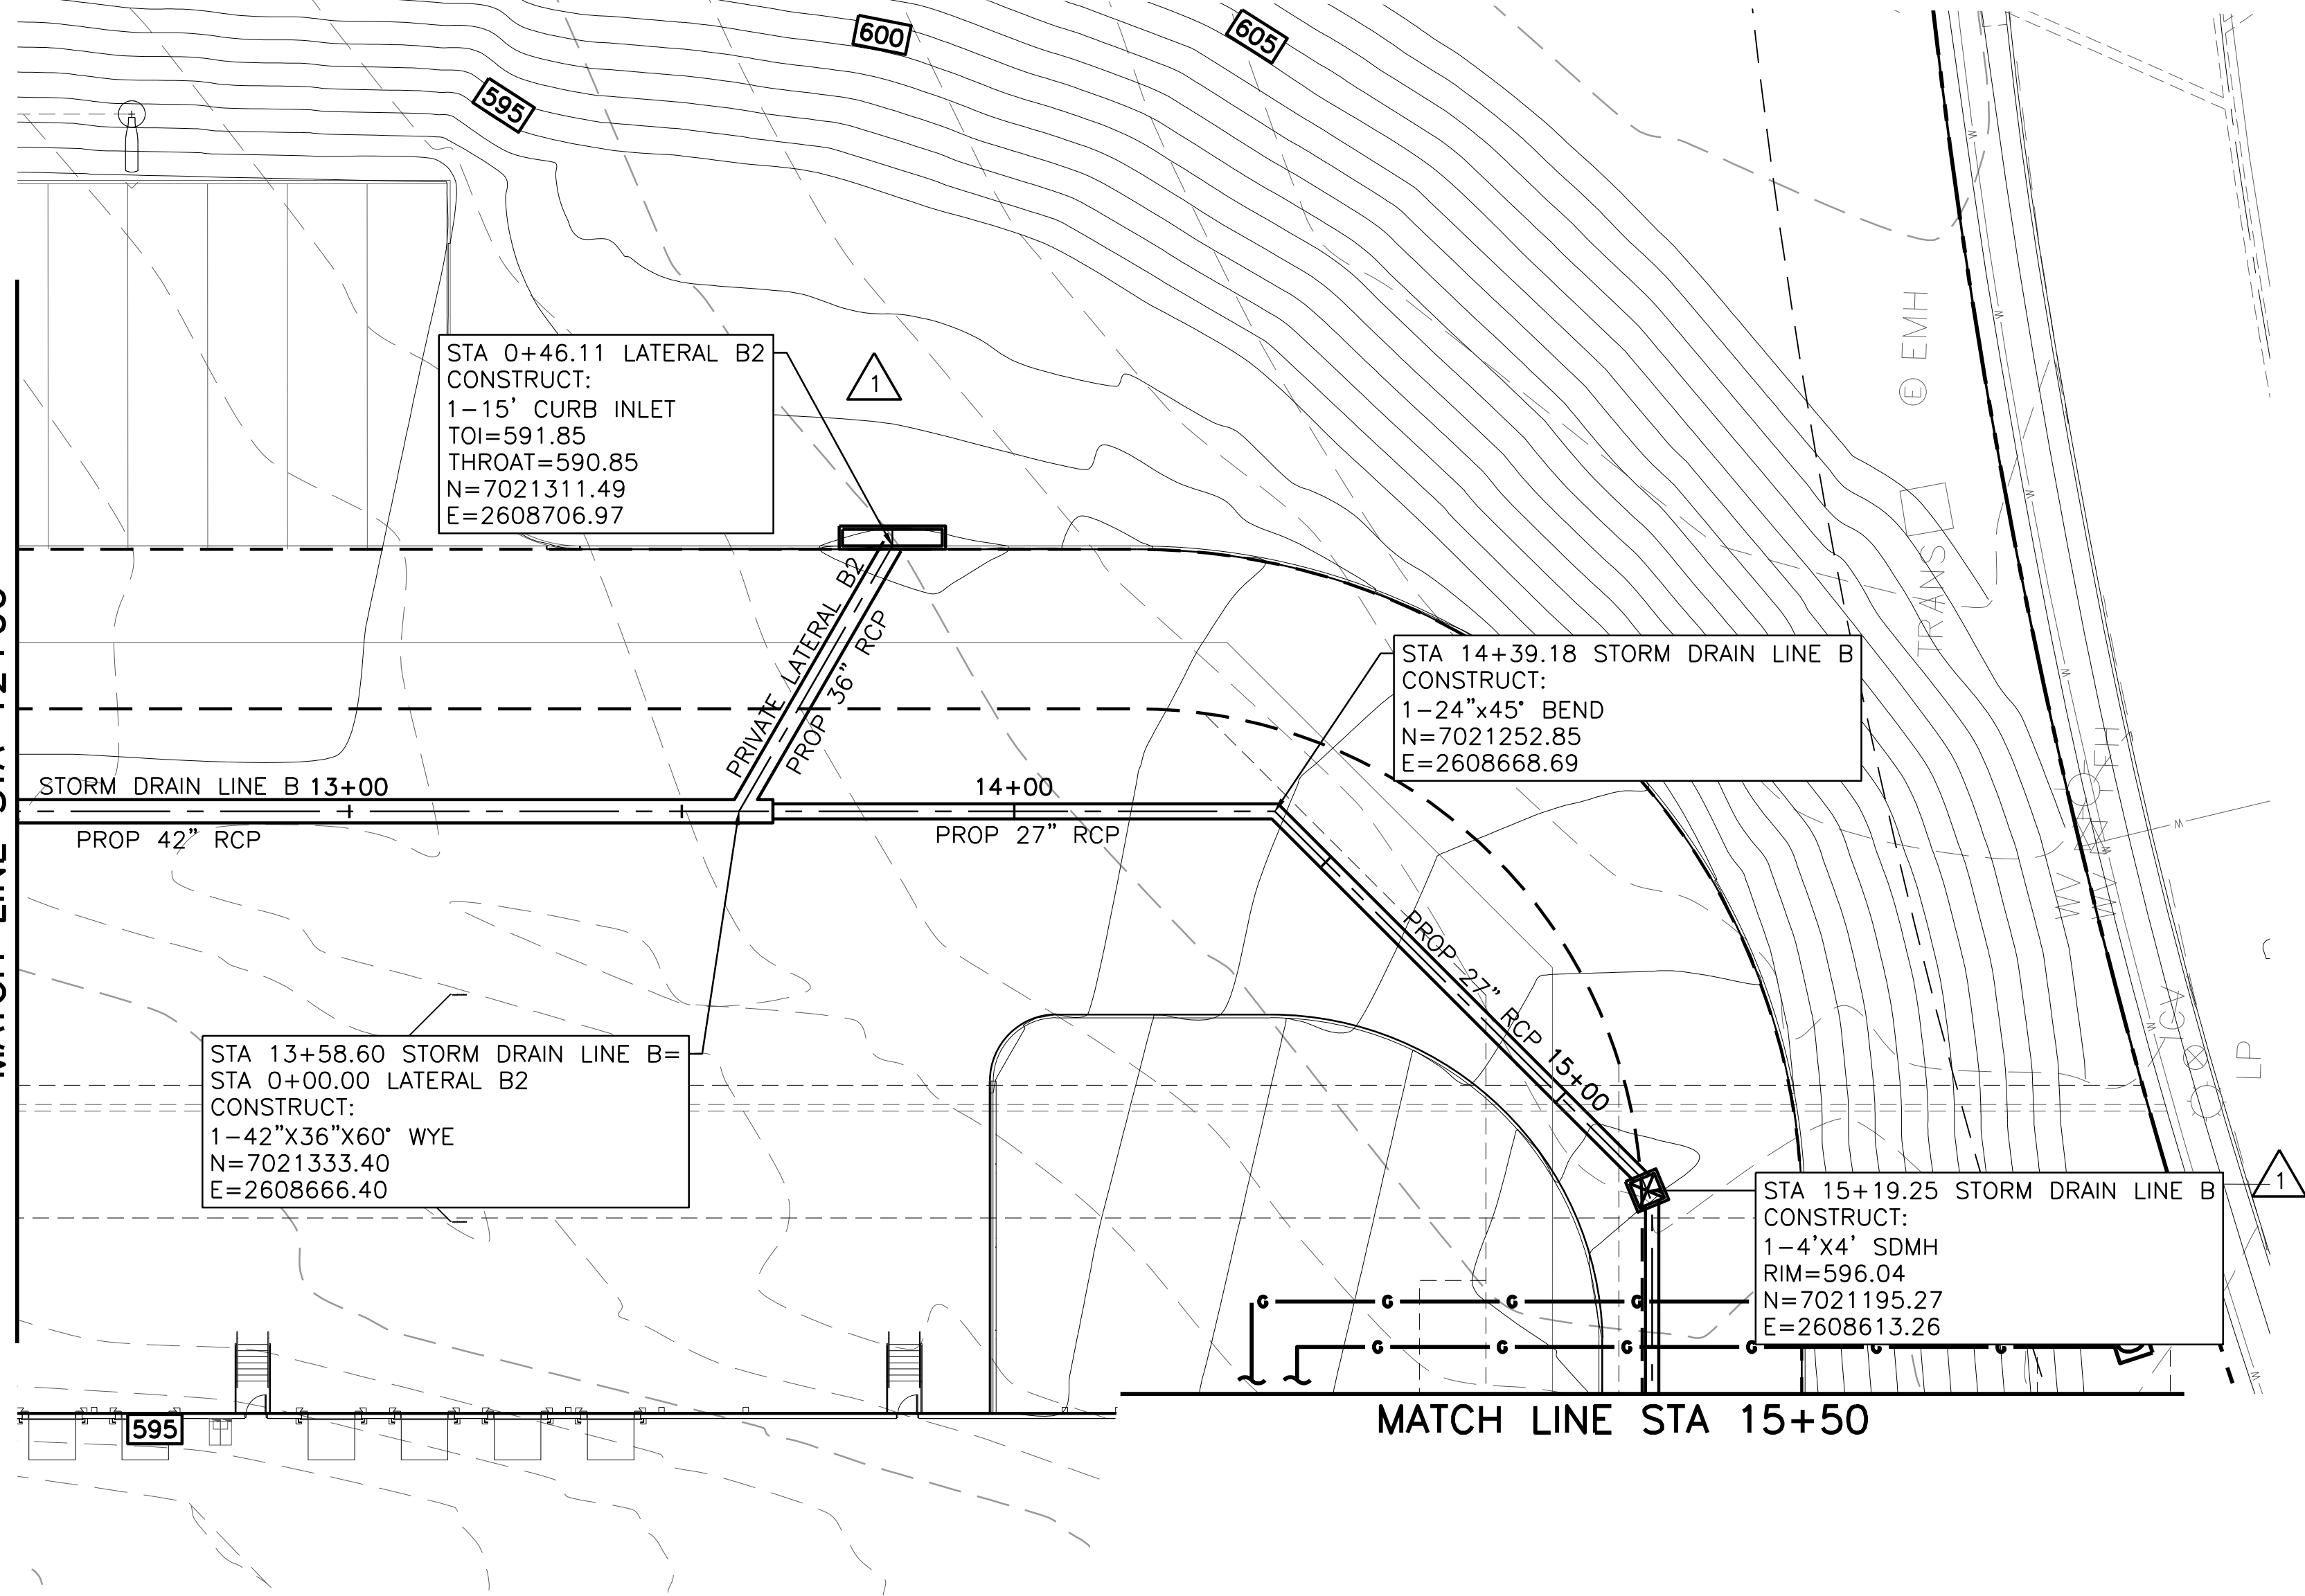

MATCH LINE STA 15+50

PRIVATE STORM DRAIN LINE B

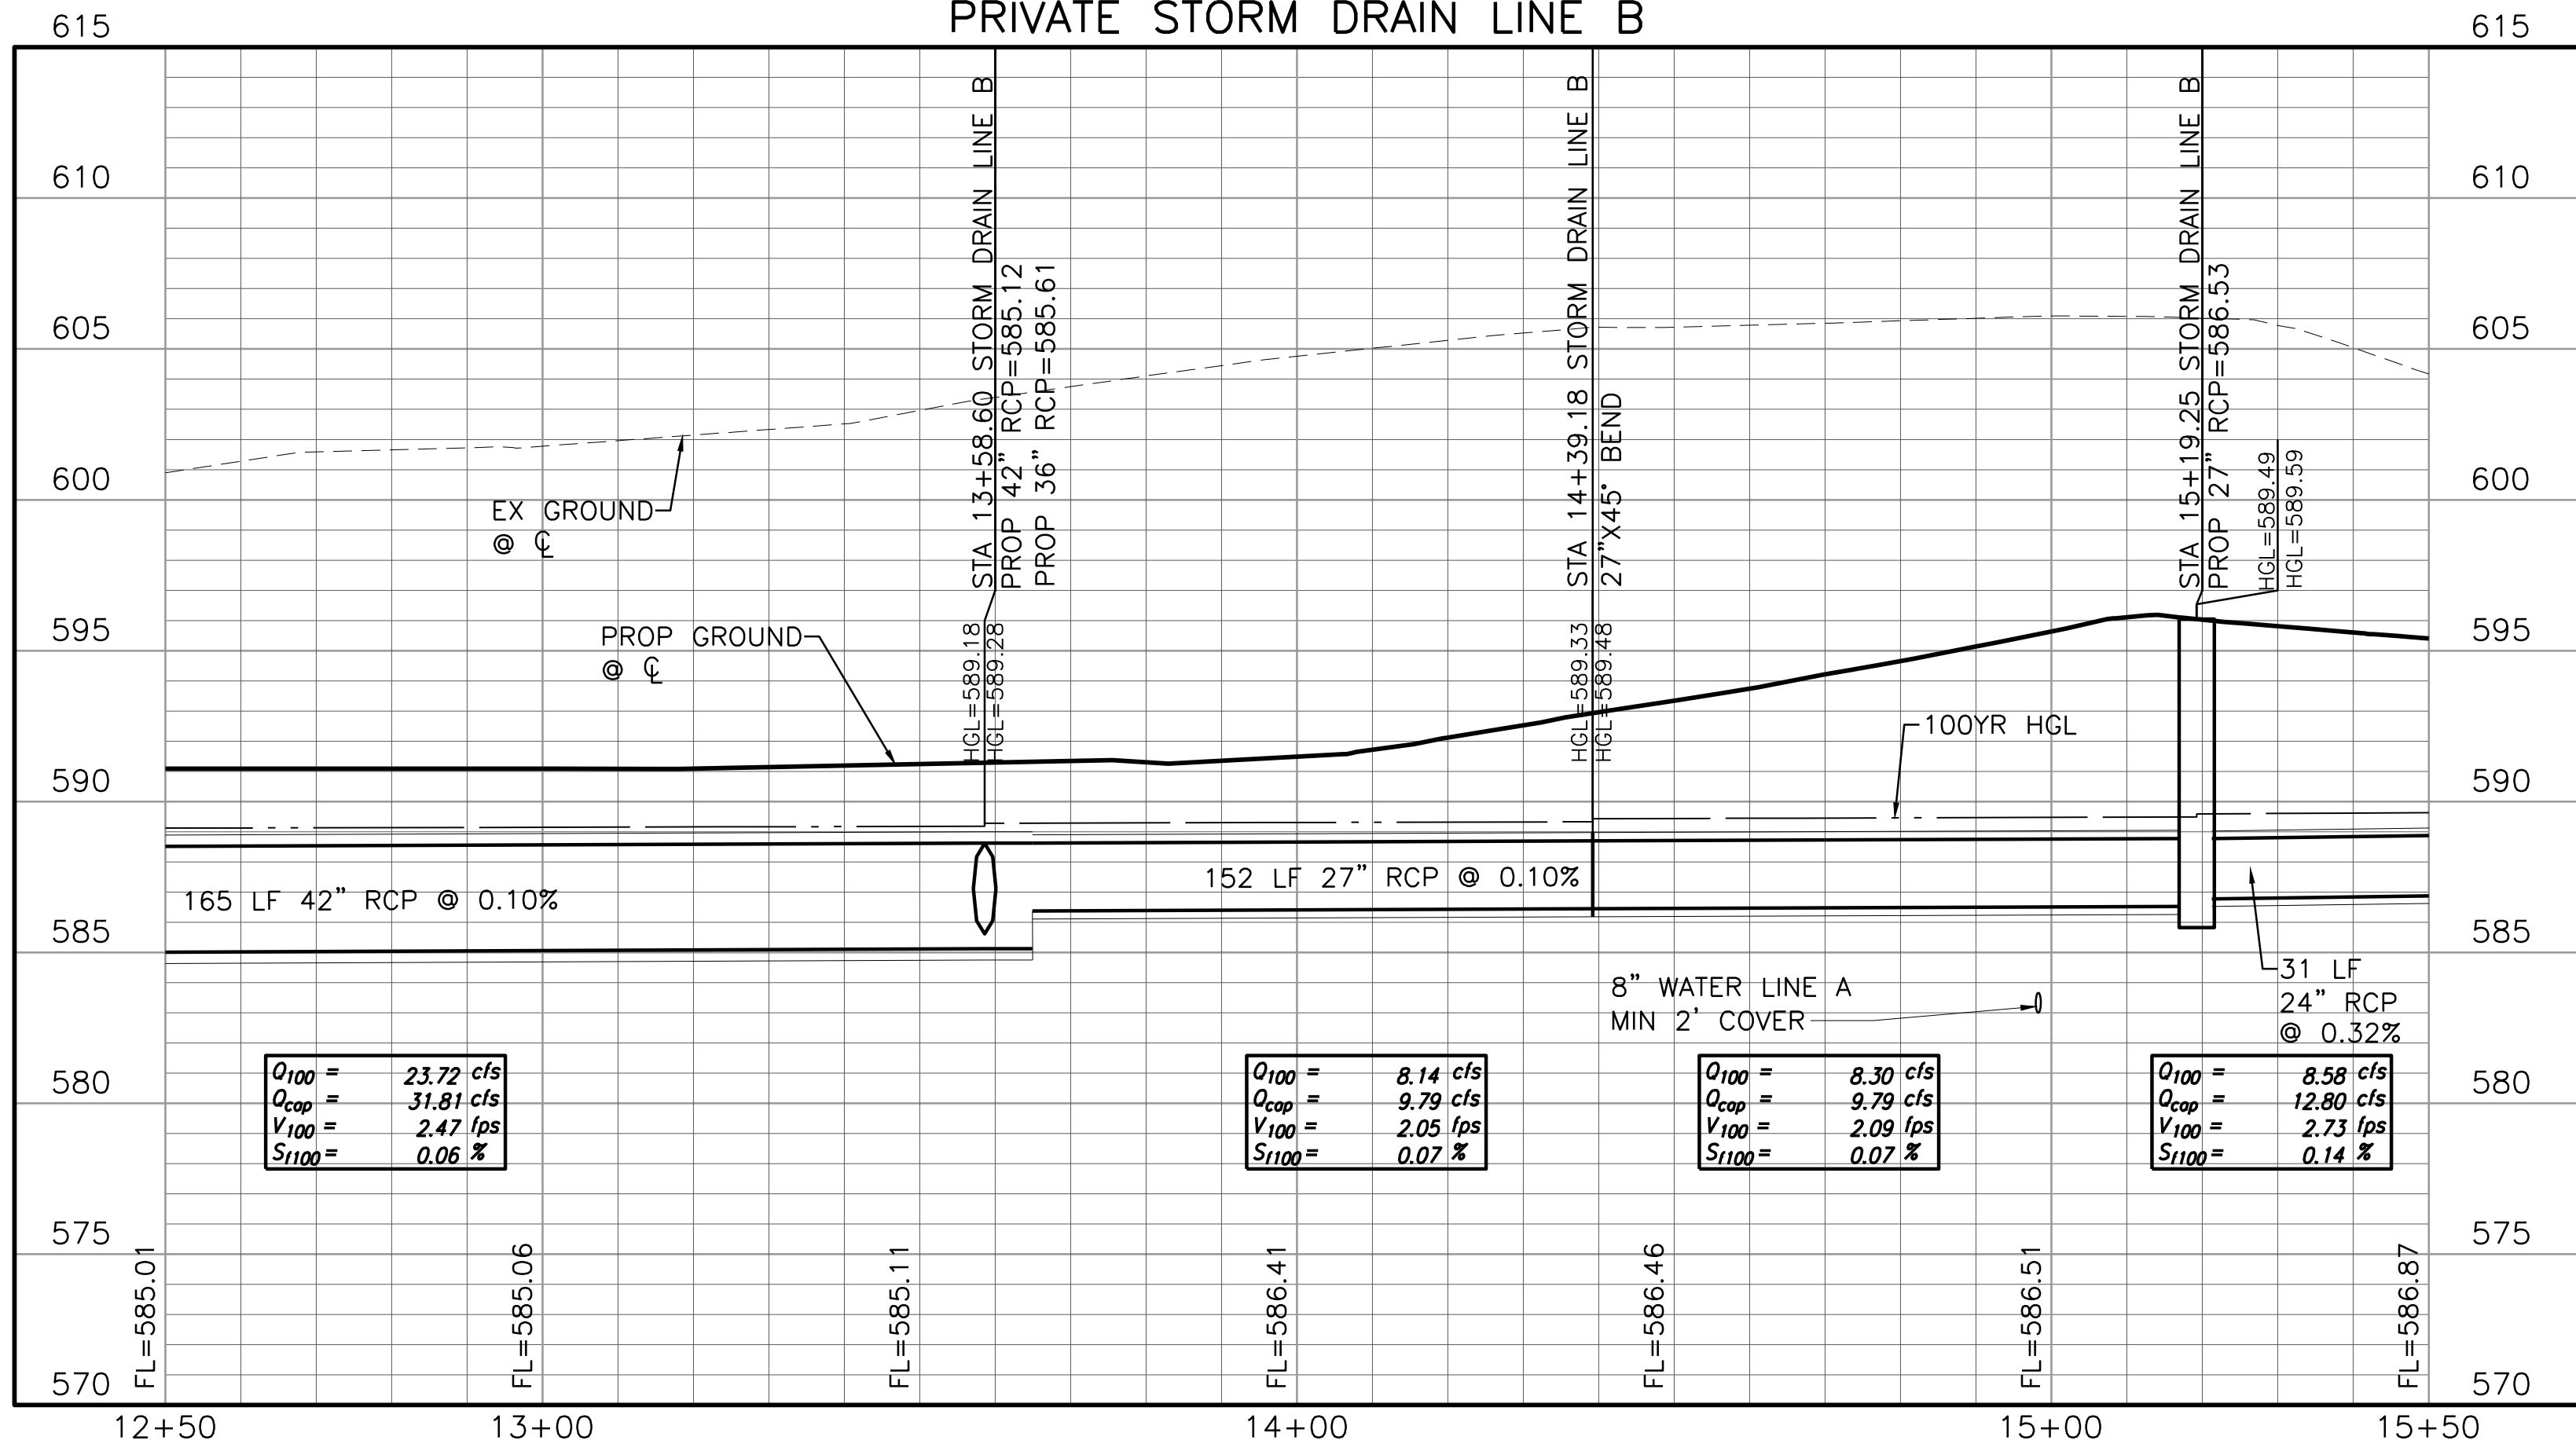

BENCHMARKS:

BENCHMARK A-AN "X" CUT IN THE CENTER OF THE SIDEWALK AT THE END OF THE HANDICAP RAMP AT THE SOUTHEAST CORNER OF THE INTERSECTION OF DISCOVERY BLVD. AND DATA DR., 11 FEET SOUTHEAST OF THE CURB LINE. ELEV=600.44

BENCHMARK B-AN "X" CUT ON THE CURB ON THE NORTH SIDE OF DISCOVERY BLVD. 580 FEET EAST OF CORPORATE CROSSING, 11 FEET SOUTHEAST OF A FIRE HYDRANT, AND 19 FEET NORTHEAST OF TWO (2) WATER VALVES. ELEV=599.67

THE SEAL THAT ORIGINALLY APPEARED ON THIS DOCUMENT WAS AUTHORIZED BY: BRIET M. BRISLOW, P.E. TEXAS NO. 101000 ON 12/13/2016. ALTERATION OF A SEALED DOCUMENT WITHOUT PROPER NOTIFICATION OF THE RESPONSIBLE ENGINEER IS AN OFFENSE UNDER THE TEXAS ENGINEERING PRACTICE ACT.

This Record Drawing is a combination of the sealed engineering contract drawings for this project, modified by information furnished by the contractor reflecting changes in the Project made during construction. The original sealed drawings are on file at the offices of:

FREESE AND NICHOLS, INC.
RECORD DRAWINGS PREPARED ON: 3/6/2019

CLAYCO
THE ART & SCIENCE OF BUILDING
2199 INNERBELT BUSINESS CENTER DRIVE
ST. LOUIS, MISSOURI 63114
Ph 314.429.5100 Fx 314.429.3137

ARCHITECT
FORUM
2199 INNERBELT BUSINESS CENTER DRIVE
ST. LOUIS, MISSOURI 63114
Ph 314.429.1010 Fx 314.429.7770

CONTRACTOR / DEVELOPER
CLAYCO

LANDSCAPE ARCHITECT
FORUM

CIVIL ENGINEER
FREESE & NICHOLS

STRUCTURAL ENGINEER

MECHANICAL ENGINEER

ELECTRICAL ENGINEER

PLUMBING ENGINEER

FIRE PROTECTION ENGINEER



0 20' 40'
SCALE IN FEET
HORIZONTAL

0 5' 10'
SCALE IN FEET
VERTICAL

NOTES

- ALL RESPONSIBILITY FOR ADEQUACY OF DESIGN REMAINS WITH THE DESIGN ENGINEER. THE CITY OF ROCKWALL, IN REVIEWING AND RELEASING PLANS FOR CONSTRUCTION, ASSUMES NO RESPONSIBILITY FOR ADEQUACY OR ACCURACY OF DESIGN.

Lollicup
ROCKWALL TECHNOLOGY PARK
ROCKWALL, TEXAS

APPLICANT INFORMATION

BOB LEIMBERG
CLAYCO
2199 INNERBELT BUSINESS CENTER DR.
ST. LOUIS, MO 63114
314.592.2234 office
314.713.7874 mobile
leimbergb@claycorp.com

OWNER INFORMATION



ALAN YU
LOLLICUP USA
6185 KIMBALL AVE.
CHINO, CA 91708
626.965.8882 x110 office
626.226.8556 mobile
alan.yu@lollicup.com

PROJECT NAME

LOLLICUP USA WAREHOUSE
CASE NUMBER:

DRAWING ISSUE

DESCRIPTION	DATE
ENGINEERING SUBMITTAL CITY OF ROCKWALL	2/2/2018
ENGINEERING REVIEW 2ND SUBMITTAL	3/2/2018
ENGINEERING REVIEW 3RD SUBMITTAL	3/23/2018
ISSUED FOR CONSTRUCTION	4/10/2018
SD RFI'S	6/13/2018
RECORD DRAWING	3/6/2019
DRAWING TITLE STORM DRAIN LINE B PLAN AND PROFILE	
DRAWING NO.	C04-07
Forum #	601-03049
Consult.#	101-03049

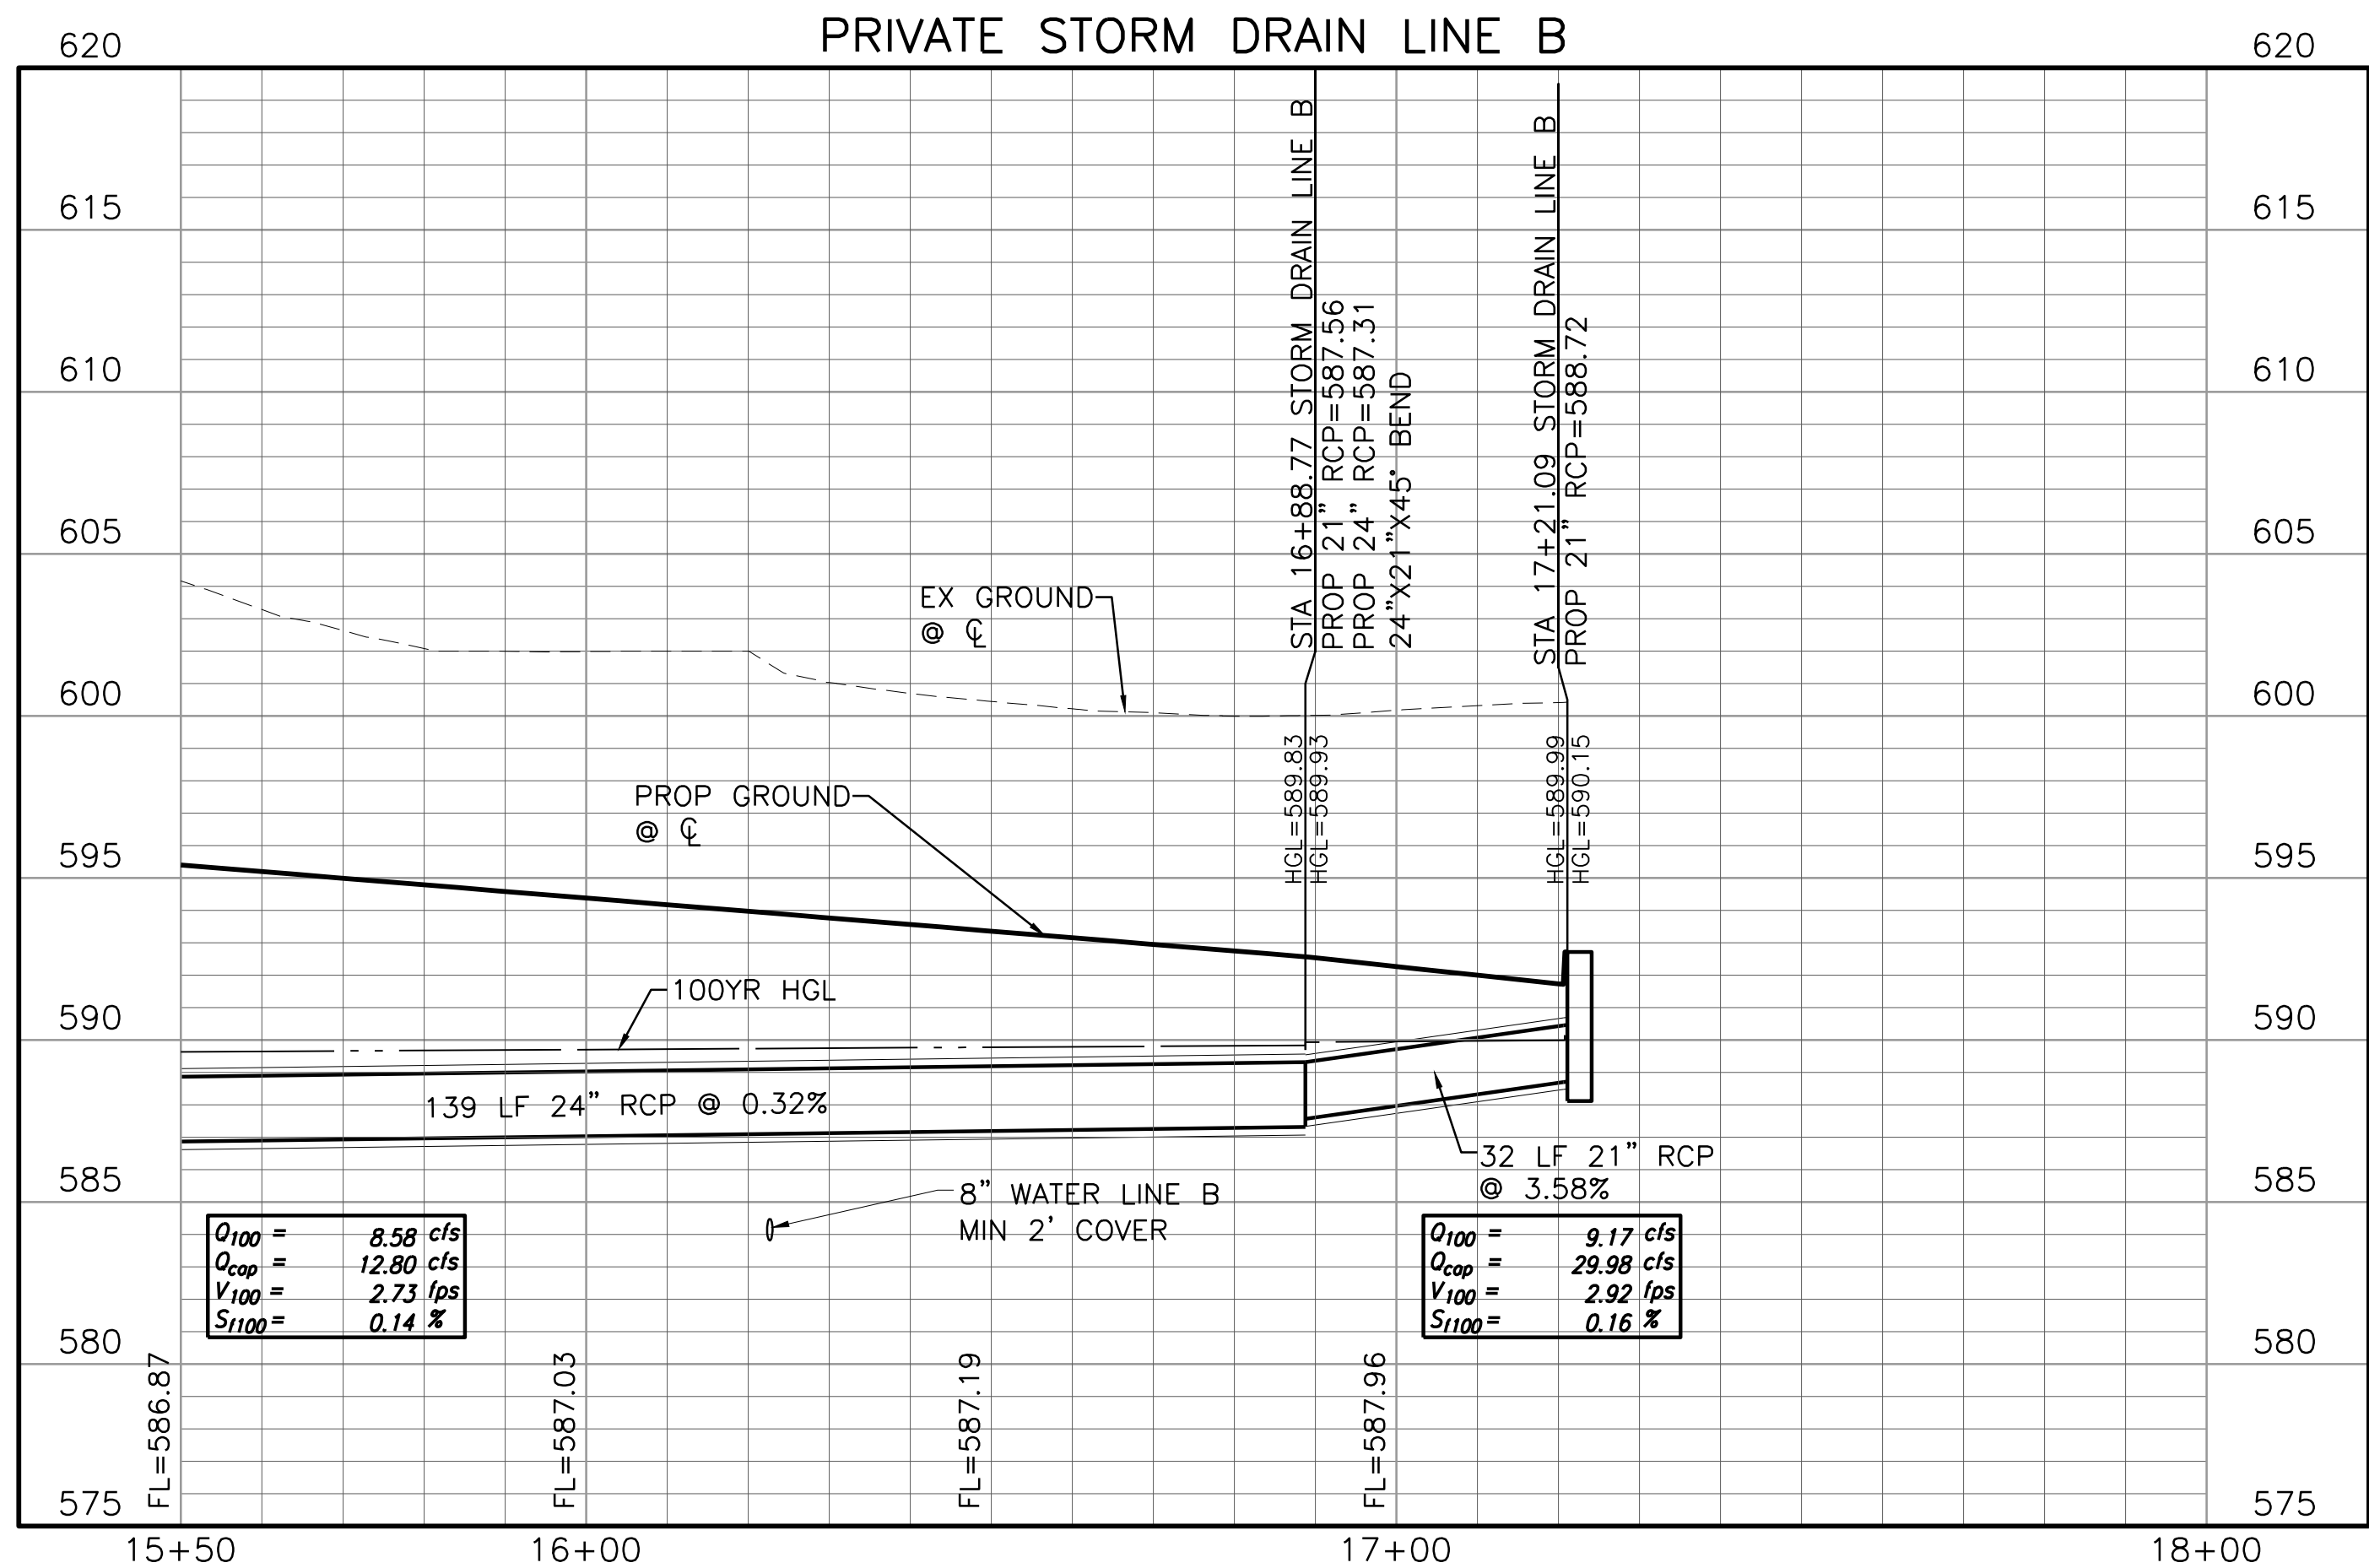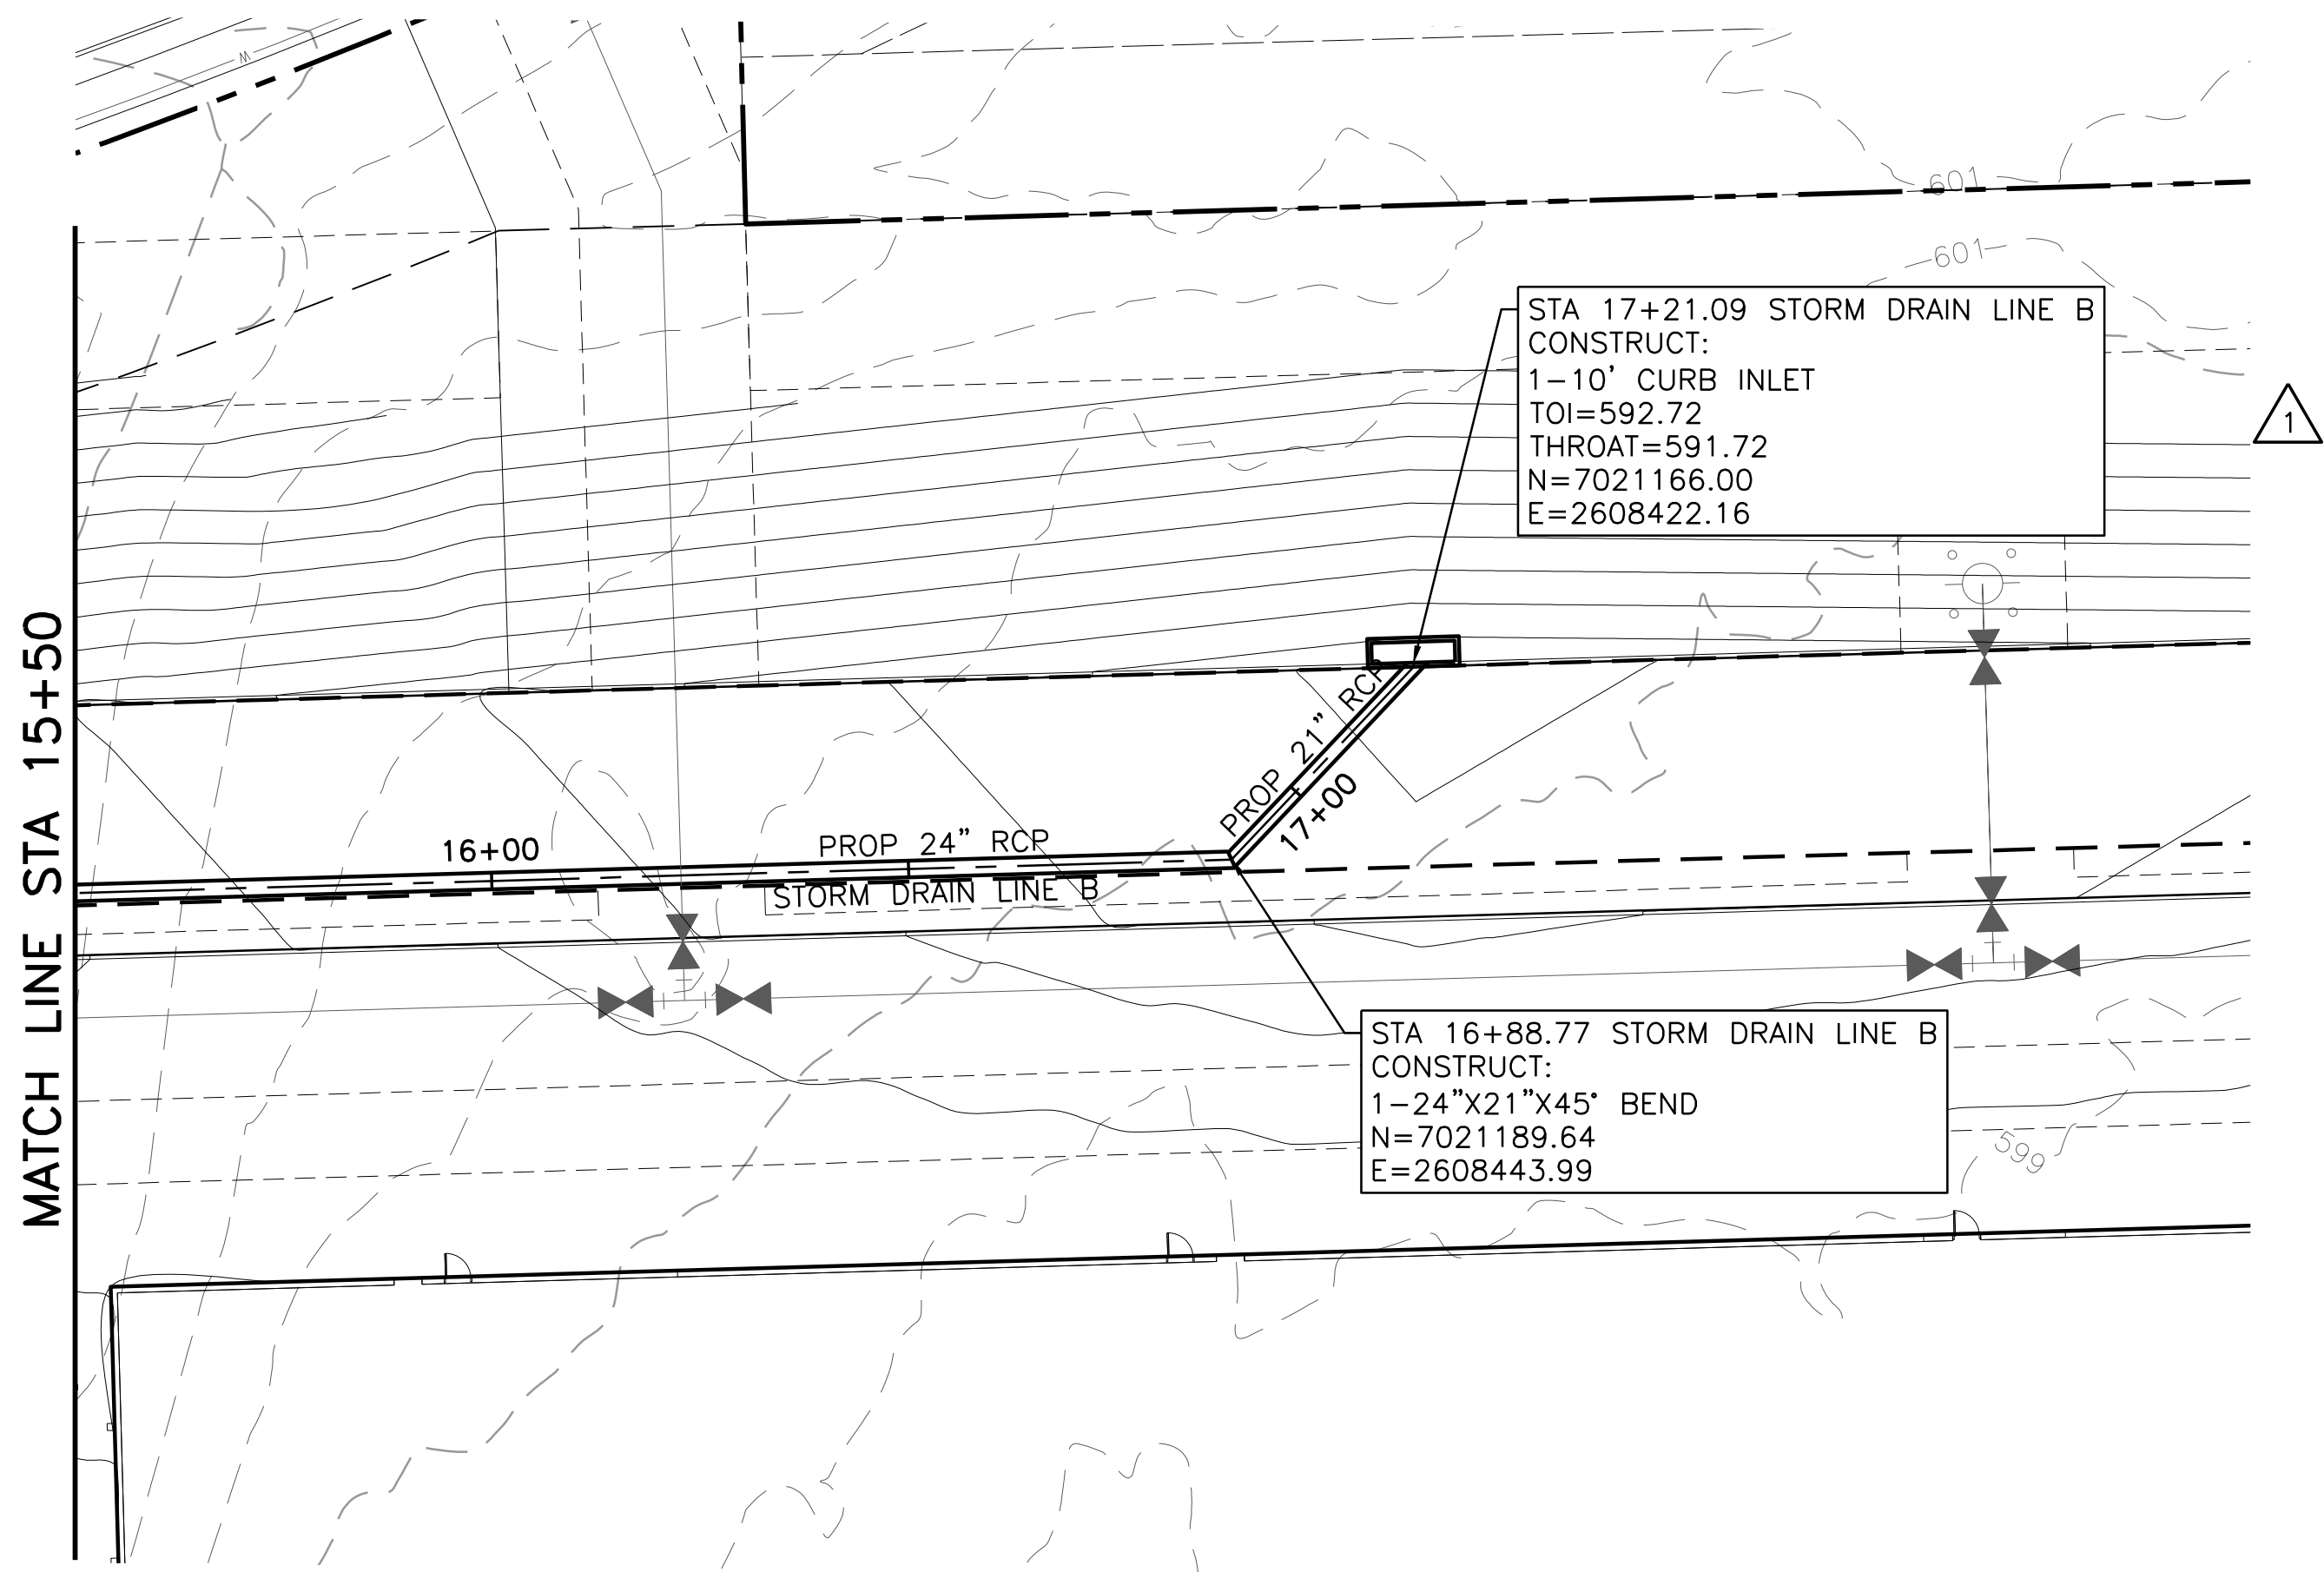

BENCHMARKS:

BENCHMARK A-AN "X" CUT IN THE CENTER OF THE SIDEWALK AT THE END OF THE HANDICAP RAMP AT THE SOUTHEAST CORNER OF THE INTERSECTION OF DISCOVERY BLVD. AND DATA DR., 11 FEET SOUTHEAST OF THE CURB LINE.
ELEV=600.44

BENCHMARK B-AN "X" CUT ON THE CURB ON THE NORTH SIDE OF DISCOVERY BLVD. 580 FEET EAST OF CORPORATE CROSSING, 11 FEET SOUTHEAST OF A FIRE HYDRANT, AND 19 FEET NORTHEAST OF TWO (2) WATER VALVES.
ELEV=599.67

THE SEAL THAT ORIGINALLY APPEARED ON THIS DOCUMENT WAS AUTHORIZED BY: BRIET M. BRISLOW, P.E.
TEXAS NO.: 101000 ON: 12/13/2018
ALTERATION OF A SEALED DOCUMENT WITHOUT PROPER NOTIFICATION OF THE RESPONSIBLE ENGINEER IS AN OFFENSE UNDER THE TEXAS ENGINEERING PRACTICE ACT.

This Record Drawing is a combination of the sealed engineering contract drawings for this project, modified by information furnished by the contractor reflecting changes in the Project made during construction. The original sealed drawings are on file at the offices of:

FREESE AND NICHOLS, INC.
RECORD DRAWINGS PREPARED ON: 3/6/2019

CLAYCO
THE ART & SCIENCE OF BUILDING

2199 INNERBELT BUSINESS CENTER DRIVE
ST. LOUIS, MISSOURI 63114
Ph 314.429.5100 Fx 314.429.3137

ARCHITECT
FORUM
2199 INNERBELT BUSINESS CENTER DRIVE
ST. LOUIS, MISSOURI 63114
Ph 314.429.1010 Fx 314.429.7770

CONTRACTOR / DEVELOPER
CLAYCO

LANDSCAPE ARCHITECT
FORUM

CIVIL ENGINEER
FREESE & NICHOLS

STRUCTURAL ENGINEER


MECHANICAL ENGINEER

ELECTRICAL ENGINEER

PLUMBING ENGINEER

FIRE PROTECTION ENGINEER

Lollicup
ROCKWALL TECHNOLOGY PARK
ROCKWALL, TEXAS

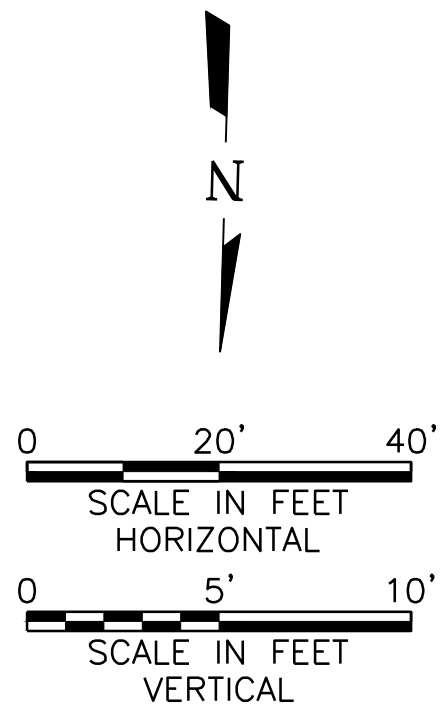

NOTES

1. ALL RESPONSIBILITY FOR ADEQUACY OF DESIGN REMAINS WITH THE DESIGN ENGINEER. THE CITY OF ROCKWALL, IN REVIEWING AND RELEASING PLANS FOR CONSTRUCTION, ASSUMES NO RESPONSIBILITY FOR ADEQUACY OR ACCURACY OF DESIGN.

APPLICANT INFORMATION

BOB LEIMBERG
CLAYCO
2199 INNERBELT BUSINESS CENTER DR.
ST. LOUIS, MO 63114
314.592.2234 office
314.713.7874 mobile
leimbergb@claycorp.com

OWNER INFORMATION

ALAN YU
LOLLICUP USA
6185 KIMBALL AVE.
CHINO, CA 91708
626.965.8882 x110 office
626.226.8556 mobile
alan.yu@lollicup.com

PROJECT NAME

LOLLICUP USA WAREHOUSE
CASE NUMBER:

DRAWING ISSUE

DESCRIPTION	DATE
ENGINEERING SUBMITTAL CITY OF ROCKWALL	2/2/2018
ENGINEERING REVIEW 2ND SUBMITTAL	3/2/2018
ENGINEERING REVIEW 3RD SUBMITTAL	3/23/2018
ISSUED FOR CONSTRUCTION	4/10/2018
SD RFI'S	6/13/2018

RECORD DRAWING


3/6/2019

DRAWING TITLE
STORM DRAIN LINE B PLAN
AND PROFILE

DRAWING NO.

C04-08

Forum # 601-03049 Consult.# 101-03049

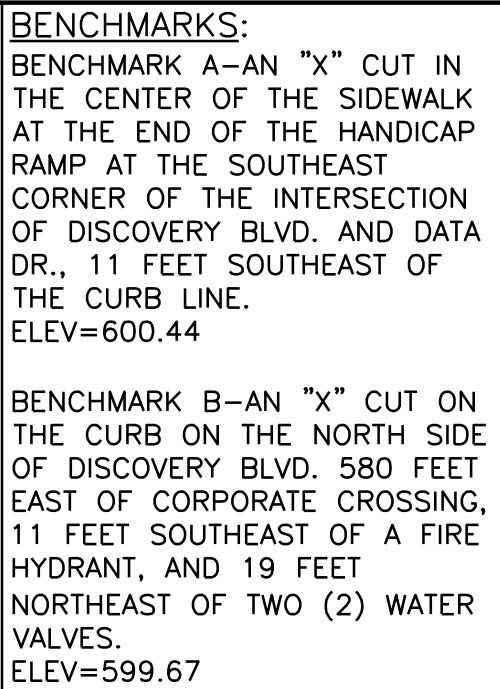

This Record Drawing is a combination of the sealed engineering contract drawings for this project, modified by information furnished by the contractor reflecting changes in the Project made during construction. The original sealed drawings are on file at the offices of

FREESE AND NICHOLS, INC.
RECORD DRAWINGS PREPARED ON:
3/6/2019

CLAYCO

THE ART & SCIENCE OF BUILDING

2199 INNERBELT BUSINESS CENTER DRIVE
ST. LOUIS, MISSOURI 63114
Ph 314.429.5100 Fx 314.429.3137

ARCHITECT
FORUM
2199 INNERBELT BUSINESS CENTER DRIVE
ST. LOUIS, MISSOURI 63114
Ph 314.429.1010 Fx 314.429.7770

CONTRACTOR / DEVELOPER CLAYCO

LANDSCAPE ARCHITECT
FORUM

CIVIL ENGINEER
FREESE & NICHOLS


STRUCTURAL ENGINEER

MECHANICAL ENGINEER


ELECTRICAL ENGINEER

PLUMBING ENGINEER


FIRE PROTECTION ENGINEER

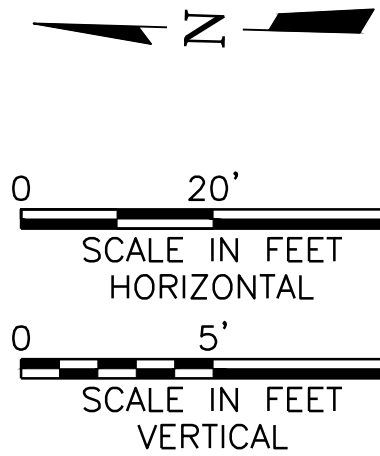

1. ALL RESPONSIBILITY FOR ADEQUACY OF DESIGN REMAINS WITH THE DESIGN ENGINEER. THE CITY OF ROCKWALL, IN REVIEWING AND RELEASING PLANS FOR CONSTRUCTION, ASSUMES NO RESPONSIBILITY FOR ADEQUACY OR ACCURACY OF DESIGN.
2. REFER TO SHEET C04-15 FOR GROUTED RIP-RAP DETAIL.
3. REFER TO SHEET C06-02 FOR TXDOT SETP-PD DETAIL

APPLICANT INFORMATION BOB LEIMBERG CLAYCO 2199 INNERBELT BUSINESS CENTER DR. ST. LOUIS, MO 63114 314.592.2234 office 314.713.7874 mobile leimbergb@claycorp.com		DRAWING ISSUE	
		DESCRIPTION ENGINEERING SUBMITTAL CITY OF ROCKWALL ENGINEERING REVIEW 2ND SUBMITTAL ENGINEERING REVIEW 3RD SUBMITTAL ISSUED FOR CONSTRUCTION	DATE 2/2/2018 3/2/2018 3/23/2018 4/10/2018 6/13/2018
OWNER INFORMATION ALAN YU LOLLICUP USA 6185 KIMBALL AVE. CHINO, CA 91708 626.965.8882 x110 office 626.226.8556 mobile alan.yu@lollcup.com		SD RFF'S 	6/13/2018
PROJECT NAME LOLLICUP USA WAREHOUSE CASE NUMBER:		RECORD DRAWING	3/6/2019
		DRAWING TITLE STORM DRAIN LINE D PLAN AND PROFILE	
		DRAWING NO. C04-10	
		Form # 601-03049	Consult# 101-03049

MATCH LINE STA 4+50

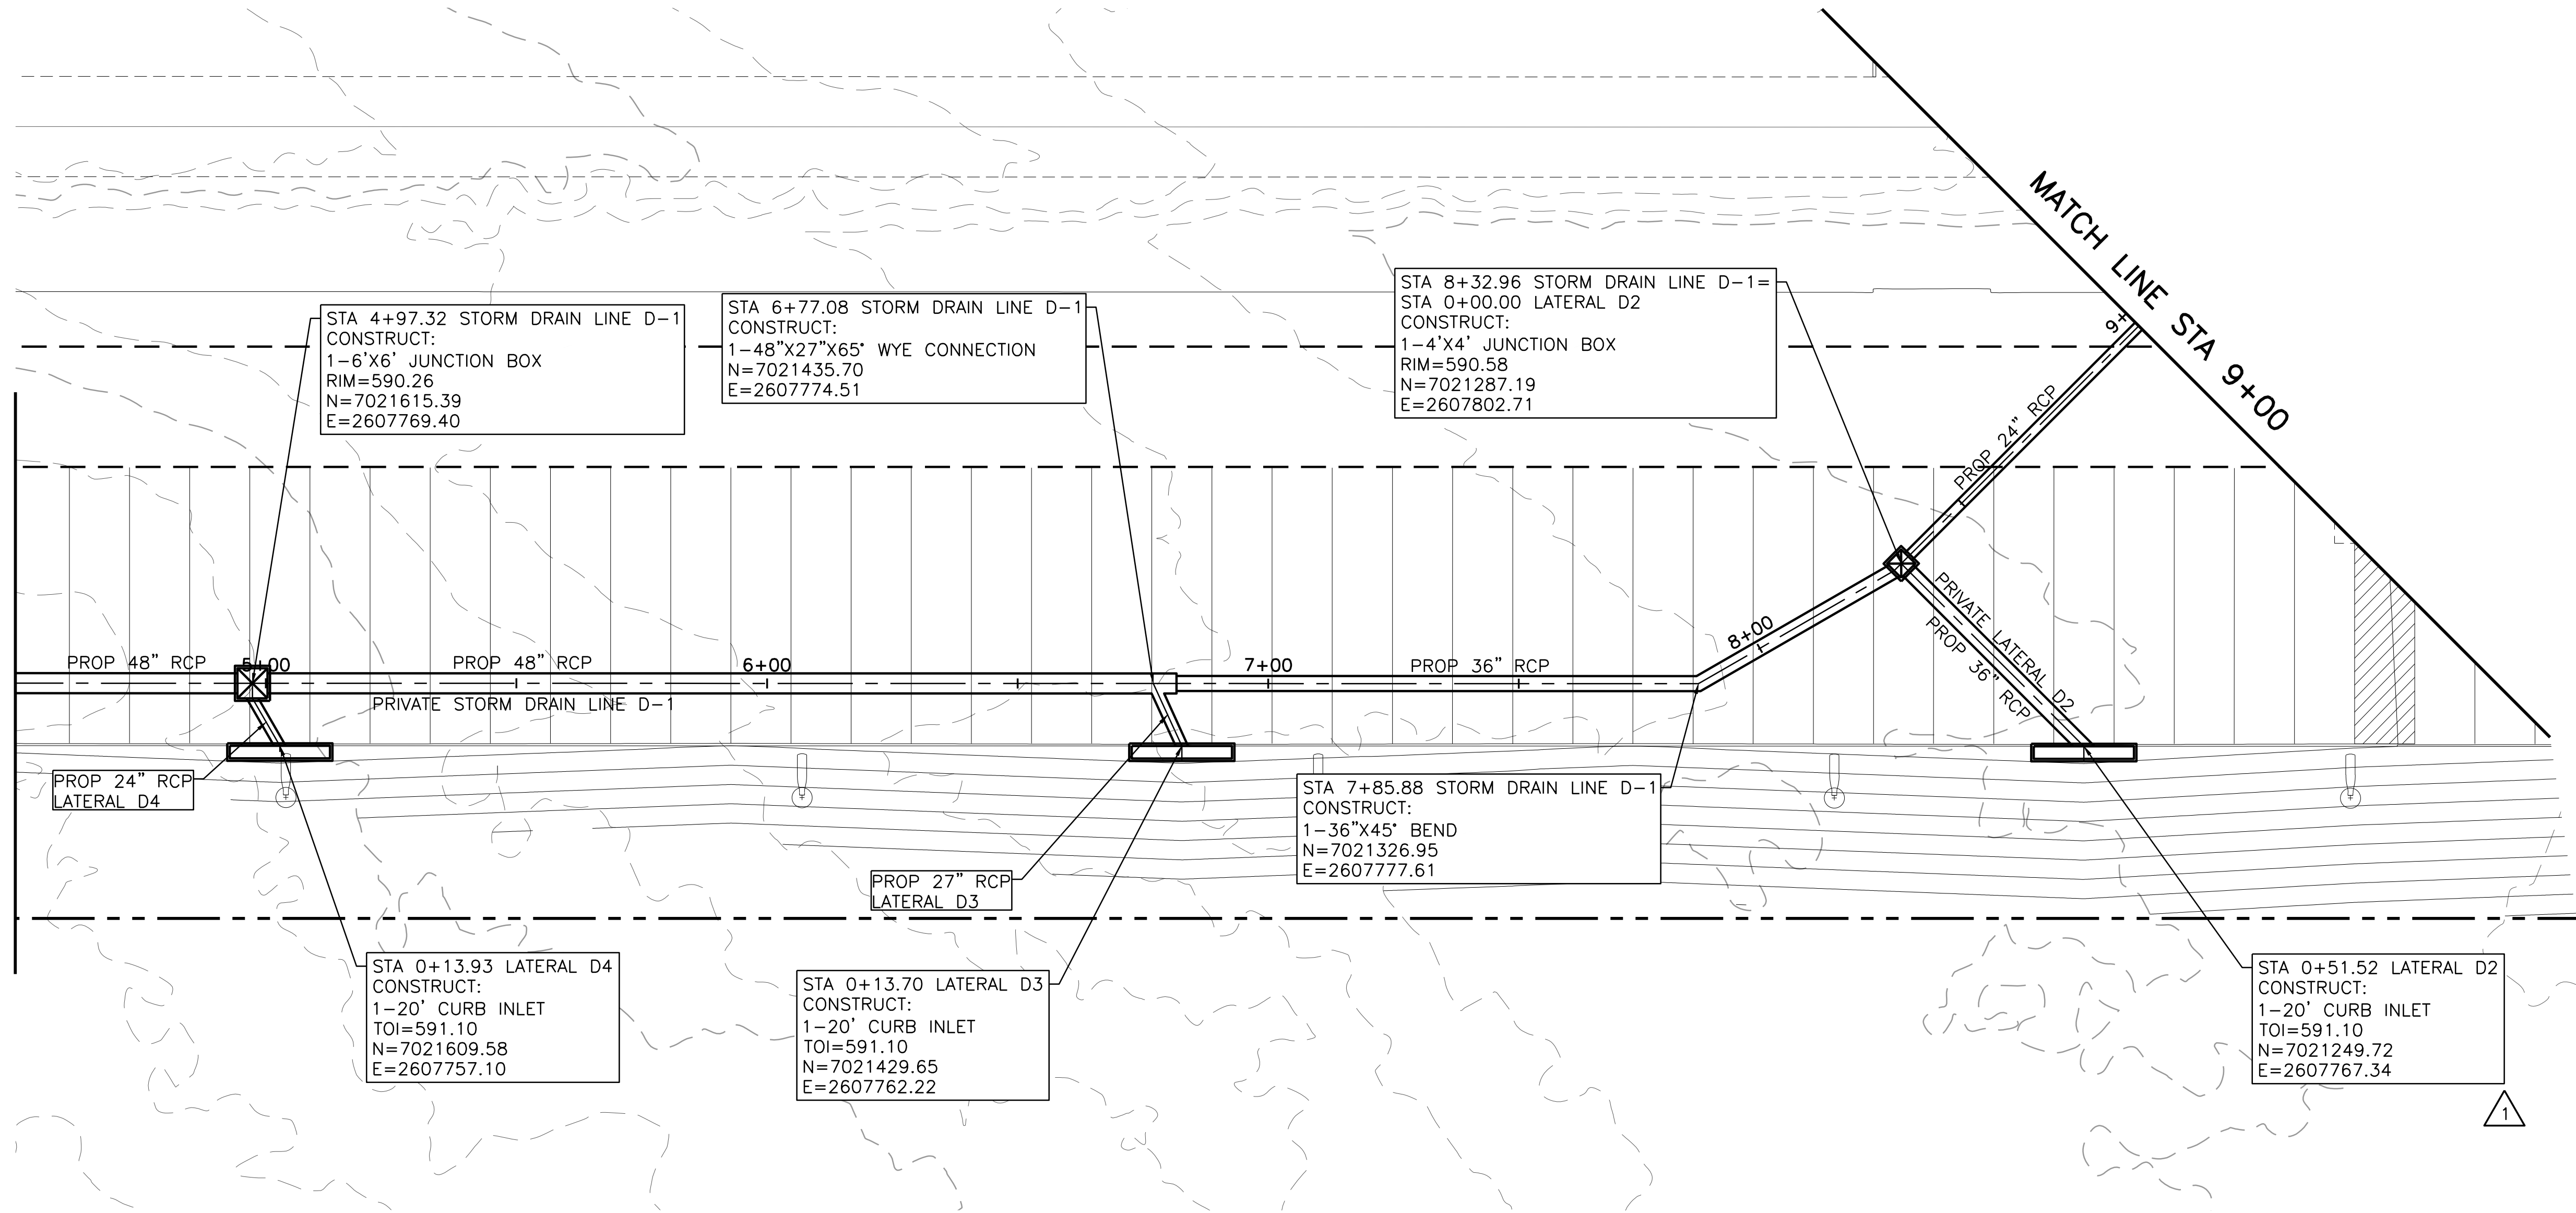

BENCHMARKS:
BENCHMARK A-AN "X" CUT IN THE CENTER OF THE SIDEWALK AT THE END OF THE HANDICAP RAMP AT THE SOUTHEAST CORNER OF THE INTERSECTION OF DISCOVERY BLVD. AND DATA DR., 11 FEET SOUTHEAST OF THE CURB LINE. ELEV=600.44
BENCHMARK B-AN "X" CUT ON THE CURB ON THE NORTH SIDE OF DISCOVERY BLVD. 580 FEET EAST OF CORPORATE CROSSING, 11 FEET SOUTHEAST OF A FIRE HYDRANT, AND 19 FEET NORTHEAST OF TWO (2) WATER VALVES. ELEV=599.67

THE SEAL THAT ORIGINALLY APPEARED ON THIS DOCUMENT WAS AUTHORIZED BY: BRIET M. BRISLOW, P.E.
TEXAS NO.: 303000 EXP. 12/31/2020
ALTERNATION OF A SEALED DOCUMENT WITHOUT PROPER NOTIFICATION OF THE RESPONSIBLE ENGINEER IS AN OFFENSE UNDER THE TEXAS ENGINEERING PRACTICE ACT.
This Record Drawing is a combination of the sealed engineering contract drawings for this project, modified by information furnished by the contractor reflecting changes in the Project made during construction. The original sealed drawings are on file at the offices of:
FREESE AND NICHOLS, INC.
RECORD DRAWINGS PREPARED ON: 3/6/2019

CLAYCO
THE ART & SCIENCE OF BUILDING
2199 INNERBELT BUSINESS CENTER DRIVE
ST. LOUIS, MISSOURI 63114
Ph 314.429.5100 Fx 314.429.3137

ARCHITECT
FORUM
2199 INNERBELT BUSINESS CENTER DRIVE
ST. LOUIS, MISSOURI 63114
Ph 314.429.1010 Fx 314.429.7770
CONTRACTOR / DEVELOPER
CLAYCO
LANDSCAPE ARCHITECT
FORUM
CIVIL ENGINEER
FREESE & NICHOLS
STRUCTURAL ENGINEER
MECHANICAL ENGINEER
ELECTRICAL ENGINEER
PLUMBING ENGINEER
FIRE PROTECTION ENGINEER



0 20' 40'
SCALE IN FEET
HORIZONTAL
0 5' 10'
SCALE IN FEET
VERTICAL

NOTES

1. ALL RESPONSIBILITY FOR ADEQUACY OF DESIGN REMAINS WITH THE DESIGN ENGINEER. THE CITY OF ROCKWALL, IN REVIEWING AND RELEASING PLANS FOR CONSTRUCTION, ASSUMES NO RESPONSIBILITY FOR ADEQUACY OR ACCURACY OF DESIGN.

Lollicup
ROCKWALL TECHNOLOGY PARK
ROCKWALL, TEXAS

DRAWING ISSUE

APPLICANT INFORMATION

BOB LEIMBERG
CLAYCO
2199 INNERBELT BUSINESS CENTER DR.
ST. LOUIS, MO 63114
314.592.2234 office
314.713.7874 mobile
leimbergb@claycorp.com


OWNER INFORMATION



ALAN YU
LOLLICUP USA
6185 KIMBALL AVE
CHINO, CA 91708
626.965.8882 x110 office
626.226.8556 mobile
alan.yu@lollicup.com

PROJECT NAME

LOLLICUP USA WAREHOUSE
CASE NUMBER:

DESCRIPTION	DATE
ENGINEERING SUBMITTAL CITY OF ROCKWALL	2/2/2018
ENGINEERING REVIEW 2ND SUBMITTAL	3/2/2018
ENGINEERING REVIEW 3RD SUBMITTAL	3/23/2018
ISSUED FOR CONSTRUCTION	4/10/2018
SD RFIS	6/13/2018
RECORD DRAWING	3/6/2019
DRAWING TITLE STORM DRAIN LINE D PLAN AND PROFILE	
DRAWING NO.	C04-11
Form #	601-03049
Consult #	101-03049

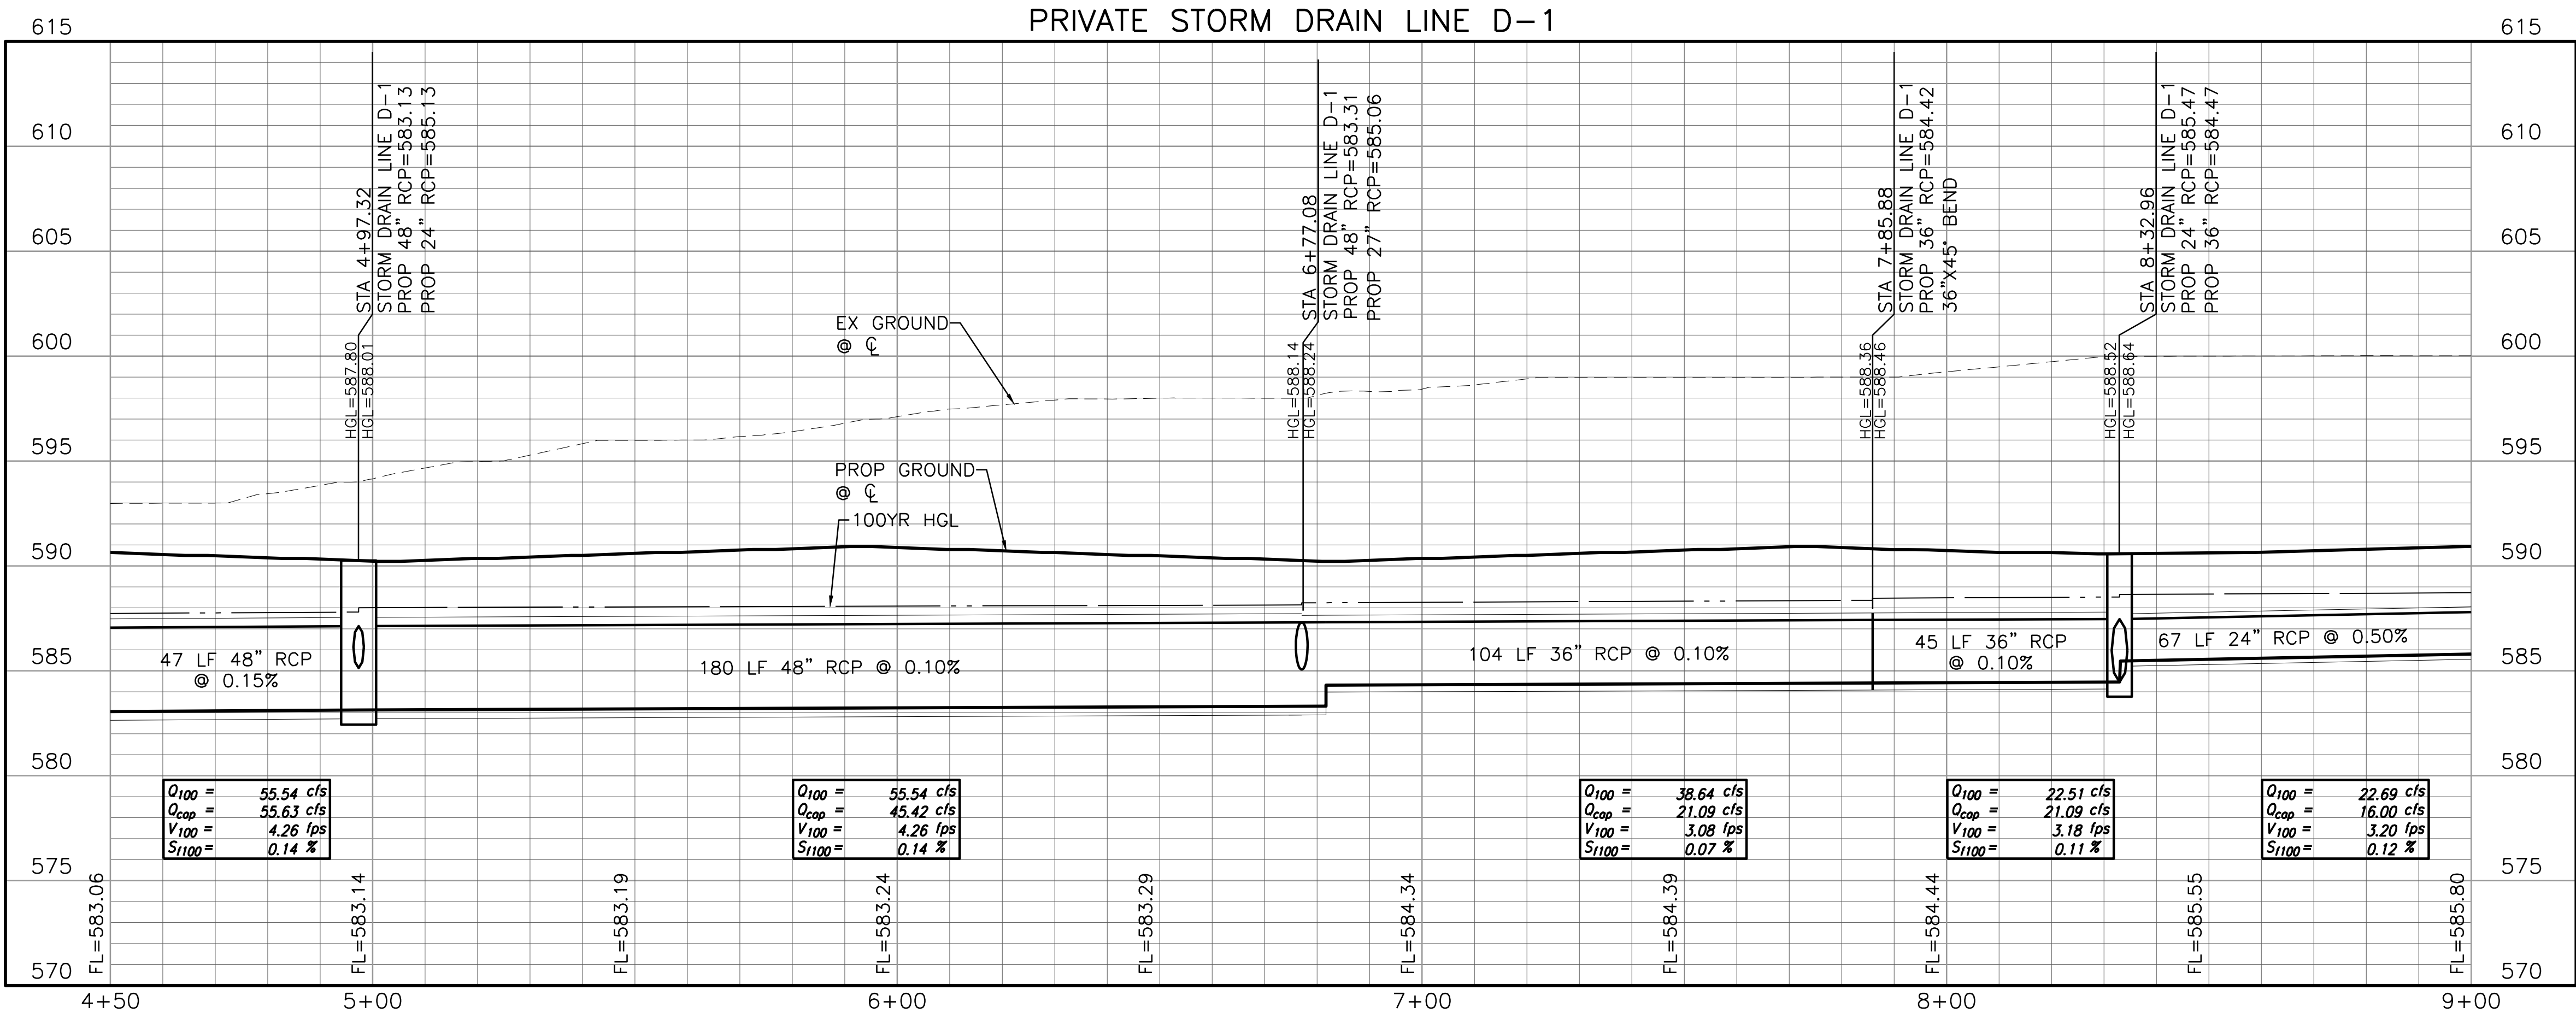

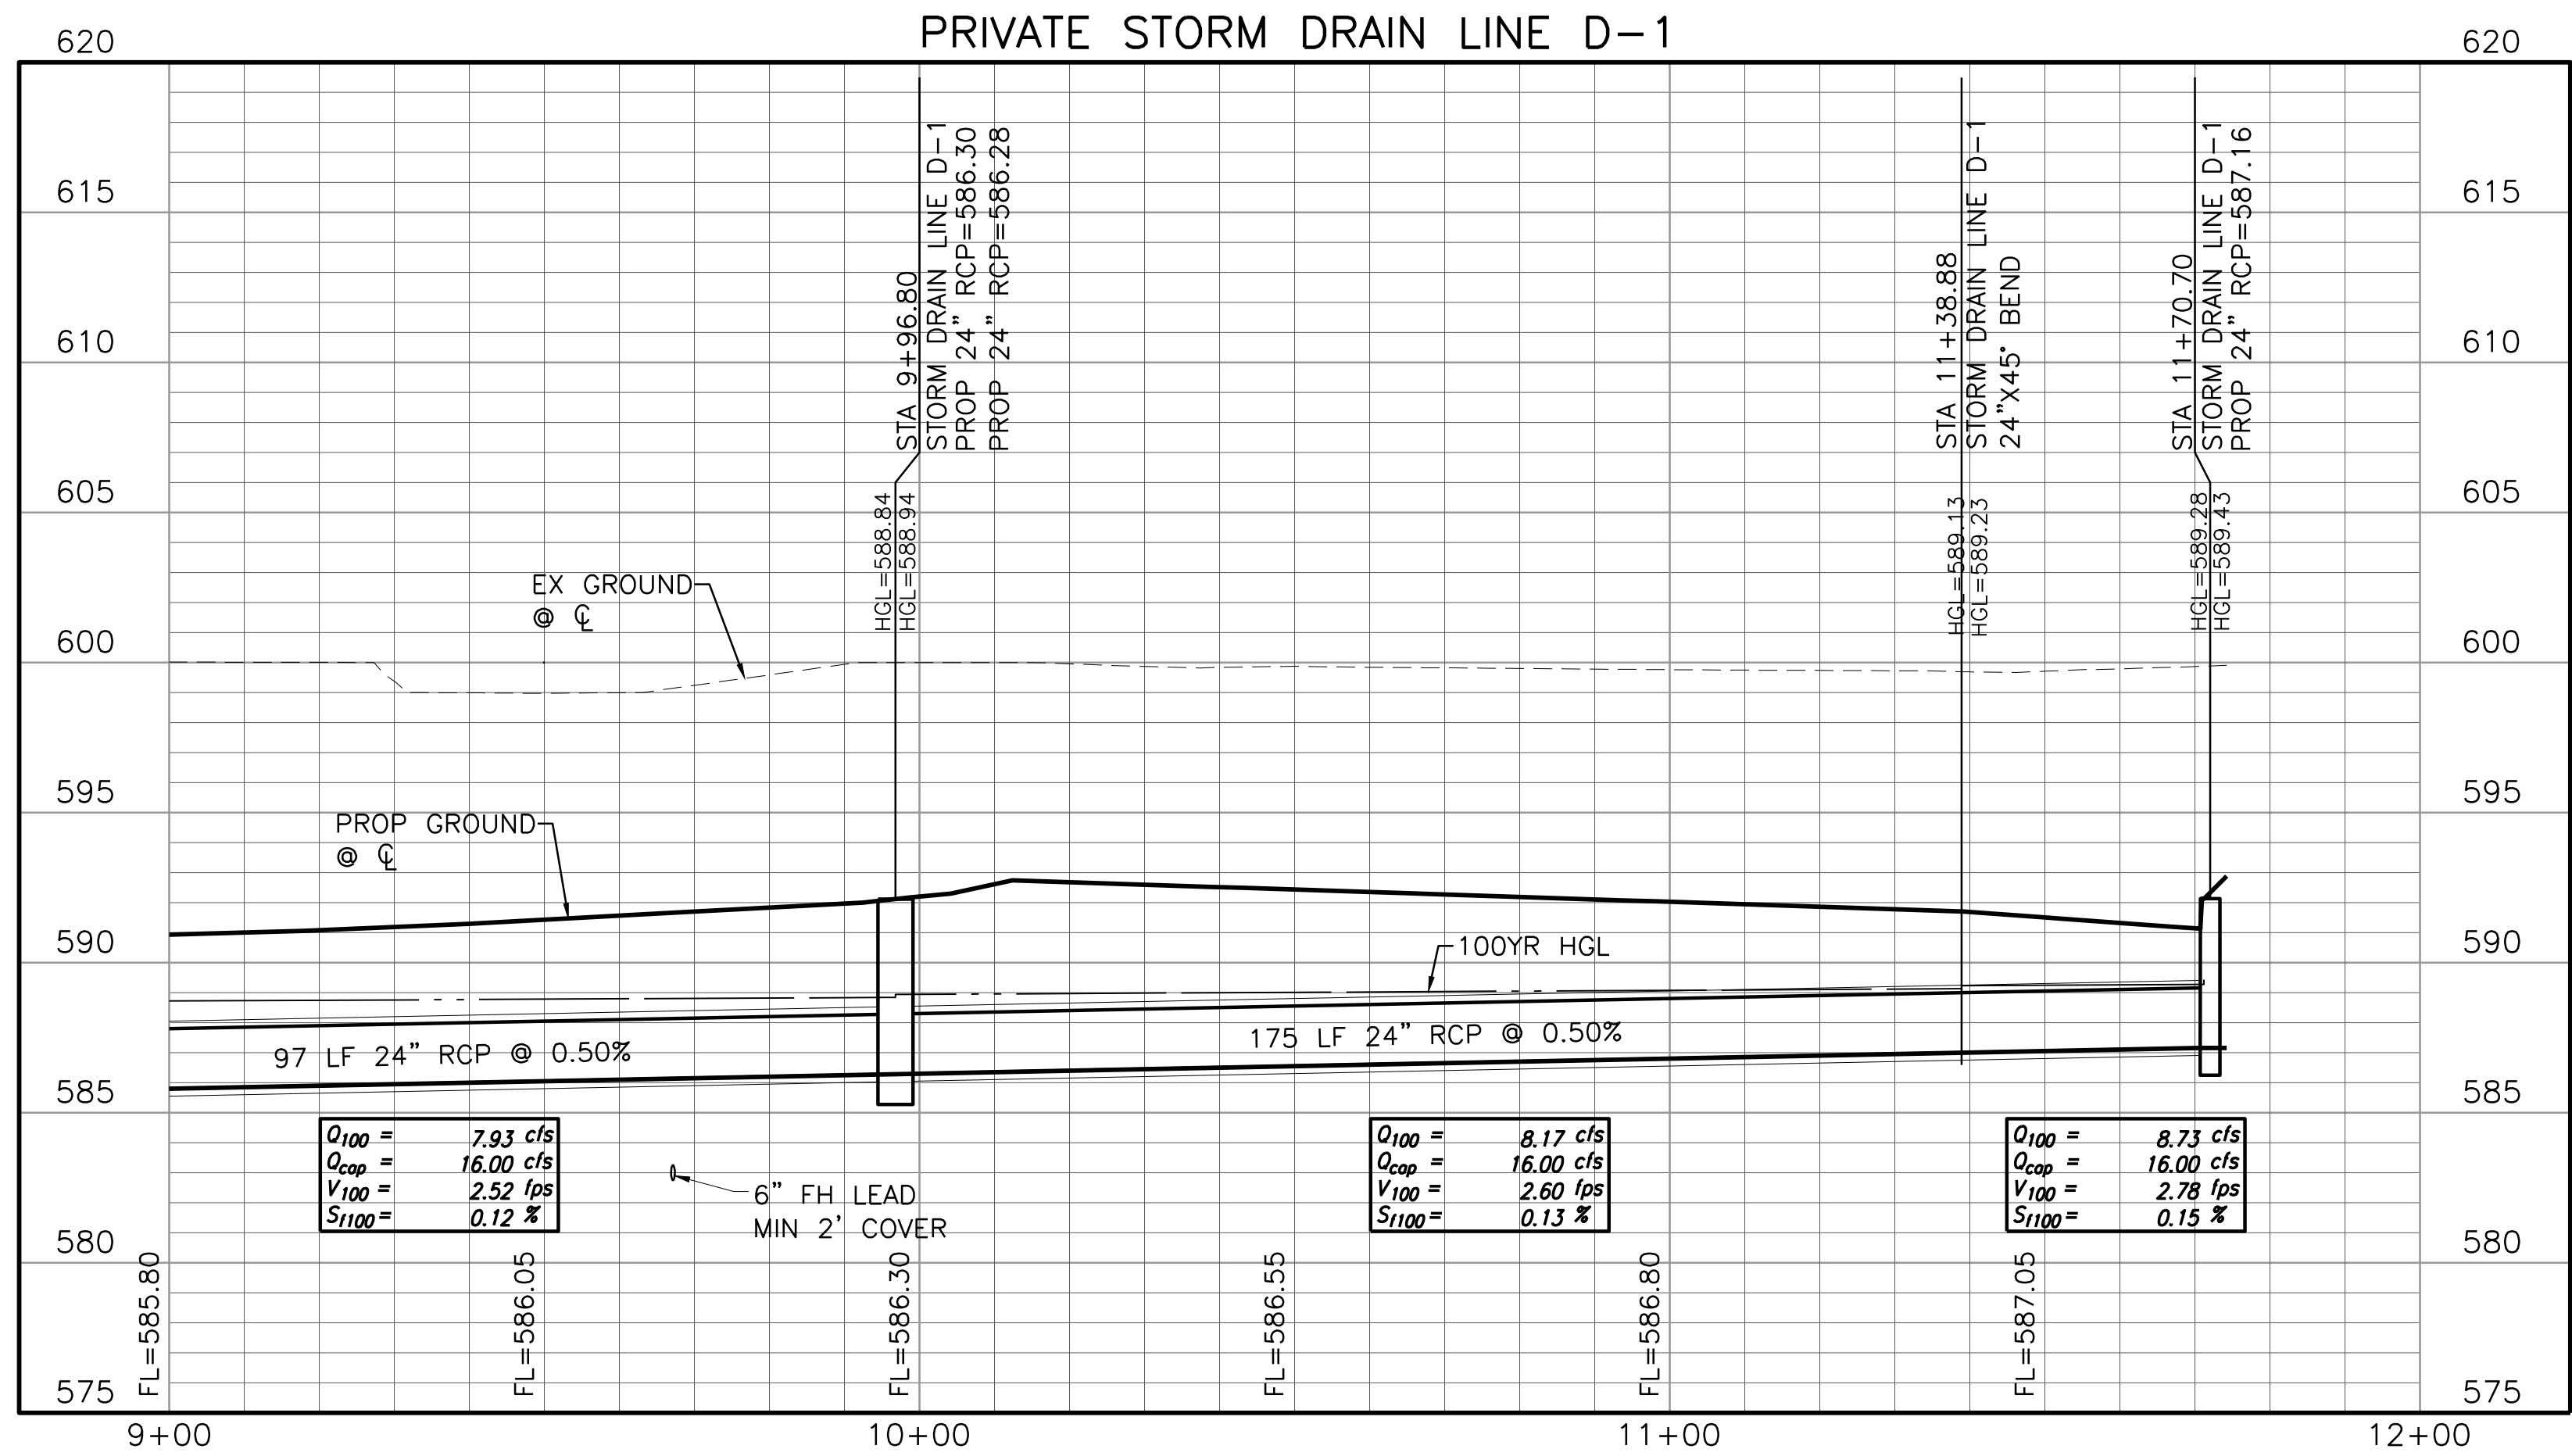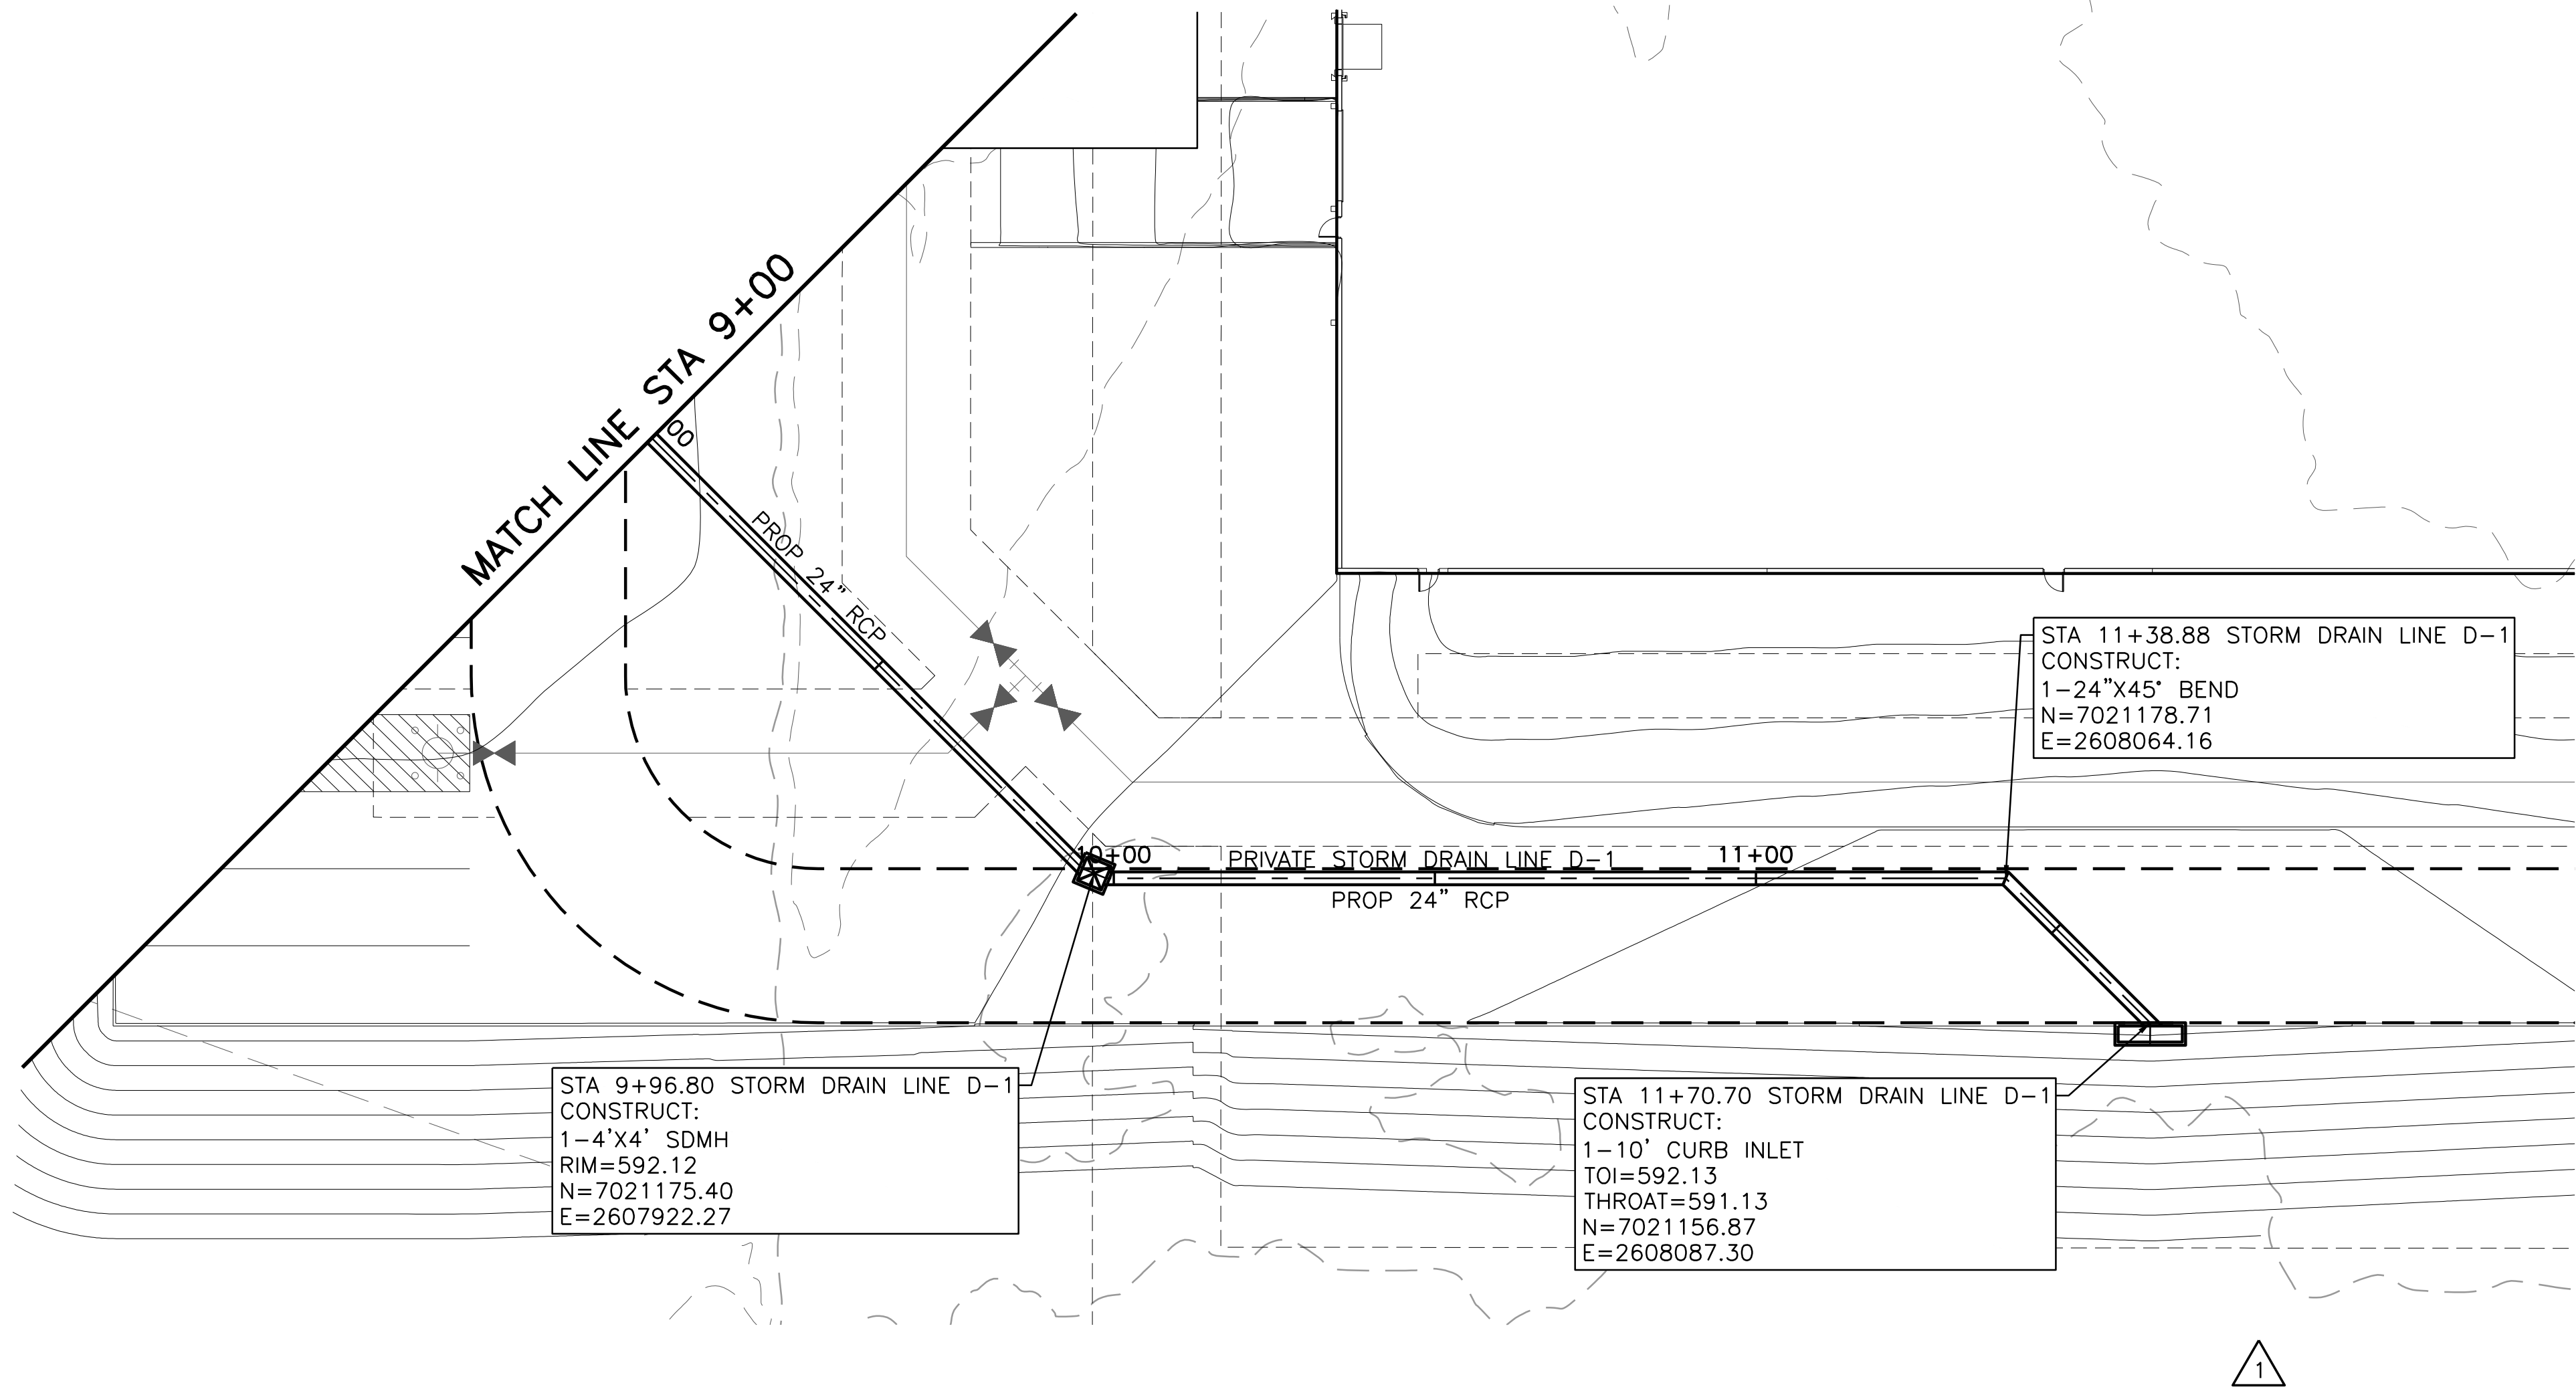

BENCHMARKS:
BENCHMARK A-AN "X" CUT IN THE CENTER OF THE SIDEWALK AT THE END OF THE HANDICAP RAMP AT THE SOUTHEAST CORNER OF THE INTERSECTION OF DISCOVERY BLVD. AND DATA DR., 11 FEET SOUTHEAST OF THE CURB LINE. ELEV=600.44
BENCHMARK B-AN "X" CUT ON THE CURB ON THE NORTH SIDE OF DISCOVERY BLVD. 580 FEET EAST OF CORPORATE CROSSING, 11 FEET SOUTHEAST OF A FIRE HYDRANT, AND 19 FEET NORTHEAST OF TWO (2) WATER VALVES. ELEV=599.67

THE SEAL THAT ORIGINALLY APPEARED ON THIS DOCUMENT WAS AUTHORIZED BY: BRIET M. BRISOW, P.E.
TEXAS NO. 101000 ON 12/13/2018
ALTERATION OF A SEALED DOCUMENT WITHOUT PROPER NOTIFICATION OF THE RESPONSIBLE ENGINEER IS AN OFFENSE UNDER THE TEXAS ENGINEERING PRACTICE ACT.

This Record Drawing is a combination of the sealed engineering contract drawings for this project, modified by information furnished by the contractor reflecting changes in the Project made during construction. The original sealed drawings are on file at the offices of:

FREESE AND NICHOLS, INC.
RECORD DRAWINGS PREPARED ON: 3/6/2019

CLAYCO
THE ART & SCIENCE OF BUILDING
2199 INNERBELT BUSINESS CENTER DRIVE
ST. LOUIS, MISSOURI 63114
Ph 314.428.5100 Fx 314.428.3137

ARCHITECT
FORUM
2199 INNERBELT BUSINESS CENTER DRIVE
ST. LOUIS, MISSOURI 63114
Ph 314.428.1010 Fx 314.428.7770

CONTRACTOR / DEVELOPER
CLAYCO

LANDSCAPE ARCHITECT
FORUM

CIVIL ENGINEER
FREESE & NICHOLS

STRUCTURAL ENGINEER

MECHANICAL ENGINEER

ELECTRICAL ENGINEER

PLUMBING ENGINEER

FIRE PROTECTION ENGINEER

Lollicup
ROCKWALL TECHNOLOGY PARK
ROCKWALL, TEXAS

DRAWING ISSUE


DESCRIPTION	DATE
ENGINEERING SUBMITTAL CITY OF ROCKWALL	2/2/2018
ENGINEERING REVIEW 2ND SUBMITTAL	3/2/2018
ENGINEERING REVIEW 3RD SUBMITTAL	3/23/2018
ISSUED FOR CONSTRUCTION	4/10/2018
SD RFI'S	6/13/2018
RECORD DRAWING	3/6/2019

DRAWING TITLE
STORM DRAIN LINE D-1
PLAN AND PROFILE

DRAWING NO.
C04-12

PROJECT NAME
LOLLICUP USA WAREHOUSE



CASE NUMBER:
Forum # 601-03049 Consult # 101-03049

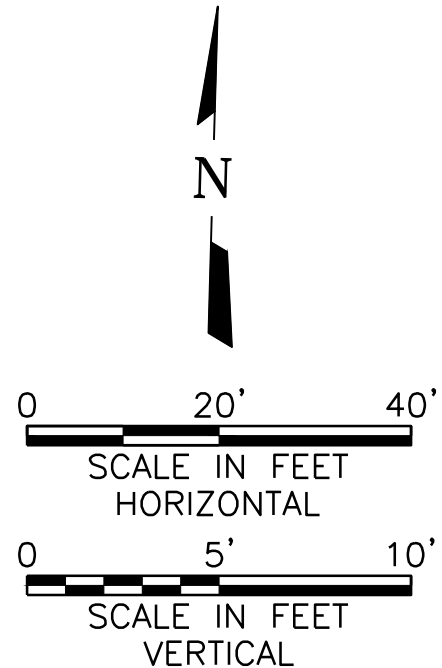

NOTES

- ALL RESPONSIBILITY FOR ADEQUACY OF DESIGN REMAINS WITH THE DESIGN ENGINEER. THE CITY OF ROCKWALL, IN REVIEWING AND RELEASING PLANS FOR CONSTRUCTION, ASSUMES NO RESPONSIBILITY FOR ADEQUACY OR ACCURACY OF DESIGN.

CAPITAL BOULEVARD
(VARIABLE WIDTH RIGHT-OF-WAY)
CAB. I, SL. 13
P.R.R.C.T.

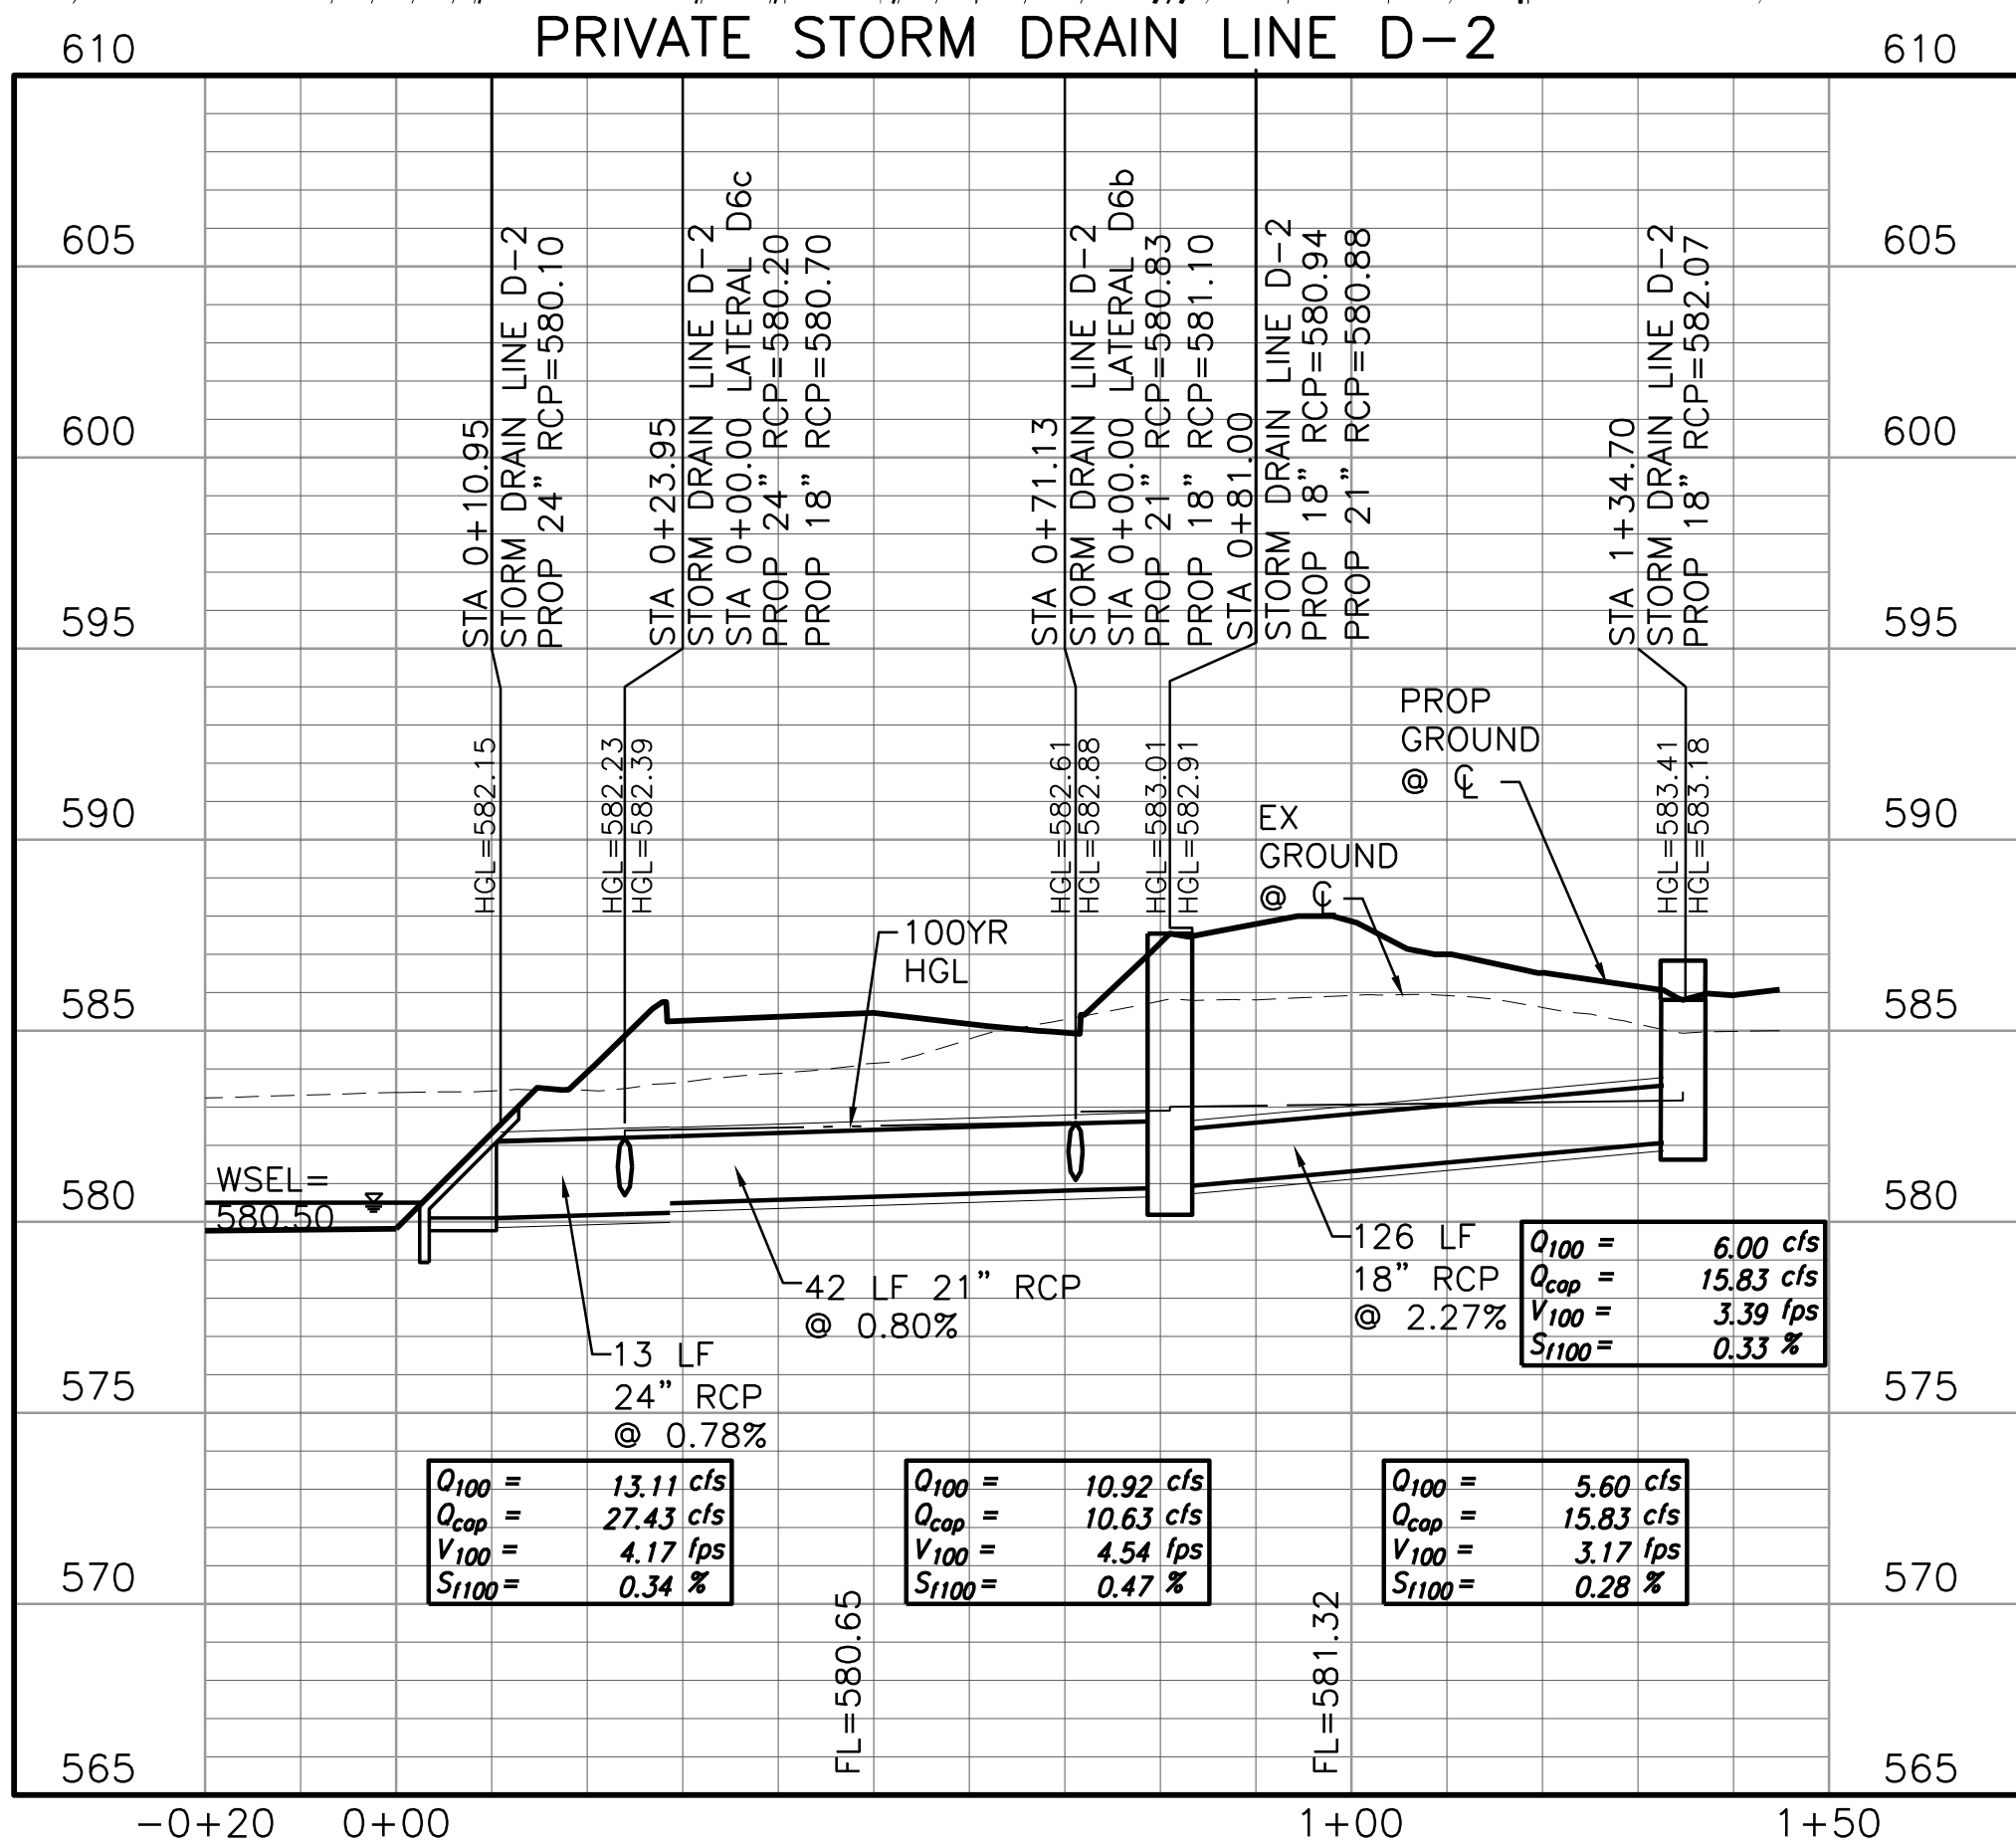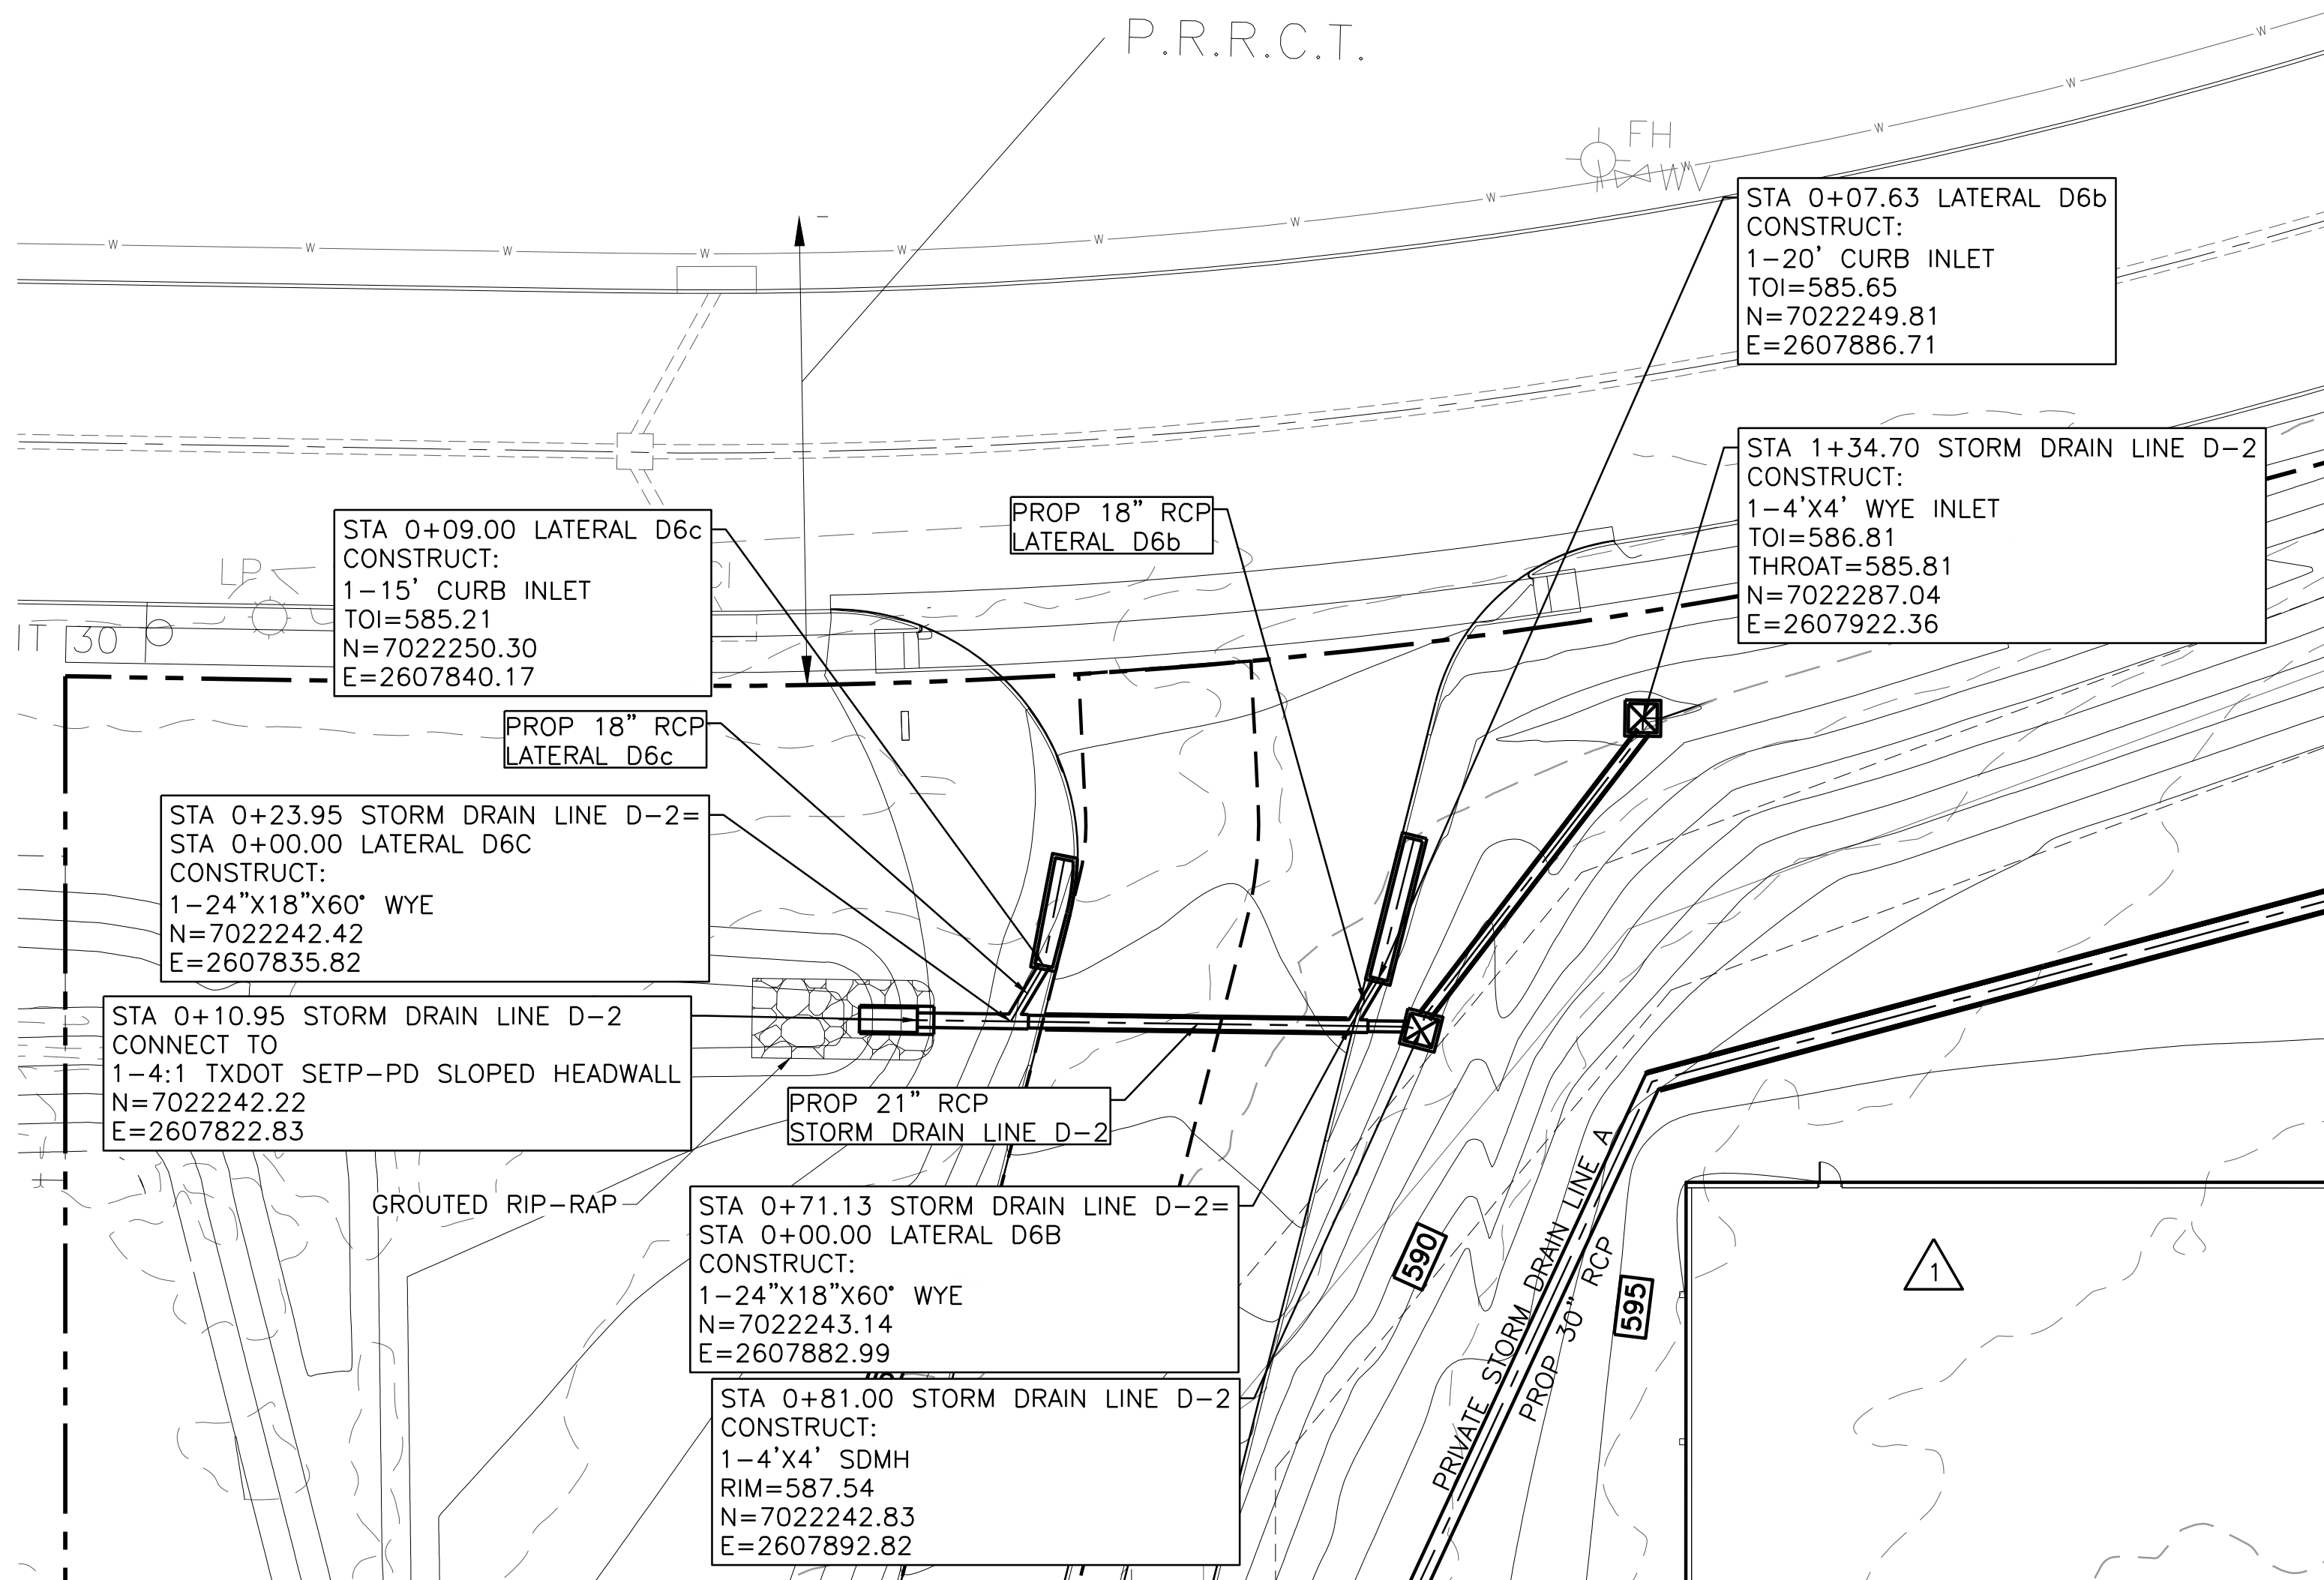

BENCHMARKS:

BENCHMARK A-AN "X" CUT IN THE CENTER OF THE SIDEWALK AT THE END OF THE HANDICAP RAMP AT THE SOUTHEAST CORNER OF THE INTERSECTION OF DISCOVERY BLVD. AND DATA DR., 11 FEET SOUTHEAST OF THE CURB LINE. ELEV=600.44

BENCHMARK B-AN "X" CUT ON THE CURB ON THE NORTH SIDE OF DISCOVERY BLVD. 580 FEET EAST OF CORPORATE CROSSING, 11 FEET SOUTHEAST OF A FIRE HYDRANT, AND 19 FEET NORTHEAST OF TWO (2) WATER VALVES. ELEV=599.67

THE SEAL THAT ORIGINALLY APPEARED ON THIS DOCUMENT WAS AUTHORIZED BY: BRIET M. BRISLOW, P.E. TEXAS NO. 100000 ON 12/31/2018. ALTERATION OF A SEALED DOCUMENT WITHOUT PROPER NOTIFICATION OF THE RESPONSIBLE ENGINEER IS AN OFFENSE UNDER THE TEXAS ENGINEERING PRACTICE ACT.

This Record Drawing is a combination of the sealed engineering contract drawings for this project, modified by information furnished by the contractor reflecting changes in the Project made during construction. The original sealed drawings are on file at the offices of:

FREES AND NICHOLS, INC.
RECORD DRAWINGS PREPARED ON: 3/6/2019

CLAYCO
THE ART & SCIENCE OF BUILDING
2199 INNERBELT BUSINESS CENTER DRIVE
ST. LOUIS, MISSOURI 63114
Ph 314.428.5100 Fx 314.428.3137

ARCHITECT
FORUM
2199 INNERBELT BUSINESS CENTER DRIVE
ST. LOUIS, MISSOURI 63114
Ph 314.428.1010 Fx 314.428.7770

CONTRACTOR / DEVELOPER
CLAYCO

LANDSCAPE ARCHITECT
FORUM

CIVIL ENGINEER
FREES & NICHOLS


STRUCTURAL ENGINEER

MECHANICAL ENGINEER

ELECTRICAL ENGINEER

PLUMBING ENGINEER

FIRE PROTECTION ENGINEER

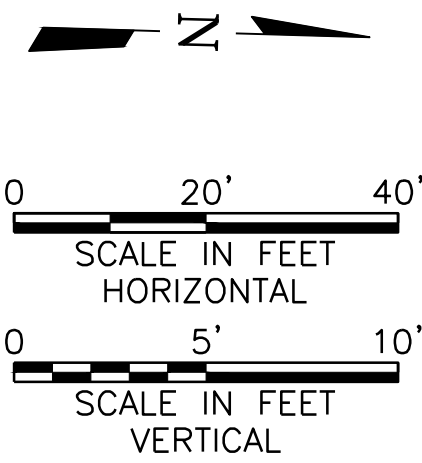

NOTES

- ALL RESPONSIBILITY FOR ADEQUACY OF DESIGN REMAINS WITH THE DESIGN ENGINEER. THE CITY OF ROCKWALL, IN REVIEWING AND RELEASING PLANS FOR CONSTRUCTION, ASSUMES NO RESPONSIBILITY FOR ADEQUACY OR ACCURACY OF DESIGN.
- REFER TO SHEET C04-15 FOR GROUTED RIP-RAP DETAIL.
- REFER TO SHEET C06-02 FOR TXDOT SETP-PD DETAIL.

APPLICANT INFORMATION

BOB LEIMBERG
CLAYCO
2199 INNERBELT BUSINESS CENTER DR.
ST. LOUIS, MO 63114
314.592.2234 office
314.713.7874 mobile
leimberg@claycorp.com







OWNER INFORMATION

ALAN YU
LOLLICUP USA
6185 KIMBALL AVE.
CHINO, CA 91708
626.965.8882 x110 office
626.226.8556 mobile
alan.yu@lolicup.com

PROJECT NAME

LOLLICUP USA WAREHOUSE
CASE NUMBER:

DRAWING ISSUE	
DESCRIPTION	DATE
ENGINEERING SUBMITTAL CITY OF ROCKWALL	2/2/2018
ENGINEERING REVIEW 2ND SUBMITTAL	3/2/2018
ENGINEERING REVIEW 3RD SUBMITTAL	3/23/2018
ISSUED FOR CONSTRUCTION	4/10/2018
SD RFIS	6/13/2018
RECORD DRAWING	3/6/2019
DRAWING TITLE STORM DRAIN LINE D-2 PLAN AND PROFILE	
DRAWING NO. C04-13	
Forum #	601-03049
Consult #	101-03049

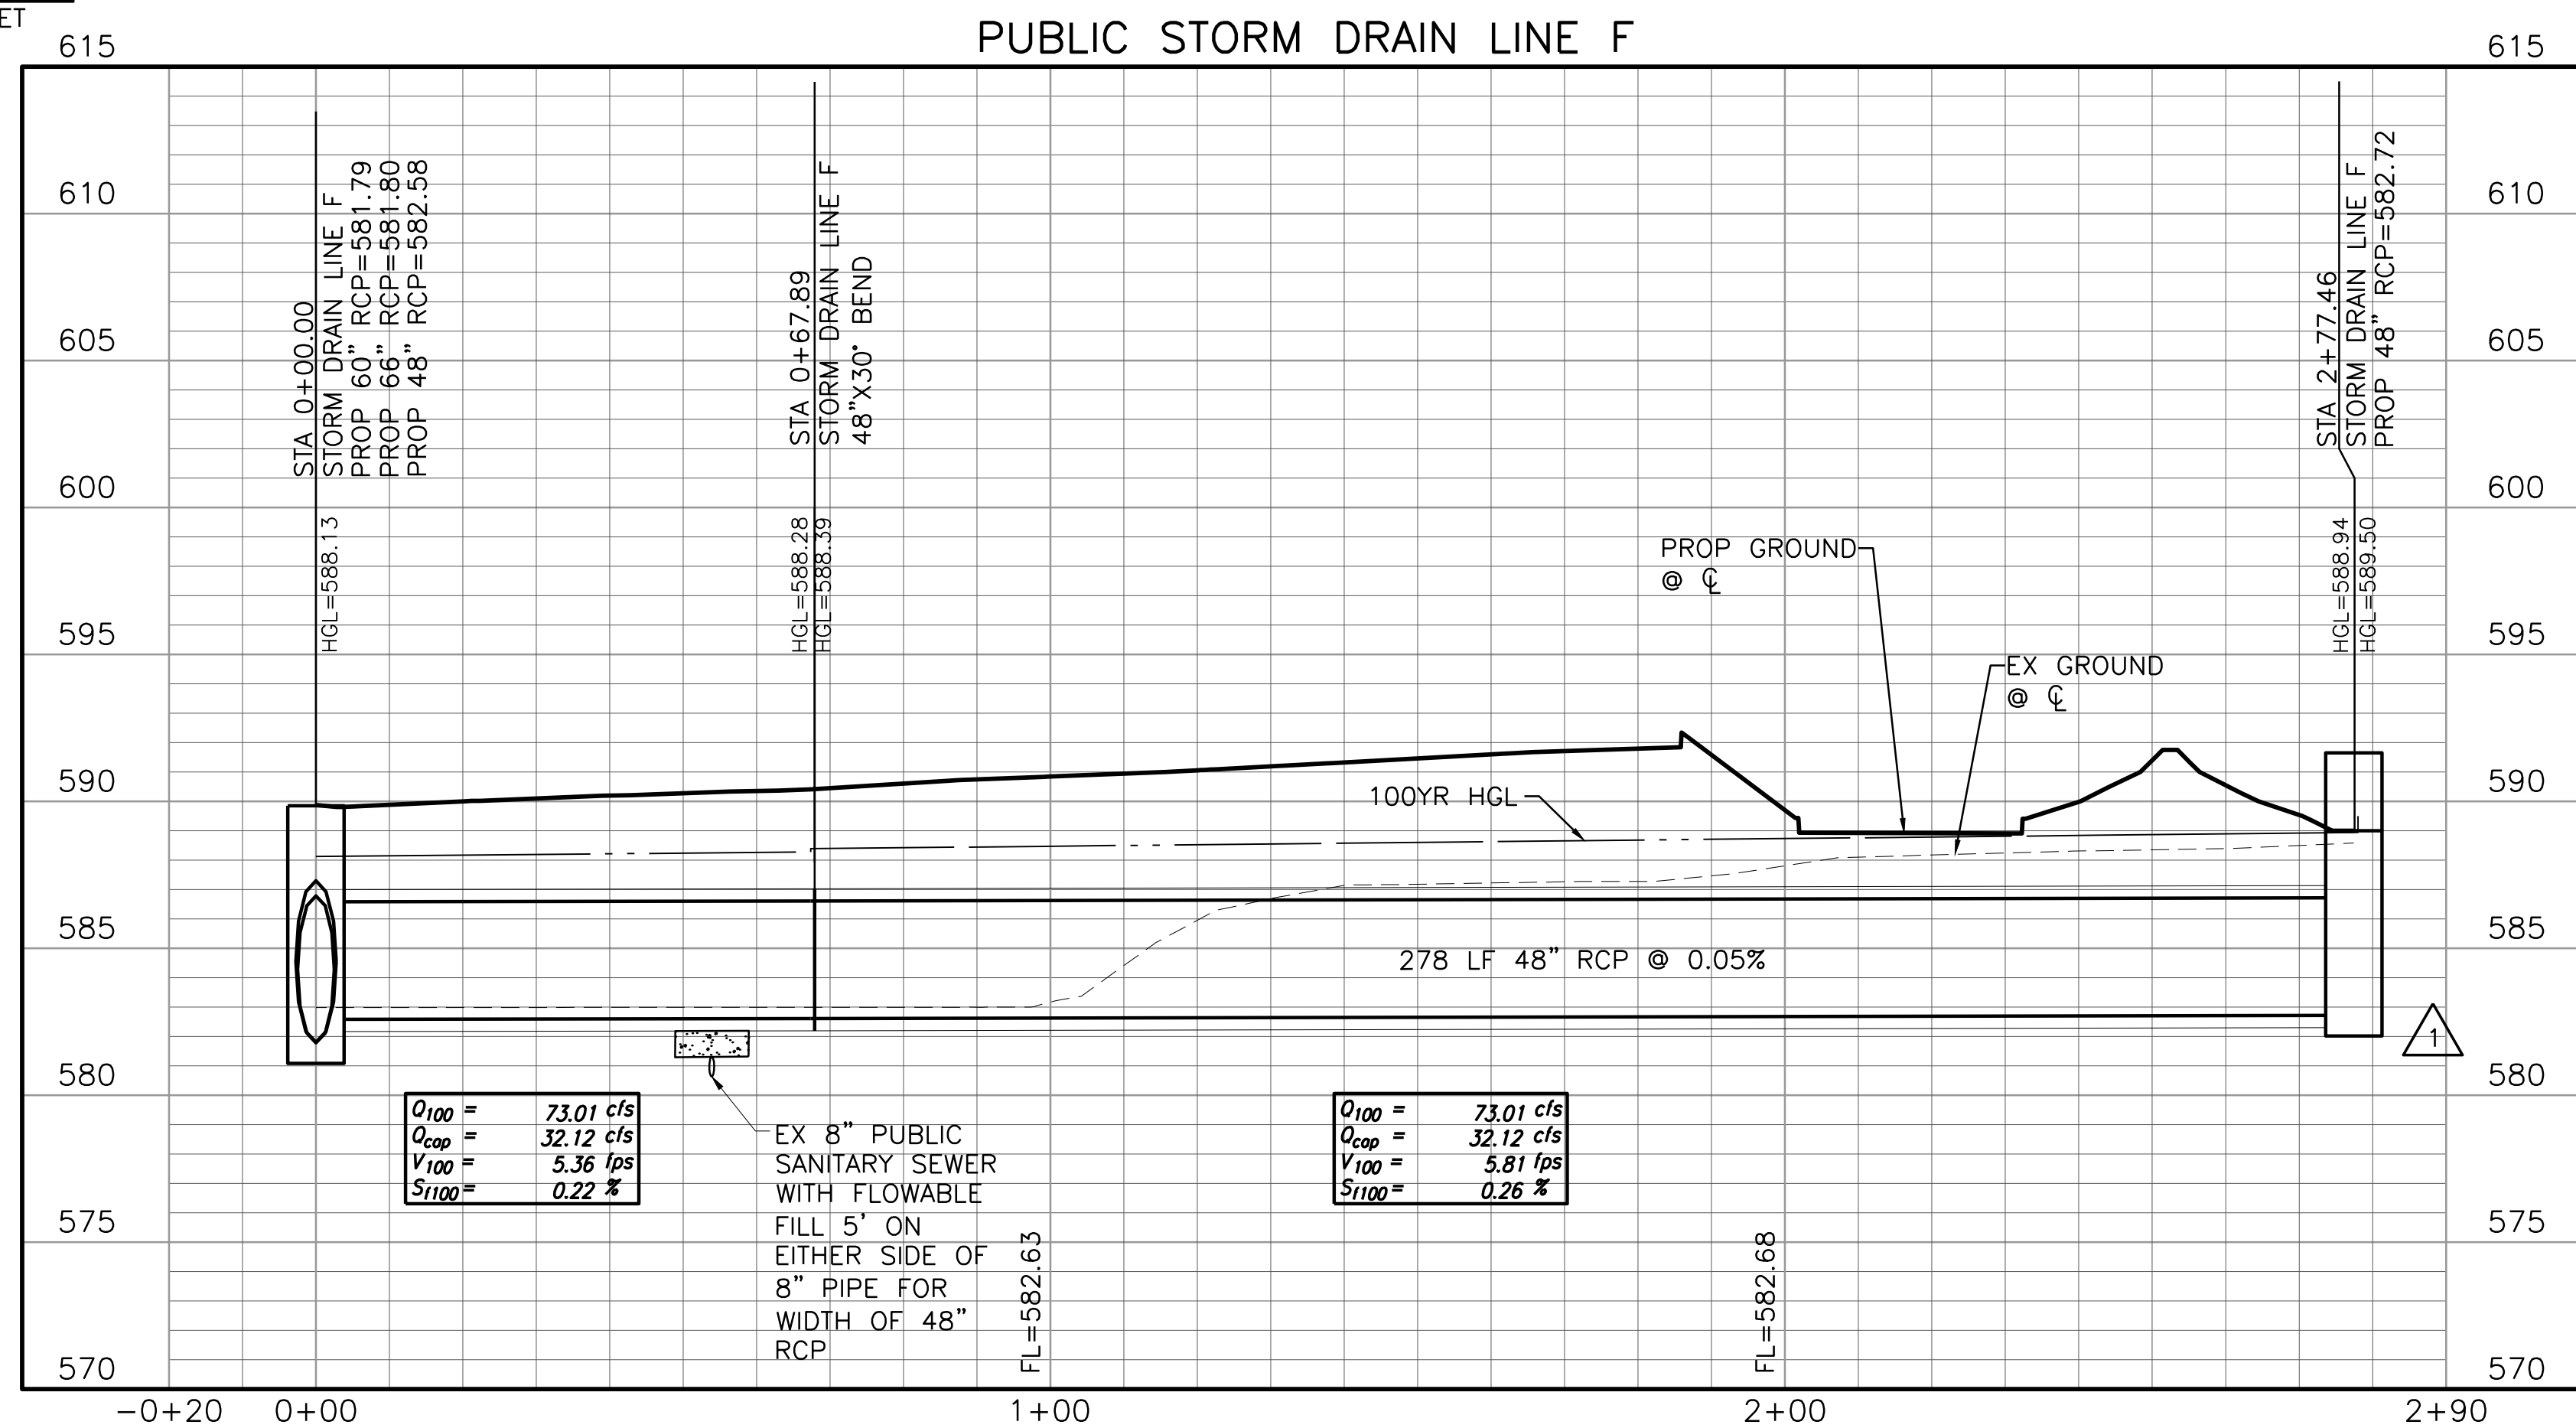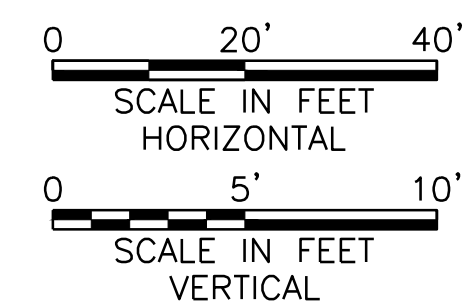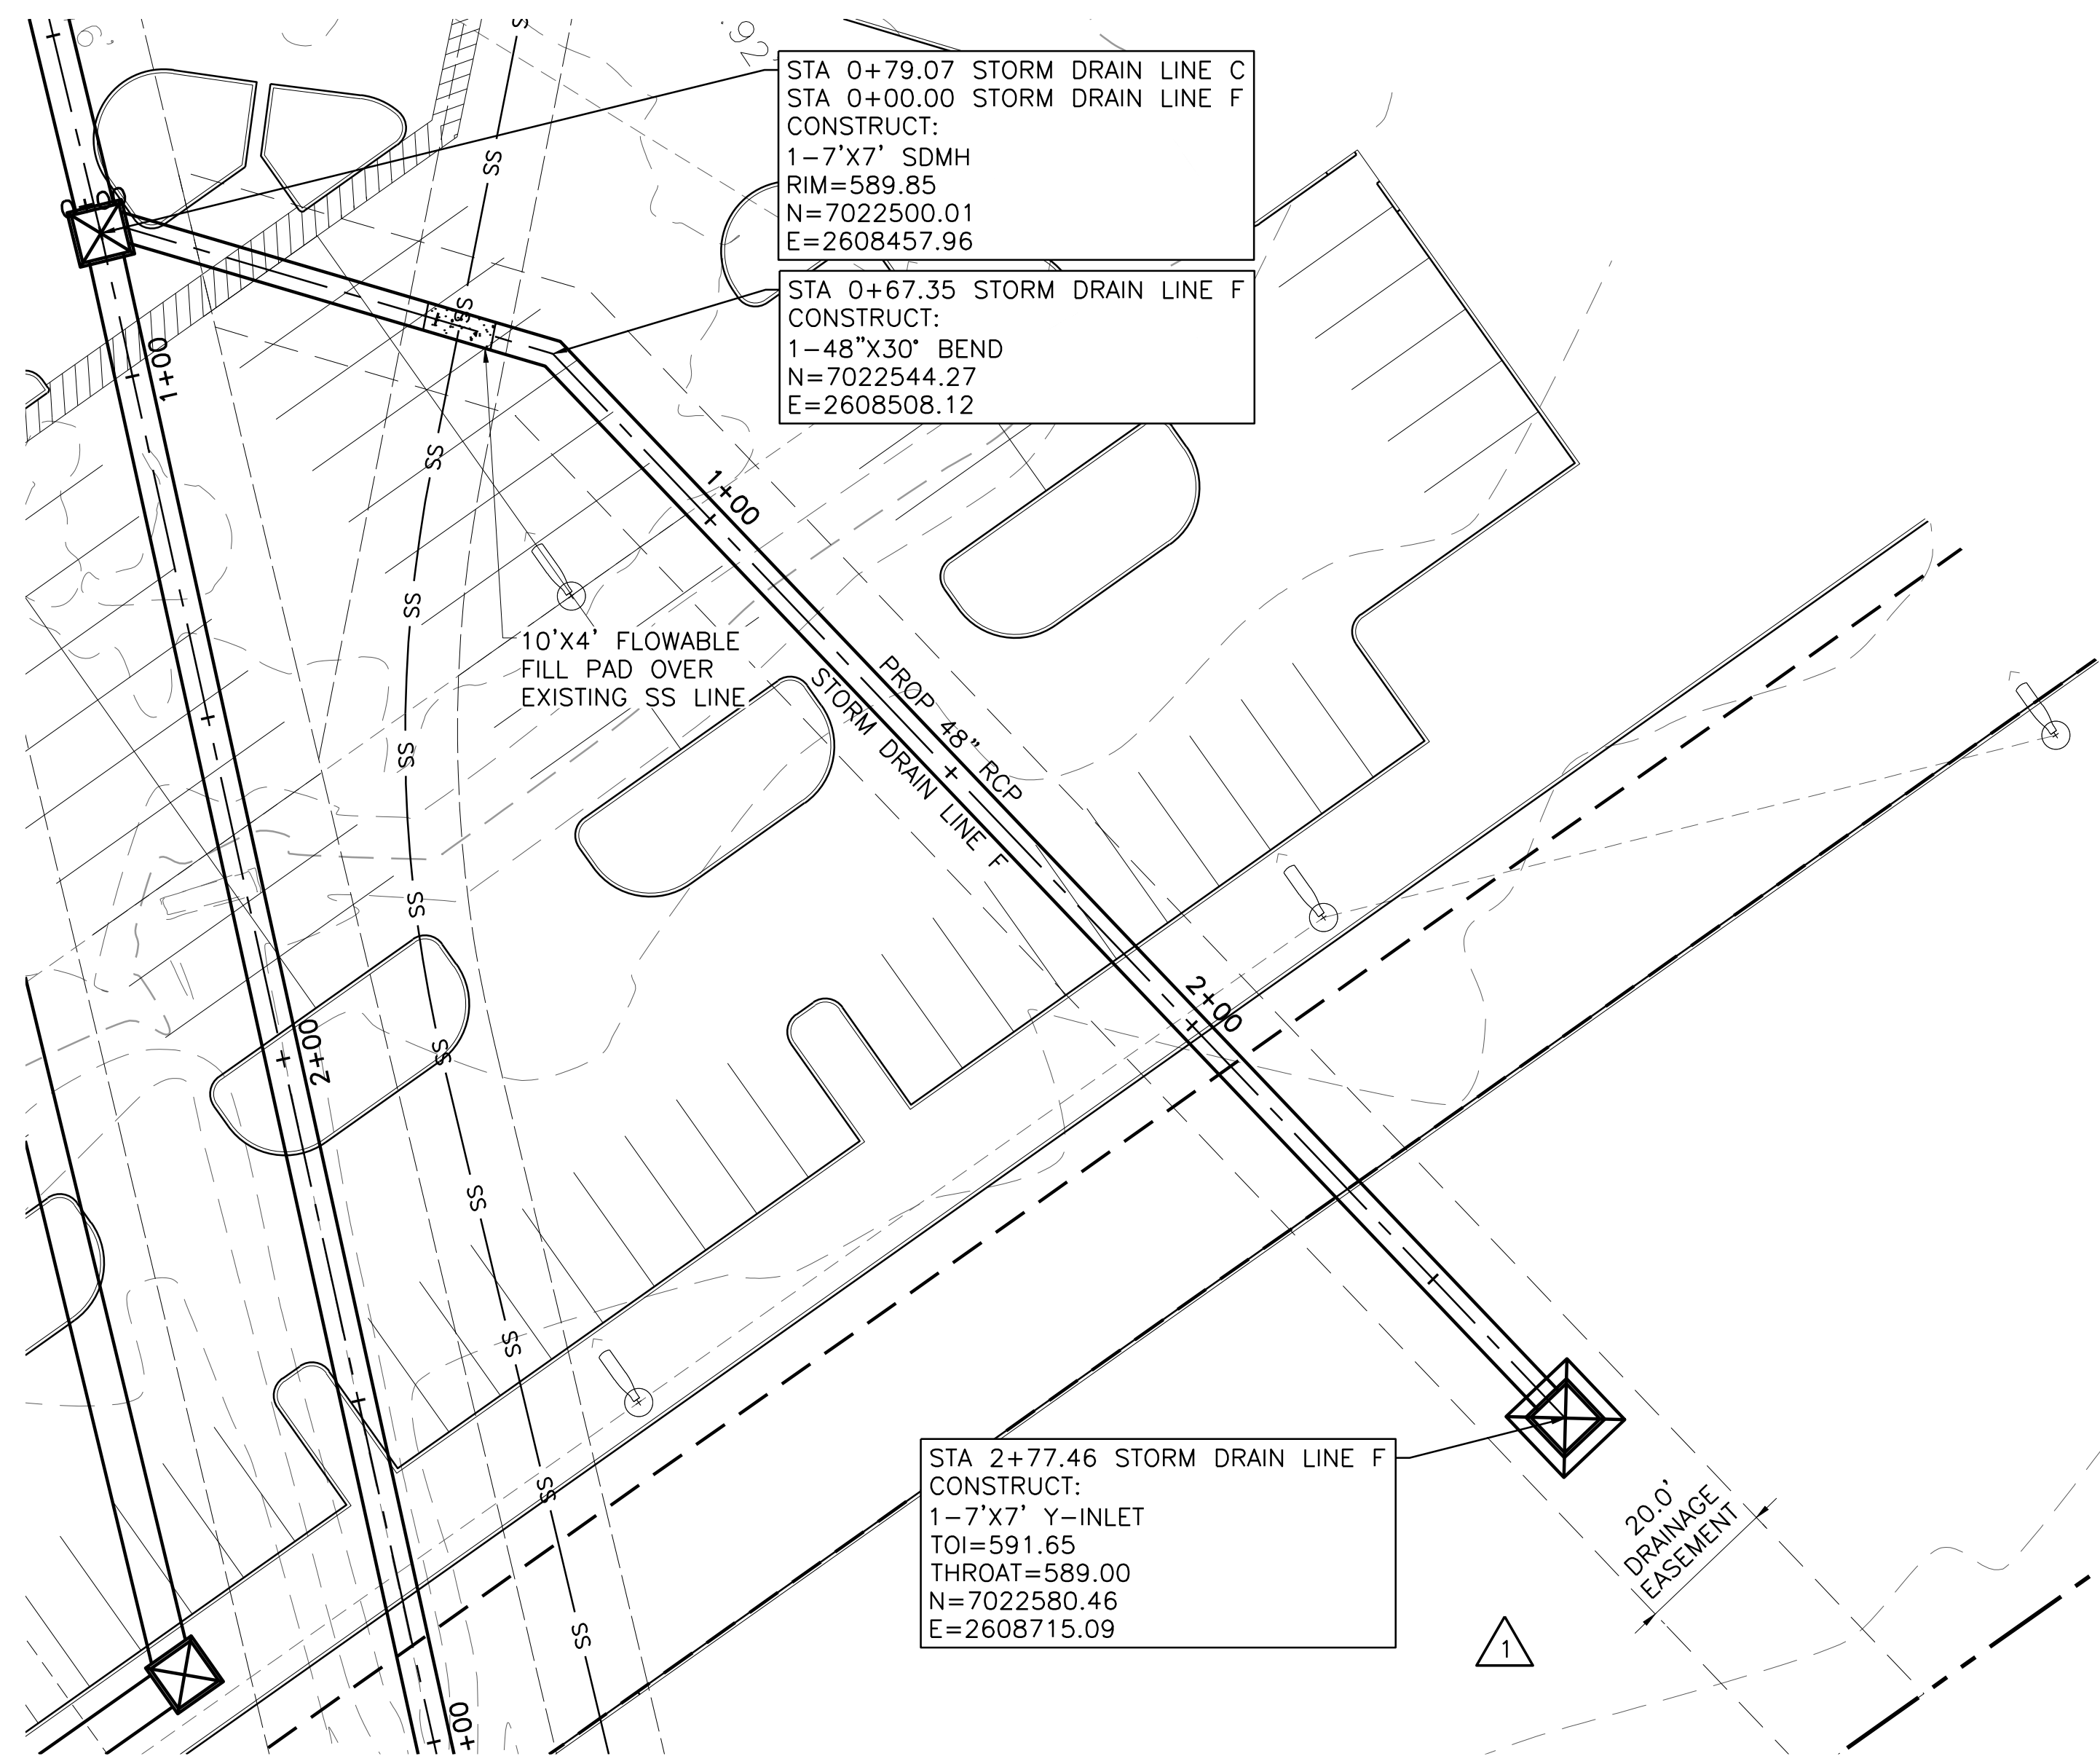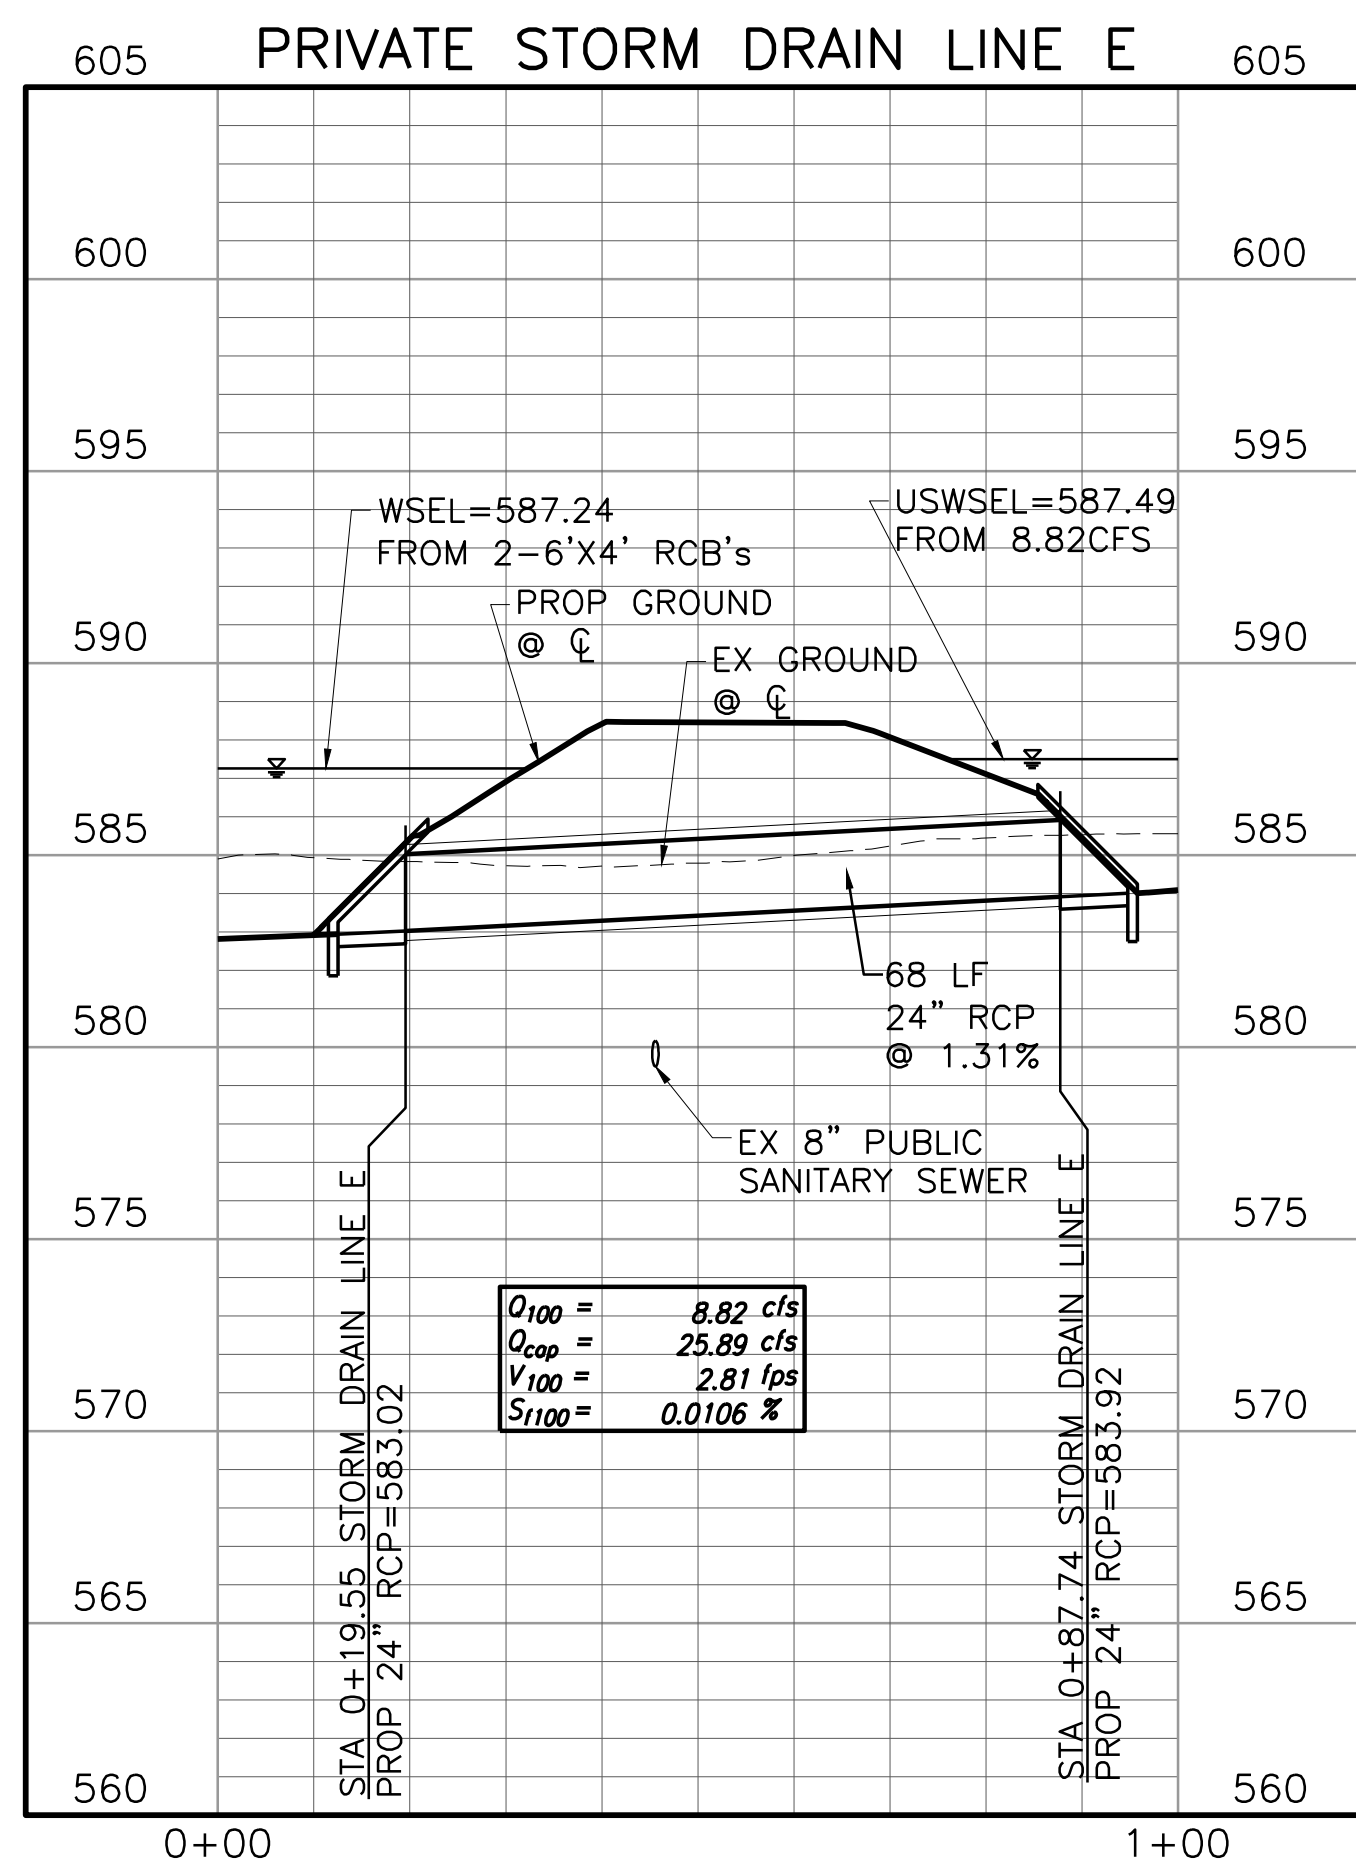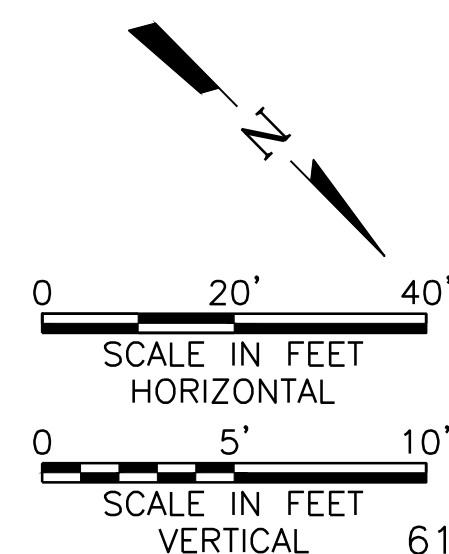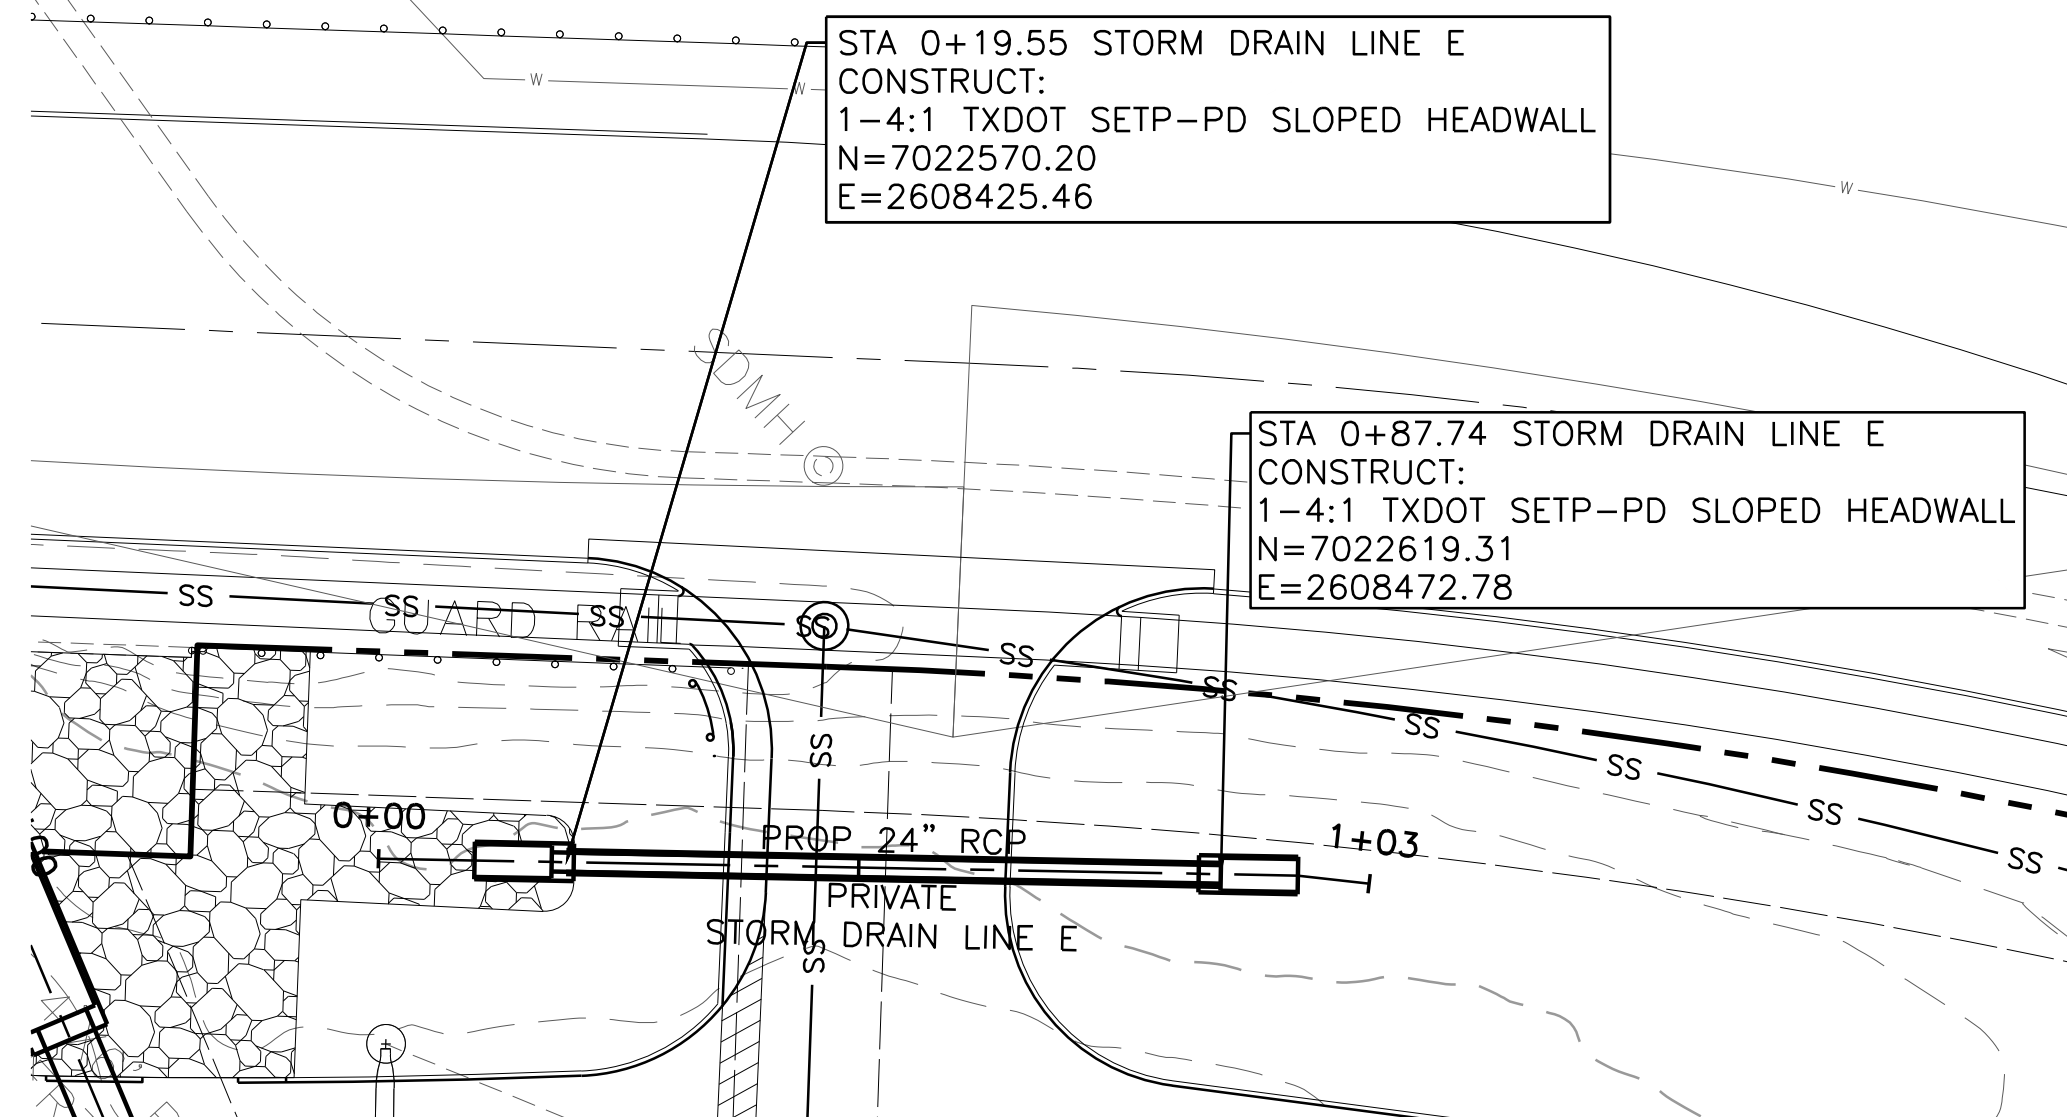

BENCHMARKS:

BENCHMARK A--AN "X" CUT IN THE CENTER OF THE SIDEWALK AT THE END OF THE HANDICAP RAMP AT THE SOUTHEAST CORNER OF THE INTERSECTION OF DISCOVERY BLVD. AND DATA DR., 11 FEET SOUTHEAST OF THE CURB LINE.
ELEV=600.44

BENCHMARK B--AN "X" CUT ON THE CURB ON THE NORTH SIDE OF DISCOVERY BLVD. 580 FEET EAST OF CORPORATE CROSSING, 11 FEET SOUTHEAST OF A FIRE HYDRANT, AND 19 FEET NORTHEAST OF TWO (2) WATER VALVES.
ELEV=599.67

NOTES

1. ALL RESPONSIBILITY FOR ADEQUACY OF DESIGN REMAINS WITH THE DESIGN ENGINEER. THE CITY OF ROCKWALL, IN REVIEWING AND RELEASING PLANS FOR CONSTRUCTION, ASSUMES NO RESPONSIBILITY FOR ADEQUACY OR ACCURACY OF DESIGN.
2. REFER TO SHEET C04-15 FOR GROUTED RIP-RAP DETAIL.
3. REFER TO SHEET C06-02 FOR TXDOT SETP-PD DETAIL.

THE SEAL THAT ORIGINALLY APPEARED ON THIS DOCUMENT
 WAS AUTHORIZED BY BRETT M. BRISTOW P.E.
 TEXAS NO: 101000 ON 6/13/2018
 ALTERATION OF A SEALED DOCUMENT WITHOUT PROPER
 NOTIFICATION OF THE RESPONSIBLE ENGINEER IS AN
 OFFENSE UNDER THE TEXAS ENGINEERING PRACTICE ACT.

This Record Drawing is a combination of the sealed engineering contract drawings for this project, modified by information furnished by the contractor reflecting changes in the Project made during construction. The original sealed drawings are on file at the offices of
FRESE AND NICHOLS, INC.
RECORD DRAWINGS PREPARED ON:
3/6/2019

CLAYCO
THE ART & SCIENCE OF BUILDING
12199 INNERBELT BUSINESS CENTER DRIVE
ST. LOUIS, MISSOURI 63114
Ph 314.429.5100 Fx 314.429.3137

ARCHITECT

FORUM

2199 INNERBELT BUSINESS CENTER DRIVE
ST. LOUIS, MISSOURI 63114
Ph 314.429.1010 Fx 314.429.7770

CONTRACTOR / DEVELOPER
CLAYCO

LANDSCAPE ARCHITECT
FORUM

CIVIL ENGINEER

STRUCTURAL ENGINEER

MECHANICAL ENGINEER


ELECTRICAL ENGINEER

PLUMBING ENGINEER

FIRE PROTECTION ENGINEER

Lollicup
ROCKWALL TECHNOLOGY PARK
ROCKWALL, TEXAS

DRAWING ISSUE
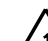
<div>APPLICANT INFORMATION</div> <div>BOB LEIMBERG CLAYCO 2199 INNERBELT BUSINESS CENTER DR. ST. LOUIS, MO 63114 314.592.2234 office 314.713.7874 mobile leimbergb@claycorp.com</div>		DESCRIPTION		DATE		
		ENGINEERING SUBMITTAL CITY OF ROCKWALL		2/2/2018		
		ENGINEERING REVIEW 2ND SUBMITTAL		3/2/2018		
		ENGINEERING REVIEW 3RD SUBMITTAL		3/23/2018		
		ISSUED FOR CONSTRUCTION		4/10/2018		
<div>OWNER INFORMATION</div> <div>ALAN YU LOLLICUP USA 6185 KIMBALL AVE. CHINO, CA 91708 626.965.8882 x110 office 626.226.8556 mobile alan.yu@lollipuc.com</div>		SD RF1'S 		6/13/2018		
		RECORD DRAWING		3/6/2019		
		<div>DRAWING TITLE</div> <div>STORM DRAIN LINE E AND F PLAN AND PROFILE</div>				
<div>PROJECT NAME</div> <div>LOLLICUP USA WAREHOUSE CASE NUMBER:</div>		DRAWING NO.				
		<div>C04-14</div>				
		Forum #		601-03049	Consult.#	101-03049

12/2/2017 1:31:05 PM

Copyright © 2017 Forum Studio, Inc.







E

D

C

B

A

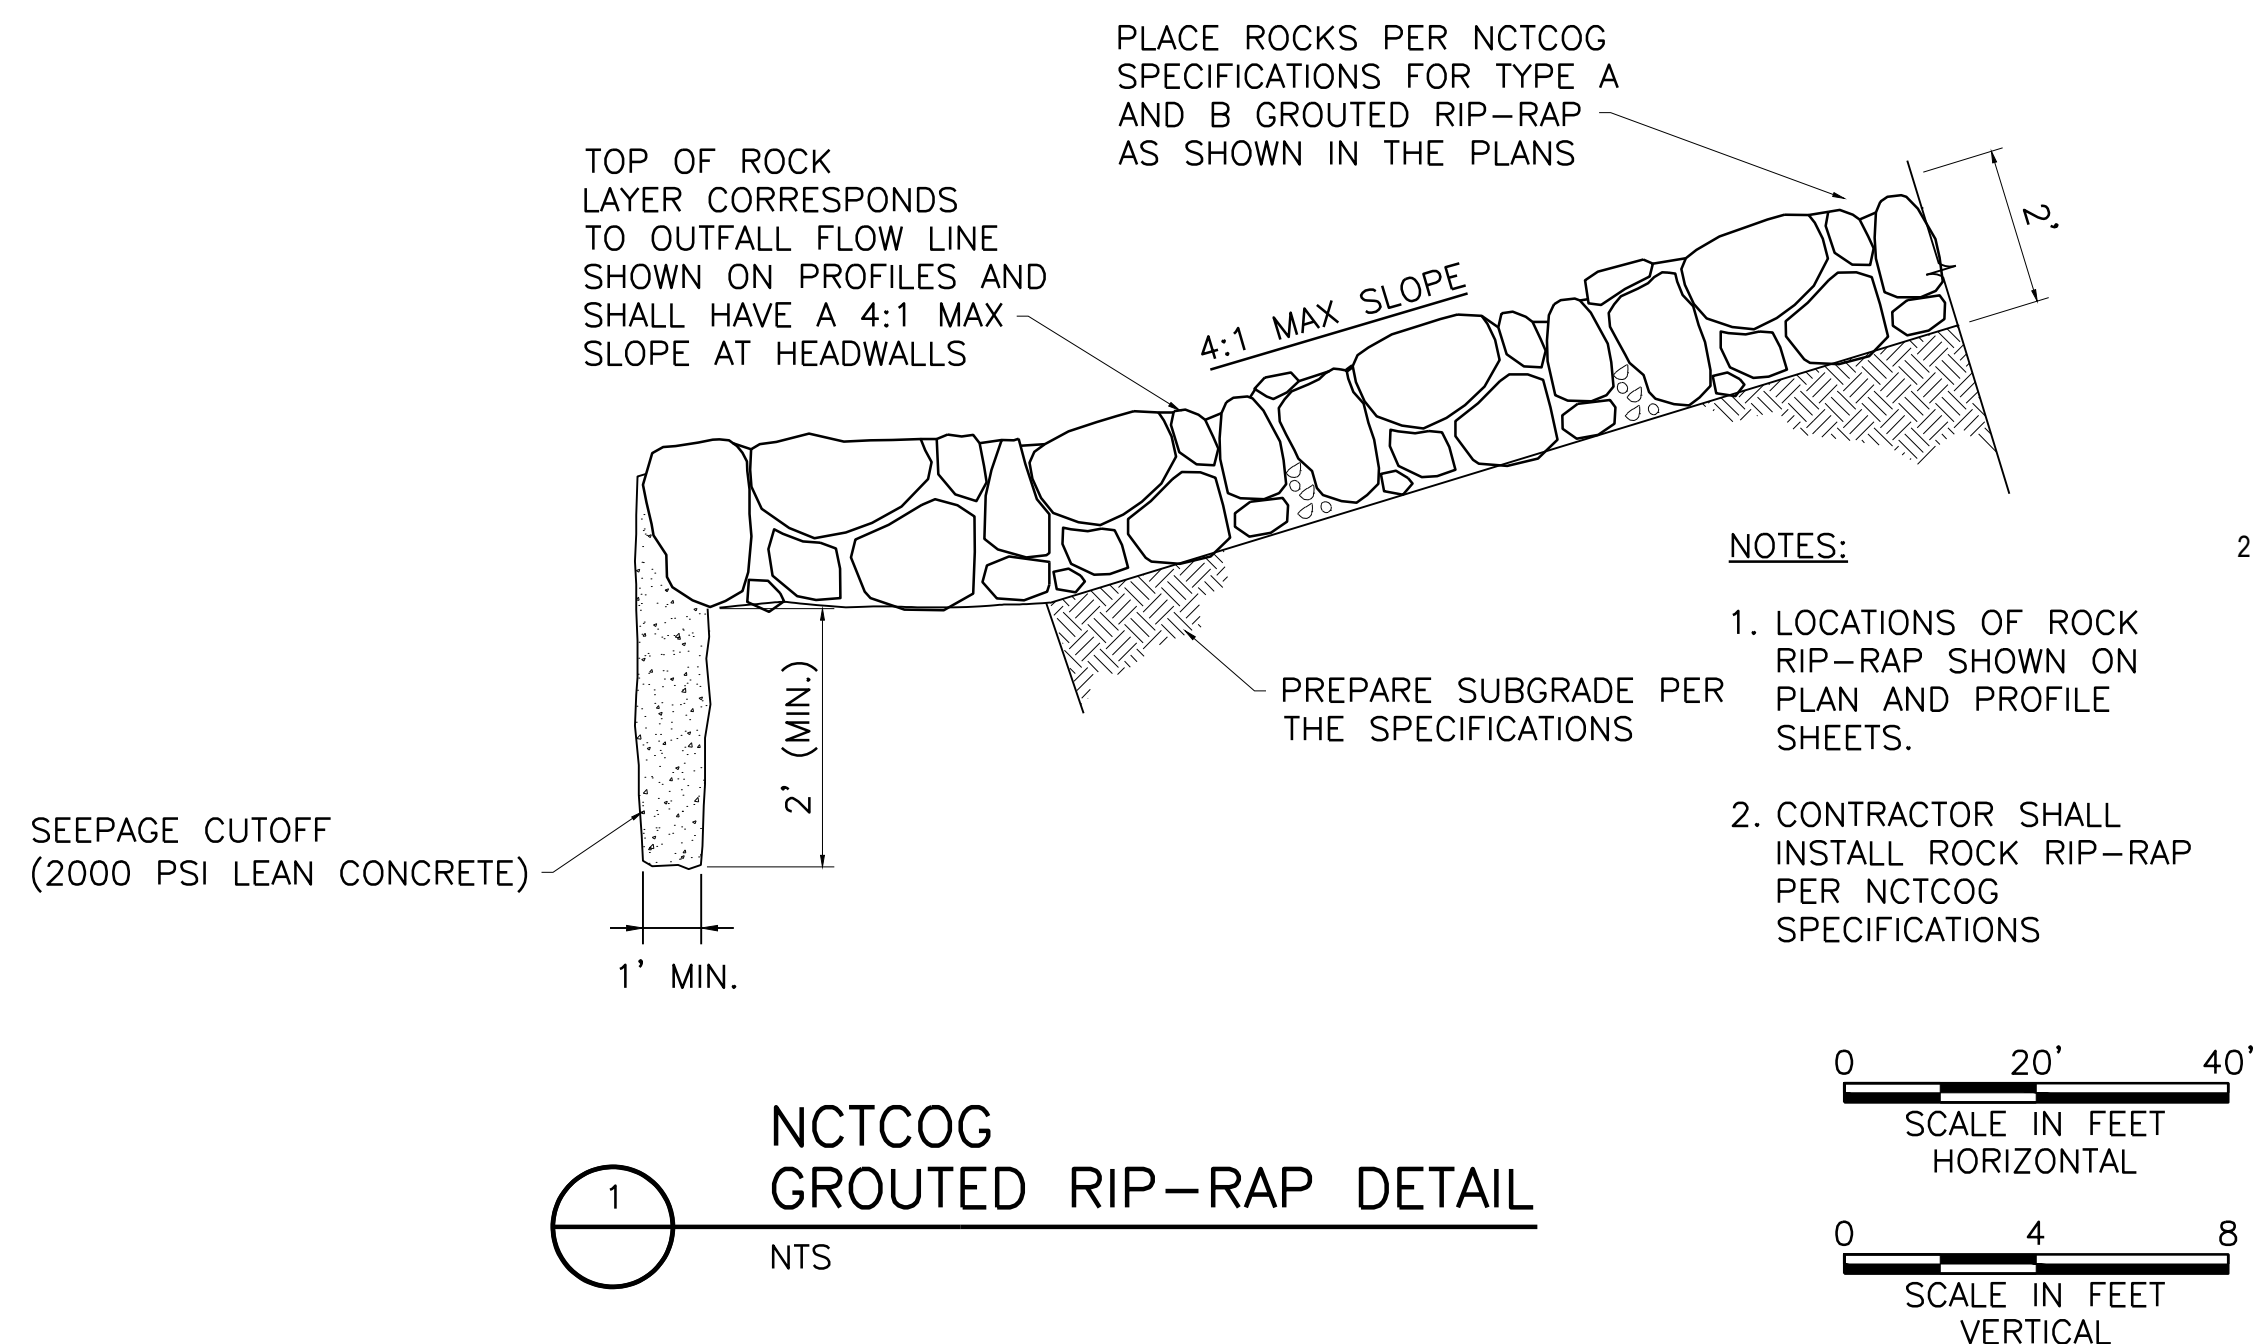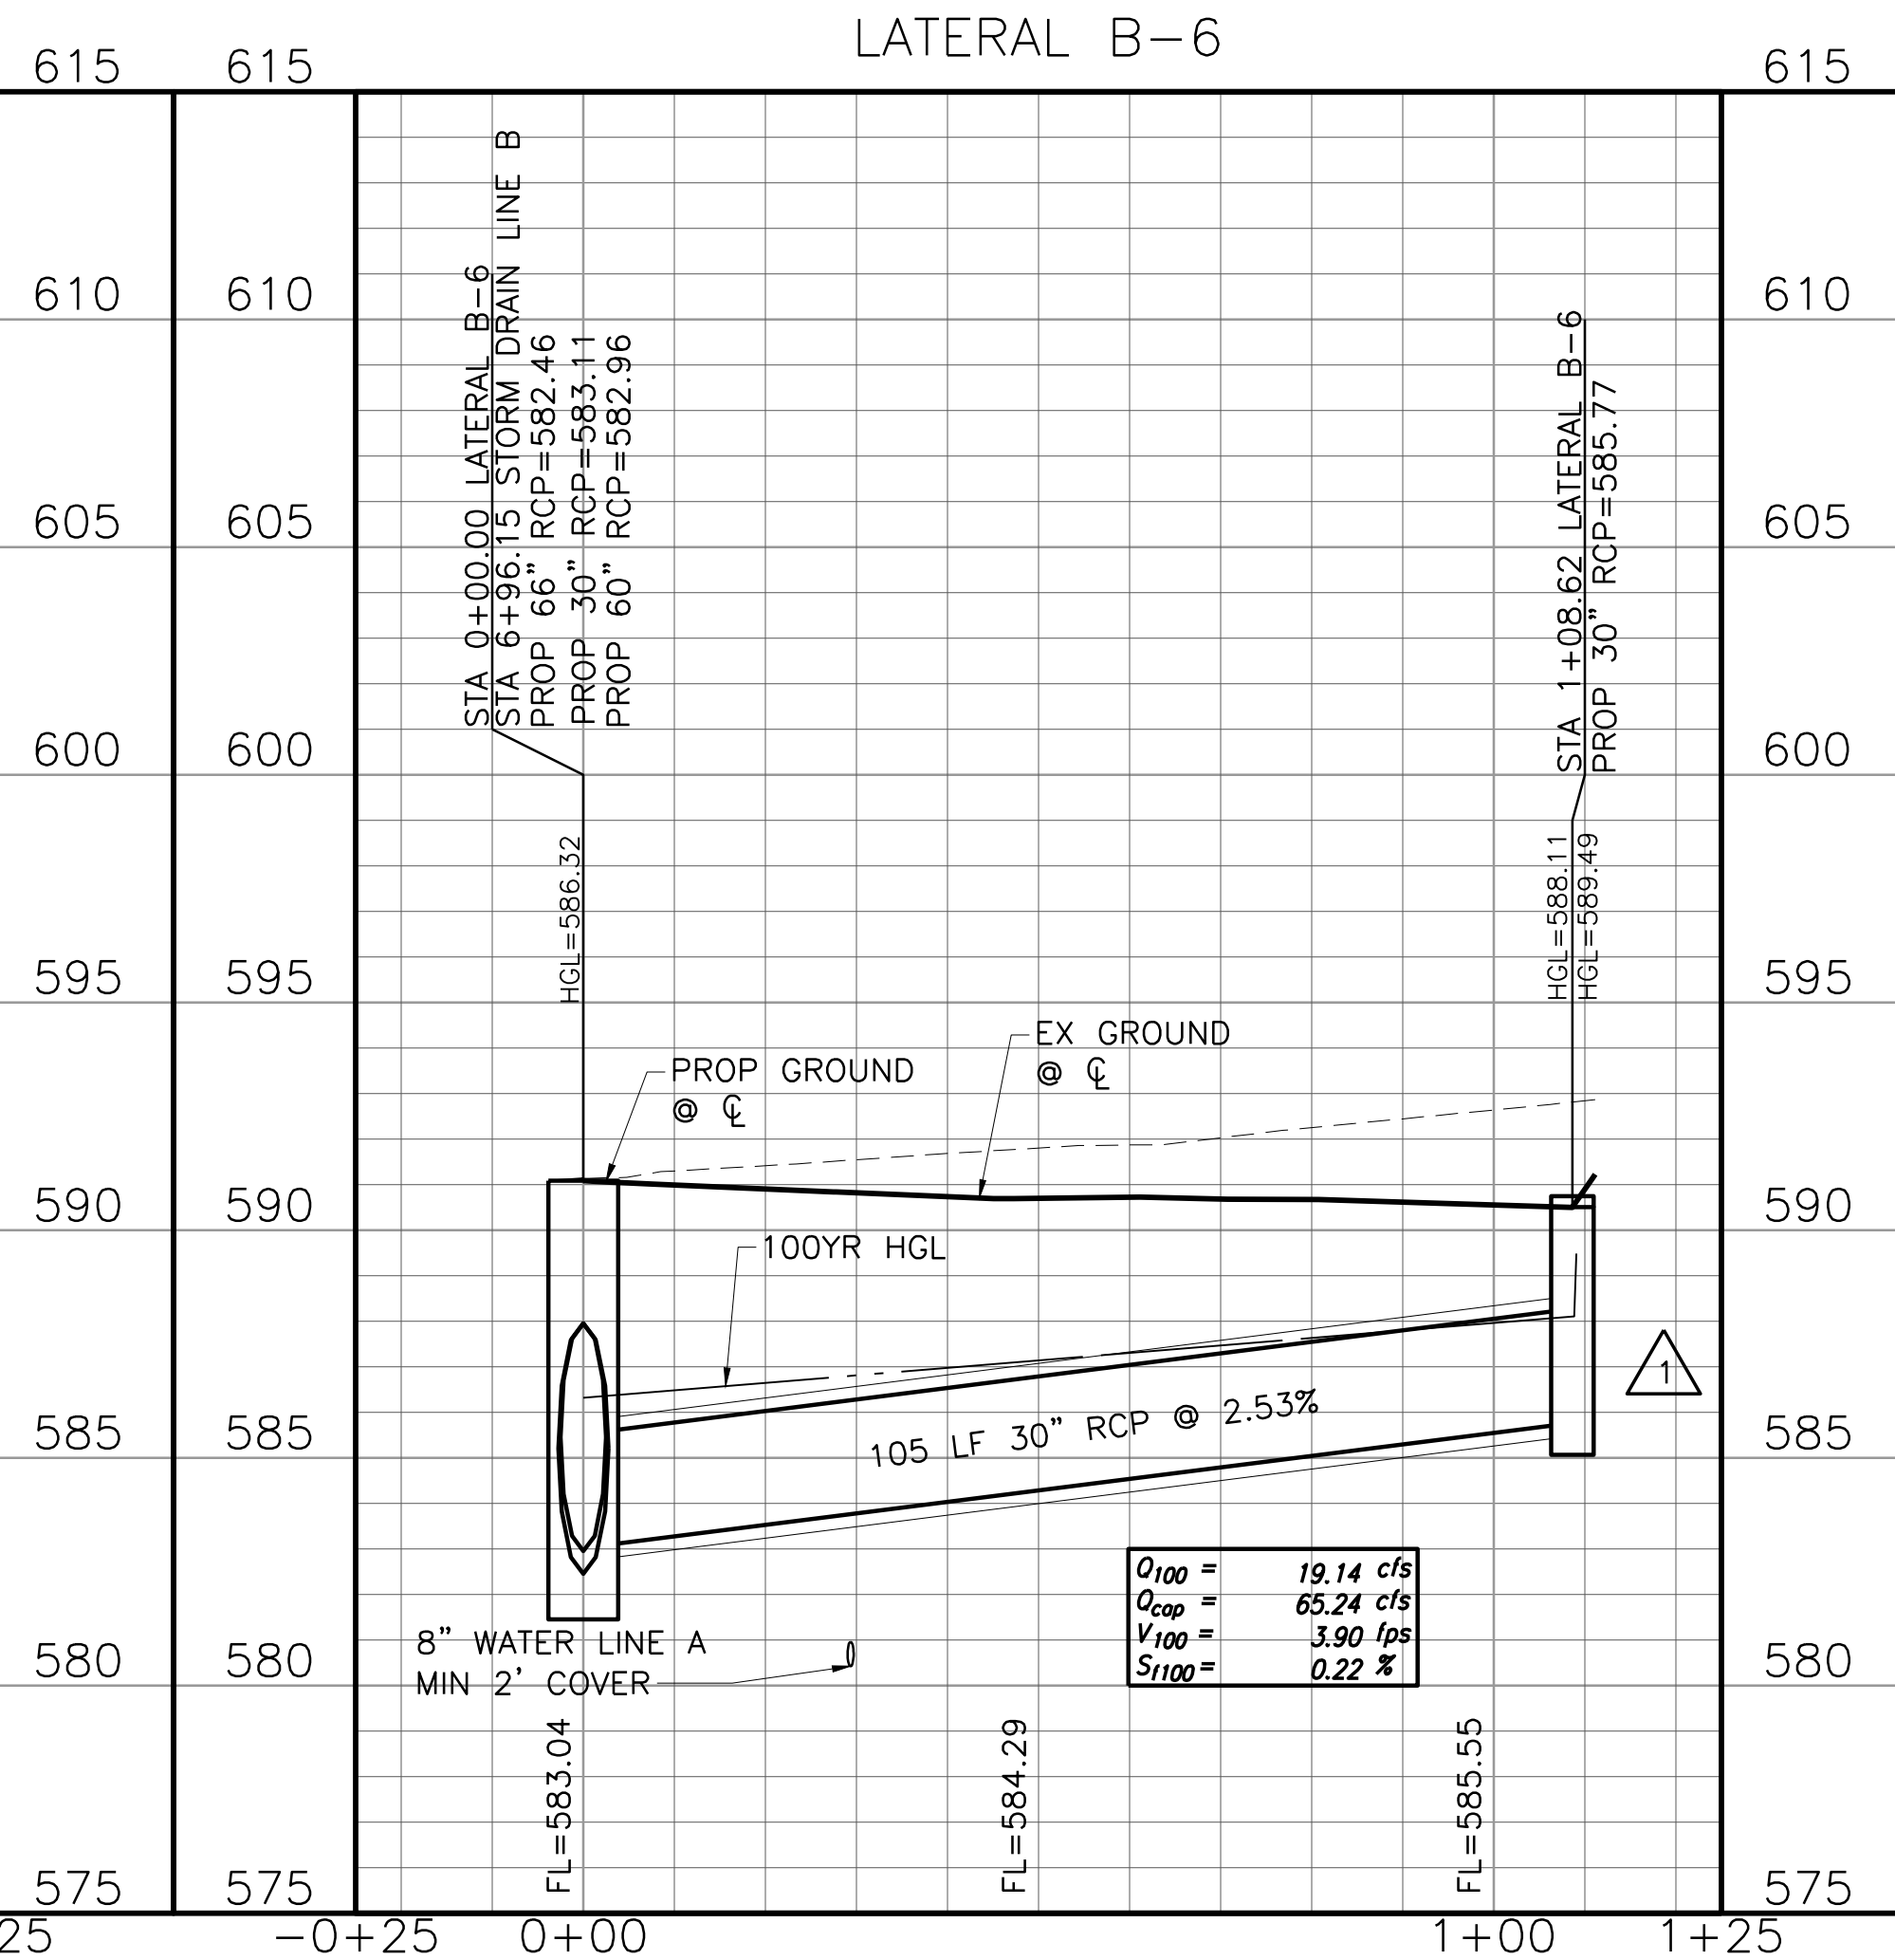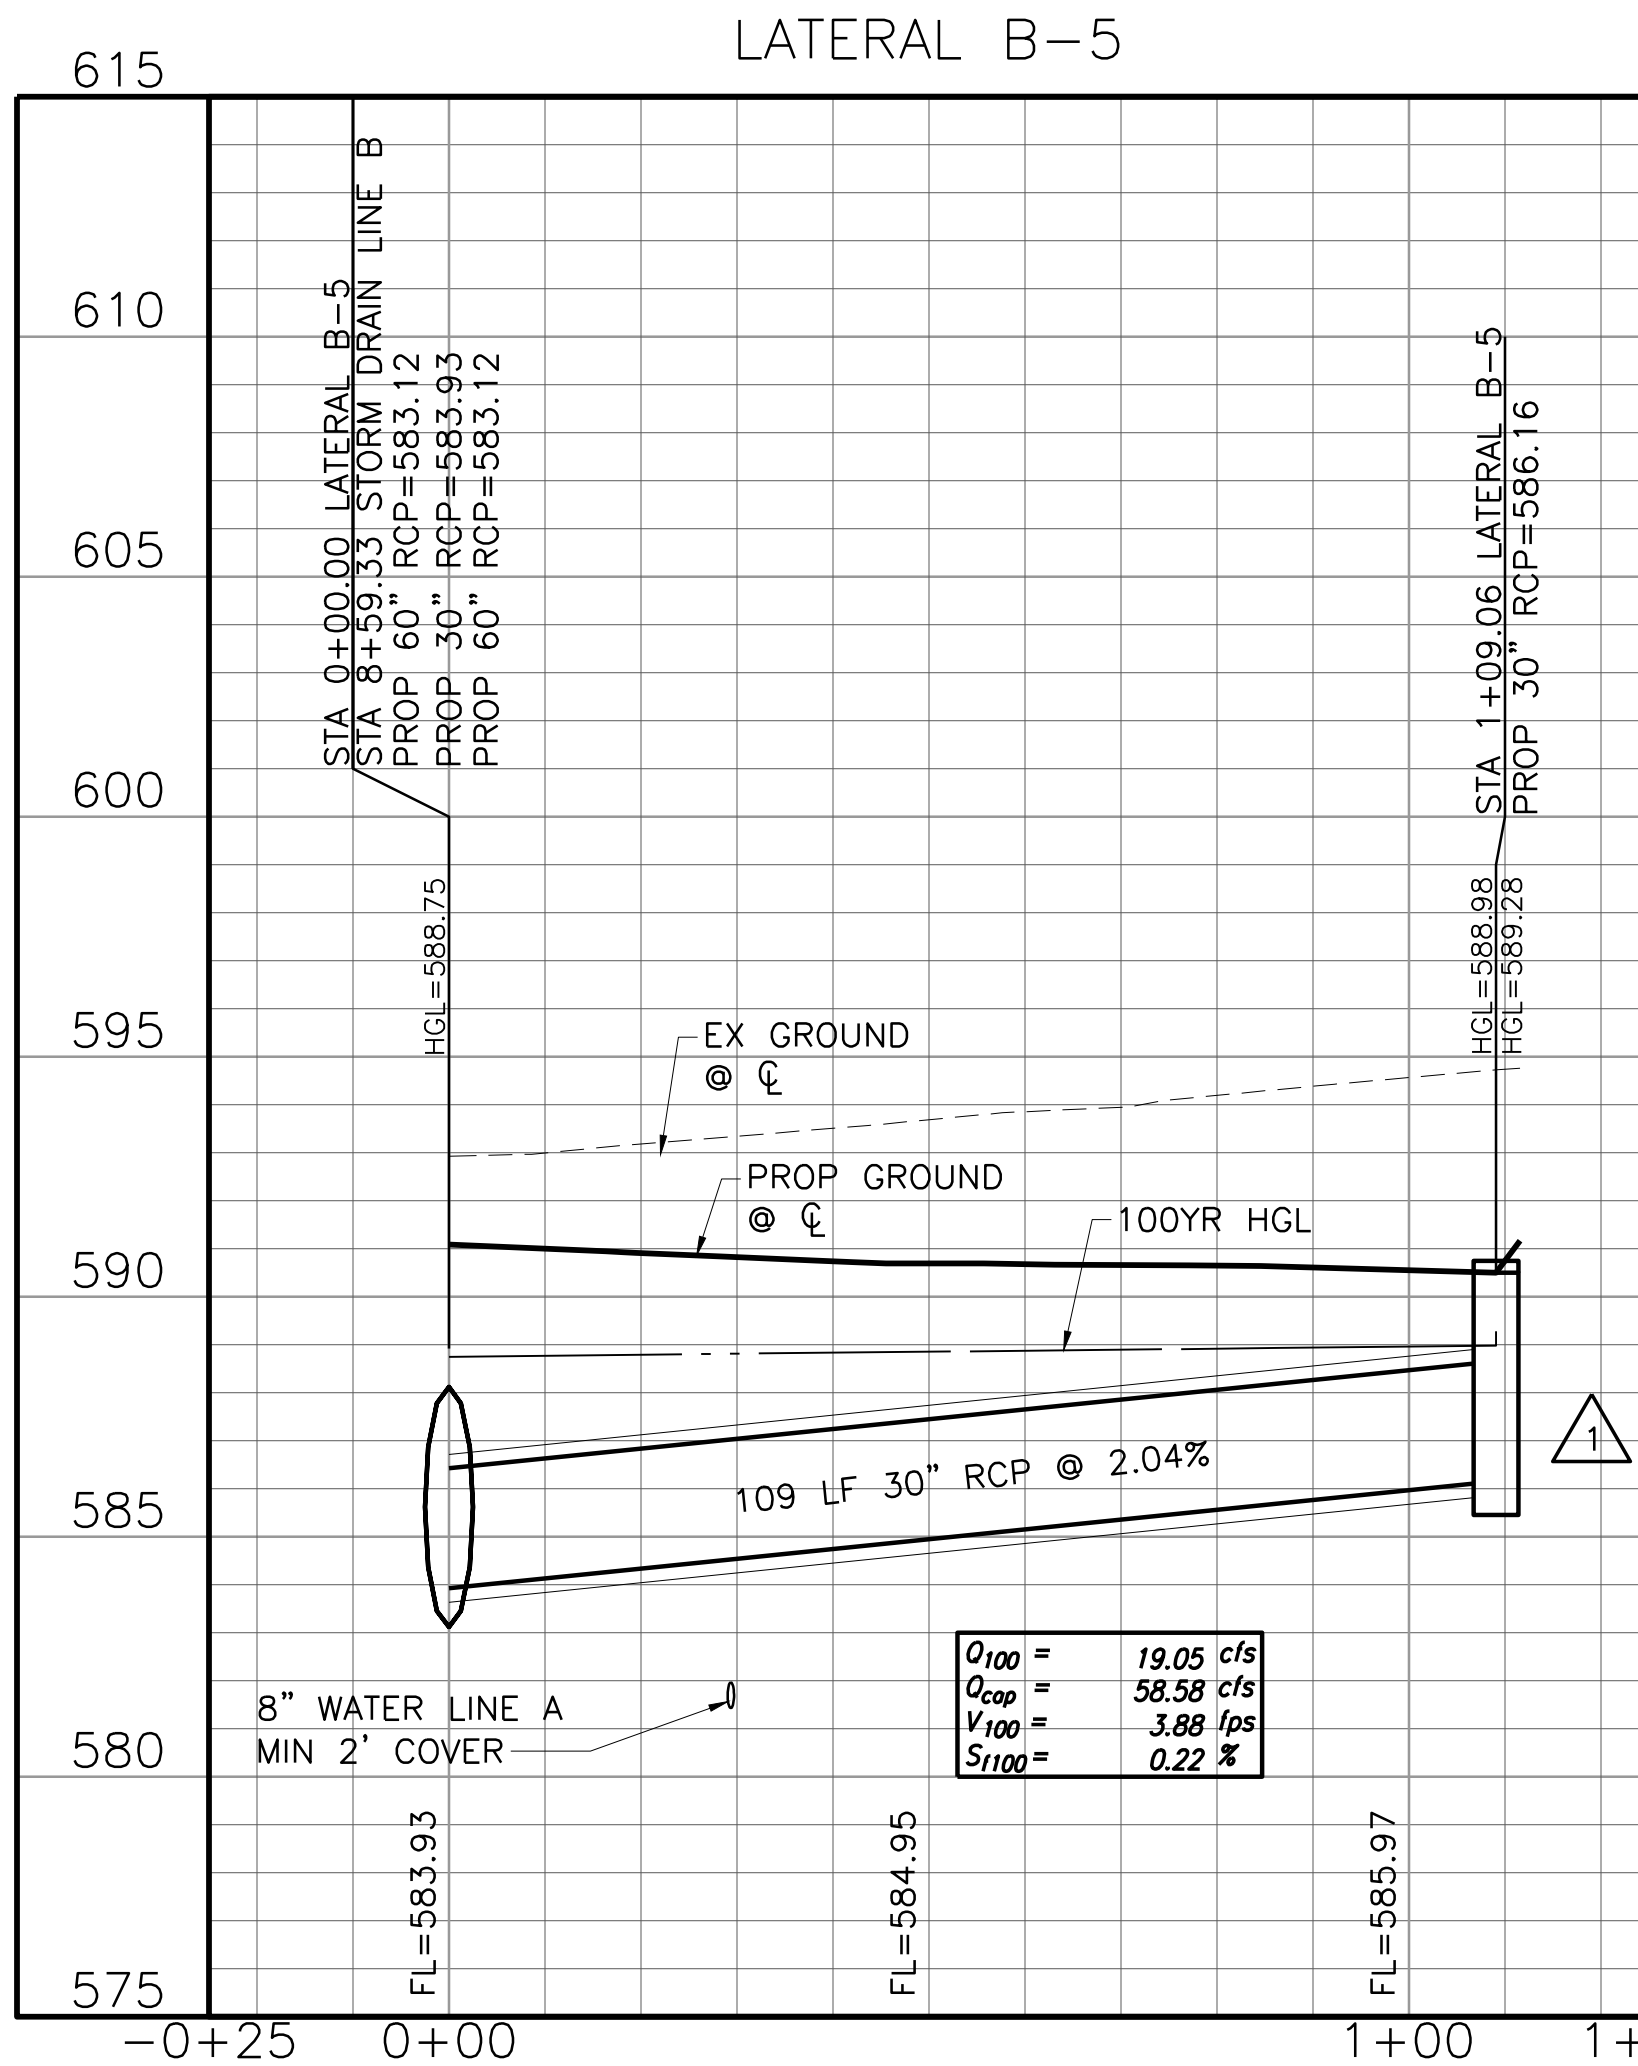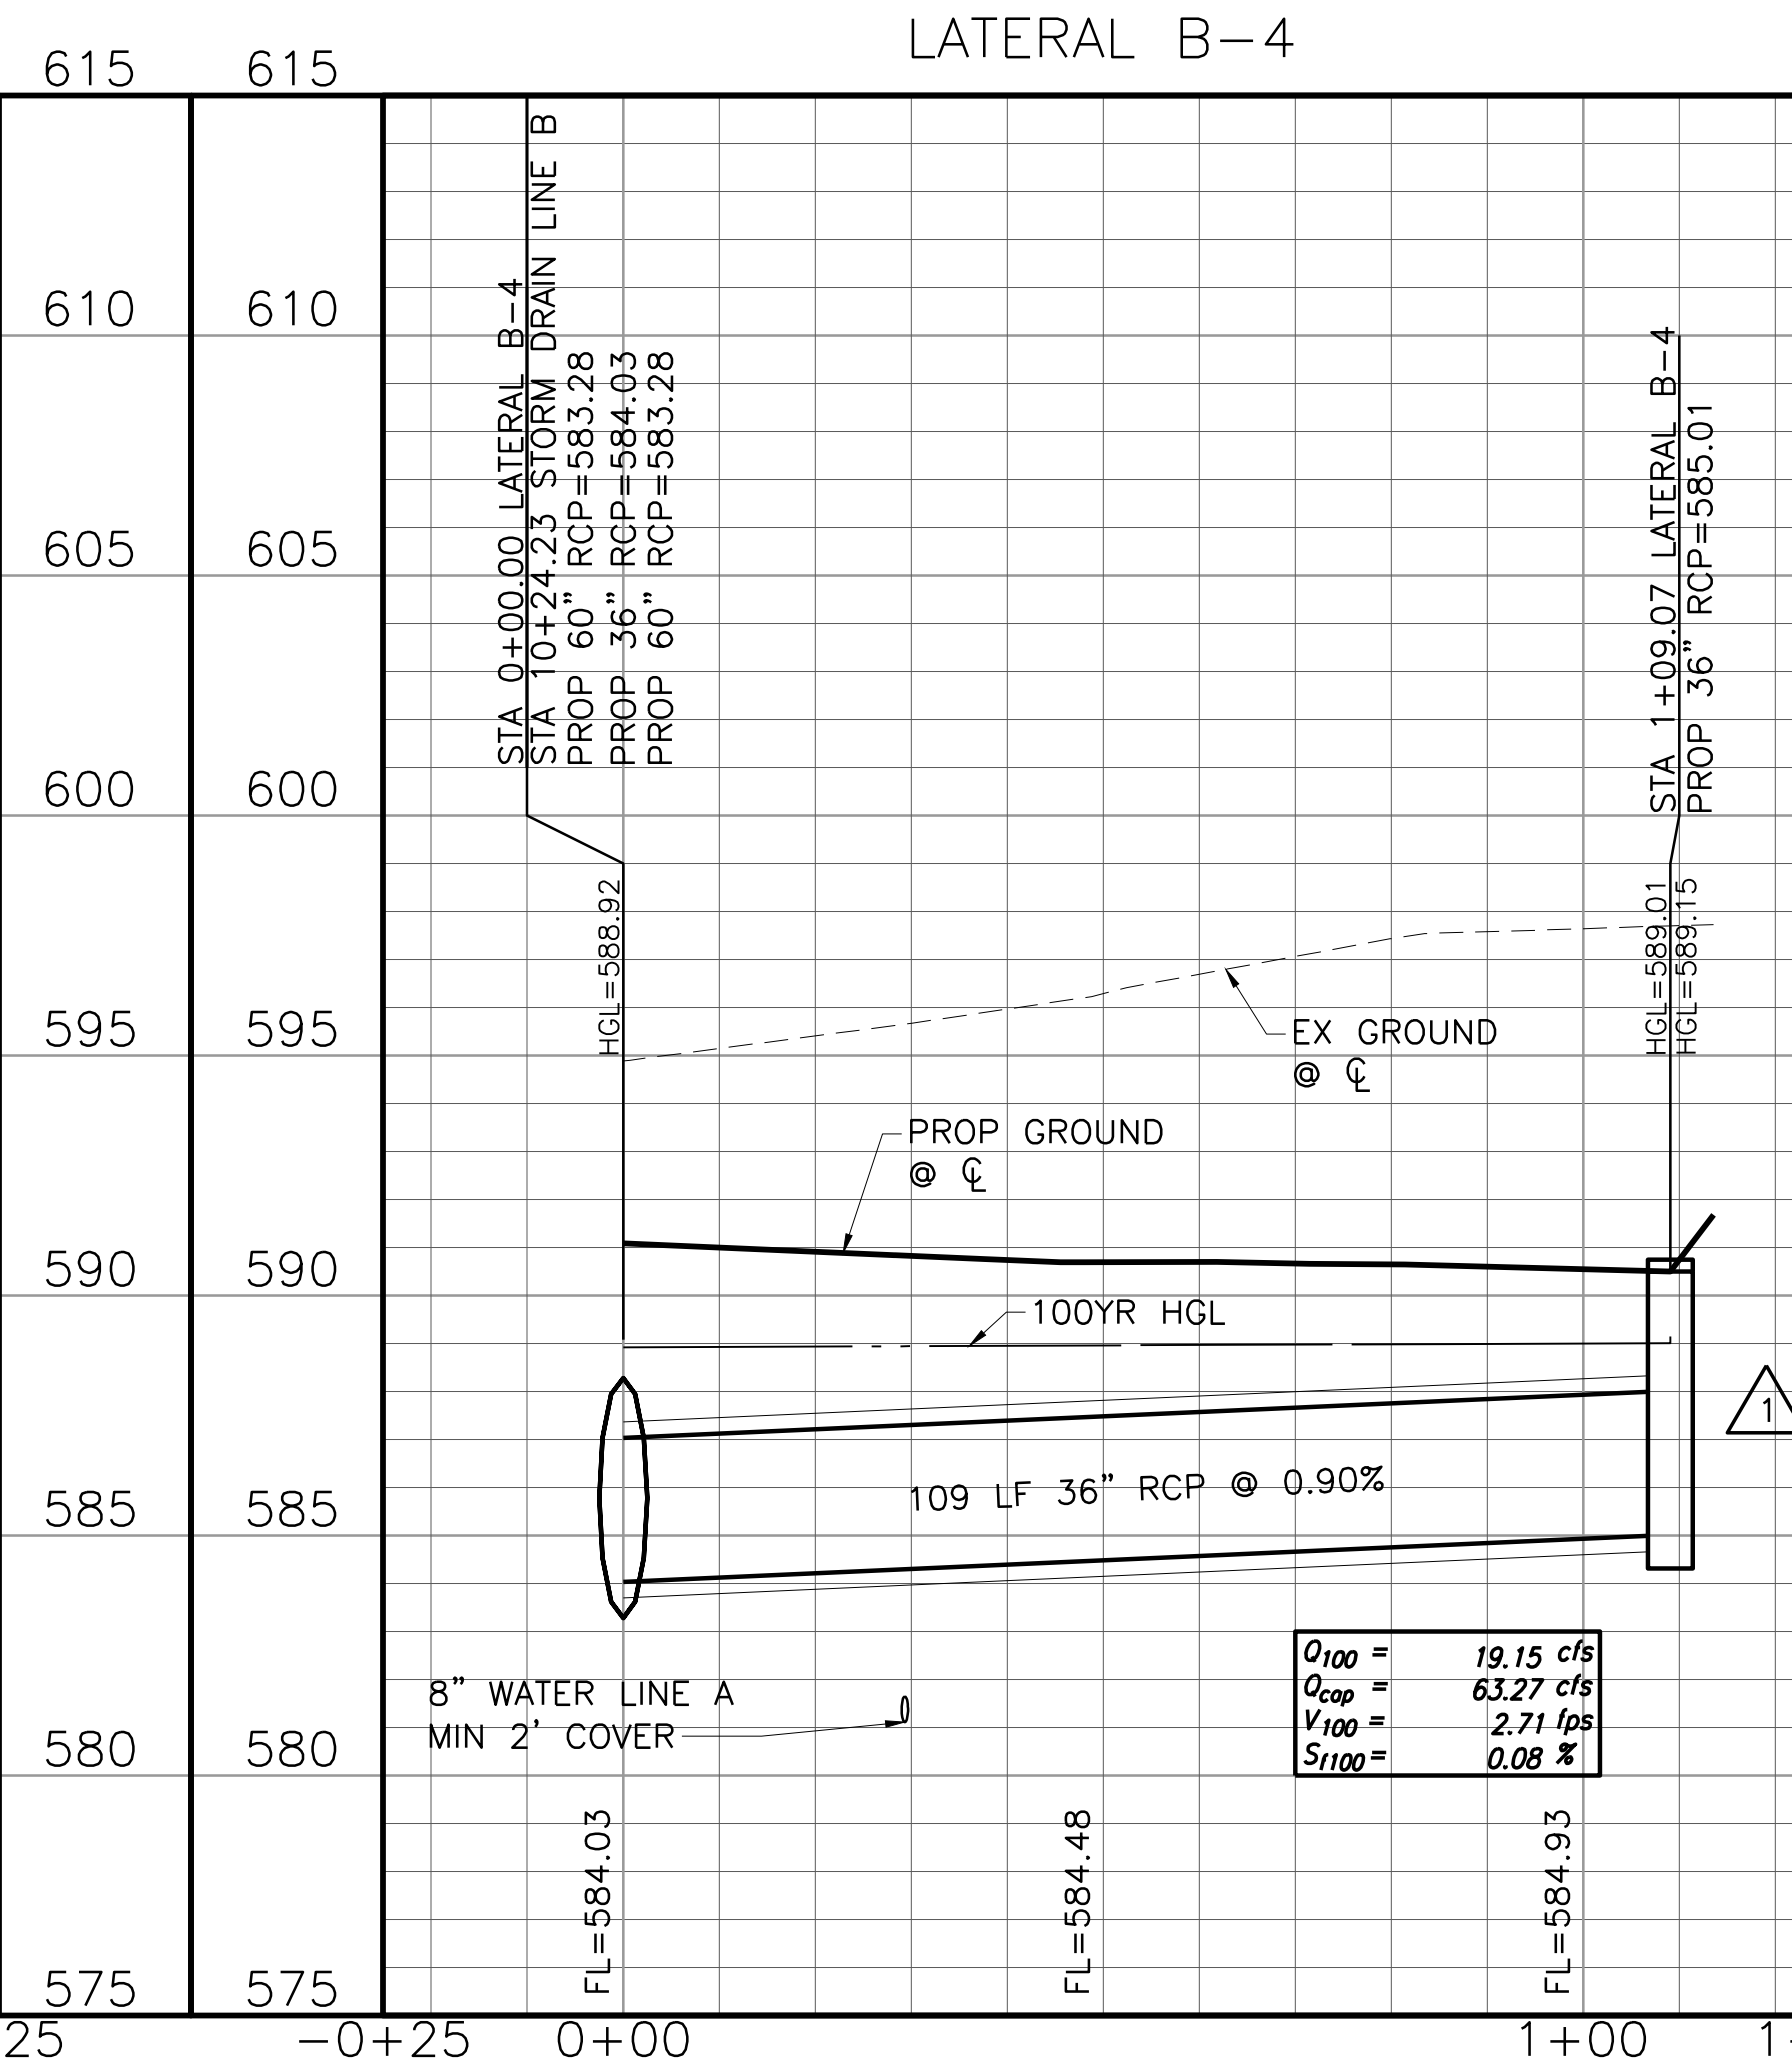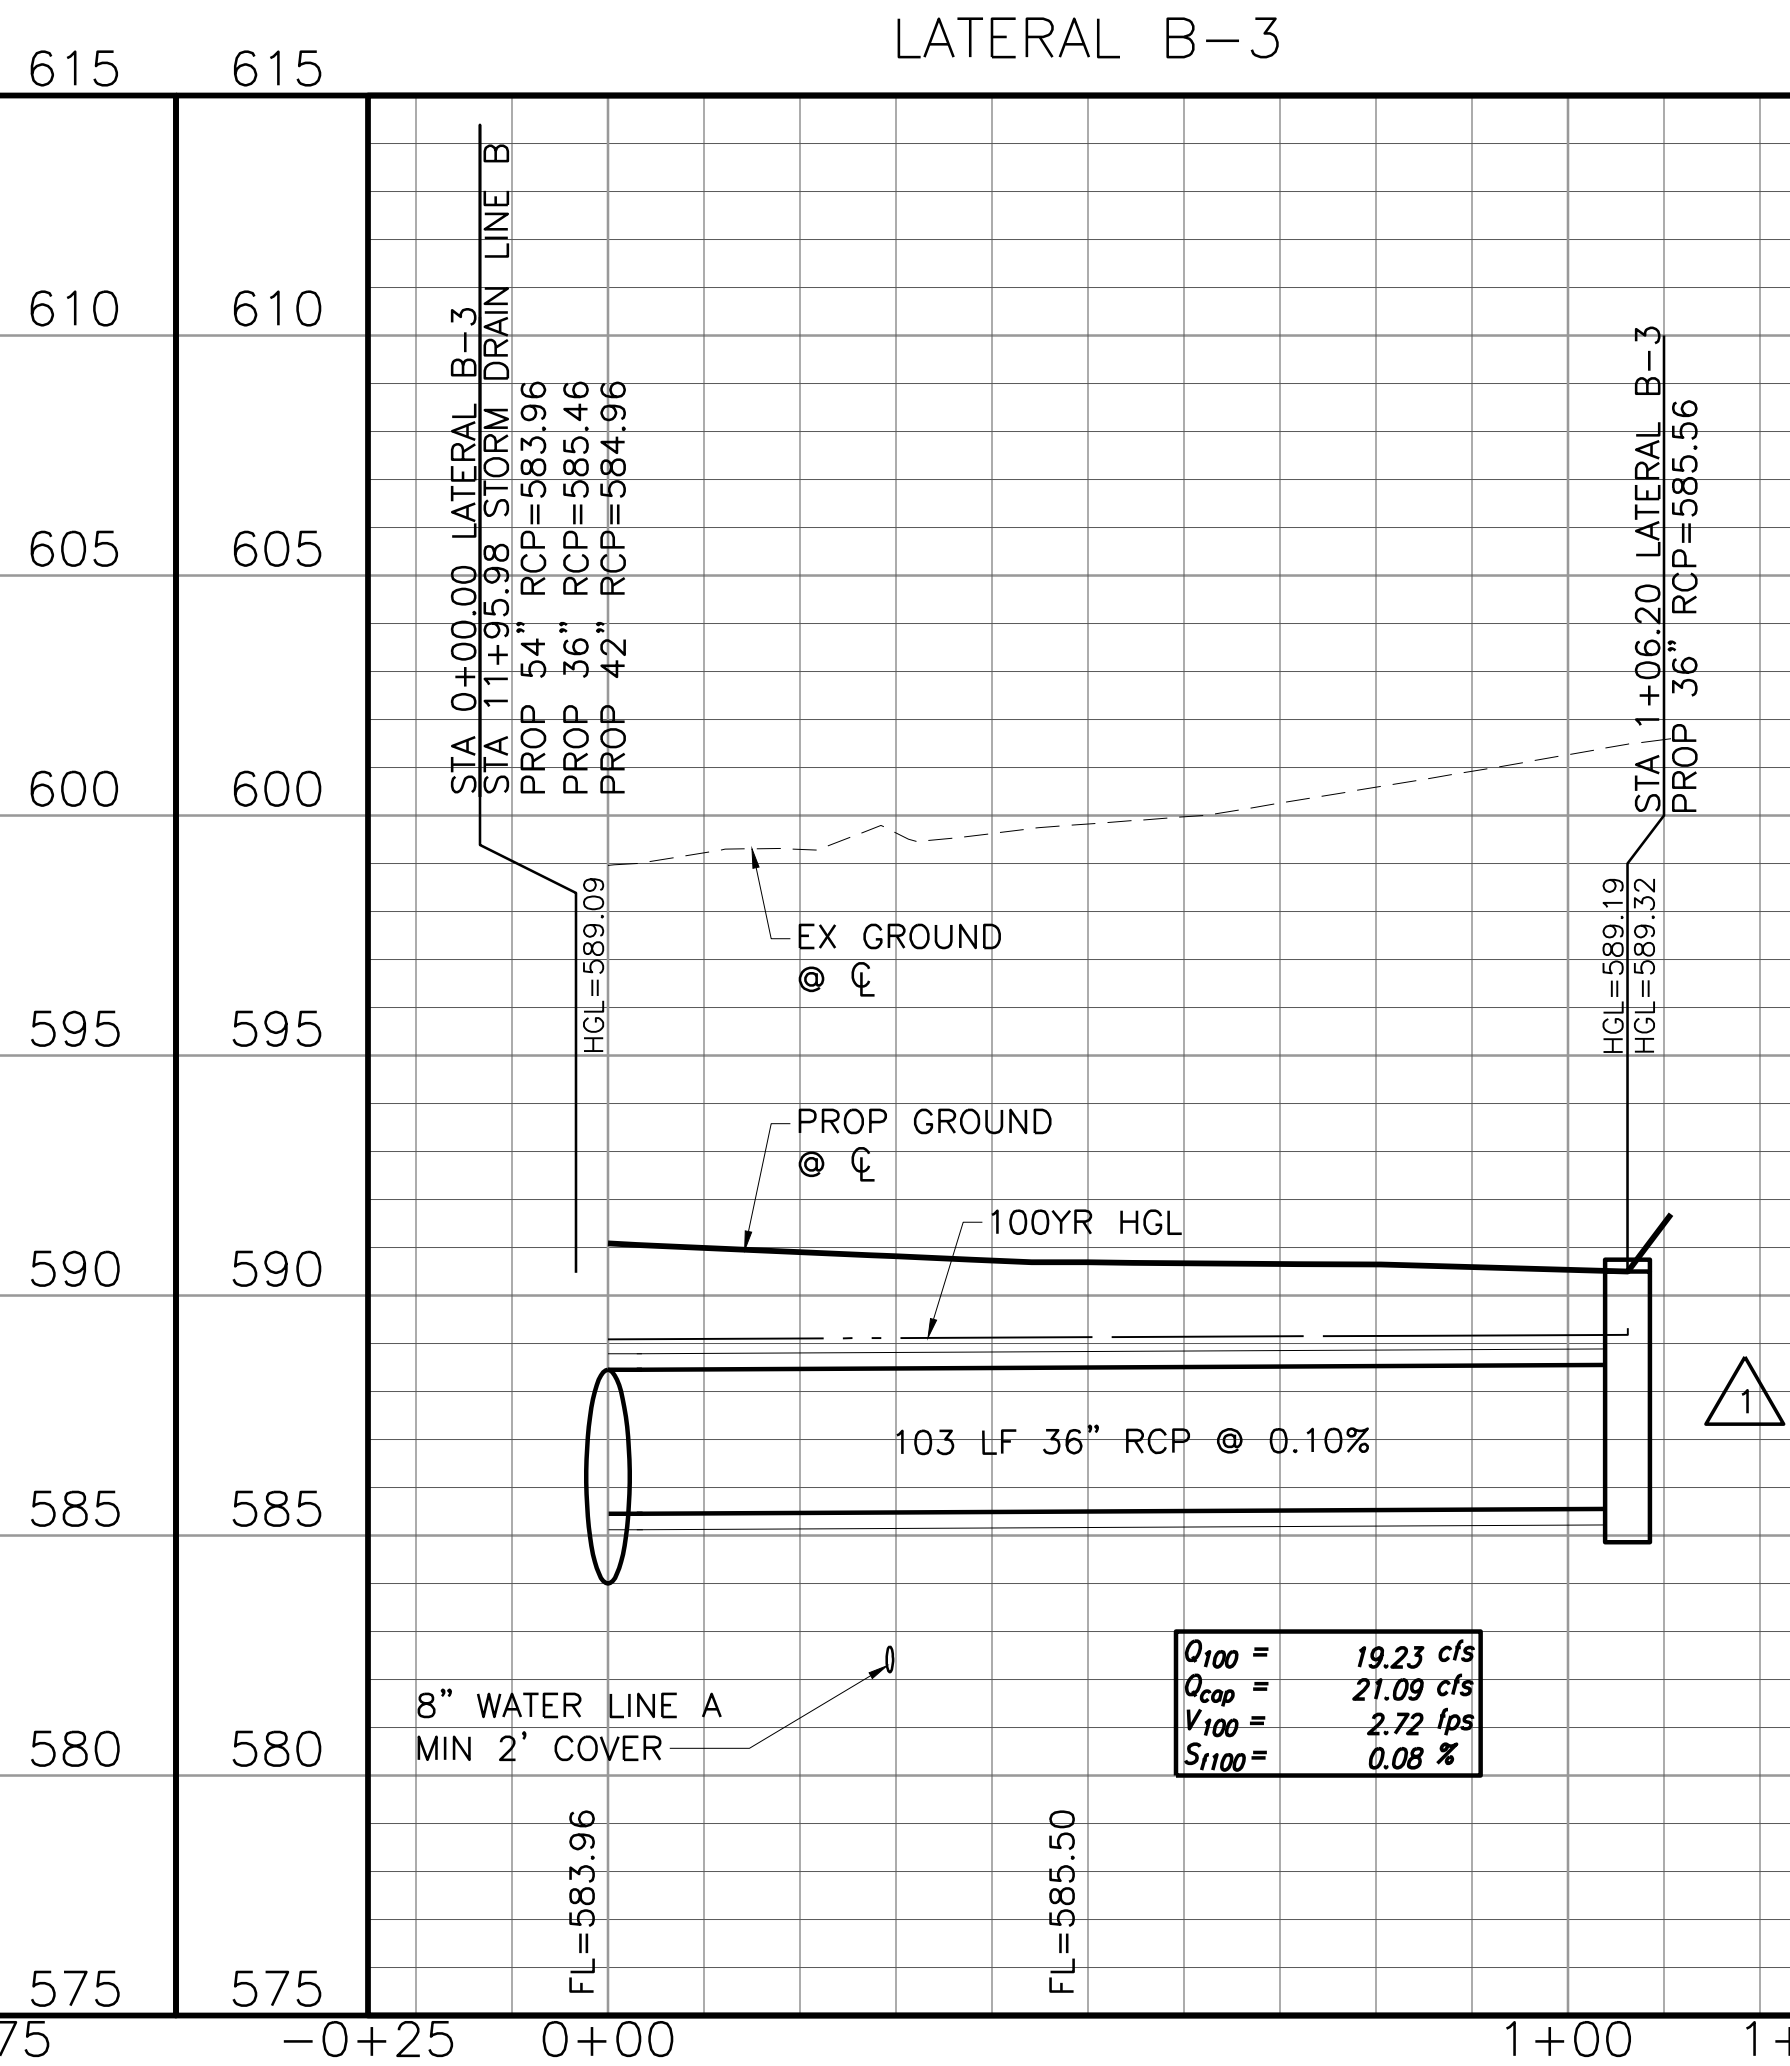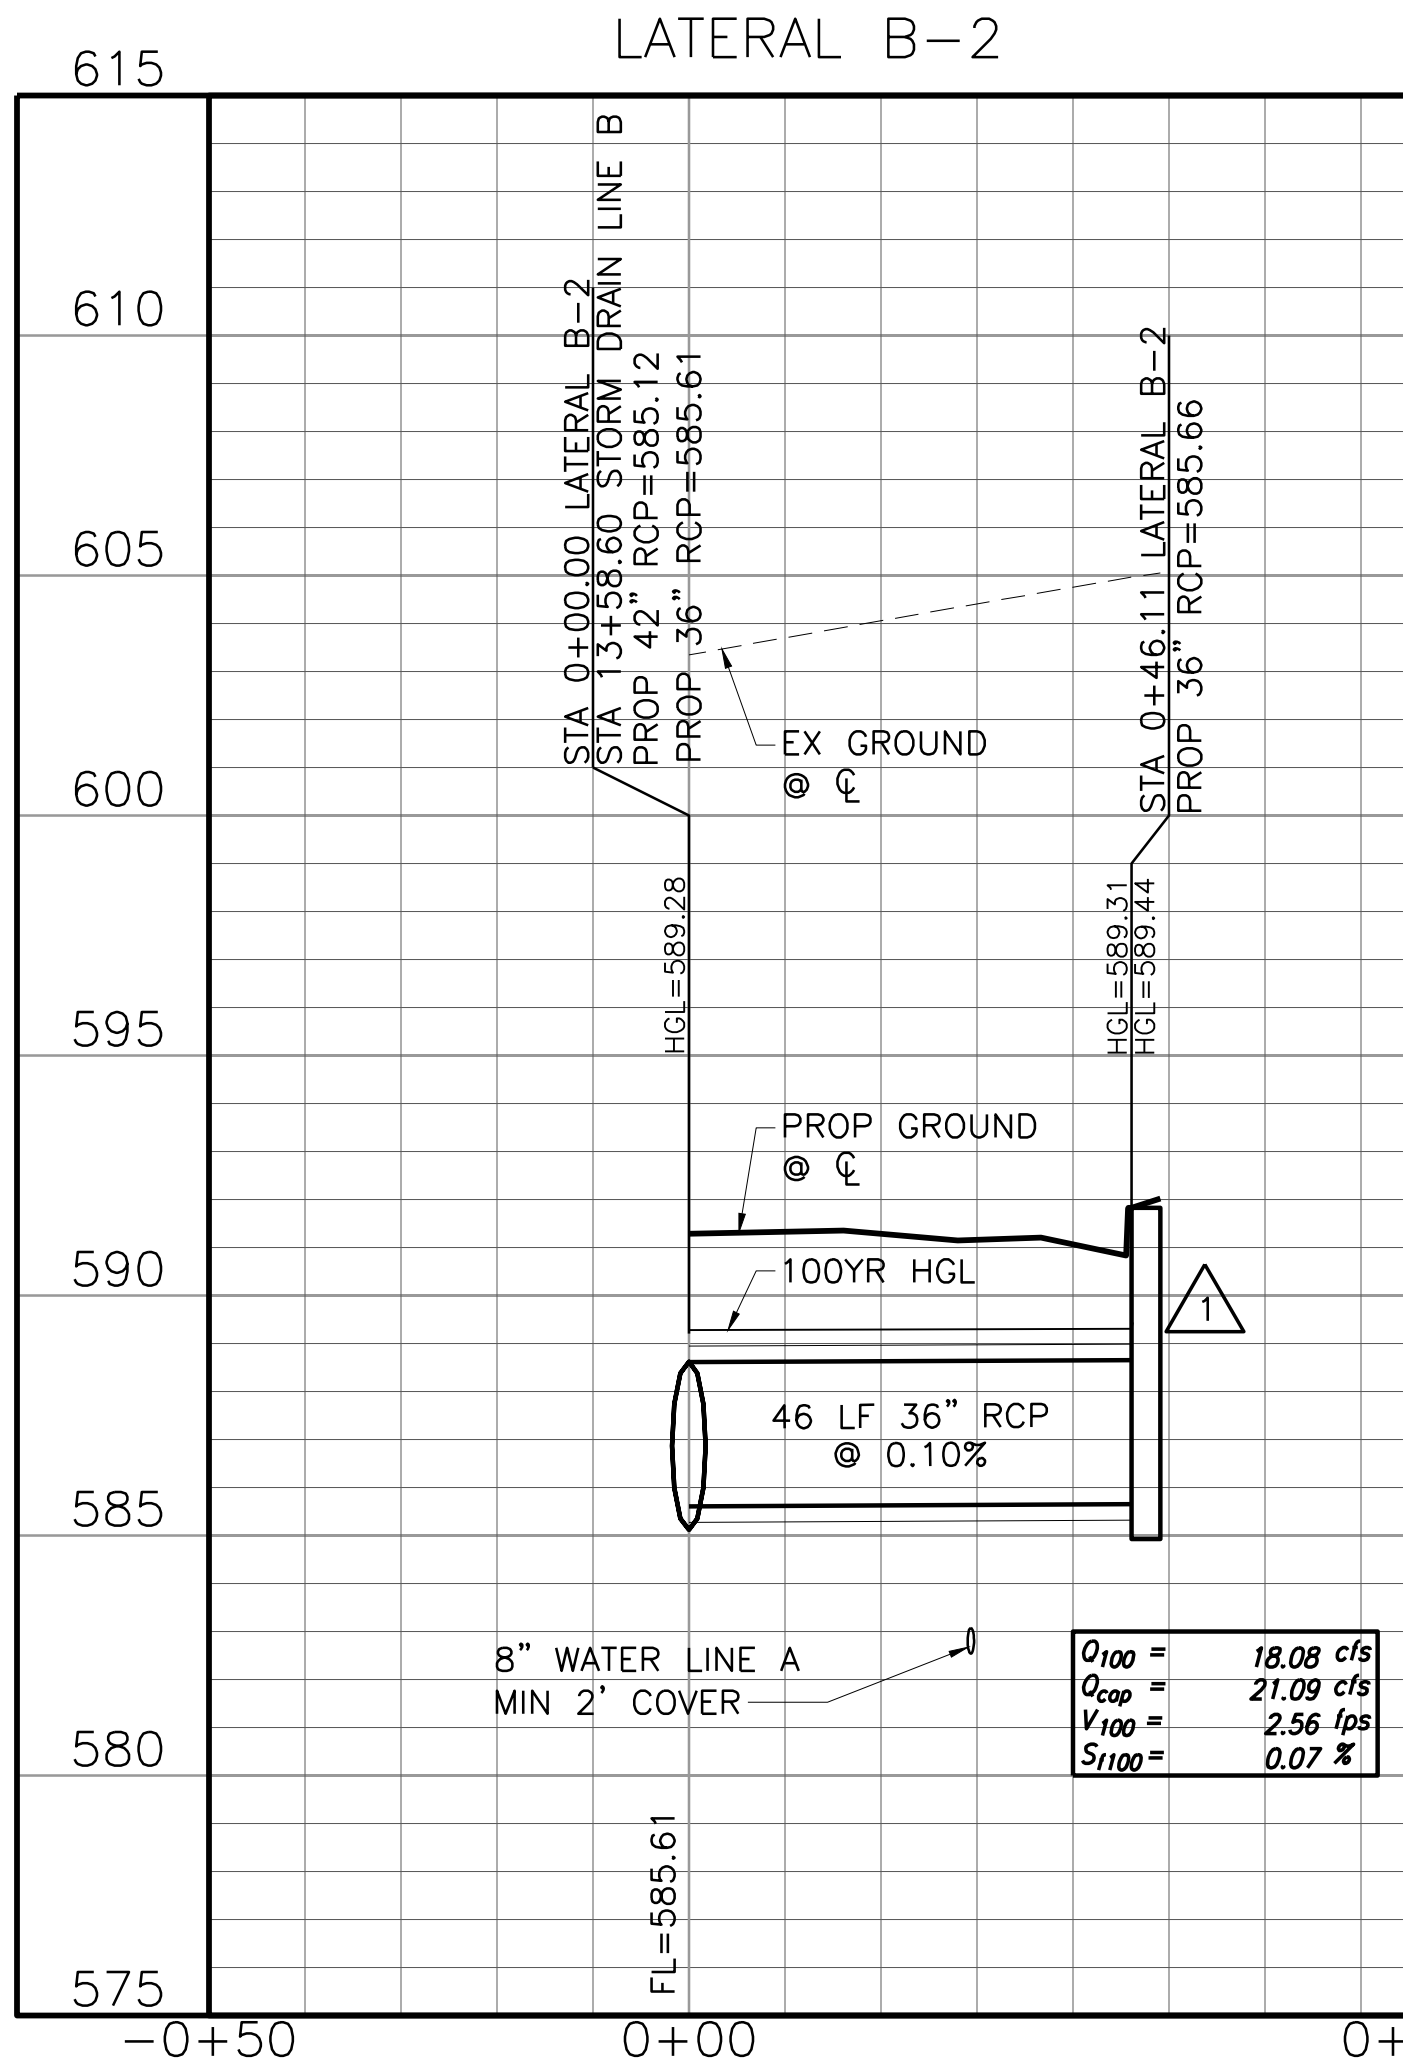

APPLICANT INFORMATION		DESCRIPTION	DATE
BOB LEIMBERG CLAYCO 2199 INNERBELT BUSINESS CENTER DR. ST. LOUIS, MO 63114 314.592.2234 office 314.713.7874 mobile leimbergb@claycorp.com		ENGINEERING SUBMITTAL	2/2/2018
		CITY OF ROCKWALL	
		ENGINEERING REVIEW 2ND SUBMITTAL	3/2/2018
		ENGINEERING REVIEW 3RD SUBMITTAL	3/23/2018
OWNER INFORMATION		ISSUED FOR CONSTRUCTION	4/10/2018
		SD RFI'S	6/13/2018
ALAN YU LOLLICUP USA 6185 KIMBALL AVE CHINO, CA 91708 626.965.8882 x110 office 626.226.8556 mobile alan.yu@lolicup.com		RECORD DRAWING	3/6/2019
		DRAWING TITLE	STORM DRAIN B LATERALS
PROJECT NAME LOLLICUP USA WAREHOUSE CASE NUMBER:		DRAWING NO.	C04-15
		Form #	601-03049
		Consult #	101-03049

BENCHMARKS:

BENCHMARK A-AN "X" CUT IN THE CENTER OF THE SIDEWALK AT THE END OF THE HANDICAP RAMP AT THE SOUTHEAST CORNER OF THE INTERSECTION OF DISCOVERY BLVD. AND DATA DR., 11 FEET SOUTHEAST OF THE CURB LINE.
ELEV=600.44

BENCHMARK B-AN "X" CUT ON THE CURB ON THE NORTH SIDE OF DISCOVERY BLVD. 580 FEET EAST OF CORPORATE CROSSING, 11 FEET SOUTHEAST OF A FIRE HYDRANT, AND 19 FEET NORTHEAST OF TWO (2) WATER VALVES.
ELEV=599.67

THE SEAL THAT ORIGINALLY APPEARED ON THIS DOCUMENT WAS AUTHORIZED BY: BRIET M. BRISOW, P.E.
TEAS NO.: 393000
DATE: 02/27/2018
ALTERATION OF A SEALED DOCUMENT WITHOUT PROPER NOTIFICATION OF THE RESPONSIBLE ENGINEER IS AN OFFENSE UNDER THE TEXAS ENGINEERING PRACTICE ACT.

This Record Drawing is a combination of the sealed engineering contract drawings for this project, modified by information furnished by the contractor reflecting changes in the Project made during construction. The original sealed drawings are on file at the offices of:

FREESE AND NICHOLS, INC.
RECORD DRAWINGS PREPARED ON: 3/6/2019

CLAYCO
THE ART & SCIENCE OF BUILDING

2199 INNERBELT BUSINESS CENTER DRIVE
ST. LOUIS, MISSOURI 63114
Ph 314.429.5100 Fx 314.429.3137

ARCHITECT
FORUM
2199 INNERBELT BUSINESS CENTER DRIVE
ST. LOUIS, MISSOURI 63114
Ph 314.429.1010 Fx 314.429.7770

CONTRACTOR / DEVELOPER
CLAYCO

LANDSCAPE ARCHITECT
FORUM

CIVIL ENGINEER
FREESE & NICHOLS

STRUCTURAL ENGINEER

MECHANICAL ENGINEER

ELECTRICAL ENGINEER

PLUMBING ENGINEER

FIRE PROTECTION ENGINEER

Lollicup

ROCKWALL TECHNOLOGY PARK
ROCKWALL, TEXAS



DRAWING ISSUE

DESCRIPTION	DATE
ENGINEERING SUBMITTAL	2/2/2018
CITY OF ROCKWALL	
ENGINEERING REVIEW 2ND SUBMITTAL	3/2/2018
ENGINEERING REVIEW 3RD SUBMITTAL	3/23/2018
ISSUED FOR CONSTRUCTION	4/10/2018
SD RFI'S	6/13/2018
RECORD DRAWING	3/6/2019

DRAWING TITLE
STORM DRAIN B LATERALS

DRAWING NO.
C04-15

Form # 601-03049
Consult # 101-03049

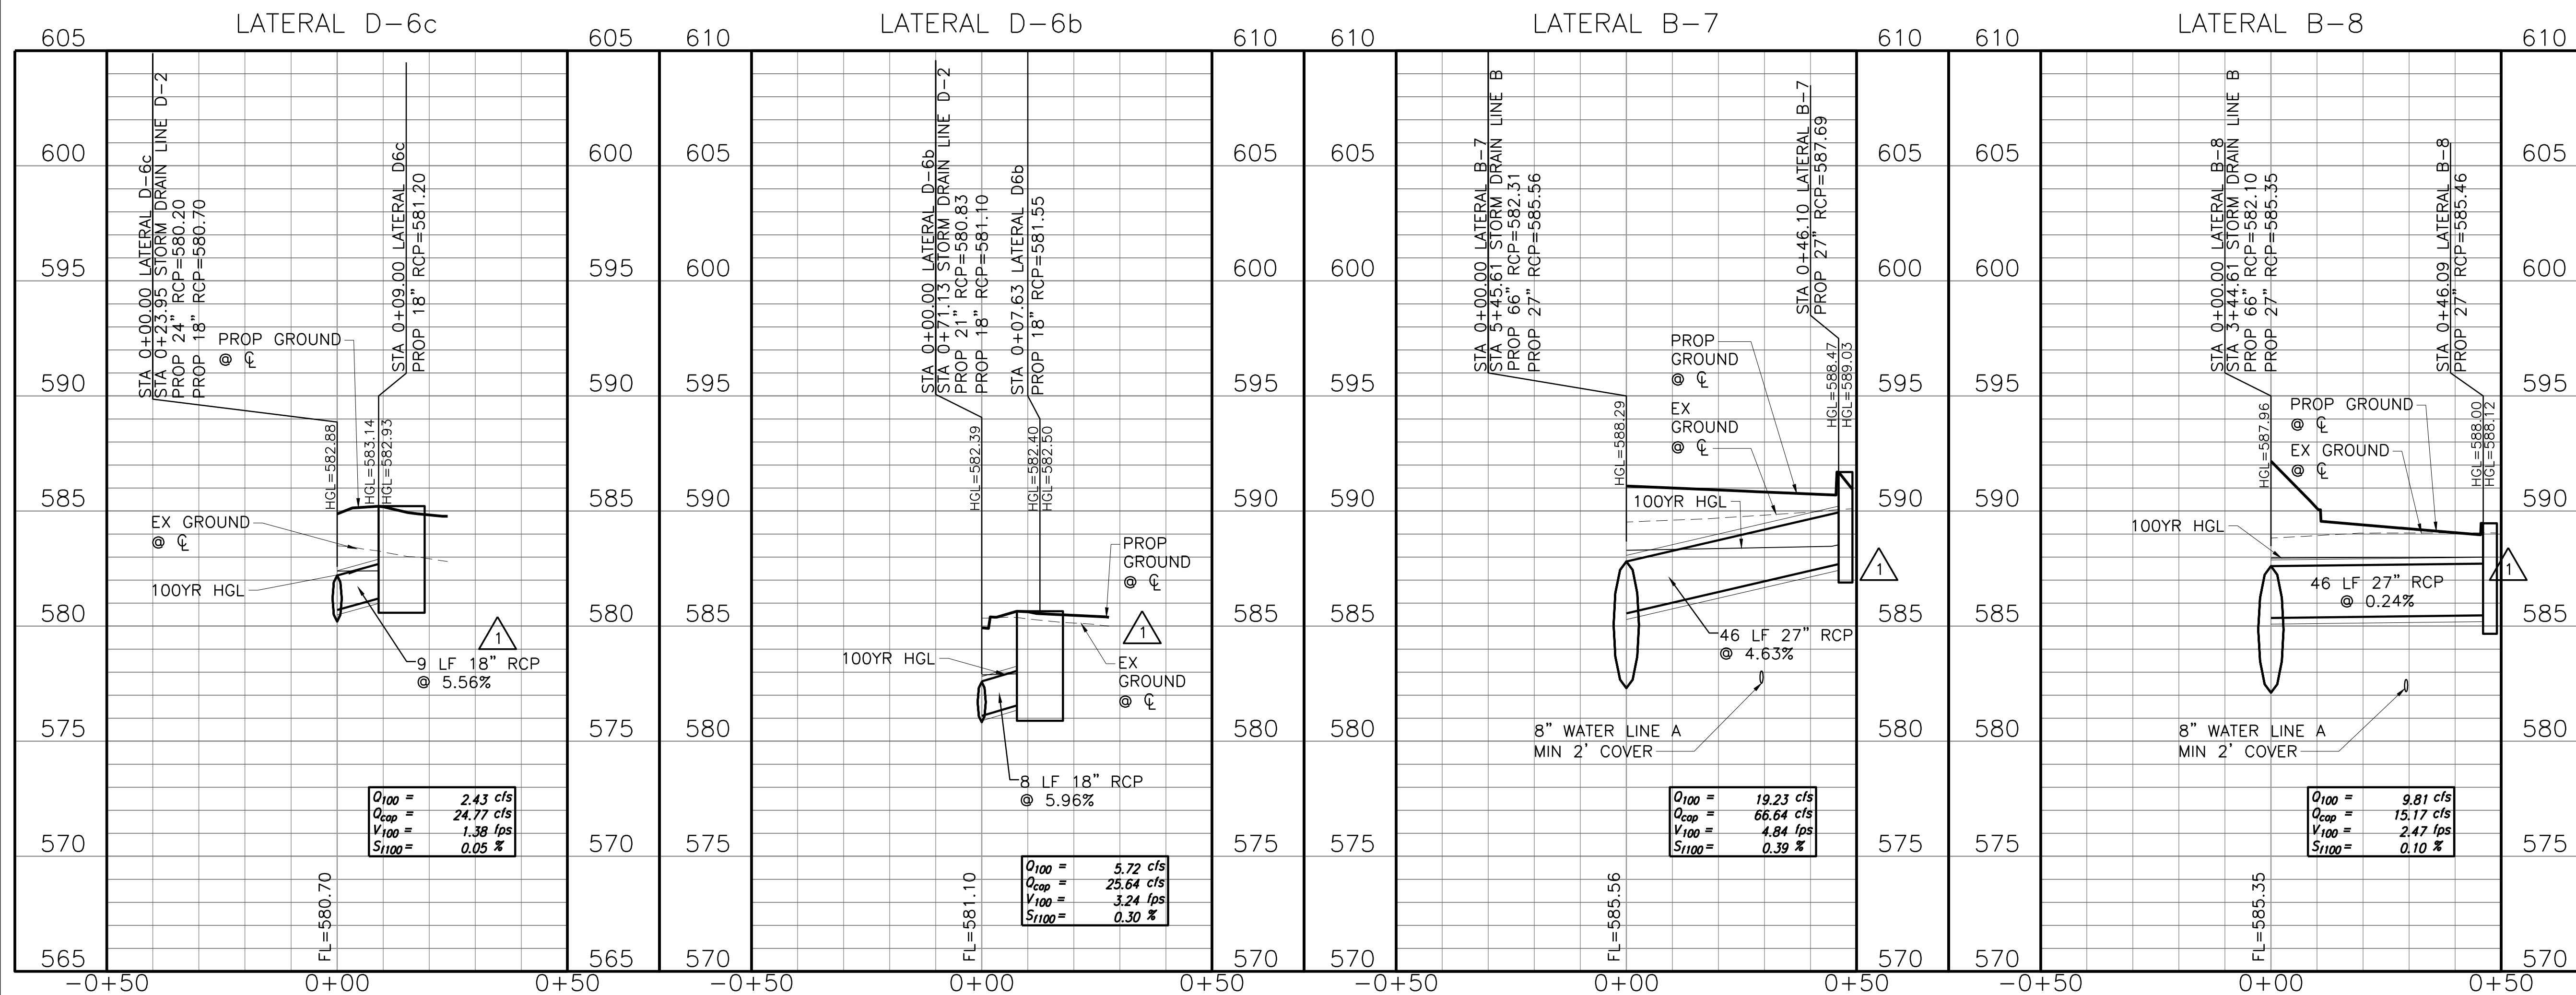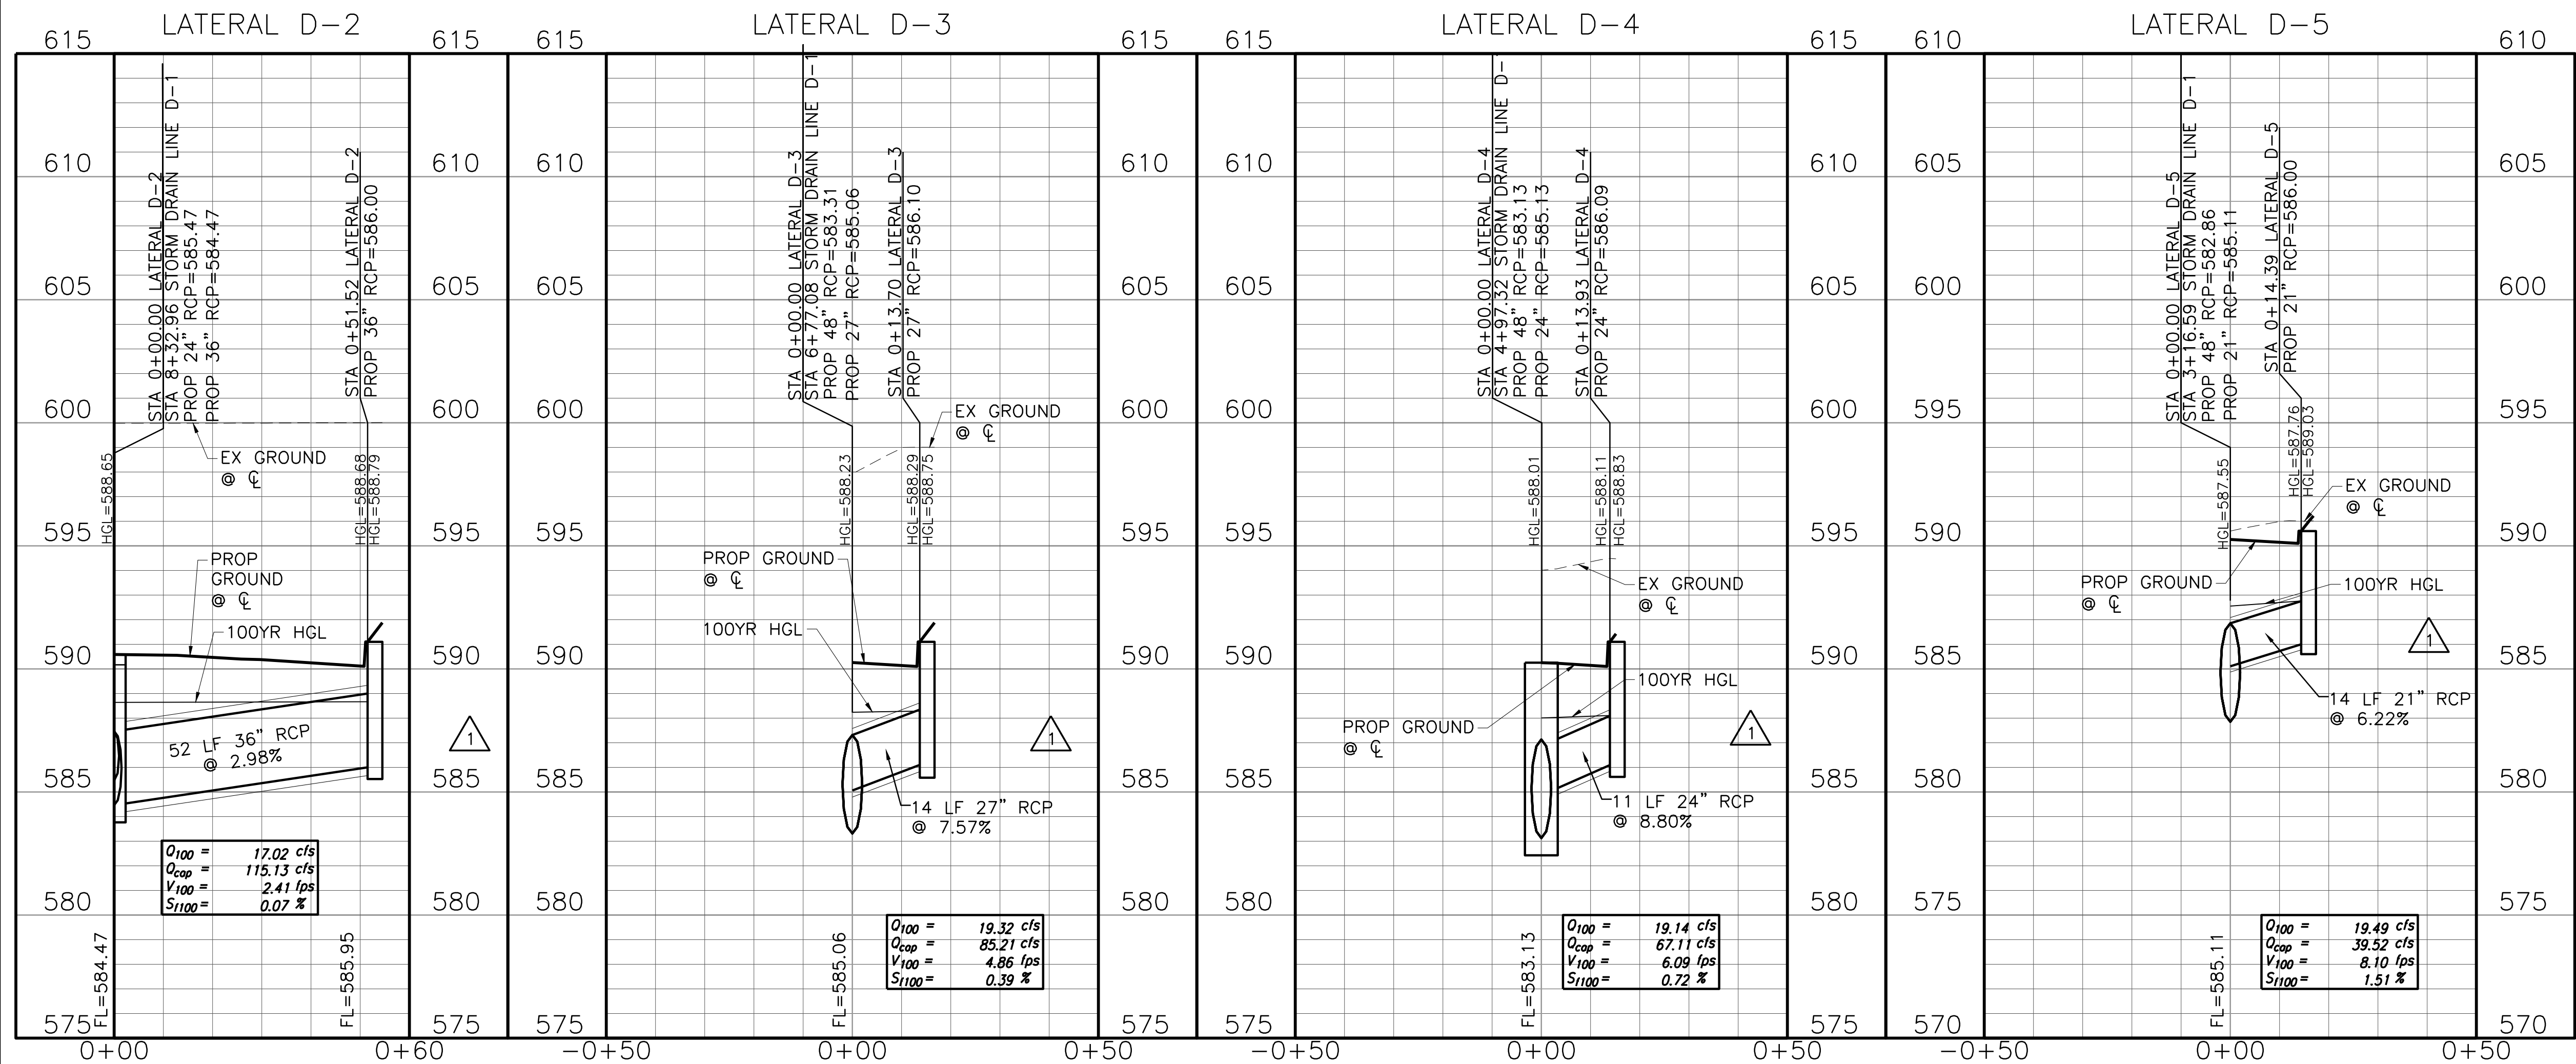

BENCHMARKS:
BENCHMARK A-AN "X" CUT IN
THE CENTER OF THE SIDEWALK.
AT THE END OF THE HANDICAP
RAMP AT THE SOUTHEAST
CORNER OF THE INTERSECTION
OF DISCOVERY BLVD. AND DATA
DR., 11 FEET SOUTHEAST OF
THE CURB LINE.
ELEV=600.44

BENCHMARK B-AN "X" CUT ON
THE CURB ON THE NORTH SIDE
OF DISCOVERY BLVD. 580 FEET
EAST OF CORPORATE CROSSING,
11 FEET SOUTHEAST OF A FIRE
HYDRANT, AND 19 FEET
NORTHEAST OF TWO (2) WATER
VALVES.
ELEV=599.67

THE SEAL THAT ORIGINALLY APPEARED ON THIS DOCUMENT
WAS AUTHORIZED BY BRETT M. BISTOW P.E.
TEXAS NO. 101000 ON 01/27/2013
ALTERATION OF A SEALED DOCUMENT WITHOUT PROPER
NOTIFICATION OF THE RESPONSIBLE ENGINEER IS AN
OFFENSE UNDER THE TEXAS ENGINEERING PRACTICE ACT

This Record Drawing is a combination of the
sealed engineering contract drawings for this
project, modified by information furnished by
the contractor reflecting changes in the Project made
during construction. The original sealed drawings
are on file at the offices of
FRESEE AND NICHOLS, INC.
RECORD DRAWINGS PREPARED ON:
3/6/2019

CLAYCO

THE ART & SCIENCE OF BUILDING

2199 INNERBELT BUSINESS CENTER DRIVE
ST. LOUIS, MISSOURI 63114
Ph 314.429.5100 Fx 314.429.3137

ARCHITECT
FORUM
2199 INNERBELT BUSINESS CENTER DRIVE
ST. LOUIS, MISSOURI 63114
Ph 314.429.1010 Fx 314.429.7770

CONTRACTOR / DEVELOPER
CLAYCO
LANDSCAPE ARCHITECT
FORUM

CIVIL ENGINEER
FREESE & NICHOLS
STRUCTURAL ENGINEER

MECHANICAL ENGINEER

ELECTRICAL ENGINEER

PLUMBING ENGINEER

FIRE PROTECTION ENGINEER

Lollicup
ROCKWALL TECHNOLOGY PARK
ROCKWALL, TEXAS

DRAWING ISSUE

APPLICANT INFORMATION		DESCRIPTION	DATE
BOB LEIMBERG CLAYCO 2199 INNERBELT BUSINESS CENTER DR. ST. LOUIS, MO 63114 314.592.2234 office 314.713.7874 mobile leimbergb@claycorp.com		ENGINEERING SUBMITTAL CITY OF ROCKWALL	2/22/2018
		ENGINEERING REVIEW 2ND SUBMITTAL	3/22/2018
		ENGINEERING REVIEW 3RD SUBMITTAL	3/23/2018
		ISSUED FOR CONSTRUCTION	4/10/2018
		SD RFP'S	6/13/2018
OWNER INFORMATION ALAN YU LOLLICUP USA 6185 KIMBALL AVE. CHINO, CA 91708 626.965.8882 x110 office 626.226.8556 mobile alan.yu@lollcup.com		RECORD DRAWING	3/6/2019
		DRAWING TITLE STORM DRAIN D, B-7, AND B-8 LATERALS	
		DRAWING NO.	
		<div>C04-16</div>	
		Forum # 601-03049 Consult# 101-03049	
PROJECT NAME			
LOLLICUP USA WAREHOUSE CASE NUMBER:			

THE SEAL THAT ORIGINALLY APPEARED ON THIS DOCUMENT WAS AUTHORIZED BY: JRETT.M. 8853202 E.E. TEXAS NO. 101000, EXPIRATION DATE: 8/22/2018. ALTERATION OF A SEALED DOCUMENT WITHOUT PROPER NOTIFICATION OF THE RESPONSIBLE ENGINEER IS AN OFFENSE UNDER THE TEXAS ENGINEERING PRACTICE ACT.

This Record Drawing is a combination of the sealed engineering contract drawings for this project, modified by information furnished by the contractor reflecting changes in the Project made during construction. The original sealed drawings are on file at the offices of:
FREESE AND NICHOLS, INC.
RECORD DRAWINGS PREPARED ON: 3/6/2019

ARCHITECT
FORUM
2199 INNERBELT BUSINESS CENTER DRIVE
ST. LOUIS, MISSOURI 63114
Ph 314.429.1010 Fx 314.429.7770

CONTRACTOR / DEVELOPER
CLAYCO

LANDSCAPE ARCHITECT
FORUM

CIVIL ENGINEER
FREESE & NICHOLS

STRUCTURAL ENGINEER

MECHANICAL ENGINEER

ELECTRICAL ENGINEER

PLUMBING ENGINEER

FIRE PROTECTION ENGINEER

Lollicup
ROCKWALL TECHNOLOGY PARK
ROCKWALL, TEXAS

DRAWING ISSUE

DESCRIPTION	DATE
ENGINEERING SUBMITTAL	2/2/2018
CITY OF ROCKWALL	
ENGINEERING REVIEW	3/2/2018
2ND SUBMITTAL	
ENGINEERING REVIEW	3/23/2018
3RD SUBMITTAL	
ISSUED FOR CONSTRUCTION	4/10/2018

OWNER INFORMATION

ALAN YU
LOLLICUP USA
6185 KIMBALL AVE.
CHINO, CA 91708
626.965.8882 x110 office
626.226.8556 mobile
alan.yu@lollicup.com

PROJECT NAME

LOLLICUP USA WAREHOUSE

CASE NUMBER:


DRAWING TITLE

OVERALL UTILITY PLAN


DRAWING NO.



C05-00

Form # 601-03049 Consult # 101-03049

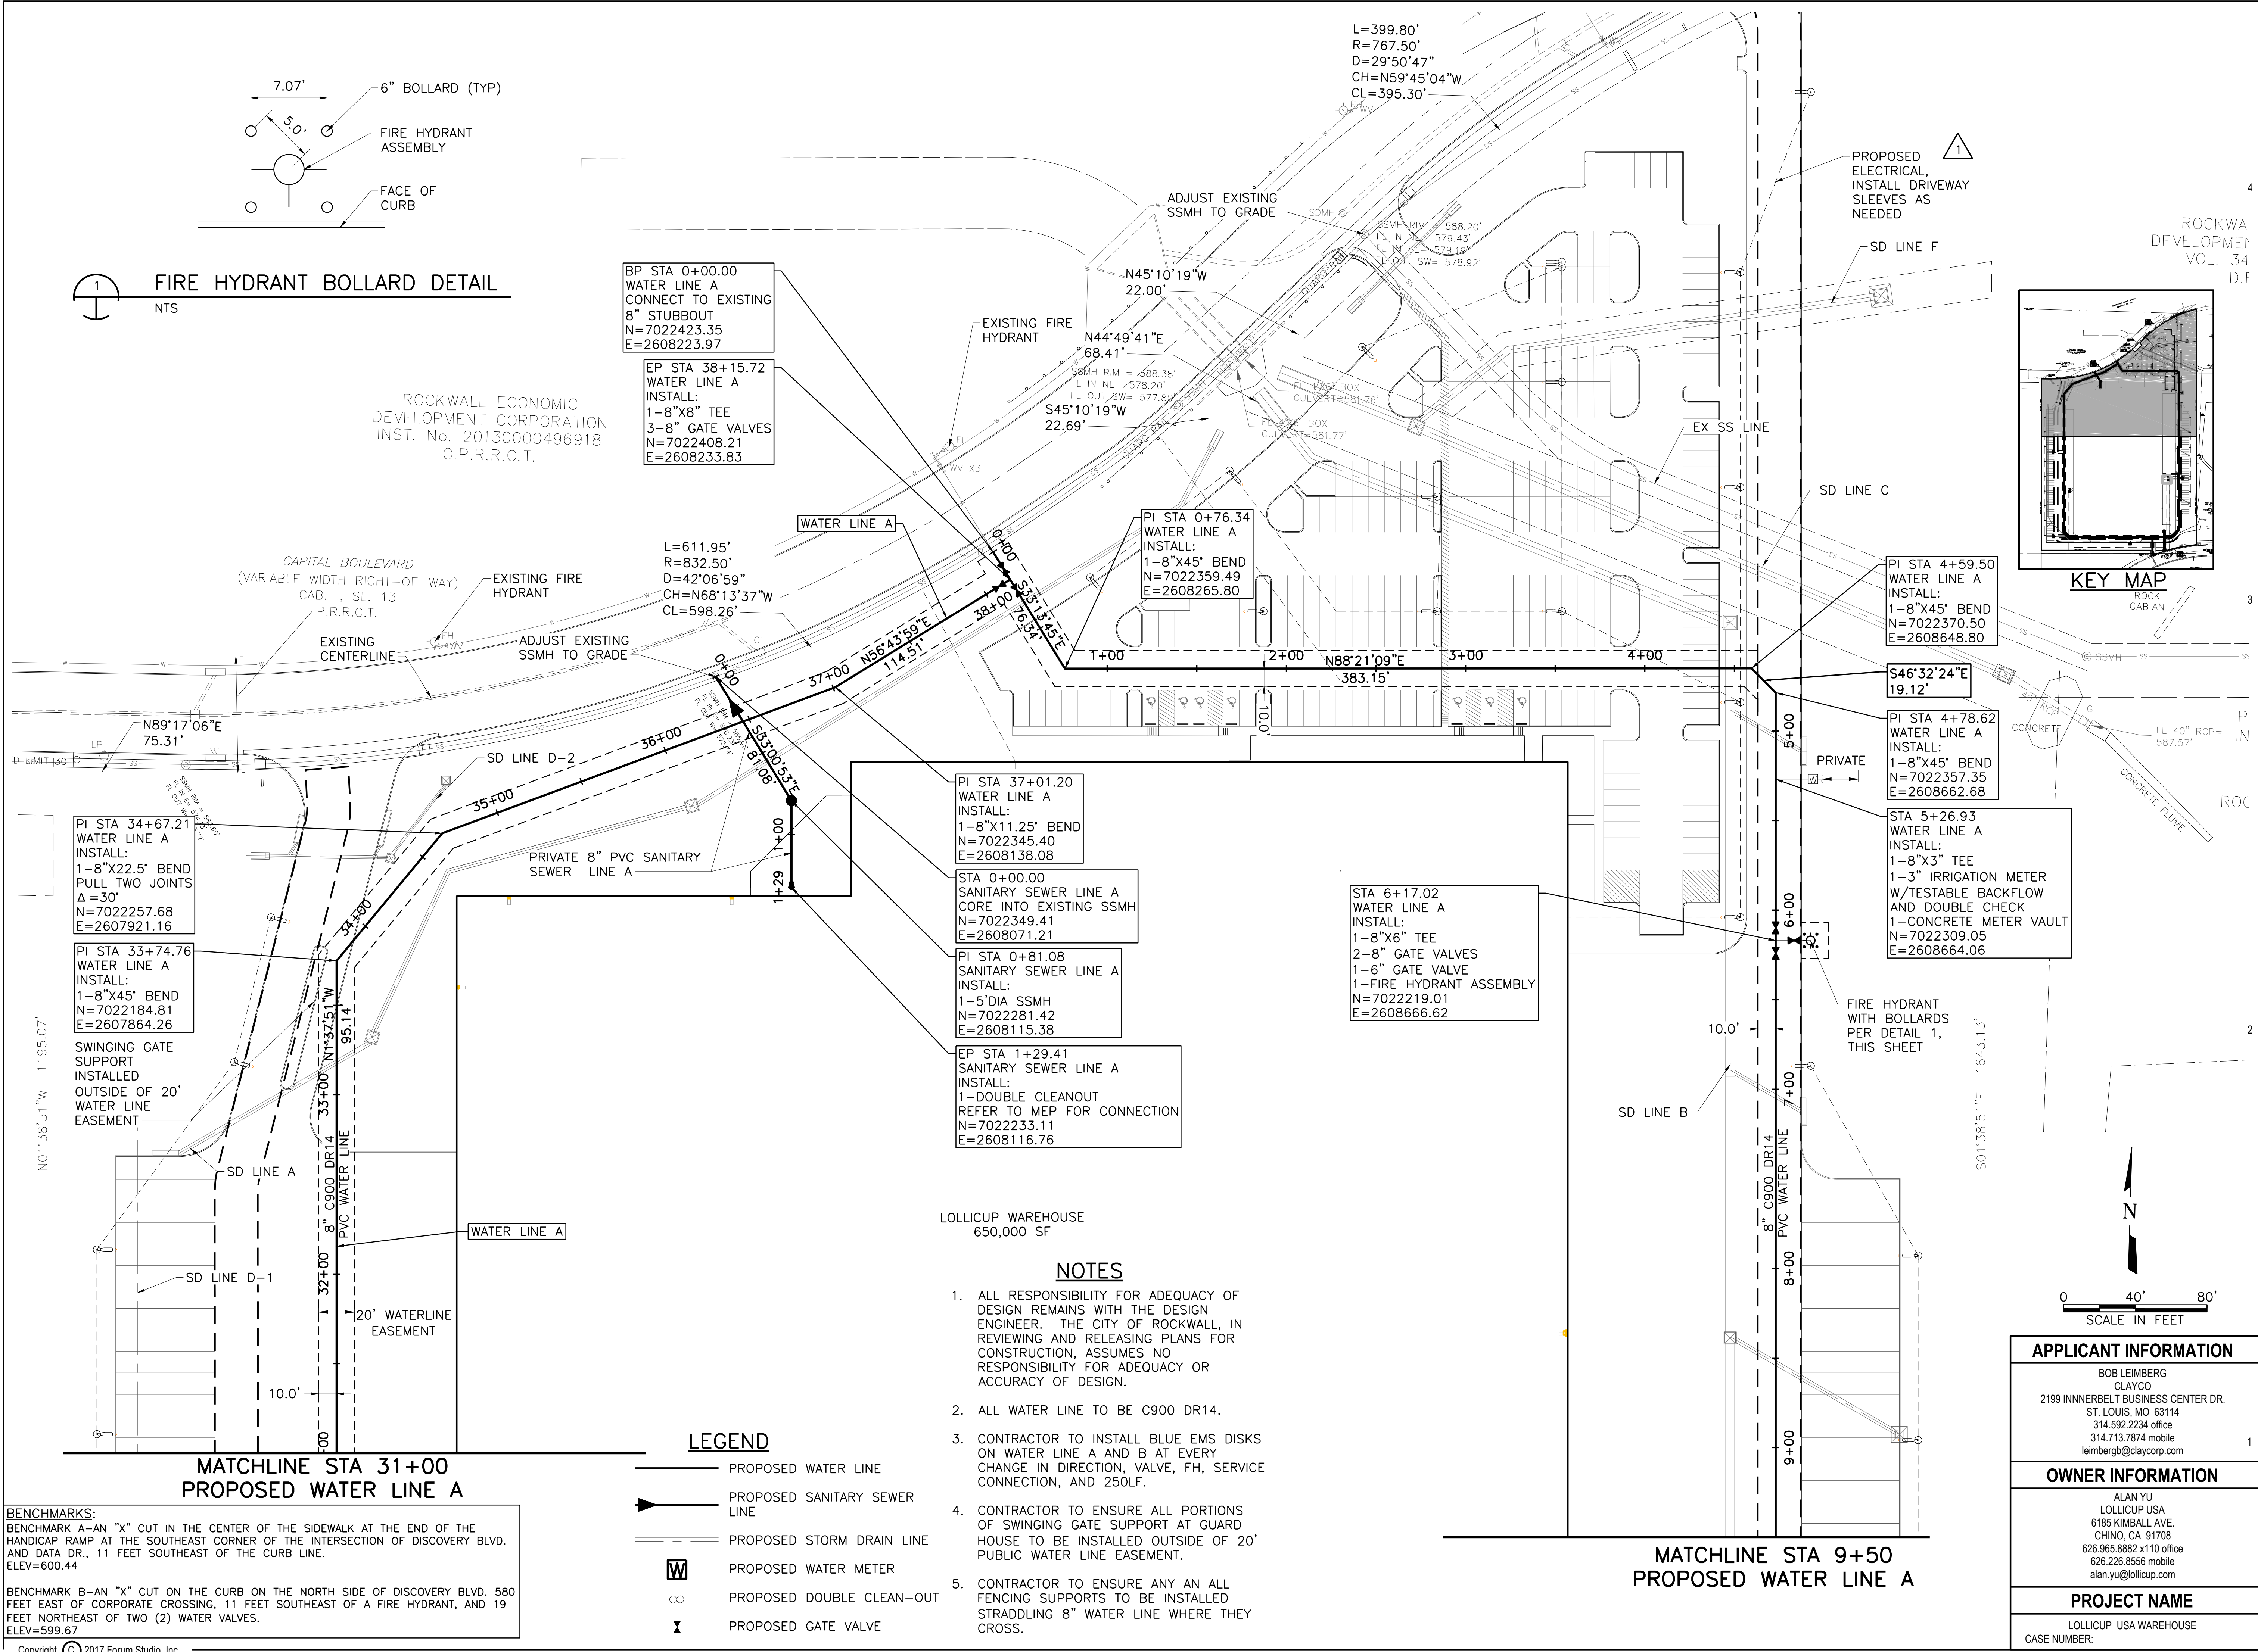

12/2/2017 1:10:05 PM

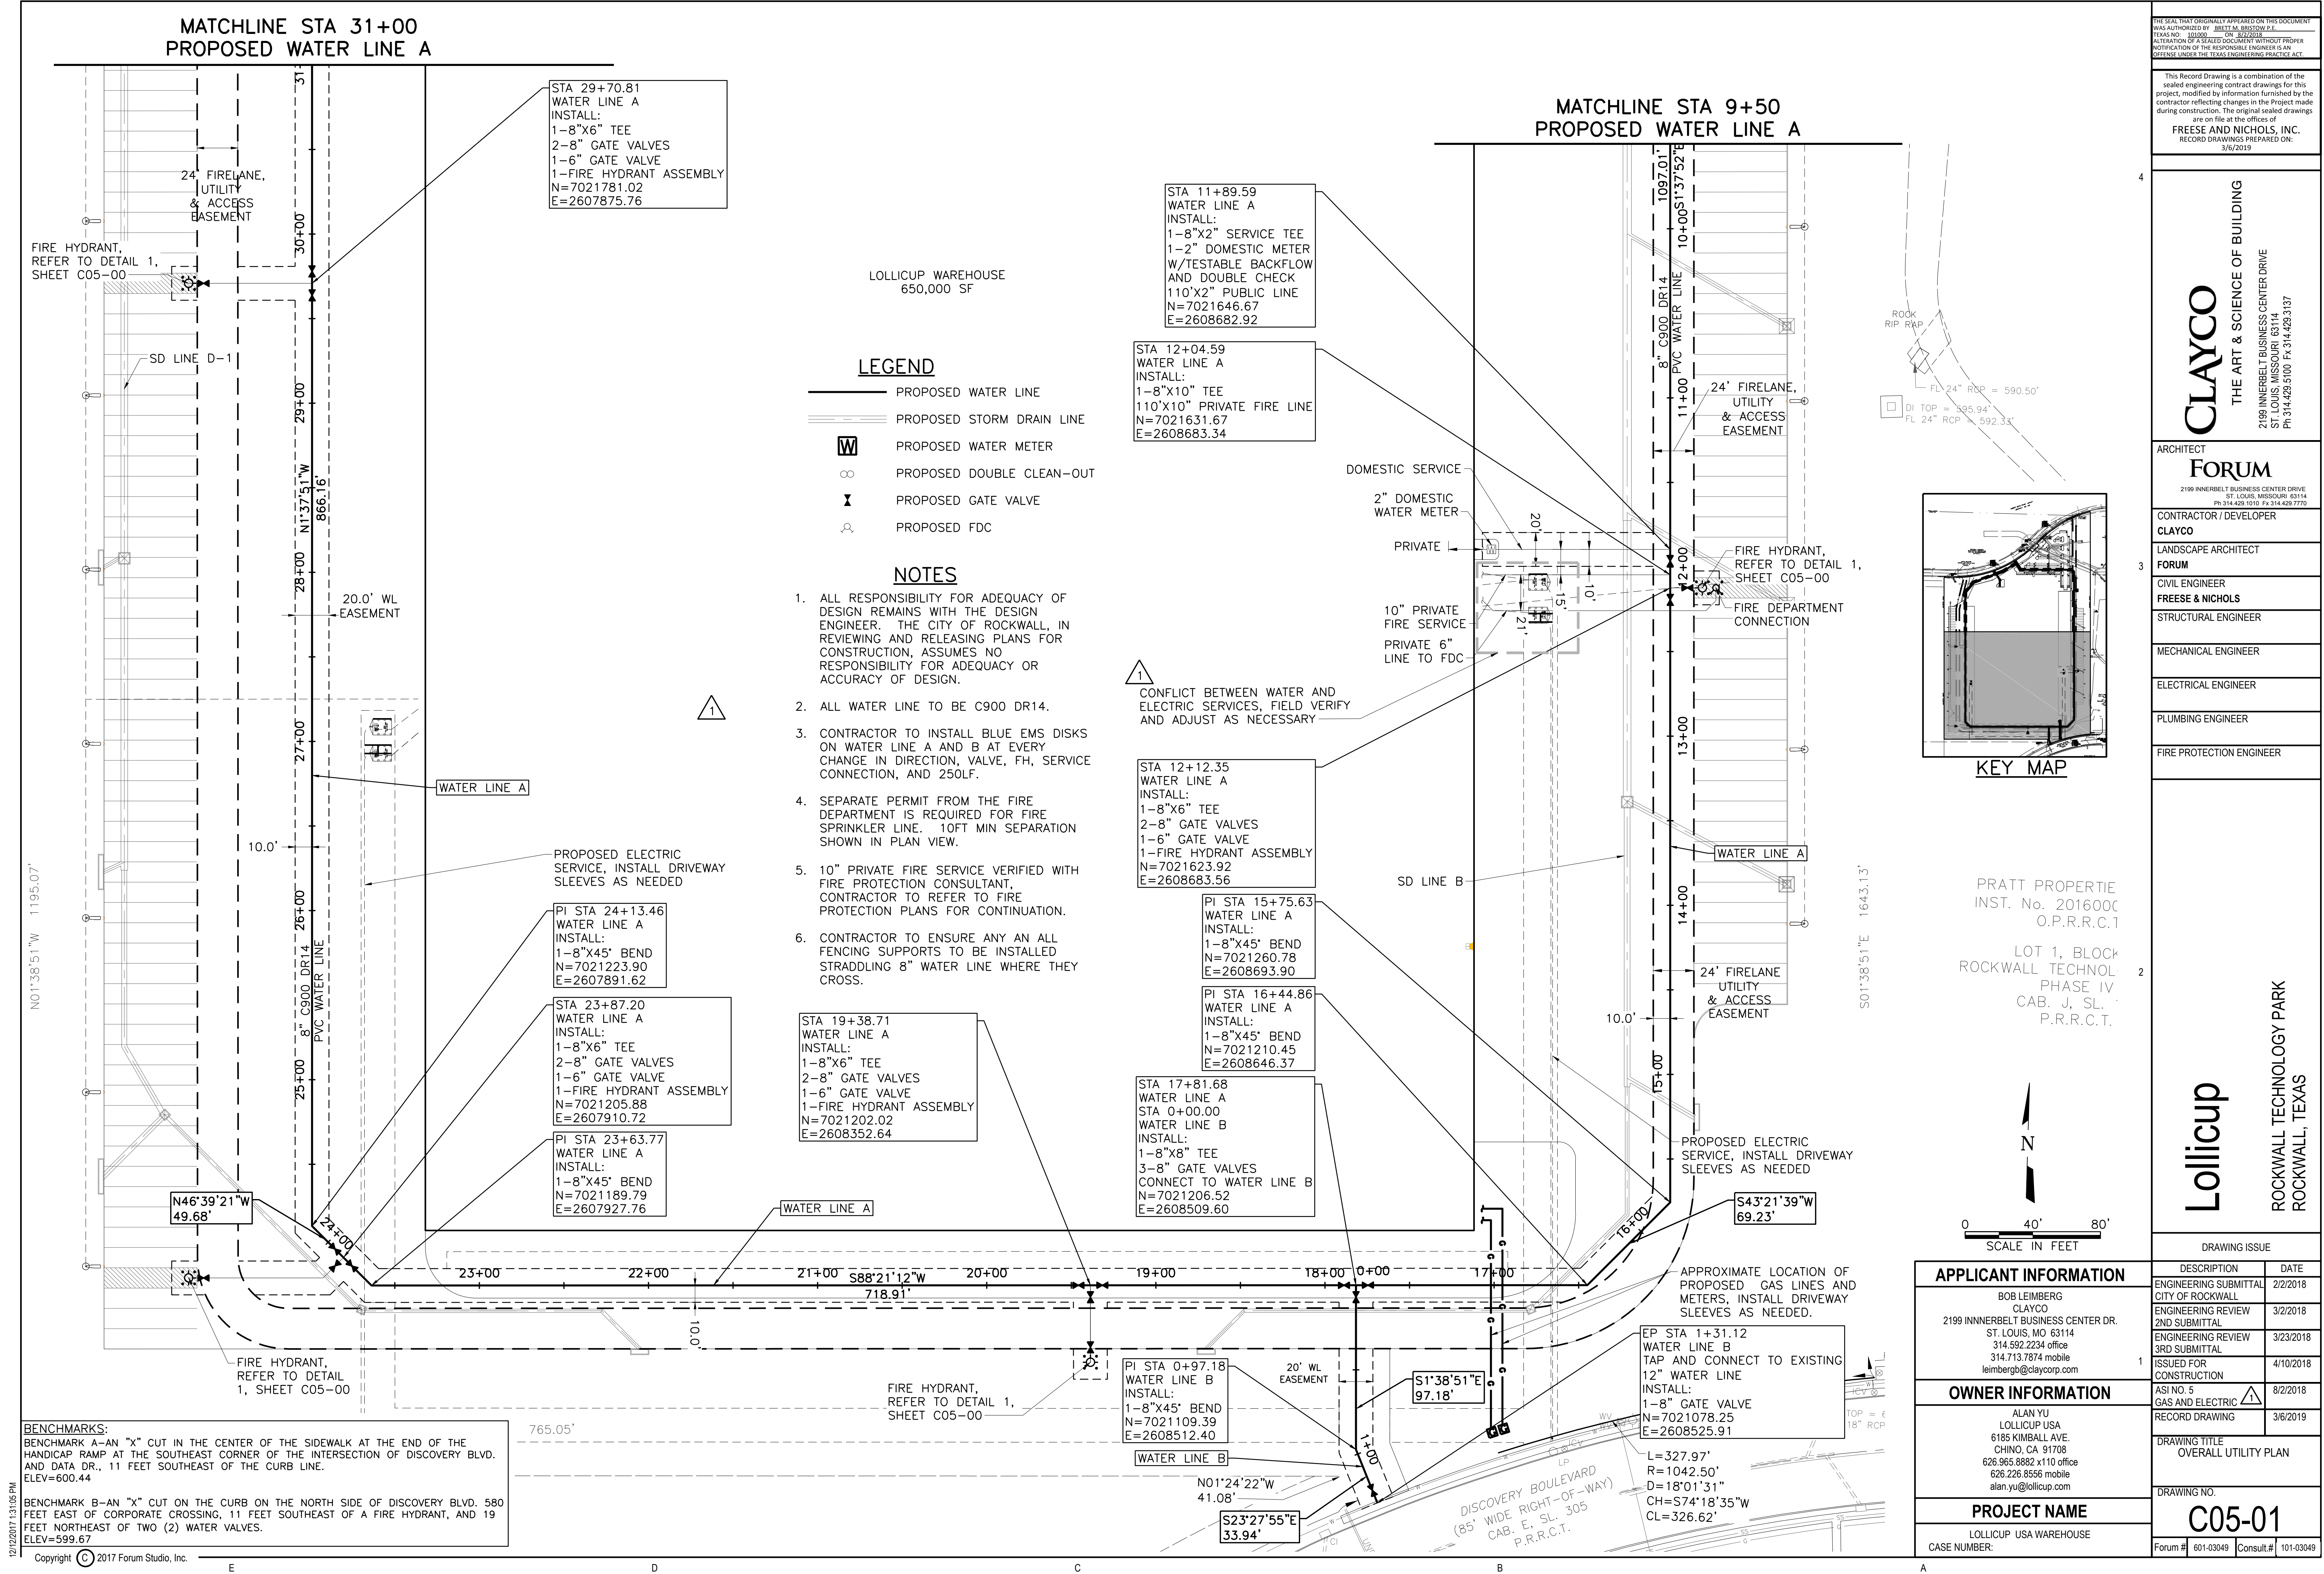

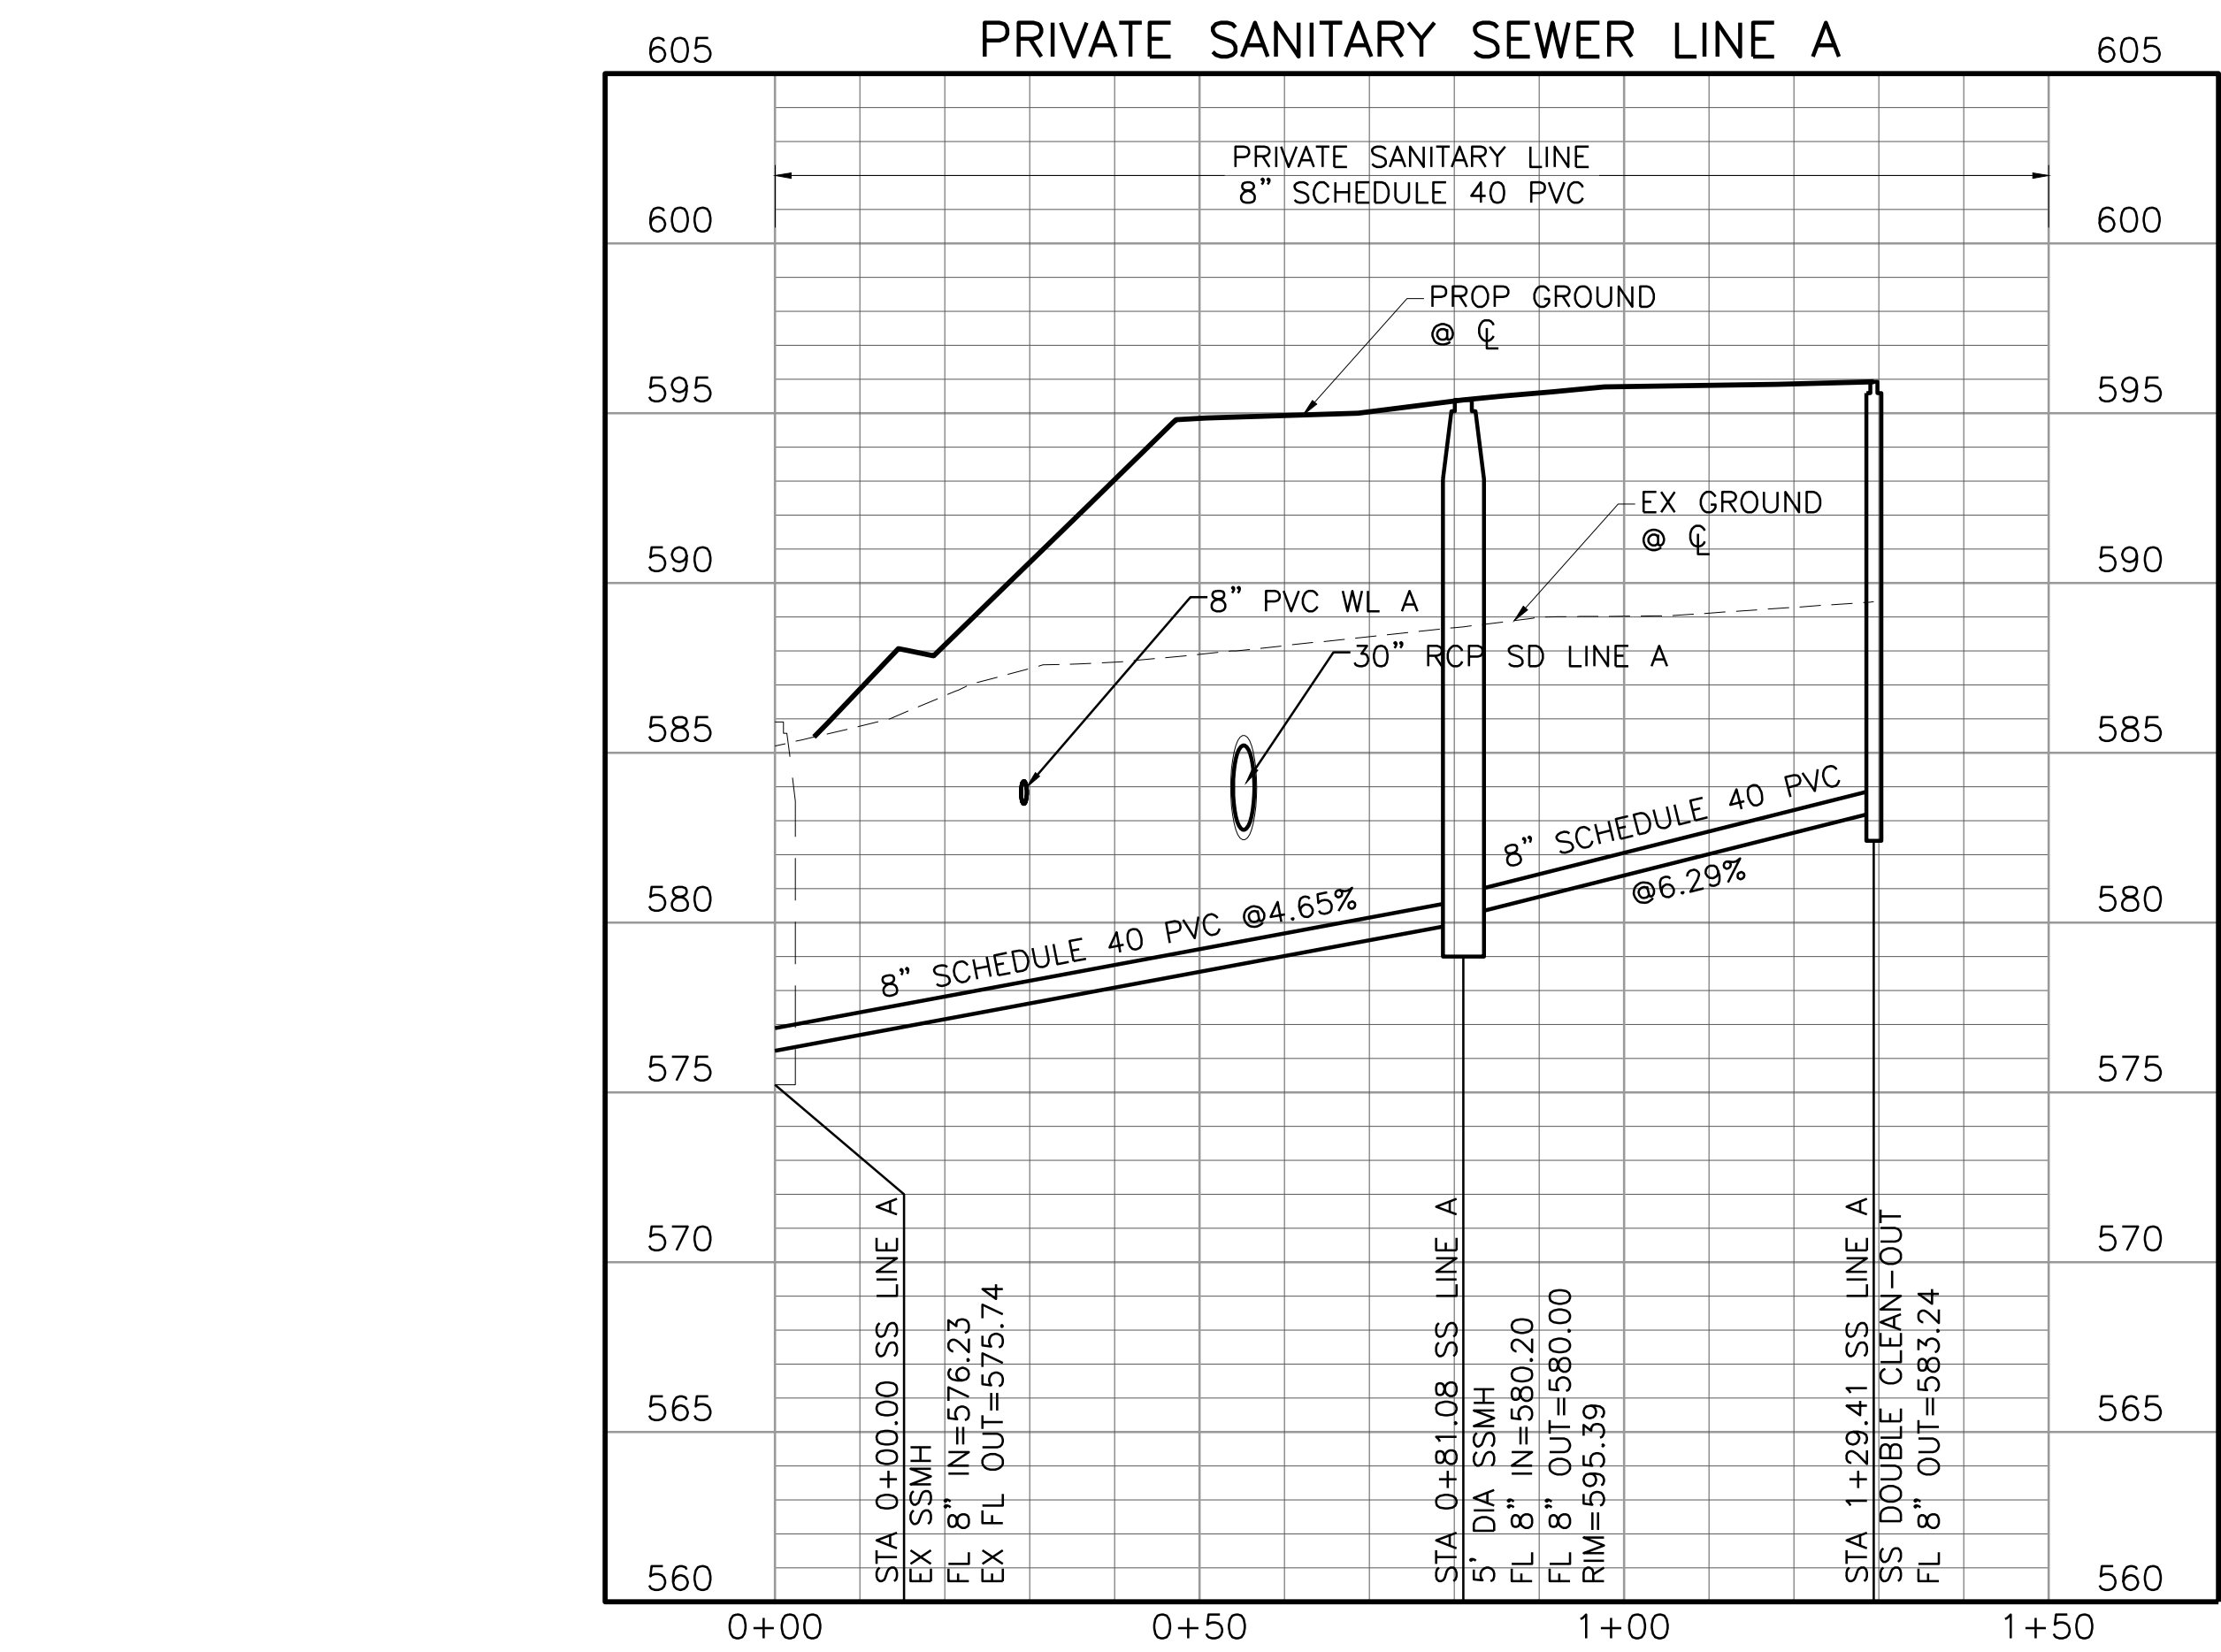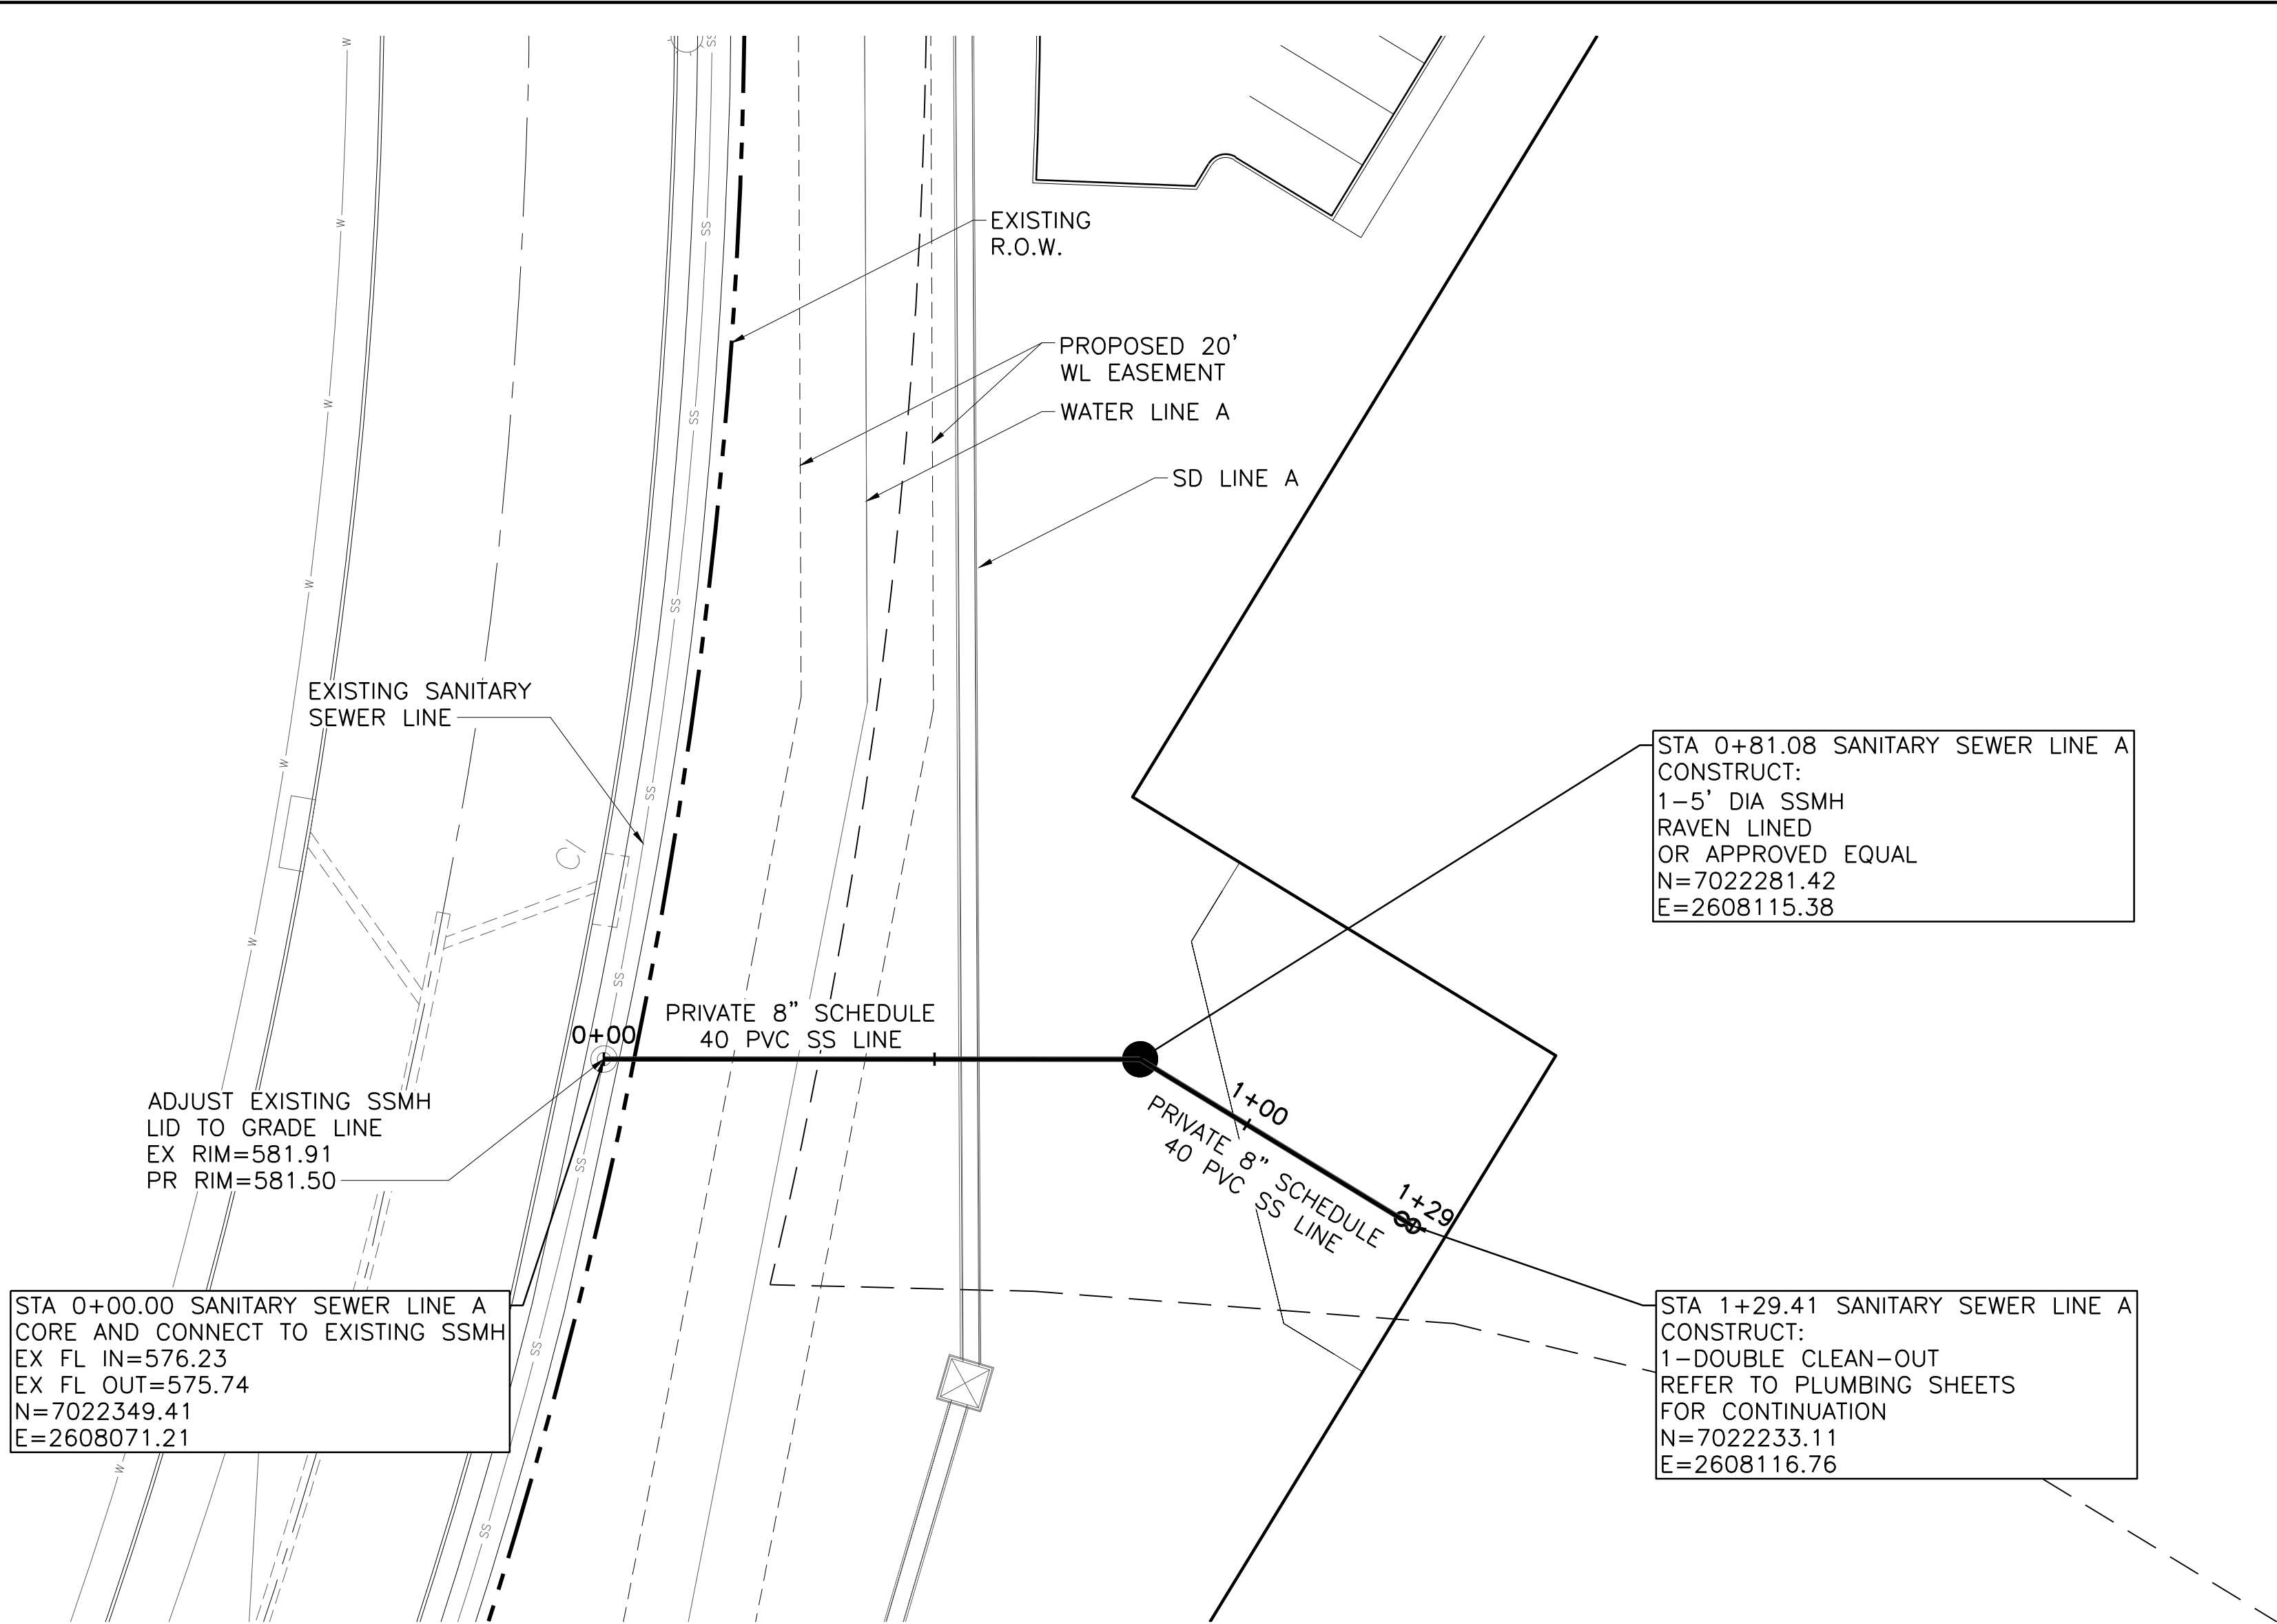

1

NOTES

- ALL RESPONSIBILITY FOR ADEQUACY OF DESIGN REMAINS WITH THE DESIGN ENGINEER. THE CITY OF ROCKWALL, IN REVIEWING AND RELEASING PLANS FOR CONSTRUCTION, ASSUMES NO RESPONSIBILITY FOR ADEQUACY OR ACCURACY OF DESIGN.
- ALL SANITARY SEWER WORK DESIGNATED AS "PRIVATE" IN THIS SET OF PLANS SHALL BE INSTALLED IN ACCORDANCE WITH THE INTERNATIONAL PLUMBING CODE, PERMITTED AND INSPECTED BY THE CITY BUILDING INSPECTION DEPARTMENT AND INSTALLED BY A LICENSED PLUMBER.

BENCHMARKS:
BENCHMARK A—AN "X" CUT IN THE CENTER OF THE SIDEWALK AT THE END OF THE HANDICAP RAMP AT THE SOUTHEAST CORNER OF THE INTERSECTION OF DISCOVERY BLVD. AND DATA DR., 11 FEET SOUTHEAST OF THE CURB LINE.
ELEV=600.44
BENCHMARK B—AN "X" CUT ON THE CURB ON THE NORTH SIDE OF DISCOVERY BLVD. 580 FEET EAST OF CORPORATE CROSSING, 11 FEET SOUTHEAST OF A FIRE HYDRANT, AND 19 FEET NORTHEAST OF TWO (2) WATER VALVES.
ELEV=599.67

THE SEAL THAT ORIGINALLY APPEARED ON THIS DOCUMENT WAS AUTHORIZED BY: JRETT M. 8853206 J.E. TEXAS NO. 101000 EXPIRATION DATE 8/1/2018. ALTERATION OF A SEALED DOCUMENT WITHOUT PROPER NOTIFICATION OF THE RESPONSIBLE ENGINEER IS AN OFFENSE UNDER THE TEXAS ENGINEERING PRACTICE ACT.
This Record Drawing is a combination of the sealed engineering contract drawings for this project, modified by information furnished by the contractor reflecting changes in the Project made during construction. The original sealed drawings are on file at the offices of:
FREESE AND NICHOLS, INC.
RECORD DRAWINGS PREPARED ON: 3/6/2019

CLAYCO
THE ART & SCIENCE OF BUILDING
2199 INNERBELT BUSINESS CENTER DRIVE
ST. LOUIS, MISSOURI 63114
Ph 314.429.1010 Fx 314.429.3137

ARCHITECT
FORUM
2199 INNERBELT BUSINESS CENTER DRIVE
ST. LOUIS, MISSOURI 63114
Ph 314.429.1010 Fx 314.429.7770

CONTRACTOR / DEVELOPER
CLAYCO

LANDSCAPE ARCHITECT
FORUM

CIVIL ENGINEER
FREESE & NICHOLS


STRUCTURAL ENGINEER

MECHANICAL ENGINEER

ELECTRICAL ENGINEER


PLUMBING ENGINEER

FIRE PROTECTION ENGINEER

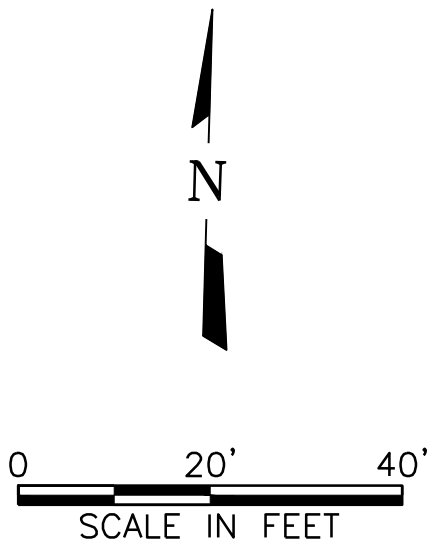


Lollicup
ROCKWALL TECHNOLOGY PARK
ROCKWALL, TEXAS

DRAWING ISSUE

APPLICANT INFORMATION		DESCRIPTION	DATE
BOB LEIMBERG CLAYCO 2199 INNERBELT BUSINESS CENTER DR. ST. LOUIS, MO 63114 314.592.2234 office 314.713.7874 mobile leimbergb@claycorp.com	1	ENGINEERING SUBMITTAL CITY OF ROCKWALL	2/2/2018
		ENGINEERING REVIEW 2ND SUBMITTAL	3/2/2018
		ENGINEERING REVIEW 3RD SUBMITTAL	3/23/2018
		ISSUED FOR CONSTRUCTION	4/10/2018
		OWNER INFORMATION	
		ALAN YU LOLLICUP USA 6185 KIMBALL AVE. CHINO, CA 91708 626.965.8882 x110 office 626.226.8556 mobile alan.yu@lollicup.com	
PROJECT NAME LOLLICUP USA WAREHOUSE CASE NUMBER:	1	 SS ELEVATION REV	6/1/2018
		RECORD DRAWING	3/6/2019
		DRAWING TITLE SANITARY SEWER PLAN AND PROFILE	
		DRAWING NO. C05-02	
		Forum #	601-03049

3.12 Stone Outlet Sediment Trap

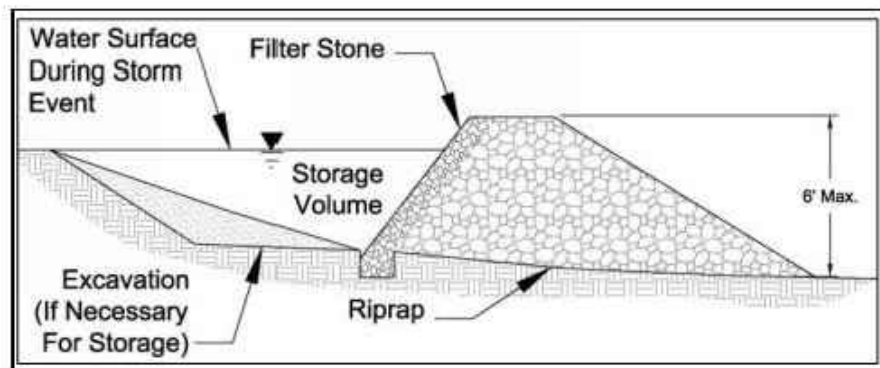

Description: A stone outlet sediment trap is a small detention area formed by placing a stone embankment with an integral stone filter outlet across a drainage swale for the purpose of detaining sediment-laden runoff from construction activities. The sediment trap detains runoff long enough to allow most of the suspended sediment to settle while still allowing for diffused flow of runoff.

KEY CONSIDERATIONS

- DESIGN CRITERIA:**
- Maximum contributing drainage area of 10 acres for excavated trap and 5 acres for bermed trap
 - Provide storage volume for the 2-year, 24-hour design storm
 - Maximum embankment height of 6 feet
 - Embankment slope of 1.5:1 or flatter
 - 2 foot minimum top width

- ADVANTAGES / BENEFITS:**
- Effectively traps sediment in a drainage swale
 - Reduces flow velocities
 - Relatively long effective life

- DISADVANTAGES / LIMITATIONS:**
- Amount of land required
 - Can cause minor upstream flooding, possibly impacting construction operations
 - Not for use in "live" (normally flowing) channels

- MAINTENANCE REQUIREMENTS:**
- Inspect regularly
 - Replace filter stone when it appears to be silted in such that efficiency is diminished
 - Remove trash and debris after each storm event
 - Remove deposited sediment when before the storage capacity is reduced by one third or has reached a depth of one foot, whichever is less

TARGETED POLLUTANTS

- Sediment
- Nutrients & Toxic Materials
- Oil & Grease
- Floatable Materials
- Other Construction Wastes

Stone Outlet Sediment Trap
Revised 04/10

CC-152


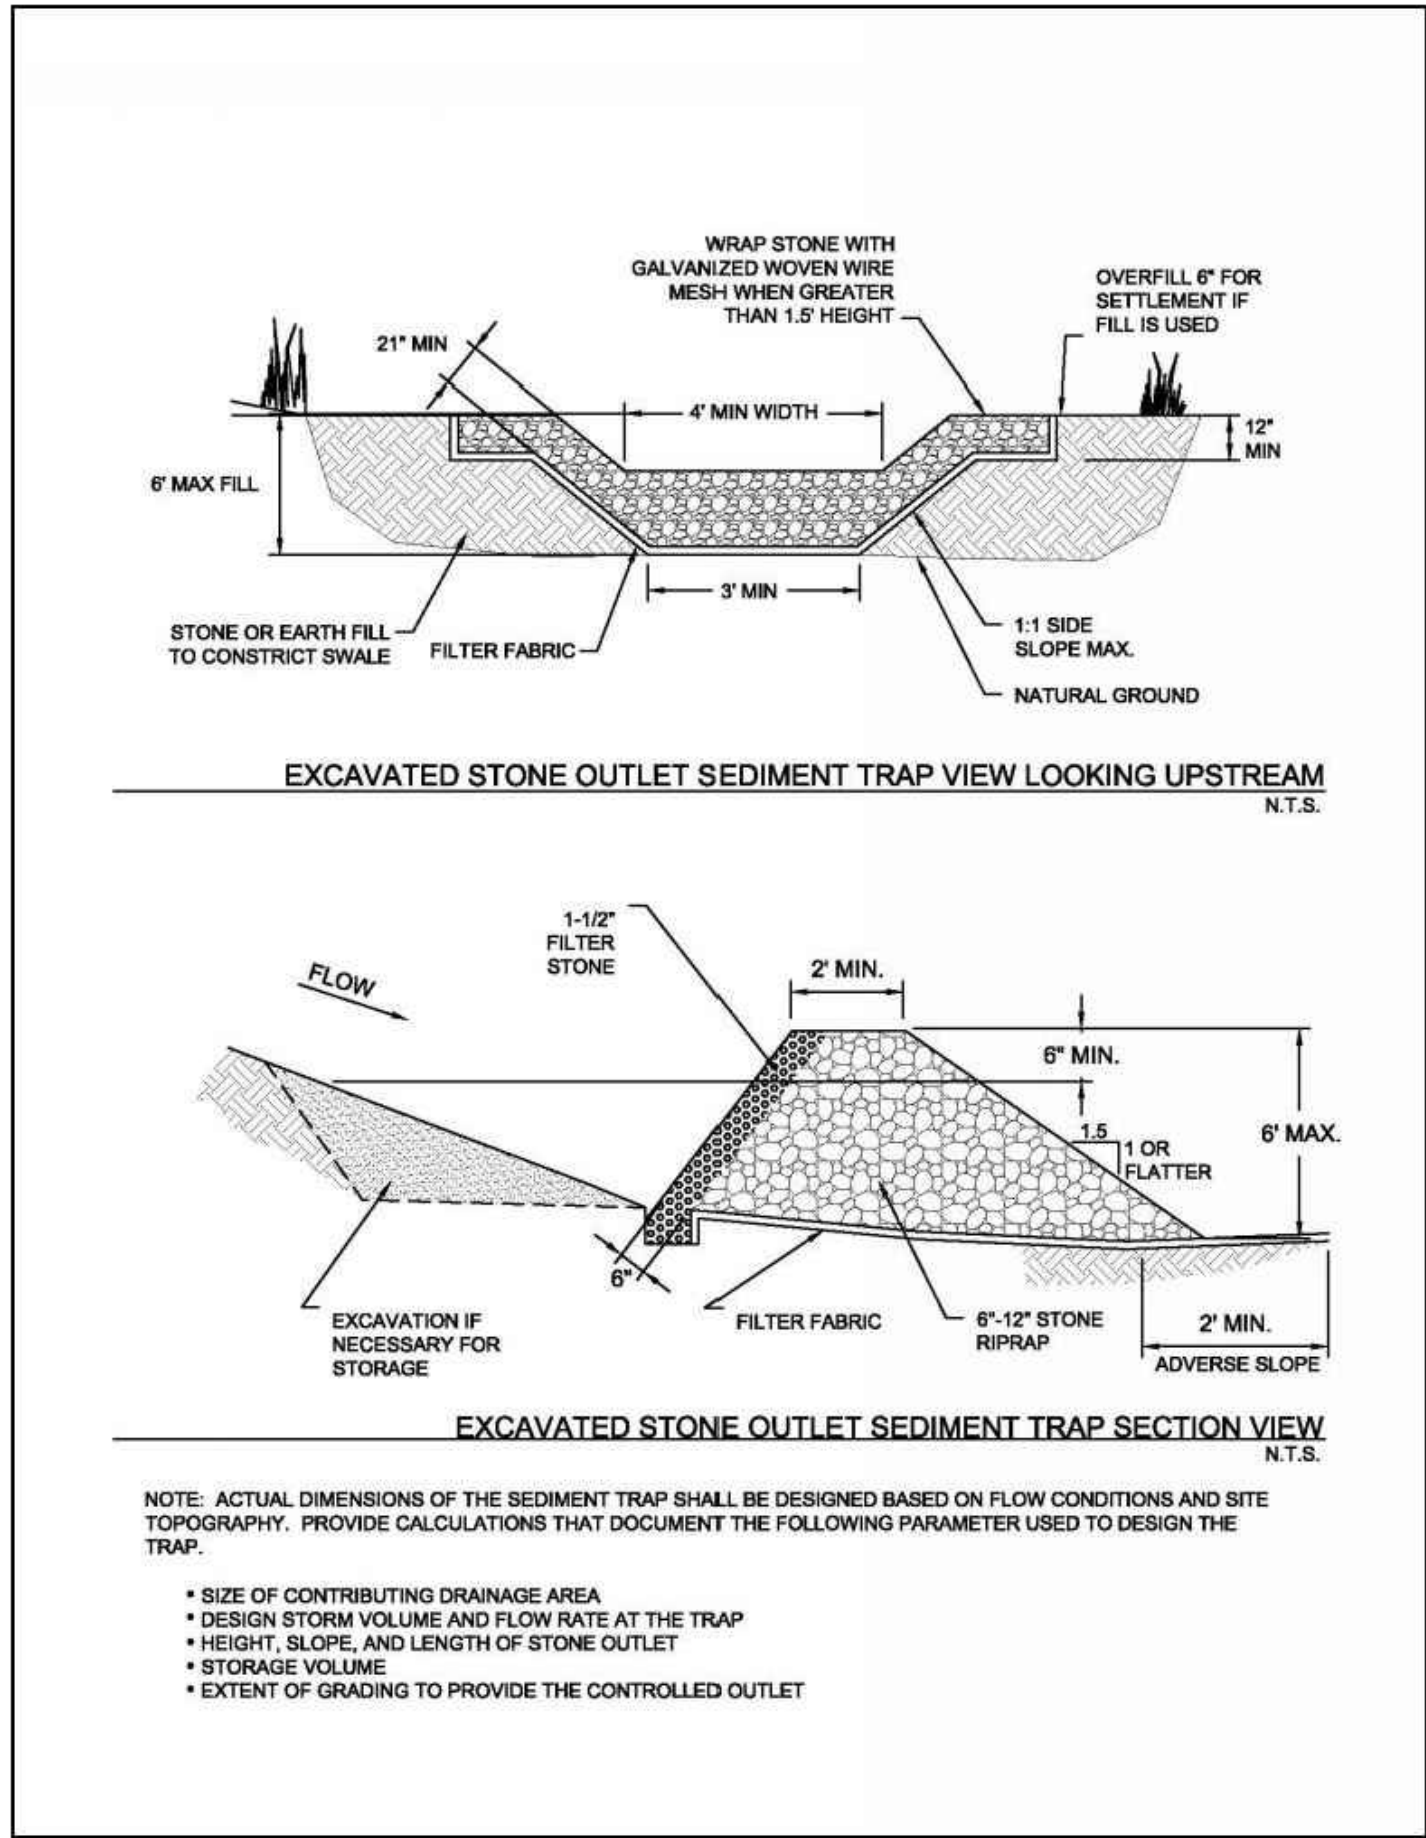


Figure 3.30 Schematics of Excavated Stone Outlet Sediment Trap

Stone Outlet Sediment Trap
Revised 04/10

CC-155

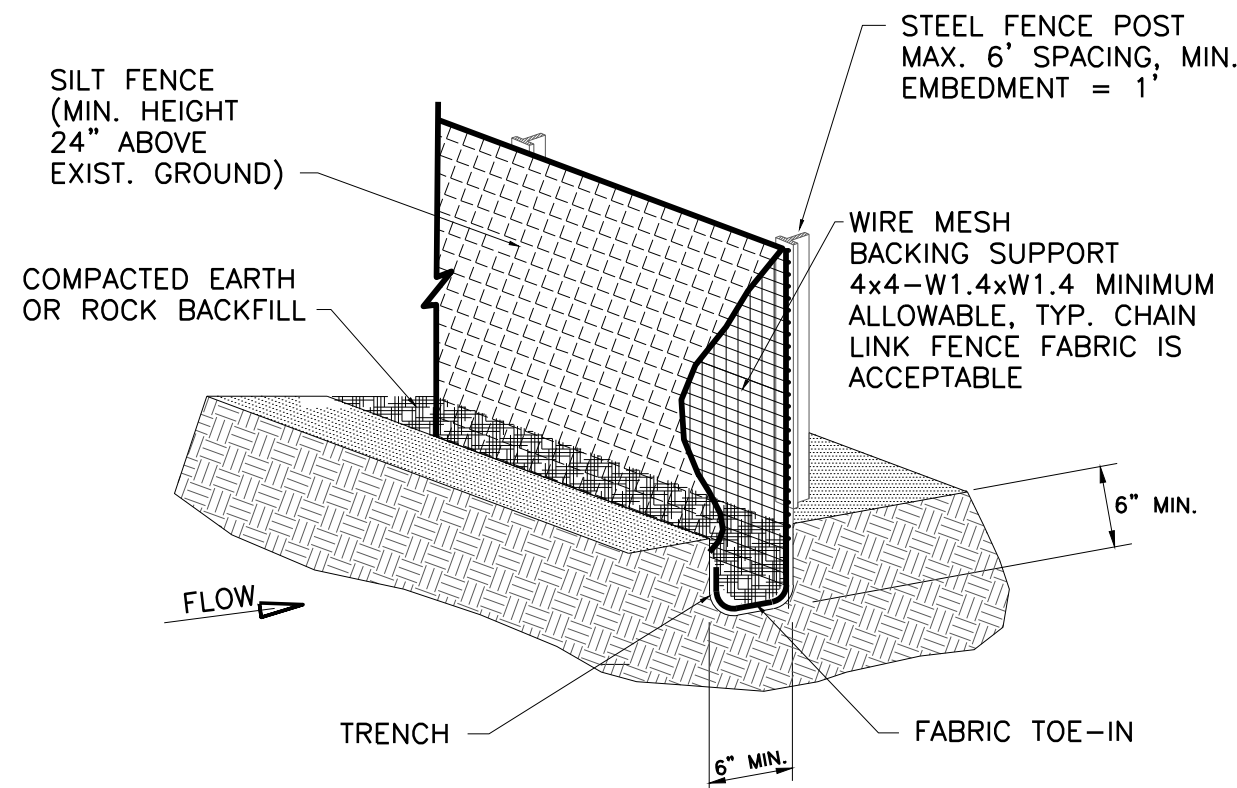


ISOMETRIC PLAN VIEW
NOT TO SCALE


1 SILT FENCE
NOT TO SCALE

SILT FENCE GENERAL NOTES:

- STEEL POSTS WHICH SUPPORT THE SILT FENCE SHALL BE INSTALLED ON A SLIGHT ANGLE TOWARD THE ANTICIPATED RUNOFF SOURCE. POST MUST BE EMBEDDED A MINIMUM OF ONE FOOT.
- THE TOE OF THE SILT FENCE SHALL BE TRENCHED IN WITH A SPADE OR MECHANICAL TRENCHER, SO THAT THE DOWNSLOPE FACE OF THE TRENCH IS FLAT AND PERPENDICULAR TO THE LINE OF FLOW. WHERE FENCE CANNOT BE TRENCHED IN (e.g. PAVEMENT), WEIGHT FABRIC FLAP WITH ROCK ON UPHILL SIDE TO PREVENT FLOW FROM SEEPING UNDER FENCE.
- THE TRENCH MUST BE A MINIMUM OF 6 INCHES DEEP AND 6 INCHES WIDE TO ALLOW FOR THE SILT FENCE FABRIC TO BE LAID IN THE GROUND AND BACKFILLED WITH COMPACTED MATERIAL.
- SILT FENCE SHOULD BE SECURELY FASTENED TO EACH STEEL SUPPORT POST OR TO WOVEN WIRE, WHICH IN TURN IS ATTACHED TO THE STEEL FENCE POST. THERE SHALL BE A 3 FOOT OVERLAP, SECURELY FASTENED WHERE ENDS OF FABRIC MEET.
- INSPECTION SHALL BE MADE EVERY TWO WEEKS AND AFTER EACH 1/2" RAINFALL. REPAIR OR REPLACEMENT SHALL BE MADE PROMPTLY AS NEEDED.
- SILT FENCE SHALL BE REMOVED WHEN THE SITE IS COMPLETELY STABILIZED SO AS NOT TO BLOCK OR IMPEDE STORM FLOW OR DRAINAGE.
- ACCUMULATED SILT SHALL BE REMOVED WHEN IT REACHES A DEPTH OF HALF THE HEIGHT OF THE FENCE. THE SILT SHALL BE DISPOSED OF AT AN APPROVED SITE AND IN SUCH A MANNER AS TO NOT CONTRIBUTE TO ADDITIONAL SILTATION.

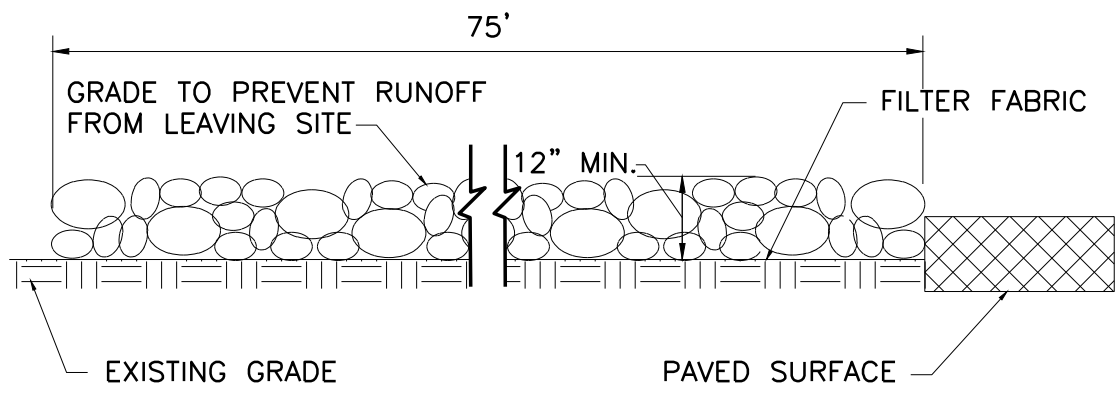

PROFILE VIEW
NOT TO SCALE

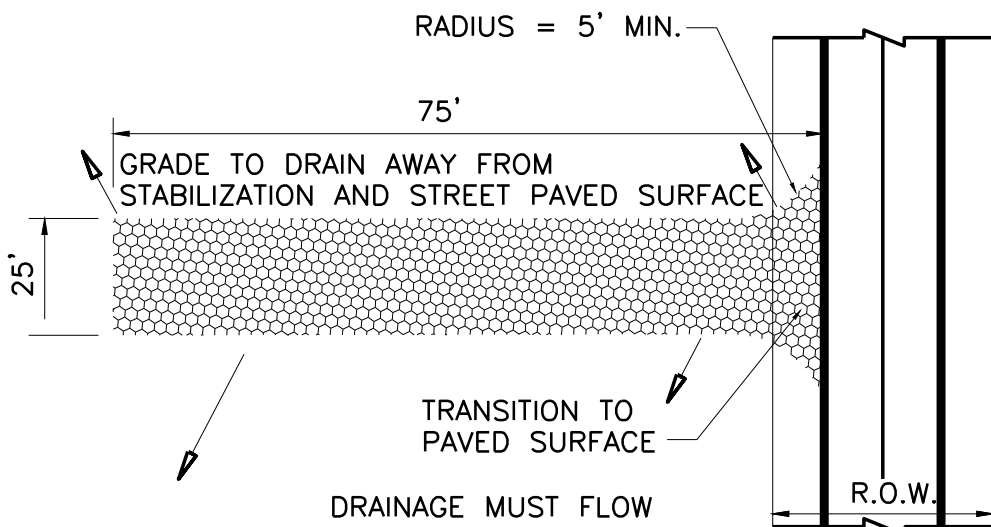

PLAN VIEW
NOT TO SCALE

2 STABILIZED CONSTRUCTION ENTRANCE
NOT TO SCALE

STABILIZED CONSTRUCTION ENTRANCE GENERAL NOTES:

- STONE SHALL BE 4 TO 6 INCH DIAMETER CRUSHED ROCK. NO CRUSHED PORTLAND CEMENT CONCRETE IS ALLOWED.
- LENGTH SHALL BE SHOWN ON PLANS, WITH A MINIMUM LENGTH OF 30 FEET FOR LOTS WHICH ARE LESS THAN 150 FEET FROM EDGE OF PAVEMENT. THE MINIMUM DEPTH IN ALL OTHER CASES SHALL BE 50 FEET.
- THE THICKNESS SHALL NOT BE LESS THAN 12 INCHES.
- THE WIDTH SHALL BE NO LESS THAN THE FULL WIDTH OF ALL POINTS OF INGRESS OR EGRESS.
- WHEN NECESSARY, VEHICLES SHALL BE CLEANED TO REMOVE SEDIMENT PRIOR TO ENTRANCE ONTO A PUBLIC ROADWAY. WHEN WASHING IS REQUIRED, IT SHALL BE DONE ON AN AREA STABILIZED WITH CRUSHED STONE WITH DRAINAGE FLOWING AWAY FROM BOTH THE STREET AND THE STABILIZED ENTRANCE. ALL SEDIMENT SHALL BE PREVENTED FROM ENTERING ANY STORM DRAIN, DITCH OR WATERCOURSE USING CITY APPROVED METHODS.
- THE ENTRANCE SHALL BE MAINTAINED IN A CONDITION WHICH WILL PREVENT TRACKING OR FLOWING OF SEDIMENT ONTO PAVED SURFACES. THIS MAY REQUIRE PERIODIC TOP DRESSING WITH ADDITIONAL STONE AS CONDITIONS DEMAND. ALL SEDIMENT SPILLED, DROPPED, WASHED, OR TRACKED ONTO PAVED SURFACES MUST BE REMOVED IMMEDIATELY.
- THE ENTRANCE MUST BE PROPERLY GRADED OR INCORPORATE A DRAINAGE SWALE TO PREVENT RUNOFF FROM LEAVING THE CONSTRUCTION SITE.

NOTES

- ALL RESPONSIBILITY FOR ADEQUACY OF DESIGN REMAINS WITH THE DESIGN ENGINEER. THE CITY OF ROCKWALL, IN REVIEWING AND RELEASING PLANS FOR CONSTRUCTION, ASSUMES NO RESPONSIBILITY FOR ADEQUACY OR ACCURACY OF DESIGN.
- DETAILS ARE BASED ON NCTCOG DESIGN STANDARDS 4TH EDITION.

APPLICANT INFORMATION		DESCRIPTION	DATE
BOB LEIMBERG CLAYCO 2199 INNERBELT BUSINESS CENTER DR. ST. LOUIS, MO 63114 314.592.2234 office 314.713.7874 mobile leimbergb@claycorp.com	1	ENGINEERING SUBMITTAL CITY OF ROCKWALL	2/2/2018
		ENGINEERING REVIEW 2ND SUBMITTAL	3/2/2018
		ENGINEERING REVIEW 3RD SUBMITTAL	3/23/2018
		ISSUED FOR CONSTRUCTION	4/10/2018
OWNER INFORMATION		RECORD DRAWING	12/17/2018
ALAN YU LOLLICUP USA 6185 KIMBALL AVE. CHINO, CA 91708 626.965.8882 x110 office 626.226.8556 mobile alan.yu@lolicup.com			
		DRAWING TITLE EROSION CONTROL DETAILS	
		DRAWING NO.	
PROJECT NAME		C06-01	
LOLLICUP USA WAREHOUSE			
CASE NUMBER:		Forum #	601-03049
		Consult#	101-03049

THE SEAL THAT ORIGINALLY APPEARED ON THIS DOCUMENT WAS AUTHORIZED BY BRETT M. BRISTOW, P.E. TEXAS NO. 102000 ON 2/10/2018. ALTERATION OF A SEALED DOCUMENT WITHOUT PROPER NOTIFICATION OF THE RESPONSIBLE ENGINEER IS AN OFFENSE UNDER THE TEXAS ENGINEERING PRACTICE ACT.

This Record Drawing is a combination of the sealed engineering contract drawings for this project, modified by information furnished by the contractor reflecting changes in the Project made during construction. The original sealed drawings are on file at the offices of

FREESE AND NICHOLS, INC.
RECORD DRAWINGS PREPARED ON: 3/6/2019

CLAYCO
THE ART & SCIENCE OF BUILDING
2199 INNERBELT BUSINESS CENTER DRIVE
ST. LOUIS, MISSOURI 63114
Ph 314.429.5100 Fx 314.429.3137

ARCHITECT
FORUM
2199 INNERBELT BUSINESS CENTER DRIVE
ST. LOUIS, MISSOURI 63114
Ph 314.429.1010 Fx 314.429.7770

CONTRACTOR / DEVELOPER
CLAYCO

LANDSCAPE ARCHITECT
FORUM

CIVIL ENGINEER
FREESE & NICHOLS

STRUCTURAL ENGINEER

MECHANICAL ENGINEER

ELECTRICAL ENGINEER

PLUMBING ENGINEER








FIRE PROTECTION ENGINEER

Lollicup
ROCKWALL TECHNOLOGY PARK
ROCKWALL, TEXAS

DRAWING ISSUE

DISCLAIMER:
The use of this standard is governed by the "Texas Engineering Practice Act". No warranty of any kind is made by the author or any publisher, wholesaler, or retailer in connection with the use of this standard to other persons or for other purposes or for other results or damages resulting from its use.

DATE:
FILE:

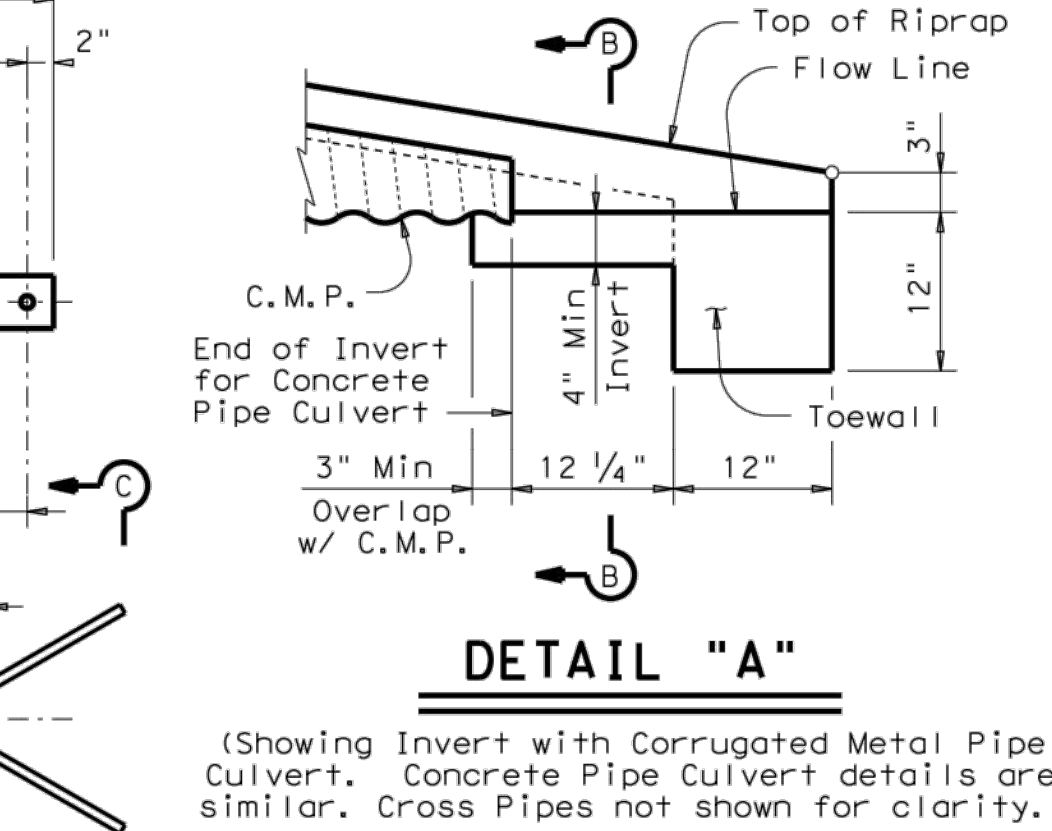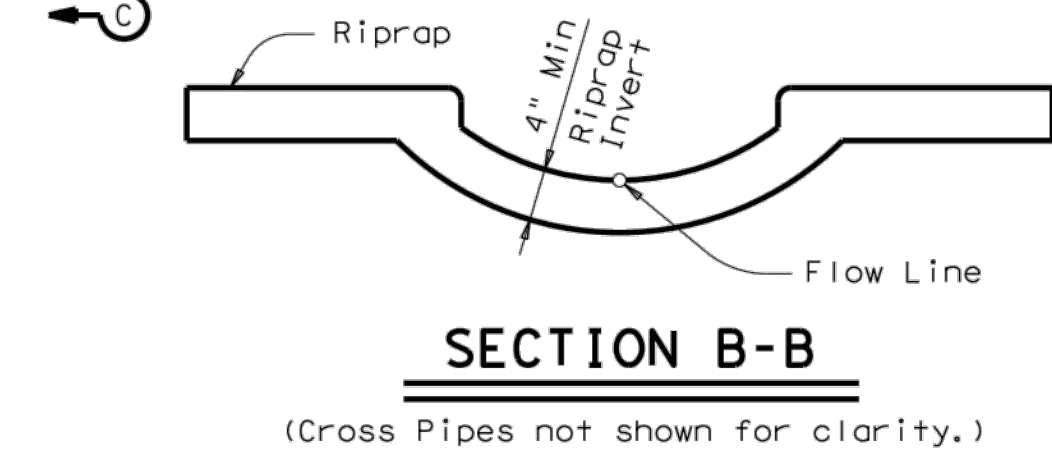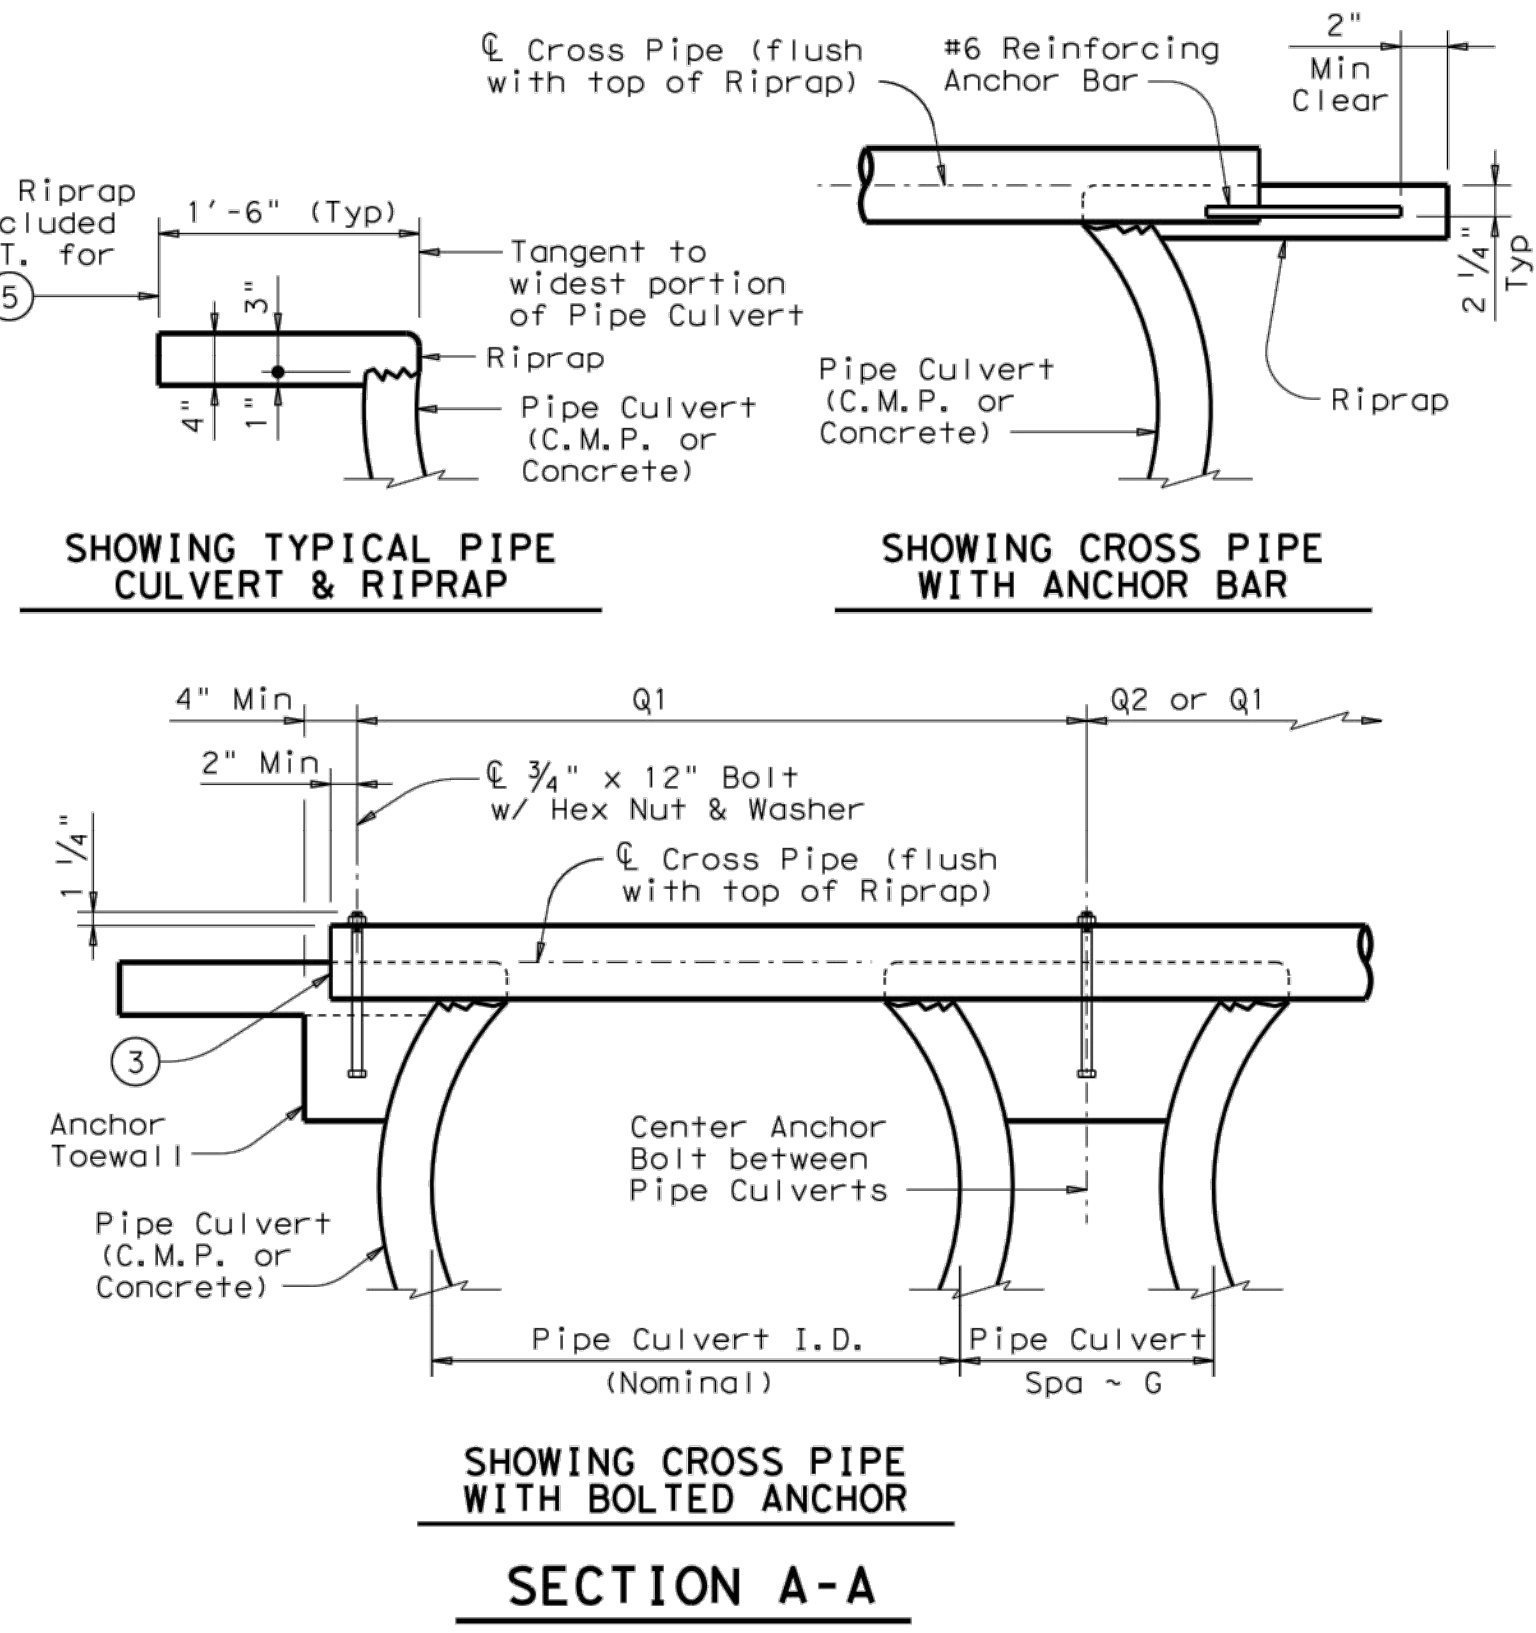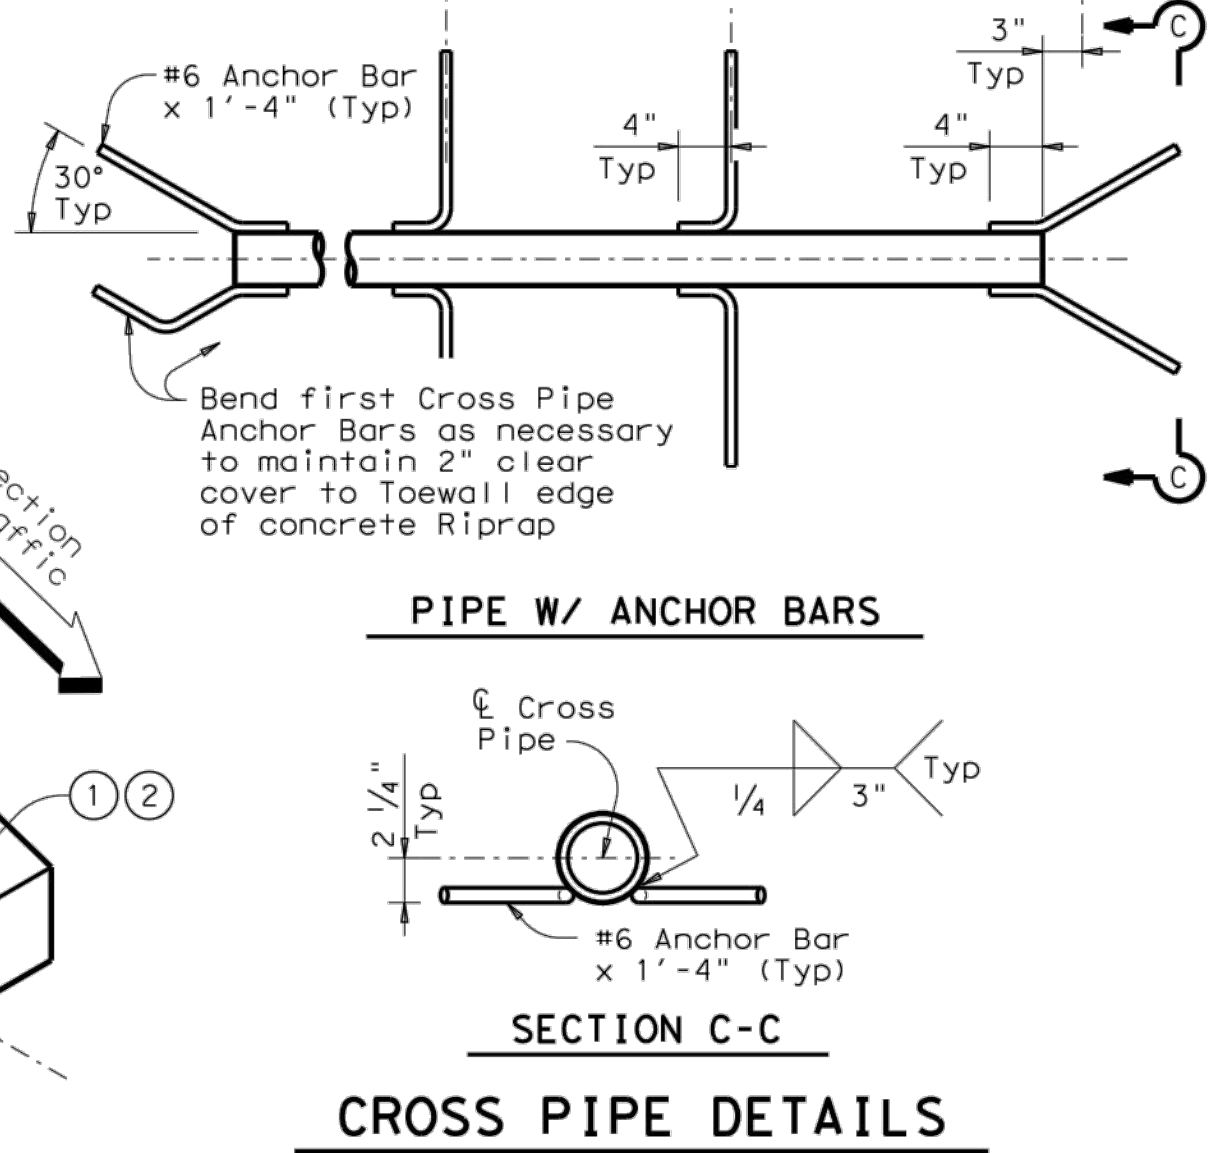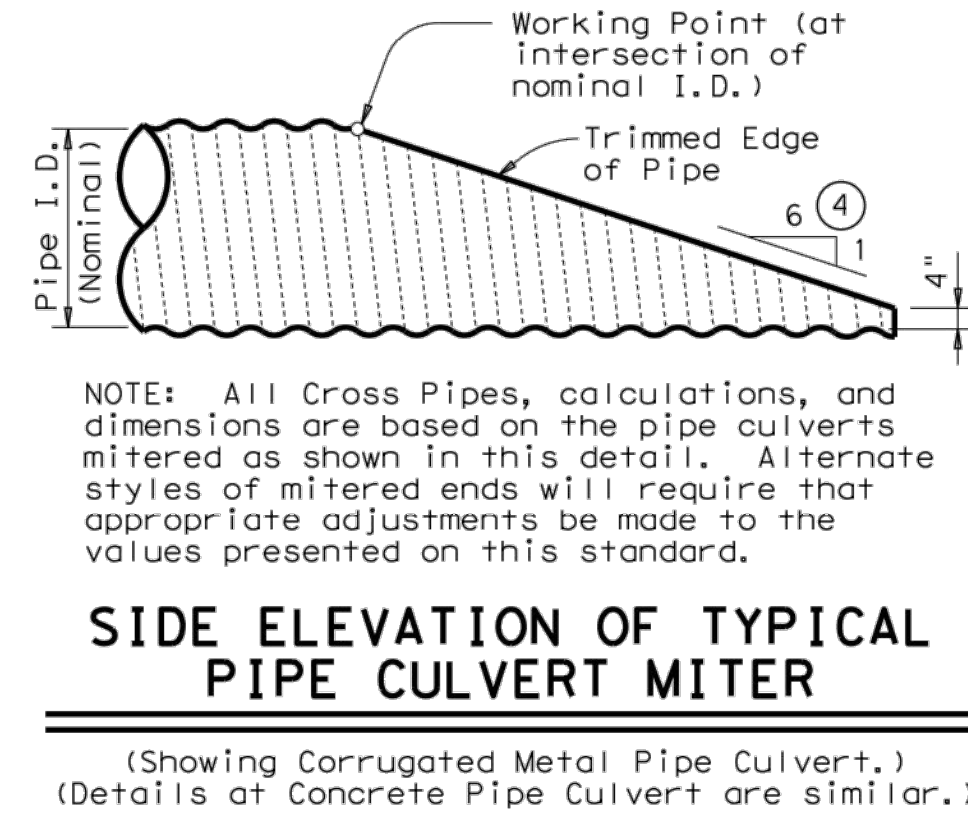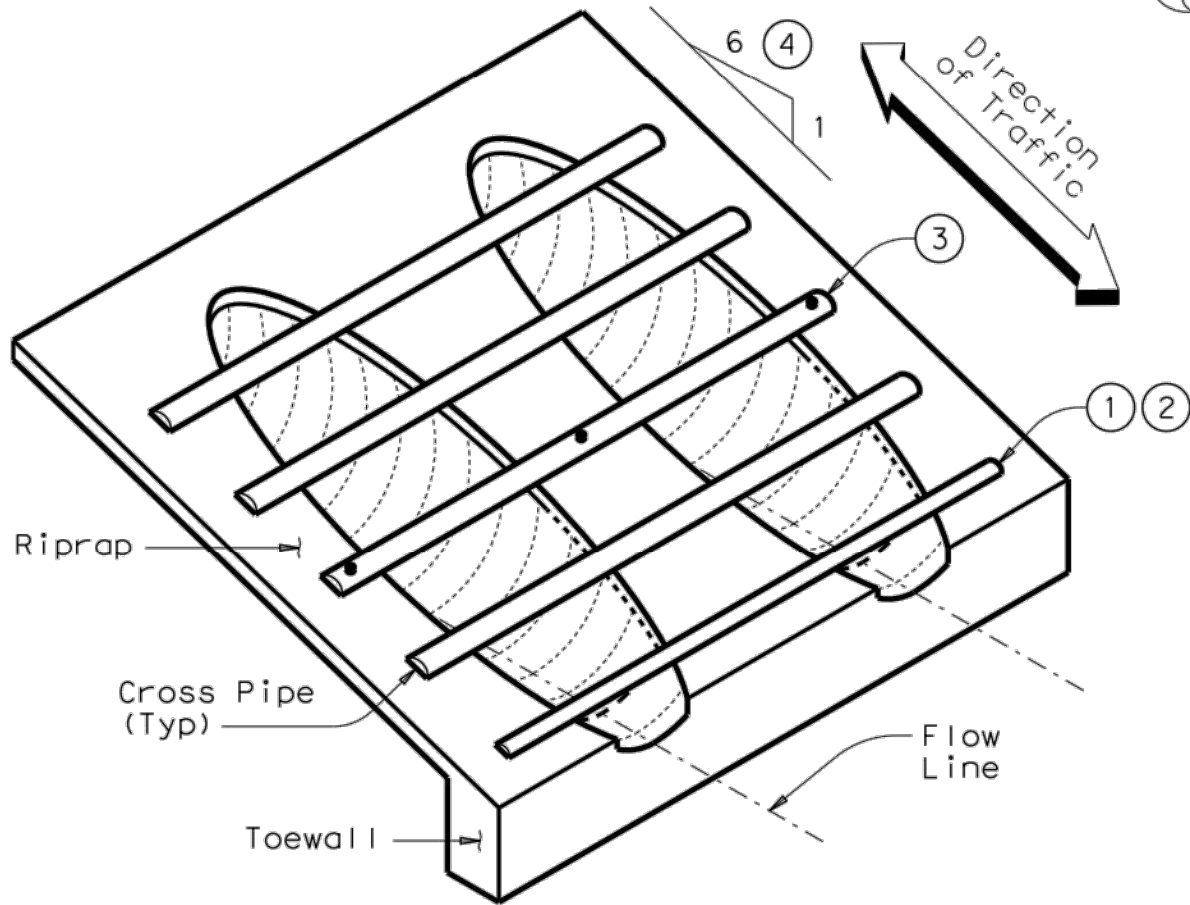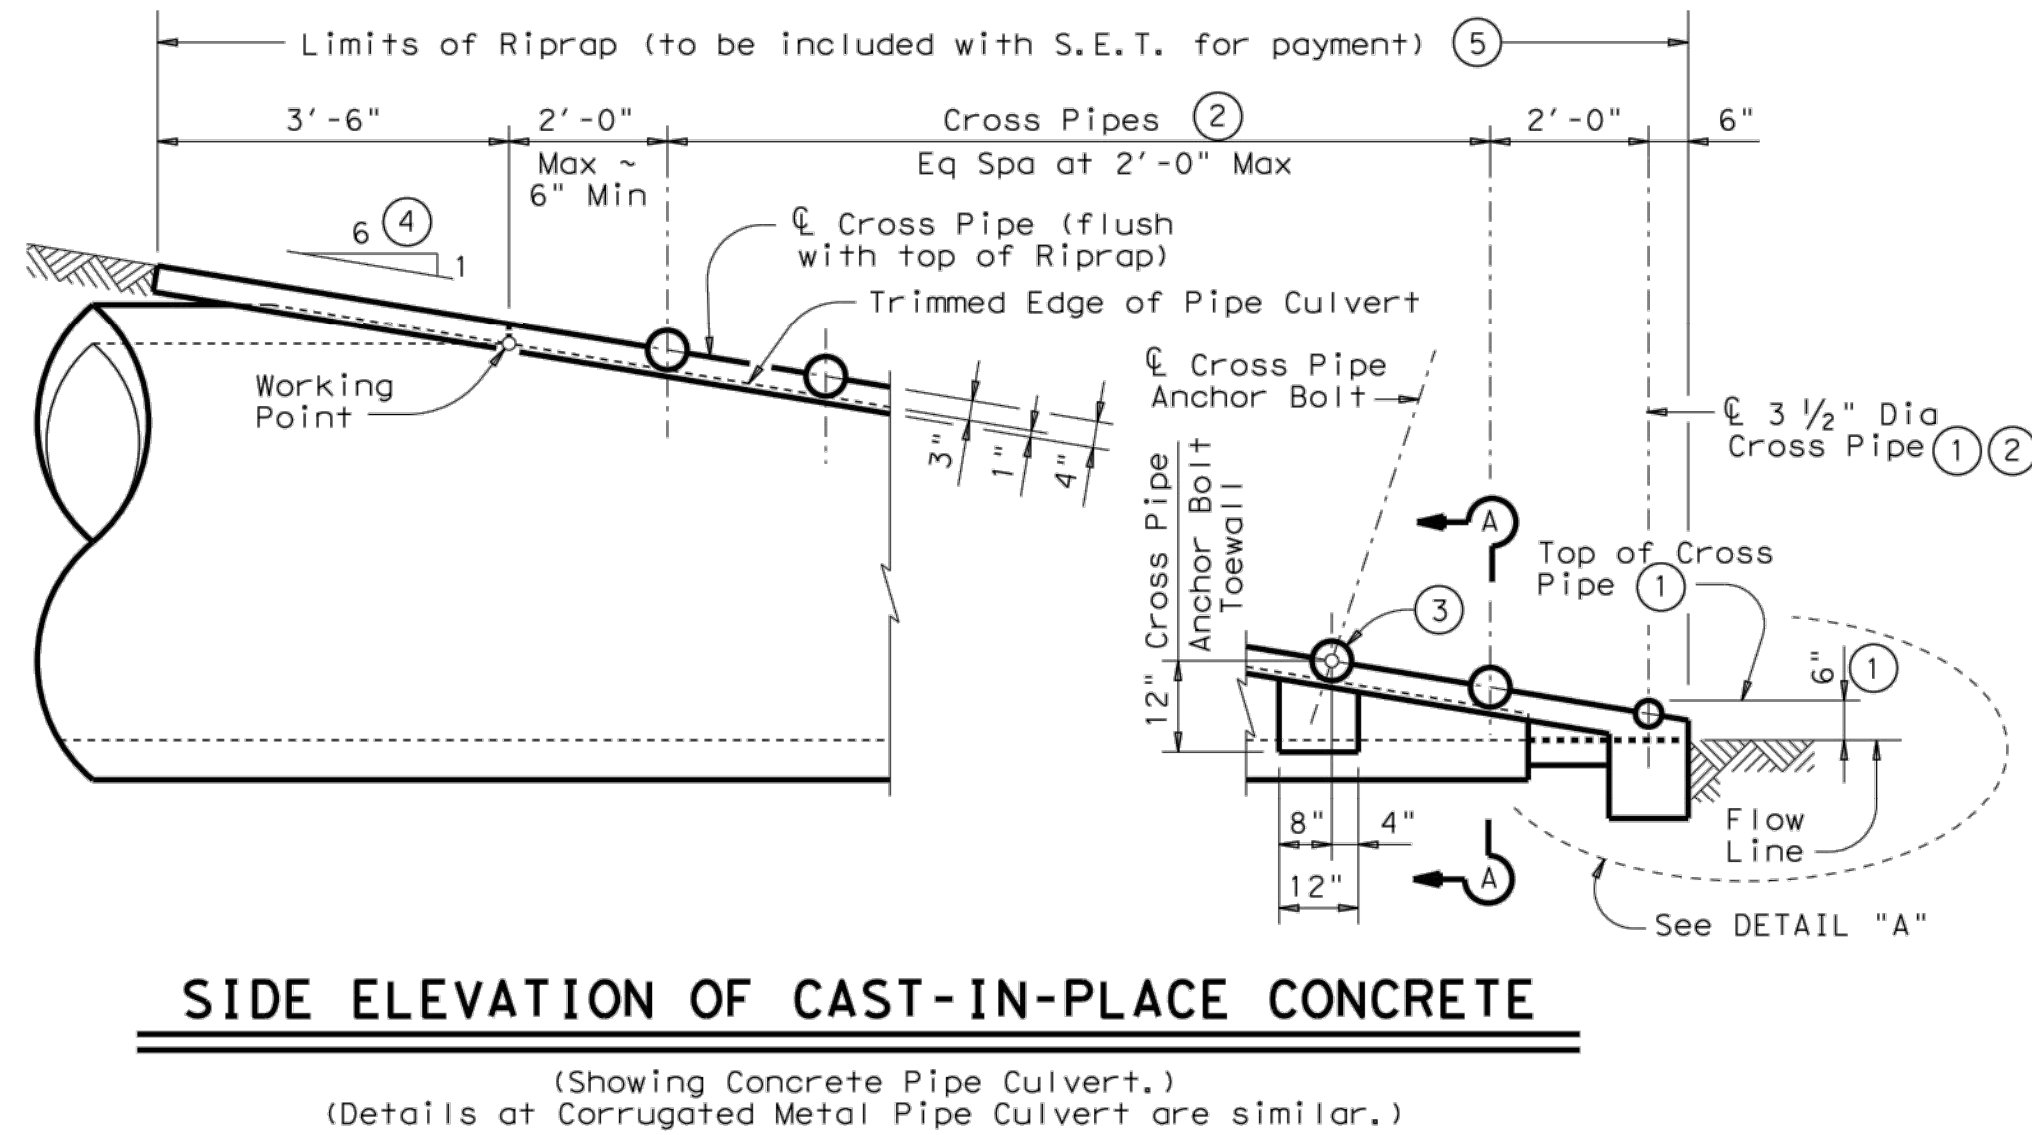

CROSS PIPE LENGTHS, REQUIRED PIPE SIZES, & RIPRAP QUANTITIES ②							Conditions for use of Cross Pipes	Cross Pipe Size
Nominal Culvert I.D.	Conc Riprap (CY) ⑥	Pipe Culvert Spa ~ G	Single Barrel ~ Q1	Multi-Barrel ~ Q1	Q2			
12"	0.6	9"	N/A	2'-1"	1'-9"		3 or more Pipe Culverts	3" Std (3,500" O.D.)
15"	0.7	11"	N/A	2'-5"	2'-2"			
18"	0.8	1'-2"	N/A	2'-10"	2'-8"			
21"	0.9	1'-4"	N/A	3'-2"	3'-1"			
24"	0.9	1'-7"	N/A	3'-6"	3'-7"		3 or more Pipe Culverts	3 1/2" Std (4,000" O.D.)
27"	1.0	1'-8"	N/A	3'-10"	3'-11"			
30"	1.1	1'-10"	N/A	4'-2"	4'-4"		2 or more Pipe Culverts	3 1/2" Std (4,000" O.D.)
33"	1.2	1'-11"	4'-2"	4'-5"	4'-8"			
36"	1.3	2'-1"	4'-5"	4'-9"	5'-1"		All Pipe Culverts	4" Std (4,500" O.D.)
42"	1.5	2'-4"	4'-11"	5'-5"	5'-10"			
48"	1.7	2'-7"	5'-5"	6'-0"	6'-7"			
54"	2.0	3'-0"	5'-11"	6'-9"	7'-6"			
60"	2.2	3'-3"	6'-5"	7'-4"	8'-3"		All Pipe Culverts	5" Std (5,563" O.D.)
66"	2.4	3'-3"	6'-11"	7'-10"	8'-9"			
72"	2.7	3'-4"	7'-5"	8'-5"	9'-4"			

- ① The proper installation of the first Cross Pipe is critical for vehicle safety. The top of the first Cross Pipe must be placed at no more than 6" above the flow line.
- ② Size of Cross Pipes, except the first bottom pipe, shall be as shown in the PIPE SIZE table. The first bottom pipe shall be 3 1/2" Standard Pipe (4" O.D.).
- ③ The third Cross Pipe from the bottom of the Culvert shall always be installed using a bolted connection. Care shall be taken to ensure that Riprap concrete does not flow into the Cross Pipe so as to permit disassembly of the bolted connection to allow cleanout access. At the Contractor's option, all other Cross Pipes may also be installed using the bolted connection details.
- ④ Match Cross Slope as shown elsewhere in the plans. Cross Slope of 6:1 or flatter is required for vehicle safety.
- ⑤ Riprap placed beyond the limits shown will be paid as Concrete Riprap in accordance with Item 432, "Riprap".
- ⑥ Quantities shown are for one end of one reinforced Concrete Pipe Culvert. For multiple pipe culverts or for Corrugated Metal Pipe Culverts, quantities will need to be adjusted. Riprap quantities are for Contractor's information only.

GENERAL NOTES:
Cross Pipes are designed for a traversing load of 10,000 pounds at yield as recommended by Research Report 280-2F, "Safety Treatment of Roadside Parallel-Drainage Structures", Texas Transportation Institute, March 1981.
Safety End Treatments shown herein are intended for use in those installations where out of control vehicles are likely to traverse the openings approximately perpendicular to the Cross Pipes.
Riprap and all necessary inverts shall be Concrete Riprap conforming to the requirements of Item 432, "Riprap".
Synthetic fibers listed on the "Fibers for Concrete" Material Producer List (MPL) may be used in lieu of steel reinforcing in riprap concrete unless noted otherwise.
Payment for riprap and toewall is included in the Price Bid for each Safety End Treatment.
Cross Pipes shall conform to the requirements of ASTM A53 (Type E or S, Grade B), ASTM A500 (Grade B), or API 5LX52. Bolts and nuts shall conform to ASTM A307.
All steel components, except concrete reinforcing, shall be galvanized after fabrication. Galvanizing damaged during transport or construction shall be repaired in accordance with the specifications.

SAFETY END TREATMENT			
FOR 12" DIA TO 72" DIA			
PIPE CULVERTS			
TYPE II ~ PARALLEL DRAINAGE			
SETP-PD			
FILE: setppdse.dgn	DN: GAF	CK: CAT	DN: JRP
©TxDOT February 2010	CONT SECT	JOB	HIGHWAY
REVISIONS			
11-10: Add note for synthetic fibers.	DIST	COUNTY	SHEET NO.

NOTES

1. ALL RESPONSIBILITY FOR ADEQUACY OF DESIGN REMAINS WITH THE DESIGN ENGINEER. THE CITY OF ROCKWALL, IN REVIEWING AND RELEASING PLANS FOR CONSTRUCTION, ASSUMES NO RESPONSIBILITY FOR ADEQUACY OR ACCURACY OF DESIGN.

APPLICANT INFORMATION

BOB LEIMBERG
CLAYCO
2199 INNERBELT BUSINESS CENTER DR.
ST. LOUIS, MO 63114
314.592.2234 office
314.713.7874 mobile
leimbergb@claycorp.com

OWNER INFORMATION

ALAN YU
LOLLICUP USA
6185 KIMBALL AVE.
CHINO, CA 91708
626.965.8882 x110 office
626.226.8556 mobile
alan.yu@lolicup.com

PROJECT NAME

LOLLICUP USA WAREHOUSE
CASE NUMBER:

DRAWING ISSUE

DESCRIPTION	DATE
ENGINEERING SUBMITTAL	2/2/2018
CITY OF ROCKWALL	
ENGINEERING REVIEW	3/2/2018
2ND SUBMITTAL	
ENGINEERING REVIEW	3/23/2018
3RD SUBMITTAL	
ISSUED FOR CONSTRUCTION	4/10/2018
RECORD DRAWING	12/17/2018

DRAWING TITLE
TXDOT SAFETY END
TREATMENT DETAILS

DRAWING NO.

C06-02

Form # 601-03049 Consult# 101-03049

ARCHITECT

FORUM

2199 INNERBELT BUSINESS CENTER DRIVE
ST. LOUIS, MISSOURI 63114
Ph 314.429.1010 Fx 314.429.7770

CONTRACTOR / DEVELOPER

CLAYCO

LANDSCAPE ARCHITECT

FORUM

CIVIL ENGINEER

FREESE & NICHOLS

STRUCTURAL ENGINEER

MECHANICAL ENGINEER

ELECTRICAL ENGINEER

PLUMBING ENGINEER

FIRE PROTECTION ENGINEER

Lolicup

ROCKWALL TECHNOLOGY PARK
ROCKWALL, TEXAS

This Record Drawing is a combination of the sealed engineering contract drawings for this project, modified by information furnished by the contractor reflecting changes in the Project made during construction. The original sealed drawings are on file at the offices of:
FREESE AND NICHOLS, INC.
RECORD DRAWINGS PREPARED ON: 12/17/2018

THE SEAL THAT ORIGINALLY APPEARED ON THIS DOCUMENT WAS AUTHORIZED BY: BRETT M. BRIDGEMAN, P.E.
TEXAS NO. 102000 EXP. 01/30/2018
ALTERATION OF A SEALED DOCUMENT WITHOUT PROPER NOTIFICATION OF THE RESPONSIBLE ENGINEER IS AN OFFENSE UNDER THE TEXAS ENGINEERING PRACTICE ACT.