

\$PLTDIV\$\$

\$MODELNAME\$

\$DATES \$TIMES \$USER\$\$CLIENTS\$FILES\$

STORM DRAIN LINE 'C'

LINE	STA.	DESC.	INCREMENTAL AREA ACRES	RUNOFF COEFFICIENT	INTENSITY IN/HR	DIST FT	TOTAL FLOW Q _{tot} CFS	DIA. IN	RISE FT	ROUGH- NESS n	PIPE SLOPE S _o %	PIPE CAPACITY Q _{cap} CFS	V _{avg} Q _{design} /A	V _{partial} FPS	FRICTION SLOPE S _f FT/FT	H _v V _{design} ² /2g	K _i	H _i FT.	INCOMING PIPE HGL FT	OUTGOING PIPE HGL FT	INCOMING PIPE INVERT FT	OUTGOING PIPE INVERT FT
LINE C	1+00.00	CONNECT TO LINE A				4184	11.73	18	1.5	0.013	4.64%	22.62	6.64	12.91	1.24%	0.68			560.44		554.98	
	1+41.84	C1	0.56	0.90	9.80	72.07	6.79	18	1.5	0.013	4.64%	22.62	3.84	11.10	0.42%	0.23	0.60	0.55	561.51	560.96	556.92	556.92
	2+13.91	C2	0.33	0.90	9.80	79.31	3.88	18	1.5	0.013	4.64%	22.62	2.20	9.56	0.14%	0.07	0.60	0.18	561.99	561.81	560.26	560.26
	2+93.22	CONNECT TO EX. 12"	0.44	0.90	9.80												1.25	0.09	562.10	562.10		563.94
LAT C1	1+00.00					97.11	4.94	18	1.5	0.013	6.35%	26.48	2.80	11.41	0.22%	0.12			561.51		556.92	
	1+97.11	INLET	0.56	0.90	9.80												1.25	0.15	561.72	561.72		563.09
LAT C2	1+00.00					34.45	2.91	18	1.5	0.013	9.31%	32.05	1.65	11.16	0.08%	0.04			561.99		560.26	
	1+34.45	INLET	0.33	0.90	9.80												1.25	0.05	562.02	562.02		563.47

STORM DRAIN LINE 'D'

LINE	STA.	DESC.	INCREMENTAL AREA ACRES	RUNOFF COEFFICIENT	INTENSITY IN/HR	DIST FT	TOTAL FLOW Q _{tot} CFS	DIA. IN	ROUGH- NESS n	PIPE SLOPE S _o %	PIPE CAPACITY Q _{cap} CFS	V _{avg} Q _{design} /A	V _{partial} FPS	FRICTION SLOPE S _f FT/FT	H _v V _{design} ² /2g	K _i	H _i FT.	INCOMING PIPE HGL FT	OUTGOING PIPE HGL FT	INCOMING PIPE INVERT FT	OUTGOING PIPE INVERT FT
LINE D	1+00.00	EXISTING 42"				9.81	40.62	42	0.013	0.48%	69.70	4.22	7.48	0.16%	0.28			554.88		549.20	
	1+09.81	LINE F	* DRAINAGE AREA D-1 IS CONSIDERED TO BE IN DEVELOPED CONDITIONS. D-1 IS CONTRIBUTING TO THE POND STORAGE CALCULATION. SEE SHEET C5.02B			5.00	40.62	42	0.013	0.48%	69.70	4.22	7.48	0.16%	0.28	0.60	0.11	555.01	554.90	549.25	549.25
	1+14.81	Pipe size Change				17.56	40.62	24	0.013	0.48%	15.67	12.93	4.99	3.2%	2.60	1.00	-2.32	552.70	555.01	549.27	549.27
	1+32.37	30 BEND	0.00	0.00	0.00	81.73	40.62	24	0.013	0.48%	15.67	12.93	4.99	3.2%	2.60	0.50	1.30	554.56	553.26	549.36	549.36
	2+14.10	DETENTION POND	-	-	-											0.70	1.82	559.00	557.18	549.75	549.75

STORM DRAIN LINE 'F'


LINE	STA.	DESC.	INCREMENTAL AREA ACRES	RUNOFF COEFFICIENT	INTENSITY IN/HR	DIST FT	TOTAL FLOW Q _{tot} CFS	DIA. IN	ROUGH- NESS n	PIPE SLOPE S _o %	PIPE CAPACITY Q _{cap} CFS	V _{avg} Q _{design} /A	V _{partial} FPS	FRICTION SLOPE S _f FT/FT	H _v V _{design} ² /2g	K _i	H _i FT.	INCOMING PIPE HGL FT	OUTGOING PIPE HGL FT	INCOMING PIPE INVERT FT	OUTGOING PIPE INVERT FT
LINE F	1+00.00					25.26	23.12	24	0.013	2.98%	39.05	7.36	12.92	1.04%	0.84			555.01		549.25	
	1+25.26	DROP INLET	7.96	0.35	8.30											1.25	1.05	556.32	555.27		550.00

ROCKWALL COUNTY
COURTHOUSE
ROCKWALL COUNTY
ROCKWALL, TEXAS



Revision No.	Date	Description
1	04/03/2010	SITE PLAN REVISIONS

RECORD DRAWING
APRIL, 2011
These Record Documents have been prepared based upon information provided by Manhattan Construction. The Design Professional has not verified the accuracy and / or completeness of this information and shall not be responsible for any errors or omissions which may be incorporated herein as a result of Design Consultant: Half Associates, Inc.
RECORD DRAWING SUBMITTAL

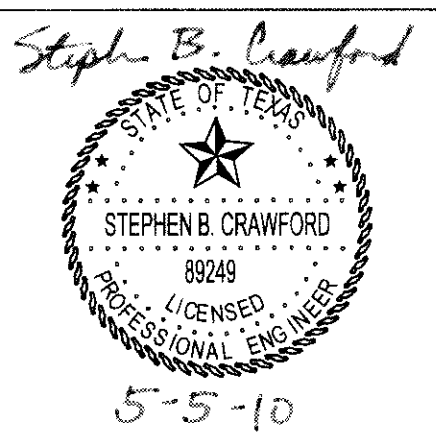

Project No.	26244
Issued:	APRIL 2011
Drawn By:	B.J.G
Checked By:	SBC
Scale:	AS NOTED
Sheet Title	STORM DRAIN CALCULATIONS
C5.10	Sheet Number